
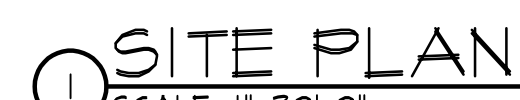
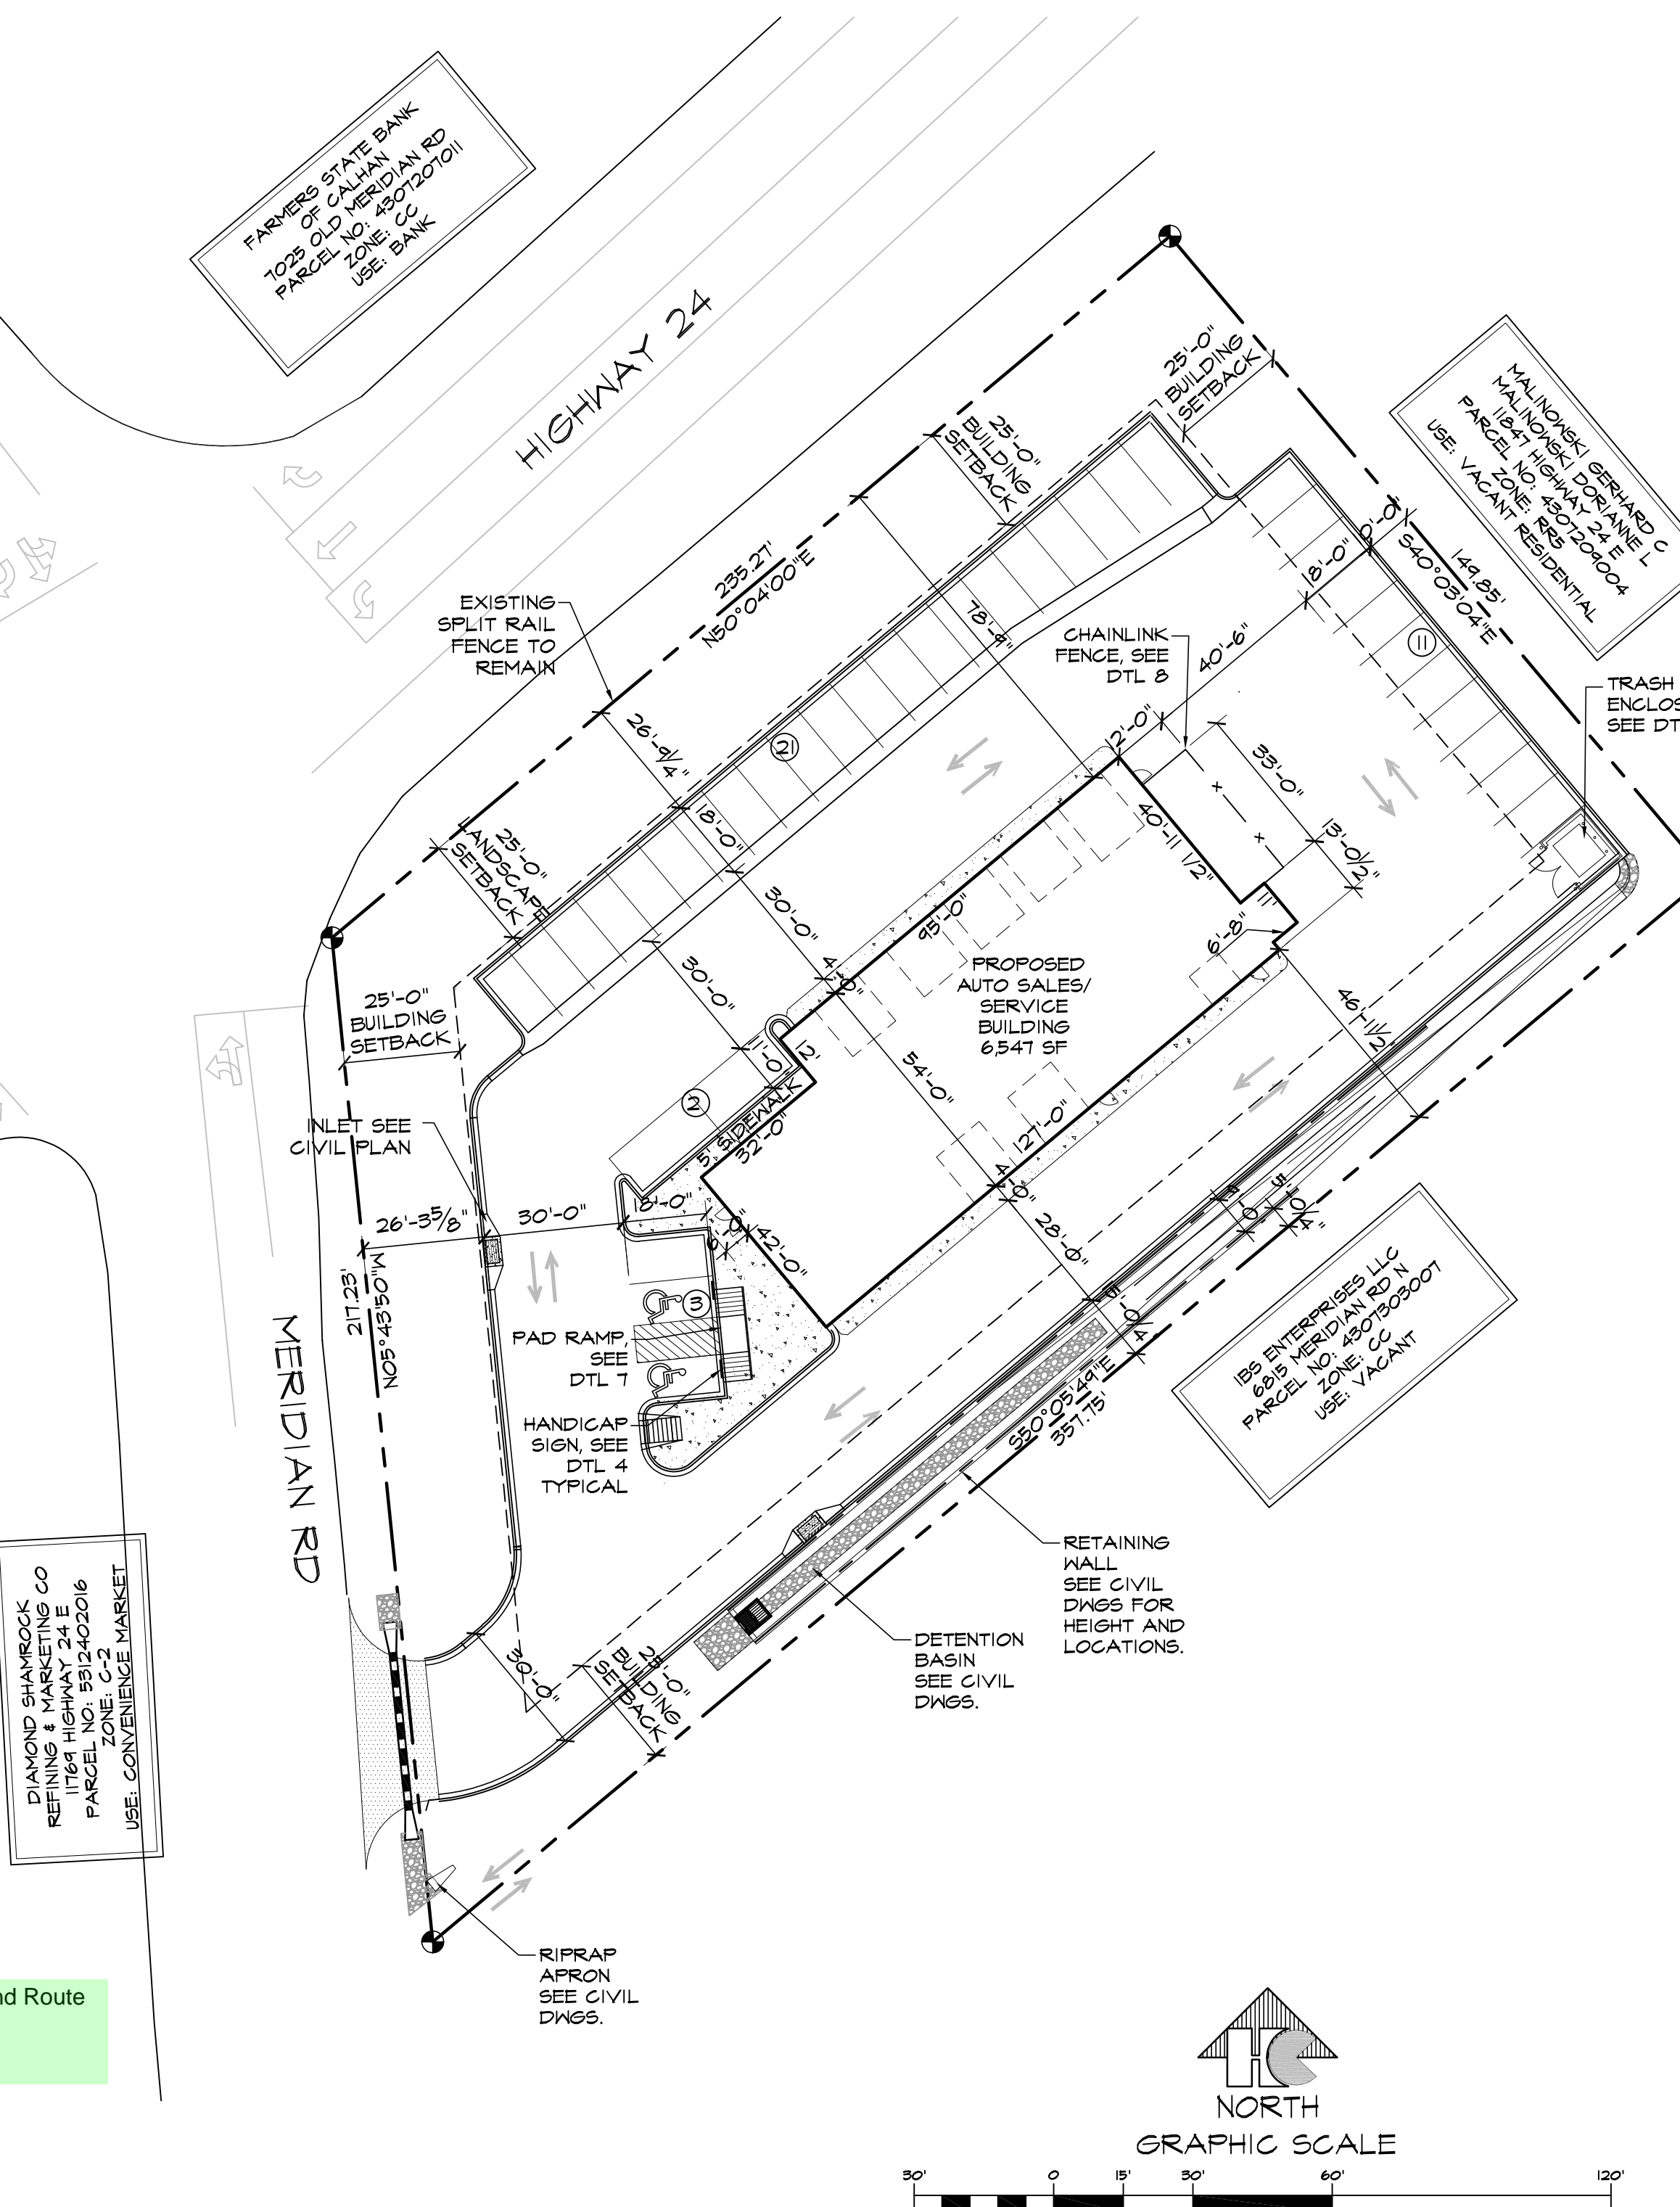
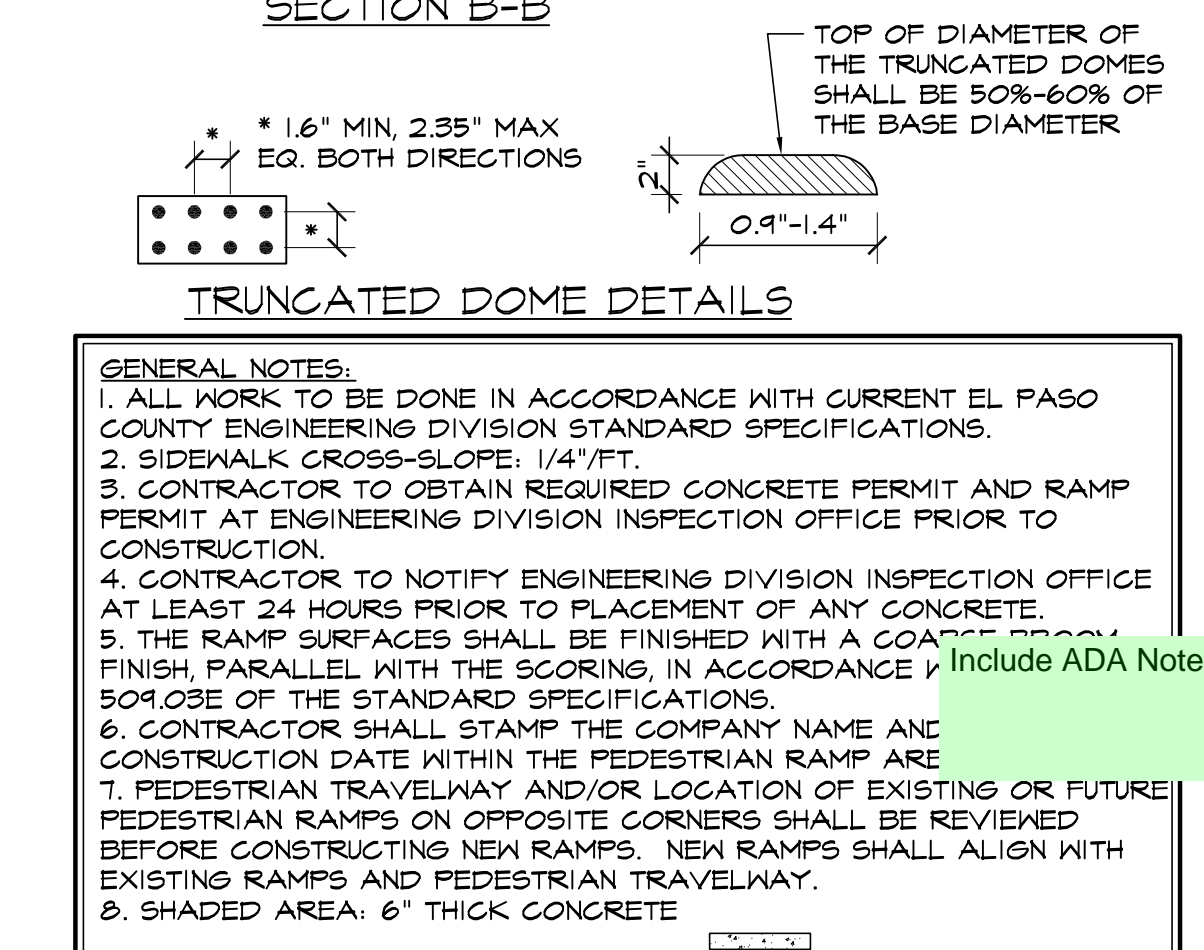
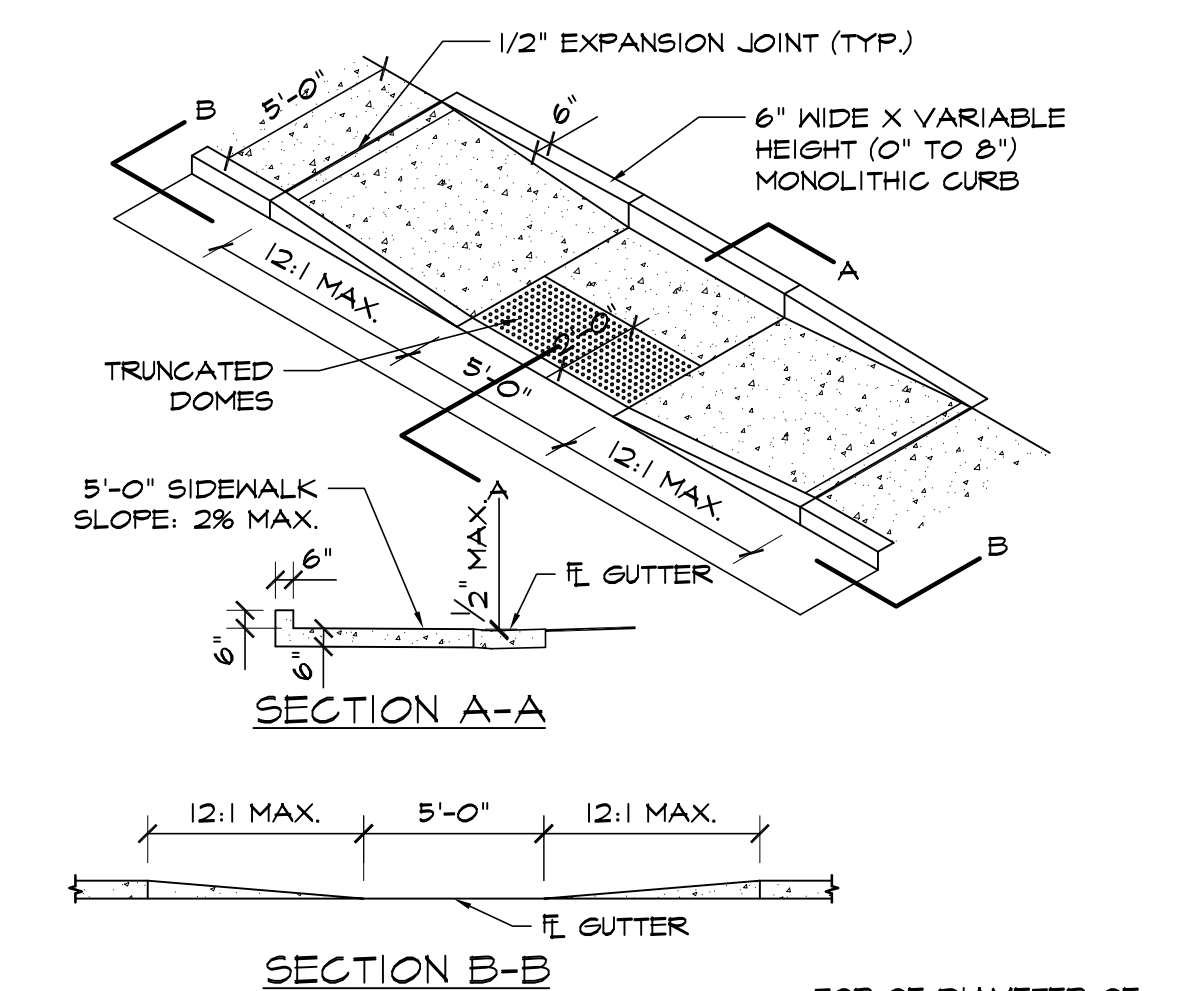
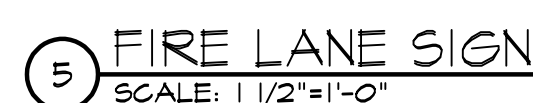
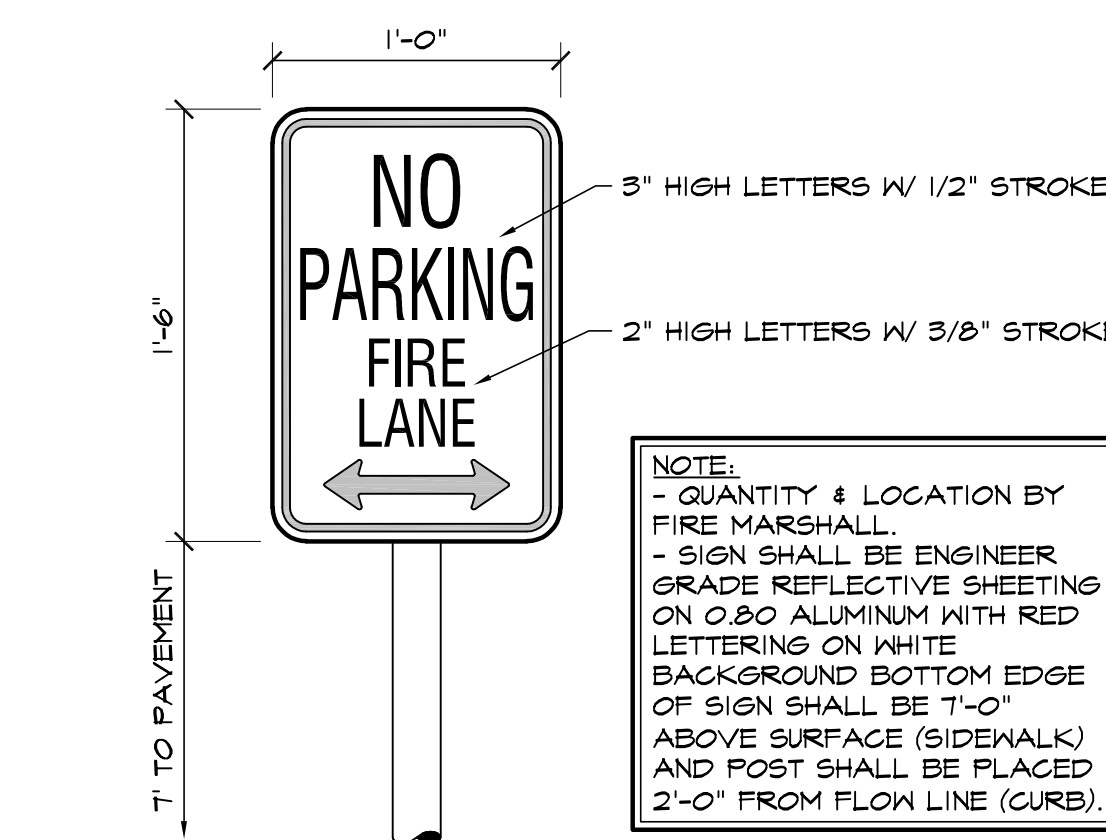
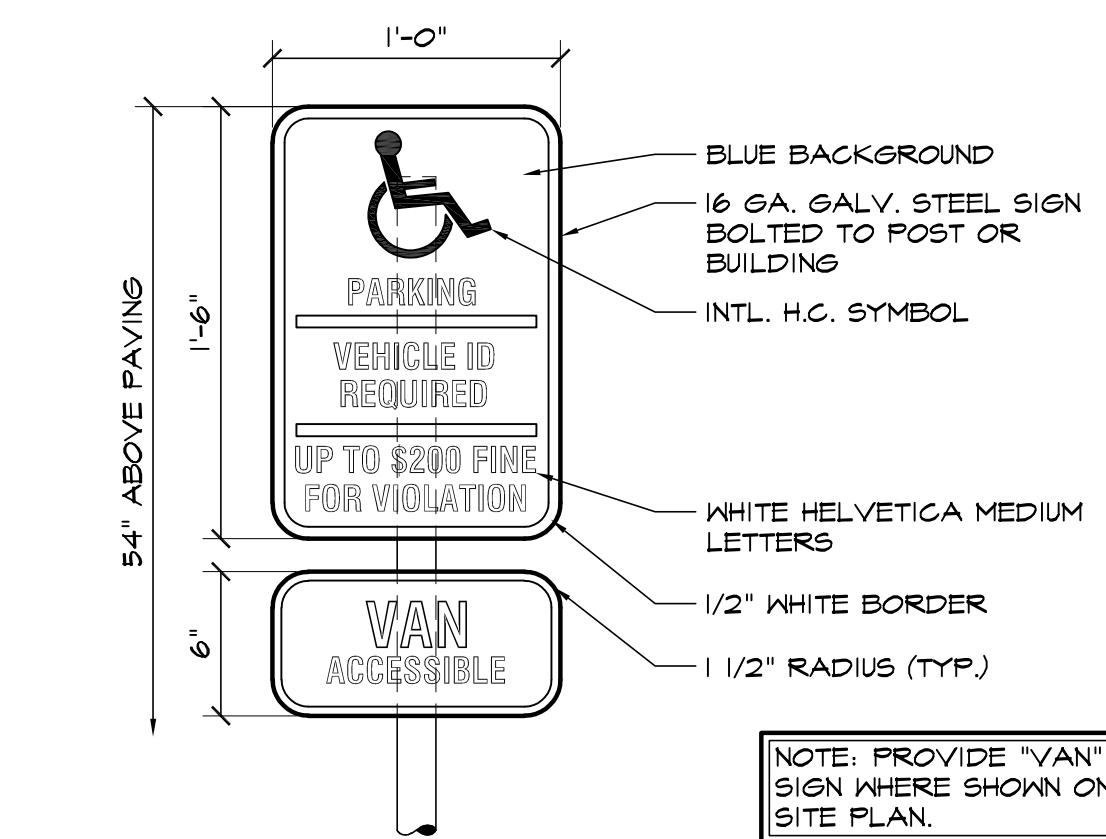


THIS DRAWING CONTAINS MATERIAL & INFORMATION WHICH MAY NOT BE REPRODUCED WITHOUT WRITTEN CONSENT OF HAMMERS CONSTRUCTION, INC. THESE DRAWINGS ARE INTENDED TO BE USED ONLY BY HAMMERS CONSTRUCTION & ITS REPRESENTATIVES. THESE DRAWINGS HAVE NOT BEEN PREPARED FOR ANY OTHER PURPOSE THAN TO INDICATE THE GENERAL FEATURES AND PLACEMENT OF THE PROPOSED PROJECT. COPYRIGHT © 2018 HAMMERS CONSTRUCTION

BIGOTRIES

6985 N. MERIDIAN RD
PEYTON, CO 80831
EL PASO COUNTY, COLORADO

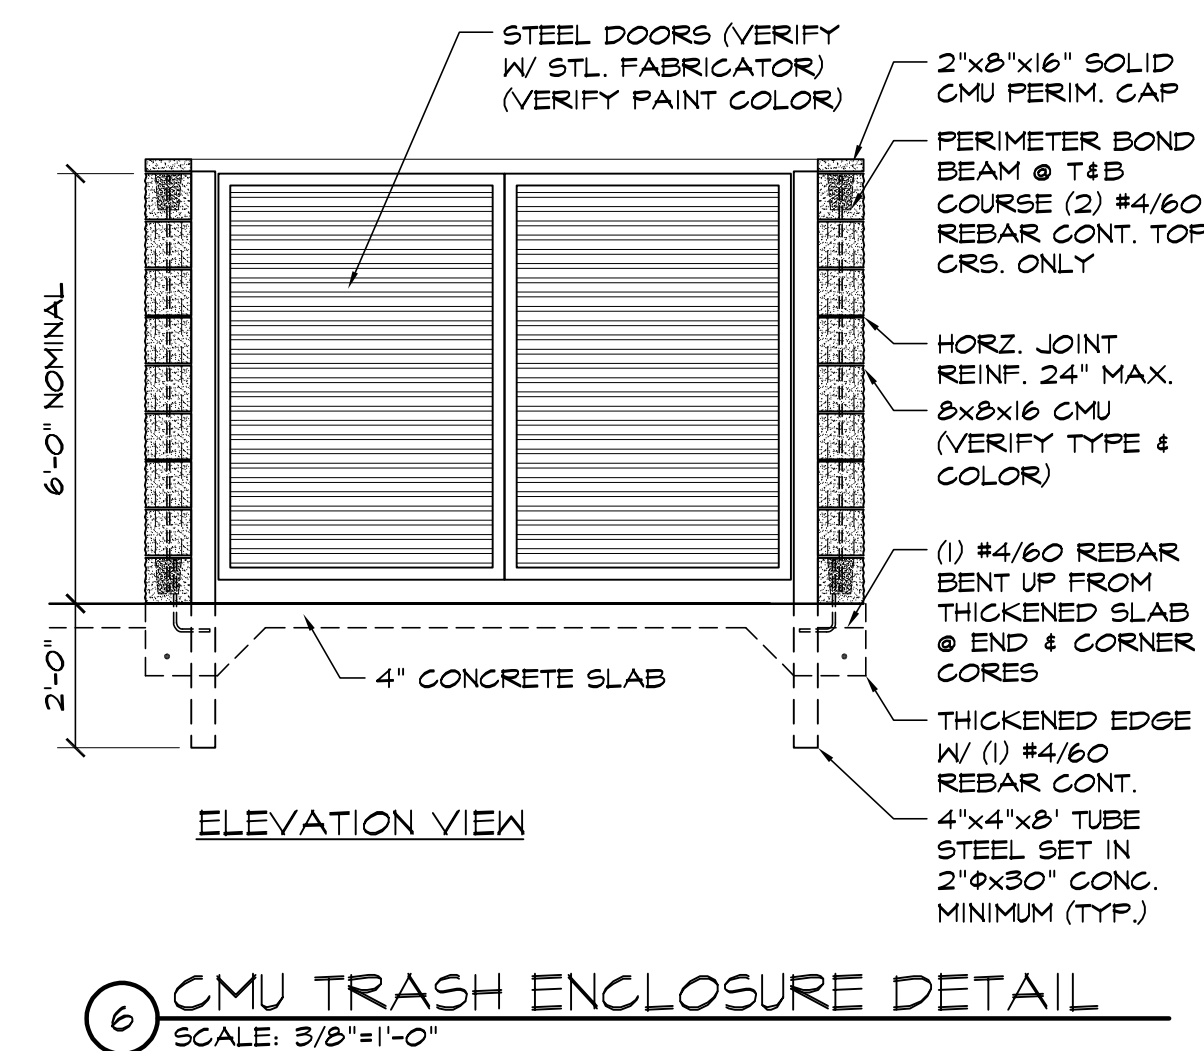

Markup Summary

dsdkendall (3)

1. LAYOUT AND RATING
2. CE PRIOR TO
3. INSPECTION OFFICE
4. CONCRETE
5. COASTAL ZONE
6. CE 1 Include ADA Note and Route
7. AND
8. ARE
9. EXISTING OR FUTURE
10. BE REVIEWED
11. SHALL ALIGN WITH

Subject: Text Box
Page Label: 1
Author: dsdkendall
Date: 8/15/2018 2:24:21 PM
Color: ■

Include ADA Note and Route

1. LAYOUT AND RATING
2. CE PRIOR TO
3. INSPECTION OFFICE
4. CONCRETE
5. COASTAL ZONE
6. CE 1 Include ADA Note and Route
7. AND
8. ARE
9. EXISTING OR FUTURE
10. BE REVIEWED
11. SHALL ALIGN WITH
12. 1/250 SF
13. 26
14. 5
15. 2
16. 2
1