


Include the Sign plan on this submittal item,
not in the application, scan the documents
better, I cannot read them.




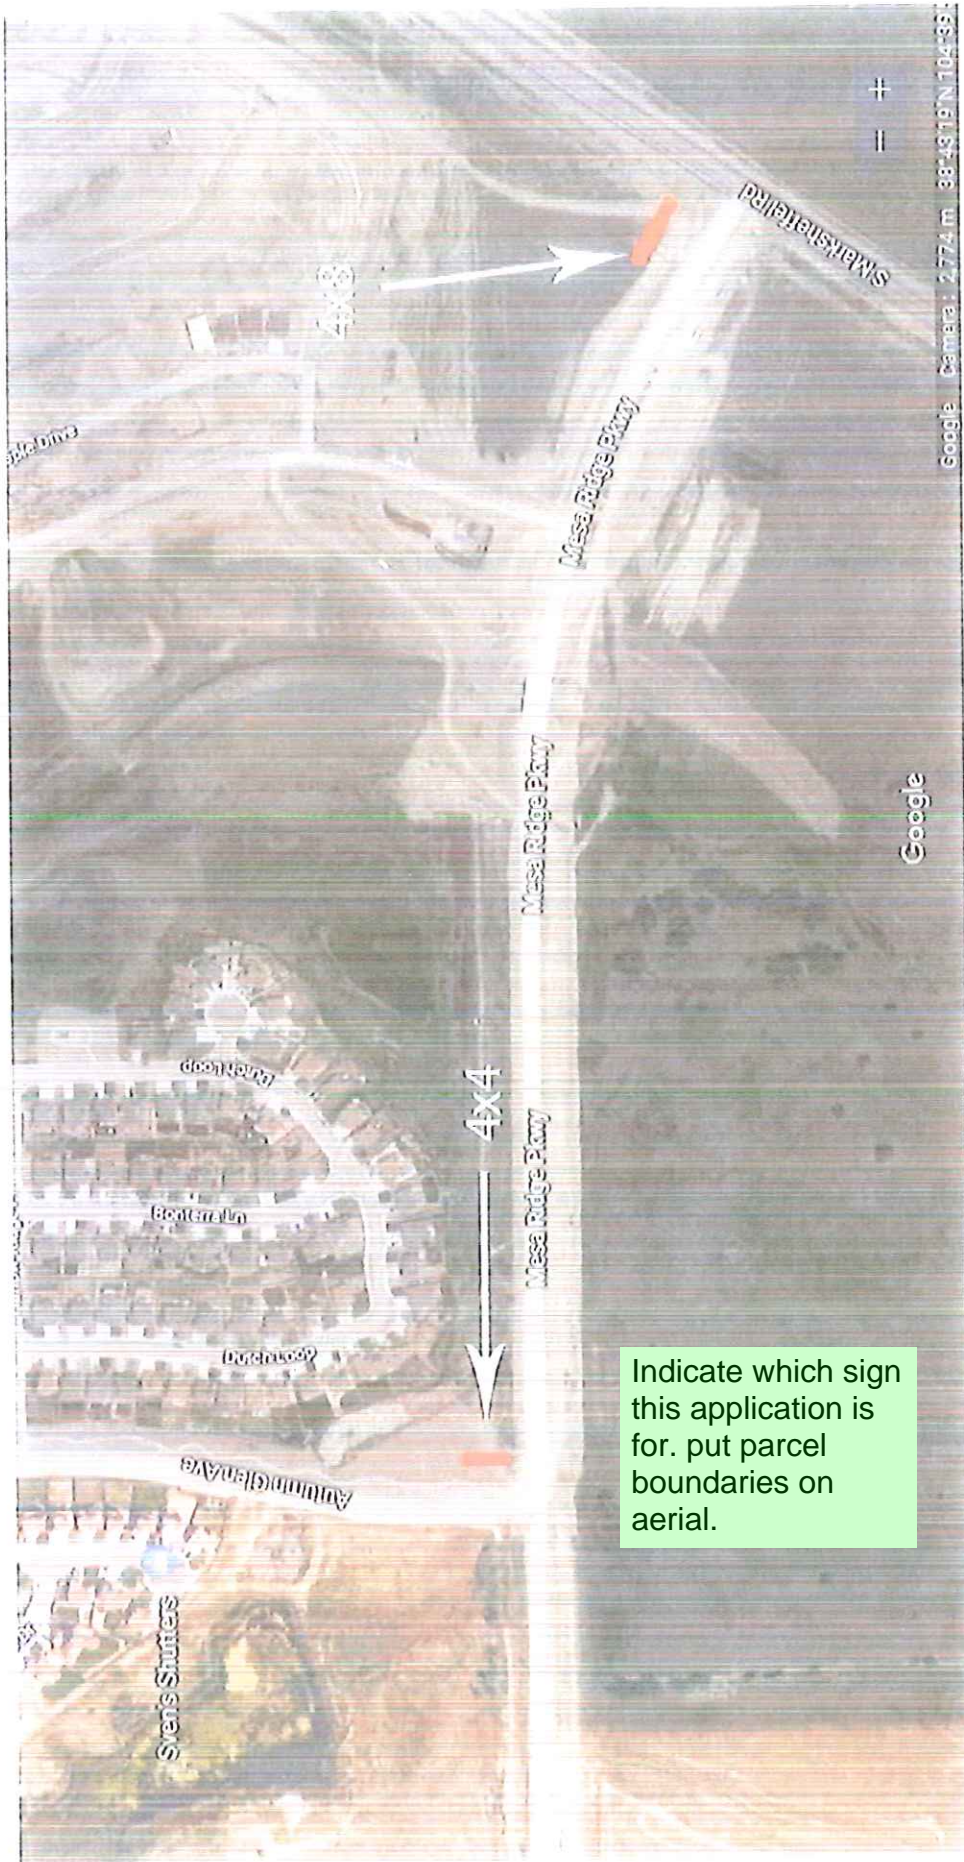

Indicate which sign
this application is
for. put parcel
boundaries on
aerial.


Markup Summary

dsdkendall (2)

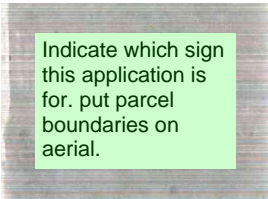

Subject: Text Box
Page Label: 2
Author: dsdkendall
Date: 8/23/2018 1:16:39 PM
Color: ■

Indicate which sign this application is for. put parcel boundaries on aerial.

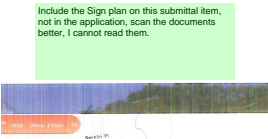

Subject: Text Box
Page Label: 1
Author: dsdkendall
Date: 8/23/2018 1:17:18 PM
Color: ■

Include the Sign plan on this submittal item, not in the application, scan the documents better, I cannot read them.