



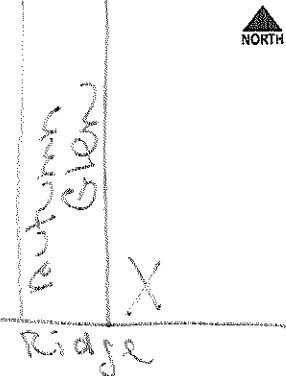

EL PASO COUNTY PLANNING & COMMUNITY DEVELOPMENT
SIGN APPLICATION

DATE: <u>7/30/18</u>	<p><u>Vicinity Map</u> Tax Schedule # <u>5528104033</u> Please show major intersections.</p> 	<p><u>Sign Plan</u> (Please indicate dimensions and sign copy)</p>
<p><u>Business</u> Name: <u>Aspen View Homes</u> Address: <u>555 Middle Creek</u> <u>Bluff St 385</u> Zone: _____ Legal Description: _____</p>	<p><u>Type of Sign</u> Illuminated: _____ Non-Illuminated: <u>X</u> Valuation: _____ Storefront Length &/or Width: _____ Proposed Sign Sq. Ft. <u>4x4</u> Existing Sign Sq. Ft. _____ Total Sign Sq. Ft. _____</p>	
<p><u>Contractor Information</u> Name: <u>Fusion Sign & design</u> Address: <u>4165 Sinton Rd</u> <u>CO Springs, CO 80907</u> Phone: <u>719-302-5144</u> Type of License: <u>BLDG-D5A</u> Contractor ID# <u>19271</u></p>	<p><u>Elevation Drawing</u> Indicate storefront length & placement of sign.</p>	<p><u>For Planning & Community Development Use Only</u> Approved Date: _____ Resubmittal? Yes _____ No _____ Denied Date: _____ Comments: _____</p>

Fee of \$262.00 must accompany this Application. Additional signs at time of first Application are \$125.00. Make checks payable to El Paso County.

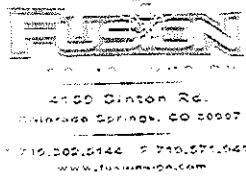

CLIENT
 ASPEN VIEW HOMES
 FILE NAME:
 4X4 Mesa Parkway & Autumn Glen
 DESIGNER:
 LOREN / AARON

PROJECT NAME:
 THE GLEN
 ACCOUNT MANAGER:
 ELISHA
 DATE & REVISIONS:
 04/11/12

APPROVAL (AS IS) ☐ APPROVAL (WITH CHANGES) ☐

WITH SIGNAGE MATERIALS BEING IN DISCREPANCY WITH THE CONCEPTS AND A THREAT TO THE USE OF THE SIGNAGE AND MAY BE SUBJECT TO A CONSENT PLEASE REQUEST COPY OF MATERIALS FROM YOUR DESIGNER IMMEDIATELY. IF THE ORIGINAL LENSES HAVE BEEN LOST OR DAMAGED BY THE USER, THE USER SHALL BE RESPONSIBLE FOR REPLACING THE EXISTING LENSES AT THEIR OWN RISK.

1/26/13 RVSN: ADDED PLANT ON FOR PH and PATRIOT PROGRAMS
 1/24/13 RVSN: -PHONE NUMBER AND ARROW ARE VCO
 1/15/14 RVSN: -SIGNS MOVED FROM MESA RIDGE TO BE RELOCATED
 01/25/18 143234 RVSN: O/O PHONE #
 1/27/17 143120 RVSN: FULL REFACE

I cannot read this, scan better and include in the sign plan item.

ET TO MESA RIDGE & AUTUMN CHASE


SC# 65230

SCALE: 3/4" = 1'

SIGN FACE
 DIGITAL VINYL PRINT
 ON 1/2" MDC

SIGN STRUCTURE
 4X4 WOOD POSTS
 PAINTED WHITE
 GAPPED 1 INCH

RIDER
 DIBOND PLANT ON WITH DVP GRAPHIC

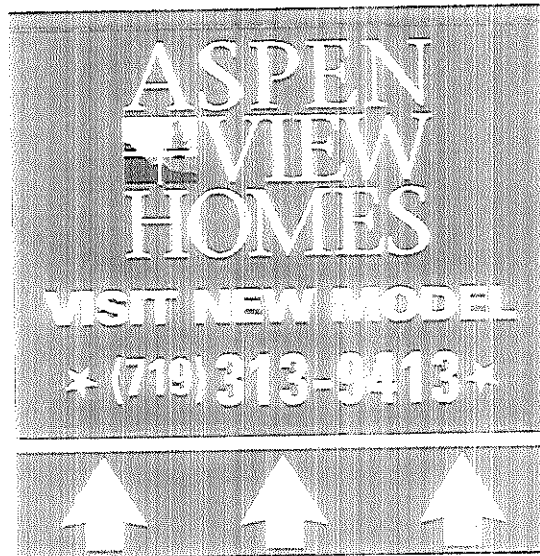

FRONT COPY




BACK COPY

D.O.# 48120 S.O.# 75876
 49469 00000

Markup Summary

dsdkendall (1)

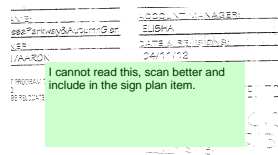

Subject: Text Box
Page Label: 2
Author: dsdkendall
Date: 8/23/2018 1:17:51 PM
Color: ■

I cannot read this, scan better and include in the sign plan item.