



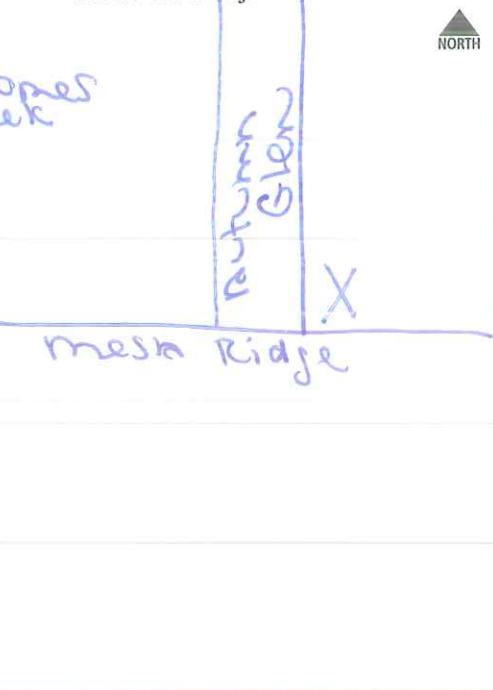

EL PASO COUNTY PLANNING & COMMUNITY DEVELOPMENT
SIGN APPLICATION

DATE: <u>7/30/18</u>	<u>Vicinity Map</u> Tax Schedule # <u>5528104033</u> Please show major intersections.	<u>Sign Plan</u> (Please indicate dimensions and sign copy)
<u>Business</u> Name: <u>Aspen View Homes</u> Address: <u>555 Middle Creek</u> <u>Pkwy, St 385</u> Zone: _____ Legal Description: _____		
<u>Type of Sign</u> Illuminated: _____ Non-Illuminated: <u>X</u> Valuation: _____ Storefront Length &/or Width: _____ Proposed Sign Sq. Ft. <u>4x4</u> Existing Sign Sq. Ft. _____ Total Sign Sq. Ft. <u>16 sq Ft.</u>	<u>Elevation Drawing</u> Indicate storefront length & placement of sign.	<u>For Planning & Community Development Use Only</u> Approved Date: _____ Resubmittal? Yes _____ No _____ Denied Date: _____ Comments: _____
<u>Contractor Information</u> Name: <u>Fusion Sign & design</u> Address: <u>4165 Sinton Rd</u> <u>CO Springs, CO 80907</u> Phone: <u>719-302-5144</u> Type of License: <u>BLDG-DSA</u> Contractor ID# <u>19271</u>		

Fee of \$262.00 must accompany this Application. Additional signs at time of first Application are \$125.00. Make checks payable to El Paso County.

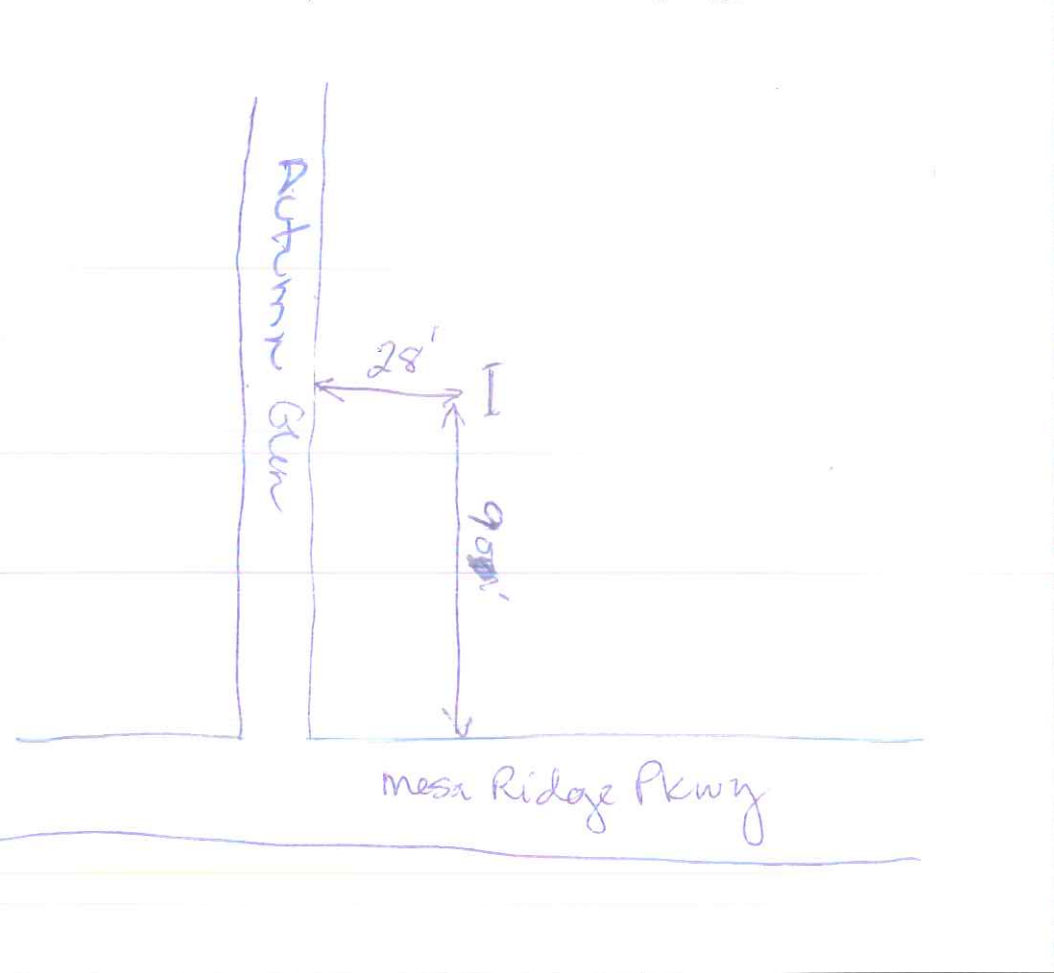

4169 Sinton Rd.
Colorado Springs, CO 80907
T 719.302.5144 F 719.571.9414
www.fusiondesign.com

CLIENT:
ASPEN VIEW HOMES
FILE NAME:
4X4 MesaParkway&AutumnGlen
DESIGNER:
LOREN /AARON

PROJECT NAME:
THE GLEN
ACCOUNT MANAGER:
ELISHA
DATE & REVISIONS:
04/11/12

APPROVAL (AS IS) ☐

APPROVAL (WITH CHANGES) ☐

* COLORS MAY VARY DEPENDING ON DISPLAYS, PRINT-OUTS, ETC. - THEREFORE THIS CONCEPT IS NOT A TRUSTWORTHY SOURCE FOR COLOR ACCURACY. IF COLORS ARE A CONCERN PLEASE REQUEST COLOR OR MATERIAL SAMPLES FROM YOUR FUSION SALES REPRESENTATIVE BEFORE SIGNING. THIS ORIGINAL CONCEPT HAS BEEN DESIGNED BY FUSION SIGN AND DESIGN. REPRODUCTION IN WHOLE OR IN PART REMAINS THE EXCLUSIVE RIGHT OF FUSION SIGN & DESIGN.

7/26/13 RVS: ADDED PLANT ON FOR PH# and PATRIOT PROGRAM COPY
1-14-16 RVS: -PHONE NUMBER AND ARROW ARE VCO
4/15/14 RVS: -SIGNS PULLED FROM MESA RIDGE TO BE RELOCATED AT THE GLEN
10/25/16 | 43264 | RVS: C/O PHONE #
7/27/17 | 48120 | RVS: FULL REFACE
10/5/17 | 49469 | RVS: FULL REFACE

RELOCATED TO MESA RIDGE & AUTUMN CHASE
SO# 85260

SCALE: 3/4" = 1'

SIGN FACE
DIGITAL VINYL PRINT
ON 1/2" MDO


SIGN STRUCTURE
4X4 WOOD POSTS
PAINTED WHITE
DADOED 1 INCH

RIDER
DIBOND PLANT ON WITH DVP GRAPHICS

I cant see the dimensions of this sign, it states 4X4.
Please add and resubmit



FRONT COPY

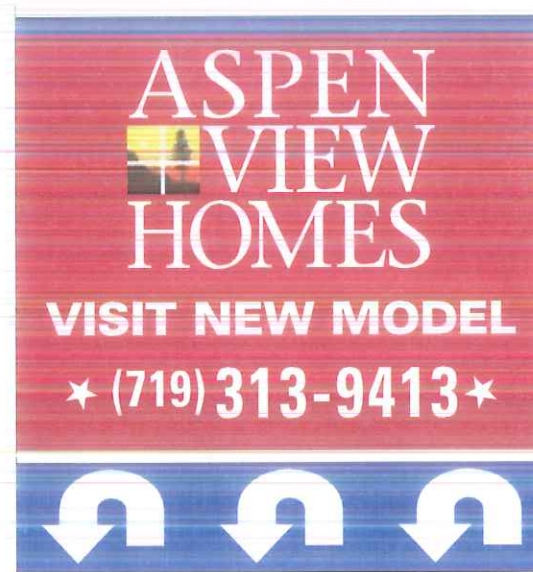

BACK COPY

D.O.#	S.O.#
48120	76876
49469	00000

8620 Mesa Ridge Pkwy





80911

5528000012

5528000025

Mesa Ridge Pkwy

Autumn Glen Ave

Autumn Glen Ave

5528000013

FOUNTAIN

DEPT 7777
08041C0958F

552804033

Section 5528

8620

552804012

5528040137702

7710

552804014

7718

7726

552804015

552800003


DUTCH LOP
77030P

bing

© 2018 Microsoft Corporation © 2018

COUNTY
ORADO

Database Search Zoom to Region Measure Tool Print Aerial Road <<

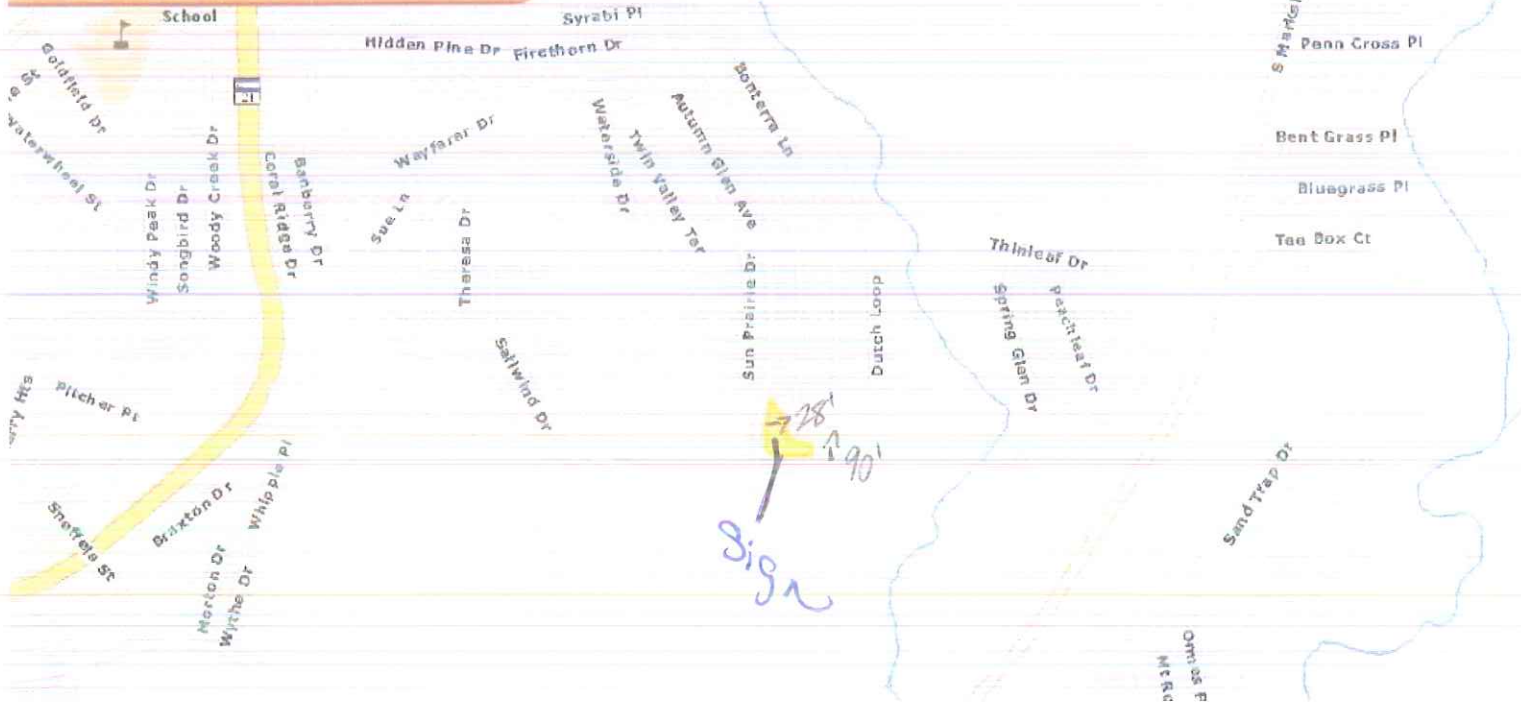

Schedule: 5528104033

Owner:
GLEN METROPOLITAN DISTRICT NO 3
Location:
7777 AUTUMN GLEN AVE

More Info...

Markup Summary

dsdkendall (1)

I cant see the dimensions of this sign, it states 4X4.

Please add and resubmit

Subject: Text Box
Page Label: 2
Author: dsdkendall
Date: 8/31/2018 12:07:08 PM
Color: ■

I cant see the dimensions of this sign, it states 4X4.

Please add and resubmit