


THIS DRAWING IS AN INSTRUMENT OF SERVICE AND IS NOT BEING PREPARED OR EXECUTED BY WILLIAM GUMAN & ASSOCIATES, LTD. UNLESS IT IS PREPARED OR EXECUTED BY OR UNDER THE CLOSE PERSONAL SUPERVISION AND CONTROL OF AN ARCHITECT LICENSED IN THE STATE OF COLORADO. ANY REVISIONS TO THIS DRAWING SHALL BE MADE BY THE ARCHITECT OR UNDER HIS CLOSE PERSONAL SUPERVISION AND CONTROL. ONLY DRAWINGS BEARING THE OFFICIAL SEAL AND SIGNATURE OF THE LICENSED ARCHITECT ARE VALID FOR CONSTRUCTION PURPOSES.

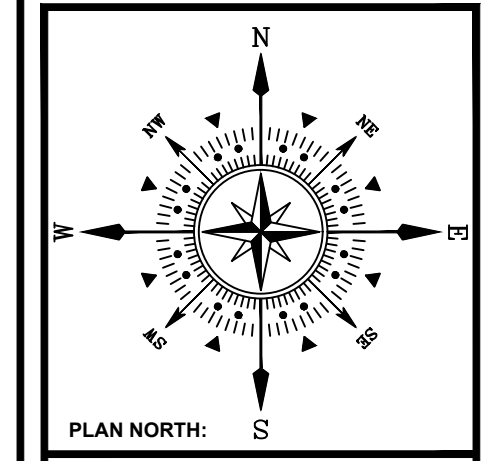

**ESTEBAN RODRIGUEZ SUBDIVISION**  
**JUDGE ORR ROAD**  
**PEYTON, CO 80831**  
 PROJECT NAME:  
 PROJECT ADDRESS:  
 PROJECT DESCRIPTION: 496.25 ACRE SKETCH PLAN

DATE:	08/22/2023
DESIGNED BY:	WFG
CHECKED BY:	GM

REVISIONS:	DATE:	BY:	DESCRIPTION:

# ESTEBAN RODRIGUEZ SUBDIVISION SKETCH PLAN

A PARCEL OF LAND BEING A PORTION OF THE SECTION 2 AND SECTION 11, TOWNSHIP 13 SOUTH, RANGE 64 WEST OF THE 6TH PRINCIPAL MERIDIAN  
 EL PASO COUNTY, COLORADO

**A. SUBDIVIDERS**  
 OWNER  
 Brent Houser Enterprises, LLC  
 11890 Garrett Road  
 Peyton, CO 80831-7685  
 TSN 430000534, 430000537, 430000538

**B. APPLICANT**  
 APPLICANT (PLANNER) LANDSCAPE ARCHITECT  
 William Guman & Associates, Ltd.  
 Attn: Bill Guman, PLA, ASLA, APA  
 731 North Weber Street, Suite 10  
 Colorado Springs, CO 80903  
 bill@guman.net

ENVIRONMENTAL  
 Ecosystem Services, LLC  
 Attn: Grant Gurnee, PWS  
 1455 Washburn Street  
 Erie, CO 80516  
 grant@ecologicalbenefits.com


TRANSPORTATION  
 LSC Transportation Consultants, Inc.  
 Attn: Jeff Hodson, PE  
 2504 E. Pikes Peak Ave., Suite 304  
 Colorado Springs, CO 80909  
 jeff@lsc-trans.com

WATER UTILITIES  
 RESPEC JDS-Hydro  
 Attn: Douglas E. Schwenke  
 5540 Tech Center Drive, Suite 100  
 Colorado Springs, CO 80919  
 Douglas.Schwenke@respec.com

**C. LEGAL DESCRIPTION**  
 A PARCEL OF LAND BEING A PORTION OF THE SECTION 2 AND SECTION 11, TOWNSHIP 13 SOUTH, RANGE 64 WEST OF THE 6TH PRINCIPAL MERIDIAN, COUNTY OF EL PASO, STATE OF COLORADO, BEING MORE PARTICULARLY DESCRIBED AS FOLLOWS:

**D. BASIS OF BEARINGS**  
 THE NORTH LINE OF THE NORTHWEST QUARTER OF SECTION 2, TOWNSHIP 13 SOUTH, RANGE 64 WEST OF THE 6TH PRINCIPAL MERIDIAN, BEING MONUMENTED AT THE WEST END BY A 3.25" ALUMINUM CAP STAMPED "LS 17496 1992" IN A RANGE BOX AND AT THE EAST END BY A 2" ALUMINUM CAP STAMPED "PLS 11624" IN A RANGE BOX, ASSUMED TO BEAR N89°53'34"E.  
 BEGINNING AT THE NORTHWEST CORNER OF SECTION 2, TOWNSHIP 13 SOUTH, RANGE 64 WEST OF THE 6TH PRINCIPAL MERIDIAN;  
 THENCE ON THE NORTH LINE OF THE NORTHWEST QUARTER OF SAID SECTION 2, N89°53'34"E A DISTANCE OF 2,622.41 FEET, TO THE NORTH QUARTER OF SAID SECTION;  
 THENCE ON THE EAST LINE OF THE WEST HALF OF SAID SECTION 2, S00°40'17"E A DISTANCE OF 3,885.66 FEET, TO A POINT OF CURVE;  
 THENCE ON THE ARC OF A CURVE TO THE LEFT, HAVING A RADIUS OF 1,000.00 FEET, A CENTRAL ANGLE OF 56°44'42" AND AN ARC LENGTH OF 990.39 FEET, TO A POINT OF TANGENT;  
 THENCE S57°24'59"E A DISTANCE OF 1,845.86 FEET, TO A POINT OF CURVE;  
 THENCE ON THE ARC OF A CURVE TO THE RIGHT, HAVING A RADIUS OF 1,200.00 FEET, A CENTRAL ANGLE OF 56°44'42" AND AN ARC LENGTH OF 1,186.08 FEET, TO A POINT ON THE SOUTH LINE OF THE NORTH HALF OF SECTION 11, TOWNSHIP 13 SOUTH, RANGE 64 WEST OF THE 6TH PRINCIPAL MERIDIAN;  
 THENCE ON SAID SOUTH LINE, S89°05'27"W A DISTANCE OF 2,560.17 FEET;  
 THENCE CONTINUING ON SAID SOUTH LINE, S89°01'18"W A DISTANCE OF 2,618.87 FEET, TO THE WEST LINE OF THE NORTHWEST QUARTER OF SAID SECTION 11;  
 THENCE CONTINUING ON SAID SOUTH LINE, S89°01'18"W A DISTANCE OF 2,618.87 FEET, TO THE WEST LINE OF THE NORTHWEST QUARTER OF SAID SECTION 11;  
 THENCE ON SAID WEST LINE, N00°19'54"E A DISTANCE OF 1,320.51 FEET, TO THE NORTHWEST CORNER OF SAID SECTION 11;  
 THENCE ON THE WEST LINE OF SAID SECTION 2, N00°42'27"W A DISTANCE OF 5,465.28 FEET, TO THE POINT OF BEGINNING.  
 CONTAINING A CALCULATED AREA OF 21,484,637 SQUARE FEET OF 493.2194 ACRES.

- E. NOTES**
1. Acreages and percentages are rounded up to equal 100%.
  2. All areas designated as wetlands and drainageways, buffers, setbacks, and easements are considered as "No-Build Areas" unless otherwise indicated.
  3. A portion of the parcels is located within a designated FEMA Floodplain as determined by the FEMA National Flood Insurance Program Flood Insurance Map Numbers 08041C0556G and 08041C0552G with an effective date of December 7, 2018. Existing floodplain boundaries may be modified. Coordination with FEMA will be completed to establish revised floodplain limits and BFE. If the submittal and review of a floodplain revision occurs independently of this Sketch Plan and shall be approved prior to platting of any lots currently located within floodplain boundaries.
  4. The proposed Sketch Plan is located within the Peyton Fire Protection District.
  5. After approval, this Sketch Plan will expire in 5 years unless a Final Plat is submitted.
  6. Streets and access locations and configurations are conceptual and subject to change. Detailed street plans will be prepared and reviewed at the subdivision process.
  7. Access locations onto Judge Orr Road will be finalized at the Preliminary Plan or Development Plan level of submittal.
  8. Trails are conceptual only. Detailed trail plans will be prepared and reviewed at the subdivision process.
  9. El Paso County Regional Trails along Judge Orr Road are to be coordinated with El Paso County Parks and Recreation at the Preliminary Plan or Development Plan level of submittal, and a Neighborhood Park will be further refined in future zoning and development plan submittals.
  10. A floodplain development permit is required prior to making any modifications within the indicated 100-year floodplain, including but not limited to grading, drainage, and all roadway crossings.
  11. A completed U.S. Army Corps of Engineers (COE) permit shall be provided to the El Paso County Planning Department prior to project commencement if ground disturbing activities are scheduled to occur in any wetland area.
  12. The wetland boundaries as indicated on the Sketch Plan are conceptual and subject to change. All existing wetland areas are to be mapped per the U.S. Army Corps of Engineers during future zoning and development plan submittals.
  13. In the event the project will create ground disturbing activity in habitat occupied by threatened or endangered species, and/or where development may occur within 300 feet of the centerline of any stream or floodplain, whichever is greater, the applicant will obtain documentation from U.S. Fish and Wildlife Service (FWS) prior to proceeding with the project.
  14. Information pertaining to wildlife protection measures will be provided by the applicant including fencing requirements, trash and debris containment, protection and enhancement of natural vegetation, weed control and riparian and wetland protection and buffer areas, as appropriate with future zoning and development plan submittals.
  15. Development proposed by this Sketch Plan is primarily larger lot single-family residential compatible with that of adjacent Rural Residential (RR) zone districts. 62% of proposed lots will adhere to zoning and development criteria for RR-2.5 and 23% for RR-5.0 zone districts within the overall 493.21 acre development.
  16. Approximately 18.83 acres with frontages along Judge Orr Road are proposed for commercial services and will be compatible with the zoning and development criteria of the county's CS zone district.
  17. Utilities for all proposed development will be via on-site well and septic as supported by the Water Resources Report submitted with the Sketch Plan application.
  18. Phasing limits for all proposed development are indicated on this Sketch Plan. Phasing will be implemented based upon prevailing market conditions and is subject to change.

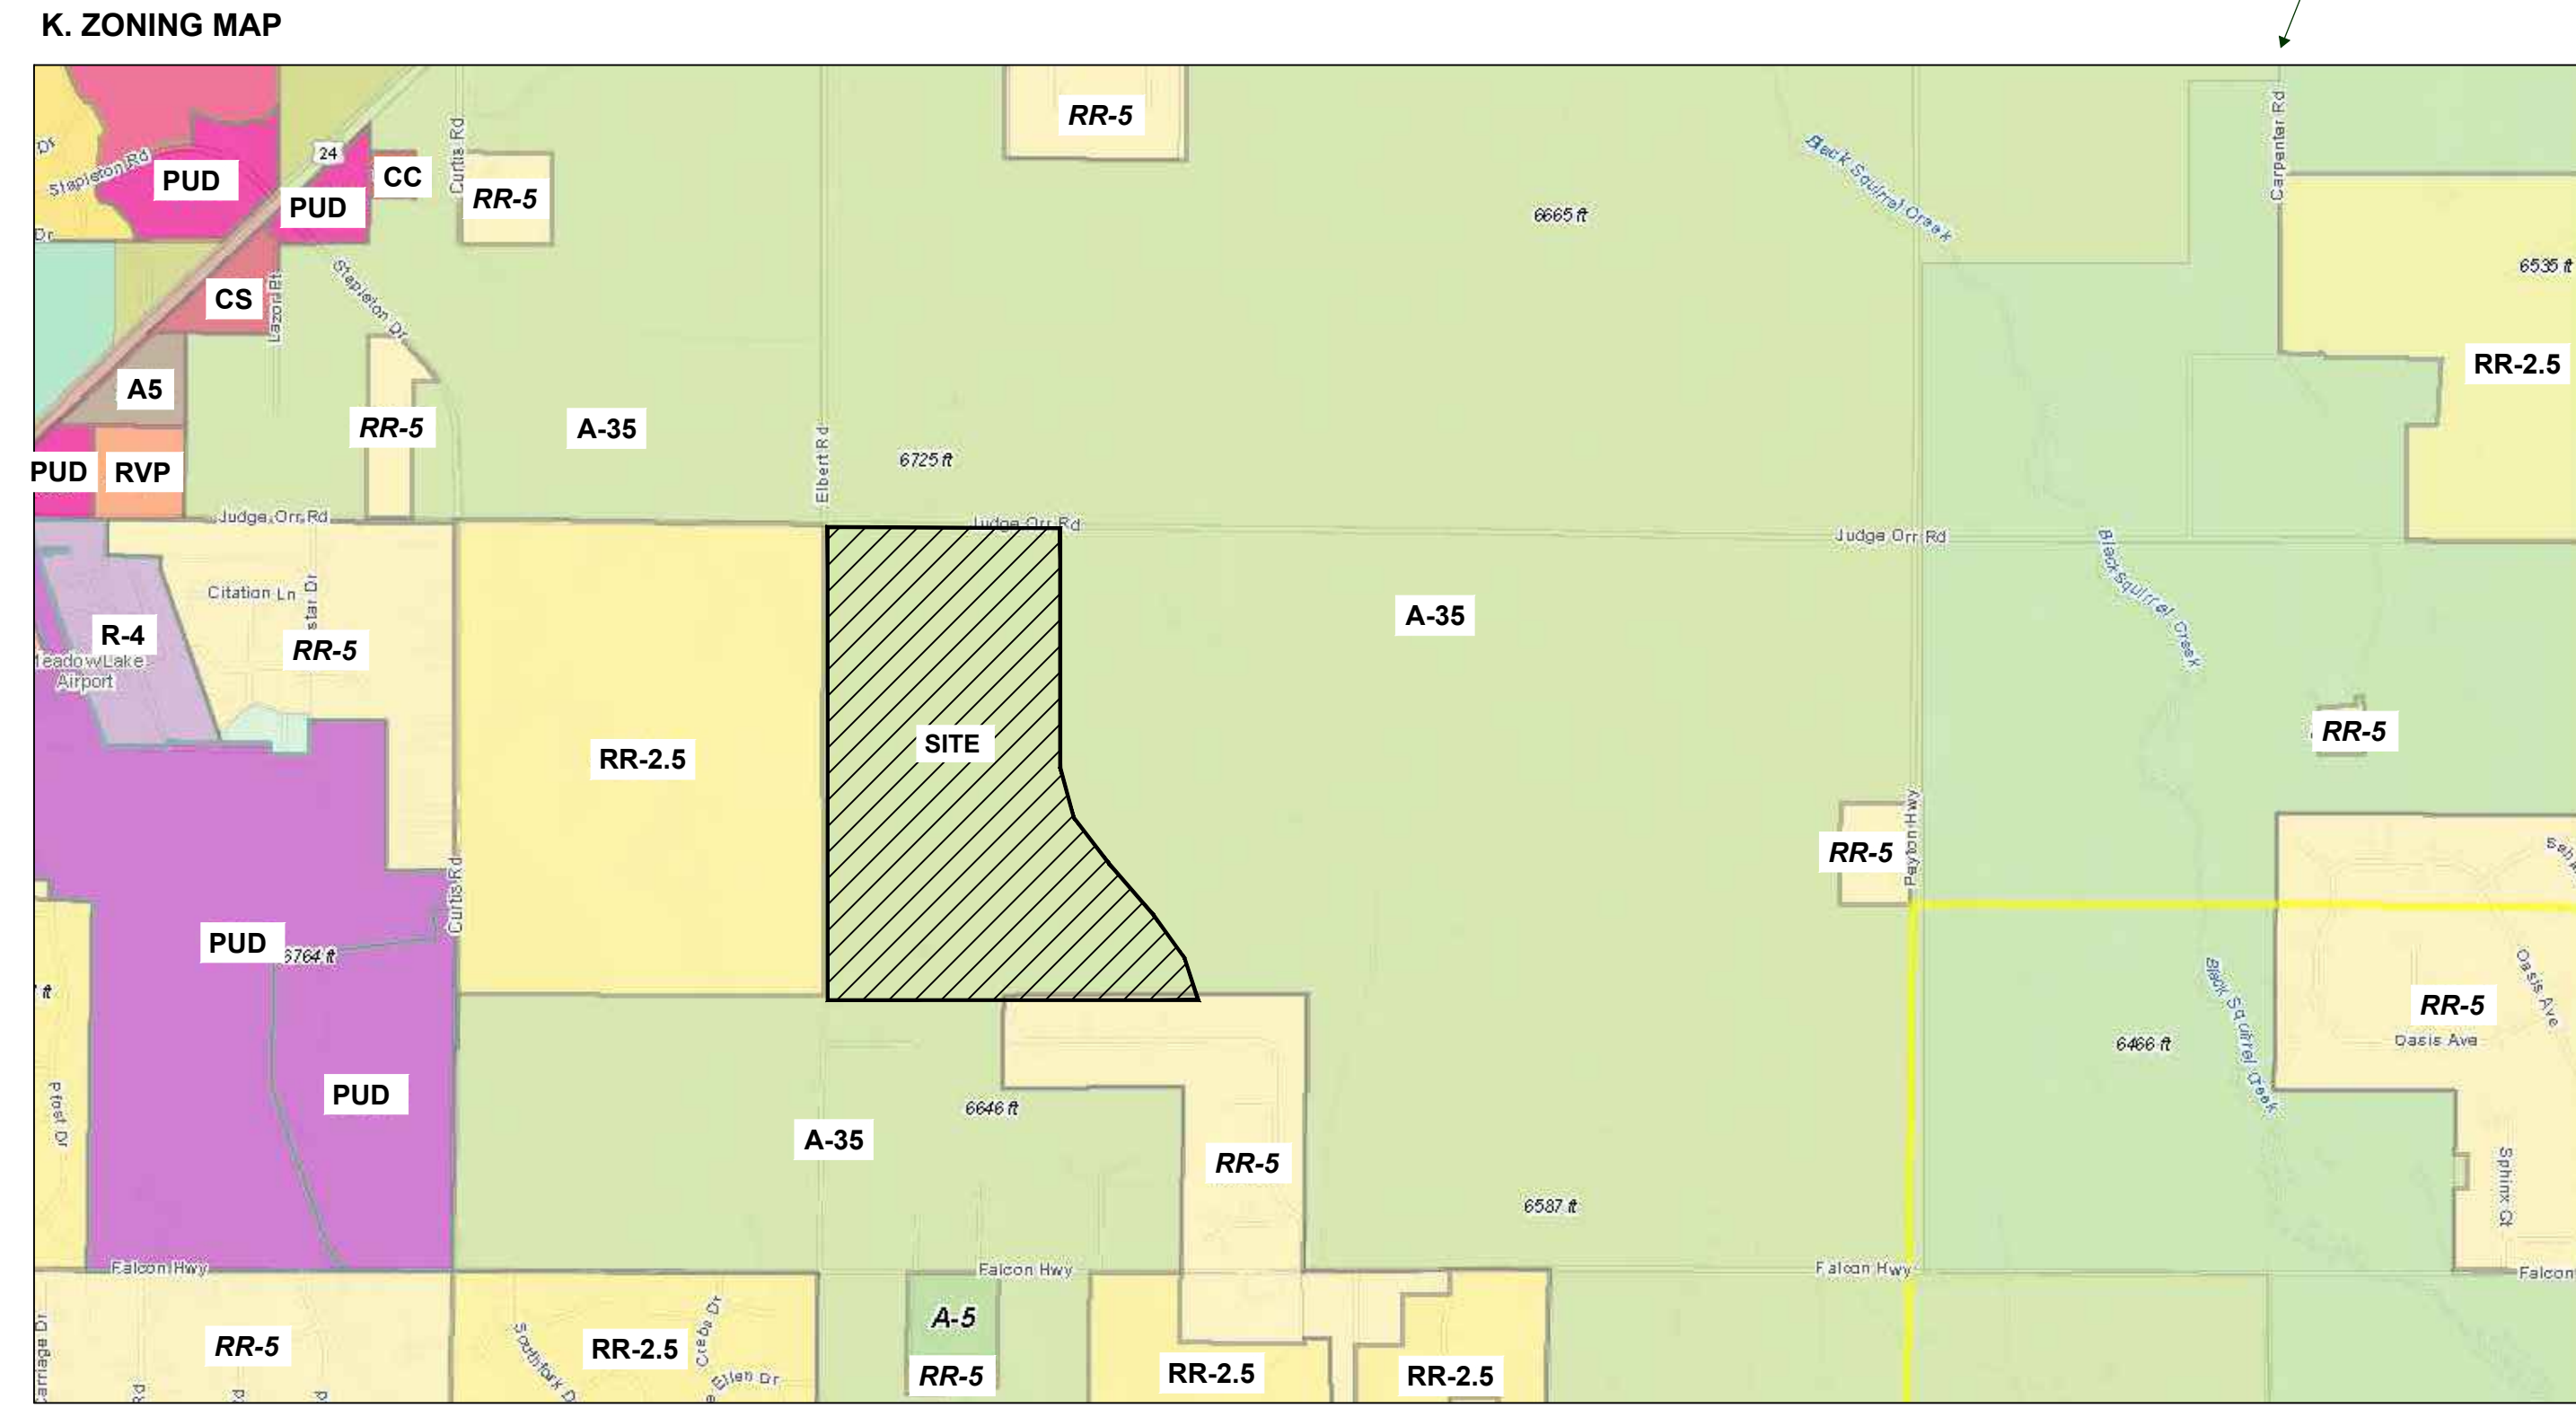

- E. NOTES CONT'D.**
19. Detention ponds and cross-lot drainage ditches will be located or HOA.
  20. Open spaces, Neighborhood Park, and other amenities to be maintained by the Rodriguez Metropolitan District or HOA.
  21. There will be no direct lot access permitted onto Judge Orr Road.
  22. A Noise Study will be required for commercial properties act as that may be required for buffer between residential properties and Judge Orr Rd.
  23. Park improvements provided by the owner may be applied to park Land Dedication and/or fees with review and approval by El Paso County Parks. Any park improvements will be coordinated at a later date with El Paso County Parks via Park Land Credits.
  24. The Sketch Plan proposes to provide fees in lieu of land for future school development. The project site is located entirely within the Peyton School District No. 23.
  25. All electric service is to be provided by Mountain View Electric Association (MVEA). Black Hills Energy and natural gas easements will be provided as required.
  26. Site lighting, if required, will satisfy the requirements of Section 6.2.3 of the El Paso County Land Development Code.
  27. The Rodriguez subdivision will comply with all Federal and State laws, regulations, ordinances, review and permit requirements, and other agency requirements, if any, of applicable agencies including but not limited to: the Colorado Division of Parks and Wildlife, Colorado Department of Transportation, U.S. Army Corps of Engineers, and the U.S. Fish and Wildlife Service regarding the Endangered Species Act particularly as it relates to all listed species.
  28. The following Districts will serve the Rodriguez property:
    - a. Rodriguez Metropolitan District or HOA (to be established) for maintenance of any/all common spaces, detention ponds, and drainage easements.
    - b. Peyton School District No. 23
    - c. Peyton Fire Protection District (Fire emergency).
    - d. Peyton Fire Protection District (Emergency services).
    - e. El Paso County Conservation District.
    - f. Pikes Peak Library District.
    - g. El Paso County Roads and Bridges.
    - h. Upper Black Squirrel Creek Ground Water.
  29. Mail box kiosk locations and design will be determined at time of Final Plat in coordination with the U.S. Postal Service.
  30. Perimeter buffers along existing adjacent zoning of A-35 shall be 20 feet where noted on the Sketch Plan. All other buffers to adjacent zoning will be 15 feet as noted on the Sketch Plan.
- F. FLOODPLAIN NOTES**
1. Portions of the Rodriguez property are bisected by and located within a designated FEMA Floodplain as determined by the FEMA National Flood Insurance Program Flood Insurance Map, numbers 08041C0558G, 08041C0559G, 08041C0566G, 08041C0567G with an effective date of December 7, 2018. The existing floodplain boundaries may be revised and/or the Base Floodplain Elevation (BFE) may be modified. Coordination with FEMA will be completed to establish revised floodplain limits and BFE. If the submittal and review of a floodplain revision occurs independently of this Sketch Plan and shall be approved prior to the platting of any lots currently located within floodplain boundaries.
  2. No development of homes, barns, ancillary structures, or fences will be permitted in areas of lots encroaching into any floodplain.


- G. PUBLIC STREETS**
1. Internal streets will meet the standards of the El Paso County Engineering Criteria Manual. A deviation request and/or modification of the ECM will be submitted for review and approval for any design that does not conform with these standards.
  2. All internal streets are designated as public, will be paved, and will provide for levels of vehicular circulation required by the Traffic Impact Study.
  3. Until approved by the County Engineer, all access points shown from the property onto Judge Orr Road are conceptual and non-binding upon the county. Approval of this Sketch Plan shall not be interpreted to include approval of any access to any existing public roads. The County Engineer shall approve accesses in accordance with the requirements and procedures of the Engineering Criteria Manual at the time of Development Plan and/or subdivision submittal and review.

- H. PRIVATE STREETS**
1. If proposed, any private streets will be privately owned and maintained by the Rodriguez Metropolitan District or Homeowner's Association (HOA).
  2. A waiver of the EPC Land Development Code will be requested to permit private roadways within this Sketch Plan at the time of future subsequent Development Plan submittals.

- I. NO-BUILD / OPEN SPACE / RESIDENTIAL LOT OPEN SPACE EASEMENTS**
1. Per Section 4.2.6.F.8.c. Calculation of Residential Open Space of the El Paso County Land Development Code: "Individual, private residential or commercial lot areas shall not be included on the open space calculation unless the open space areas located on private lots are subject to open space easements and restrictions." easements? clarify this note
  2. The "Floodplain - No Build / OS" tracts, into which some residential lots will encroach, are included in the Sketch Plan calculations as "Private Open Space" areas. Lots that encroach into the "Floodplain - No Build / OS" tracts will be platted as open space easements in future zoning and development submittals. These areas shall remain Private Open Space in perpetuity with no construction of primary and ancillary structures, sheds, barns, fences, etc., permitted within any no-build area.
  3. The Sketch Plan proposes a combination of Public and Private Open Space. Public Open Space will include a Public Park, Detention Pond parcels, and 8' Trail Easements located within certain buffer areas to provide connectivity to Private open space easements and Public open space areas.
  4. Public Open Space areas will be maintained by the Rodriguez Metropolitan District or HOA. Private Open Spaces will be maintained by the owner on whose lot Open Space easements may be located.
  5. See Sketch Plan Sheet 1.3 for acreage and tract data for all Public and Private Open Spaces.

- J. SOILS AND GEOLOGIC HAZARDS**
1. Areas of proposed development that are found to be impacted by ground water, imported fill, loose and/or expansive soils, etc., will be mitigated by avoidance, re-grading, engineering design, and construction techniques. A map of any potential hazard areas of concern and recommended mitigation measures are found in the Geological Hazard Study and Wastewater Study prepared by RMG Engineers and Architects (April 27, 2023). Further studies of these conditions that warrant additional mitigation will be provided with the Preliminary Plan or Final Plat.


- K. PHASING PLAN**
1. The Rodriguez Subdivision will be developed in multiple phases and platted in multiple filings. This Sketch Plan initially proposes three phases of development as indicated on Sketch Plan Sheet SKP1.3, and is subject to change. Subsequent phasing plans will be developed based upon prevailing market conditions and absorption of developed lots.
  2. Preliminary phasing boundaries as indicated on the Sketch Plan are subject to change. Proposed development and build-out of internal streets, park and open space, and installation of utilities will be determined with each phase.

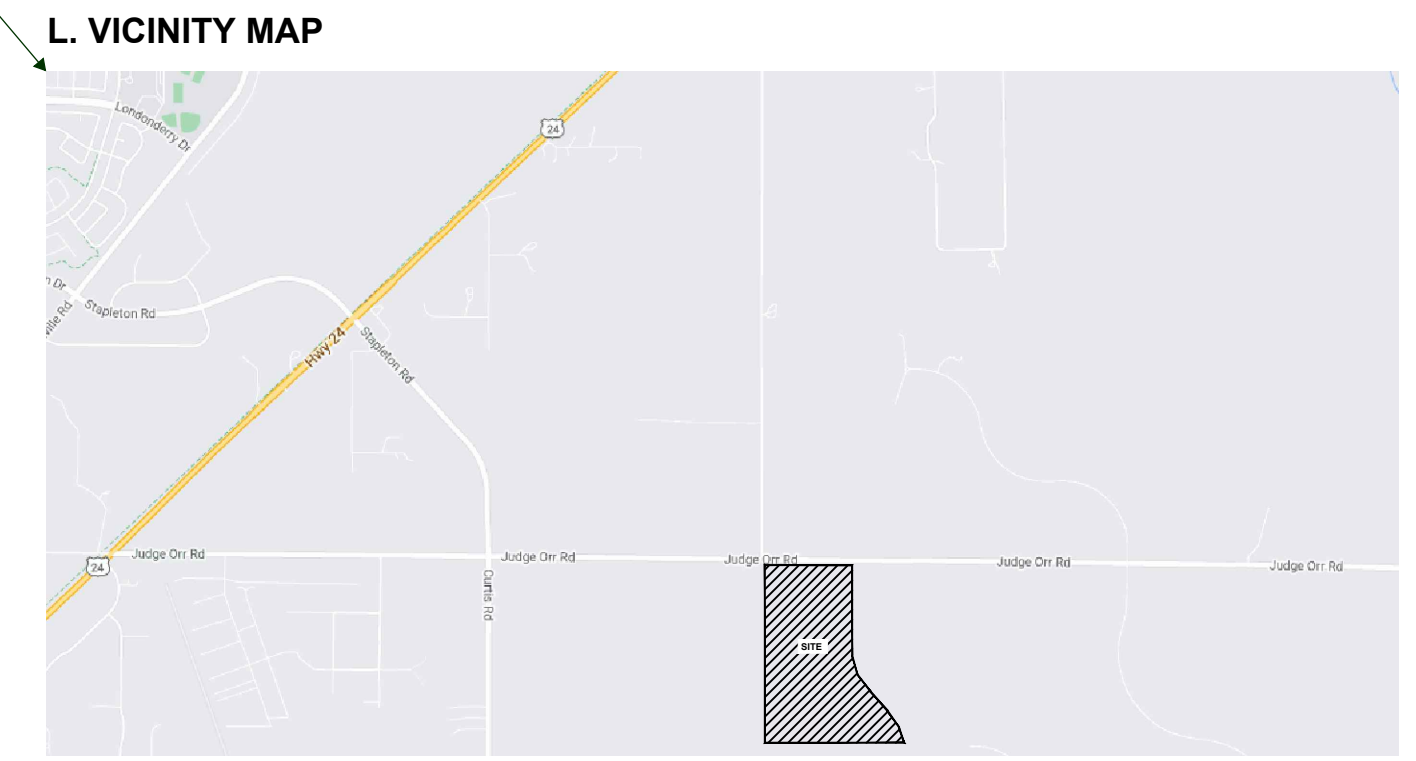


**M. SITE DATA**

Existing Land Use:	Agricultural
Existing Zone District:	A-35
Site Acreage:	24.07 AC (Judge Orr Road)
TSN 430000534	136.98 AC (Judge Orr Road)
TSN 430000537	332.16 AC (Judge Orr Road)
TSN 430000538	493.21 AC
Total Acreage:	493.21 AC
Proposed Land Uses:	Residential [ 2.5 and 5.0 acre single family] Commercial [18.83 ac] Park/Open Space [20.29 ac including detention]
Proposed Maximum Number of Units:	144 Single Family
Maximum Gross Density:	.29 DU/AC

**N. STREET DETAILS**  
 Future Local Roads

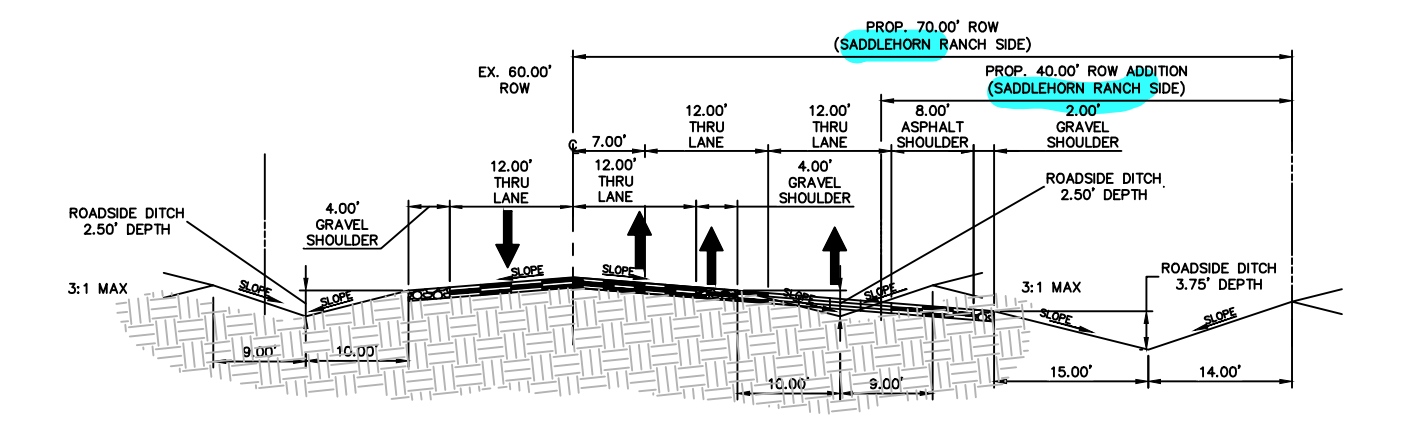

1. Existing Judge Orr Road - Typical Section  
 POSTED SPEED LIMIT = 45 MPH. DESIGN SPEED LIMIT = 50 MPH.  
 NOTE: ULTIMATE SECTION HAS BEEN OVERLAYED.

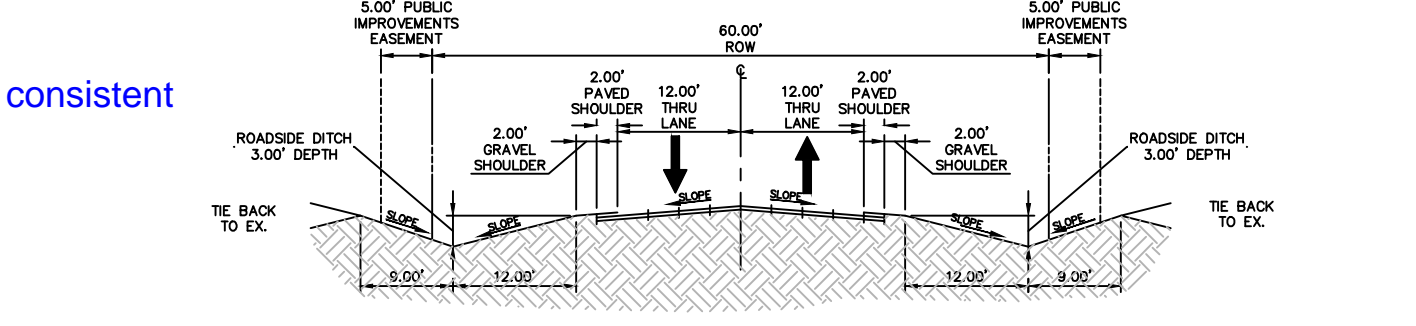

2. Proposed Rural Local - Typical Section  
 POSTED SPEED LIMIT = 30 MPH. DESIGN SPEED LIMIT = 30 MPH.

- O. TRANSMISSION EASEMENT**
1. The Sketch Plan indicates a Transmission Easement is located along the property's western boundary. The owner [Grantor] executed an Option for Transmission Easement Agreement with Mountain View Electric Association (MVEA) [Grantee] on June 14, 2014 (copy of Agreement is submitted with this application). The Agreement has not been recorded by Grantor or Grantee as of this date and therefore "legally" does not exist.
  2. The Transmission Easement is 150' but based upon the Grantee's legal description the actual easement width varies. The graphic representation indicated on the Plan is accurate per the legal description.
  3. The Owner and Applicant will resolve the recordation of the Transmission Easement at a future level of zoning and development plan submittal.

- P. SHEET INDEX**
- SKP 1.1 Subdividers/Applicant | Legal Description | Notes, Zoning Map | Vicinity Map | Site Data | Internal Street Detail
- SKP 1.2 Sketch Plan | Land Use Summary Table | Parcel Summary Table | Adjacent Owners
- SKP 1.3 Parcel/Open Space/Trails/Phasing Plan | Open Space and Trails Schedule | Open Space Tract Schedule | Trail Head Detail | Phasing Schedule

Please include the appropriate notes to memorialize the Meadow Lake Airport comments; appropriate easements will be needed at subsequent stages; however, acknowledgements that future plats will be required to carry over the airport-related notes should be included on this plan.

Actual North

SCALE: 1" = 300' - 0"

Sketch plan is part of subdivision process. Recommend to record this note to state subsequent subdivision applications.

This should be reworded to state at Preliminary Plan stage

This is fine - however, some of the documentation provided discusses annexing into a proposed BOCES metro district.

Delete duplicate of Floodplain note

You can combine this into Note 7.

Should be at Preliminary Plan

We talked about CC vs. CS in the EA meeting. Either revise this to CC, or keep it at CS and I will create a new rezone file for you.

This note appears to be incomplete.

This note is a duplicate of Section I, Note 4

This section only applies to PUD zoning and would not be applicable to this project unless PUD is proposed.

Similar question here regarding potential BOCES district?

by EPC and FEMA

delete

These notes appear inconsistent

Revise all notes about roads to be consistent

Not sure what this means. I would recommend removing references to "private open space"







