


MAP NOTES

1. THE EXISTING TOPOGRAPHY SHOWN ON THIS PLAN WAS PREPARED AND PROVIDED BY CLARK LAND SURVEYING INC.
2. ALL EXISTING UNDERGROUND UTILITIES SHOWN ON THIS MAP ARE FROM UTILITY MAIN RECORD MAPS AND UTILITY SERVICE LOCATION MAPS. THE LOCATION OF UTILITIES AS SHOWN ARE APPROXIMATE. ALL UTILITIES MAY NOT BE SHOWN OR MAY NOT HAVE BEEN LOCATED. BELOW GROUND UTILITY LOCATIONS WERE NOT PERFORMED.



1. TYPOGRAPHY TO BE HELVETICA MEDIUM
2. ALL PRIMARY SIGNS TO BE MOUNTED ON METAL SIGN POST; 7'-0" ABOVE FINISH GRADE TO BOTTOM OF SIGN-TYP. ADDITIONAL PLACARD SIGNS SHALL BE MOUNTED AT LEAST 6'-0" ABOVE FINISH GRADE TO BOTTOM OF SIGN-TYP.
3. MOUNT TO HANDICAP SIGNAGE ON BUILDING.

SITE SIGNAGE LEGEND
SCALE 1" = 1'

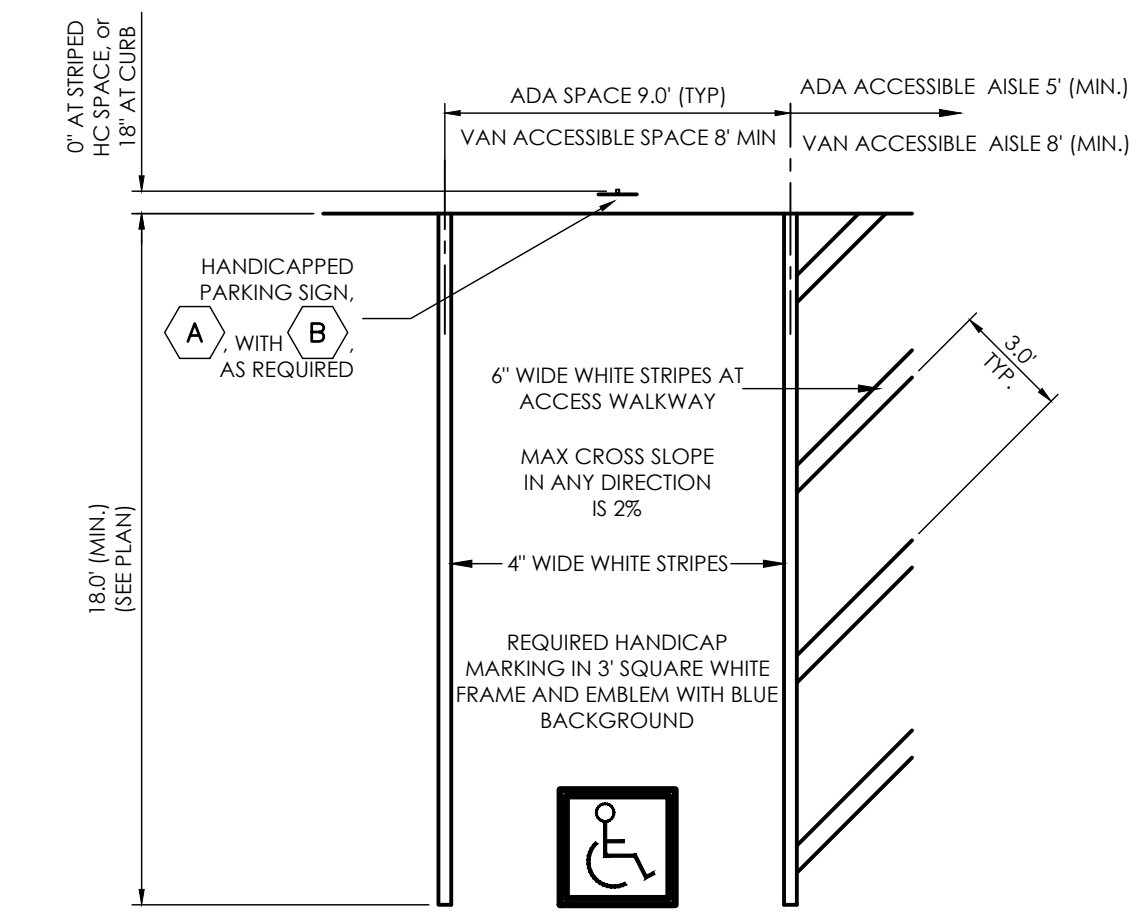


TYPICAL HANDICAP PARKING SPACE
SCALE 1" = 5'


- RAIN GARDEN, SPECIFICATIONS, NOTES & REFERENCES:**
REFERENCE URBAN DRAINAGE AND FLOOD CONTROL DISTRICT (UDFCD), URBAN STORM DRAINAGE CRITERIA MANUAL, VOLUME 3, SECTION T-3. FOR FULL SET OF RAIN GARDEN DETAILS AND SPECIFICATIONS AS IDENTIFIED.
- **GROWING MEDIA** (BY WEIGHT, USE 3-5% ORGANIC MATERIAL; 95-97% GROWING MEDIA SAND)
 - ORGANIC MATERIAL - LOOSELY PACKED, SHREDED MULCH - AGED 6 MONTHS (MIN.)
 - GROWING MEDIA SAND - PER SOIL MATERIAL GRADATION TABLE (ASTM C-33 SAND STANDARD)
 - pH - 6.8-7.5
 - NITROGEN - 15 ppm (MAX)
 - PHOSPHORUS - 15 ppm (MAX)
 - SALINITY - 6 mmhos/cm (MAX)
 - **VEGETATION** - SELECT PLANTS THAT ARE DROUGHT RESISTANT AND THRIVE IN SANDY SOIL.
- OPTIONAL: USE NATIVE SEED MIX PER RAIN GARDEN SEED MIX TABLE. AGGRESSIVE WEED CONTROL PROCEDURES WILL HELP THE DESIRED VEGETATION TO BECOME ESTABLISHED.
- **CONCENTRATED INFLOW** - PER CONCENTRATED INFLOW DETAIL.

SITE PLAN SPECIFIC NOTES


1. INSTALL 43 LF 12" HDPE PIPE W/ FES @ 1.16% FES INV IN = 74.5' FES INV OUT = 74.0'
 2. INSTALL GRASS SWALE. SEE DETAIL ON THIS SHEET.
 3. INSTALL RAIN GARDEN. SEE DETAIL ON THIS SHEET.
 4. INSTALL RIP-RAP SPILLWAY. SEE DETAIL ON THIS SHEET.
 5. INSTALL 4" CDOT CLASS 5 OR 4 AGGREGATE BASE COURSE, MIN L HYVE MOISTURE TREATED TO WITHIN 2% OPTIMUM MOISTURE CONTENT AND 95% (±3%) MAX DRY DENSITY - MOD. PROCTOR (ASTM D1557/AASHTO M294)
 6. INSTALL TYPE VL RIP-RAP LEVEL SPREADER. (SEE DETAIL)
 7. INSTALL RIP-RAP. SEE CONCENTRATED IN-FLOW DETAIL.
 8. INSTALL CONCRETE SIDEWALK 4" THICK (SEE DETAIL ON THIS SHEET)
 9. INSTALL CONCRETE PARKING STOP BLOCKS
 10. INSTALL CONCRETE PARKING AREA 4" THICK (SEE DETAIL ON THIS SHEET)
 11. INSTALL RAIN GARDEN FILTER MEDIA
- A HANDICAP PARKING SIGN (SEE DETAILS ON THIS SHEET)
B HANDICAP VAN PARKING SIGN (SEE DETAILS ON THIS SHEET)

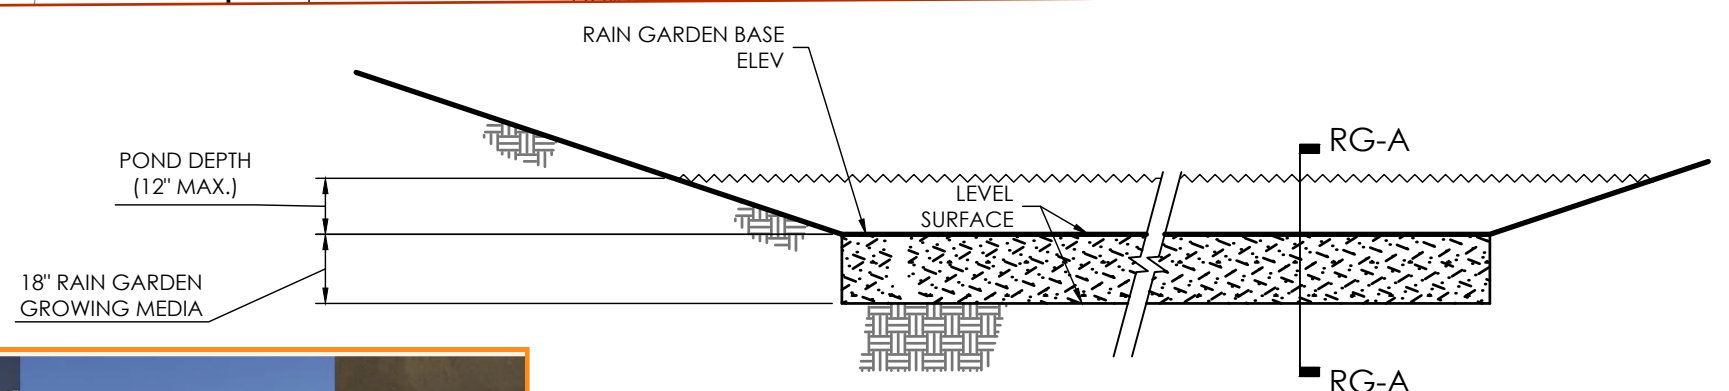


PHASE I RAIN GARDEN DETAIL
SCALE: NTS

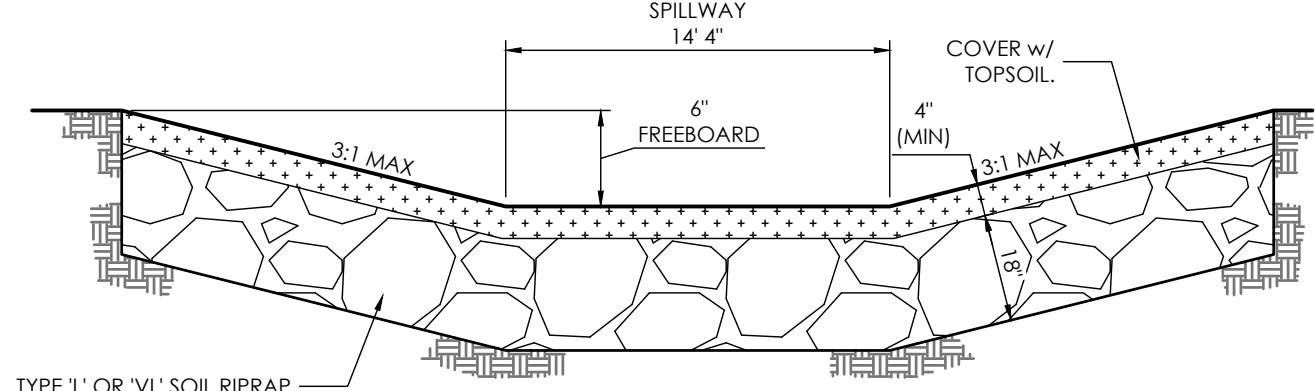

SPILLWAY DETAIL
SCALE: NTS

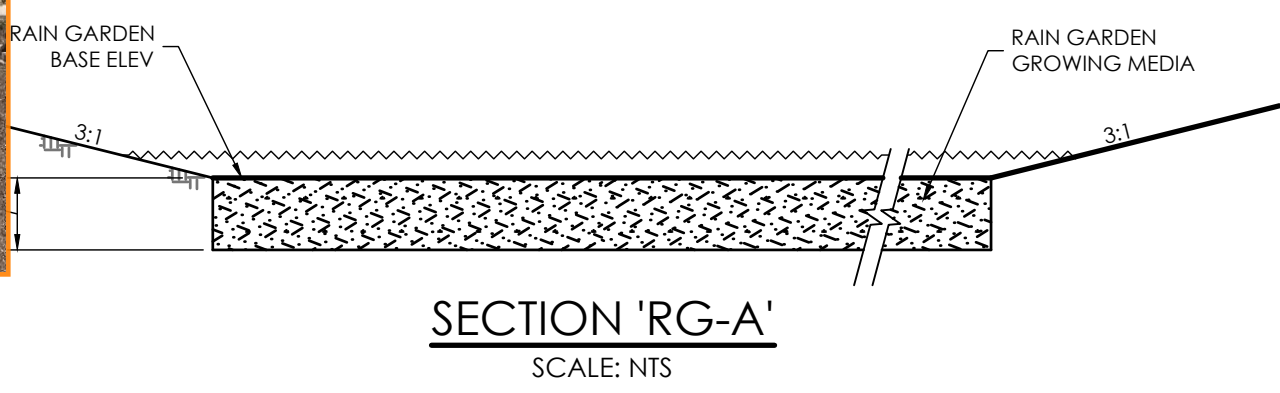

SECTION 'RG-A'
SCALE: NTS

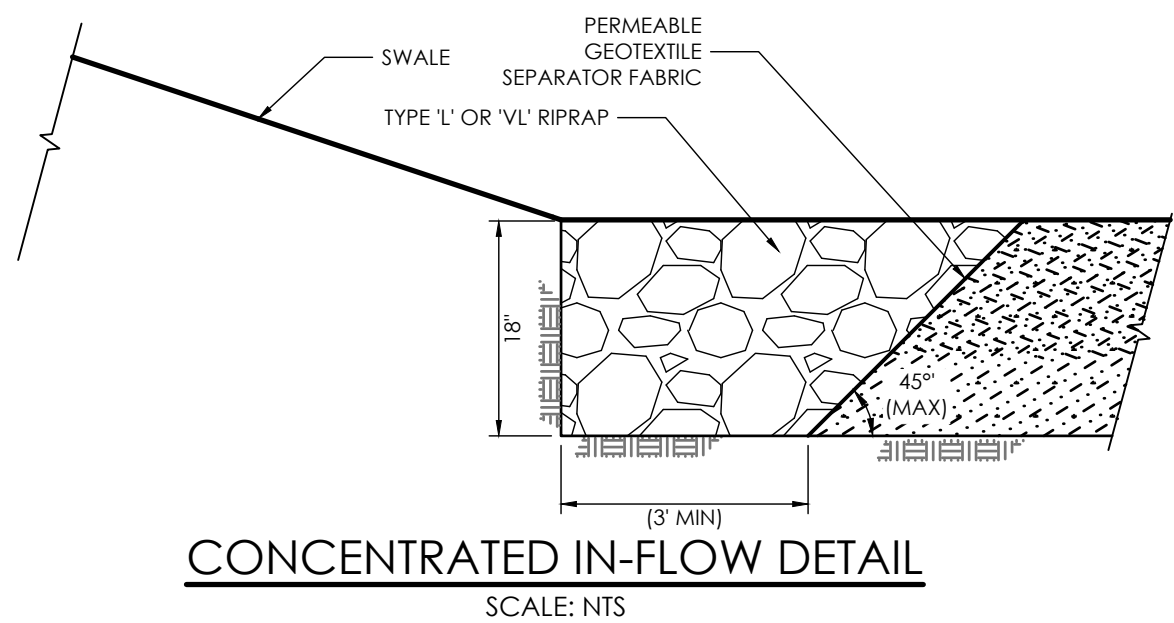


CONCENTRATED IN-FLOW DETAIL
SCALE: NTS

STANDARD SIEVE SIZE	% PASSING
3/8" (9.5 mm)	100
NO. 4 (4.75 mm)	95 - 100
NO. 8 (2.36 mm)	80 - 100
NO. 16 (1.18 mm)	50 - 85
NO. 30 (600 um)	25 - 60
NO. 50 (300 um)	10 - 30
NO. 100 (150 um)	2 - 10

LESS THAN 1.5% ORGANIC MATERIAL

COMMON NAME	LB/AC PLS ²
SAND BLUESTEM	3.5
SIDE-OATS GRAMA	3
PRAIRIE SANDREED	3
INDIAN RICEGRASS	3
SWITCHGRASS	4
WESTERN WHEATGRASS	3
LITTLE BLUESTEM	3
ALKALISACATON	3
SAND DROPSEED	3
TOTAL	27.5


SEE UDFCD TABLE B-3 FOR SCIENTIFIC NAMES AND WILDFLOWER MIX OPTION
*PLS = PURE LIVE SEED

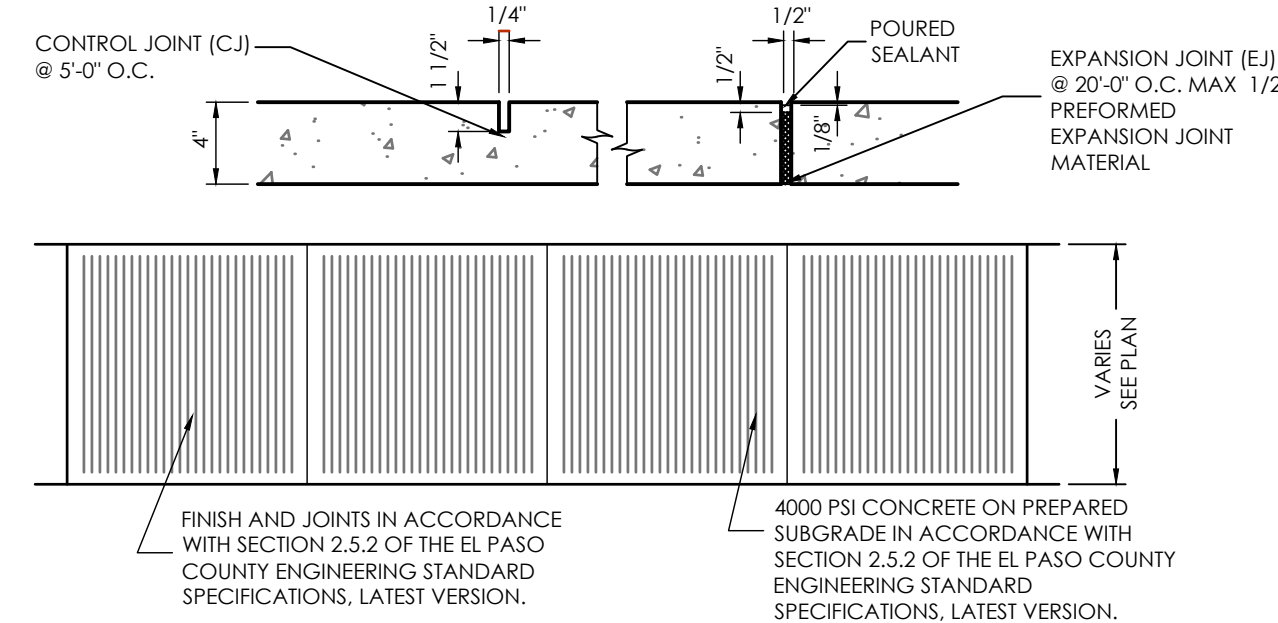


TYPICAL SIDEWALK DETAIL
SCALE 1" = 4.0'



PAVEMENT SECTION
VEHICLE TRAFFIC AREAS (CONCRETE)
SCALE 1" = 1.0'

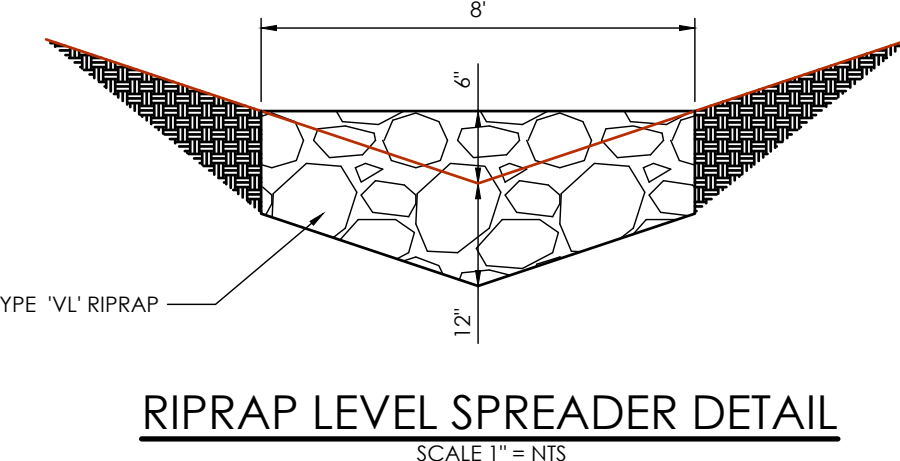

RIPRAP LEVEL SPREADER DETAIL
SCALE 1" = NTS

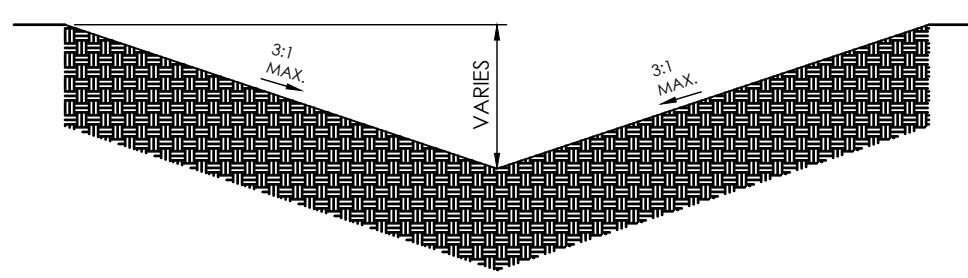

TYPICAL SWALE
SCALE 1" = 1.0'

AS-BUILT RECORD SET


M.V.E., INC.
PCD FILE # PPR2250

Even if everything was built exactly per plan, we need an electronic PDF of the original drawings to be signed, dated, and stamped with "As-Built" on each sheet. The original plan set is 7 pages long, this as-built set is only 2 pages, so please include the other 5 sheets with the next submittal.

Differences from design to as-built conditions to be shown in red text with red clouds/bubbles.



ASBUILT - 7/23/2024
DESIGN BTM = 315 SF. / ASBUILT = 1532 SF.
DESIGN VOL = 1102 CF. / ASBUILT = 2240 CF.

Cannot verify until revised UD-BMP calcs are provided.

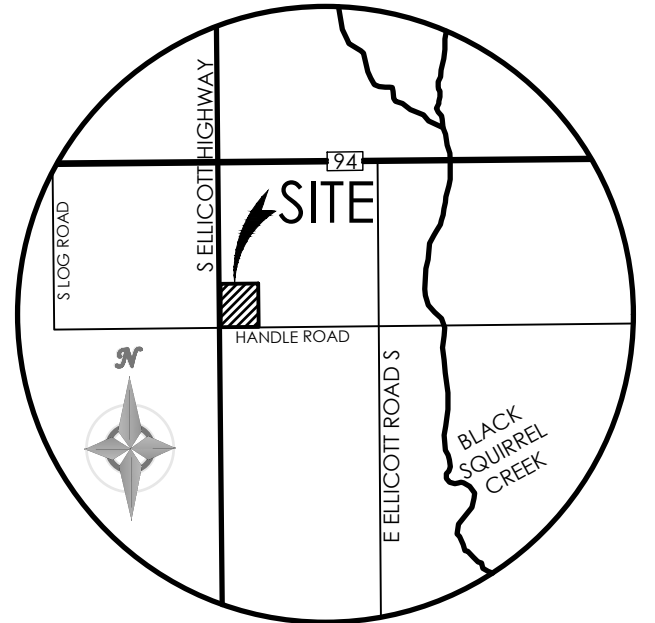

VICINITY MAP
NOT TO SCALE

BENCHMARK
THE EXISTING TOPOGRAPHY SHOWN ON THIS PLAN WAS PREPARED BY AND PROVIDED BY CLARK LAND SURVEYING INC. ELEVATIONS SHOWN ARE RELATIVE TO THE NAVD 88 VERTICAL DATUM.

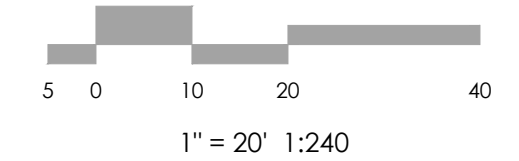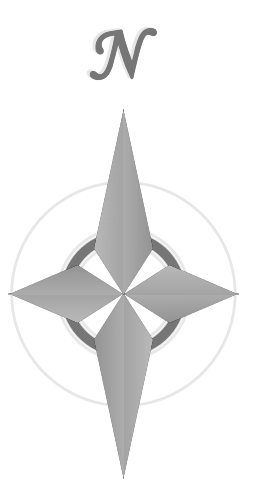

MVE, INC.
ENGINEERS & SURVEYORS

1903 Leary Street, Suite 200 Colorado Springs, CO 80909 719.635.5736

REVISIONS
REMOVED RIPRAP ITEM 4, EXISTING GRADE DID NOT WARRANT SWALE/RIPRAP.
ADDED ROOF DRAINS TO SOUTHERN GRASS SWALE ITEM 2 & REMOVED BERM.



DESIGNED BY _____
DRAWN BY _____
CHECKED BY _____
AS-BUILTS BY _____
CHECKED BY _____

ELLICOTT SCHOOL
ADDITION 2 BLDGS

PHASE I
GRADING PLAN



C1.2 MVE PROJECT 61183
MVE DRAWING GEC-GP-I

APRIL 5, 2023
SHEET 2 OF 7

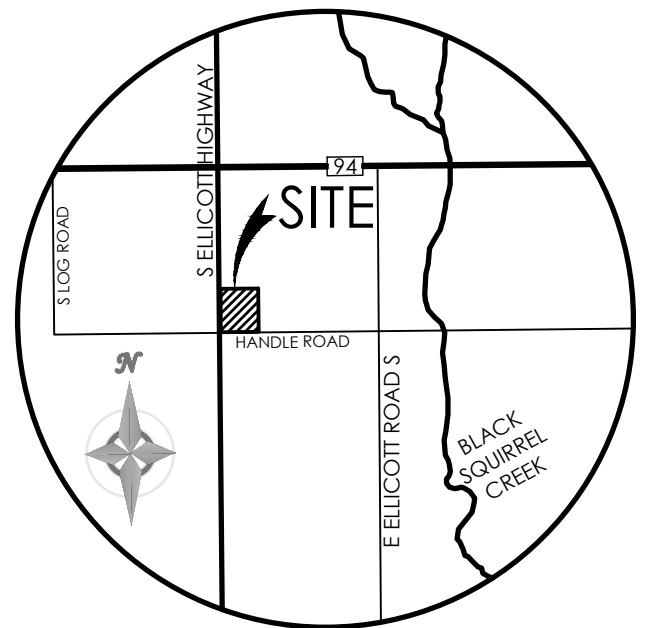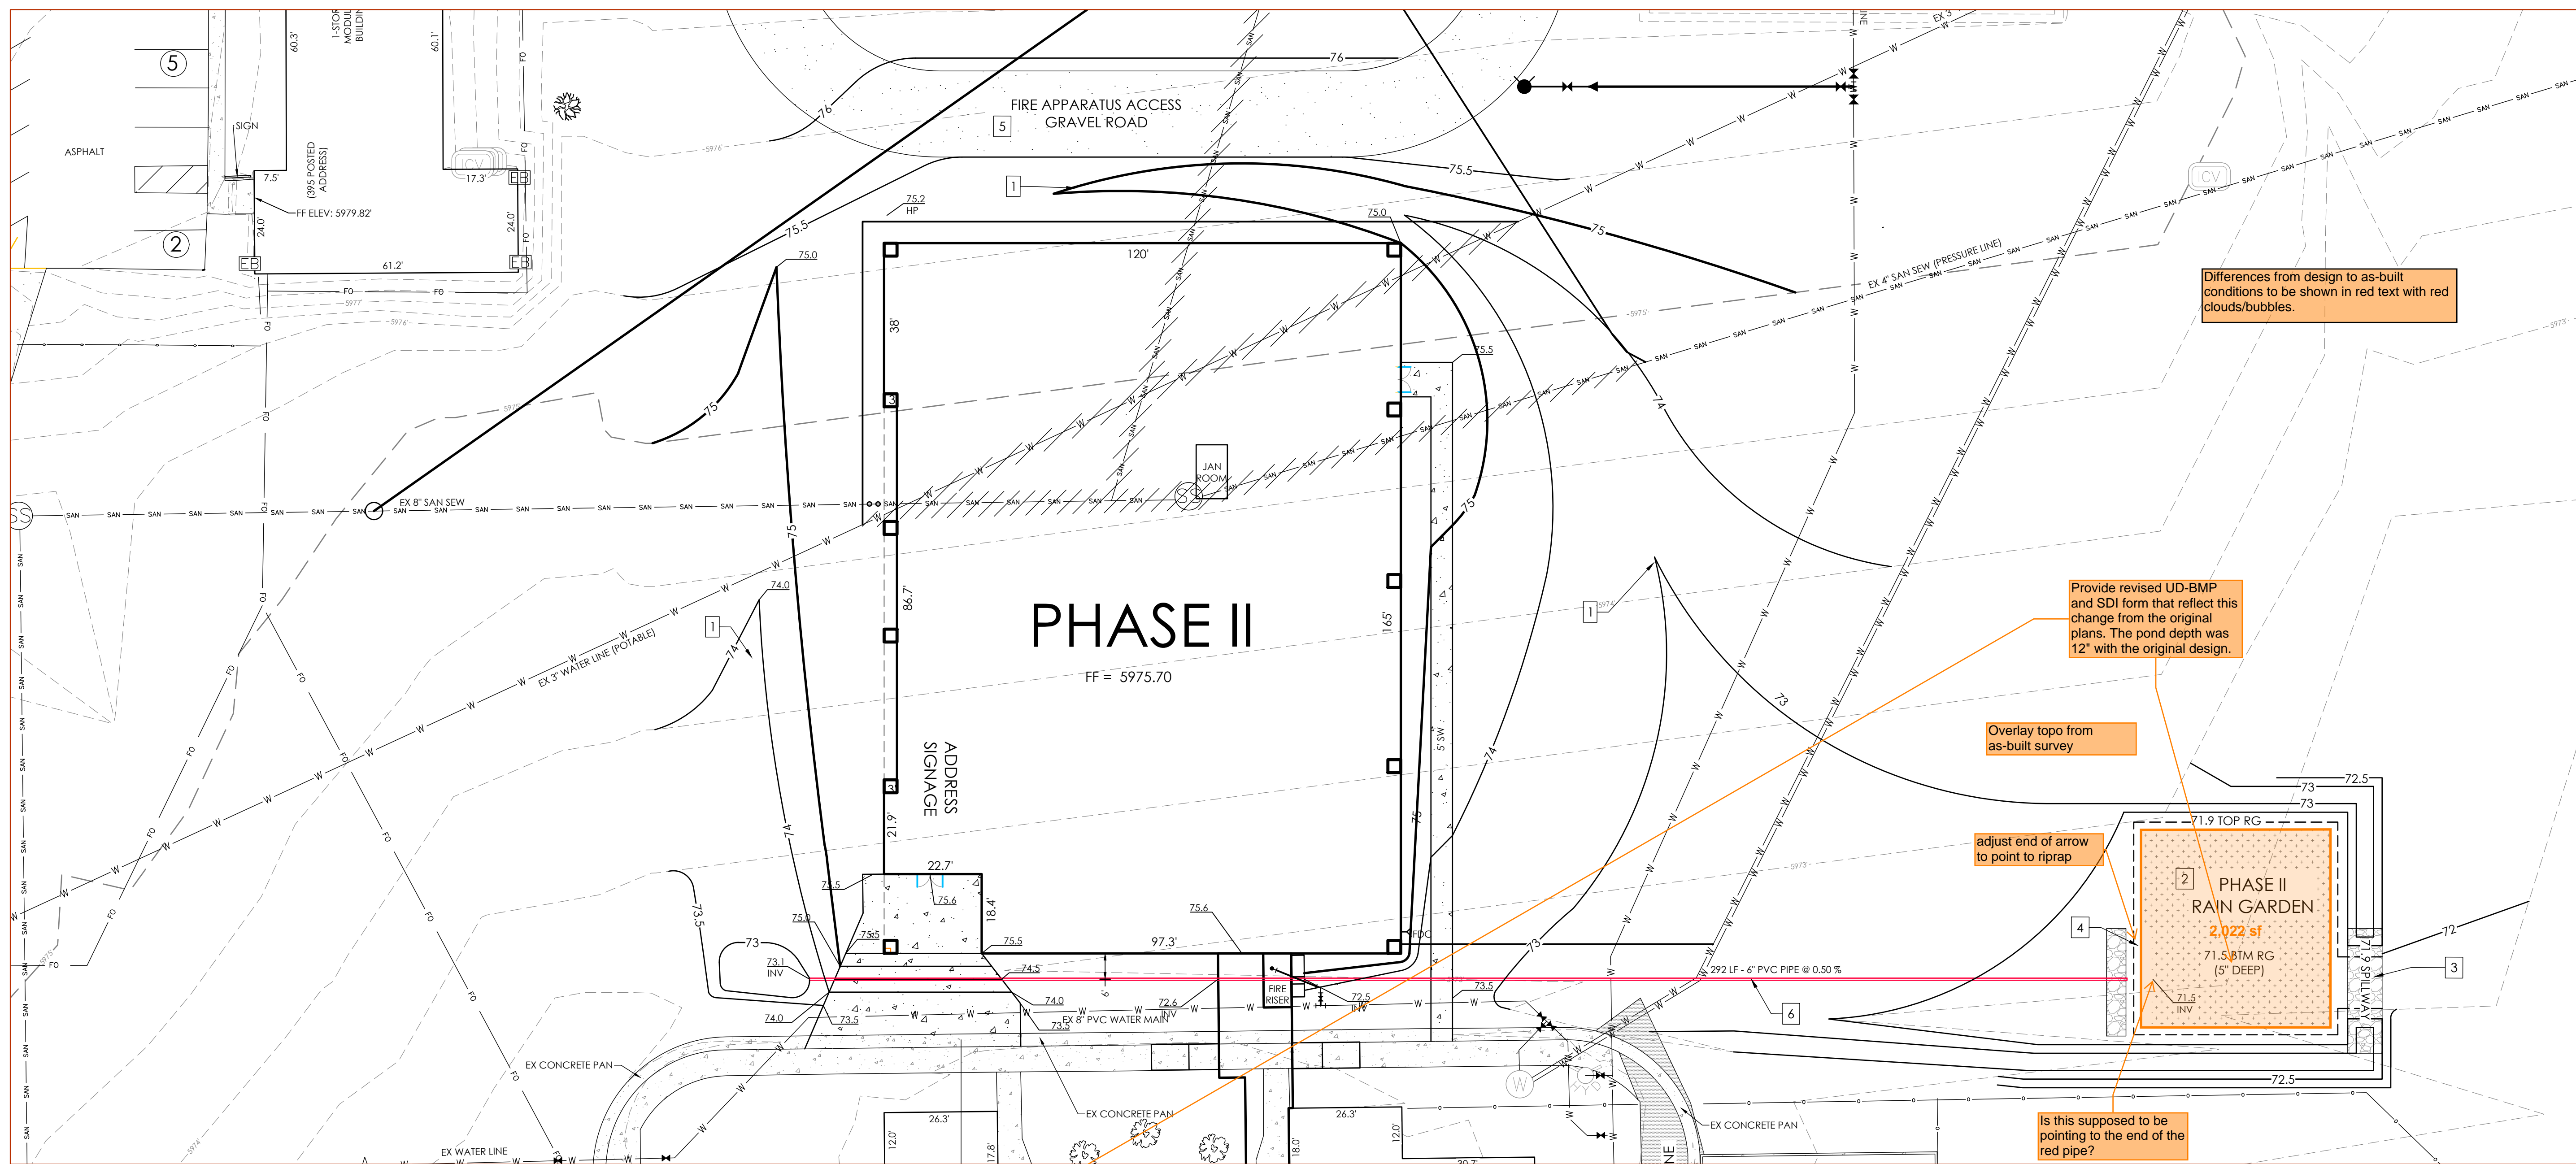

VICINITY MAP
NOT TO SCALE

BENCHMARK
THE EXISTING TOPOGRAPHY SHOWN ON THIS PLAN WAS PREPARED BY AND PROVIDED BY CLARK LAND SURVEYING INC. ELEVATIONS SHOWN ARE RELATIVE TO THE NAVD 88 VERTICAL DATUM.

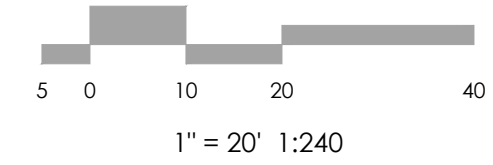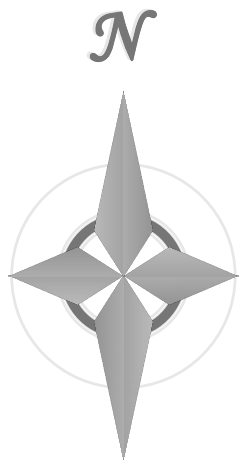

MVE, INC.
ENGINEERS / SURVEYORS
1903 Library Street, Suite 200 Colorado Springs CO 80909 719.635.5736

REVISIONS
REMOVED CONCRETE PAN AND REPLACED WITH DRAIN PIPE FOR BREEZEWAY.
REVISED RAIN GARDEN.

DESIGNED BY
DRAWN BY
CHECKED BY
AS-BUILT BY
CHECKED BY

ELLICOTT SCHOOL
ADDITION 2 BLDGS

PHASE II
GRADING PLAN

C1.4

MVE PROJECT 61183
MVE DRAWING GEC-GP-II

APRIL 5, 2023
SHEET 4 OF 7

SITE PLAN SPECIFIC NOTES

- INSTALL GRASS SWALE. SEE DETAIL ON THIS SHEET.
- INSTALL RAIN GARDEN. SEE DETAIL ON THIS SHEET.
- INSTALL RIP-RAP SPILLWAY. SEE DETAIL ON THIS SHEET.
- INSTALL RIP-RAP. SEE CONCENTRATED IN-FLOW DETAIL.
- INSTALL 6" CDOT CLASS 5 OR 6 AGGREGATE BASE COURSE, MIN L HVEEM VALUE OF 84, MOISTURE TREATED TO WITHIN 2% OPTIMUM MOISTURE CONTENT AND COMPACTED TO 95% (±3%) MAX DRY DENSITY - MOD. PROCTOR (ASTM D1557/AASHTO T-180)
- INSTALL 6" PVC PIPE.

Please update this drawing per the following note from the PA punchlist:

- Phase II Rain Garden (Sheet C1.4-C1.5) - Update the impervious area to illustrate new roof for building connection and confirm that this deviation from the plans is acceptable with the project engineer and reflect change on as-builts or install per original plans.

MAP NOTES

- THE EXISTING TOPOGRAPHY SHOWN ON THIS PLAN WAS PREPARED AND PROVIDED BY CLARK LAND SURVEYING INC.
- ALL EXISTING UNDERGROUND UTILITIES SHOWN ON THIS MAP ARE FROM UTILITY MAIN RECORD MAPS AND UTILITY SERVICE LOCATION MAPS. THE LOCATION OF UTILITIES AS SHOWN ARE APPROXIMATE. ALL UTILITIES MAY NOT BE SHOWN OR MAY NOT HAVE BEEN LOCATED. BELOW GROUND UTILITY LOCATIONS WERE NOT PERFORMED.

704 SF per UD-BMP with FDR


-2022 SF per detail on this sheet

ASBUILT - 7/23/2024


DESIGN BTM = 1984 SF. / ASBUILT = 2300 SF.
DESIGN VOL = 896 CF. / ASBUILT = 1025 CF.

1,205 CF per UD-BMP with FDR

Cannot verify until revised UD-BMP calcs are provided.

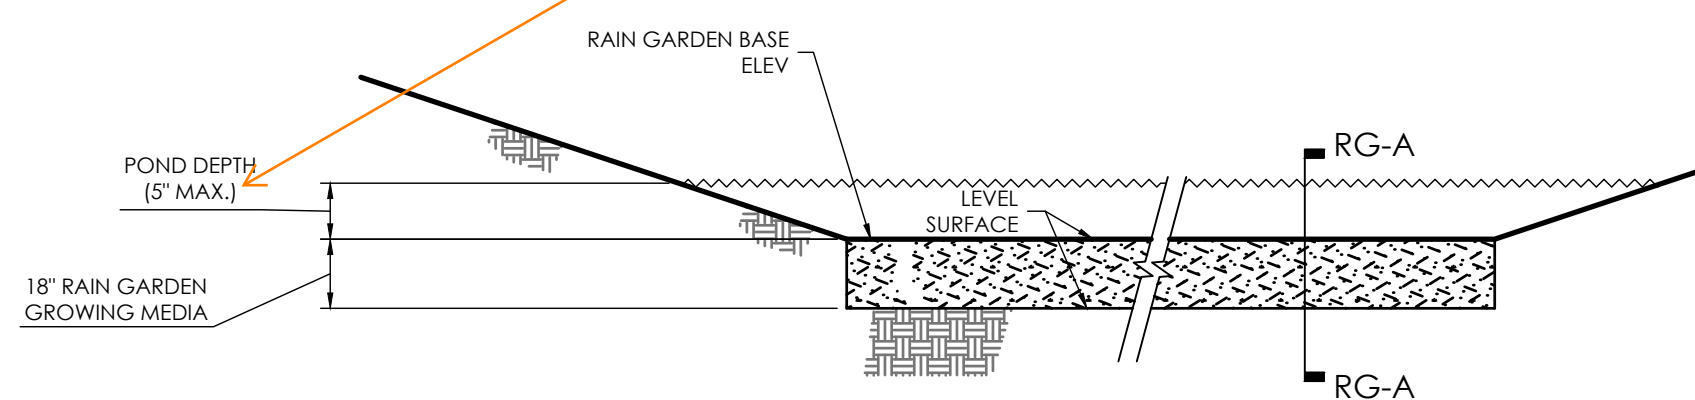

PHASE II RAIN GARDEN DETAIL
SCALE: NTS

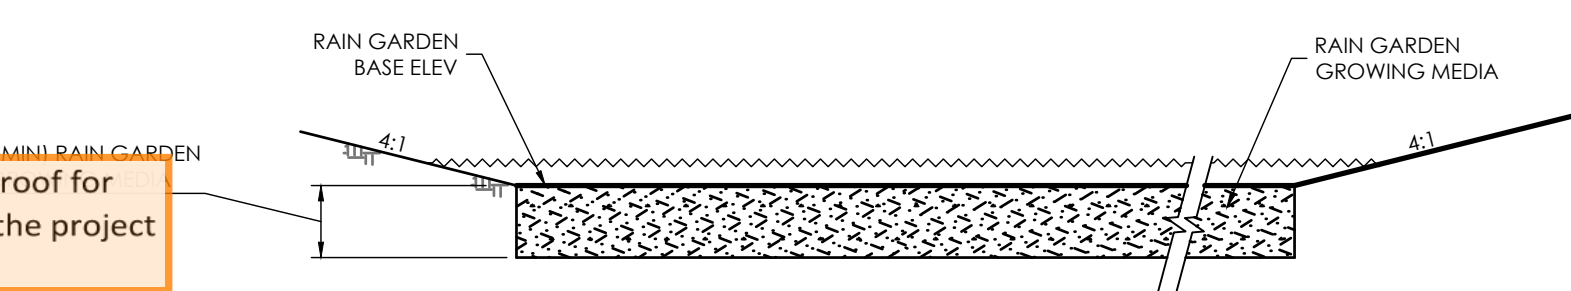


SECTION 'RG-A'
SCALE: NTS


- RAIN GARDEN, SPECIFICATIONS, NOTES & REFERENCES:**
REFERENCE URBAN DRAINAGE AND FLOOD CONTROL DISTRICT (UDFCD), URBAN STORM DRAINAGE CRITERIA MANUAL VOLUME 3, SECTION T-3, FOR FULL SET OF RAIN GARDEN DETAILS AND SPECIFICATIONS AS IDENTIFIED.
- GROWING MEDIA** (BY WEIGHT, USE 3-5% ORGANIC MATERIAL): 95-97% GROWING MEDIA SAND)
 - ORGANIC MATERIAL - LOOSELY PACKED, SHREDDED MULCH - AGED 6 MONTHS (MIN)
 - GROWING MEDIA SAND - PER SOIL MATERIAL GRADATION TABLE MEDIA SAND - PER SOIL MATERIAL GRADATION TABLE (ASTM C-33 SAND STANDARD)
 - pH: 6.8-7.5
 - NITROGEN - 15 ppm (MAX)
 - PHOSPHORUS - 15 ppm (MAX)
 - SALINITY - 6 mmhos/cm (MAX)
 - VEGETATION** - SELECT PLANTS THAT ARE DROUGHT RESISTANT AND THRIVE IN SANDY SOIL. OPTIONAL: USE NATIVE SEED MIX PER RAIN GARDEN SEED MIX TABLE. AGGRESSIVE WEED CONTROL PROCEDURES WILL HELP THE DESIRED VEGETATION TO BECOME ESTABLISHED.
 - CONCENTRATED INFLOW** - PER CONCENTRATED INFLOW DETAIL.

GROWING MEDIA SAND ¹		RAIN GARDEN SEED MIX TABLE ²	
STANDARD SIEVE SIZE	% PASSING	COMMON NAME	LB/AC PLS ²
3/8" (9.5 mm)	100	SAND BLUESTEM	3.5
NO. 4 (4.75 mm)	95-100	SEEDSATS GRAMA	3
NO. 8 (2.36 mm)	80-100	PIERRE SANDREED	3
NO. 16 (1.18 mm)	80-85	INDIAN RICEGRASS	3
NO. 30 (600 um)	25-40	SWITCHGRASS	4
NO. 50 (300 um)	10-30	WESTERN WHEATGRASS	3
NO. 100 (150 um)	2-10	LITTLE BLUESTEM	3
		ALKALI SACATON	3
		SAND DROPSIED	3
		TOTAL	27.5


¹LESS THAN 1.5% ORGANIC MATERIAL
²SEE UDFCD TABLE B-3 FOR SCIENTIFIC NAMES AND WILDFLOWER MIX OPTION
³PLS = PURE LIVE SEED

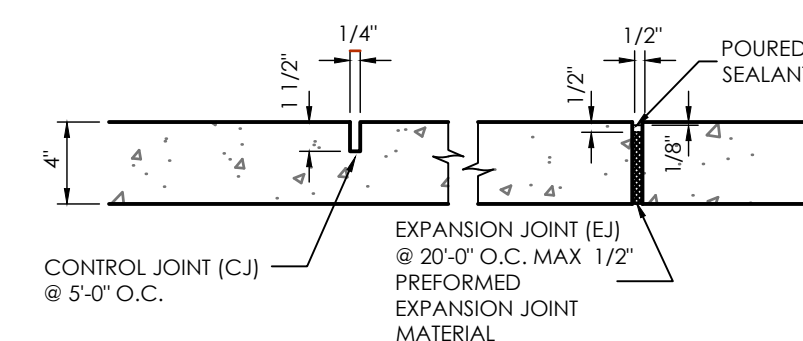


TYPICAL SIDEWALK DETAIL
SCALE 1" = 4.0'

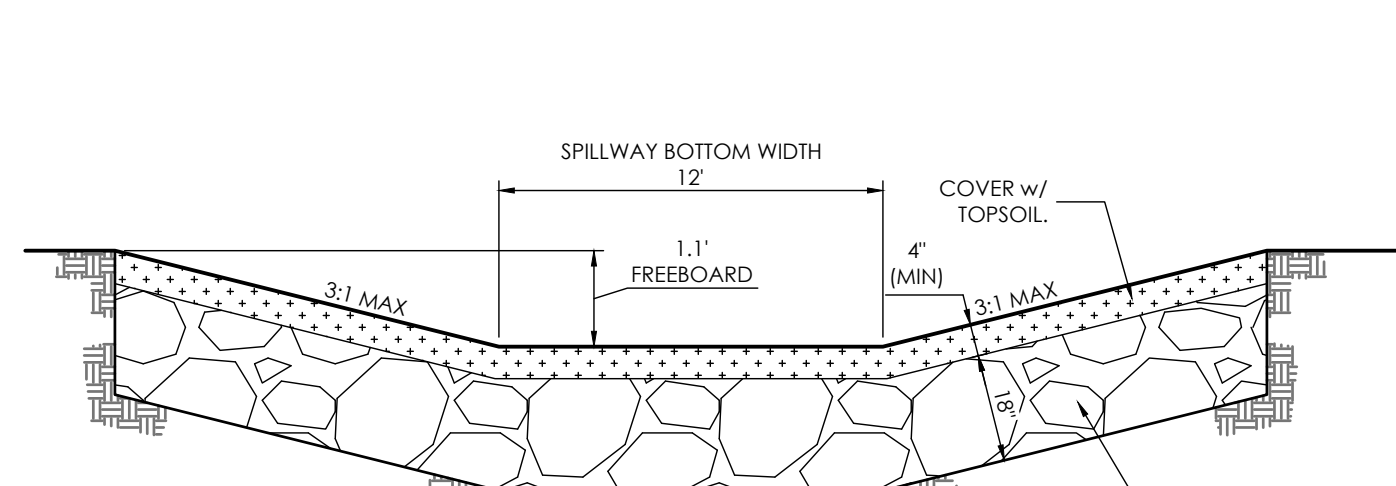

SPILLWAY DETAIL
SCALE: NTS

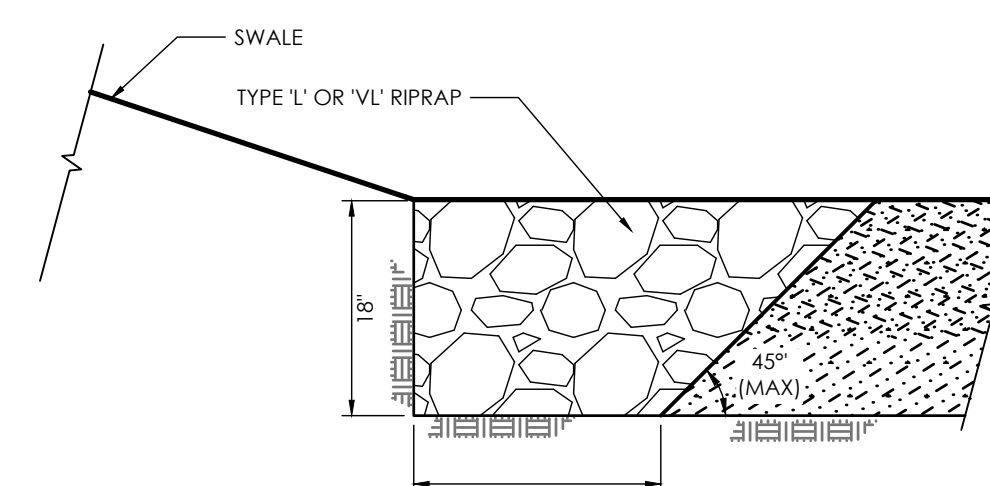

CONCENTRATED IN-FLOW DETAIL
SCALE: NTS

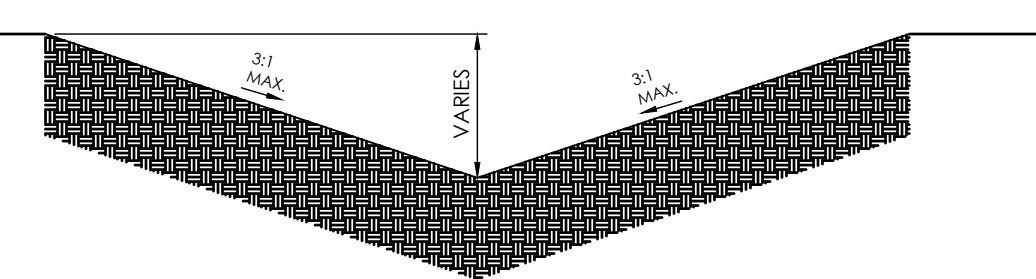

TYPICAL SWALE
SCALE 1" = 1.0'

PCD FILE # PPR2250