
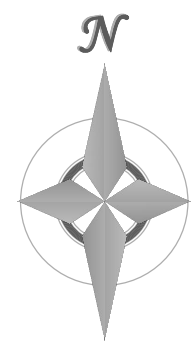


CONSTRUCTION PLANS  
for  
**JACKSON RANCH FILING NO. 3**  
SECTION 21, TOWNSHIP 11 SOUTH, RANGE 66 WEST OF THE 6TH  
P.M., EL PASO COUNTY, COLORADO

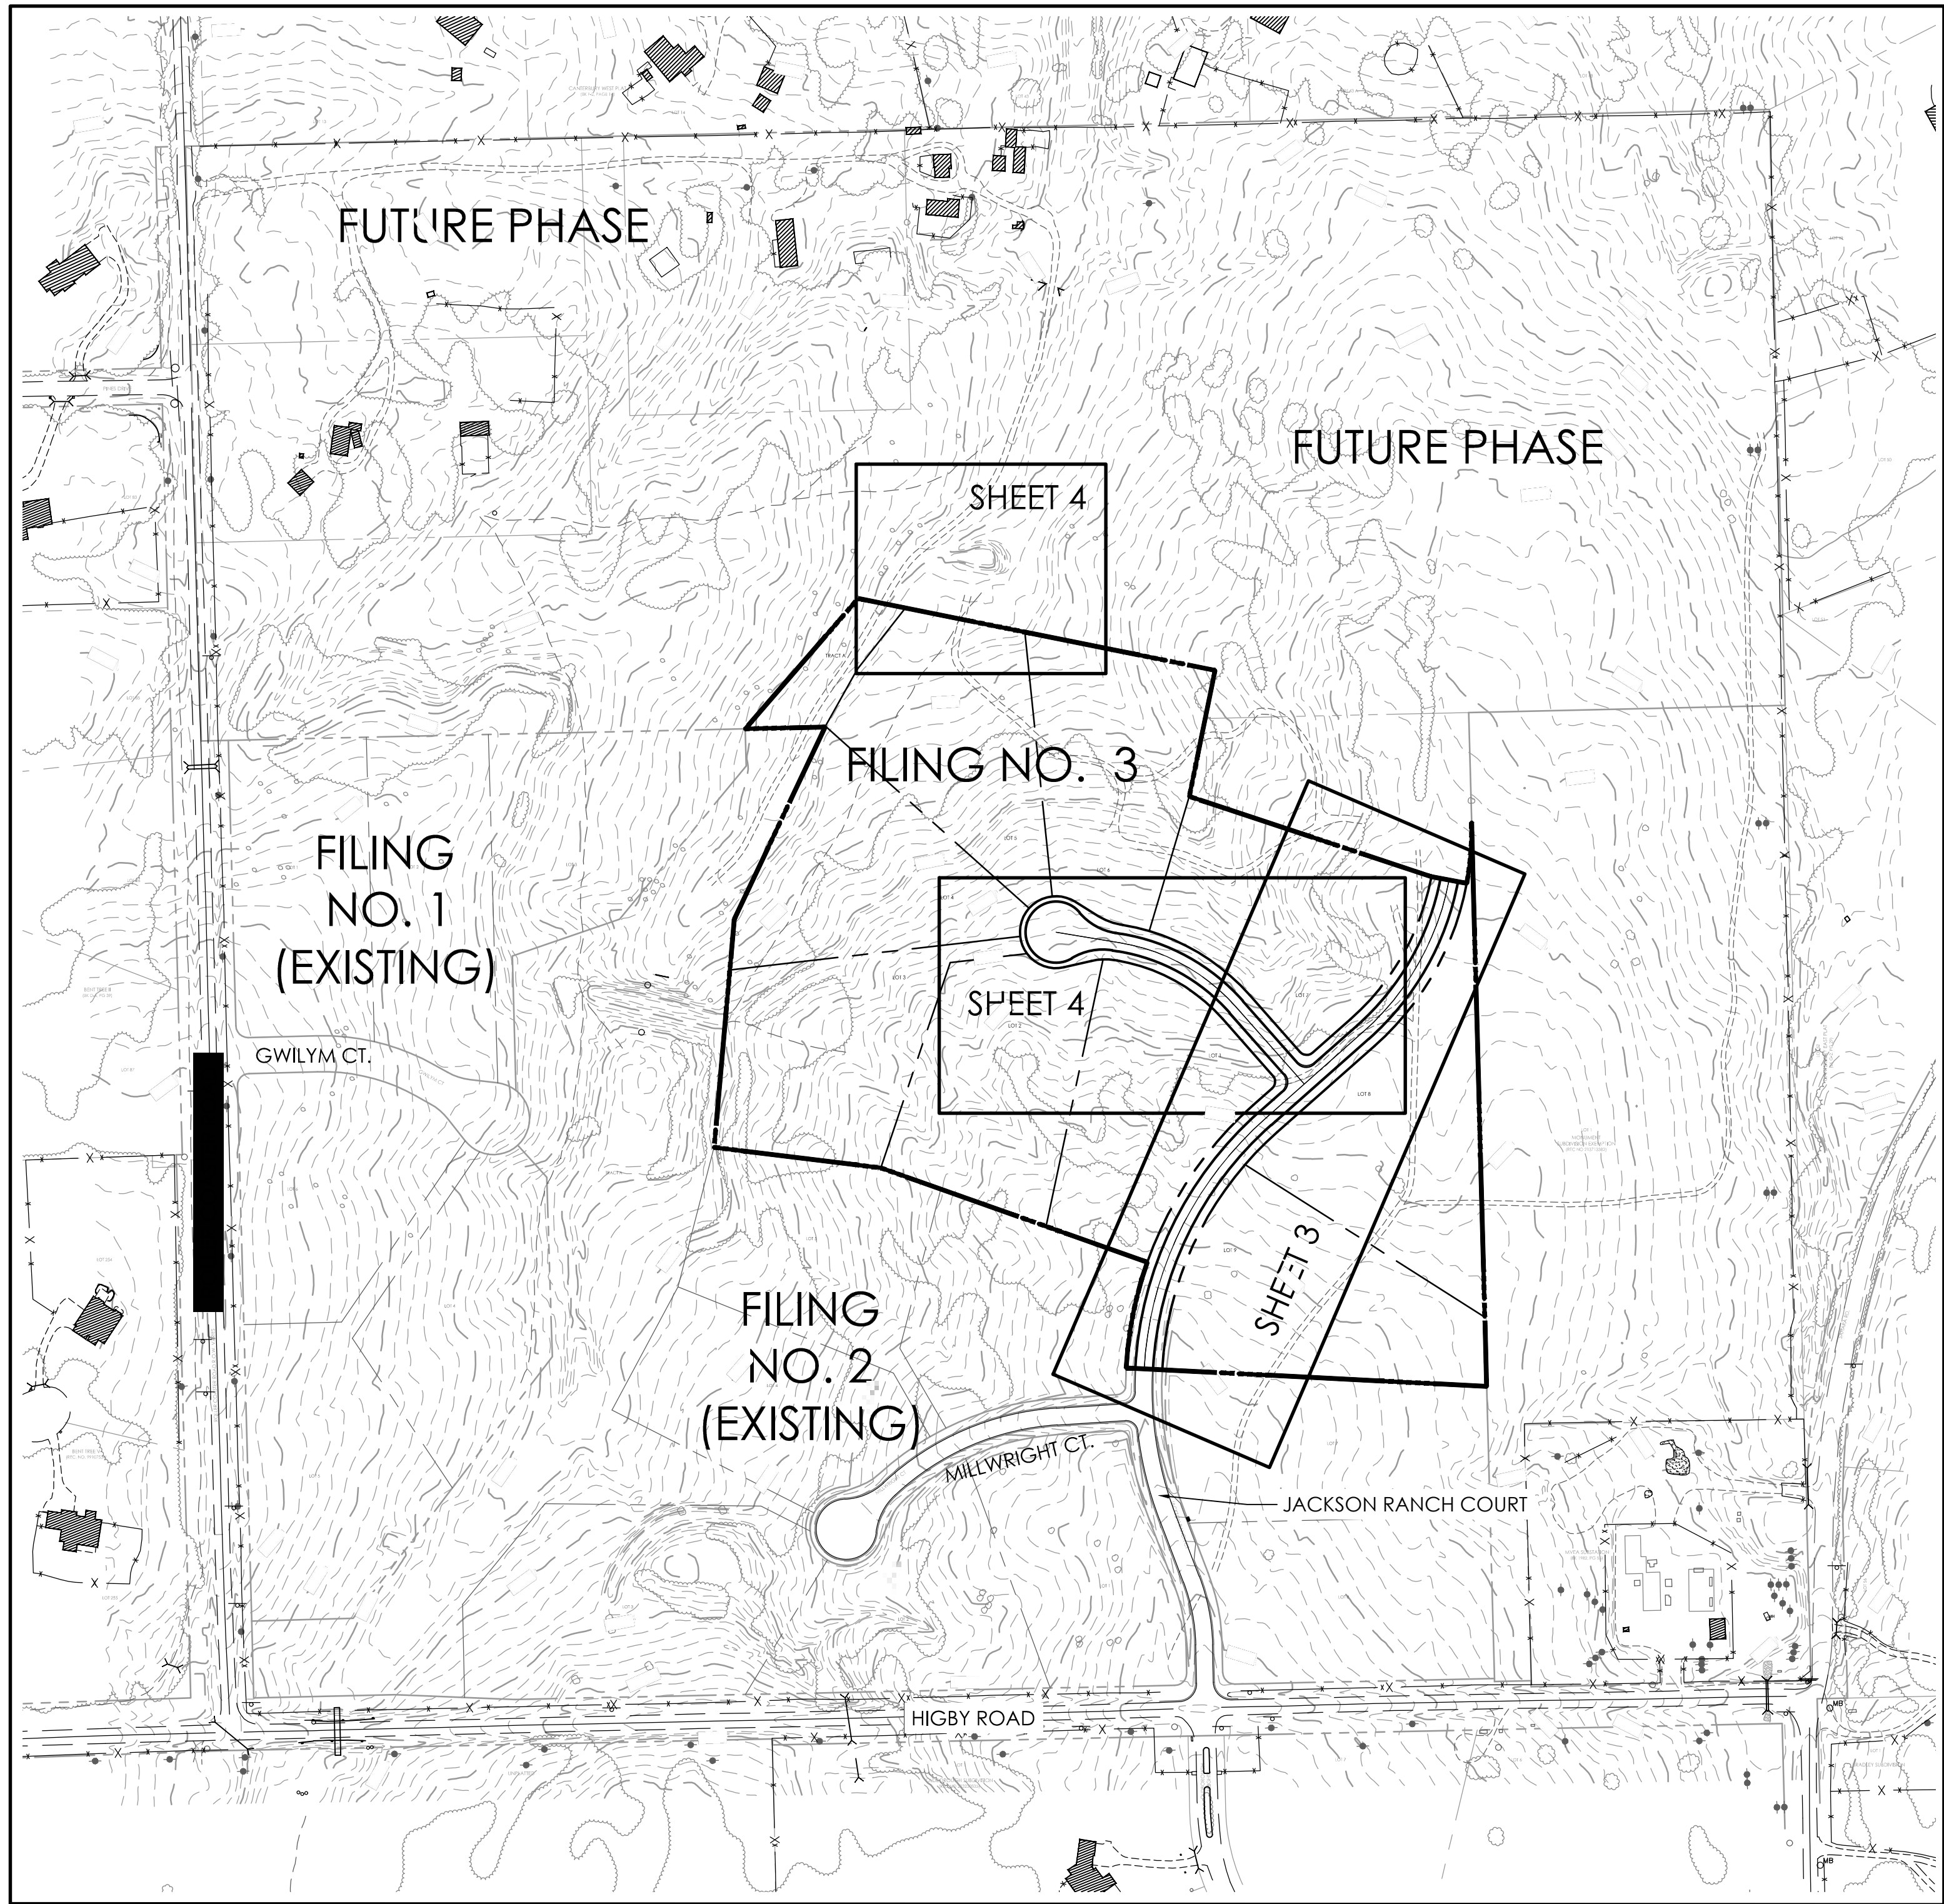

**SITE MAP**  
SCALE 1" = 200'

**ABBREVIATIONS**

EL	ELEVATION	ROW	RIGHT-OF-WAY
PC	POINT OF CURVATURE	R	RADIUS
PI	POINT OF INTERSECTION	T	TANGENT
PT	POINT OF TANGENCY	L	LENGTH
PCR	POINT OF CURVE RETURN	LF	LINEAR FEET
PRC	POINT OF REVERSE CURVATURE	CL	CENTERLINE
PVC	POINT OF VERTICAL CURVATURE	X.XX' R	DIMENSION RIGHT OF CL
PVI	POINT OF VERTICAL INTERSECTION	X.XX' L	DIMENSION LEFT OF CL
PVT	POINT OF VERTICAL TANGENCY	PL	PROPERTY LINE
GB	GRADE BREAK	PVRC	POINT OF VERT REVERSE CURVATURE
CSP	CORRUGATED STEEL PIPE	VC	VERTICAL CURVE
RCP	REINFORCED CONCRETE PIPE	AP	ANGLE POINT
CBC	CONCRETE BOX CULVERT	STA	STATION
TBC	TOP BACK CURB	INV	INVERT
TC	TOP OF CURB	RG	RAIN GARDEN
BT	BEGIN TAPER	SFB	SAND FILTER BASIN
ET	END TAPER		
EC	EDGE OF CONCRETE		

**SHEET INDEX**

PLAN SET SHEET NO.	SHEET TITLE	MVE DRAWING NO.
C1.0 (1 OF 5)	COVER SHEET	61044-CON-CS
C1.1 (2 OF 5)	NOTES / CONSTRUCTION DETAILS	61044-CON-GN
C1.2 (3 OF 5)	PLAN / PROFILE	61044-CON-PP1
C1.3 (4 OF 5)	PLAN / PROFILE	61044-CON-PP2
C1.4 (5 OF 5)	EROSION CONTROL PLAN	61044-CON-EC

**COMPANIES AND AGENCIES**

**OWNER/DEVELOPER**

FOUR GATES LAND DEVELOPMENT LLC  
17435 ROLLER COASTER ROAD  
MONUMENT, CO 80132  
(719) 488-9329

**ENGINEER**

M.V.E., INC.  
1903 LELARAY STREET, STE 200  
COLORADO SPRINGS, CO 80909  
(719) 635-5736

**STREETS AND RIGHTS-OF-WAY**

PUBLIC SERVICES DEPARTMENT - TRANSPORTATION DIV.  
3275 AKERS DRIVE  
COLORADO SPRINGS, CO 80922  
(719) 520-6460

**ELECTRIC**

MOUNTAIN VIEW ELECTRIC ASSOCIATION  
11140 EAST WOODMEN ROAD  
FALCON, CO 80831  
(719) 495-2283

**TELEPHONE**

CENTURYLINK  
555 TECH CENTER DRIVE SUITE 110  
COLORADO SPRINGS, CO 80919  
866.301.9889

**LEGEND**

EXISTING	PROPOSED
BOUNDARY LINE .....	BOUNDARY LINE .....
ADJACENT BOUNDARY LINE .....	LOT LINE .....
ADJACENT LOT LINE .....	EASEMENT LINE .....
EASEMENT LINE .....	CENTER LINE .....
INDEX CONTOUR .....	INDEX CONTOUR .....
INTERMEDIATE CONTOUR .....	INTERMEDIATE CONTOUR .....
TEST HOLE LOCATION .....	SLOPE / GRADE .....
CURB AND GUTTER .....	SPOT ELEVATION .....
SIGN .....	
FENCE .....	
LIGHT POLE .....	
MANHOLE .....	
UTILITY POLE .....	
MISC OBJECT .....	
PILE .....	
CULVERT .....	
ROCK .....	
MAILBOX .....	
TREE .....	
RIPRAP .....	
POLE-ANCHOR .....	

**OWNERS STATEMENT**

I, THE OWNER/DEVELOPER HAVE READ AND WILL COMPLY WITH ALL OF THE REQUIREMENTS SPECIFIED IN THESE DETAILED PLANS AND SPECIFICATIONS.

MARLENE D. BROWN  
MANAGER, FOUR GATES LAND DEVELOPMENT LLC  
DATE

**DESIGN ENGINEER'S STATEMENT:**

THESE DETAILED PLANS AND SPECIFICATIONS WERE PREPARED UNDER MY DIRECTION AND SUPERVISION. SAID PLANS AND SPECIFICATIONS HAVE BEEN PREPARED ACCORDING TO THE CRITERIA ESTABLISHED BY THE COUNTY FOR DETAILED ROADWAY, DRAINAGE, GRADING AND EROSION CONTROL PLANS AND SPECIFICATIONS, AND SAID PLANS AND SPECIFICATIONS ARE IN CONFORMITY WITH APPLICABLE MASTER DRAINAGE PLANS AND MASTER TRANSPORTATION PLANS. SAID PLANS AND SPECIFICATIONS MEET THE PURPOSES FOR WHICH THE PARTICULAR ROADWAY AND DRAINAGE FACILITIES ARE DESIGNED AND ARE CORRECT TO THE BEST OF MY KNOWLEDGE AND BELIEF. I ACCEPT RESPONSIBILITY FOR ANY LIABILITY CAUSED BY ANY NEGLIGENT ACTS, ERRORS OR OMISSIONS ON MY PART IN PREPARATION OF THESE DETAILED PLANS AND SPECIFICATIONS


DAVID R. GORMAN, P.E.  
FOR AND ON BEHALF OF M.V.E., INC.  
COLORADO NO. 31672  
DATE

**EL PASO COUNTY:**

COUNTY PLAN REVIEW IS PROVIDED ONLY FOR GENERAL CONFORMANCE WITH COUNTY DESIGN CRITERIA. THE COUNTY IS NOT RESPONSIBLE FOR THE ACCURACY AND ADEQUACY OF THE DESIGN, DIMENSIONS, AND/OR ELEVATIONS WHICH SHALL BE CONFIRMED AT THE JOB SITE. THE COUNTY THROUGH THE APPROVAL OF THIS DOCUMENT ASSUMES NO RESPONSIBILITY FOR COMPLETENESS AND/OR ACCURACY OF THIS DOCUMENT.

FILED IN ACCORDANCE WITH THE REQUIREMENTS OF THE EL PASO COUNTY LAND DEVELOPMENT CODE, DRAINAGE CRITERIA MANUAL, AND ENGINEERING CRITERIA MANUAL AS AMENDED.


JENNIFER IRVINE, P.E.  
COUNTY ENGINEER / ECM ADMINISTRATOR  
DATE

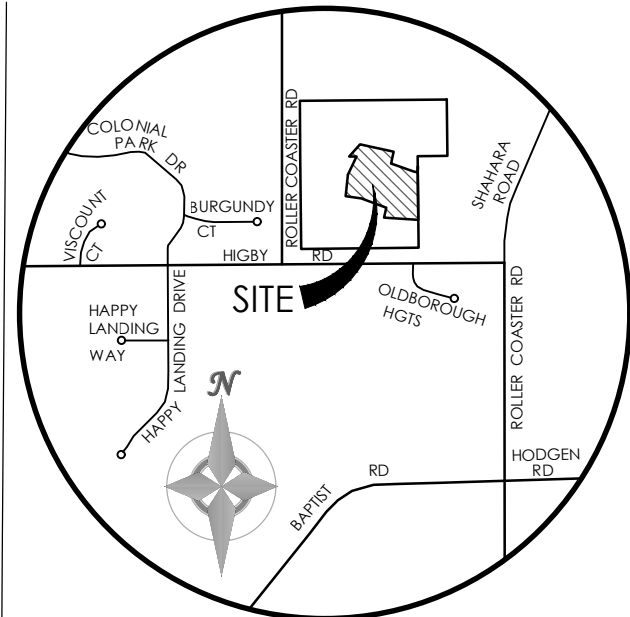

**VICINITY MAP**

NOT TO SCALE  
BENCHMARK  
THE BENCHMARK FOR THESE PLANS IS THE TOP OF PANEL POINT "SW", LOCATED NORTHWEST OF ROLLER COASTER ROAD & HIGBY ROAD. ELEVATION = 7461.14' (NAVD88).

BASIS OF BEARINGS: THE SOUTH LINE OF THE NW QUARTER OF SEC 21, T. 11 S., R. 66 W. OF THE 6TH P.M., EL PASO COUNTY, COLORADO, S88°46'41"W, A DISTANCE OF 2639.80 FEET & MONUMENTED BY A 2 1/2" DIA. ALUMINUM CAP LS #23890 ON THE EAST & A 2 1/2" DIA. ALUMINUM CAP LS #9853 ON THE WEST

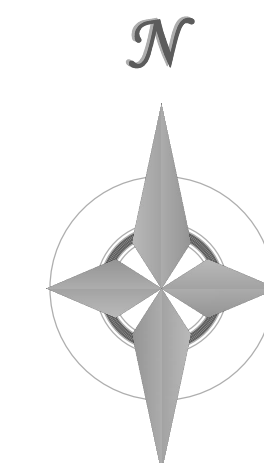

50 0 100 200 400  
1" = 200' 1:2,400

**MVE, INC.**  
ENGINEERS, SURVEYORS  
1903 LELARAY STREET, SUITE 200 COLORADO SPRINGS CO 80909 719.635.5736

REVISIONS

DESIGNED BY CCC  
DRAWN BY TJW  
CHECKED BY  
AS-BUILTS BY  
CHECKED BY

**JACKSON RANCH  
FILING NO. 3  
COVER SHEET**

**C1.0**  
MVE PROJECT **61044**  
MVE DRAWING **CON-CS**

**APRIL 17, 2017  
SHEET 1 OF 5**

Add EPC Planning  
& Community  
Development  
Department.

Add "PCD Project  
No. SF-17-017"



GENERAL NOTES

1. ALL NEW CONSTRUCTION IS TO CONFORM TO THE SPECIFICATIONS OF EL PASO COUNTY.
2. UNDERGROUND FACILITIES, STRUCTURES AND UTILITIES HAVE BEEN DRAWN FROM AVAILABLE RECORDS AND/OR SURFACE EVIDENCE. THE LOCATION OF ALL UTILITIES MAY NOT BE SHOWN OR MAY NOT HAVE BEEN LOCATED. BELOW GROUND LOCATIONS HAVE NOT BEEN PERFORMED. THEREFORE, THE RELATIONSHIP BETWEEN PROPOSED WORK AND EXISTING FACILITIES, STRUCTURES AND UTILITIES MUST BE CONSIDERED APPROXIMATE. CONTRACTOR SHALL BE RESPONSIBLE FOR CONTACTING ALL SUBSURFACE UTILITY OWNERS PRIOR TO BEGINNING WORK TO DETERMINE LOCATION OF UTILITY FACILITIES. ALL UTILITIES SHALL BE LOCATED PRIOR TO ANY EARTH WORK OR DIGGING (1-800-922-1987). THE CONTRACTOR SHALL BE FULLY RESPONSIBLE FOR ANY AND ALL DAMAGES WHICH MAY BE OCCASIONED BY THE CONTRACTOR'S FAILURE TO EXACTLY LOCATE AND PRESERVE ANY AND ALL UTILITIES.
3. EXISTING CONDITIONS SHALL BE VERIFIED BY THE GENERAL CONTRACTOR. DISCREPANCIES ARE TO BE REPORTED TO THE ENGINEER PRIOR TO CONSTRUCTION.
4. SOIL PREPARATION, SEEDING, AND MULCHING FOR AN ESTIMATED 3.3 ACRES WILL BE REQUIRED ON ALL DISTURBED AREAS NOT SURFACED. THE FOLLOWING TYPES AND RATES SHALL BE USED:

GRASS	VARIETY	AMOUNT IN PLS lbs. PER AC.
SIDEOLATS GRAMA	EL RENO	3.0 lbs.
WESTERN WHEATGRASS	BARTON	2.5 lbs.
SLENDER WHEAT GRASS	NATIVE	2.0 lbs.
LITTLE BLUESTEM	PASTURA	2.0 lbs.
SAND DROPSIED	NATIVE	0.5 lbs.
SWITCH GRASS	NEBRASKA 28	3.0 lbs.
WEEPIING LOVE GRASS	MORPHA	1.0 lbs.
	TOTAL	14.0 lbs.

STANDARD EL PASO COUNTY GRADING & EROSION CONTROL PLAN NOTES

1. CONSTRUCTION MAY NOT COMMENCE UNTIL A CONSTRUCTION PERMIT IS OBTAINED FROM DEVELOPMENT SERVICES ADN A PRECONSTRUCTION CONFERENCE IS HELD WITH DEVELOPMENT SERVICES INSPECTIONS.
2. STORMWATER DISCHARGES FROM CONSTRUCTION SITES SHALL NOT CAUSE OR THREATEN TO CAUSE POLLUTION, CONTAMINATION, OR DEGRADATION OF STATE WATERS. ALL WORK AND EARTH DISTURBANCE SHALL BE DONE IN A MANNER THAT MINIMIZES POLLUTION OF ANY ON-SITE OR OFF-SITE WATERS, INCLUDING WETLANDS.
3. NOTWITHSTANDING ANYTHING DEPICTED IN THESE PLANS IN WORDS OR GRAPHIC REPRESENTATION, ALL DESIGN AND CONSTRUCTION RELATED TO ROADS, STORM DRAINAGE AND EROSION CONTROL SHALL CONFORM TO THE STANDARDS AND REQUIREMENTS OF THE MOST RECENT VERSION OF THE RELEVANT ADOPTED EL PASO COUNTY STANDARDS INCLUDING THE LAND DEVELOPMENT CODE, THE ENGINEERING CRITERIA MANUAL, THE DRAINAGE CRITERIA MANUAL AND THE DRAINAGE CRITERIA MANUAL VOLUME 2. ANY DEVIATIONS FROM REGULATIONS AND STANDARDS MUST BE REQUESTED, AND APPROVED, IN WRITING.
4. A SEPARATE STORMWATER MANAGEMENT PLAN (SWMP) FOR THIS PROJECT SHALL BE COMPLETED AND AN EROSION AND STORMWATER QUALITY CONTROL PERMIT (ESQCP) ISSUED PRIOR TO COMMENCING CONSTRUCTION. DURING CONSTRUCTION, THE SWMP IS THE RESPONSIBILITY OF THE DESIGNATED STORMWATER MANAGER. SHALL BE LOCATED ON SITE AT ALL TIMES AND SHALL BE KEPT UP TO DATE WITH WORK PROGRESS AND CHANGES IN THE FIELD.
5. ONCE THE ESQCP HAS BEEN ISSUED, THE CONTRACTOR MAY INSTALL THE INITIAL STAGE EROSION AND SEDIMENT CONTROL BMPs AS INDICATED ON THE GEC. A PRECONSTRUCTION MEETING BETWEEN THE CONTRACTOR, ENGINEER, AND EL PASO COUNTY WILL BE HELD PRIOR TO ANY CONSTRUCTION. IT IS THE RESPONSIBILITY OF THE APPLICANT TO COORDINATE THE MEETING TIME AND PLACE WITH COUNTY DSD INSPECTIONS STAFF.
6. SOIL EROSION CONTROL MEASURES FOR ALL SLOPES, CHANNELS, DITCHES, OR ANY DISTURBED LAND AREA SHALL BE COMPLETED WITHIN 21 CALENDAR DAYS AFTER FINAL GRADING, OR FINAL EARTH DISTURBANCE, HAS BEEN COMPLETED. DISTURBED AREAS AND STOCKPILES WHICH ARE NOT AT FINAL GRADE BUT WILL REMAIN DORMANT FOR LONGER THAN 30 DAYS SHALL ALSO BE MULCHED WITHIN 21 DAYS AFTER INTERIM GRADING. AN AREA THAT IS GOING TO REMAIN IN AN INTERIM STATE FOR MORE THAN 60 DAYS SHALL ALSO BE SEEDDED. ALL TEMPORARY SOIL EROSION CONTROL MEASURES AND BMPs SHALL BE MAINTAINED UNTIL PERMANENT SOIL EROSION CONTROL MEASURES ARE IMPLEMENTED AND ESTABLISHED.
7. TEMPORARY SOIL EROSION CONTROL FACILITIES SHALL BE REMOVED AND EARTH DISTURBANCE AREAS GRADED AND STABILIZED WITH PERMANENT SOIL EROSION CONTROL MEASURES PURSUANT TO STANDARDS AND SPECIFICATION DESCRIBED IN THE DCM VOLUME I AND THE ENGINEERING CRITERIA MANUAL [ECM] APPENDIX I.
8. ALL PERSONS ENGAGED IN EARTH DISTURBANCE SHALL IMPLEMENT AND MAINTAIN ACCEPTABLE SOIL EROSION AND SEDIMENT CONTROL MEASURES IN CONFORMANCE WITH THE EROSION CONTROL TECHNIQUE STANDARDS OF THE DRAINAGE CRITERIA MANUAL [DCM] VOLUME I AND IN ACCORDANCE WITH THE STORMWATER MANAGEMENT PLAN (SWMP).
9. ALL TEMPORARY EROSION CONTROL FACILITIES INCLUDING BMPs AND ALL PERMANENT FACILITIES INTENDED TO CONTROL EROSION OF ANY EARTH DISTURBANCE OPERATIONS, SHALL BE INSTALLED AS DEFINED IN THE APPROVED PLANS, THE SWMP AND THE DCM VOLUME I AND MAINTAINED THROUGHOUT THE DURATION OF THE EARTH DISTURBANCE OPERATION.
10. ANY EARTH DISTURBANCE SHALL BE CONDUCTED IN SUCH A MANNER SO AS TO EFFECTIVELY REDUCE ACCELERATED SOIL EROSION AND RESULTING SEDIMENTATION. ALL DISTURBANCES SHALL BE DESIGNED, CONSTRUCTED, AND COMPLETED SO THAT THE EXPOSED AREA OF ANY DISTURBED LAND SHALL BE LIMITED TO THE SHORTEST PRACTICAL PERIOD OF TIME.
11. ANY TEMPORARY OR PERMANENT FACILITY DESIGNED AND CONSTRUCTED FOR THE CONVEYANCE OF STORMWATER AROUND, THROUGH, OR FROM THE EARTH DISTURBANCE AREA SHALL BE DESIGNED TO LIMIT THE DISCHARGE TO A NON-EROSIVE VELOCITY.
12. CONCRETE WASH WATER SHALL BE CONTAINED AND DISPOSED OF IN ACCORDANCE WITH THE SWMP. NO WASH WATER SHALL BE DISCHARGED TO OR ALLOWED TO RUNOFF TO STATE WATERS, INCLUDING ANY SURFACE OR SUBSURFACE STORM DRAINAGE SYSTEM OR FACILITIES.
13. EROSION CONTROL BLANKETING SHALL BE USED ON SLOPES STEEPER THAN 3:1.
14. BUILDING, CONSTRUCTION, EXCAVATION, OR OTHER WASTE MATERIALS SHALL NOT BE TEMPORARILY PLACED OR STORED IN THE STREET, ALLEY, OR OTHER PUBLIC WAY, UNLESS IN ACCORDANCE WITH AN APPROVED TRAFFIC CONTROL PLAN. BMPs MAY BE REQUIRED BY EL PASO COUNTY ENGINEERING IF DEEMED NECESSARY, BASED ON SPECIFIC CONDITIONS AND CIRCUMSTANCES.
15. VEHICLE TRACKING OF SOILS AND CONSTRUCTION DEBRIS OFF-SITE SHALL BE MINIMIZED. MATERIALS TRACKED OFFSITE SHALL BE CLEANED UP AND PROPERLY DISPOSED OF IMMEDIATELY.
16. CONTRACTOR SHALL BE RESPONSIBLE FOR THE REMOVAL OF ALL WASTES FROM THE CONSTRUCTION SITE FOR DISPOSAL IN ACCORDANCE WITH LOCAL AND STATE REGULATORY REQUIREMENTS. NO CONSTRUCTION DEBRIS, TREE SHALB, BUILDING MATERIAL WASTES OR UNUSED BUILDING MATERIALS SHALL BE BURIED, DUMPED, OR DISCHARGED AT THE SITE.
17. THE OWNER, SITE DEVELOPER, CONTRACTOR, AND/OR THEIR AUTHORIZED AGENTS SHALL BE RESPONSIBLE FOR THE REMOVAL OF ALL CONSTRUCTION DEBRIS, DIRT, TRASH, ROCK, SEDIMENT, AND SAND THAT MAY ACCUMULATE IN THE STORM SEWER OR OTHER DRAINAGE CONVEYANCE SYSTEM AND STORMWATER APPEARANCES AS A RESULT OF SITE DEVELOPMENT.
18. THE QUANTITY OF MATERIALS STORED ON THE PROJECT SITE SHALL BE LIMITED, AS MUCH AS PRACTICAL, TO THAT QUANTITY REQUIRED TO PERFORM THE WORK IN AN ORDERLY SEQUENCE. ALL MATERIALS STORED ON-SITE SHALL BE STORED IN A NEAT, ORDERLY MANNER, IN THEIR ORIGINAL CONTAINERS, WITH ORIGINAL MANUFACTURER'S LABELS.
19. NO CHEMICALS ARE TO BE USED BY THE CONTRACTOR, WHICH HAVE THE POTENTIAL TO BE RELEASED IN STORMWATER UNLESS PERMISSION FOR THE USE OF A SPECIFIC CHEMICAL IS GRANTED IN WRITING BY THE ECM ADMINISTRATOR. IN GRANTING THE USE OF SUCH CHEMICALS, SPECIAL CONDITIONS AND MONITORING MAY BE REQUIRED.
20. BULK STORAGE STRUCTURES FOR PETROLEUM PRODUCTS AND OTHER CHEMICALS SHALL HAVE ADEQUATE PROTECTION SO AS TO CONTAIN ALL SPILLS AND PREVENT ANY SPILLED MATERIAL FROM ENTERING STATE WATERS, INCLUDING ANY SURFACE OR SUBSURFACE STORM DRAINAGE SYSTEM OR FACILITIES.
21. NO PERSON SHALL CAUSE THE IMPEDIMENT OF STORMWATER FLOW IN THE FLOW LINE OF THE CURB AND GUTTER OR IN THE DITCHLINE.
22. INDIVIDUALS SHALL COMPLY WITH THE "COLORADO WATER QUALITY CONTROL ACT" (TITLE 25, ARTICLE 8, CRS), AND THE "CLEAN WATER ACT" (33 USC 1344), IN ADDITION TO THE REQUIREMENTS INCLUDED IN THE DCM VOLUME II AND THE ECM APPENDIX I. ALL APPLICABLE PERMITS MUST BE OBTAINED BY THE CONTRACTOR PRIOR TO CONSTRUCTION (NPDES, FLOODPLAIN, 404, FUGITIVE DUST, ETC.). IN THE EVENT OF CONFLICTS BETWEEN THESE REQUIREMENTS AND LAWS, RULES, OR REGULATIONS OF OTHER FEDERAL, STATE, OR COUNTY AGENCIES, THE MORE RESTRICTIVE LAWS, RULES, OR REGULATIONS SHALL APPLY.
23. ALL CONSTRUCTION TRAFFIC MUST ENTER/EXIT THE SITE AT APPROVED CONSTRUCTION ACCESS POINTS.
24. PRIOR TO ACTUAL CONSTRUCTION THE PERMITTEE SHALL VERIFY THE LOCATION OF EXISTING UTILITIES.
25. A WATER SOURCE SHALL BE AVAILABLE ON SITE DURING EARTHWORK OPERATIONS AND UTILIZED AS REQUIRED TO MINIMIZE DUST FROM EARTHWORK EQUIPMENT AND WIND.
26. THE SOILS REPORT FOR THIS SITE HAS BEEN PREPARED BY ENTECH ENGINEERING, INC. AND SHALL BE CONSIDERED A PART OF THESE PLANS.
27. AT LEAST TEN DAYS PRIOR TO THE ANTICIPATED START OF CONSTRUCTION, FOR PROJECTS THAT WILL DISTURB 1 ACRE OR MORE, THE OWNER OR OPERATOR OF CONSTRUCTION ACTIVITY SHALL SUBMIT A PERMIT APPLICATION FOR STORMWATER DISCHARGE TO THE COLORADO DEPARTMENT OF PUBLIC HEALTH AND ENVIRONMENT, WATER QUALITY DIVISION, THE APPLICATION CONTAINS CERTIFICATION OF COMPLETION OF A STORMWATER MANAGEMENT PLAN (SWMP), OF WHICH THIS GRADING AND EROSION CONTROL PLAN MAY BE A PART. FOR INFORMATION OR APPLICATION MATERIALS CONTACT:

COLORADO DEPARTMENT OF PUBLIC HEALTH AND ENVIRONMENT  
WATER QUALITY CONTROL DIVISION, WQCD - PERMITS  
4300 CRENSHAW DRIVE SOUTH  
DENVER, CO 80246-1520  
ATTN: PERMIT UNIT

STANDARD EL PASO COUNTY CONSTRUCTION PLAN NOTES

1. ALL DRAINAGE AND ROADWAY CONSTRUCTION SHALL MEET THE STANDARDS AND SPECIFICATIONS OF THE CITY OF COLORADO SPRINGS/EL PASO COUNTY DRAINAGE CRITERIA MANUAL, VOLUMES 1 AND 2, AND THE EL PASO COUNTY ENGINEERING CRITERIA MANUAL.
2. CONTRACTOR SHALL BE RESPONSIBLE FOR THE NOTIFICATION AND FIELD NOTIFICATION OF ALL EXISTING UTILITIES, WHETHER SHOWN ON THE PLANS OR NOT, BEFORE BEGINNING CONSTRUCTION. LOCATION OF EXISTING UTILITIES SHALL BE VERIFIED BY THE CONTRACTOR PRIOR TO CONSTRUCTION. CALL 811 TO CONTACT THE UTILITY NOTIFICATION CENTER OF COLORADO (UNCC).
3. CONTRACTOR SHALL KEEP A COPY OF THESE APPROVED PLANS, THE GRADING AND EROSION CONTROL PLAN, THE STORMWATER MANAGEMENT PLAN (SWMP), THE SOILS AND GEOTECHNICAL REPORT, AND THE APPROPRIATE DESIGN AND CONSTRUCTION STANDARDS AND SPECIFICATIONS AT THE JOB SITE AT ALL TIMES, INCLUDING THE FOLLOWING:  
a. EL PASO COUNTY ENGINEERING CRITERIA MANUAL [ECM]  
b. CITY OF COLORADO SPRINGS/EL PASO COUNTY DRAINAGE CRITERIA MANUAL, VOLUMES 1 AND 2  
c. COLORADO DEPARTMENT OF TRANSPORTATION (CDOT) STANDARD SPECIFICATIONS FOR ROAD AND BRIDGE CONSTRUCTION  
d. CDOT M & S STANDARDS
4. NOTWITHSTANDING ANYTHING DEPICTED IN THESE PLANS IN WORDS OR GRAPHIC REPRESENTATION, ALL DESIGN AND CONSTRUCTION RELATED TO ROADS, STORM DRAINAGE AND EROSION CONTROL SHALL CONFORM TO THE STANDARDS AND REQUIREMENTS OF THE MOST RECENT VERSION OF THE RELEVANT ADOPTED EL PASO COUNTY STANDARDS, INCLUDING THE LAND DEVELOPMENT CODE, THE ENGINEERING CRITERIA MANUAL, THE DRAINAGE CRITERIA MANUAL, AND THE DRAINAGE CRITERIA MANUAL VOLUME 2. ANY DEVIATIONS FROM REGULATIONS AND STANDARDS MUST BE REQUESTED, AND APPROVED, IN WRITING. ANY MODIFICATIONS NECESSARY TO MEET CRITERIA AFTER THE FACT WILL BE ENTIRELY THE DEVELOPER'S RESPONSIBILITY TO RECTIFY.
5. IT IS THE DESIGN ENGINEER'S RESPONSIBILITY TO ACCURATELY SHOW EXISTING CONDITIONS, BOTH ONSITE AND OFFSITE, ON THE CONSTRUCTION PLANS. ANY MODIFICATIONS NECESSARY DUE TO CONFLICTS, OMISSIONS, OR CHANGED CONDITIONS WILL BE ENTIRELY THE DEVELOPER'S RESPONSIBILITY TO RECTIFY.
6. CONTRACTOR SHALL SCHEDULE A PRE-CONSTRUCTION MEETING WITH EL PASO COUNTY DEVELOPMENT SERVICES DEPARTMENT (DSD) - INSPECTIONS, PRIOR TO STARTING CONSTRUCTION.
7. IT IS THE CONTRACTOR'S RESPONSIBILITY TO UNDERSTAND THE REQUIREMENTS OF ALL JURISDICTIONAL AGENCIES AND TO OBTAIN ALL REQUIRED BUT NOT LIMITED TO EL PASO COUNTY ENGINEERING CRITERIA MANUAL, U.S. ARMY CORPS OF ENGINEERS-ISSUED 401 AND/OR 404 PERMITS, AND COUNTY AND STATE FUGITIVE DUST PERMITS.
8. CONTRACTOR SHALL NOT DEViate FROM THE PLANS WITHOUT FIRST OBTAINING WRITTEN APPROVAL FROM THE DESIGN ENGINEER AND DSD. CONTRACTOR SHALL NOTIFY THE DESIGN ENGINEER IMMEDIATELY UPON DISCOVERY OF ANY ERRORS OR INCONSISTENCIES.
9. ALL STORM DRAIN PIPE SHALL BE CLASS II RCP UNLESS OTHERWISE NOTED AND APPROVED BY DSD.
10. CONTRACTOR SHALL COORDINATE GEOTECHNICAL TESTING PER ECM STANDARDS. PAVEMENT DESIGN SHALL BE APPROVED BY EL PASO COUNTY DSD PRIOR TO PLACEMENT OF CURB AND GUTTER AND PAVEMENT.
11. ALL CONSTRUCTION TRAFFIC MUST ENTER/EXIT THE SITE AT APPROVED CONSTRUCTION ACCESS POINTS.
12. SIGHT VISIBILITY TRIANGLES AS IDENTIFIED IN THE PLANS SHALL BE PROVIDED AT ALL INTERSECTIONS. OBSTRUCTIONS GREATER THAN 18 INCHES ABOVE FLOWLINE ARE NOT ALLOWED WITHIN SIGHT TRIANGLES.
13. SIGNING AND STRIPING SHALL COMPLY WITH EL PASO COUNTY DOT AND MUTCD CRITERIA. [IF APPLICABLE, ADDITIONAL SIGNING AND STRIPING NOTES WILL BE PROVIDED.]
14. CONTRACTOR SHALL OBTAIN ANY PERMITS REQUIRED BY EL PASO COUNTY DOT, INCLUDING WORK WITHIN THE RIGHT-OF-WAY AND SPECIAL TRANSPORT PERMITS.
15. THE LIMITS OF CONSTRUCTION SHALL REMAIN WITHIN THE PROPERTY LINE UNLESS OTHERWISE NOTED. THE OWNER/DEVELOPER SHALL OBTAIN WRITTEN PERMISSION AND EASEMENTS, WHERE REQUIRED, FROM ADJOINING PROPERTY OWNER(S) PRIOR TO ANY OFF-SITE DISTURBANCE, GRADING, OR CONSTRUCTION.

STANDARD EL PASO COUNTY SIGNING AND STRIPING NOTES

1. ALL SIGNS AND PAVEMENT MARKINGS SHALL BE IN COMPLIANCE WITH THE CURRENT MANUAL ON UNIFORM TRAFFIC CONTROL DEVICES (MUTCD).
2. REMOVAL OF EXISTING PAVEMENT MARKINGS SHALL BE ACCOMPLISHED BY A METHOD THAT DOES NOT MATERIALLY DAMAGE THE PAVEMENT. THE PAVEMENT MARKINGS SHALL BE REMOVED TO THE EXTENT THAT THEY WILL NOT BE VISIBLE UNDER DAY OR NIGHT CONDITIONS. AT NO TIME WILL IT BE ACCEPTABLE TO PAINT OVER EXISTING PAVEMENT MARKINGS.
3. ANY DEVIATION FROM THE STRIPING AND SIGNING PLAN SHALL BE APPROVED BY EL PASO COUNTY DEVELOPMENT SERVICES.
4. ALL SIGNS SHOWN ON THE SIGNING AND STRIPING PLAN SHALL BE NEW SIGNS. EXISTING SIGNS MAY REMAIN OR BE REUSED IF THEY MEET CURRENT EL PASO COUNTY AND MUTCD STANDARDS.
5. STREET NAME AND REGULATORY STOP SIGNS SHALL BE ON THE SAME POST AT INTERSECTIONS.
6. ALL REMOVED SIGNS SHALL BE DISPOSED OF IN A PROPER MANNER BY THE CONTRACTOR.
7. ALL STREET NAME SIGNS SHALL HAVE "C" SERIES LETTERS, WITH LOCAL ROADWAY SIGNS BEING 4" UPPER-LOWER CASE LETTERING ON 8" BLANK AND COLLECTOR ROADWAY SIGNS BEING 6" LETTERING, UPPER-LOWER CASE ON 12" BLANK, WITH 1/2" WHITE BORDER THAT IS NOT RECESSED.
8. ALL TRAFFIC SIGNS SHALL HAVE A MINIMUM HIGH INTENSITY PRISMATIC GRADE SHEETING.
9. ALL LOCAL RESIDENTIAL STREET SIGNS SHALL BE MOUNTED ON A 1.75" X 1.75" SQUARE TUBE SIGN POST AND STUB POST BASE. FOR OTHER APPLICATIONS, REFER TO THE CDOT STANDARD S-614-B REGARDING USE OF THE P2 TUBULAR STEEL POST SUPBASE DESIGN.
10. ALL SIGNS SHALL BE SINGLE SHEET ALUMINUM WITH 0.100" MINIMUM THICKNESS.
11. ALL LIMIT LINES/STOP LINES, CROSSWALK LINES, PAVEMENT LEGENDS, AND ARROWS SHALL BE A MINIMUM 125 MIL THICKNESS PREFORMED THERMOPLASTIC PAVEMENT MARKINGS WITH TAPERED LEADING EDGES PER CDOT STANDARD S-627-1. WORD AND SYMBOL MARKINGS SHALL BE THE NARROW TYPE. STOP BARS SHALL BE 24" IN WIDTH. CROSSWALKS LINES SHALL BE 12" WIDE AND 8" LONG PER CDOT S-627-1.
12. ALL LONGITUDINAL LINES SHALL BE A MINIMUM 15MIL THICKNESS EPOXY PAINT. ALL NON-LOCAL RESIDENTIAL ROADWAYS SHALL INCLUDE BOTH RIGHT AND LEFT EDGE LINE STRIPING AND ANY ADDITIONAL STRIPING AS REQUIRED BY CDOT S-647-1.
13. THE CONTRACTOR SHALL NOTIFY EL PASO COUNTY DEVELOPMENT SERVICES (719) 520-6819 PRIOR TO AND UPON COMPLETION OF SIGNING AND STRIPING.
14. THE CONTRACTOR SHALL OBTAIN A WORK IN THE RIGHT OF WAY PERMIT FROM THE EL PASO COUNTY DEPARTMENT OF TRANSPORTATION PRIOR TO ANY SIGNAGE OR STRIPING WORK WITHIN AN EXISTING EL PASO COUNTY ROADWAY.

TOPOGRAPHIC SURVEY NOTES

- 1.] THE EXISTING TOPOGRAPHIC BASE MAPPING WAS PREPARED BY LANDMARK MAPPING, LTD. INC. USING AERIAL PHOTOGRAPHIC DATA GATHERED ON JUNE 25, 2015.
- 2.] ALL EXISTING UTILITIES SHOWN ON THIS SURVEY ARE FROM SURFACE EVIDENCE AND/OR FROM MAPS OBTAINED FROM UTILITY PROVIDERS. THE LOCATION OF UTILITIES AS SHOWN ARE APPROXIMATE. ALL UTILITIES MAY NOT BE SHOWN OR MAY NOT HAVE BEEN LOCATED. UNDERGROUND UTILITY LOCATIONS WERE NOT PERFORMED.

PROJECT CONTROL:

BASIS OF BEARINGS: THE SOUTH LINE OF THE NORTHWEST QUARTER OF SECTION 21, TOWNSHIP 11 SOUTH, RANGE 66 WEST OF THE 6TH P.M., EL PASO COUNTY, COLORADO, S88°46'41"W A DISTANCE OF 2639.80 FEET AND MONUMENTED BY A 2 1/2" DIAMETER ALUMINUM CAP LS #23890 ON THE EAST AND A 2 1/2" DIAMETER ALUMINUM CAP LS # 9853 ON THE WEST

EAST MONUMENT:  
NORTHING: 5655.29'  
EASTING: 7639.19'

WEST MONUMENT:  
NORTHING: 5000.00'  
EASTING: 5000.00'


BENCHMARK: THE BENCHMARK FOR THESE PLANS IS THE TOP OF PANEL POINT "SW", LOCATED NORTHWEST OF ROLLER COASTER ROAD & HIGBY ROAD, NORTHING: 5061.61; EASTING: 4958.09; ELEVATION = 7461.14' (NAVDB88).

THE SOILS REPORT FOR THIS SITE HAS BEEN PREPARED BY ENTECH ENGINEERING, INC. AND SHALL BE CONSIDERED A PART OF THESE PLANS.


CALL BEFORE YOU DIG...  
1-800-922-1987



48 HOURS BEFORE YOU DIG, CALL UTILITY LOCATORS FOR GAS, ELECTRIC, WATER, AND SEWER

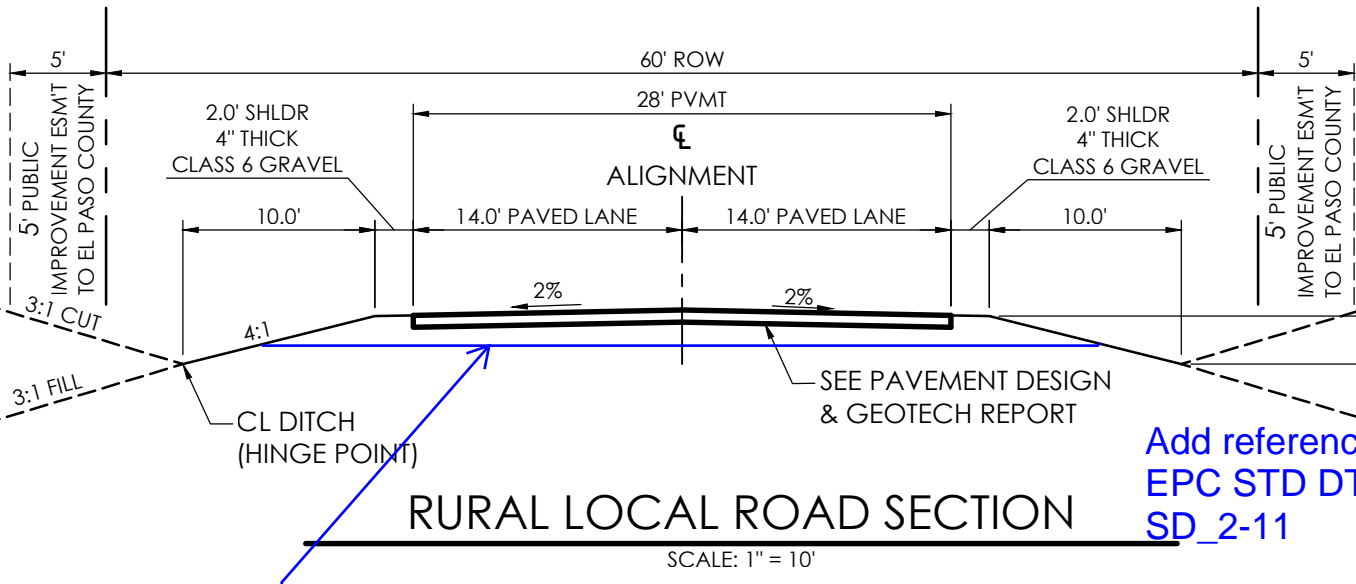


Show aggregate base course.

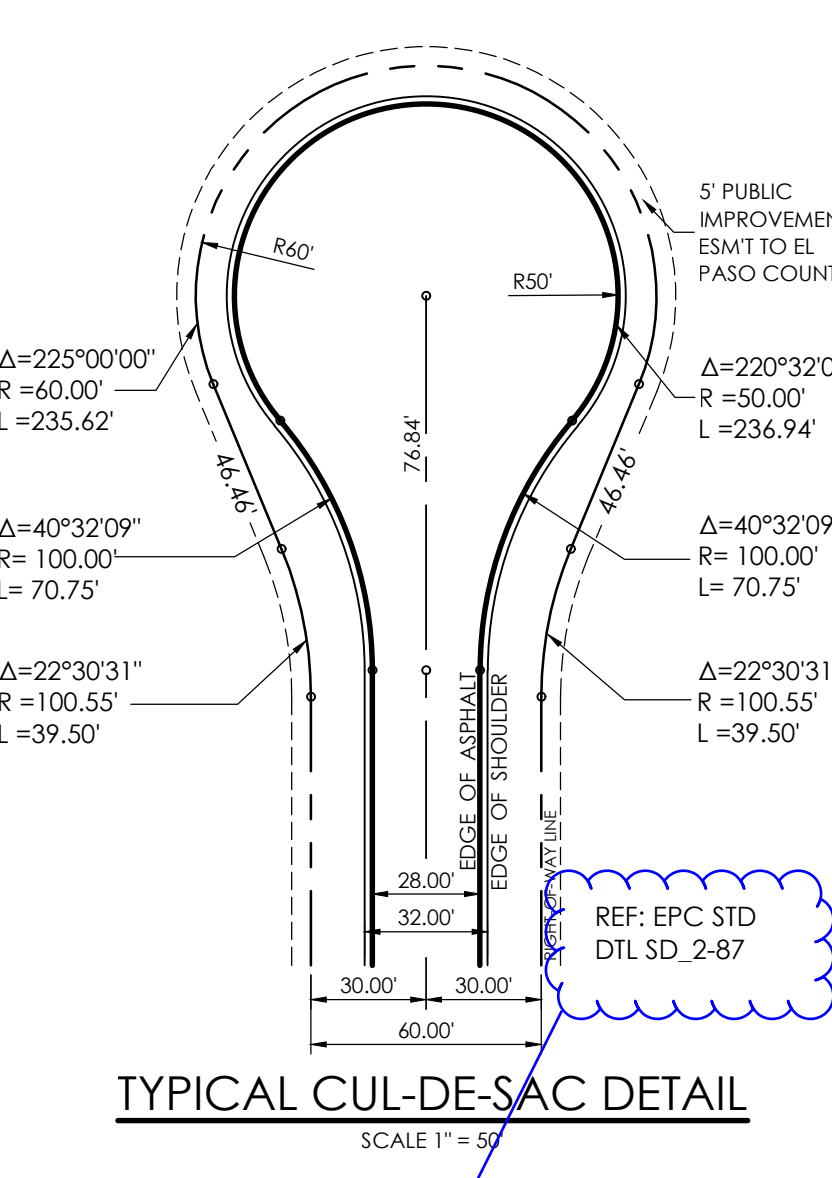


Revise to SD-2-76

RIP-RAP GRADATION TABLE	
% SMALLER BY WEIGHT	TYPE VL SPECIAL INTER ROCK DIM.(INCHES)
70 - 100	d <sub>100</sub> = 8
50 - 70	d <sub>70</sub> = 6
35 - 50	d <sub>30</sub> = 3
2 - 10	d <sub>10</sub> = 2

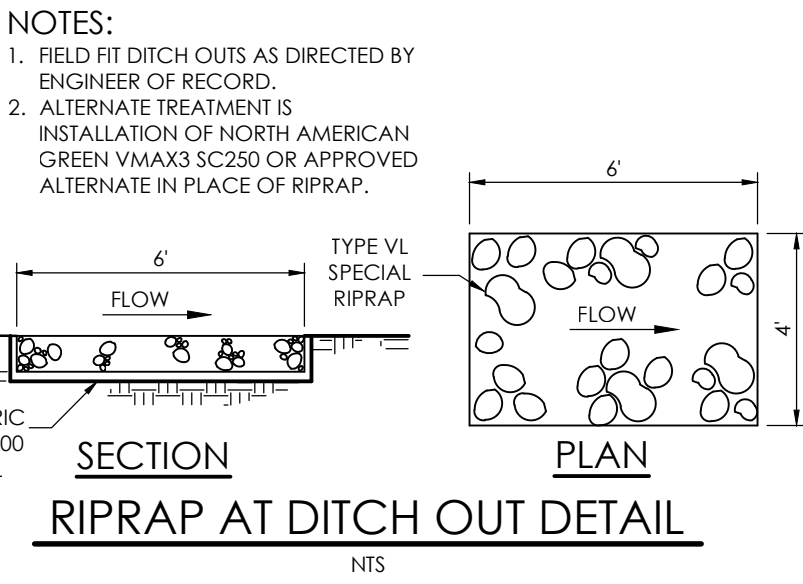


PLAN

NTS

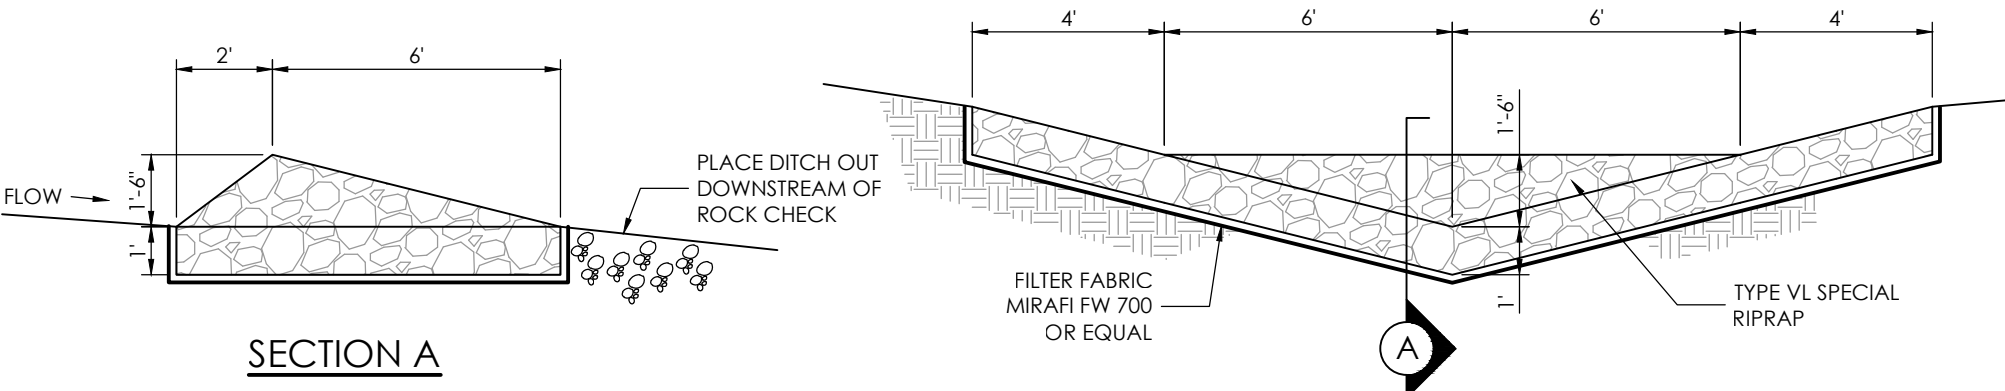


ROCK CHECK DETAIL

NTS

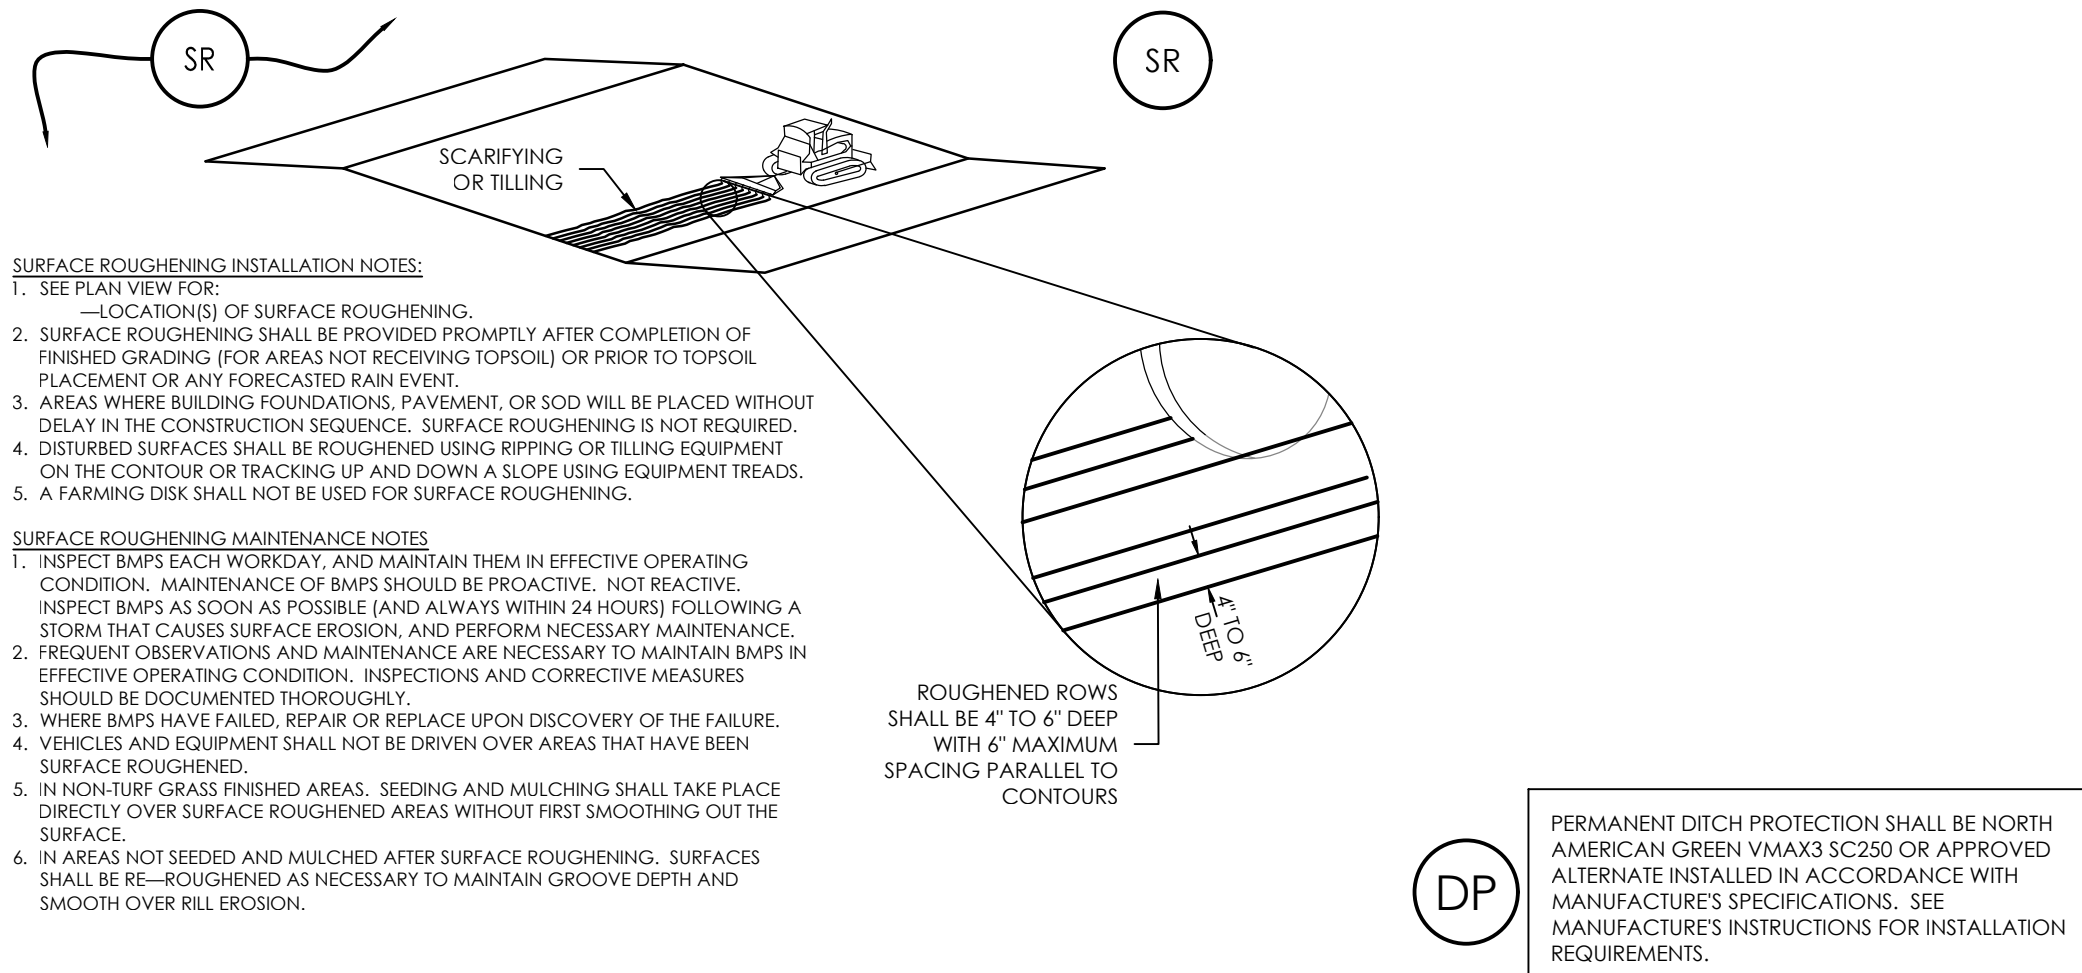


SR-2. SURFACE ROUGHENING FOR LOW SLOPES (LESS THAN 3:1)

PERMANENT DITCH PROTECTION FOR LOW SLOPES (LESS THAN 3:1)

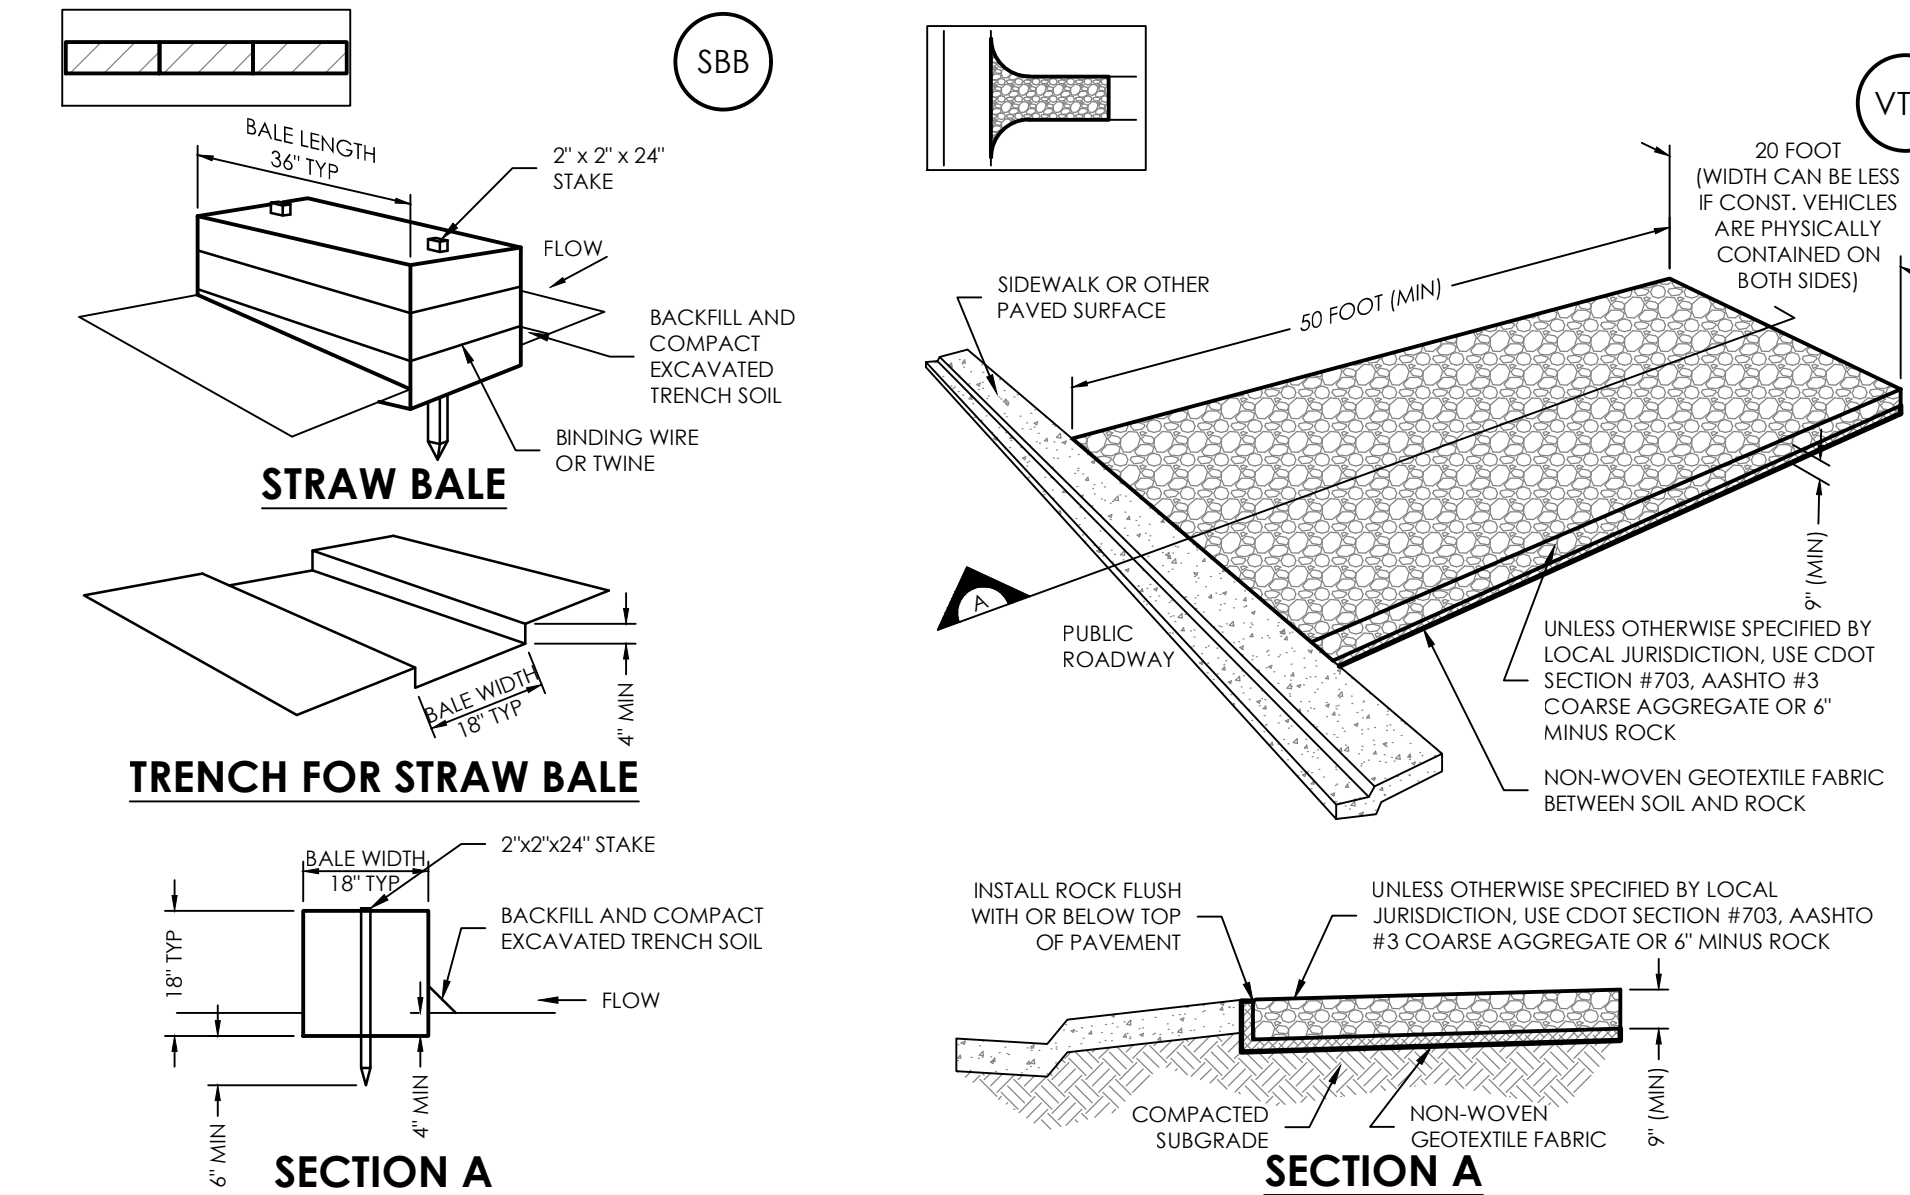


SECTION A

SBB-1. STRAW BALE

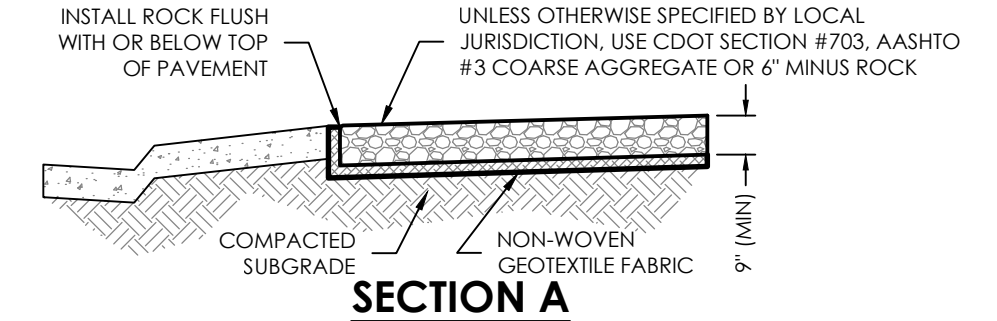

SECTION A

VTC-1. AGGREGATE VEHICLE TRACKING CONTROL

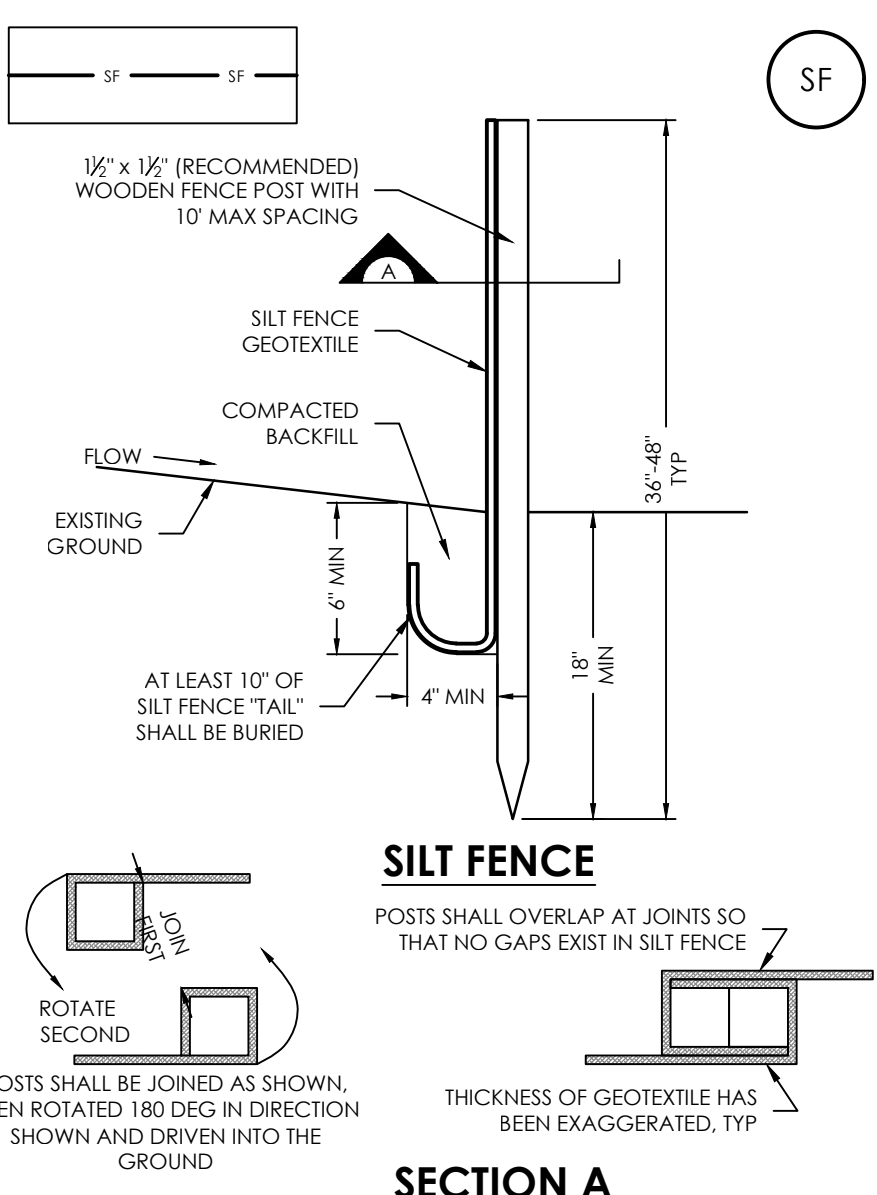

SECTION A

SF-1. SILT FENCE

STRAW BALE INSTALLATION NOTES:

1. SEE PLAN VIEW FOR —LOCATION(S) OF STRAW BALES.
2. STRAW BALES SHALL CONSIST OF CERTIFIED WOOD FREE STRAW OR HAY. LOCAL JURISDICTIONS MAY REQUIRE PROOF THAT BALES ARE WOOD FREE.
3. STRAW BALES SHALL CONSIST OF APPROXIMATELY 5 CUBIC FEET OF STRAW OR HAY AND WEIGH NOT LESS THAN 15 POUNDS.
4. WHEN STRAW BALES ARE USED IN SERIES AS A BARRIER, THE END OF EACH BALE SHALL BE TIGHTLY ABUTTING ONE ANOTHER.
5. STRAW BALE DIMENSIONS SHALL BE APPROXIMATELY 36"X18"X18".
6. A UNIFORM ANCHOR TRENCH SHALL BE EXCAVATED TO A DEPTH OF 4". STRAW BALES SHALL BE PLACED SO THAT BINDING TWINE IS ENCOMPASSING THE VERTICAL Sides OF THE BALES. ALL EXCAVATED SOIL SHALL BE PLACED ON THE UPDRILL SIDE OF THE STRAW BALES AND COMPACTED.
7. TWO (2) WOODEN STAKES SHALL BE USED TO HOLD EACH BALE IN PLACE. WOODEN STAKES SHALL BE 2"x2"x4". WOODEN STAKES SHALL BE DRIVEN 6" INTO THE GROUND.

STRAW BALE MAINTENANCE NOTES:

1. INSPECT BMPs EACH WORKDAY, AND MAINTAIN THEM IN EFFECTIVE OPERATING CONDITION. MAINTENANCE OF BMPs SHOULD BE PROACTIVE, NOT REACTIVE. INSPECT BMPs AS SOON AS POSSIBLE (AND ALWAYS WITHIN 24 HOURS) FOLLOWING A STORM THAT CAUSES SURFACE EROSION, AND PERFORM NECESSARY MAINTENANCE.
2. FREQUENT OBSERVATIONS AND MAINTENANCE ARE NECESSARY TO MAINTAIN BMPs IN EFFECTIVE OPERATING CONDITION. INSPECTIONS AND CORRECTIVE MEASURES SHOULD BE DOCUMENTED THOROUGHLY.
3. WHERE BMPs HAVE FAILED, REPAIR OR REPLACEMENT SHOULD BE INITIATED UPON DISCOVERY OF THE FAILURE.
4. STRAW BALES SHALL BE REPLACED IF THEY BECOME HEAVILY SOILED, ROTTEN, OR DAMAGED BEYOND REPAIR.
5. SEDIMENT ACCUMULATED UPSTREAM OF STRAW BALE BARRIER SHALL BE REMOVED AS NEEDED TO MAINTAIN FUNCTIONALITY OF THE BMP. TYPICALLY WHEN DEPTH OF ACCUMULATED SEDIMENTS IS APPROXIMATELY 1/4" OF THE HEIGHT OF THE STRAW BALE BARRIER.
6. STRAW BALES ARE TO REMAIN IN PLACE UNTIL THE UPSTREAM DISTURBED AREA IS STABILIZED AND APPROVED BY THE LOCAL JURISDICTION.
7. WHEN STRAW BALES ARE REMOVED, ALL DISTURBED AREAS SHALL BE COVERED WITH TOPSOIL, SEEDING AND MULCHED OR OTHERWISE STABILIZED AS APPROVED BY LOCAL JURISDICTION.


STABILIZED CONSTRUCTION ENTRANCE/EXIT INSTALLATION NOTES:

1. SEE PLAN VIEW FOR —LOCATION OF CONSTRUCTION ENTRANCE(S)/EXIT(S).
2. TYPE OF CONSTRUCTION ENTRANCE(S)/EXIT(S) (WITH/WITHOUT WHEEL ASH CONSTRUCTION MAT OR TRIM).
3. CONSTRUCTION MAT OR TRIM STABILIZED CONSTRUCTION ENTRANCES ARE ONLY TO BE USED ON SHORT DURATION PROJECTS (TYPICALLY RANGING FROM A WEEK TO A MONTH) WHERE THERE WILL BE LIMITED VEHICULAR ACCESS.
4. A STABILIZED CONSTRUCTION ENTRANCE/EXIT SHALL BE LOCATED AT ALL ACCESS POINTS WHERE VEHICLES ACCESS THE CONSTRUCTION SITE FROM PAVED ROADS ORWAYS.
5. STABILIZED CONSTRUCTION ENTRANCE/EXIT SHALL BE INSTALLED PRIOR TO ANY LAND DISTURBING ACTIVITIES.
6. A NON-WOVEN GEOTEXTILE FABRIC SHALL BE PLACED UNDER THE STABILIZED CONSTRUCTION ENTRANCE/EXIT PRIOR TO THE PLACEMENT OF ROCK.
7. UNLESS OTHERWISE SPECIFIED BY LOCAL JURISDICTION, ROCK SHALL CONSIST OF DOT SECT. #703, AASHTO #3 COARSE AGGREGATE OR 6" MINUS ROCK.

STABILIZED CONSTRUCTION ENTRANCE EXIT MAINTENANCE NOTES:

1. INSPECT BMPs EACH WORKDAY, AND MAINTAIN THEM IN EFFECTIVE OPERATING CONDITION. MAINTENANCE OF BMPs SHOULD BE PROACTIVE, NOT REACTIVE. INSPECT BMPs AS SOON AS POSSIBLE (AND ALWAYS WITHIN 24 HOURS) FOLLOWING A STORM THAT CAUSES SURFACE EROSION, AND PERFORM NECESSARY MAINTENANCE.
2. FREQUENT OBSERVATIONS AND MAINTENANCE ARE NECESSARY TO MAINTAIN BMPs IN EFFECTIVE OPERATING CONDITION. INSPECTIONS AND CORRECTIVE MEASURES SHOULD BE DOCUMENTED THOROUGHLY.
3. WHERE BMPs HAVE FAILED, REPAIR OR REPLACEMENT SHOULD BE INITIATED UPON DISCOVERY OF THE FAILURE.
4. ROCK SHALL BE REPLACED OR REGRADED AS NECESSARY TO THE STABILIZED ENTRANCE/EXIT TO MAINTAIN A CONSISTENT DEPTH.
5. SEDIMENT TRACKED ONTO PAVED ROADS IS TO BE REMOVED THROUGHOUT THE DAY AND AT THE END OF THE DAY BY SHOVELING OR SWEEPING. SEDIMENT MAY NOT BE WASHED DOWN STORM SEWER DRAINS.

- NOTES:
1. FIELD FIT DITCH CUTS AS DIRECTED BY ENGINEER OF RECORD.
2. ALTERNATE TREATMENT IS INSTALLATION OF NORTH AMERICAN GREEN VMX3 SC250 OR APPROVED ALTERNATE IN PLACE OF RIPRAP.

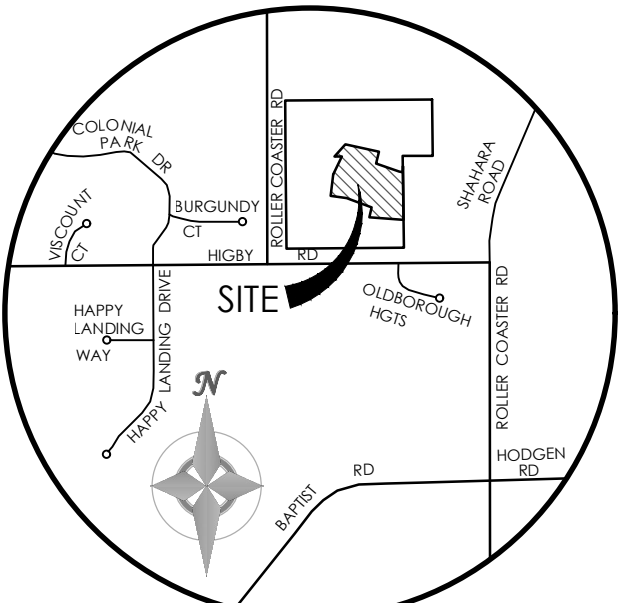

VICINITY MAP

BENCHMARK: NOT TO SCALE

THE BENCHMARK FOR THESE PLANS IS THE TOP OF PANEL POINT "SW", LOCATED NORTHWEST OF ROLLER COASTER ROAD & HIGBY ROAD. ELEVATION = 7461.14' (NAVDB88).

BASIS OF BEARINGS

THE SOUTH LINE OF THE NORTHWEST QUARTER OF SECTION 21, TOWNSHIP 11 SOUTH, RANGE 66 WEST OF THE 6TH P.M., EL PASO COUNTY, COLORADO, S88°46'41"W A DISTANCE OF 2639.80 FEET AND MONUMENTED BY A 2 1/2" DIAMETER ALUMINUM CAP LS #23890 ON THE EAST AND A 2 1/2" DIAMETER ALUMINUM CAP LS # 9853 ON THE WEST

MVE, INC.  
ENGINEERS, SURVEYORS

1903 Kellary Street, Suite 200 Colorado Springs, CO 80909 719.635.5736

REVISIONS

DESIGNED BY CCC  
DRAWN BY TJW  
CHECKED BY  
AS-BUILT BY  
CHECKED BY

JACKSON RANCH  
FILING NO. 3



GENERAL NOTES  
AND DETAILS

C1.1

MVE PROJECT #1044  
MVE DRAWING CON-GN

APRIL 17, 2017  
SHEET 2 OF 5



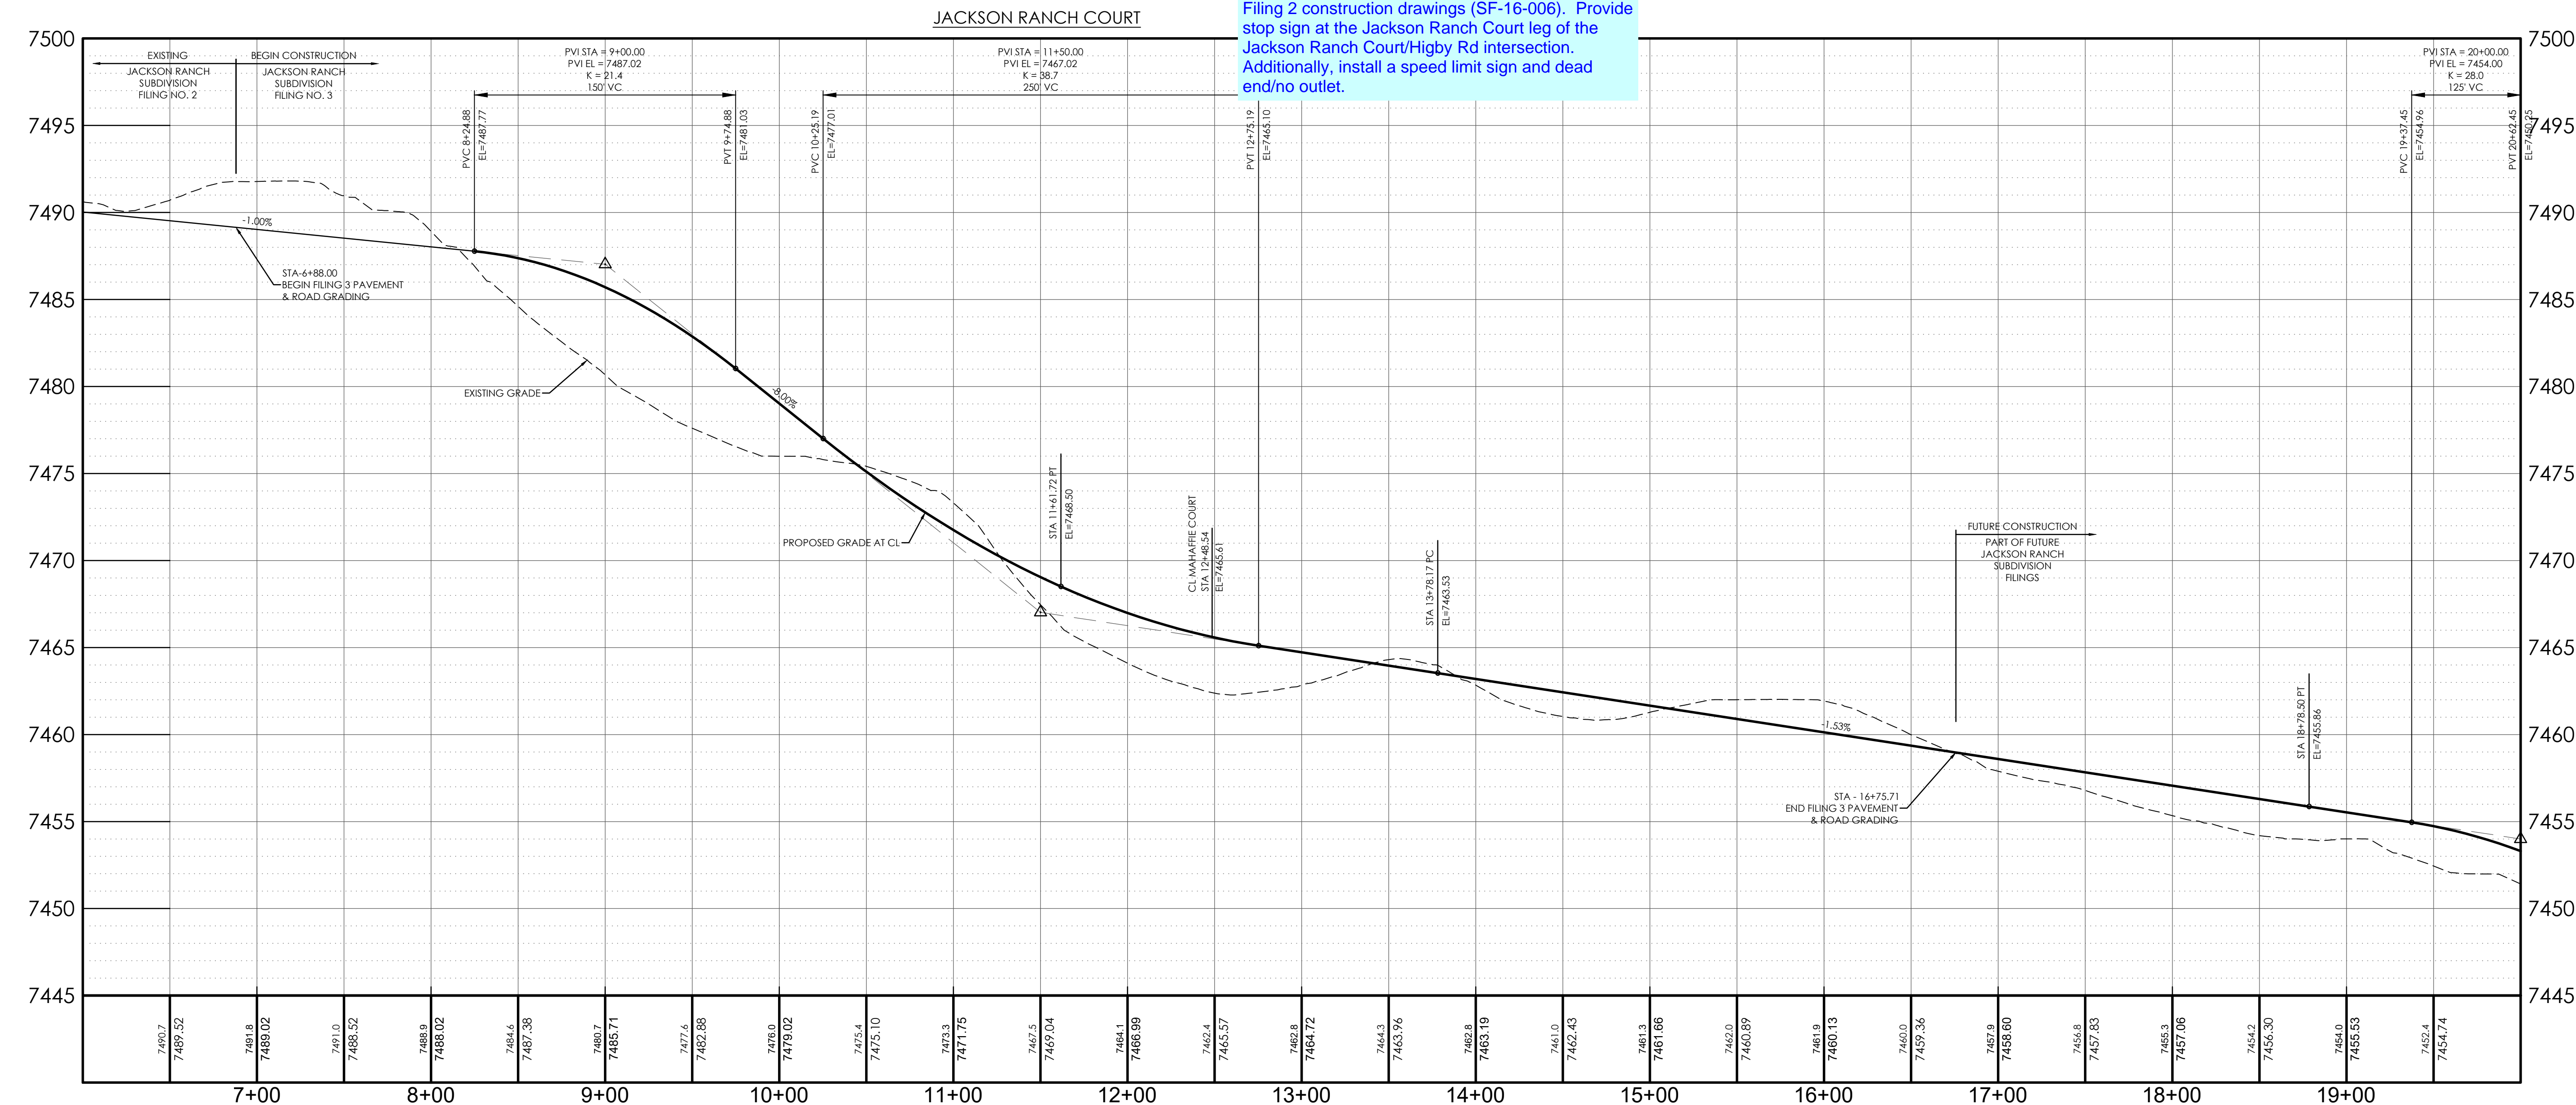
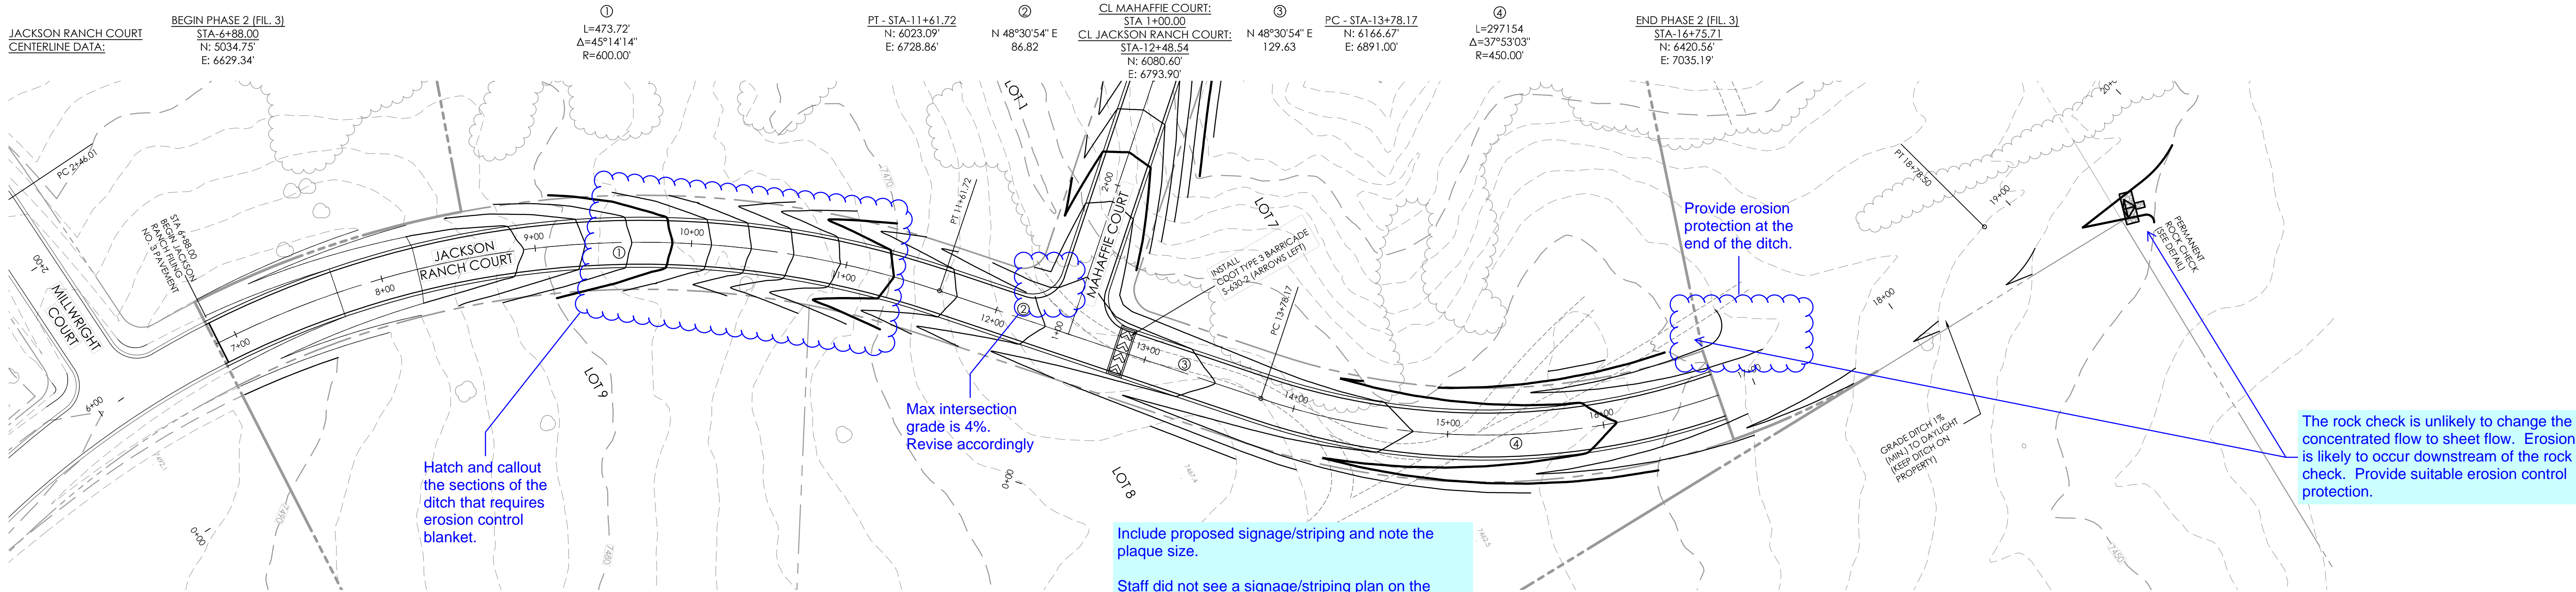


BENCHMARK: THE BENCHMARK FOR THESE PLANS IS THE TOP OF PANEL POINT "SW", LOCATED NORTHWEST OF ROLLER COASTER ROAD & HIGBY ROAD. ELEVATION = 7461.14' (NAVD88).

BASIS OF BEARINGS: THE SOUTH LINE OF THE NORTHWEST QUARTER OF SECTION 21, TOWNSHIP 11 SOUTH, RANGE 66 WEST OF THE 6TH P.M., EL PASO COUNTY, COLORADO, S88°46'41"W A DISTANCE OF 2639.80 FEET AND MONUMENTED BY A 2 1/2" DIAMETER ALUMINUM CAP LS #23890 ON THE EAST AND A 2 1/2" DIAMETER ALUMINUM CAP LS #9853 ON THE WEST

DESIGN DATA:  
SIDEWALKS: WIDTH N/A  
LOCATION: Attached ☐ Detached ☐  
DESIGN SPEED 30 MPH  
CURB TYPE: A ☐ B ☐ C ☐ D ☐  
ROW WIDTH: 60' FL-FL 28'  
STREET TYPE: RURAL LOCAL

PAVEMENT:  
TYPE: HMA ☐ PCC ☐  
THICKNESS: \_\_\_\_\_  
COMPOSITE SECTION:  
HMA \_\_\_\_\_ BASE \_\_\_\_\_  
SUBGRADE STABILIZATION:  
CHEMICAL TYPE \_\_\_\_\_ MECHANICAL THICKNESS \_\_\_\_\_

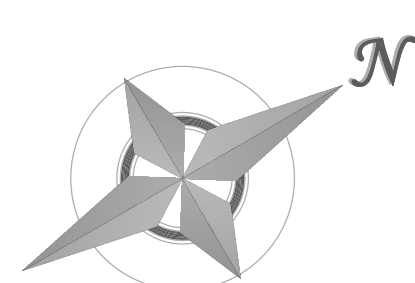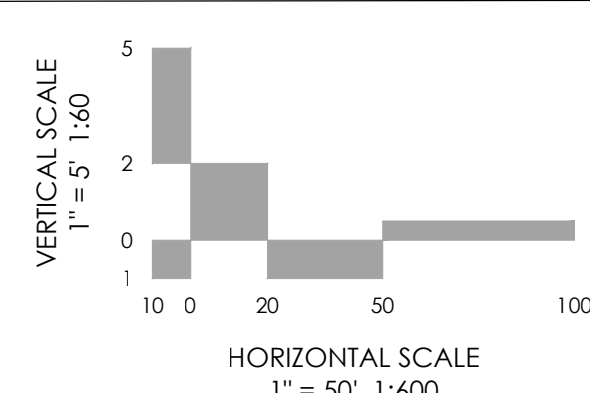

MVE, INC.  
ENGINEERS SURVEYORS

1903 Irlaray street  
colorado springs  
719.635.5736

suite 200  
co 80909  
www.mvecivil.com

REVISIONS

MVE PROJECT **61044**  
MVE DRAWING **-CON-PP1**

APRIL 17, 2017

DESIGNED BY CCC  
DRAWN BY TJW  
CHECKED BY \_\_\_\_\_  
AS-BUILT BY \_\_\_\_\_  
CHECKED BY \_\_\_\_\_

JACKSON RANCH COURT  
FROM STA 6+88.00  
TO STA 12+48.54  
JACKSON RANCH FILING NO. 3  
C1.2  
SHEET 3 OF 5









- EROSION CONTROL NOTES
1. ALL DISTURBED AREAS SHALL BE REVEGETATED. SEE GENERAL NOTES FOR SEED MIX AND APPLICATION NOTES.
  2. RIP-RAP APRONS WILL BE PLACED AT ALL CULVERT OUTLETS. (SEE DETAILS FOR RIP-RAP APRONS ON THIS SHEET.)
  3. HAY BALES WILL BE PLACED UPSTREAM OF CULVERTS IN NEW ROADSIDE DITCHES AS DETERMINED IN THE FIELD BY THE ENGINEER.
  4. ALL PERSONS ENGAGED IN EARTH DISTURBANCE SHALL IMPLEMENT AND MAINTAIN ACCEPTABLE SOIL EROSION AND SEDIMENT CONTROL MEASURES INCLUDING BMPs IN CONFORMANCE WITH THIS EROSION CONTROL PLAN AND THE BMP DETAILS SHOWN ON THIS PLAN.
  5. THE INSTALLATION OF THE FIRST LEVEL OF TEMPORARY EROSION CONTROL FACILITIES AND BMPs SHALL BE INSTALLED PRIOR TO ANY EARTH DISTURBANCE OPERATIONS TAKING PLACE.
  6. CONTRACTOR SHALL PROVIDE APPROPRIATE EROSION CONTROL MEASURES DURING EARTHWORK OPERATIONS TO CONTROL EROSION AND SEDIMENT TRANSFER TO ADJACENT PROPERTIES. EROSION CONTROL MEASURES ARE NOT LIMITED TO THOSE NOTED ON THIS PLAN.
  7. SEDIMENT (MUD AND DIRT) TRANSPORTED ONTO A PUBLIC ROAD, REGARDLESS OF THE SIZE OF THE SITE, SHALL BE CLEANED AT THE END OF EACH DAY.

HYDROLOGIC SOIL GROUP	
MAP UNIT NUMBER	DESCRIPTION
92	TOMAH-CROWFOOT LOAMY, HYDROLOGIC SOIL GROUP B, SLIGHT TO MODERATE HAZARD OF EROSION
93	TOMAH-CROWFOOT COMPLEX HYDROLOGIC SOIL GROUP B, MODERATE HAZARD OF EROSION


EROSION CONTROL DATA	
<b>TIMING</b>	
ANTICIPATED START & COMPLETION TIME PERIOD OF SITE GRADING	AUGUST, 2017 TO JANUARY, 2018
EXPECTED DATE ON WHICH FINAL STABILIZATION WILL BE COMPLETED	NOVEMBER, 2018
<b>AREAS</b>	
TOTAL AREA OF SITE	31.8 ACRES
AREA OF THE SITE TO BE CLEARED, EXCAVATED OR GRADED	3.0 ACRES
<b>RECEIVING WATERS</b>	
NAME OF RECEIVING WATERS	CHERRY CREEK
<b>SOIL DATA</b>	
PRIMARY SOIL DESCRIPTION	SEE TABLE
PERMEABILITY	MODERATELY RAPID
SURFACE RUNOFF	SLOW TO MEDIUM
HAZARD OF EROSION	SLIGHT TO MODERATE
HYDROLOGIC SOIL GROUP	B
EXISTING PERCENT IMPERVIOUS	0%
DEVELOPED PERCENT IMPERVIOUS	-
<b>LOCATION</b>	
LATITUDE	39.08160°
LONGITUDE	-104.78865°

BMP LEGEND		
MAP SYMBOL	KEY	DESCRIPTION
	CWA	CONCRETE WASHOUT AREA
	SF	SILT FENCE
	SCL	SEDIMENT CONTROL LOG
	SBB	STRAW BALE BARRIER
	RS	ROCK SOCK
	ECB DP	EROSION CONTROL BLANKET/PERMANENT DITCH PROTECTION
	VTC	VEHICLE TRACKING CONTROL
	SW	STREET SWEEPING
	IP	INLET PROTECTION
	OP	PERMANENT OUTLET PROTECTION (SEE CONSTRUCTION PLANS)
	SSA	STABILIZED STAGING AREA
	MU	MULCHING
	SR	SURFACE ROUGHENING
	PS	PERMANENT SEEDING
		LIMITS OF CONSTRUCTION SITE BOUNDARIES
		LIMITS OF CUT/FILL
		LIMITS OF SOIL TYPE

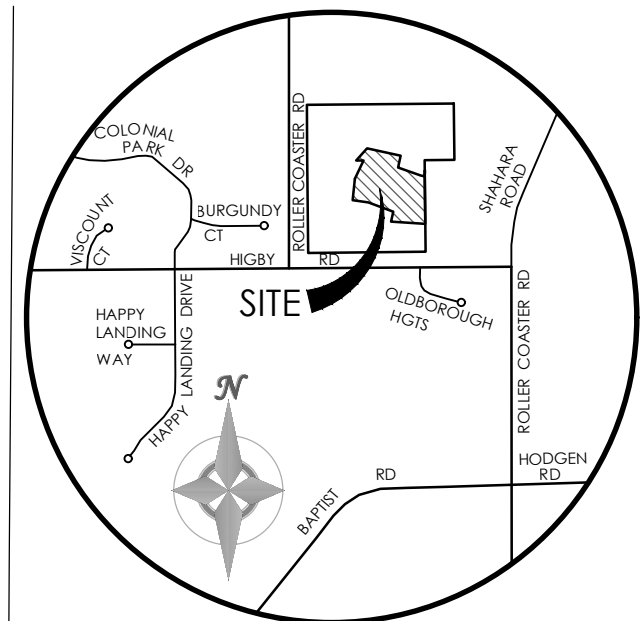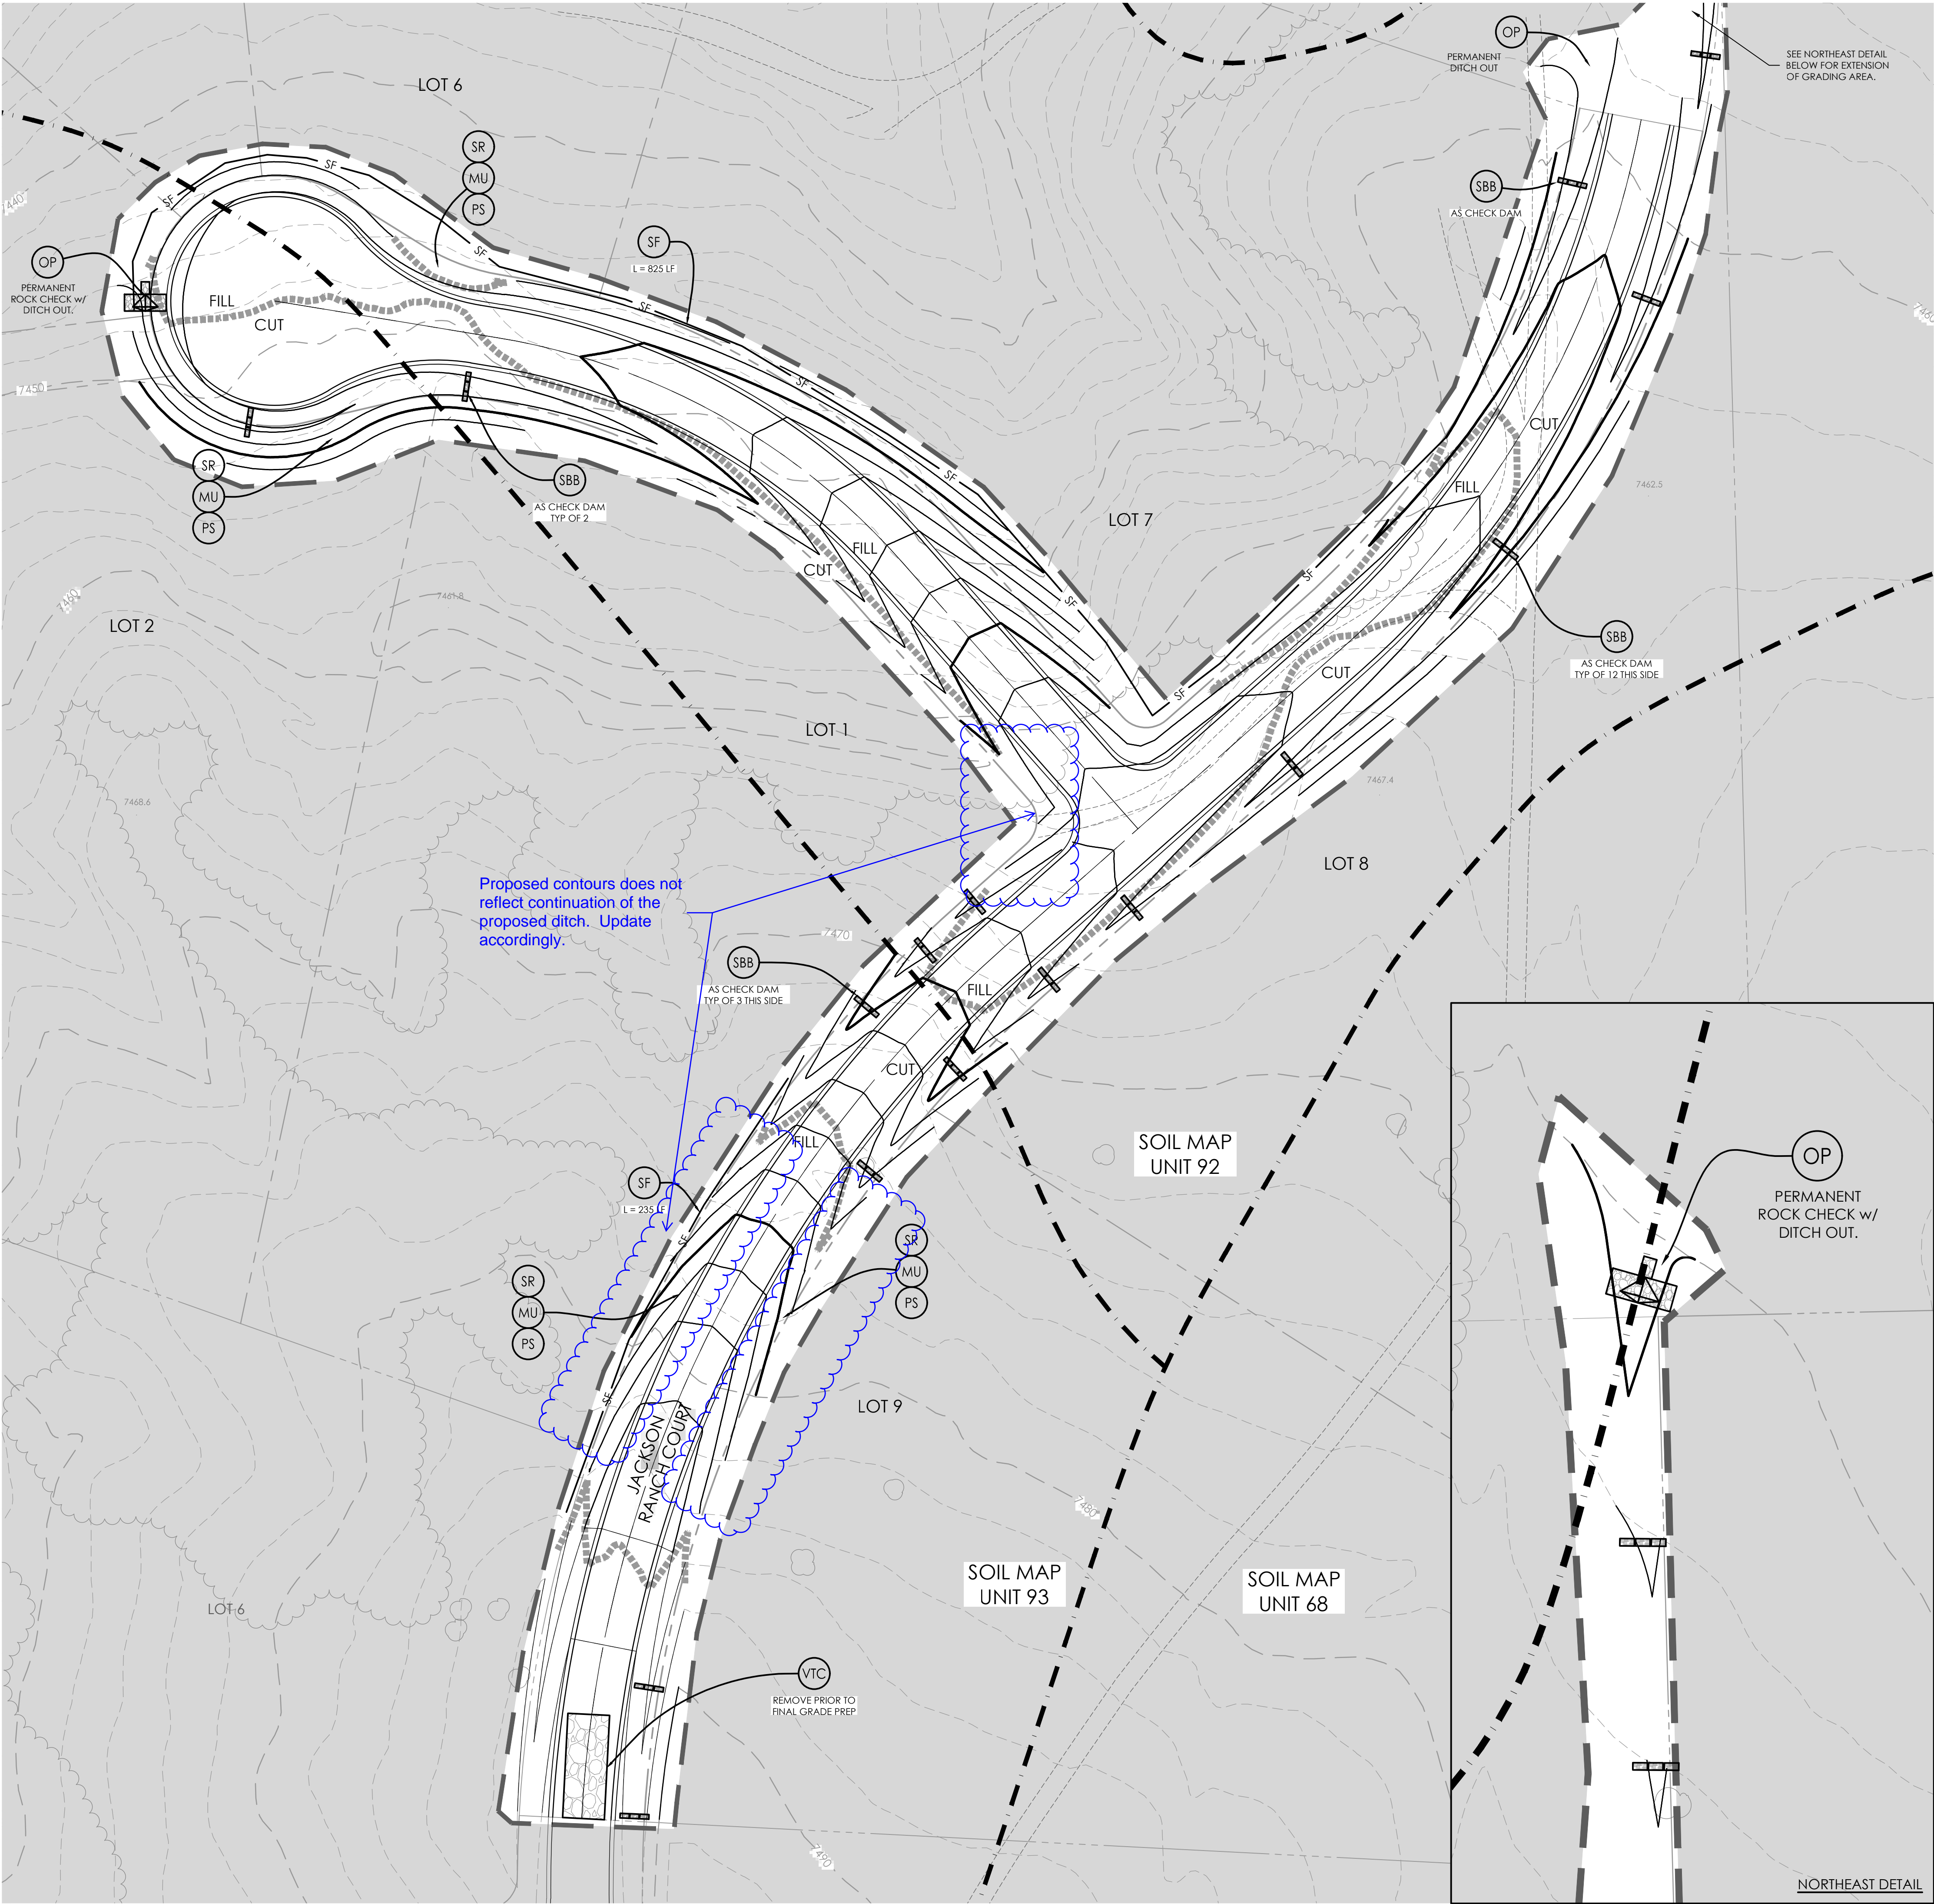

BENCHMARK:  
THE BENCHMARK FOR THESE PLANS IS THE TOP OF PANEL POINT "SW", LOCATED NORTHWEST OF ROLLER COASTER ROAD & HIGBY ROAD. ELEVATION = 7461.14' (NAVD88).

BASIS OF BEARINGS: THE SOUTH LINE OF THE NW QUARTER OF SEC 21, T 11 S, R 86 W OF THE 6TH P.M., EL PASO COUNTY, COLORADO, S88°46'41"W, A DISTANCE OF 2639.80 FEET & MONUMENTED BY A 2 1/2" DIA. ALUMINUM CAP LS #23890 ON THE EAST & A 2 1/2" DIA. ALUMINUM CAP LS # 9853 ON THE WEST

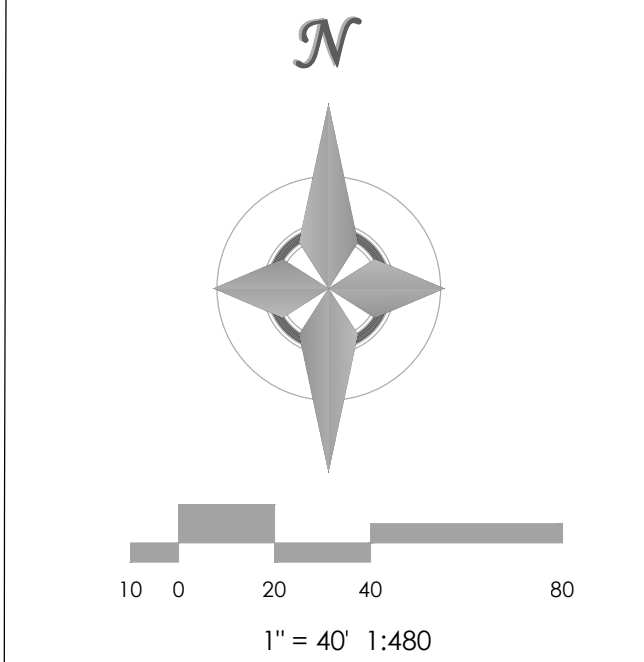

MVE, INC.  
ENGINEERS, SURVEYORS

1903 ledney street, suite 200 colorado springs co 80909 719.635.5736

REVISIONS  
1

DESIGNED BY CCC  
DRAWN BY \_\_\_\_\_  
CHECKED BY \_\_\_\_\_  
AS-BUILTS BY \_\_\_\_\_  
CHECKED BY \_\_\_\_\_

JACKSON RANCH  
FILING NO. 3

EROSION  
CONTROL PLAN  
C1.4




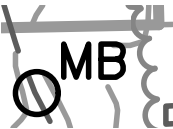


MVE PROJECT #1044  
MVE DRAWING CON-EC

APRIL 17, 2017  
SHEET 5 OF 5



# Markup Summary

AutoCAD SHX Text (72)

	<p><b>Subject:</b></p> <p><b>Page Label:</b> [1] 61044-CON-CS-C1.0</p> <p><b>Lock:</b> Unlocked</p> <p><b>Status:</b></p> <p><b>Checkmark:</b> Unchecked</p> <p><b>Author:</b> AutoCAD SHX Text</p> <p><b>Date:</b></p> <p><b>Color:</b> <input type="checkbox"/></p>	MH
	<p><b>Subject:</b></p> <p><b>Page Label:</b> [1] 61044-CON-CS-C1.0</p> <p><b>Lock:</b> Unlocked</p> <p><b>Status:</b></p> <p><b>Checkmark:</b> Unchecked</p> <p><b>Author:</b> AutoCAD SHX Text</p> <p><b>Date:</b></p> <p><b>Color:</b> <input type="checkbox"/></p>	MB
	<p><b>Subject:</b></p> <p><b>Page Label:</b> [1] 61044-CON-CS-C1.0</p> <p><b>Lock:</b> Unlocked</p> <p><b>Status:</b></p> <p><b>Checkmark:</b> Unchecked</p> <p><b>Author:</b> AutoCAD SHX Text</p> <p><b>Date:</b></p> <p><b>Color:</b> <input type="checkbox"/></p>	R
	<p><b>Subject:</b></p> <p><b>Page Label:</b> [1] 61044-CON-CS-C1.0</p> <p><b>Lock:</b> Unlocked</p> <p><b>Status:</b></p> <p><b>Checkmark:</b> Unchecked</p> <p><b>Author:</b> AutoCAD SHX Text</p> <p><b>Date:</b></p> <p><b>Color:</b> <input type="checkbox"/></p>	MH




Subject:  
Page Label: [2] 61044-CON-GN-C1.1 YOU  
Lock: Unlocked  
Status:  
Checkmark: Unchecked  
Author: AutoCAD SHX Text  
Date:  
Color: ☐



Subject:  
Page Label: [2] 61044-CON-GN-C1.1 O  
Lock: Unlocked  
Status:  
Checkmark: Unchecked  
Author: AutoCAD SHX Text  
Date:  
Color: ☐



Subject:  
Page Label: [2] 61044-CON-GN-C1.1 T  
Lock: Unlocked  
Status:  
Checkmark: Unchecked  
Author: AutoCAD SHX Text  
Date:  
Color: ☐

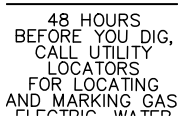

Subject:  
Page Label: [2] 61044-CON-GN-C1.1 CALL UTILITY  
Lock: Unlocked  
Status:  
Checkmark: Unchecked  
Author: AutoCAD SHX Text  
Date:  
Color: ☐



Subject:  
Page Label: [2] 61044-CON-GN-C1.1 CALL  
Lock: Unlocked  
Status:  
Checkmark: Unchecked  
Author: AutoCAD SHX Text  
Date:  
Color: ☐



Subject:  
Page Label: [2] 61044-CON-GN-C1.1 E  
Lock: Unlocked  
Status:  
Checkmark: Unchecked  
Author: AutoCAD SHX Text  
Date:  
Color: ☐




Subject:  
Page Label: [2] 61044-CON-GN-C1.1  
Lock: Unlocked  
Status:  
Checkmark: Unchecked  
Author: AutoCAD SHX Text  
Date:  
Color: ☐

F



Subject:  
Page Label: [2] 61044-CON-GN-C1.1  
Lock: Unlocked  
Status:  
Checkmark: Unchecked  
Author: AutoCAD SHX Text  
Date:  
Color: ☐

C

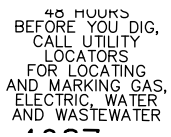

Subject:  
Page Label: [2] 61044-CON-GN-C1.1  
Lock: Unlocked  
Status:  
Checkmark: Unchecked  
Author: AutoCAD SHX Text  
Date:  
Color: ☐

FOR LOCATING



Subject:  
Page Label: [2] 61044-CON-GN-C1.1  
Lock: Unlocked  
Status:  
Checkmark: Unchecked  
Author: AutoCAD SHX Text  
Date:  
Color: ☐

BEFORE



Subject:  
Page Label: [2] 61044-CON-GN-C1.1  
Lock: Unlocked  
Status:  
Checkmark: Unchecked  
Author: AutoCAD SHX Text  
Date:  
Color: ☐

F



Subject:  
Page Label: [2] 61044-CON-GN-C1.1  
Lock: Unlocked  
Status:  
Checkmark: Unchecked  
Author: AutoCAD SHX Text  
Date:  
Color: ☐

I





Subject: Y  
Page Label: [2] 61044-CON-GN-C1.1  
Lock: Unlocked  
Status:  
Checkmark: Unchecked  
Author: AutoCAD SHX Text  
Date:  
Color: ☐




Subject: O  
Page Label: [2] 61044-CON-GN-C1.1  
Lock: Unlocked  
Status:  
Checkmark: Unchecked  
Author: AutoCAD SHX Text  
Date:  
Color: ☐




2-1987

Subject: AND WASTEWATER  
Page Label: [2] 61044-CON-GN-C1.1  
Lock: Unlocked  
Status:  
Checkmark: Unchecked  
Author: AutoCAD SHX Text  
Date:  
Color: ☐

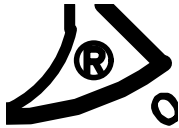

Subject: R  
Page Label: [2] 61044-CON-GN-C1.1  
Lock: Unlocked  
Status:  
Checkmark: Unchecked  
Author: AutoCAD SHX Text  
Date:  
Color: ☐

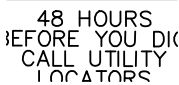

Subject: 48 HOURS  
Page Label: [2] 61044-CON-GN-C1.1  
Lock: Unlocked  
Status:  
Checkmark: Unchecked  
Author: AutoCAD SHX Text  
Date:  
Color: ☐




Subject: L  
Page Label: [2] 61044-CON-GN-C1.1  
Lock: Unlocked  
Status:  
Checkmark: Unchecked  
Author: AutoCAD SHX Text  
Date:  
Color: ☐





Subject:  
Page Label: [2] 61044-CON-GN-C1.1 D  
Lock: Unlocked  
Status:  
Checkmark: Unchecked  
Author: AutoCAD SHX Text  
Date:  
Color: ☐

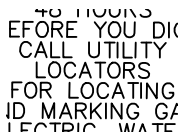

Subject:  
Page Label: [2] 61044-CON-GN-C1.1 LOCATORS  
Lock: Unlocked  
Status:  
Checkmark: Unchecked  
Author: AutoCAD SHX Text  
Date:  
Color: ☐



Subject:  
Page Label: [2] 61044-CON-GN-C1.1 O  
Lock: Unlocked  
Status:  
Checkmark: Unchecked  
Author: AutoCAD SHX Text  
Date:  
Color: ☐



Subject:  
Page Label: [2] 61044-CON-GN-C1.1 L  
Lock: Unlocked  
Status:  
Checkmark: Unchecked  
Author: AutoCAD SHX Text  
Date:  
Color: ☐



Subject:  
Page Label: [2] 61044-CON-GN-C1.1 N  
Lock: Unlocked  
Color: ☐

A



Subject:  
Page Label: [2] 61044-CON-GN-C1.1  
Lock: Unlocked  
Status:  
Checkmark: Unchecked  
Author: AutoCAD SHX Text  
Date:  
Color: ☐

G



Subject:  
Page Label: [2] 61044-CON-GN-C1.1  
Lock: Unlocked  
Status:  
Checkmark: Unchecked  
Author: AutoCAD SHX Text  
Date:  
Color: ☐

L






**Subject:**  
**Page Label:** [2] 61044-CON-GN-C1.1  
**Lock:** Unlocked  
**Status:**  
**Checkmark:** Unchecked  
**Author:** AutoCAD SHX Text  
**Date:**  
**Color:** ☐

L



**Subject:**  
**Page Label:** [2] 61044-CON-GN-C1.1  
**Lock:** Unlocked  
**Status:**  
**Checkmark:** Unchecked  
**Author:** AutoCAD SHX Text  
**Date:**  
**Color:** ☐

ELECTRIC, WATER

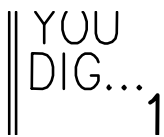

**Subject:**  
**Page Label:** [2] 61044-CON-GN-C1.1  
**Lock:** Unlocked  
**Status:**  
**Checkmark:** Unchecked  
**Author:** AutoCAD SHX Text  
**Date:**  
**Color:** ☐

DIG...



**Subject:**  
**Page Label:** [2] 61044-CON-GN-C1.1  
**Lock:** Unlocked  
**Status:**  
**Checkmark:** Unchecked  
**Author:** AutoCAD SHX Text  
**Date:**  
**Color:** ☐

F



**Subject:**  
**Page Label:** [2] 61044-CON-GN-C1.1  
**Lock:** Unlocked  
**Status:**  
**Checkmark:** Unchecked  
**Author:** AutoCAD SHX Text  
**Date:**  
**Color:** ☐


AND MARKING GAS,



**Subject:**  
**Page Label:** [2] 61044-CON-GN-C1.1  
**Lock:** Unlocked  
**Status:**  
**Checkmark:** Unchecked  
**Author:** AutoCAD SHX Text  
**Date:**  
**Color:** ☐

I



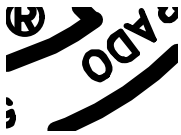

Subject:  
Page Label: [2] 61044-CON-GN-C1.1 O  
Lock: Unlocked  
Status:  
Checkmark: Unchecked  
Author: AutoCAD SHX Text  
Date:  
Color: ☐



Subject:  
Page Label: [2] 61044-CON-GN-C1.1 I  
Lock: Unlocked  
Status:  
Checkmark: Unchecked  
Author: AutoCAD SHX Text  
Date:  
Color: ☐



Subject:  
Page Label: [2] 61044-CON-GN-C1.1 B  
Lock: Unlocked  
Status:  
Checkmark: Unchecked  
Author: AutoCAD SHX Text  
Date:  
Color: ☐



Subject:  
Page Label: [2] 61044-CON-GN-C1.1 T  
Lock: Unlocked  
Status:  
Checkmark: Unchecked  
Author: AutoCAD SHX Text  
Date:  
Color: ☐



Subject:  
Page Label: [2] 61044-CON-GN-C1.1 U  
Lock: Unlocked  
Status:  
Checkmark: Unchecked  
Author: AutoCAD SHX Text  
Date:  
Color: ☐



Subject:  
Page Label: [2] 61044-CON-GN-C1.1 O  
Lock: Unlocked  
Status:  
Checkmark: Unchecked  
Author: AutoCAD SHX Text  
Date:  
Color: ☐





Subject:  
Page Label: [2] 61044-CON-GN-C1.1 R  
Lock: Unlocked  
Status:  
Checkmark: Unchecked  
Author: AutoCAD SHX Text  
Date:  
Color: ☐



Subject:  
Page Label: [2] 61044-CON-GN-C1.1 O  
Lock: Unlocked  
Status:  
Checkmark: Unchecked  
Author: AutoCAD SHX Text  
Date:  
Color: ☐



Subject:  
Page Label: [2] 61044-CON-GN-C1.1 A  
Lock: Unlocked  
Status:  
Checkmark: Unchecked  
Author: AutoCAD SHX Text  
Date:  
Color: ☐



Subject:  
Page Label: [2] 61044-CON-GN-C1.1 D  
Lock: Unlocked  
Status:  
Checkmark: Unchecked  
Author: AutoCAD SHX Text  
Date:  
Color: ☐



Subject:  
Page Label: [2] 61044-CON-GN-C1.1 N  
Lock: Unlocked  
Status:  
Checkmark: Unchecked  
Author: AutoCAD SHX Text  
Date:  
Color: ☐



Subject:  
Page Label: [2] 61044-CON-GN-C1.1 C  
Lock: Unlocked  
Status:  
Checkmark: Unchecked  
Author: AutoCAD SHX Text  
Date:  
Color: ☐





Subject:  
Page Label: [2] 61044-CON-GN-C1.1  
Lock: Unlocked  
Status:  
Checkmark: Unchecked  
Author: AutoCAD SHX Text  
Date:  
Color: ☐

1-800-922-1987



Subject:  
Page Label: [2] 61044-CON-GN-C1.1  
Lock: Unlocked  
Status:  
Checkmark: Unchecked  
Author: AutoCAD SHX Text  
Date:  
Color: ☐

I




Subject:  
Page Label: [2] 61044-CON-GN-C1.1  
Lock: Unlocked  
Status:  
Checkmark: Unchecked  
Author: AutoCAD SHX Text  
Date:  
Color: ☐

C



Subject:  
Page Label: [2] 61044-CON-GN-C1.1  
Lock: Unlocked  
Status:  
Checkmark: Unchecked  
Author: AutoCAD SHX Text  
Date:  
Color: ☐

Y

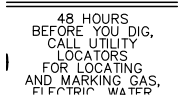

Subject:  
Page Label: [2] 61044-CON-GN-C1.1  
Lock: Unlocked  
Status:  
Checkmark: Unchecked  
Author: AutoCAD SHX Text  
Date:  
Color: ☐

BEFORE YOU DIG,



Subject:  
Page Label: [2] 61044-CON-GN-C1.1  
Lock: Unlocked  
Status:  
Checkmark: Unchecked  
Author: AutoCAD SHX Text  
Date:  
Color: ☐

1-800-922-1987



---

**Subject:**  
**Page Label:** [2] 61044-CON-GN-C1.1 U  
**Lock:** Unlocked  
**Status:**  
**Checkmark:** Unchecked  
**Author:** AutoCAD SHX Text  
**Date:**  
**Color:** ☐



---

**Subject:**  
**Page Label:** [2] 61044-CON-GN-C1.1 O  
**Lock:** Unlocked  
**Status:**  
**Checkmark:** Unchecked  
**Author:** AutoCAD SHX Text  
**Date:**  
**Color:** ☐



---

**Subject:**  
**Page Label:** [2] 61044-CON-GN-C1.1 I  
**Lock:** Unlocked  
**Status:**  
**Checkmark:** Unchecked  
**Author:** AutoCAD SHX Text  
**Date:**  
**Color:** ☐



---

**Subject:**  
**Page Label:** [2] 61044-CON-GN-C1.1 R  
**Lock:** Unlocked  
**Status:**  
**Checkmark:** Unchecked  
**Author:** AutoCAD SHX Text  
**Date:**  
**Color:** ☐



---

**Subject:**  
**Page Label:** [2] 61044-CON-GN-C1.1 A  
**Lock:** Unlocked  
**Status:**  
**Checkmark:** Unchecked  
**Author:** AutoCAD SHX Text  
**Date:**  
**Color:** ☐



---

**Subject:**  
**Page Label:** [2] 61044-CON-GN-C1.1 T  
**Lock:** Unlocked  
**Status:**  
**Checkmark:** Unchecked  
**Author:** AutoCAD SHX Text  
**Date:**  
**Color:** ☐





Subject:  
Page Label: [2] 61044-CON-GN-C1.1 E  
Lock: Unlocked  
Status:  
Checkmark: Unchecked  
Author: AutoCAD SHX Text  
Date:  
Color: ☐



Subject:  
Page Label: [2] 61044-CON-GN-C1.1 E  
Lock: Unlocked  
Status:  
Checkmark: Unchecked  
Author: AutoCAD SHX Text  
Date:  
Color: ☐



Subject:  
Page Label: [2] 61044-CON-GN-C1.1 I  
Lock: Unlocked  
Status:  
Checkmark: Unchecked  
Author: AutoCAD SHX Text  
Date:  
Color: ☐



Subject:  
Page Label: [2] 61044-CON-GN-C1.1 T  
Lock: Unlocked  
Status:  
Checkmark: Unchecked  
Author: AutoCAD SHX Text  
Date:  
Color: ☐



Subject:  
Page Label: [2] 61044-CON-GN-C1.1 N  
Lock: Unlocked  
Status:  
Checkmark: Unchecked  
Author: AutoCAD SHX Text  
Date:  
Color: ☐



Subject:  
Page Label: [2] 61044-CON-GN-C1.1 E  
Lock: Unlocked  
Status:  
Checkmark: Unchecked  
Author: AutoCAD SHX Text  
Date:  
Color: ☐




**Subject:** Callout  
**Page Label:** [1] 61044-CON-CS-C1.0  
**Lock:** Unlocked  
**Status:**  
**Checkmark:** Unchecked  
**Author:** dsdlaforce  
**Date:** 6/12/2017 3:38:03 PM  
**Color:** ■

Add EPC Planning & Community Development Department.




**Subject:** Callout  
**Page Label:** [1] 61044-CON-CS-C1.0  
**Lock:** Unlocked  
**Status:**  
**Checkmark:** Unchecked  
**Author:** dsdlaforce  
**Date:** 6/12/2017 3:38:41 PM  
**Color:** ■

Add "PCD Project No. SF-17-017"

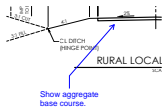


**Subject:** Callout  
**Page Label:** [2] 61044-CON-GN-C1.1  
**Lock:** Unlocked  
**Status:**  
**Checkmark:** Unchecked  
**Author:** dsdlaforce  
**Date:** 6/12/2017 3:44:53 PM  
**Color:** ■

Show aggregate base course.

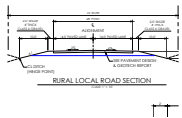


**Subject:** PolyLine  
**Page Label:** [2] 61044-CON-GN-C1.1  
**Lock:** Unlocked  
**Status:**  
**Checkmark:** Unchecked  
**Author:** dsdlaforce  
**Date:** 6/12/2017 3:44:15 PM  
**Color:** ■

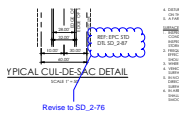

**Subject:** Cloud+  
**Page Label:** [2] 61044-CON-GN-C1.1  
**Lock:** Unlocked  
**Status:**  
**Checkmark:** Unchecked  
**Author:** dsdlaforce  
**Date:** 6/12/2017 3:41:26 PM  
**Color:** ■


Revise to SD\_2-76

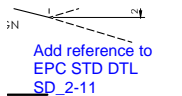

**Subject:** Text Box  
**Page Label:** [2] 61044-CON-GN-C1.1  
**Lock:** Unlocked  
**Status:**  
**Checkmark:** Unchecked  
**Author:** dsdlaforce  
**Date:** 6/12/2017 3:45:20 PM  
**Color:** ■


Add reference to EPC STD DTL SD\_2-11



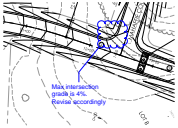


**Subject:** Cloud+  
**Page Label:** [3] 61044-CON-PP1-C1.2  
**Lock:** Unlocked  
**Status:**  
**Checkmark:** Unchecked  
**Author:** dsdlaforce  
**Date:** 6/12/2017 4:48:16 PM  
**Color:** ■

Max intersection grade is 4%. Revise accordingly

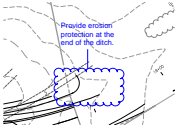


**Subject:** Cloud+  
**Page Label:** [3] 61044-CON-PP1-C1.2  
**Lock:** Unlocked  
**Status:**  
**Checkmark:** Unchecked  
**Author:** dsdlaforce  
**Date:** 6/12/2017 4:50:31 PM  
**Color:** ■

Provide erosion protection at the end of the ditch.

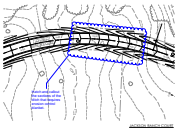

**Subject:** Cloud+  
**Page Label:** [3] 61044-CON-PP1-C1.2  
**Lock:** Unlocked  
**Status:**  
**Checkmark:** Unchecked  
**Author:** dsdlaforce  
**Date:** 6/12/2017 4:35:57 PM  
**Color:** ■


Hatch and callout the sections of the ditch that requires erosion control blanket.

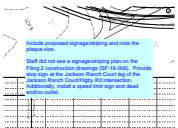

**Subject:** Text Box  
**Page Label:** [3] 61044-CON-PP1-C1.2  
**Lock:** Unlocked  
**Status:**  
**Checkmark:** Unchecked  
**Author:** dsdlaforce  
**Date:** 6/14/2017 1:11:06 PM  
**Color:** ■


Include proposed signage/stripping and note the plaque size.

Staff did not see a signage/stripping plan on the Filing 2 construction drawings (SF-16-006). Provide stop sign at the Jackson Ranch Court leg of the Jackson Ranch Court/Higby Rd intersection. Additionally, install a speed limit sign and dead end/no outlet.

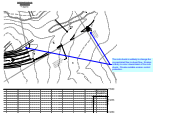


**Subject:** Callout  
**Page Label:** [3] 61044-CON-PP1-C1.2  
**Lock:** Unlocked  
**Status:**  
**Checkmark:** Unchecked  
**Author:** dsdlaforce  
**Date:** 6/12/2017 3:34:54 PM  
**Color:** ■

The rock check is unlikely to change the concentrated flow to sheet flow. Erosion is likely to occur downstream of the rock check. Provide suitable erosion control protection.

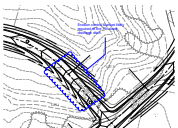


**Subject:** Cloud+  
**Page Label:** [4] 61044-CON-PP2-C1.3  
**Lock:** Unlocked  
**Status:**  
**Checkmark:** Unchecked  
**Author:** dsdlaforce  
**Date:** 6/12/2017 5:05:02 PM  
**Color:** ■

Erosion control blanket likely required at the 7% slope drainage ditch.

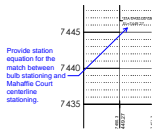


**Subject:** Callout  
**Page Label:** [4] 61044-CON-PP2-C1.3  
**Lock:** Unlocked  
**Status:**  
**Checkmark:** Unchecked  
**Author:** dsdlaforce  
**Date:** 6/12/2017 4:54:08 PM  
**Color:** ■

Provide station equation for the match between bulb stationing and Mahaffie Court centerline stationing.

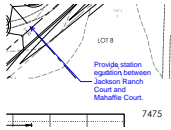


**Subject:** Callout  
**Page Label:** [4] 61044-CON-PP2-C1.3  
**Lock:** Unlocked  
**Status:**  
**Checkmark:** Unchecked  
**Author:** dsdlaforce  
**Date:** 6/12/2017 4:56:01 PM  
**Color:** ■

Provide station equation between Jackson Ranch Court and Mahaffie Court.

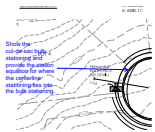

**Subject:** Callout  
**Page Label:** [4] 61044-CON-PP2-C1.3  
**Lock:** Unlocked  
**Status:**  
**Checkmark:** Unchecked  
**Author:** dsdlaforce  
**Date:** 6/14/2017 11:05:20 AM  
**Color:** ■

Show the cul-de-sac bulb stationing and provide the station equation for where the centerline stationing ties into the bulb stationing.

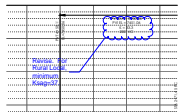


**Subject:** Cloud+  
**Page Label:** [4] 61044-CON-PP2-C1.3  
**Lock:** Unlocked  
**Status:**  
**Checkmark:** Unchecked  
**Author:** dsdlaforce  
**Date:** 6/12/2017 4:42:44 PM  
**Color:** ■

Revise. For Rural Local, minimum Ksag=37.




**Subject:** Callout  
**Page Label:** [4] 61044-CON-PP2-C1.3  
**Lock:** Unlocked  
**Status:**  
**Checkmark:** Unchecked  
**Author:** dsdlaforce  
**Date:** 6/12/2017 3:34:19 PM  
**Color:** ■

The rock check is unlikely to change the concentrated flow to sheet flow. Erosion is likely to occur downstream of the rock check. Provide suitable erosion control protection.

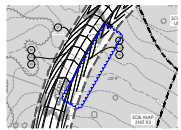

**Subject:** Cloud  
**Page Label:** [5] 61044-CON-EC-C1.4  
**Lock:** Unlocked  
**Status:**  
**Checkmark:** Unchecked  
**Author:** dsdlaforce  
**Date:** 6/13/2017 11:34:50 AM  
**Color:** ■



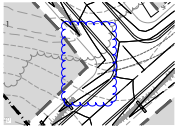

---


**Subject:** Cloud  
**Page Label:** [5] 61044-CON-EC-C1.4  
**Lock:** Unlocked  
**Status:**  
**Checkmark:** Unchecked  
**Author:** dsdlaforce  
**Date:** 6/13/2017 11:34:17 AM  
**Color:** ■



---

**Subject:** Callout  
**Page Label:** [5] 61044-CON-EC-C1.4  
**Lock:** Unlocked  
**Status:**  
**Checkmark:** Unchecked  
**Author:** dsdlaforce  
**Date:** 6/13/2017 11:35:55 AM  
**Color:** ■

Proposed contours does not reflect continuation of the proposed ditch. Update accordingly.

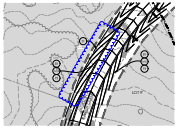

---

**Subject:** Cloud  
**Page Label:** [5] 61044-CON-EC-C1.4  
**Lock:** Unlocked  
**Status:**  
**Checkmark:** Unchecked  
**Author:** dsdlaforce  
**Date:** 6/13/2017 11:34:35 AM  
**Color:** ■