

GENERAL NOTES

- Profile design lines are based on centerline, as shown, unless otherwise noted.
- All new construction to conform to the specifications of El Paso County Development Services Department, Widefield Water and Sanitation District, and the Fountain Mutual Irrigation Company (FMIC). Any asphalt removed is to be replaced to meet the specifications of the El Paso County Development Services Department.
- For pavement design, curb and gutter, and sidewalks see individual plan and profile sheets. Pavement design to be based on Resistance Value 'R' results from Hveem test and are to be approved by the Engineering Division of the El Paso County Development Services Department prior to work above ground.
- At intersections, all curb returns will have 20-foot radius unless otherwise noted.
- All existing utilities have been shown according to the best available information. The contractor is responsible for field location and verification prior to beginning work. If it appears that there could be a conflict with any utilities, whether indicated on the plans or not, the contractor is to notify the engineer and owner immediately. The contractor is responsible for the protection and repair (if necessary) of all utilities.
- A Pre-Construction meeting shall be held at the El Paso County Development Services Department and Widefield Water and Sanitation District prior to any construction.
- Approved plans, Engineering Criteria Manual, etc. is required to be on-site at all times during construction.
- All storm sewer pipe such as SWMP, ESQCP, Fugitive Dust, Access, C.O.E. 404, etc. shall be obtained prior to construction.
- All handicap ramps to be per El Paso County Standard SD-2-40.
- The contractor shall be responsible for the placement of any pedestrian ramp prior to construction of the curb. Pedestrian ramp locations are shown on the plans.
- Where appropriate, neatly saw cut all existing concrete and asphalt. Repair/replace all disturbed existing items with like materials and thicknesses.
- All disturbed areas shall be vegetated with native grasses within 21 days of excavation per Erosion Control Plan.
- The prepared Erosion/Sediment Control Plan to be considered a part of these plans and its requirements adhered to during the construction of this project.
- All storm and sanitary sewer pipe lengths and slopes are figured from center of manhole or bend. Pipe lengths are given as a horizontal length.
- All storm cover bedding to be per CDOB Standards.
- All storm sewer pipe shall be Class III Wall unless otherwise shown on the storm sewer plan and profile sheets.
- All wyes and bends used in construction of storm sewer facilities shall be factory fabricated, unless approved by the El Paso County Development Services Department.
- Concrete components used in all storm and sanitary sewer manholes shall be per specifications. Storm sewer radial deflections to be grouted or installed per manufacturer's recommendations.
- Storm sewer manholes sizes as follows unless otherwise shown:
 - 18" thru 36" use 49" I.D. manhole
 - 42" thru 48" use 60" I.D. manhole
 - 54" thru 60" use 72" I.D. manhole
- New manholes to be constructed here shall be increased, if necessary, to facilitate future lateral connections.
- Sanitary sewer manhole sizes and facilities per Widefield Water and Sanitation District Specifications. Sanitary sewers to be installed with Class 'C' bedding. Sanitary sewers deeper than 12-feet shall require Class 'B' bedding. Pipe used for construction of sanitary sewer shall be SDR 35 unless shown otherwise on plan and profiles.
- For additional information, see the Plan and/or Services Plan.
- All vertical and horizontal stationing is based on the Face of Curb; unless otherwise shown.
- All vertical design and top of curb are based on the design point shown in the typical cross section.
- The curb line design point is located at the intersection of the face and top of curb for Type III Standard 6-inch vertical curb. See typical street section for design point locations.
- Water and sanitary sewer service provided by Widefield Water and Sanitation District. Telephone service provided by Qwest Communications. Gas Specifications, whichever is greater.
- All utility construction to be conducted in conformance with the current Widefield Water and Sanitation District Specifications and/or El Paso County Specifications.
- Vertical curb to be used between curb returns (CR) and curb inlets. Transitions from ramp to vertical curb shall be 10-feet unless otherwise approved by the El Paso County Development Services Department. All other curb & gutter to be ramp curb & gutter.
- For additional information, see the Plan and/or Services Plan.
- Contractor responsible for meeting all Widefield Water and Sanitation District criteria when connecting to existing stubs.
- Curb returns shall be straight graded from CR to CR unless otherwise noted.
- Inlets are Type 'R' inlets (CDOT STD M-604-12) unless otherwise noted.
- USPS CBU Mailboxes are to be determined by USPS.

BENCHMARK: Monument is located at the Northwest corner of the intersection of Powers Boulevard and Fontaine Street. The monument is a 3-inch aluminum cap (FIMS ID #206). Located 51.3 feet west of the west edge of asphalt of Powers Blvd and 65.5 feet north of the north edge of asphalt of Fontaine Street. Elevation=5897.89 feet (NGVD 1929, 1960 Adj.)

BASIS OF BEARINGS: Is based upon a portion of the Easterly boundary of the Glen at Widefield Subdivision Filing No. 5B as recorded under Reception No. 206712326 in the records of the Clerk and Recorder's Office, County of El Paso, State of Colorado; said line being also a portion of the Easterly Right-of-Way of the Aurora Avenue as described in subdivision, being bounded by a found rebar and cap marked "PLSC 25968". Said line bears N29°46'44" W, a distance of 1154.12 feet.

EL PASO COUNTY STANDARD NOTES

- All drainage and roadway construction shall meet the standards and specifications of the City of Colorado Springs/El Paso County Drainage Criteria Manual, Volumes 1 and 2, and the El Paso County Engineering Criteria Manual.
- Contractor shall be responsible for the notification and field notification of all existing utilities, whether shown on the plans or not, before beginning construction. Location of existing utilities shall be verified by the contractor prior to construction. Call 811 to contact the Utility Notification Center of Colorado (UNCC).
- Contractor shall keep a copy of these approved plans, the Grading and Erosion Control Plan, the Stormwater Management Plan (SWMP), the soils and geotechnical report, and the appropriate design and construction standards and specifications at the job site at all times, including the following:
 - El Paso County Engineering Criteria Manual (ECM)
 - City of Colorado Springs/El Paso County Drainage Criteria Manual, Volumes 1 and 2
 - Colorado Department of Transportation (CDOT) Standard Specifications for Road and Bridge Construction
 - CDOT M & S Standards
- Notwithstanding anything depicted in these plans in words or graphic representation, all design and construction related to roads, storm drainage and erosion control shall conform to the standards and requirements of the most recent adopted El Paso County standards, including the Land Development Code, the Engineering Criteria Manual, the Drainage Criteria Manual, and the Drainage Criteria Manual Volume 2. Any deviations from regulations and standards must be requested, and approved, in writing. Any modifications necessary to meet criteria after-the-fact will be entirely the developer's responsibility to rectify.
- It is the design engineer's responsibility to accurately show existing conditions, both onsite and offsite, on the construction plans. Any modifications necessary due to conflicts, omissions, or changed conditions will be entirely the developer's responsibility to rectify.
- Contractor shall schedule a pre-construction meeting with El Paso County Development Services Department (DSD) - Inspections, prior to starting construction.
- It is the contractor's responsibility to understand the requirements of all jurisdictional agencies and to obtain all required permits, including but not limited to El Paso County Erosion and Stormwater Quality Control Permit (ESQCP), Regional Building Floodplain Development Permit, U.S. Army Corps of Engineers-issued 401 and/or 404 permits, county and state fugitive dust permits.
- Contractor shall not deviate from the plans without first obtaining written approval from the design engineer and DSD. Contractor shall notify the design engineer immediately upon discovery of any errors or inconsistencies.
- All storm drain pipe shall be Class III RCP unless otherwise noted and approved by DSD.
- Contractor shall coordinate geotechnical testing per ECM standards. Pavement design shall be approved by El Paso County DSD prior to placement of curb and gutter and pavement.
- All construction traffic must enter/exit the site at approved construction access points.
- Sight visibility triangles as identified in the plans shall be provided at all intersections. Obstructions greater than 18 inches above flowline are not allowed within sight triangles.
- Signing and striping shall comply with El Paso County DOT and MUTCD criteria. [If applicable, additional signing and striping notes will be provided.]
- Contractor shall obtain any permits required by El Paso County DOT, including Work Within the Right-of-Way and Special Transport permits.
- The limits of construction shall remain within the property line unless otherwise noted. The owner/developer shall obtain written permission and easements, where required, from adjoining property owner(s) prior to any off-site disturbance, grading, or construction.

INDEX OF SHEETS


- Cover Sheet
- Plan and Profile - Spring Glen Drive (30+00 to 43+00)
- Plan and Profile - Spring Glen Drive 43+50 to 45+89)
- Plan and Profile - Bigtooth Maple Drive (25+50 to 37+82)
- Plan and Profile - Peachleaf Drive (25+00 to 38+36)
- Plan and Profile - Bittercress Place (0+00 to 9+00)
- Plan and Profile - Bittercress Place (9+00 to 14+39)
- Plan and Profile - Bee Balm Place (1+00 to 3+51)
- Overall Signage and Striping Plan
- Storm Sewer Plan (Outfall)
- Storm Sewer Plan - (Peachleaf Drive)
- Grading and Erosion Control Plan
- Grading and Erosion Control Details
- Utility Plan
- Utility Plan -- Water Line Lowering Details
- Utility Services Plan
- Detention Basin Details
- Detention Basin Details
- Site Detail Plan -- Site Details
- Site Detail Plan -- Utility Details




Know what's below.
Call before you dig.

Revise all references
from "Development
Services Department"
to "Planning and
Community
Development
Department"

PREPARED FOR

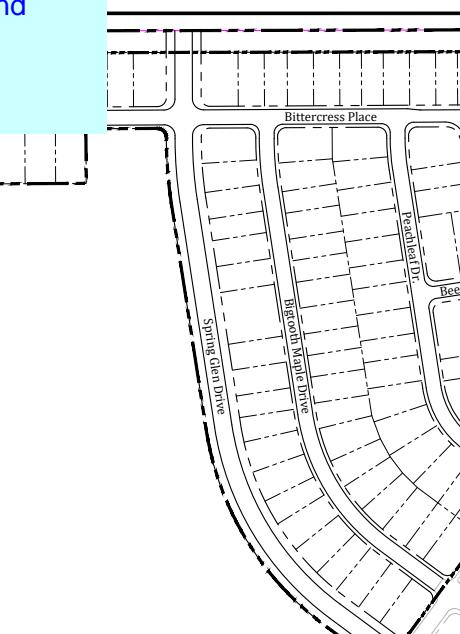

SITE MAP

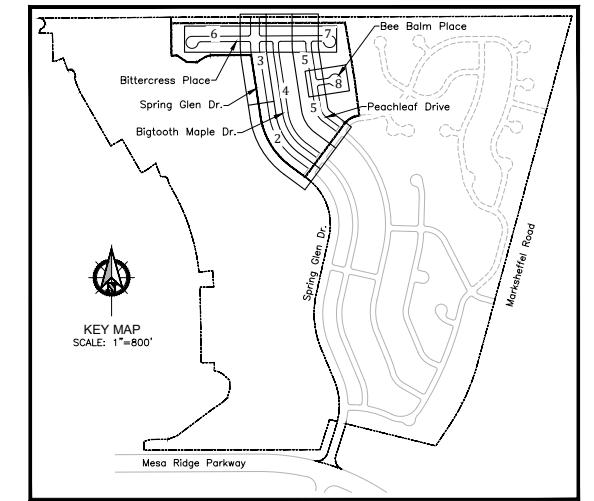

Kiowa Project No. 17038
December 15, 2017

Add as a 3rd paragraph:

In accordance with ECM Section 1.12, these construction documents will be valid for construction for a period of 2 years from the date signed by the El Paso County Engineer. If construction has not started within those 2 years, the plans will need to be resubmitted for approval, including payment of review fees at the Planning and Community Development Directors discretion.

Sanitation District reserves the right to accept or reject any such materials and workmanship that does not conform to its standards and specifications.

3. The Developer or his Engineer has located all fire hydrants and future service stubs. Any required realignment, either horizontal or vertical, shall be at the expense of the Developer.

4. All ductile iron pipe, to include fittings, valves and fire hydrants will be wrapped with polyethylene tubing, and electrically isolated.

5. All steel iron pipe and fittings shall be double bonded. Specifications for cathodic protection on both DIP mains and PVC mains can be specified in the Standards and Specifications.

6. PVC main lines shall be installed with coated No. 12 tracer wire.

7. The Contractor is required to notify the Widefield Water and Sanitation District (390-7111) a minimum of 48 hours and a maximum of 96 hours prior to the start of construction. The Contractor shall also notify affected utility companies 48 hours prior to construction adjacent to the known utility lines.

8. The location of all utilities as shown on these drawings are approximate only. The location of all utilities shall be verified prior to construction by the Contractor.

9. The Contractor shall excavate and verify the vertical and horizontal location of all tie-ins. Contractor shall notify the Widefield Water and Sanitation District and the Engineer of the field verified information prior to construction.

10. All boulds shall be staked prior to construction.

11. Any water utility material removed and not reused shall be returned to the Widefield Water and Sanitation District if the District so requests.

12. The Contractor shall at his expense support and protect all utility mains so that they will function continuously during construction. Should a utility main fail as a result of the Contractor's operation, it will be replaced immediately by either the Contractor or the Widefield Water and Sanitation District at full cost of labor and materials to the Contractor.

13. Any pumping or bypass operations must be reviewed and approved prior to execution by both the Widefield Water and Sanitation District and the Engineer.


14. Contractor must replace or repair any damage to all surface improvements, including, but not limited to fences, curb and gutter and/or asphalt that may be caused during construction.

15. All water lines 6" and larger, and all sewer lines 8" and larger, shall have as "As-Built" plans prepared and approved prior to final acceptance by the Widefield Water and Sanitation District.

16. Prior to construction, a Pre-Construction Conference is required a minimum of 72 hours in advance of commencement of work. To set the Pre-Construction conference, contact Brandon Bernard, Water Superintendent (464-2051) and/or Mark McCormick, Wastewater Superintendent (491-0128) of the Widefield Water and Sanitation District for a time. No Pre-Construction Conference times will be set until 4 sets of signed drawings are received by the Widefield W & S District. Pre-Construction Date /Initials _____


ABBREVIATIONS

ASSY = ASSEMBLY	NTS = NOT TO SCALE
BNDY = BOUNDARY	OD = OUTSIDE DIAMETER
BOP = BOTTOM OF PIPE	PC = POINT OF CURVATURE
CL = CENTERLINE	PP = PROPOSED PIPE
CPA = CENTERLINE REVERSE ANCHOR	PT = POINT OF HORIZONTAL TANGENCY
CTR = CONCRETE THRUST BLOCK	PVC = POLY VINYL CHLORIDE PIPE
CR = POINT OF CURB RETURN	PVI = POINT OF VERTICAL CURVATURE
DIP = DUCTILE IRON PIPE	PVI = POINT OF VERTICAL INTERSECTION
EL = ELEVATION	PVT = POINT OF VERTICAL TANGENCY
ESMT = EASTING	RBC = REINFORCED CONCRETE BOX
EX = EXISTING	RCP = REINFORCED CONCRETE PIPE
FC = FACE OF CURB	ROW = RIGHT OF WAY
FES = FLARED END SECTION	RT = RIGHT
FLG = FLANGE	SHT = SHEET
FL = FLOWLINE	SS = STORM SEWER
GB = GRADE BREAK	STA = STATION
HP = HIGH POINT	STD = STANDARD
HORIZ = HORIZONTAL	TA = TOP OF ASPHALT
HYD = HYDRANT	TC = TOP OF CURE
I.D. = INSIDE DIAMETER	TOP = TOP OF PIPE
LT = LENGTH	TYP = TYPICAL
LF = LOW POINT	VC = VERTICAL CURVE
LP = LOW POINT	VERT = VERTICAL
MAX = MAXIMUM	
MH = MANHOLE	

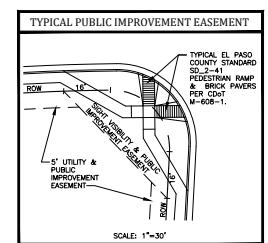

LEGEND

STREET R.O.W.	CURB & GUTTER (CURB SECTION AS SHOWN ON PLANS)
STREET CENTER LINE	EXISTING FORCE MAIN
PROPOSED WATER	EXISTING WATER
PROPOSED WATER HYDRANT	EXISTING WATER HYDRANT
PROPOSED SANITARY MH	EXISTING SANITARY MH
PROPOSED SANITARY SEWER	EXISTING SANITARY SEWER
PROPOSED STORM SEWER	EXISTING STORM SEWER
PROPOSED STORM INLET	EXISTING STORM INLET
PROPOSED STORM MH	EXISTING STORM MH
PROPOSED STORM FES	EXISTING STORM FES
PROPOSED BOXBASE MH	EXISTING STORM FES

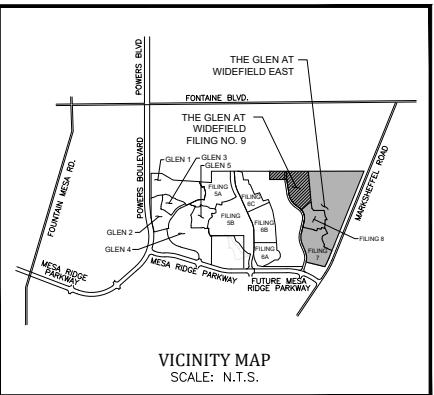

VICINITY MAP
SCALE: N.T.S.

STATEMENTS

Design Engineer's Statement:

These detailed plans and specifications were prepared under my direction and supervision. Said plans and specifications have been prepared in accordance with the standards and specifications of the El Paso County Development Services Department. Said plans and specifications are in conformity with applicable master drainage plans and master transportation plans. Said plans and specifications meet the purposes for which the particular roadway and drainage facilities are designed and are correct to the best of my knowledge and belief. I accept responsibility for any liability caused by any negligent acts, errors or omissions on my part in preparation of these detailed plans and specifications.

Andrew W. McCord, P.E. #2505
For and on behalf of Kiowa Engineering Corp. Date

Owner/Developer's Statement:

I, the owner/developer have read and will comply with all of the requirements specified in these detailed plans and specifications.

J. Mark Watson, President
Glen Development Company
37 Widefield Boulevard
Colorado Springs, Colorado 80911

El Paso County:

County plan review is provided only for general conformance with County Design Criteria. The County is not responsible for the accuracy and adequacy of the design, dimensions, and/or elevations which shall be confirmed at the job site. The County through the approval of this document assumes no responsibility for completeness and/or accuracy of this document.

Filed in accordance with the requirements of the El Paso County Land Development Code, Drainage Criteria Manual, and Engineering Criteria Manual as amended.

Jennifer Irvine, P.E.
County Engineer / ECM Administrator

Date

Signed _____ Date _____

UTILITY APPROVALS

WATER AND SEWER MAIN EXTENSIONS

Any changes or alterations affecting the grade, alignment, elevation and/or depth of cover of any water or sewer mains or other appurtenances shown on this drawing shall be the responsibility of the Owner/Developer. The Owner/Developer shall be responsible for all operational damages and defects in installation and material for mains and services from the date of approval until final acceptance is issued.

Signed _____ Date _____

Print Name J. Mark Watson, President

DBA: GLEN DEVELOPMENT COMPANY

Address: 37 Widefield Boulevard
Colorado Springs, CO 80911
(719) 392-0194

FIRE AUTHORITY APPROVAL

The number of fire hydrants and hydrant locations shown on this water installation plan are correct and adequate to satisfy the fire protection requirements as specified by the Fire District serving the property noted on the plans.

Security Fire Department

Signed _____ Date _____

DISTRICT APPROVALS



The Widefield Water and Sanitation District recognizes the design engineer as having responsibility for the design. The Widefield Water and Sanitation District has limited its scope of review accordingly.


WIDEFIELD WATER AND SANITATION DISTRICT WASTEWATER DESIGN APPROVAL

Date: _____ By

GLEN AT WIDEFIELD FILING NO. 9
SPRING GLEN DRIVE (Sta. 30+00 to Sta. 43+00)
PLAN AND PROFILE
EL PASO COUNTY, COLORADO


Project No.:	17038
Date:	December 15, 2017
Design:	AWMc
Drawn:	JAK
Check:	AWMc
Revisions:	
SHEET	2

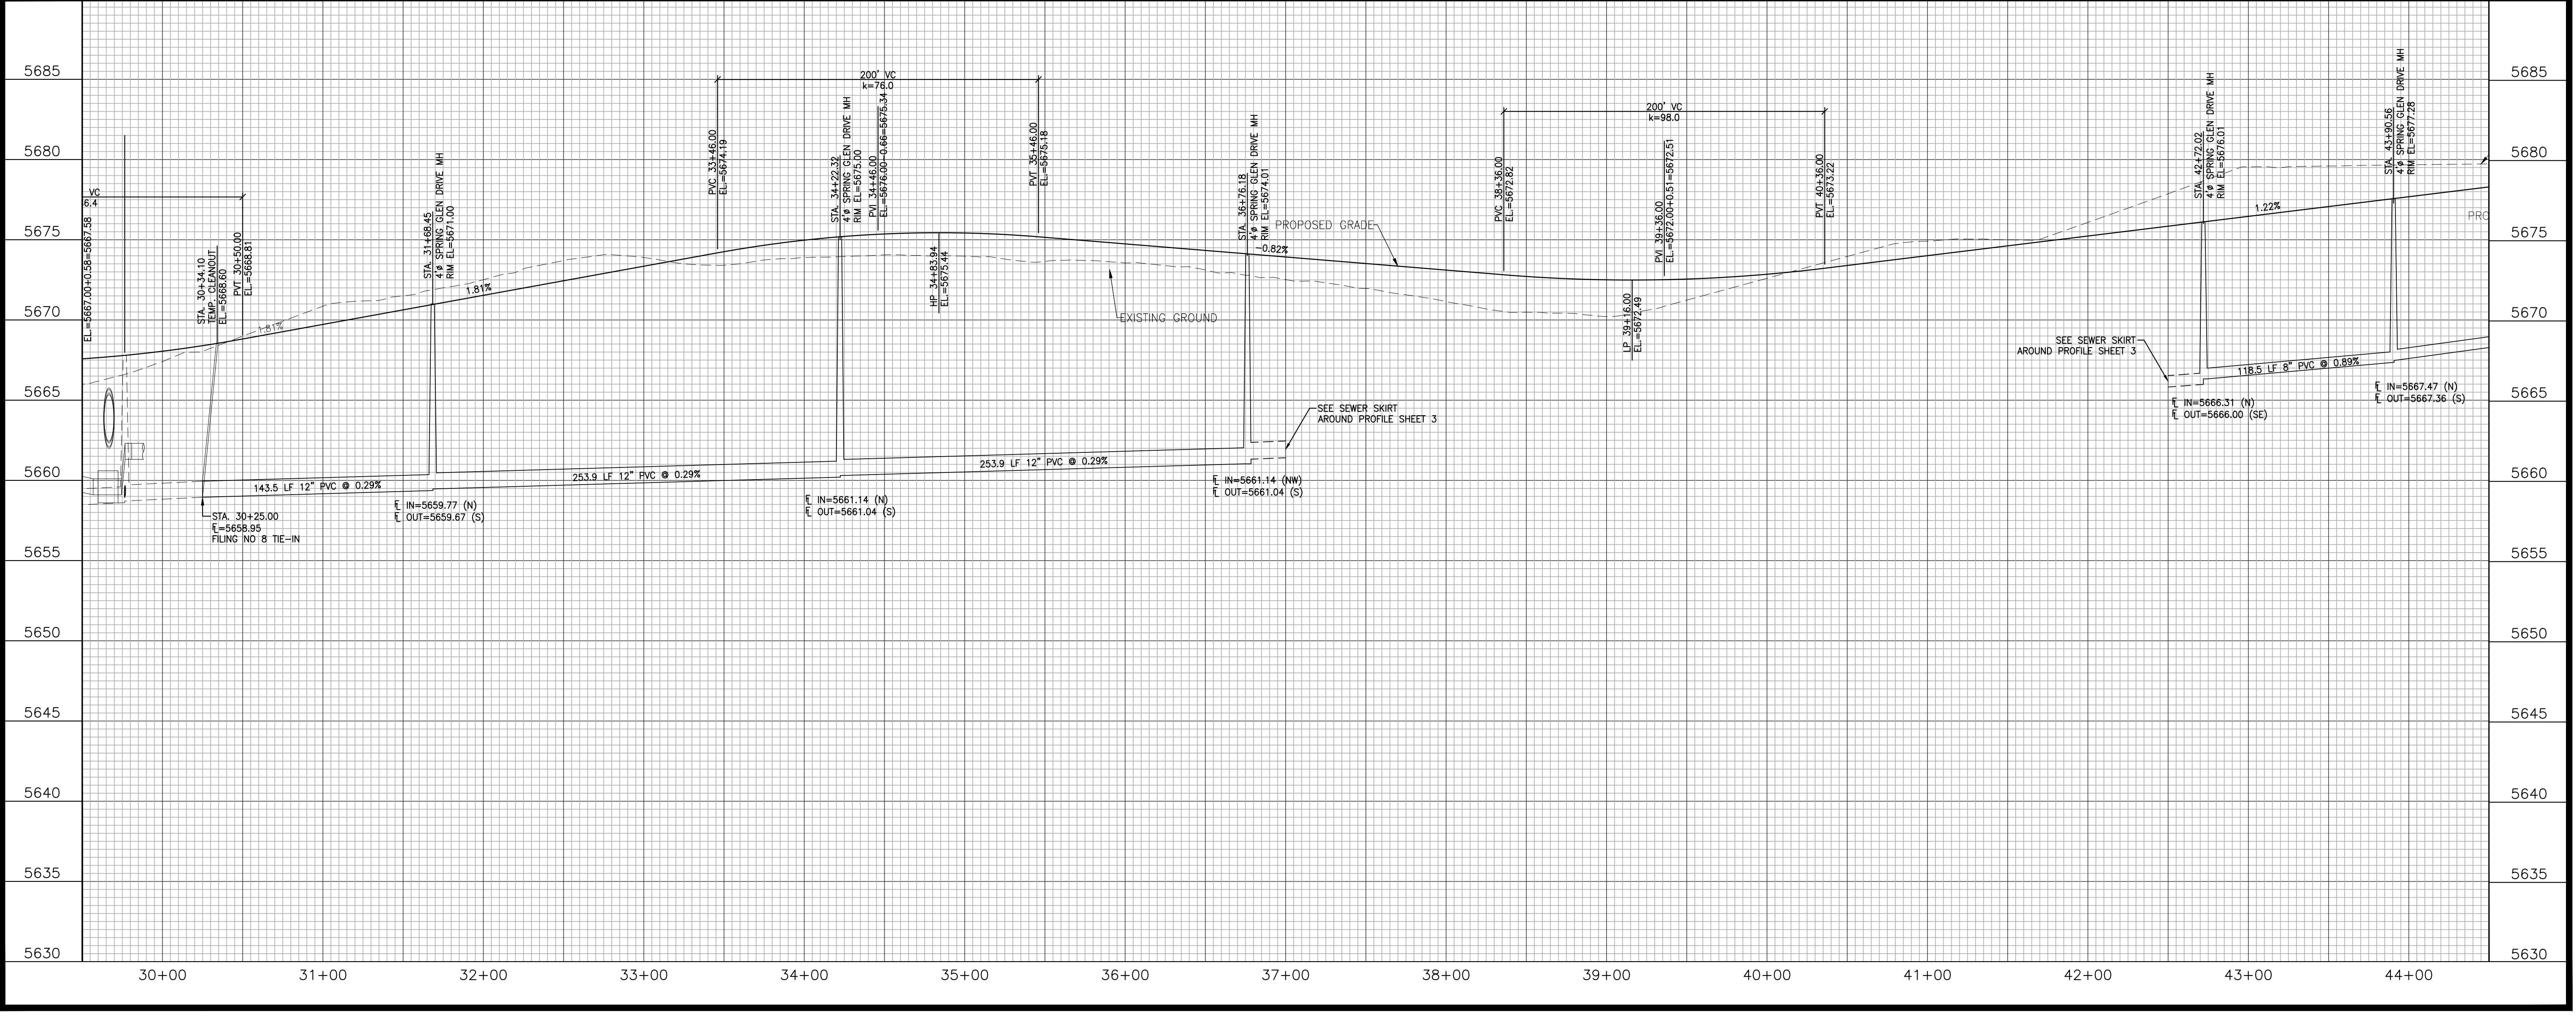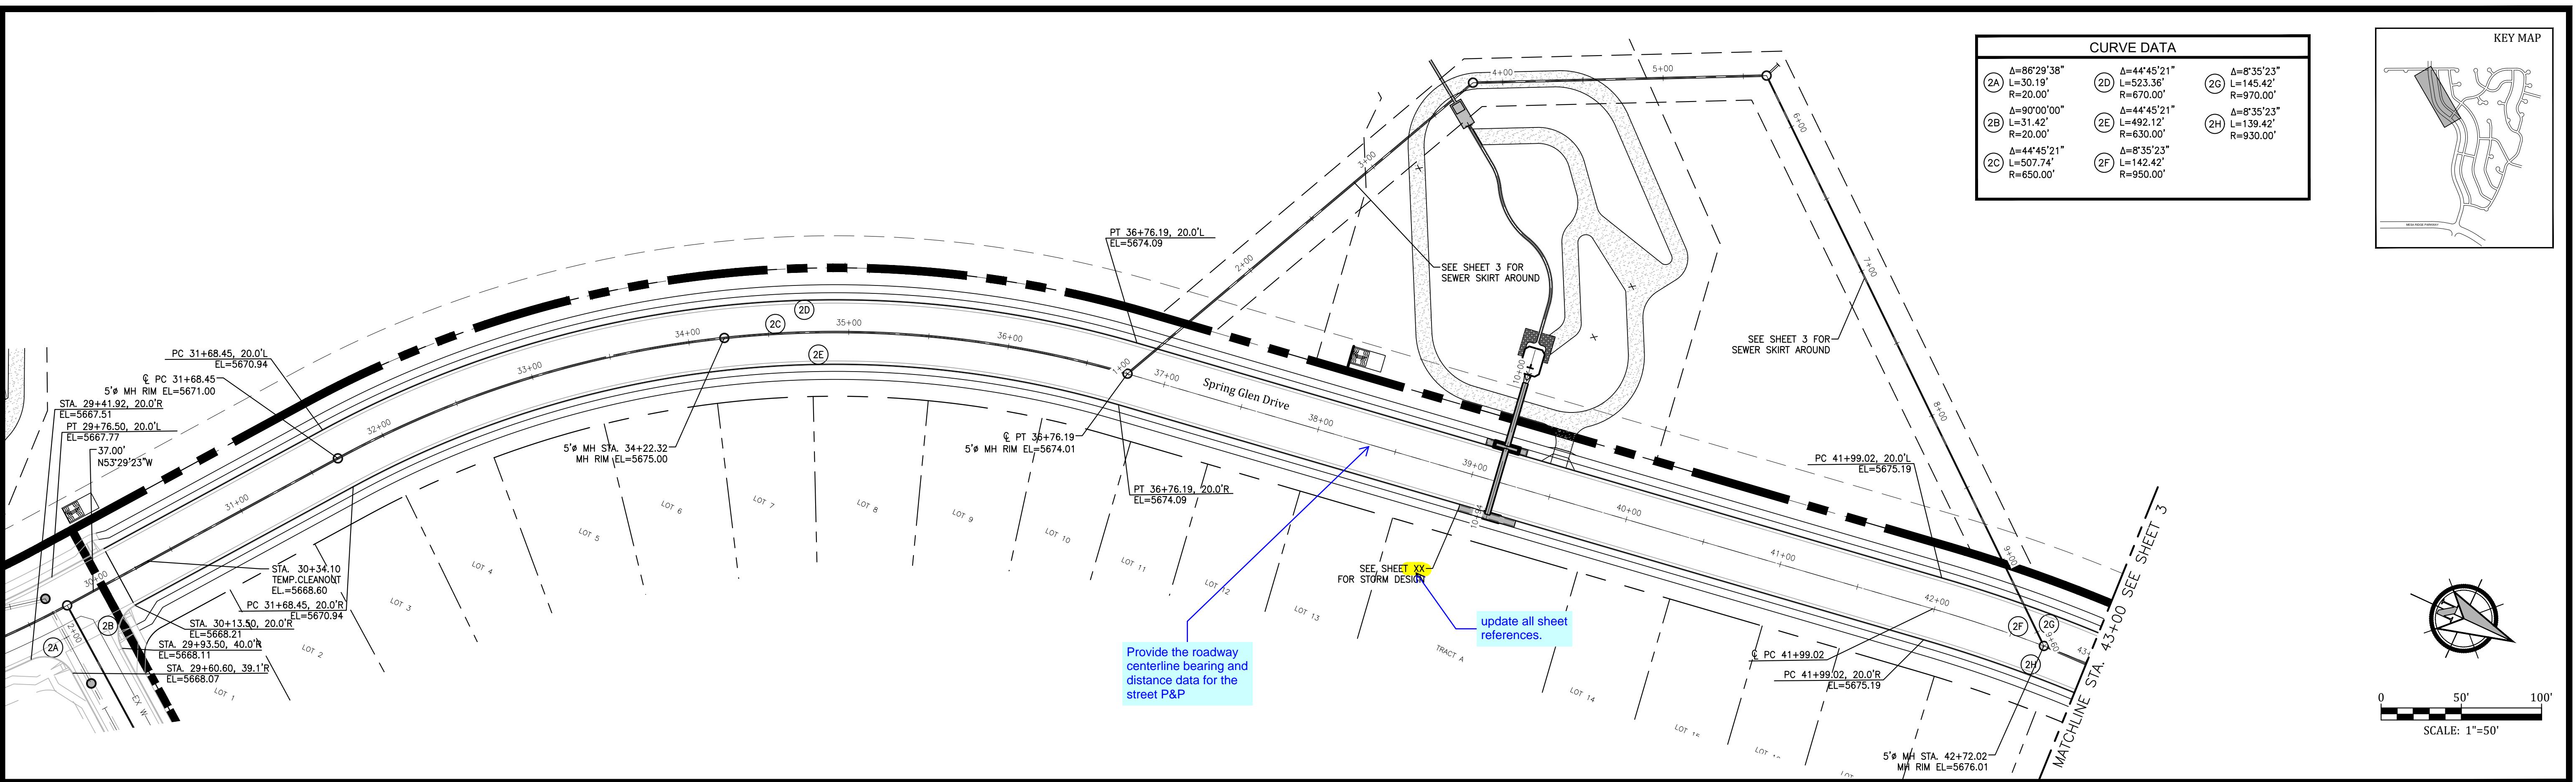

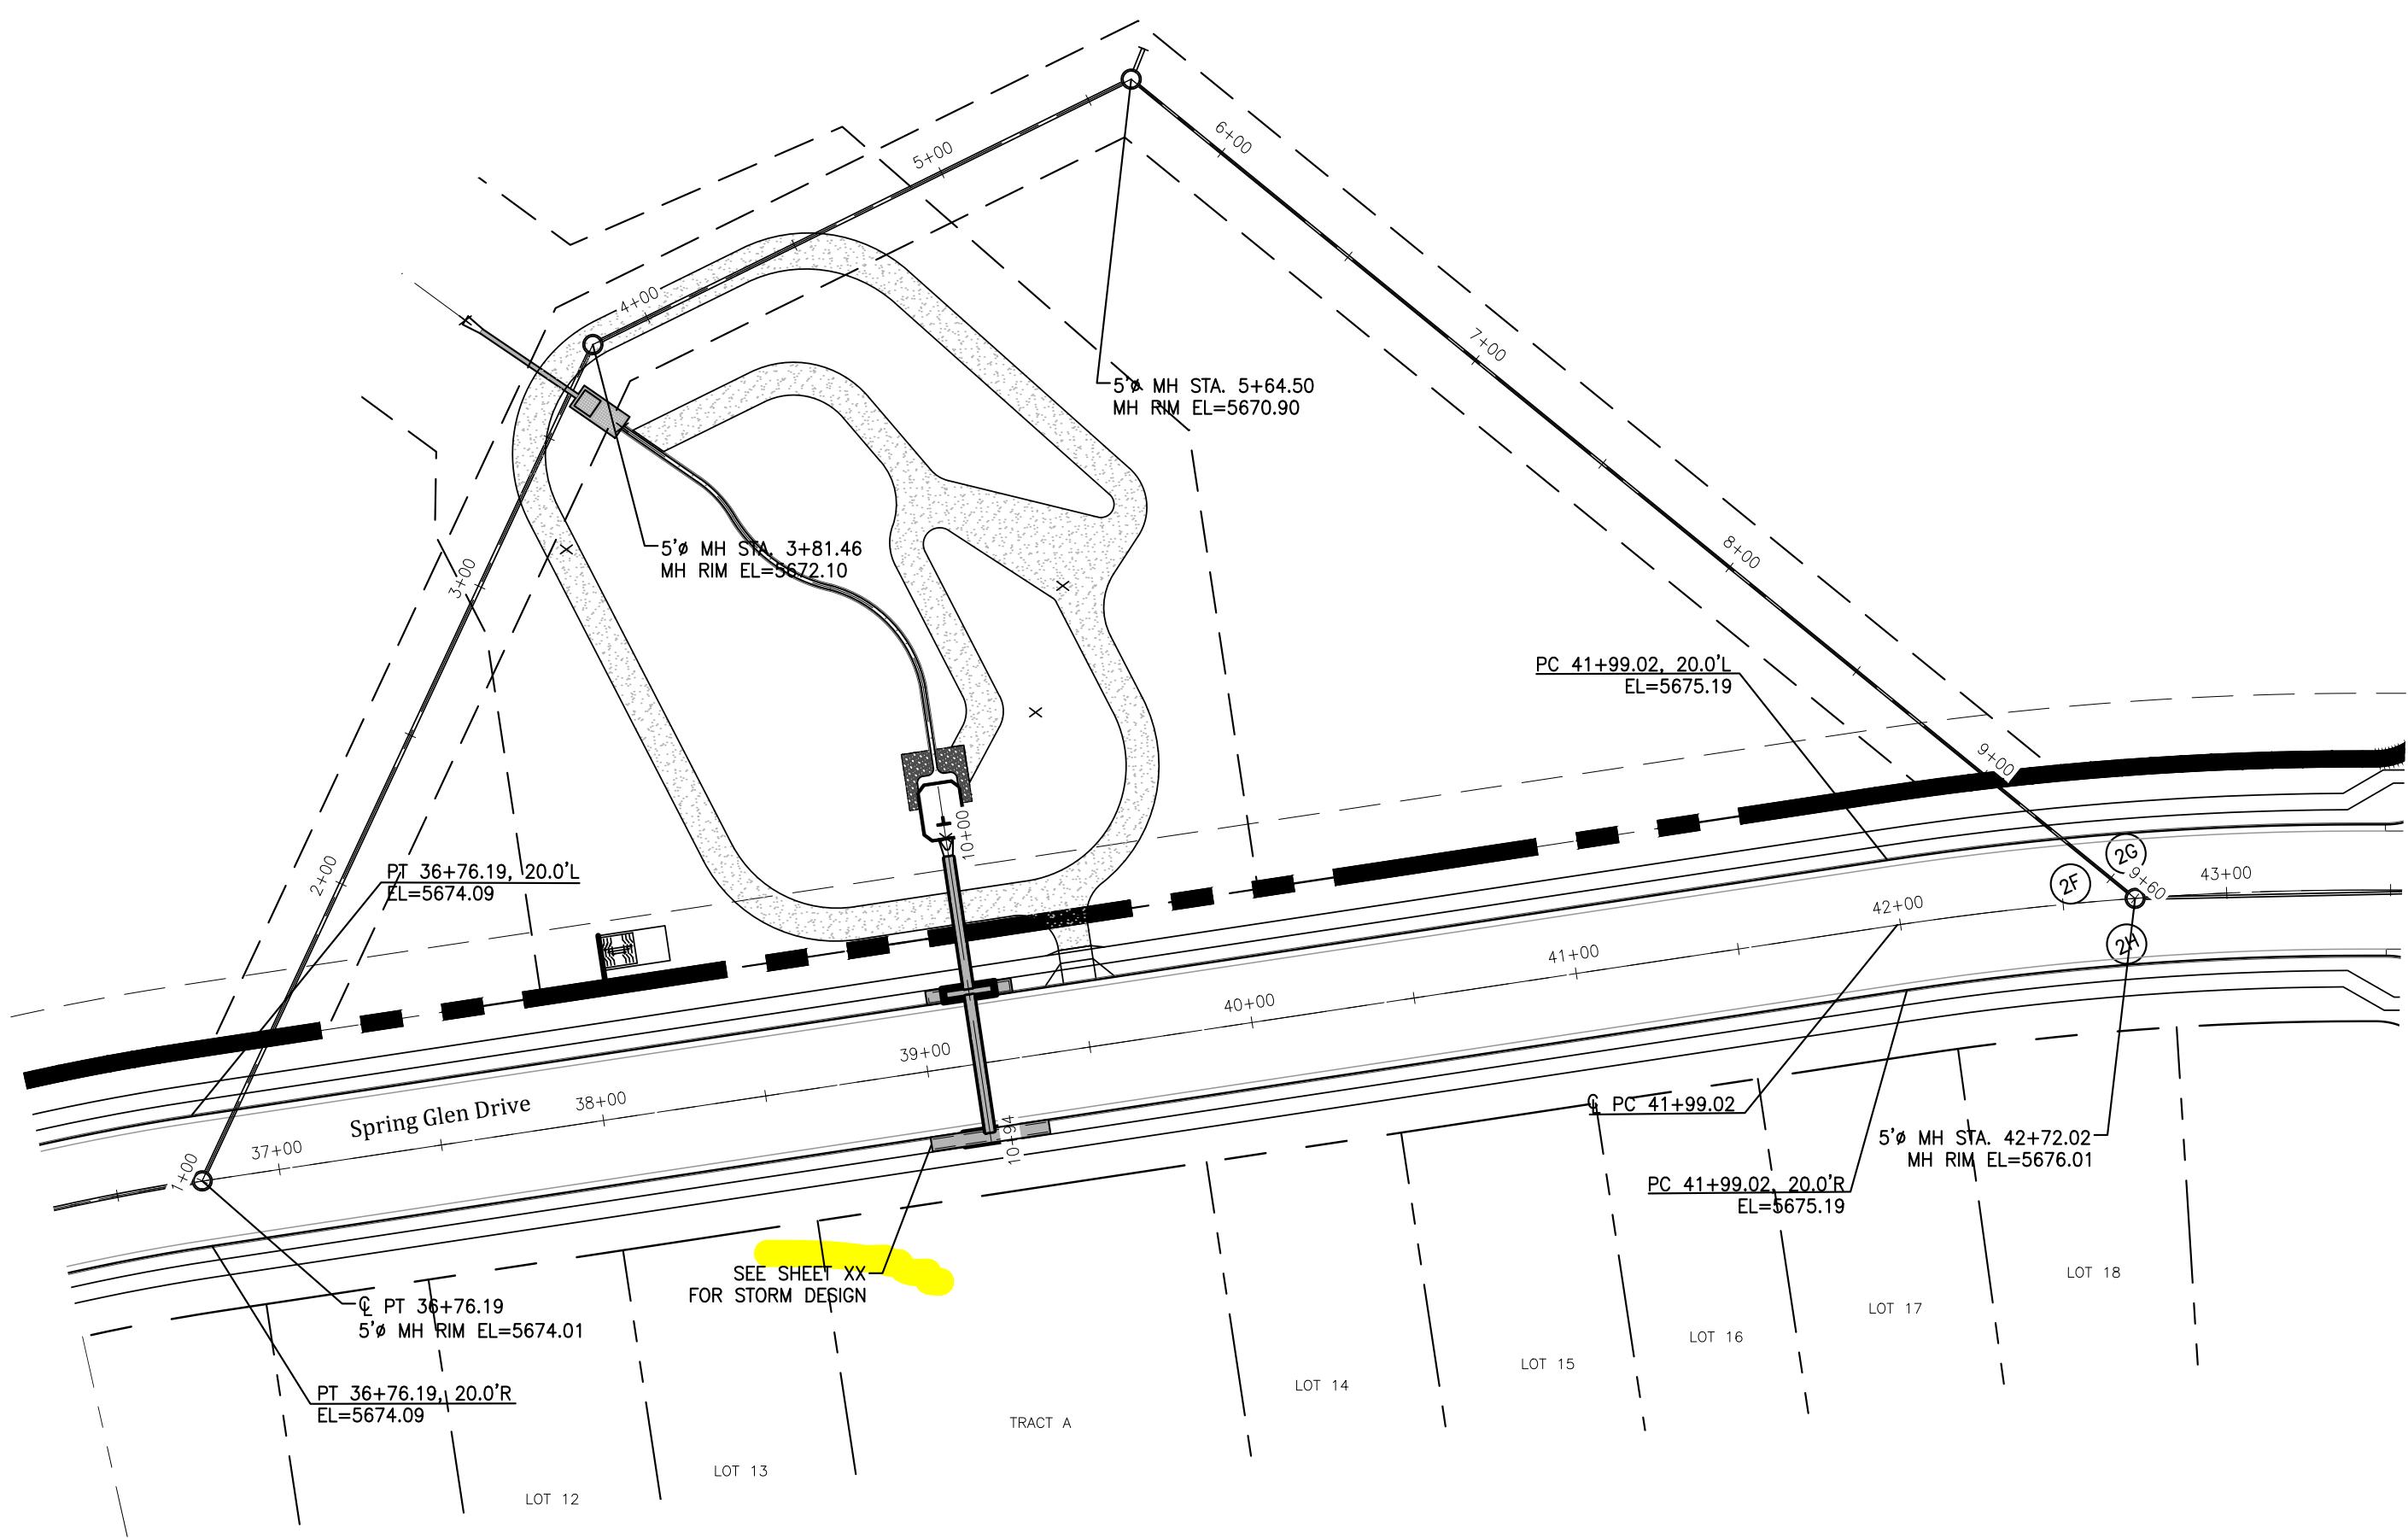


Adjust ROW at intersections so the sidewalks are completely the ROW.

Identify the width/thickness of the crosspan at all locations. The cross pan detail notes different width and thickness depending on the road classification.

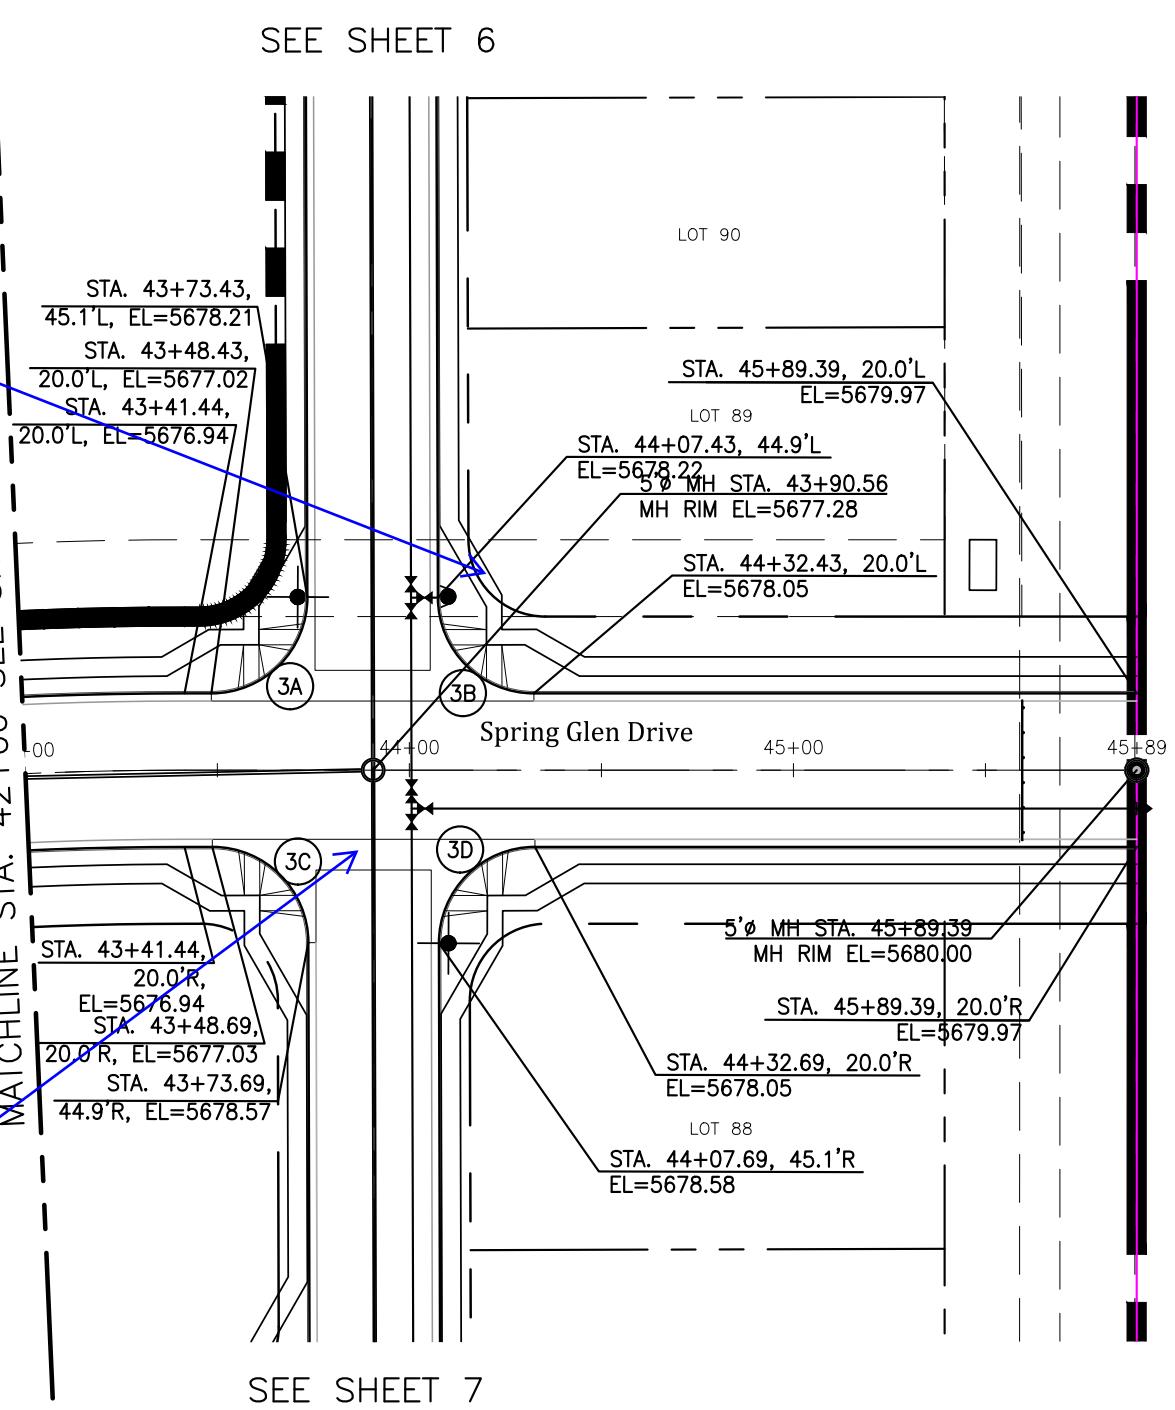



update street names.

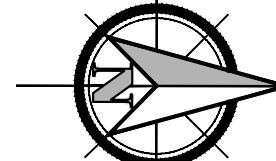

A scale bar diagram consisting of a horizontal line with tick marks at 0, 50', and 1'. The distance between 0 and 50' is divided into four equal segments by three internal tick marks. A checkered pattern (black and white squares) is placed over the first two segments from 0, representing a scale of 1 inch equals 50 feet.



Project No.:	17038
Date:	December 15, 2017
Design:	AWMc
Drawn:	JAK
Check:	AWMc
Revisions:	

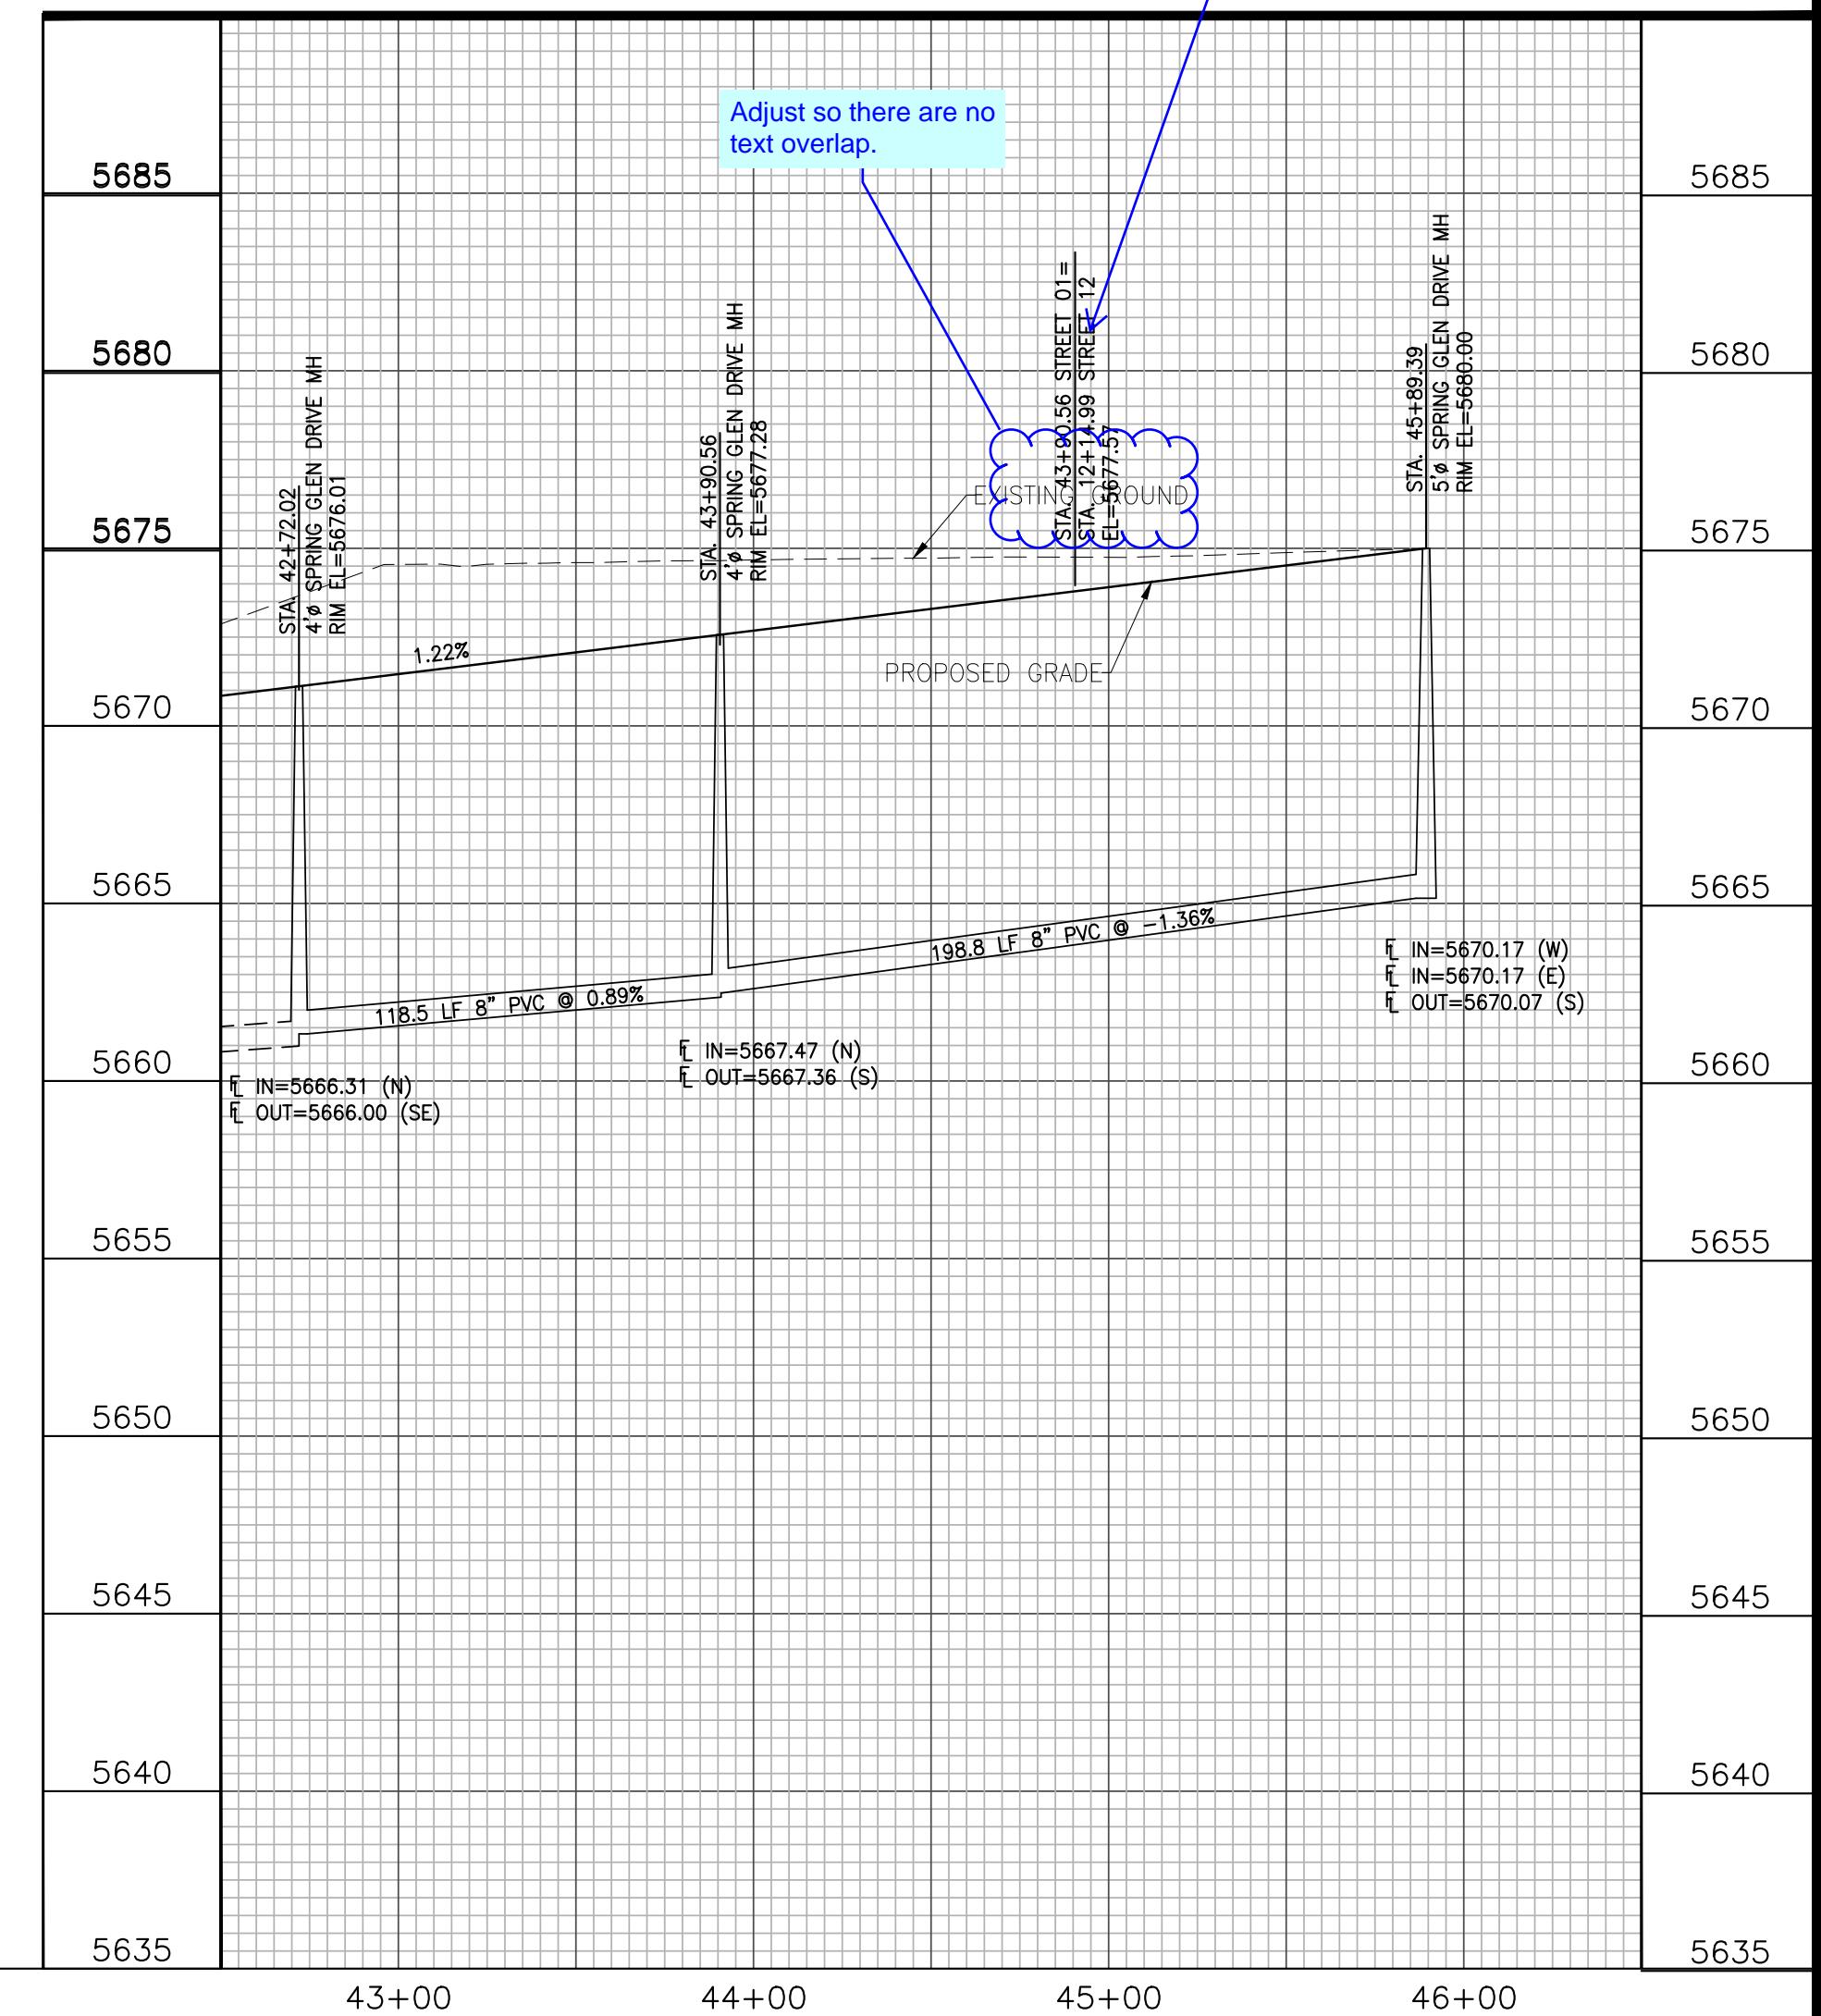
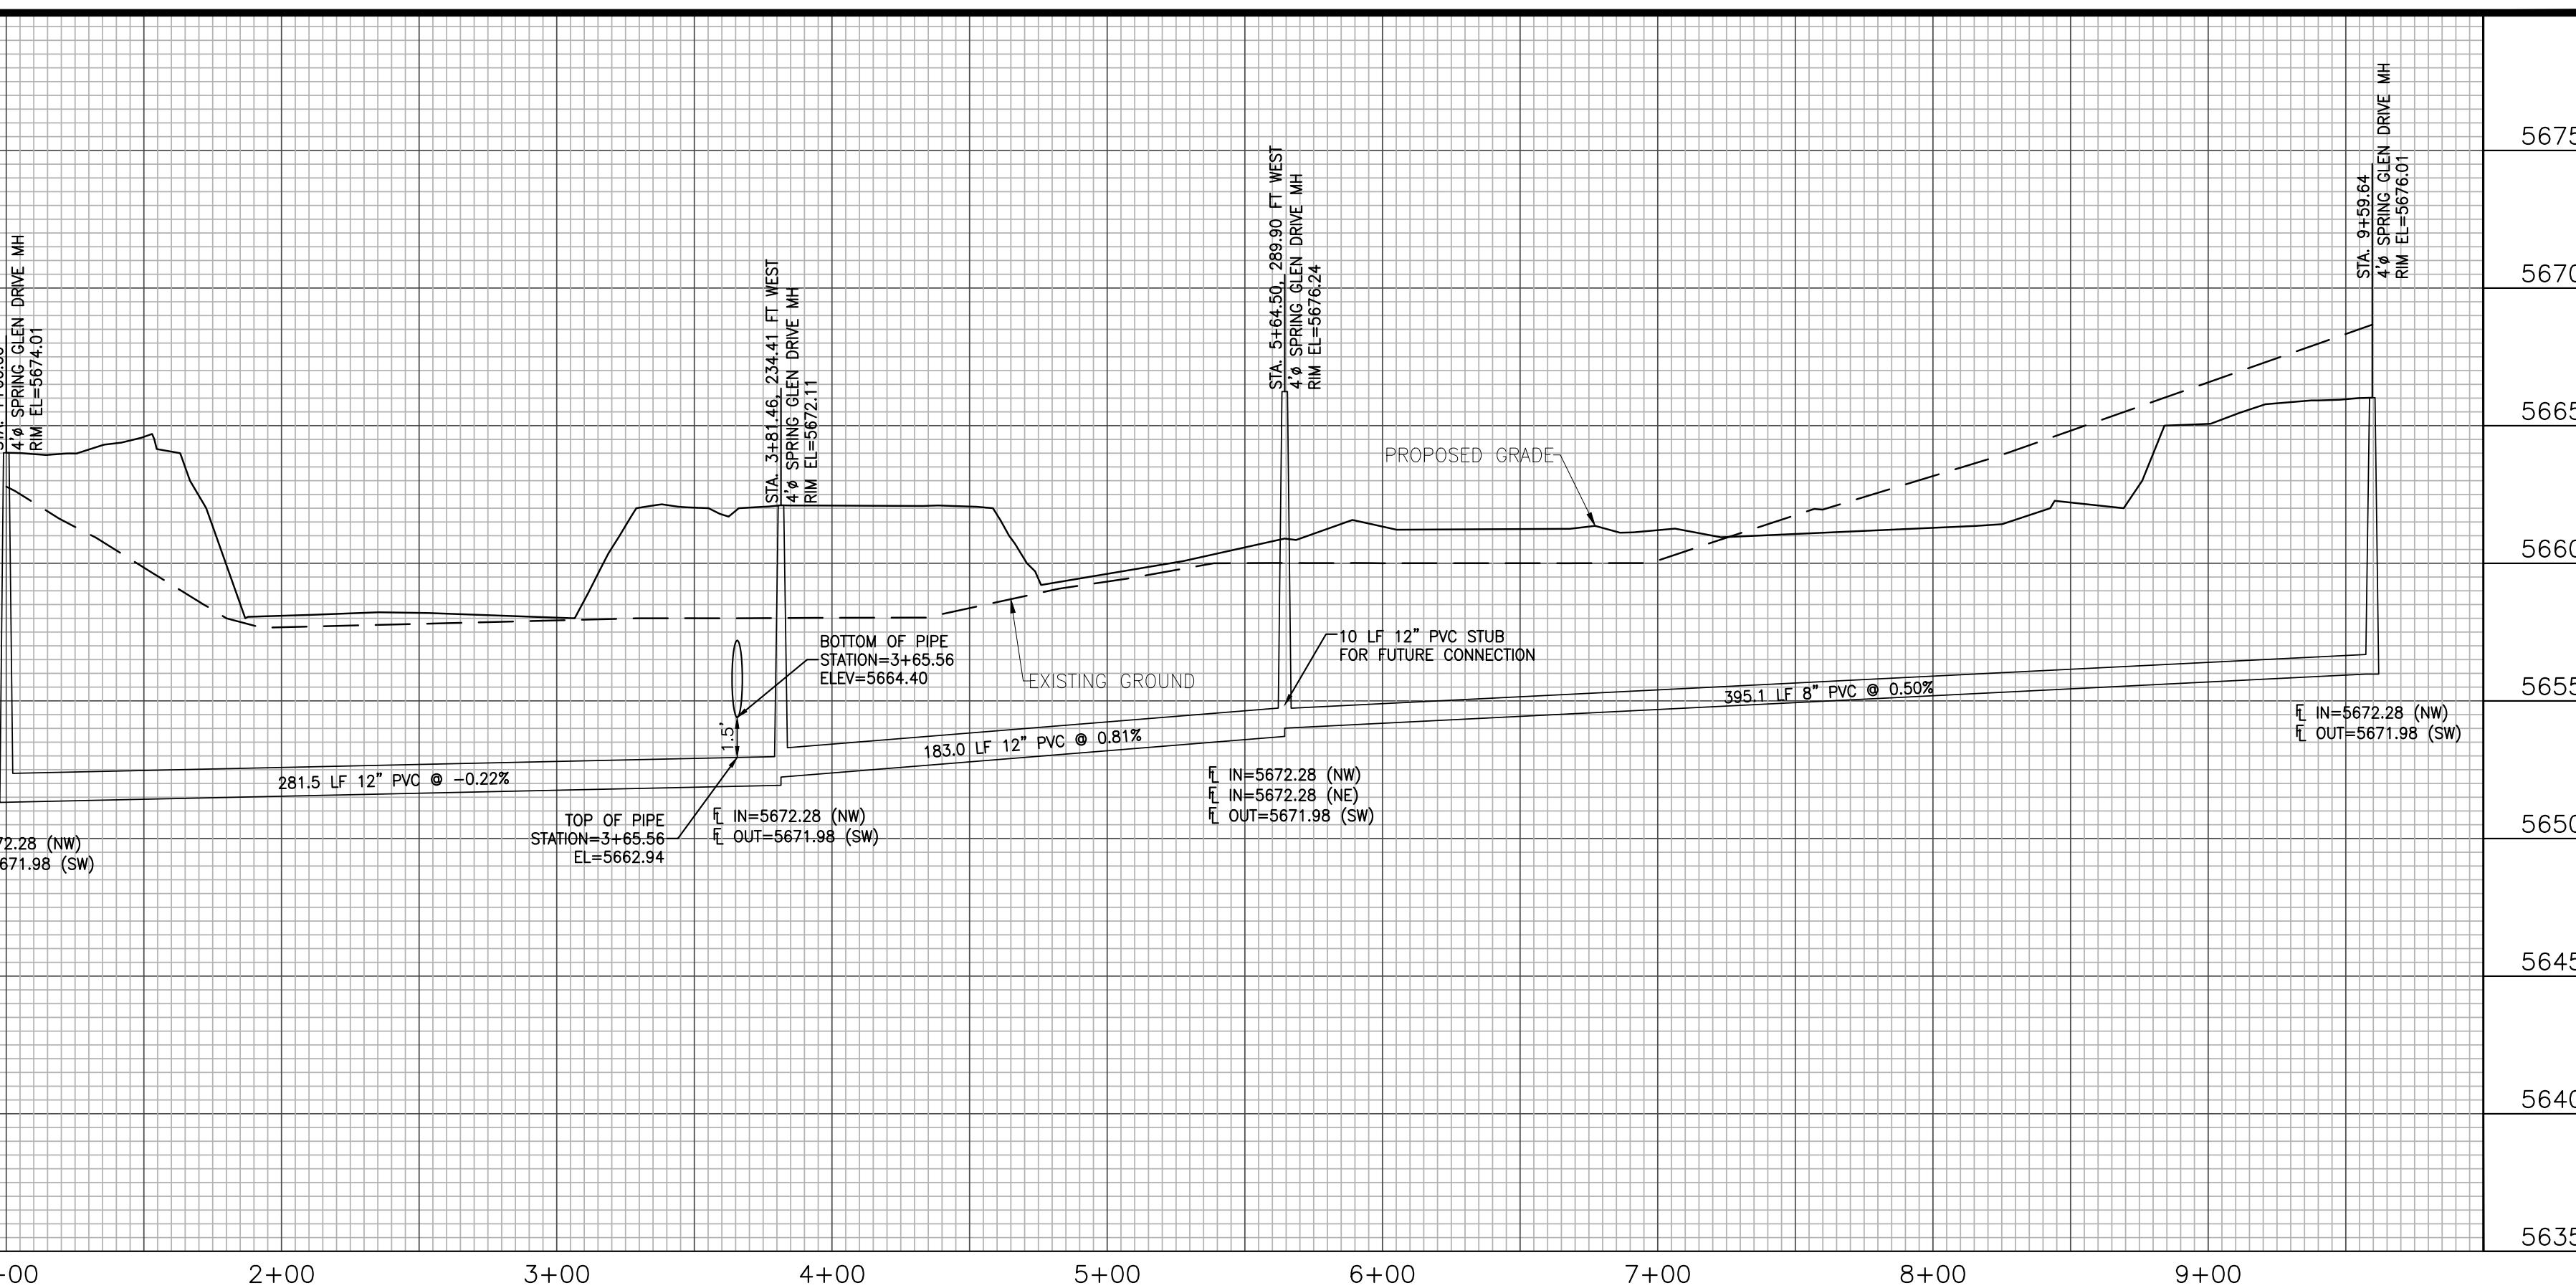


3



**GLEN AT WIDEFIELD FILING NO. 9
BIGTOOTH MAPLE DRIVE (Sta. 25+50 to Sta. 37+82)
PLAN AND PROFILE
EL PASO COUNTY, COLORADO**



Project No.: 17038
Date: December 15, 2017
Design: AWMc
Drawn: JAK
Check: AWMc
Revisions:


SHEET 4
4 of 20 Sheets

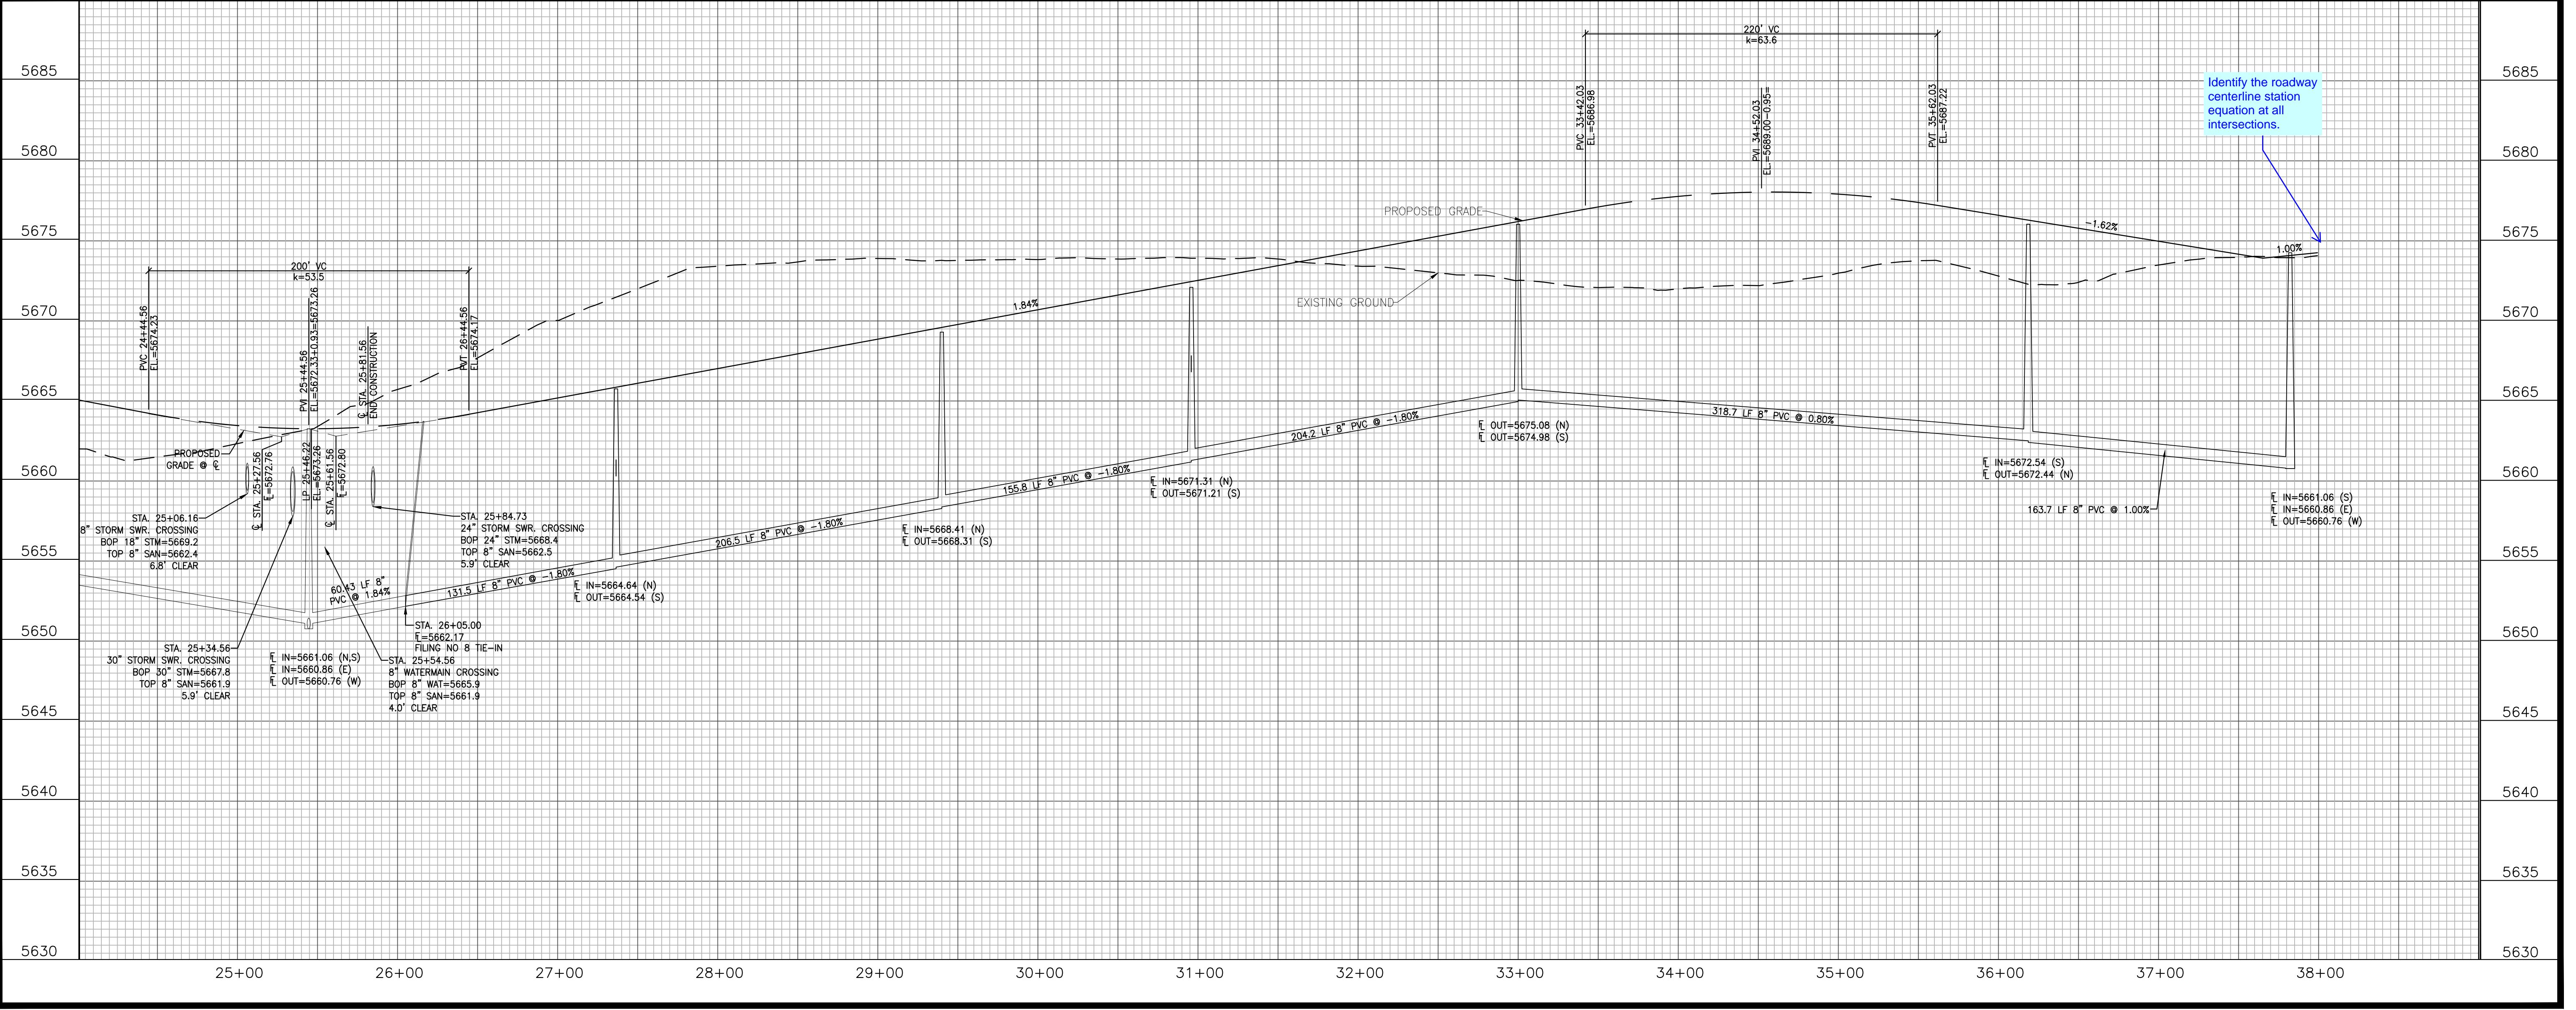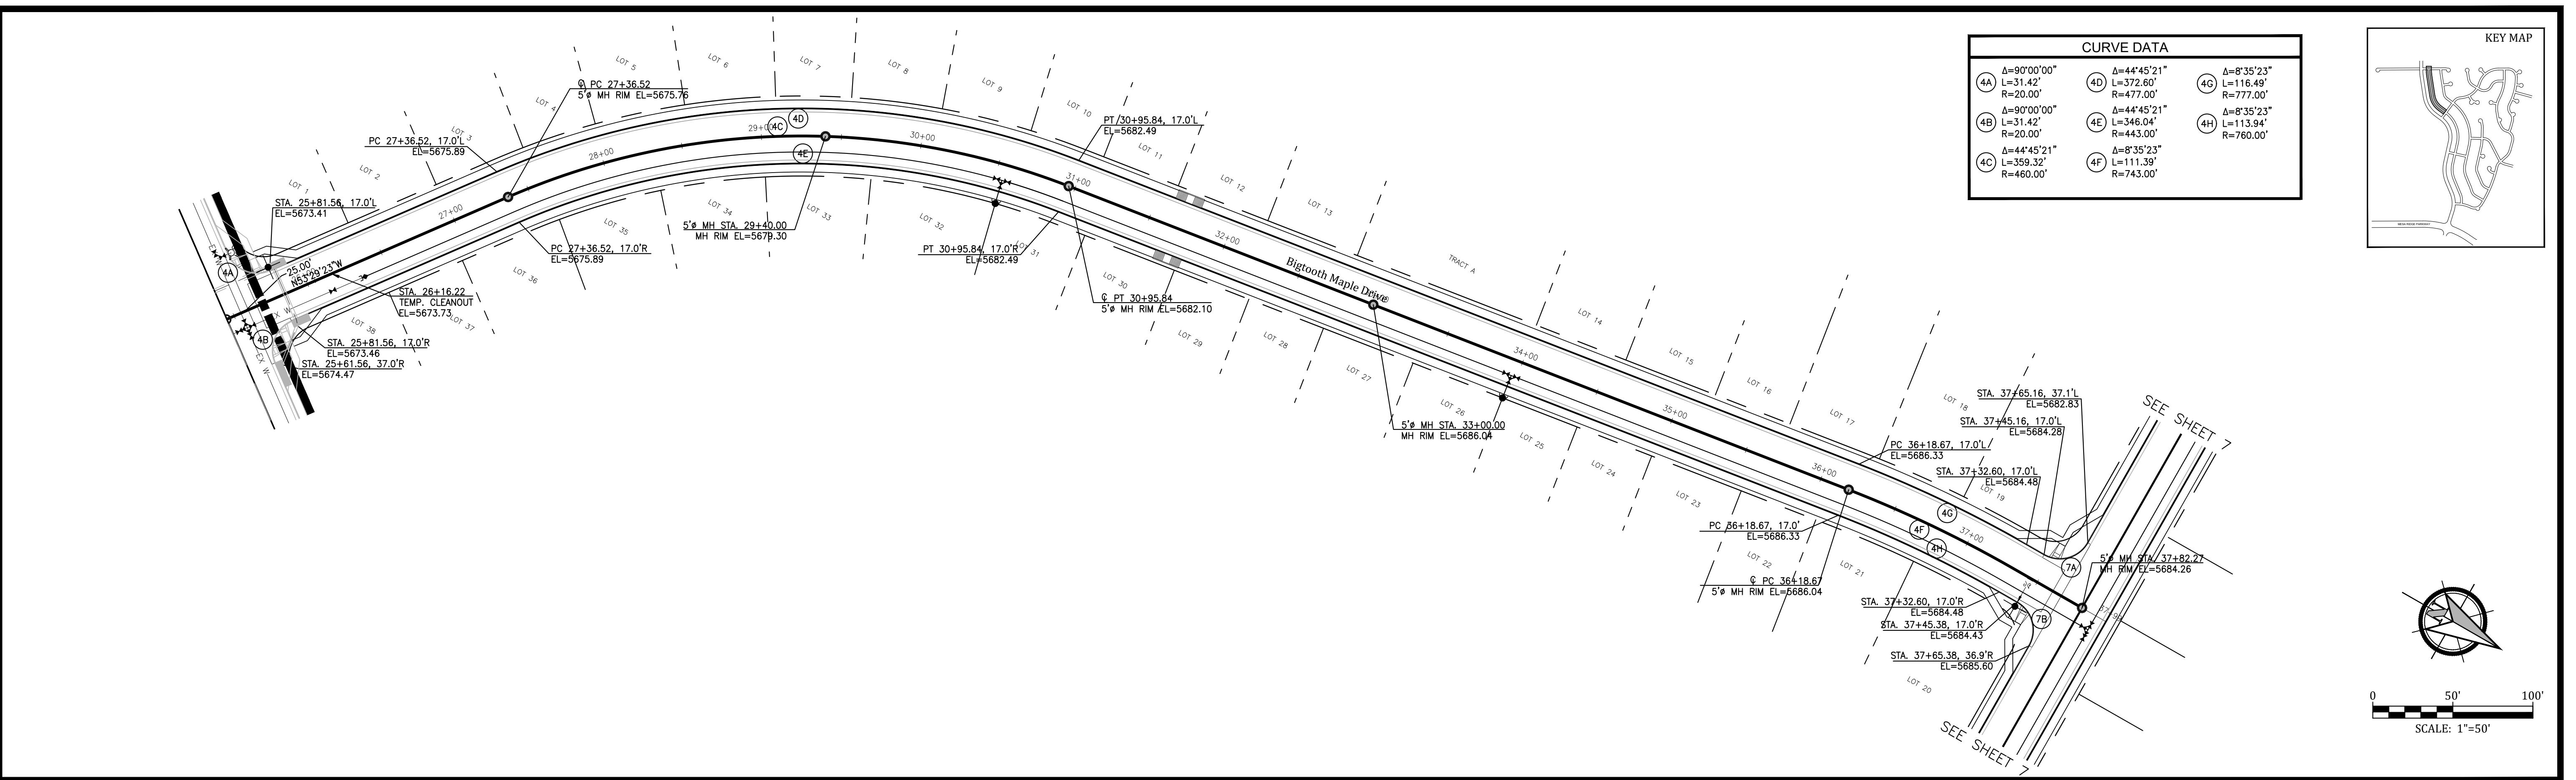

**GLEN AT WIDEFIELD FILING NO. 9
PEACHLEAF DRIVE (Sta. 25+00 to Sta. 38+36)
PLAN AND PROFILE
EL PASO COUNTY, COLORADO**

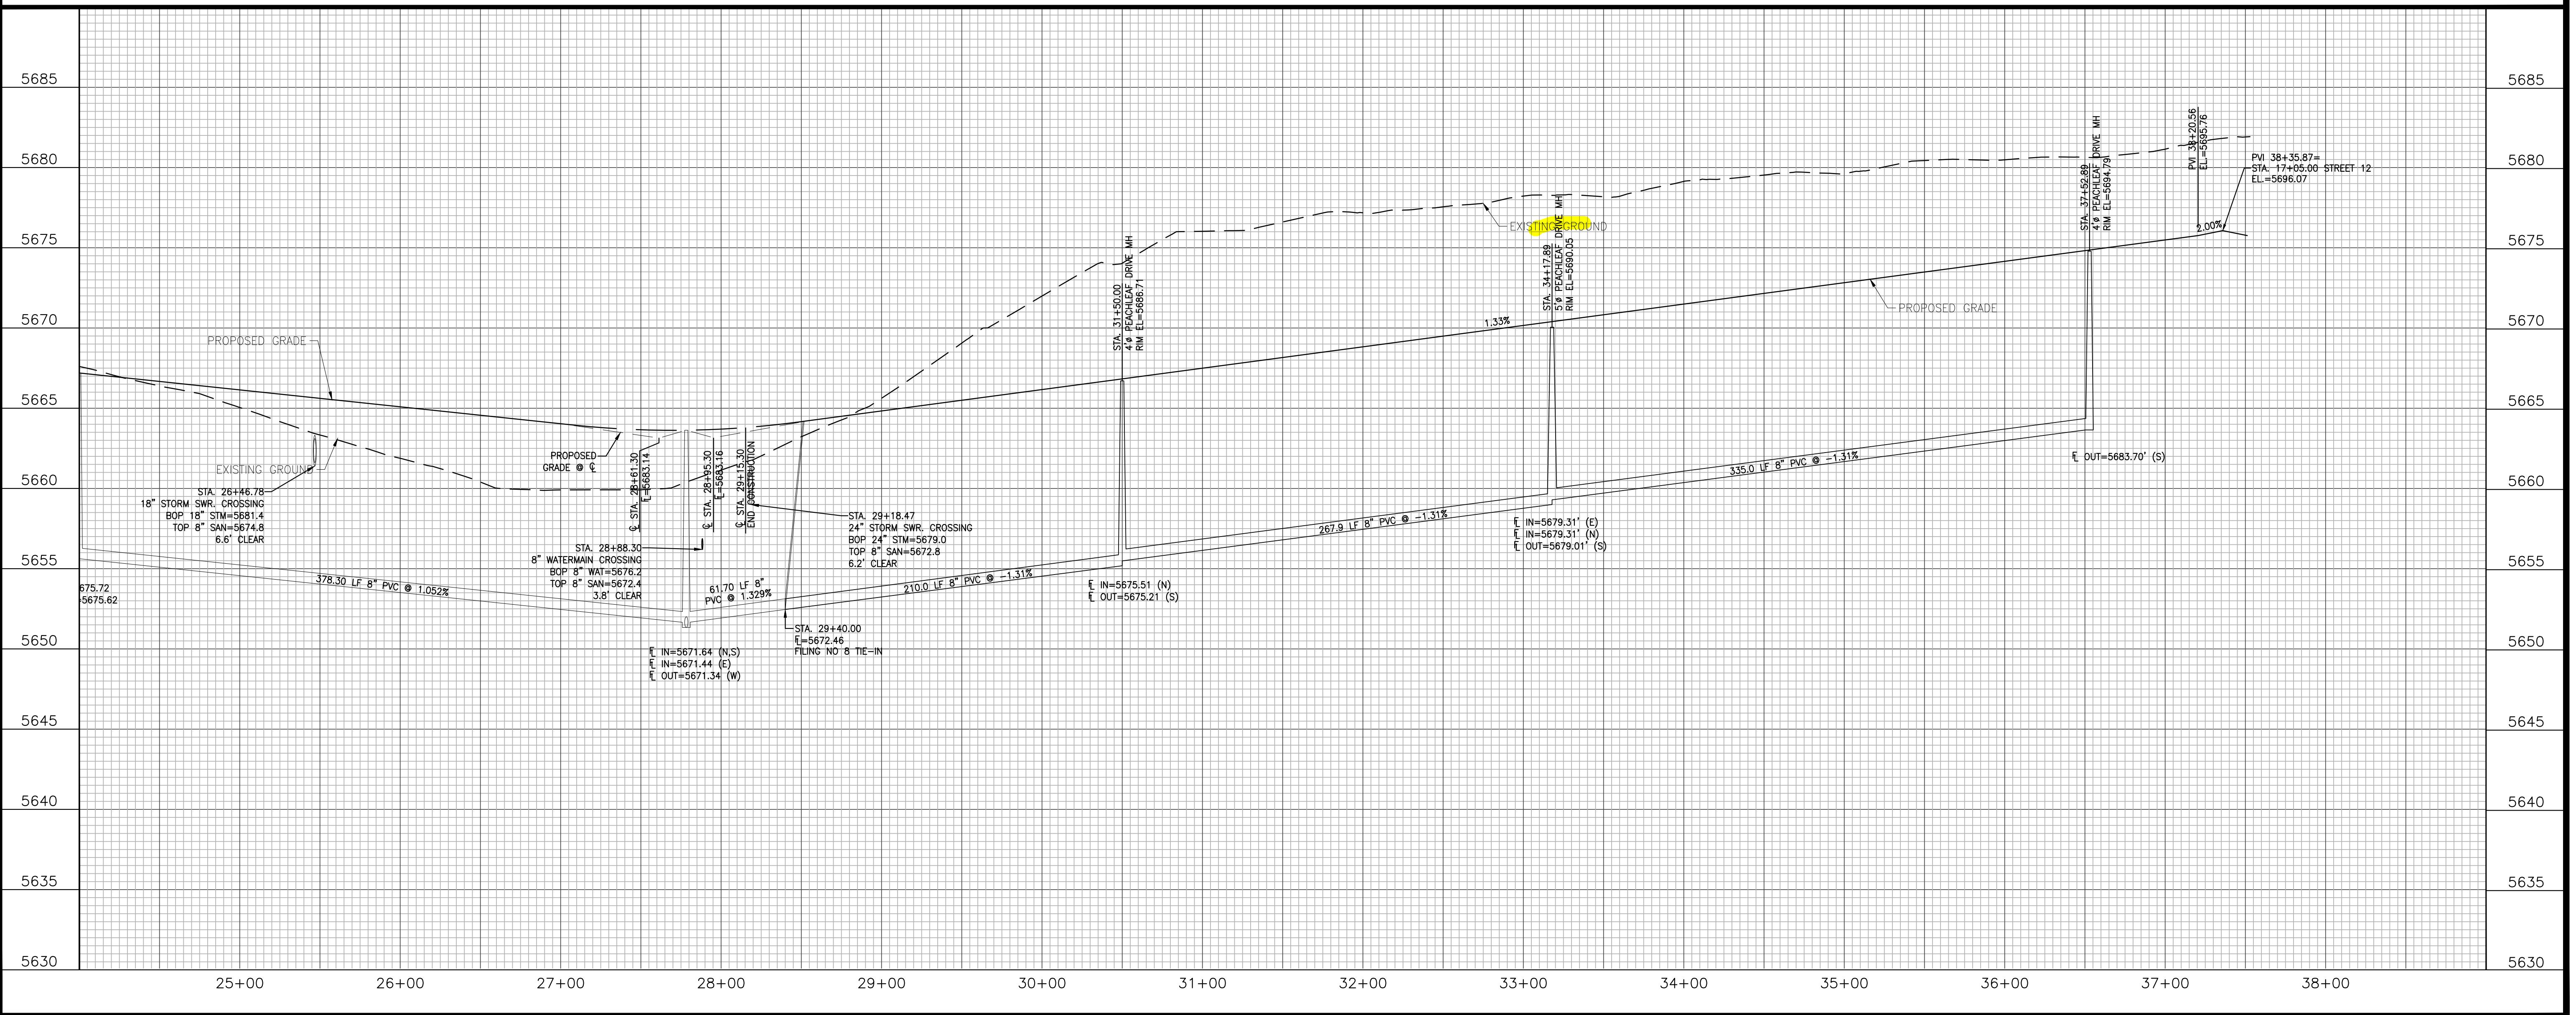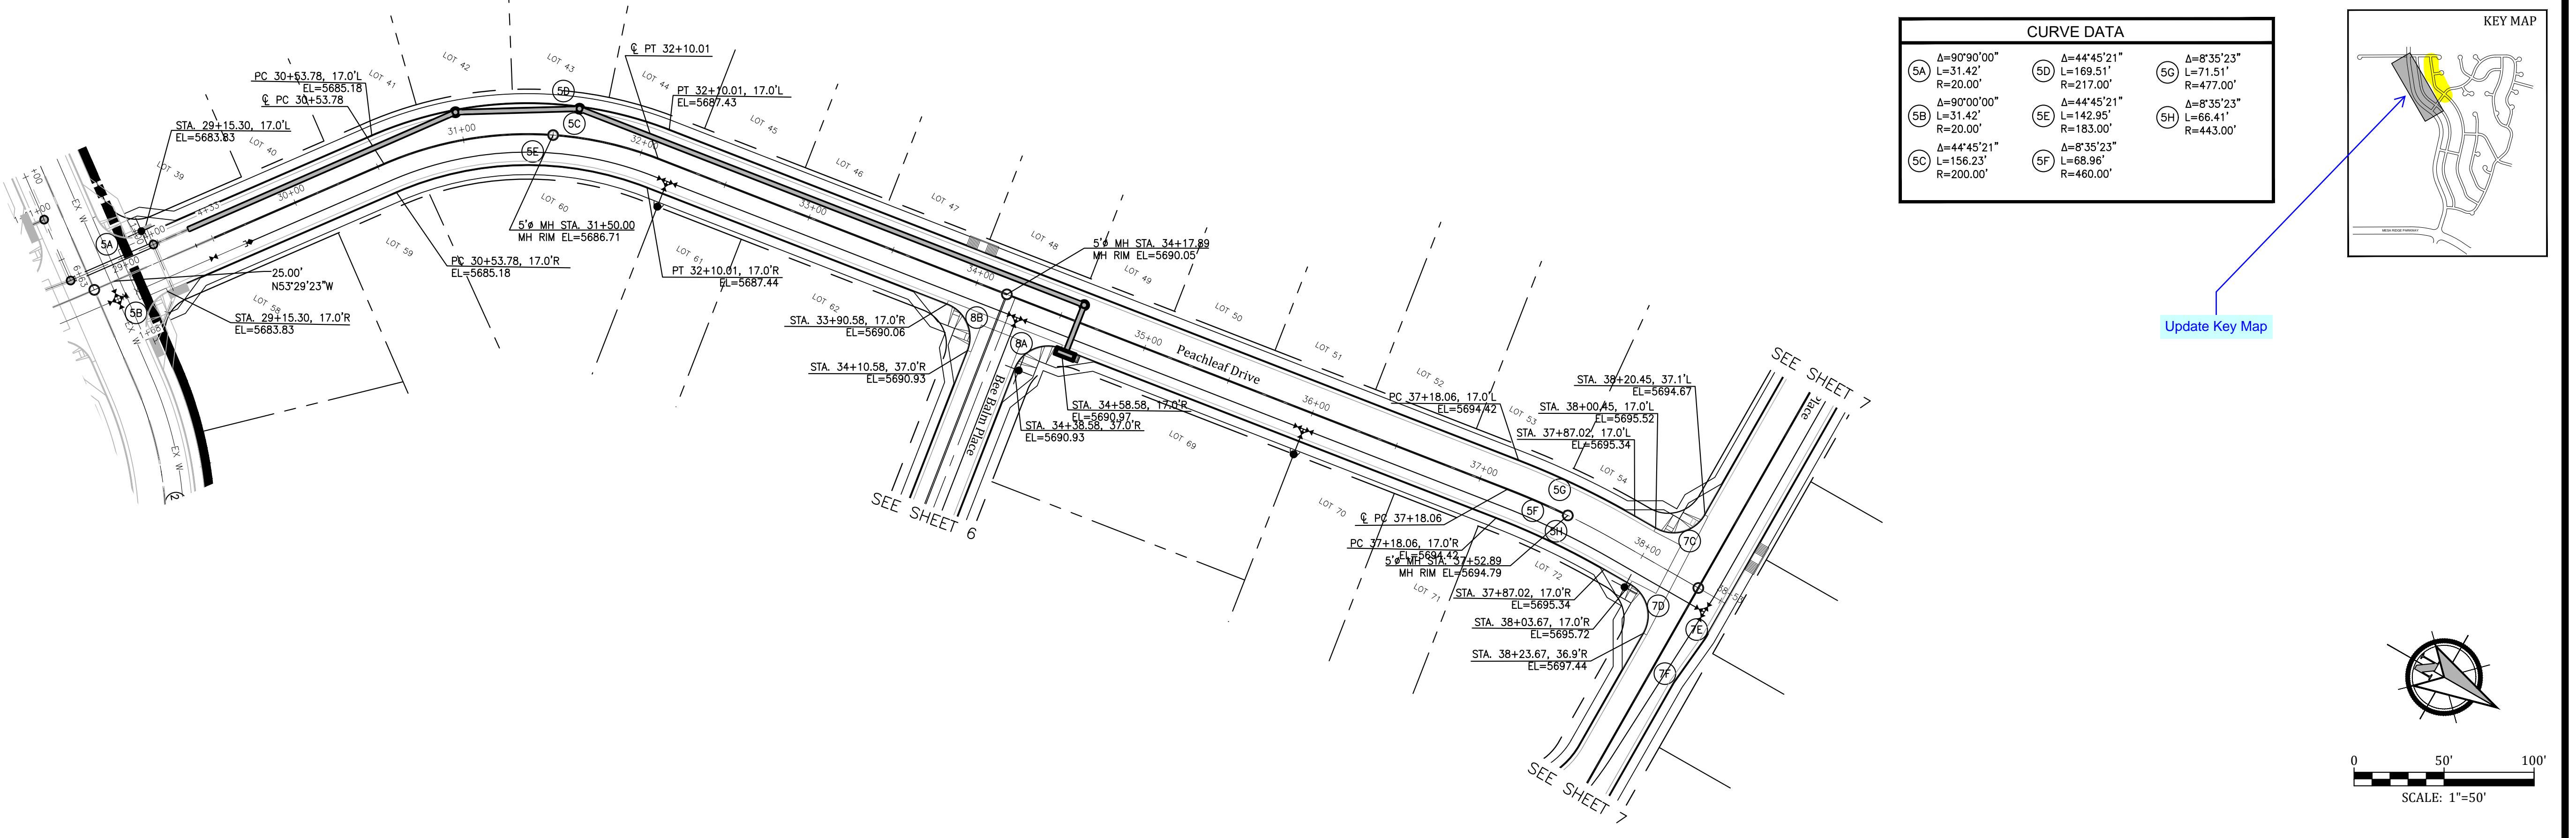

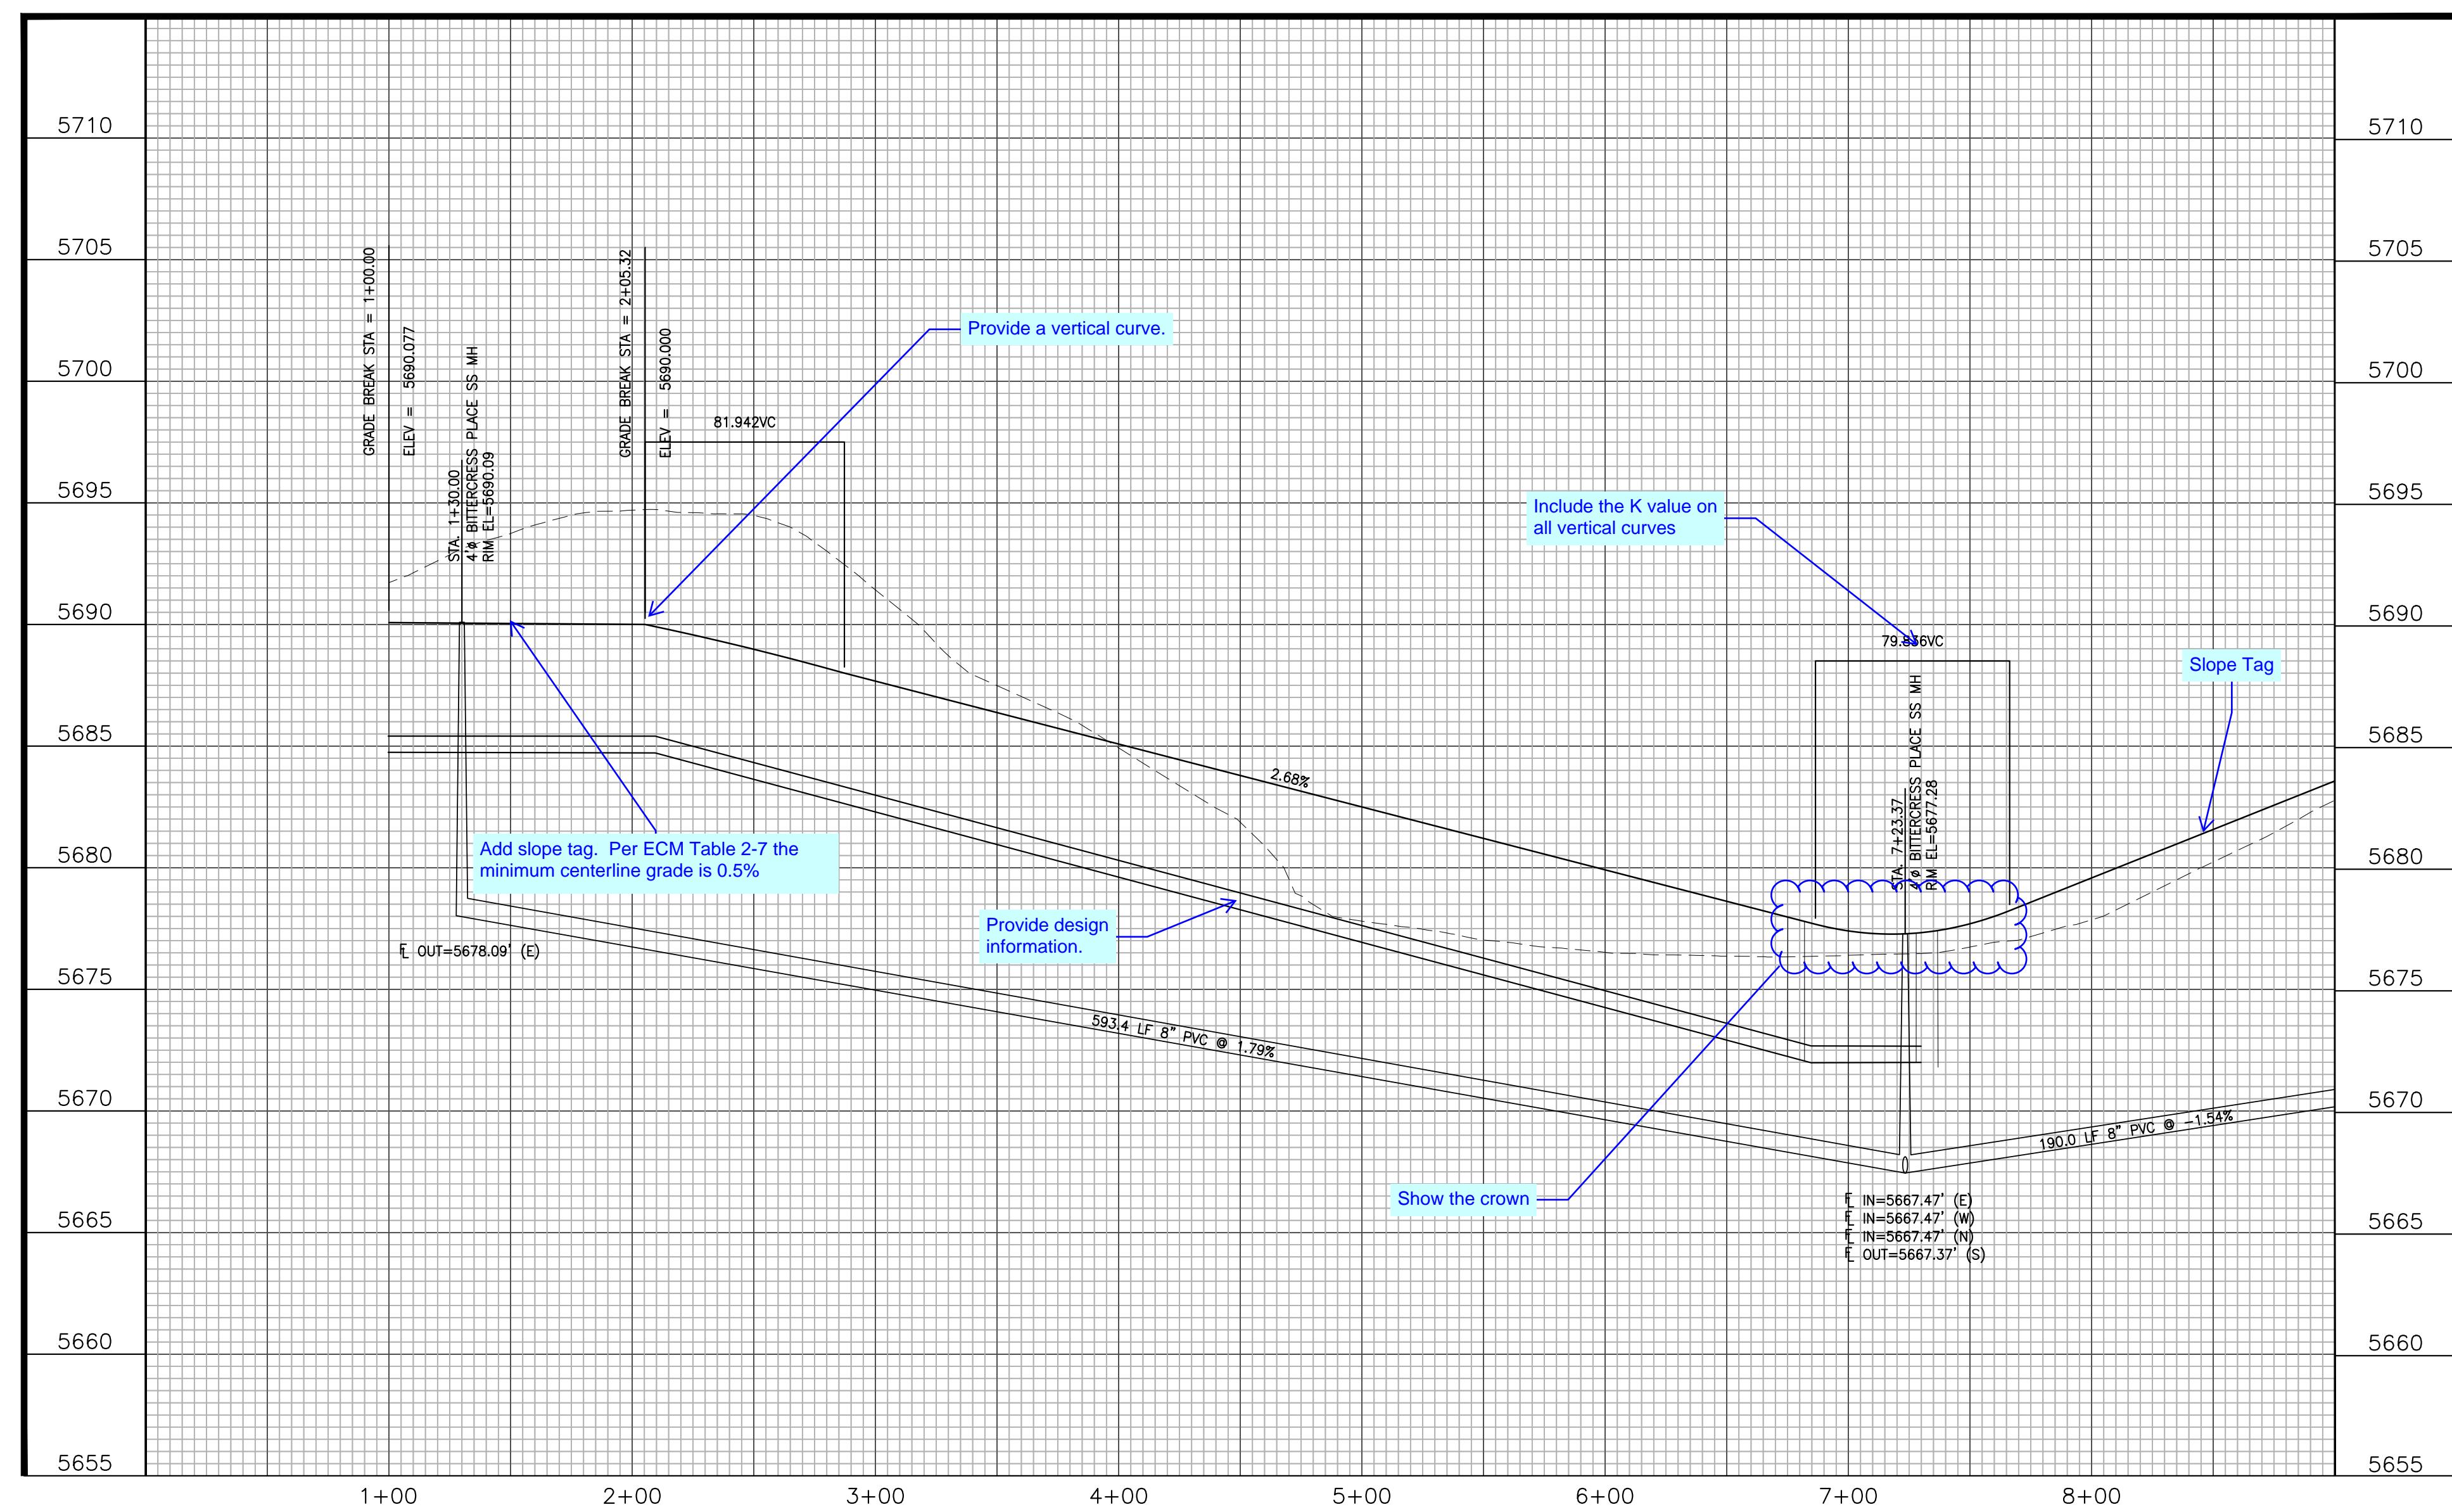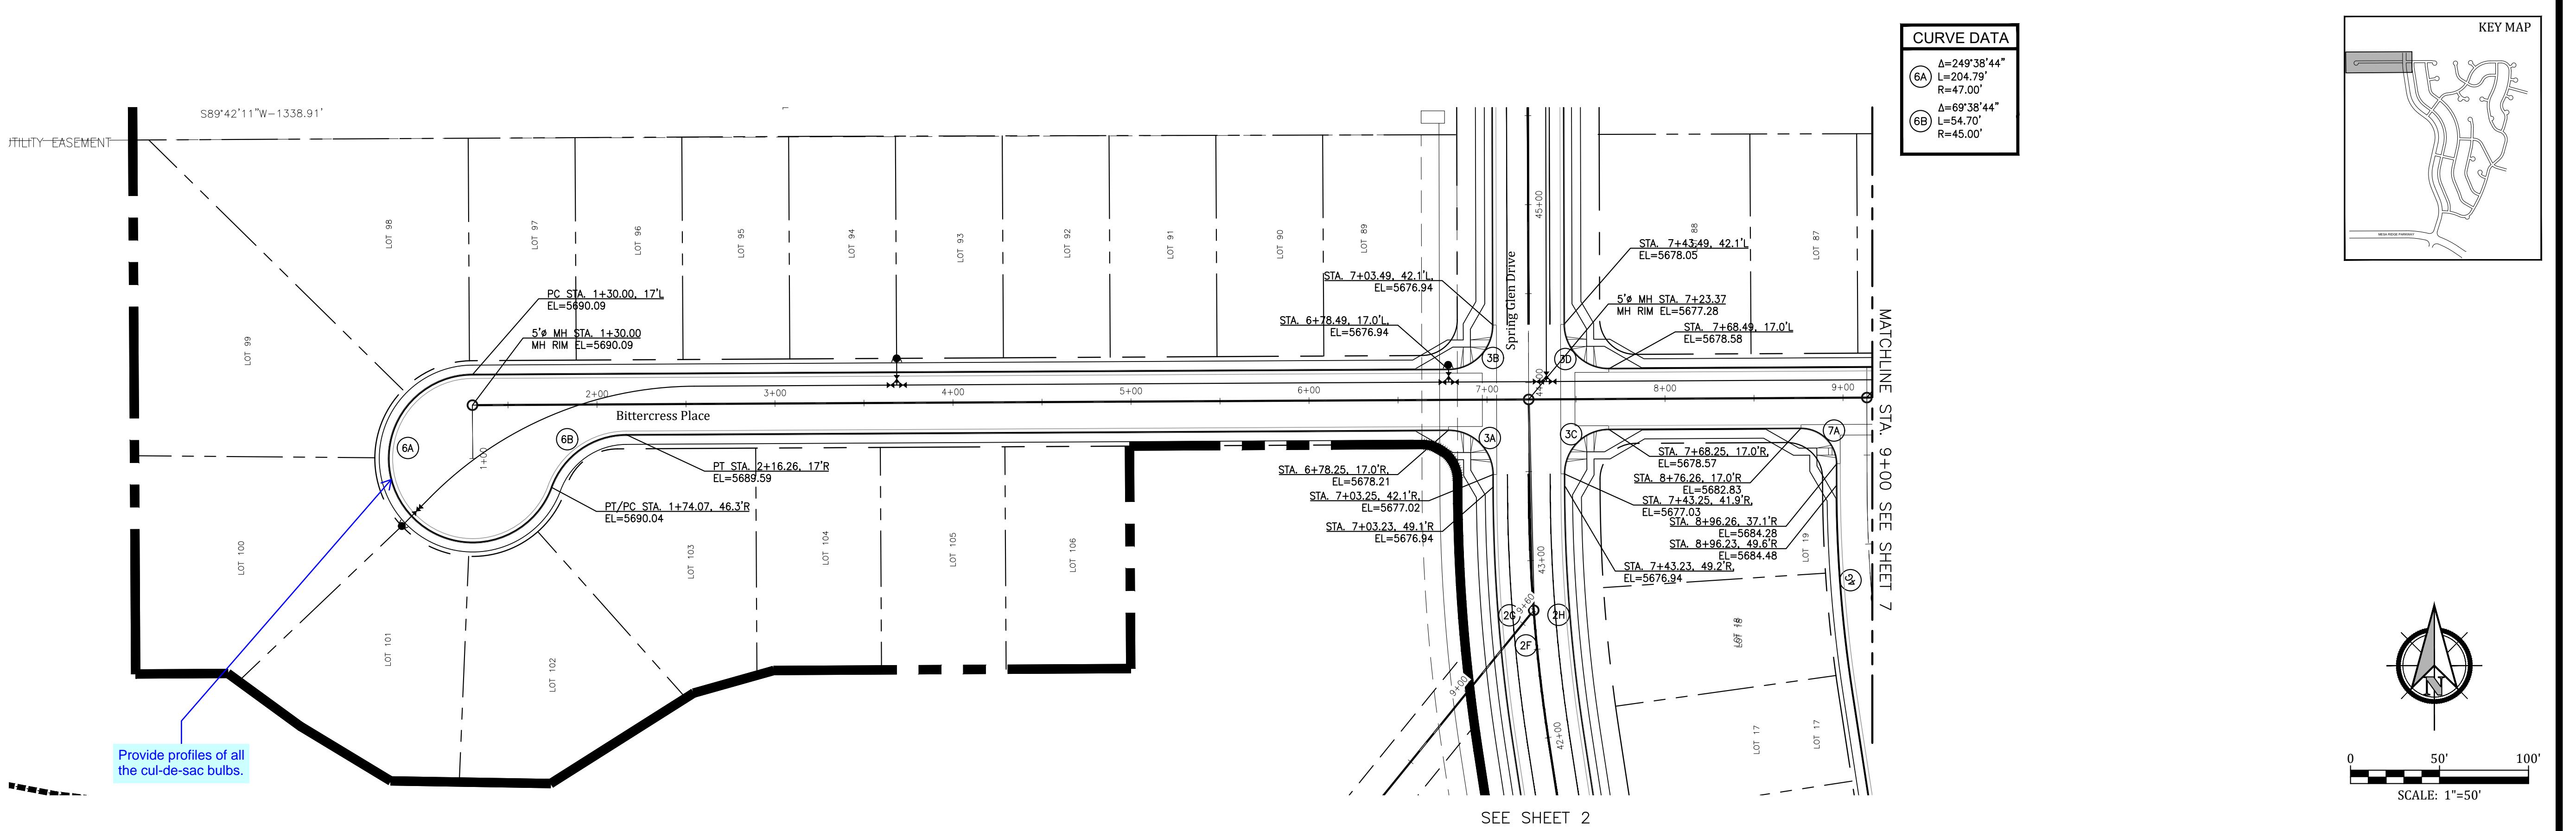

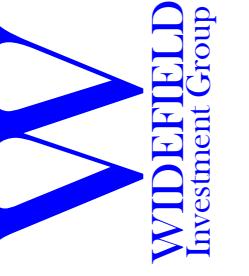


GLEN AT WILDFIELD FILING NO. 9
BITTERCRESS PLACE (Sta. 9+00 to Sta. 14+39)
PLAN AND PROFILE
EL PASO COUNTY, COLORADO

Project No.: 17038
Date: December 15, 2017
Design: AWMc
Drawn: JAK
Check: AWMc
Revisions:



SHEET

7

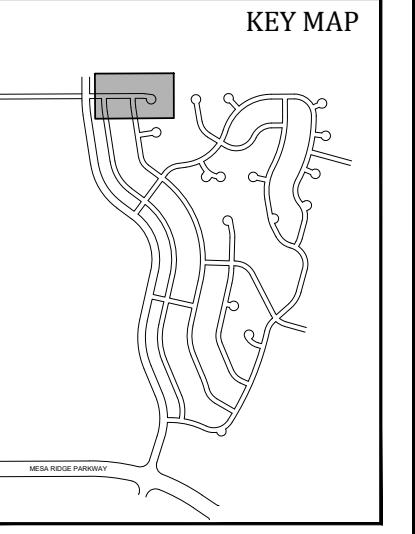

0 50' 100'
SCALE: 1"=50'

CURVE DATA	
7A	$\Delta=90^{\circ}09'59''$ L=31.47' R=20.00'
7D	$\Delta=89^{\circ}50'01''$ L=31.36' R=20.00'
7G	$\Delta=89^{\circ}50'01''$ L=31.36' R=20.00'
7B	$\Delta=89^{\circ}50'01''$ L=31.36' R=20.00'
7E	$\Delta=542'38''$ L=2.49' R=25.00'
7H	$\Delta=259^{\circ}45'06''$ L=204.01' R=45.00'
7C	$\Delta=90^{\circ}09'59''$ L=31.47' R=20.00'
7F	$\Delta=542'38''$ L=2.49' R=25.00'
7I	$\Delta=71^{\circ}12'09''$ L=55.92' R=45.00'

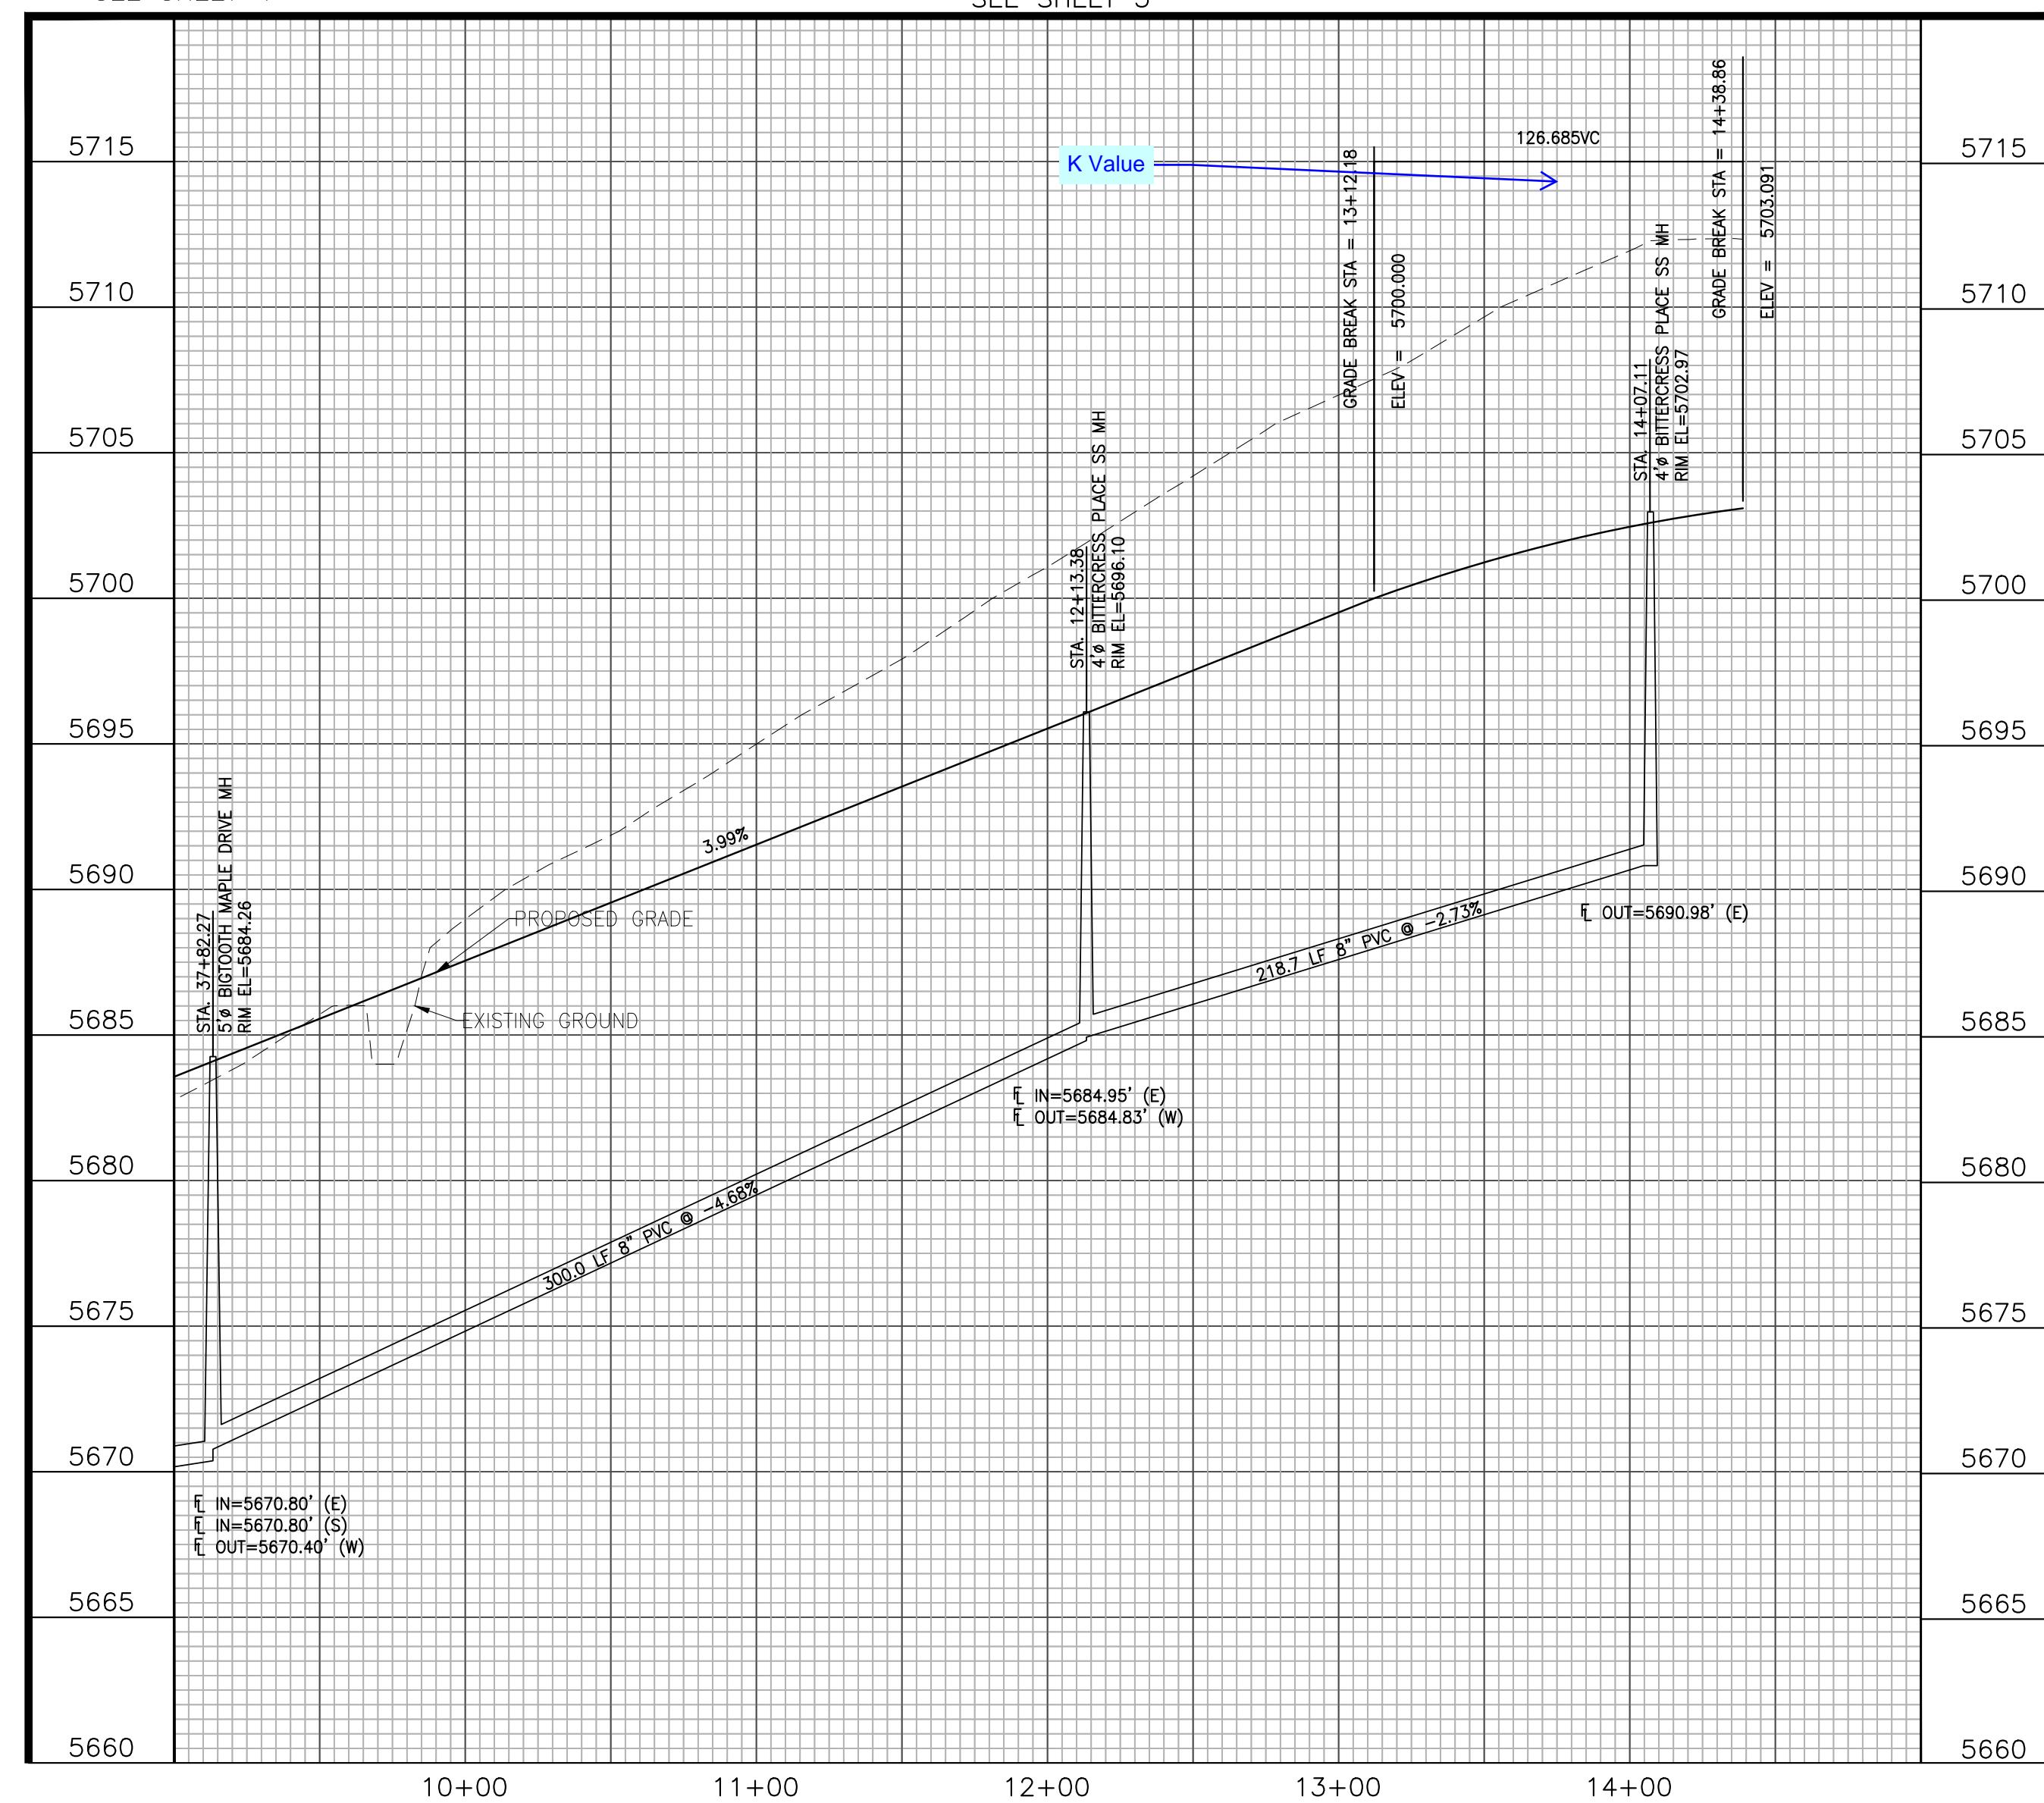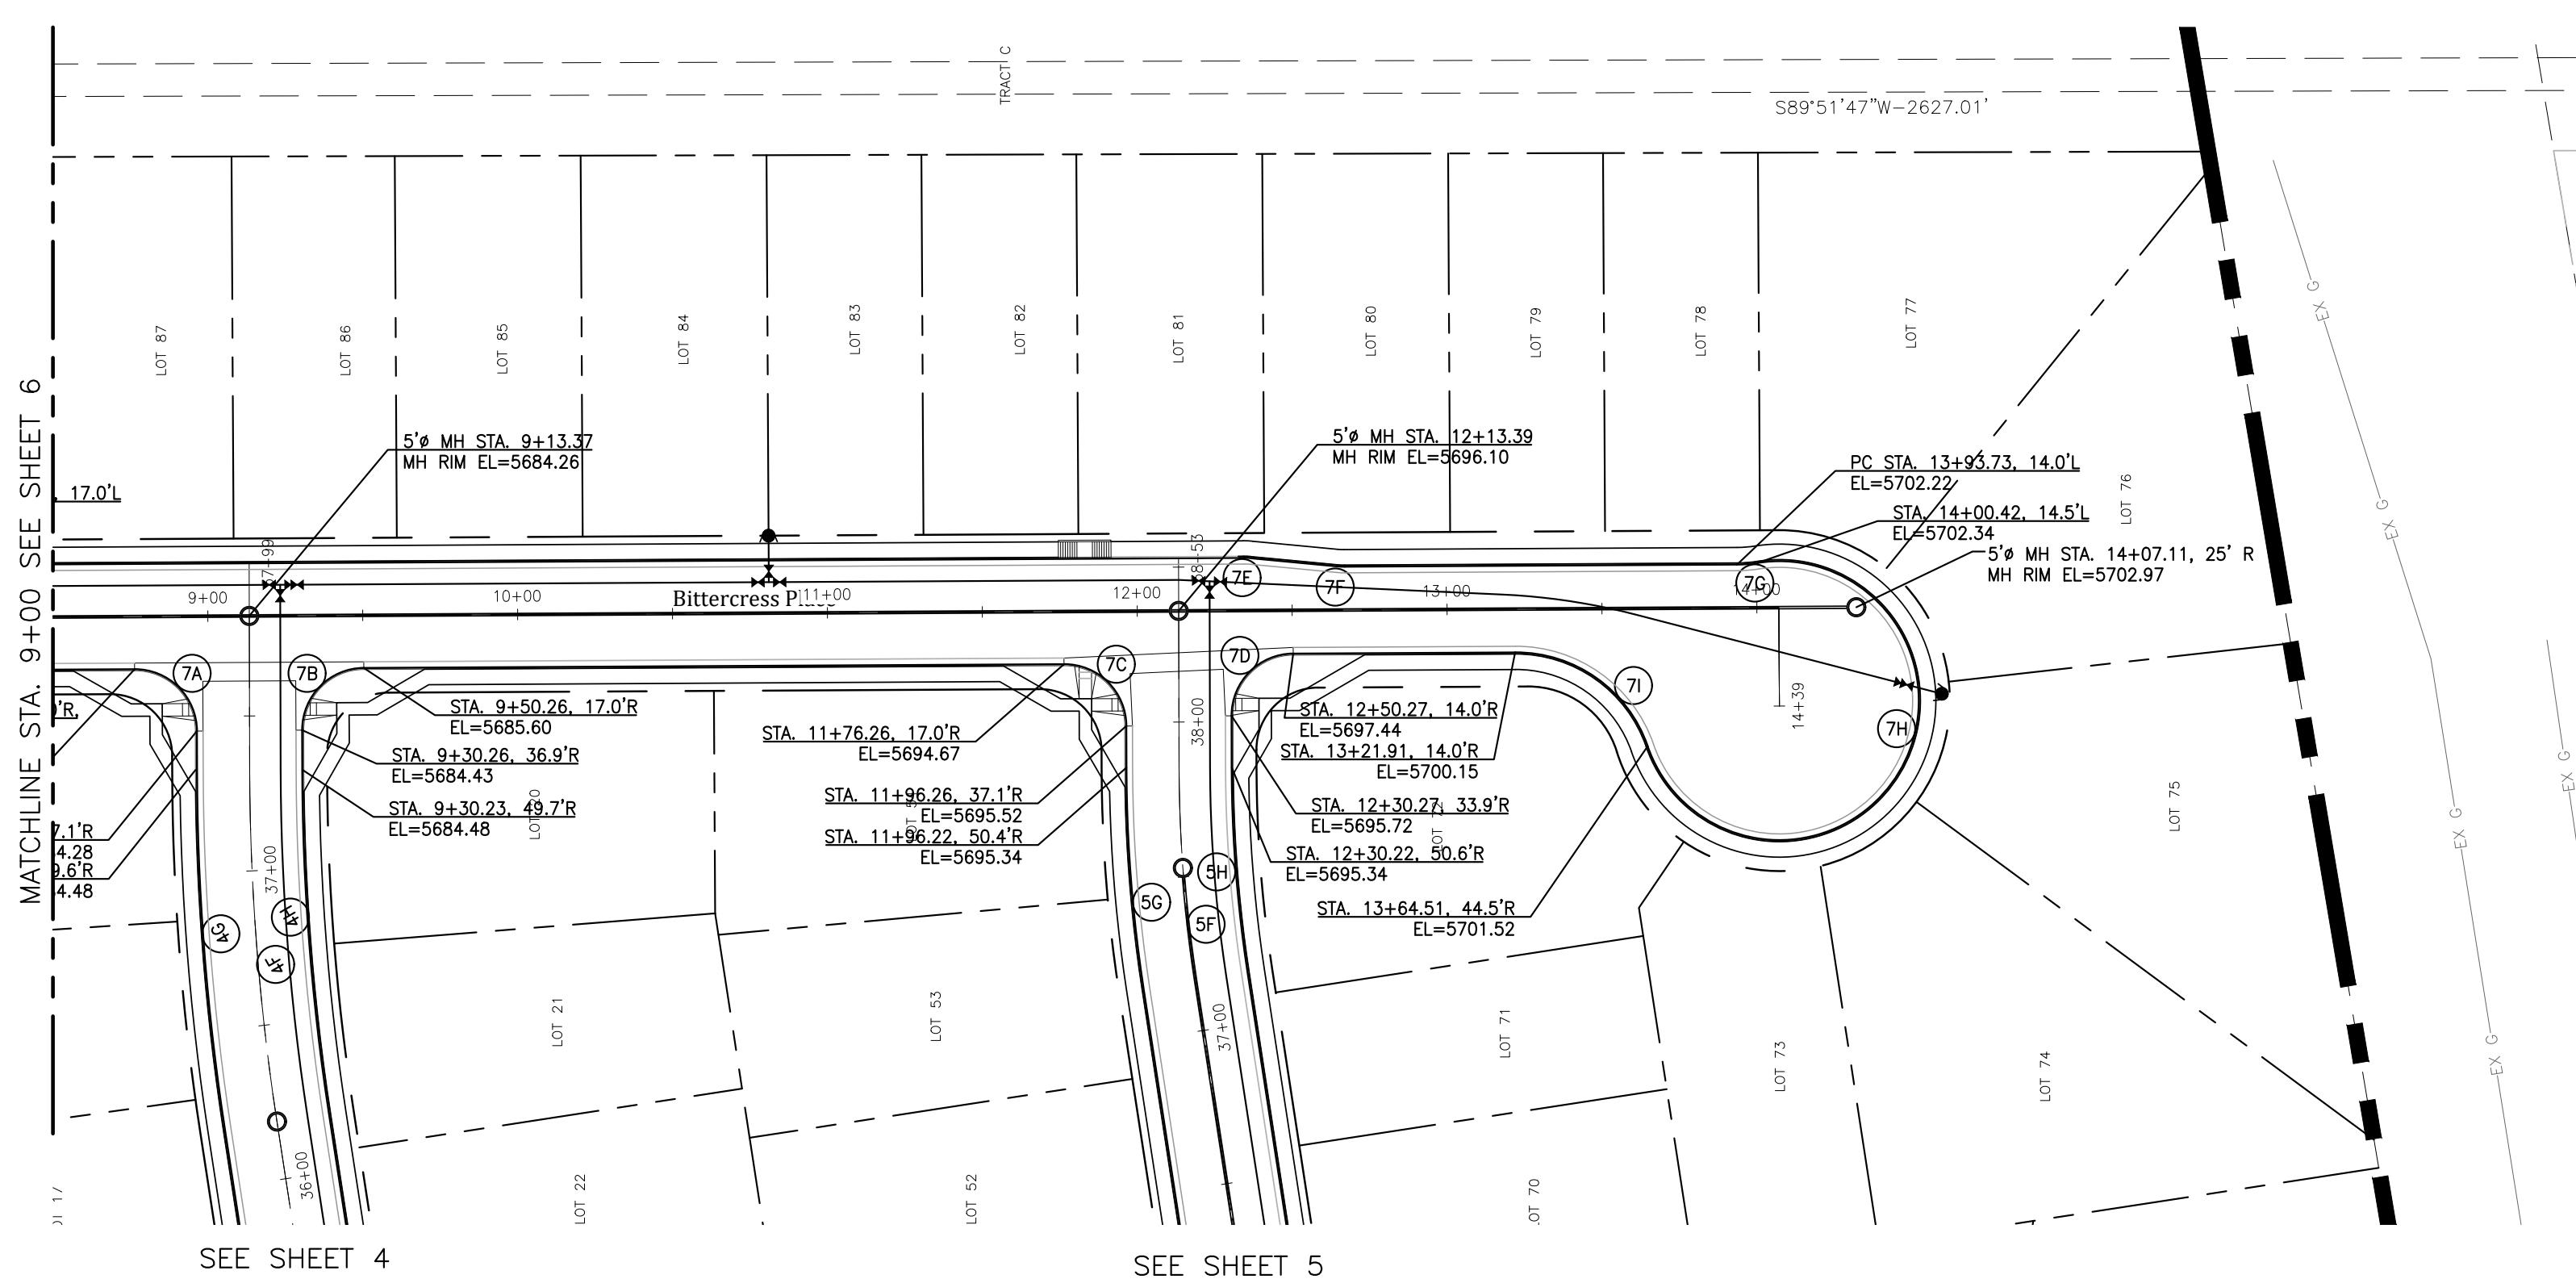


**GLEN AT WIDEFIELD FILING NO. 9
BEE BALM PLACE (Sta. 1+00 to Sta. 3+51)
PLAN AND PROFILE
EL PASO COUNTY, COLORADO**


Project No.: 17038
Date: December 15, 2017
Design: AWMc
Drawn: JAK
Check: AWMc
Revisions:

SHEET



8

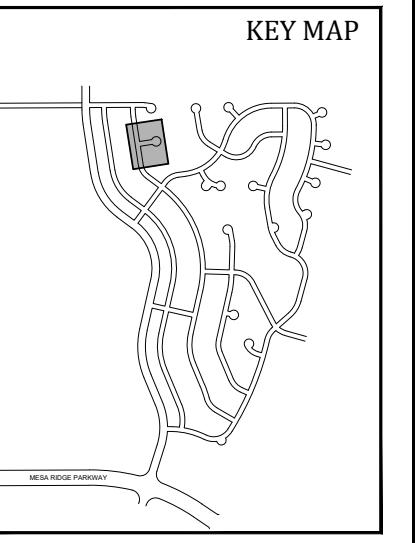

CURVE DATA		
Δ=49°02'18"	L=38.51'	R=45.00'
8A		
Δ=27°04'35"	L=218.40'	R=45.00'
8B		
Δ=49°02'18"	L=38.51'	R=45.00'
8C		

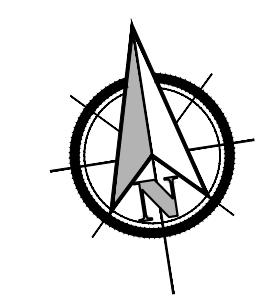


0 50' 100'
SCALE: 1"=50'

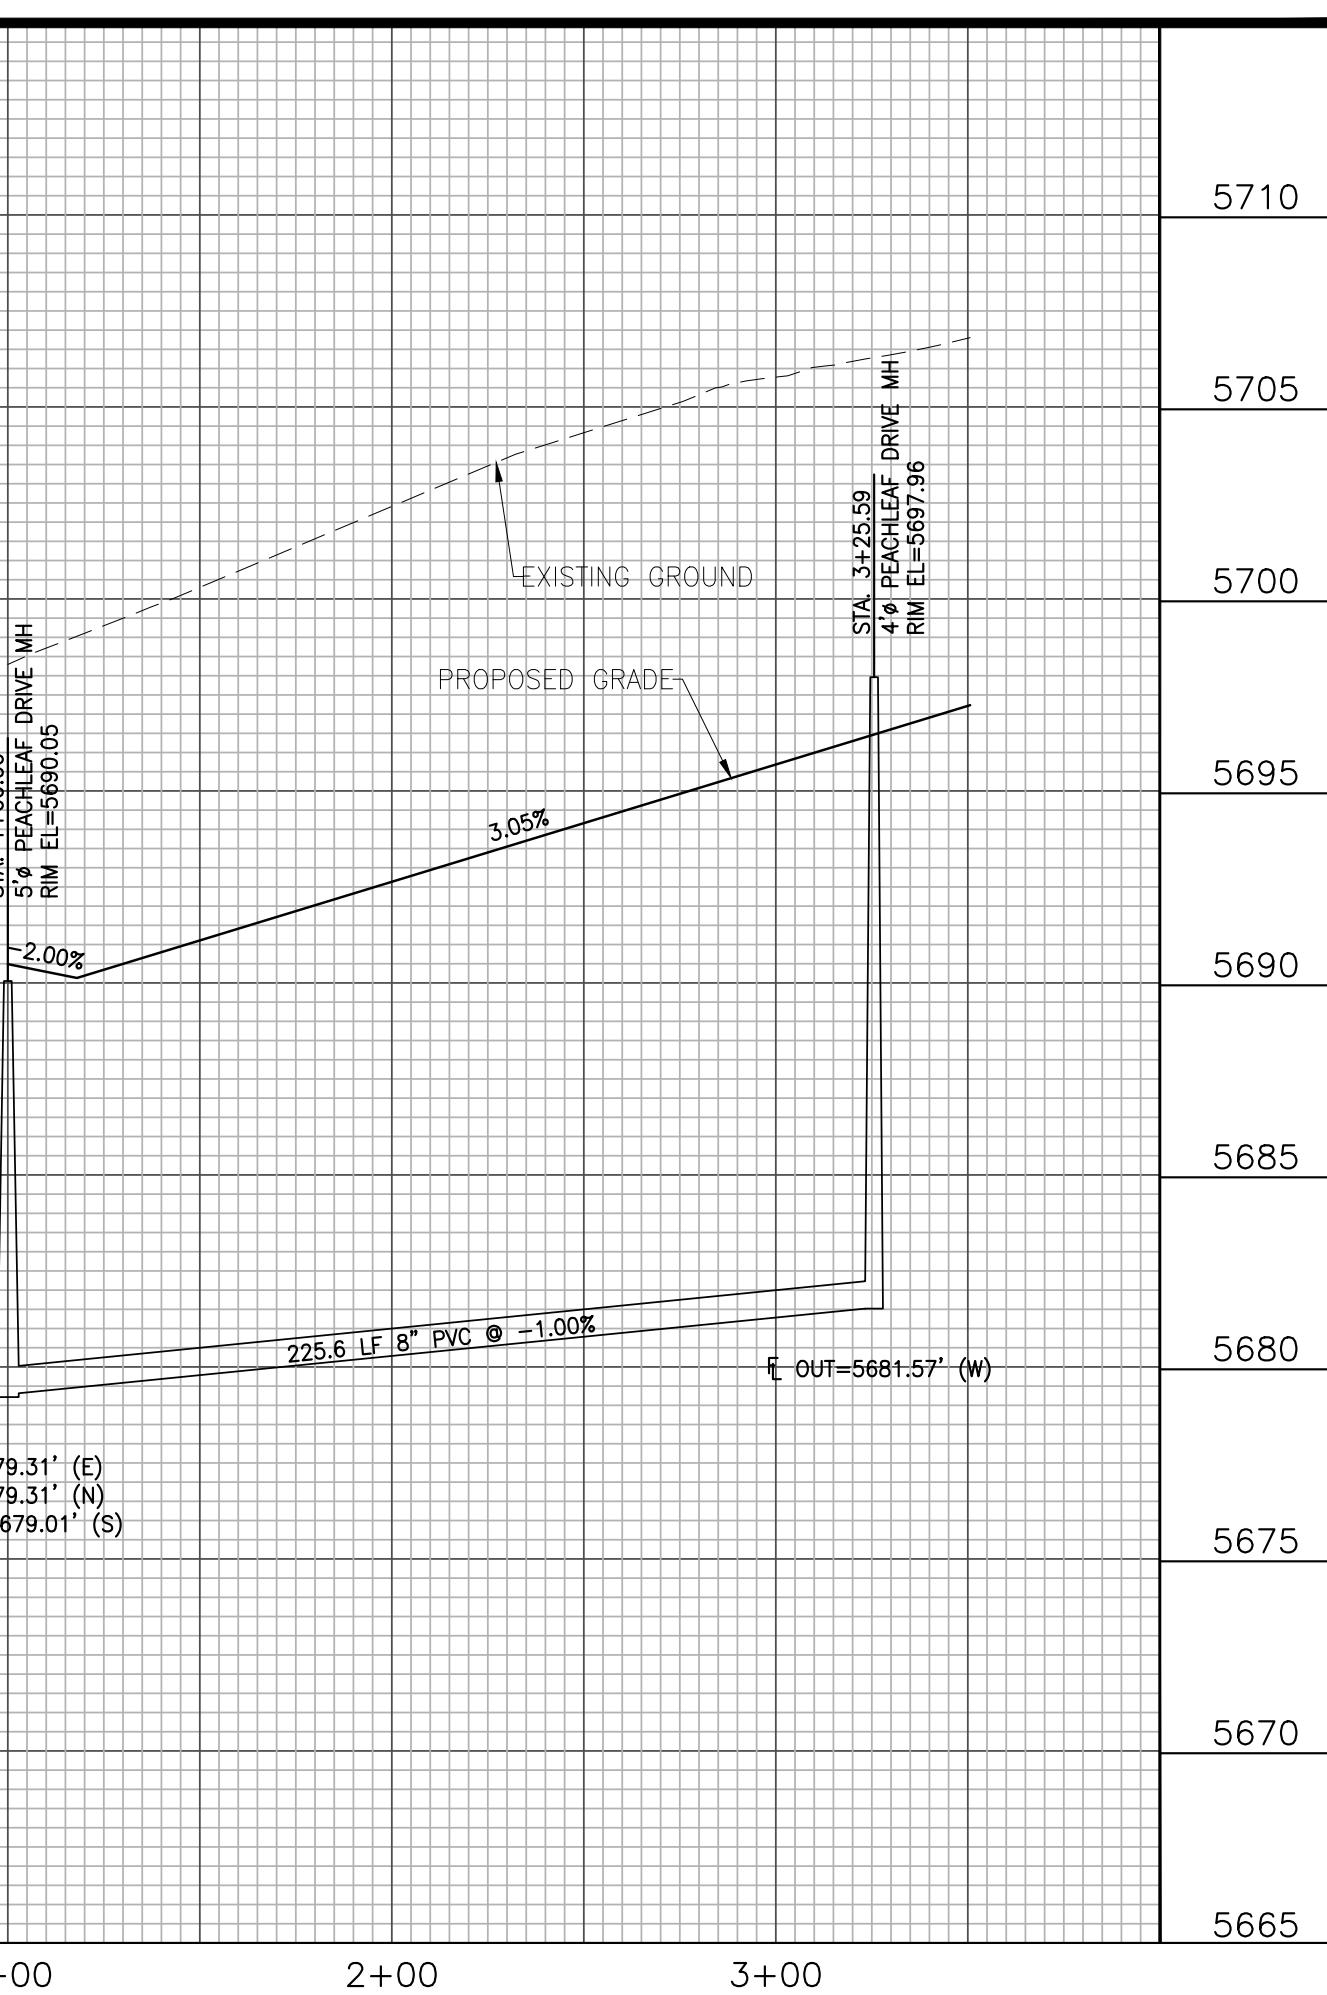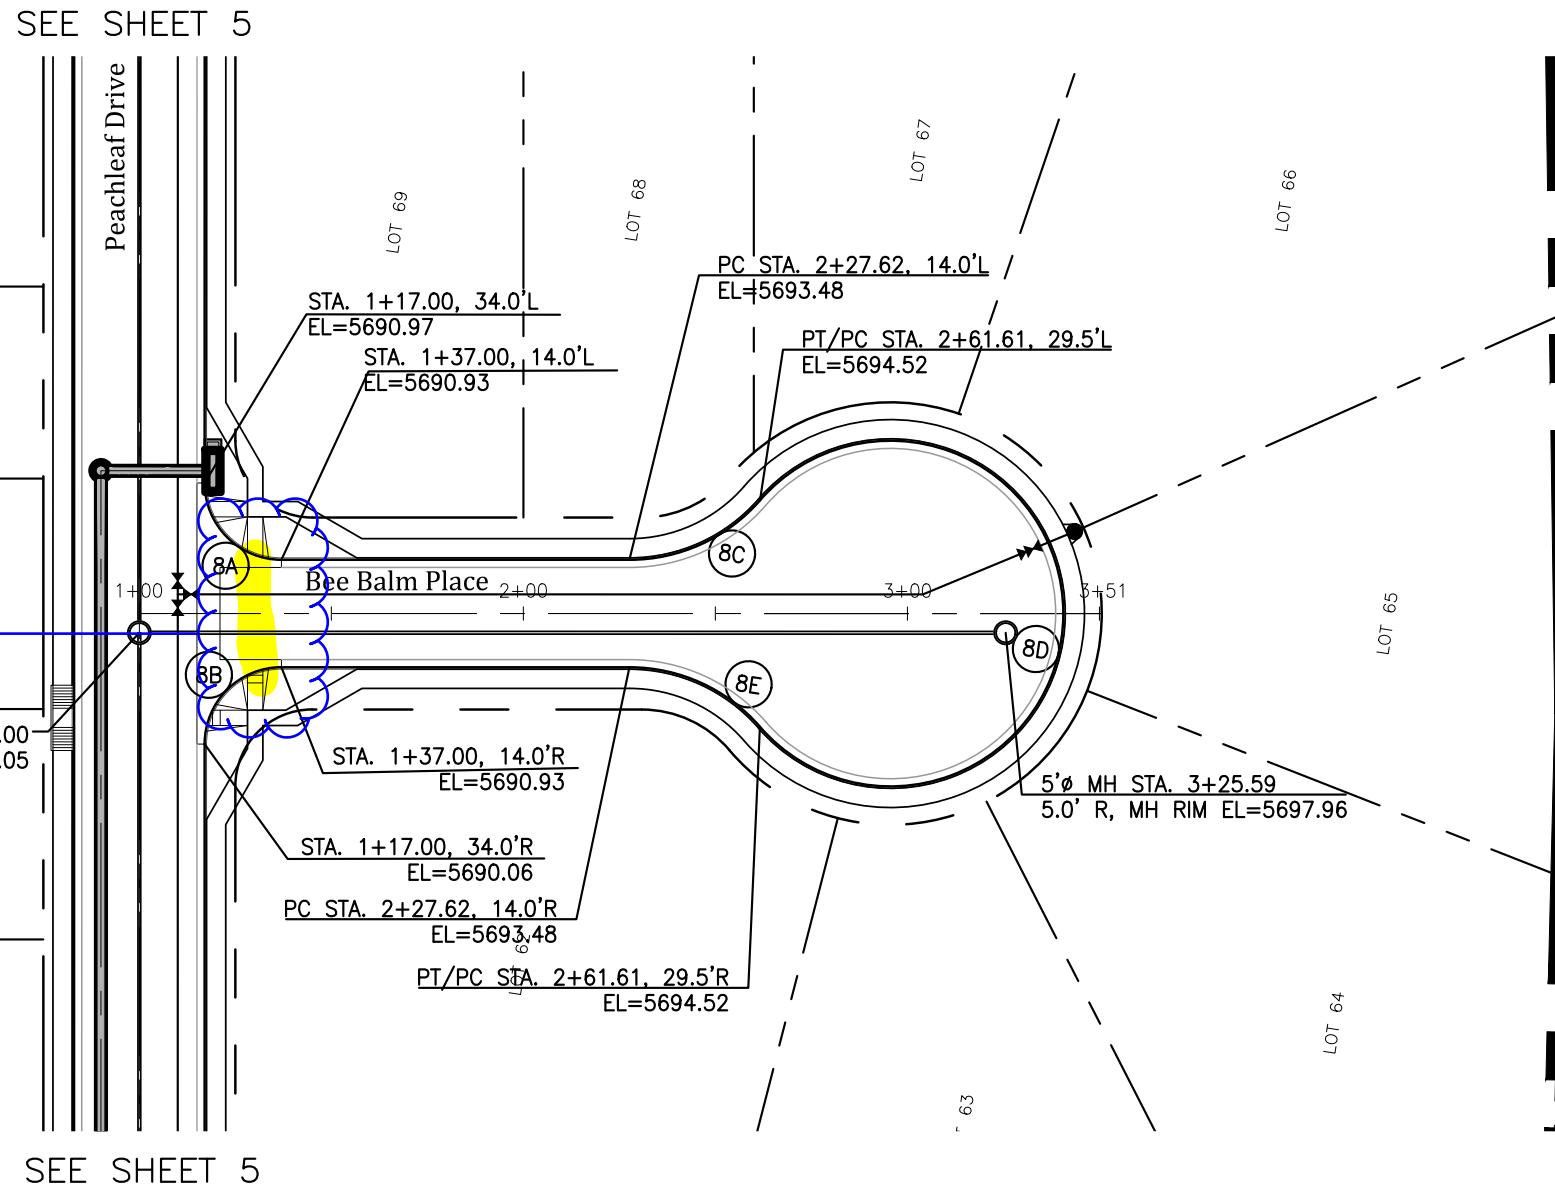

GLEN AT WIDEFIELD FILING NO. 9 OVERALL SIGNAGE AND STRIPING PLAN

EL PASO COUNTY, COLORADO

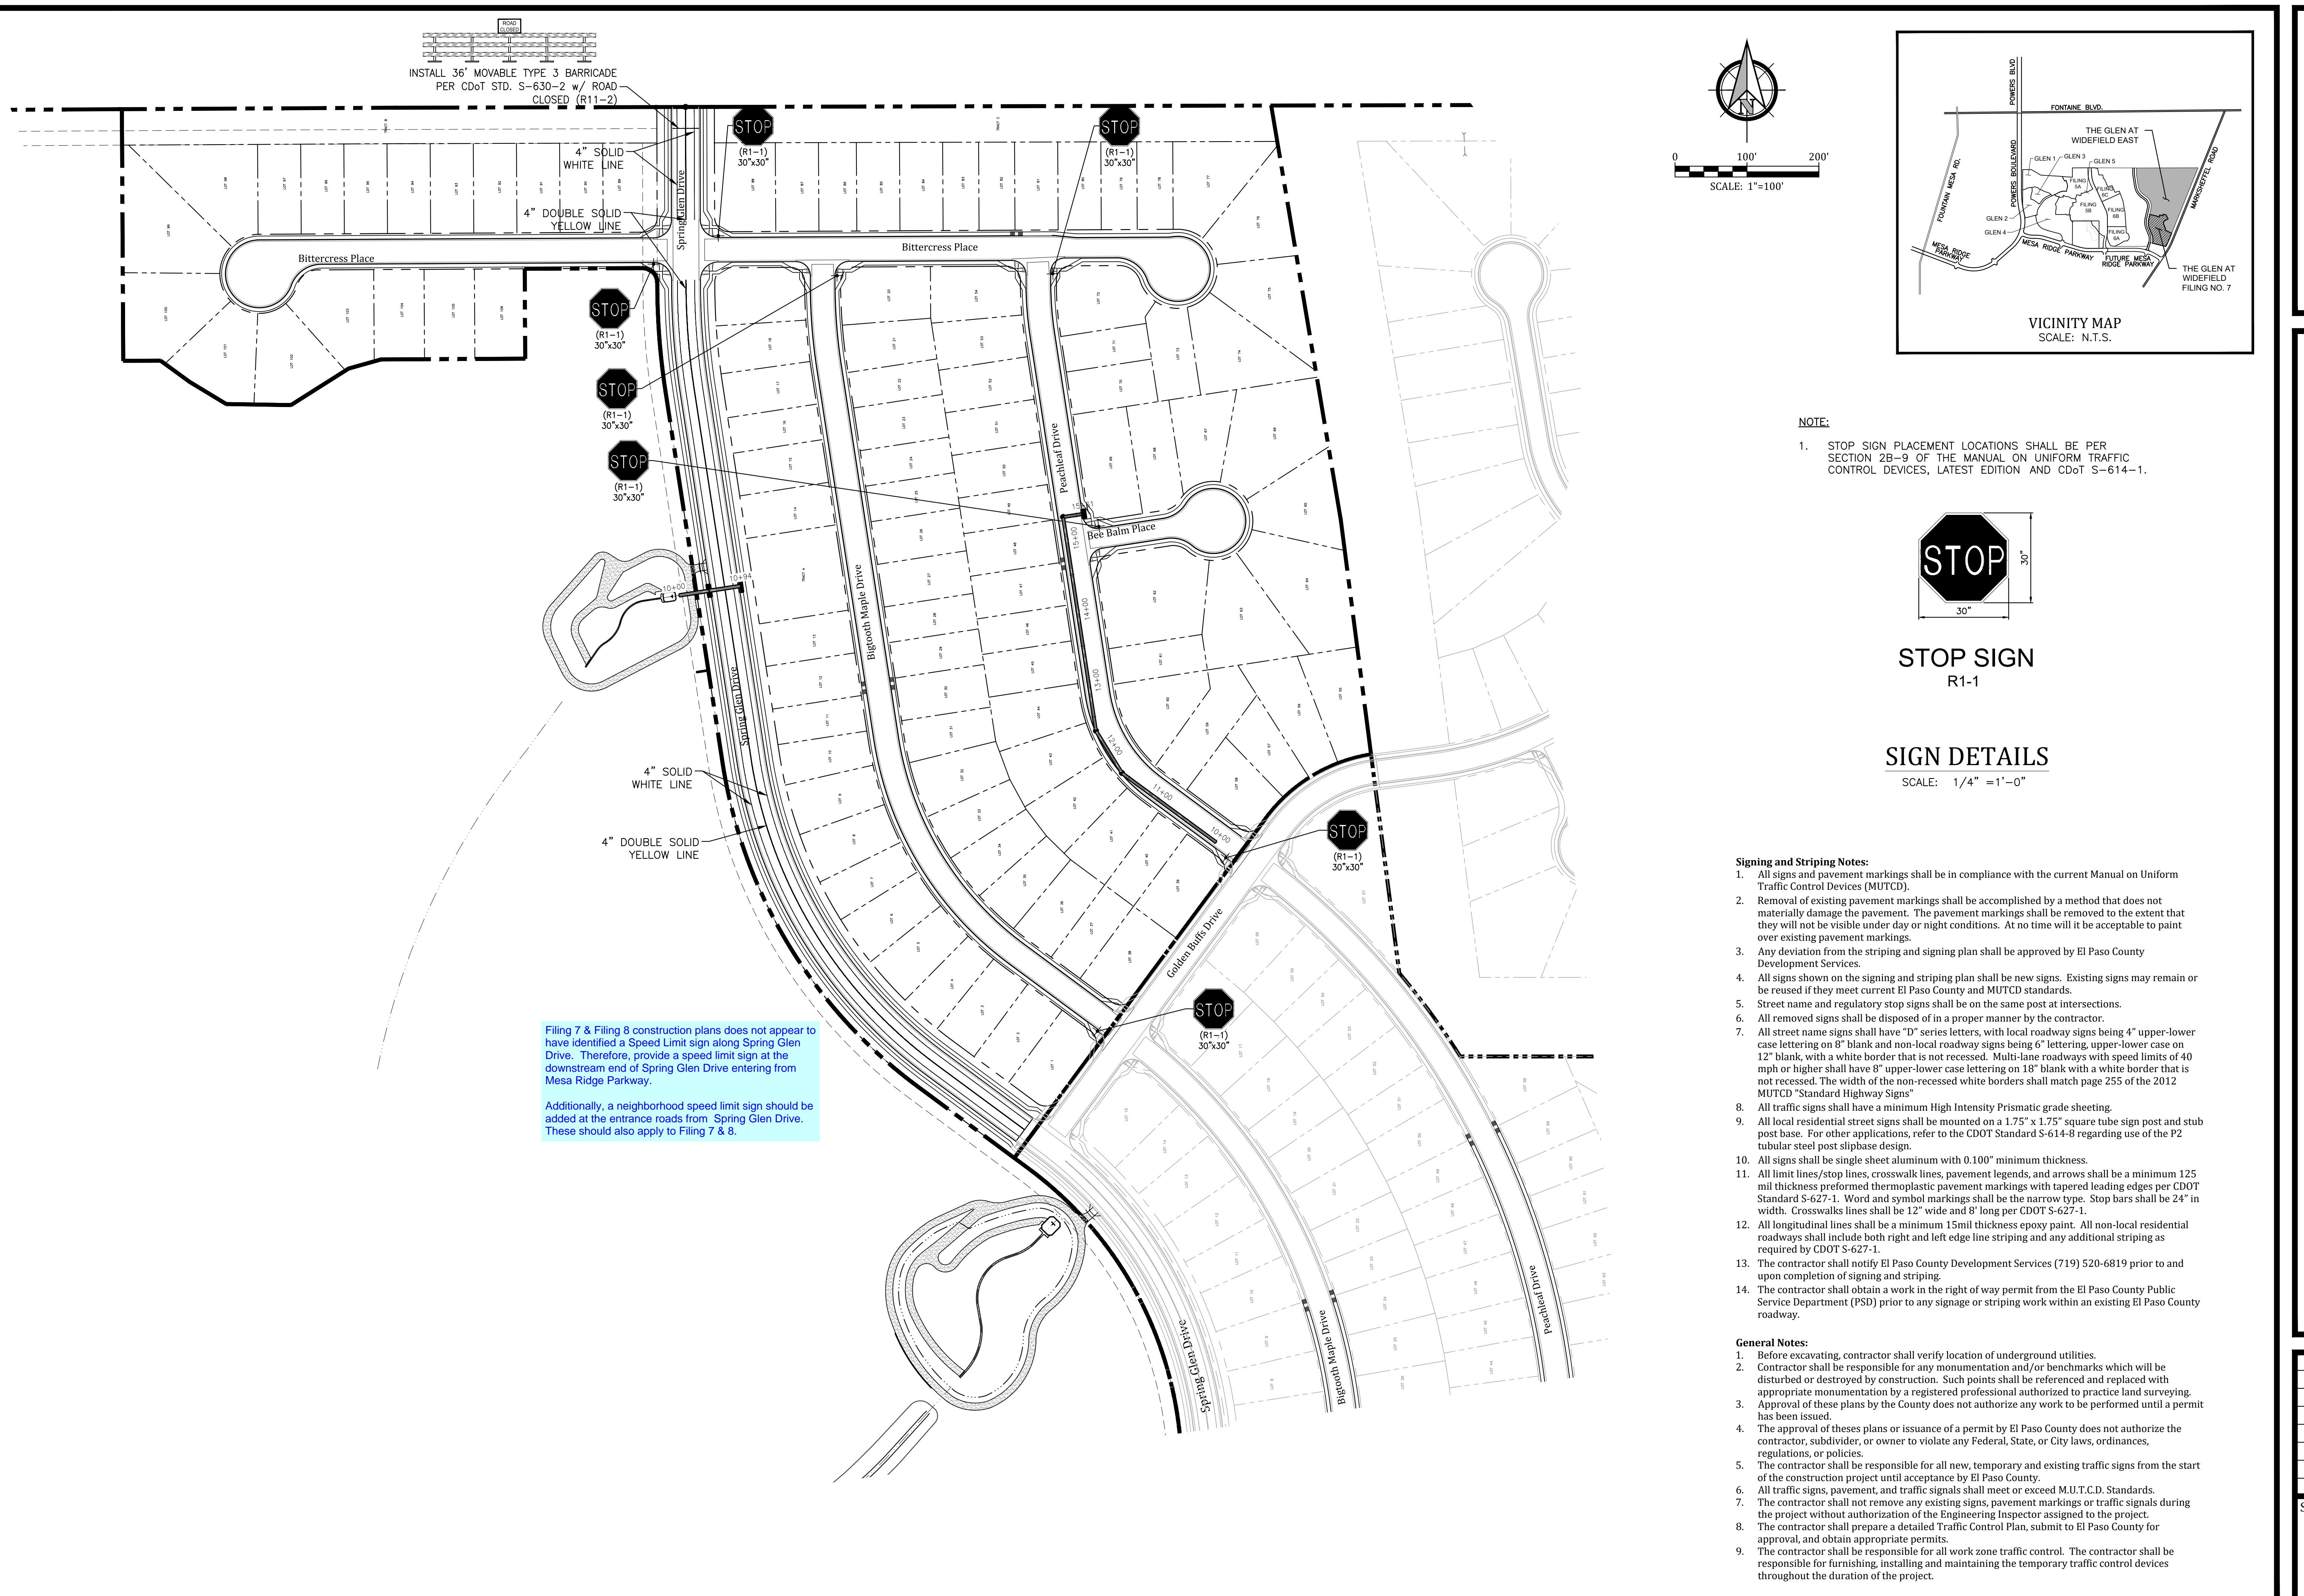



GLEN AT WIDEFIELD FILING NO. 9
STORM SEWER PLAN (Outfall)
PLAN AND PROFILE
EL PASO COUNTY, COLORADO

Project No.: 17038
Date: December 15, 2017
Design: AWMc
Drawn: JAK
Check: AWMc
Revisions:



SHEET

10


10 of 20 Sheets

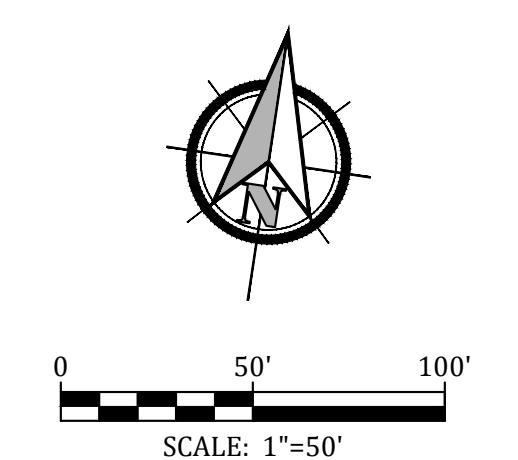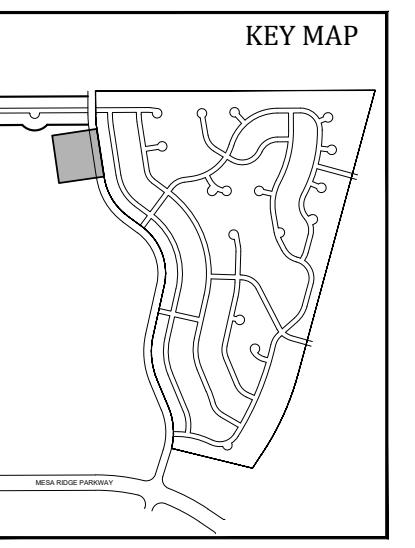

0 50' 100'
SCALE: 1"=50'

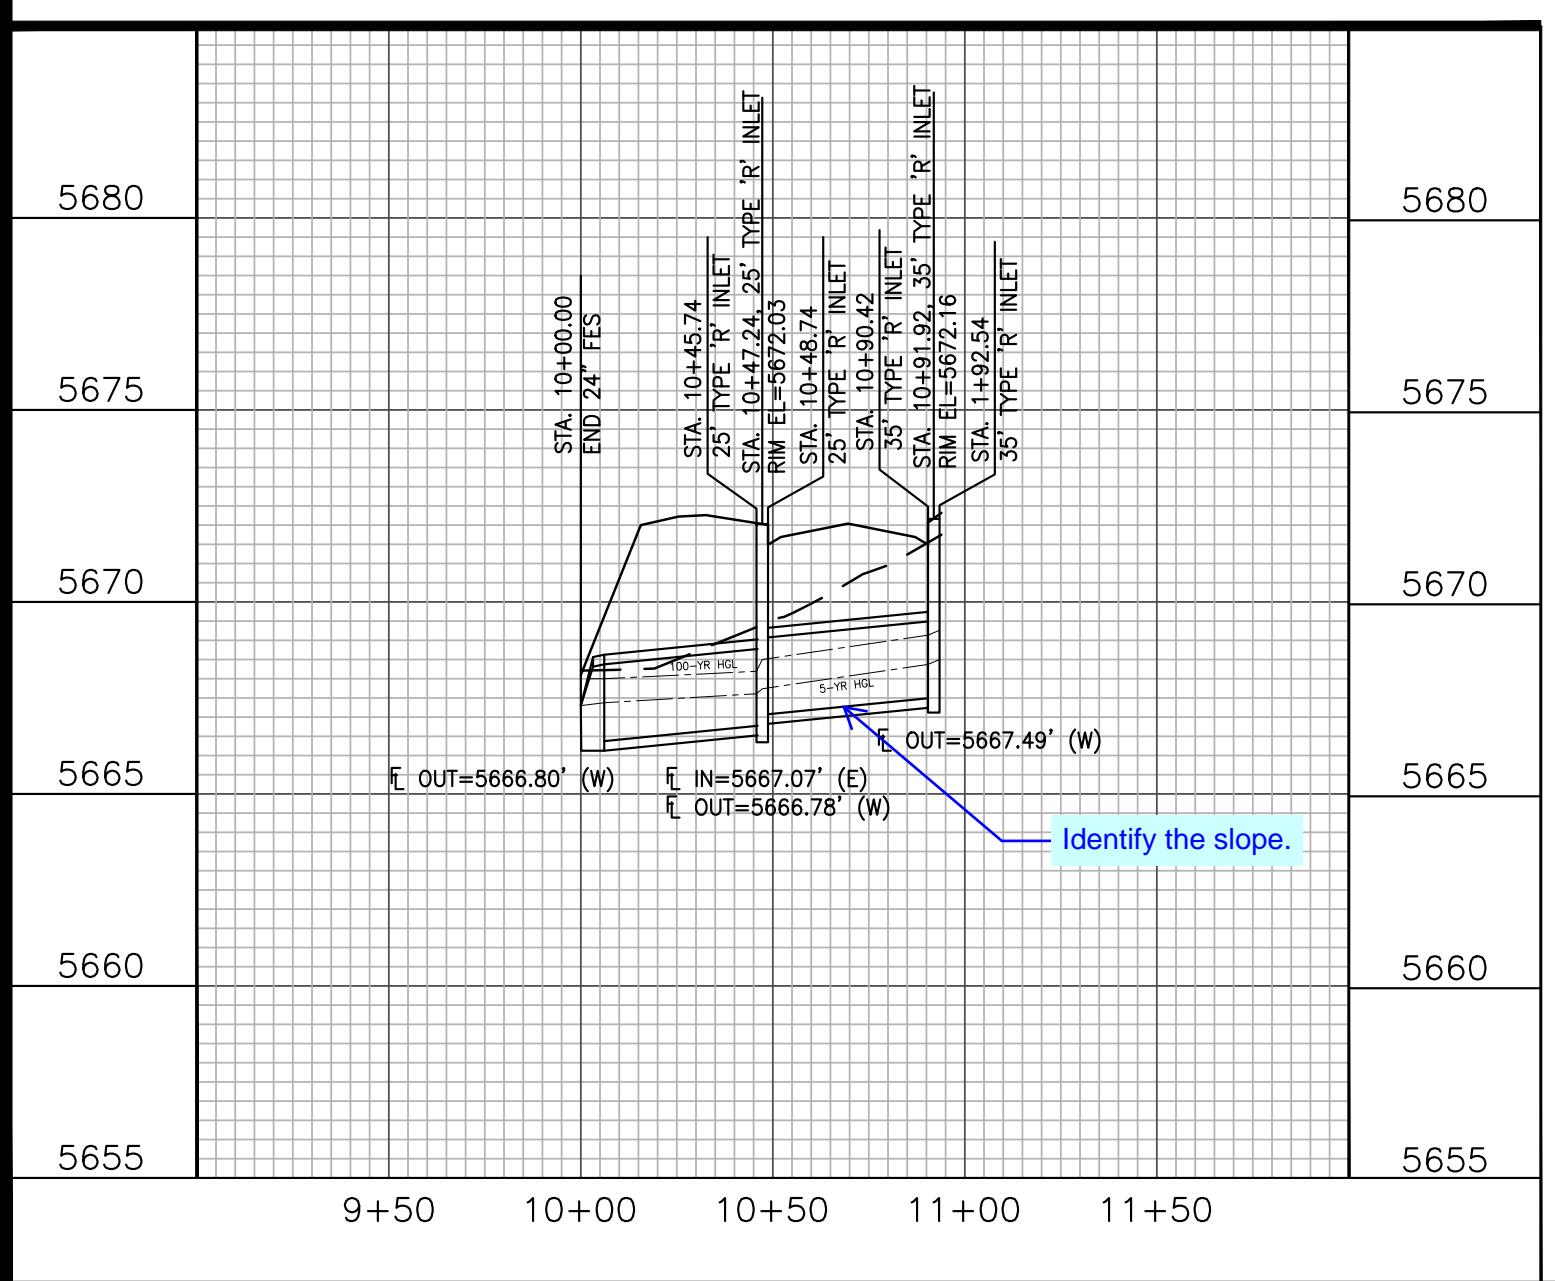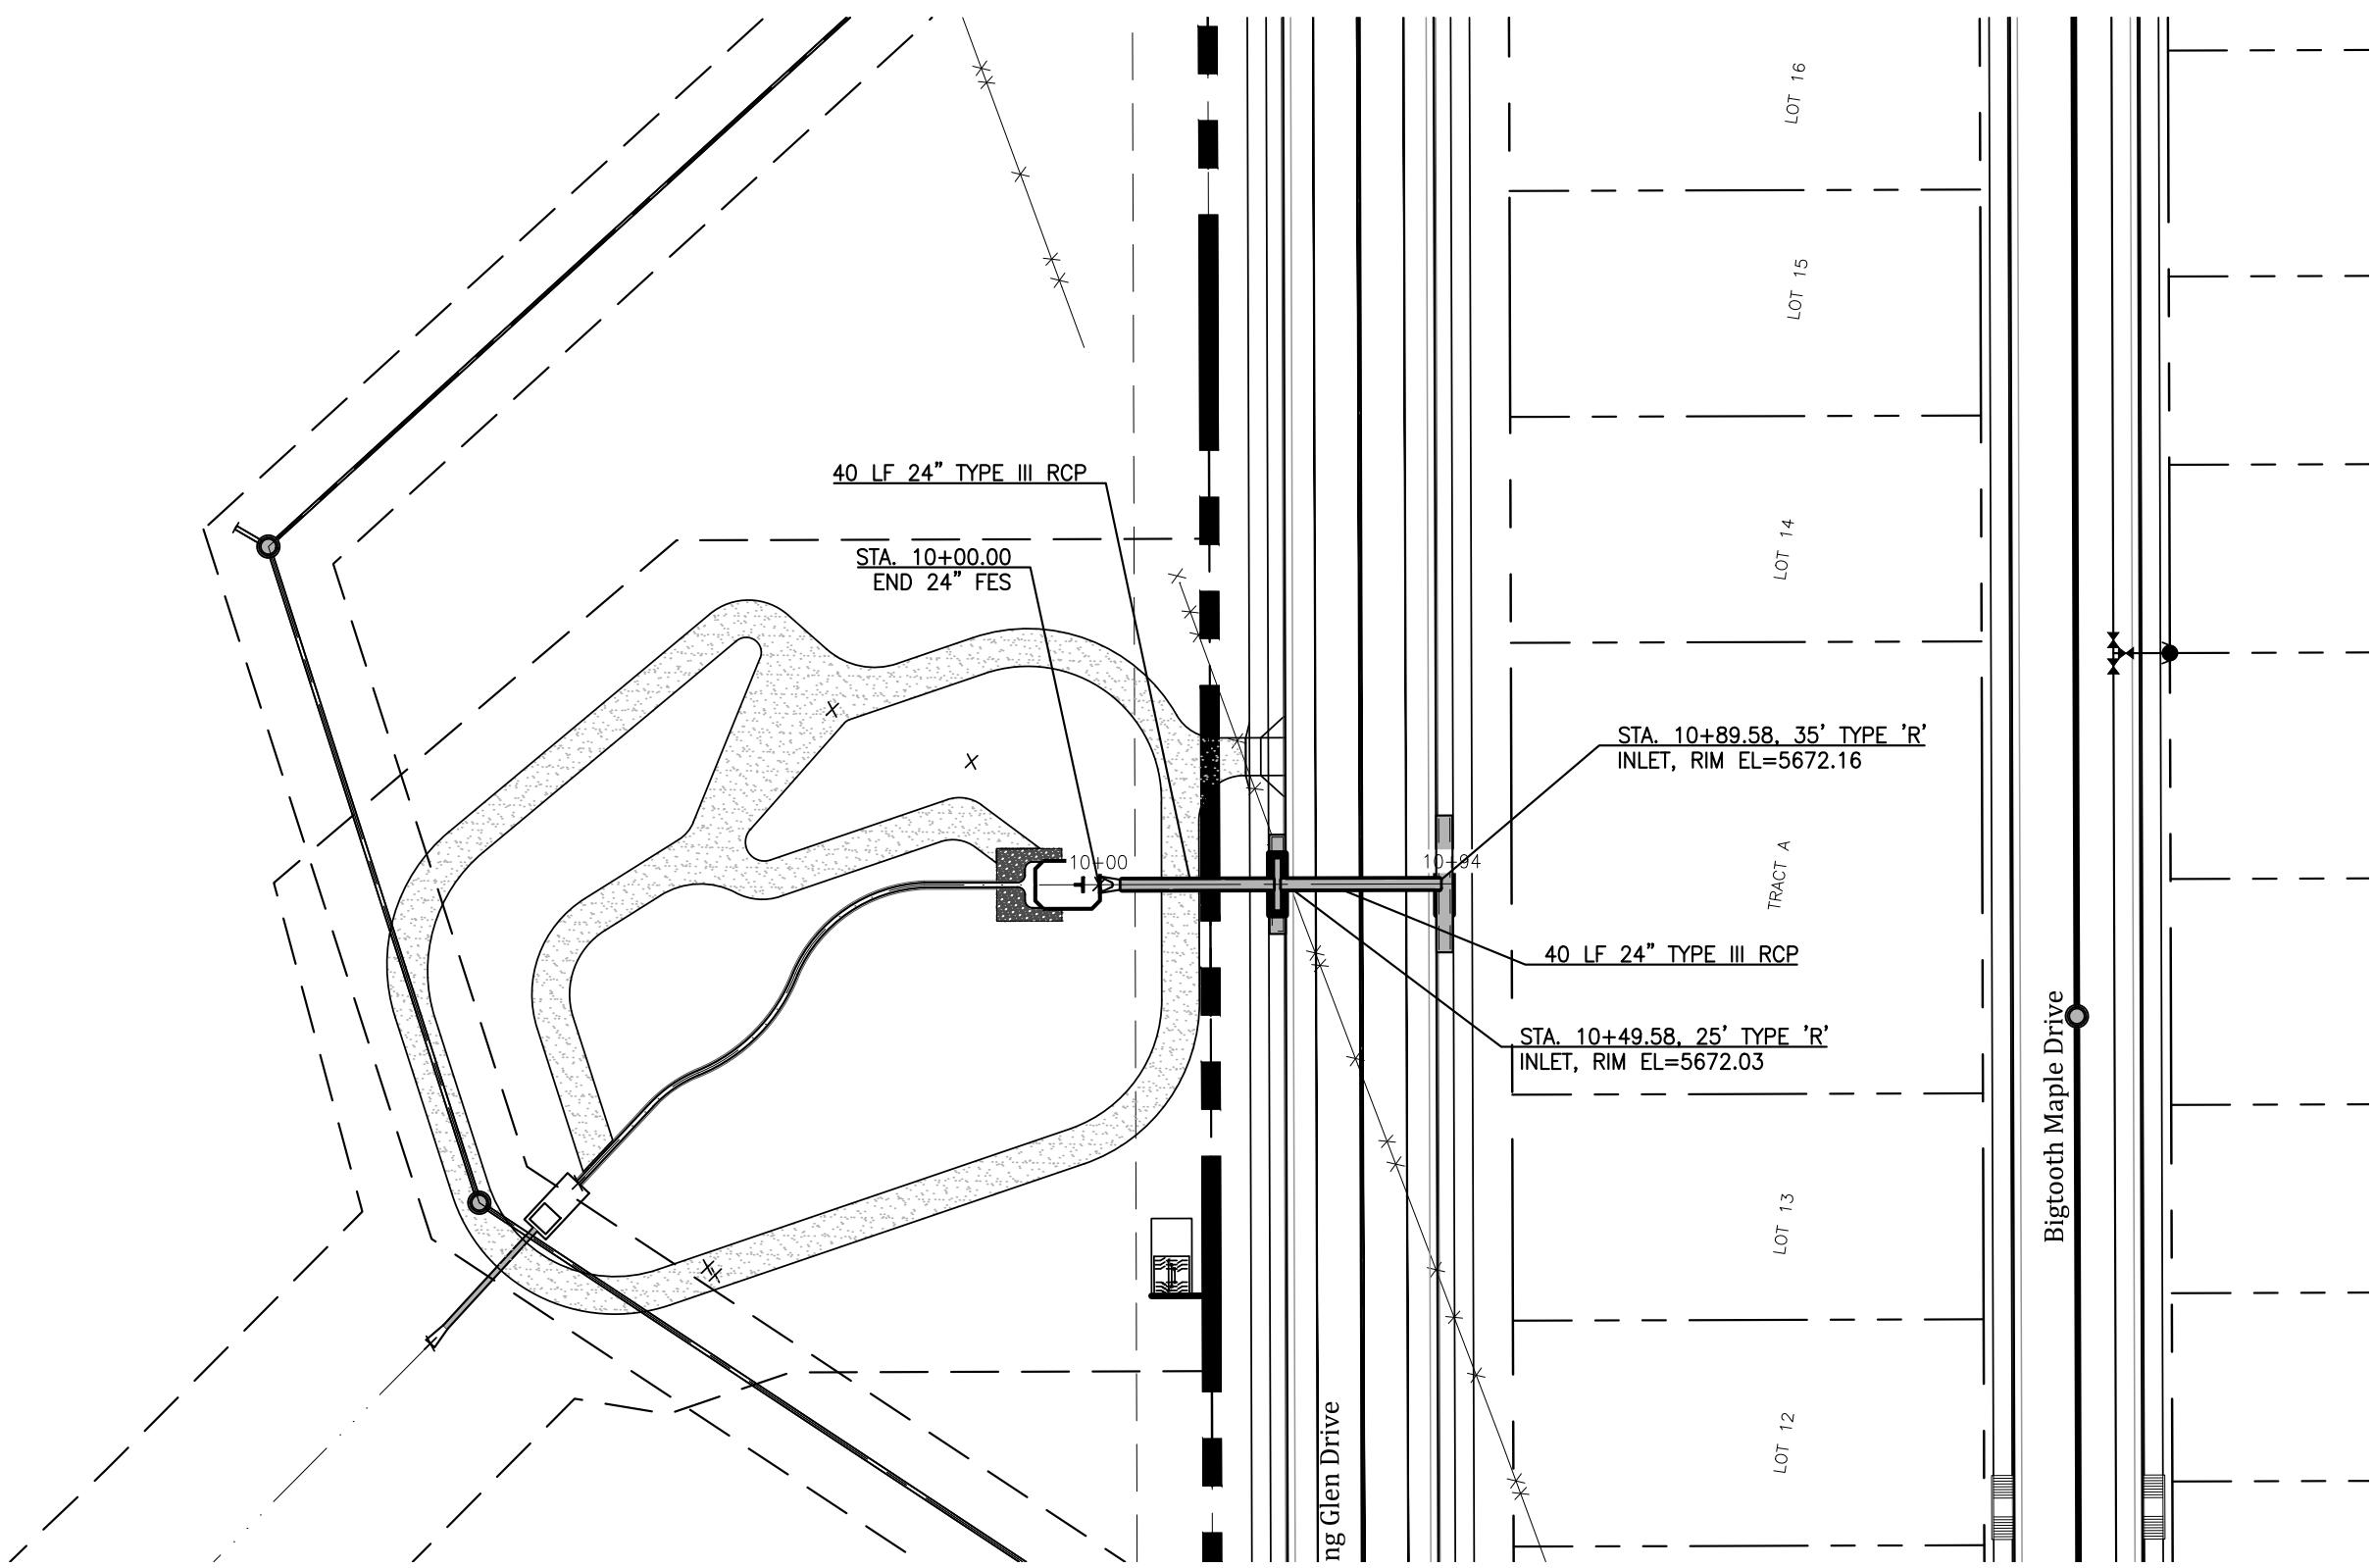

GLEN AT WIDEFIELD FILING NO. 9
STORM SEWER PLAN (PEACHLEAF DRIVE)
PLAN AND PROFILE
EL PASO COUNTY, COLORADO

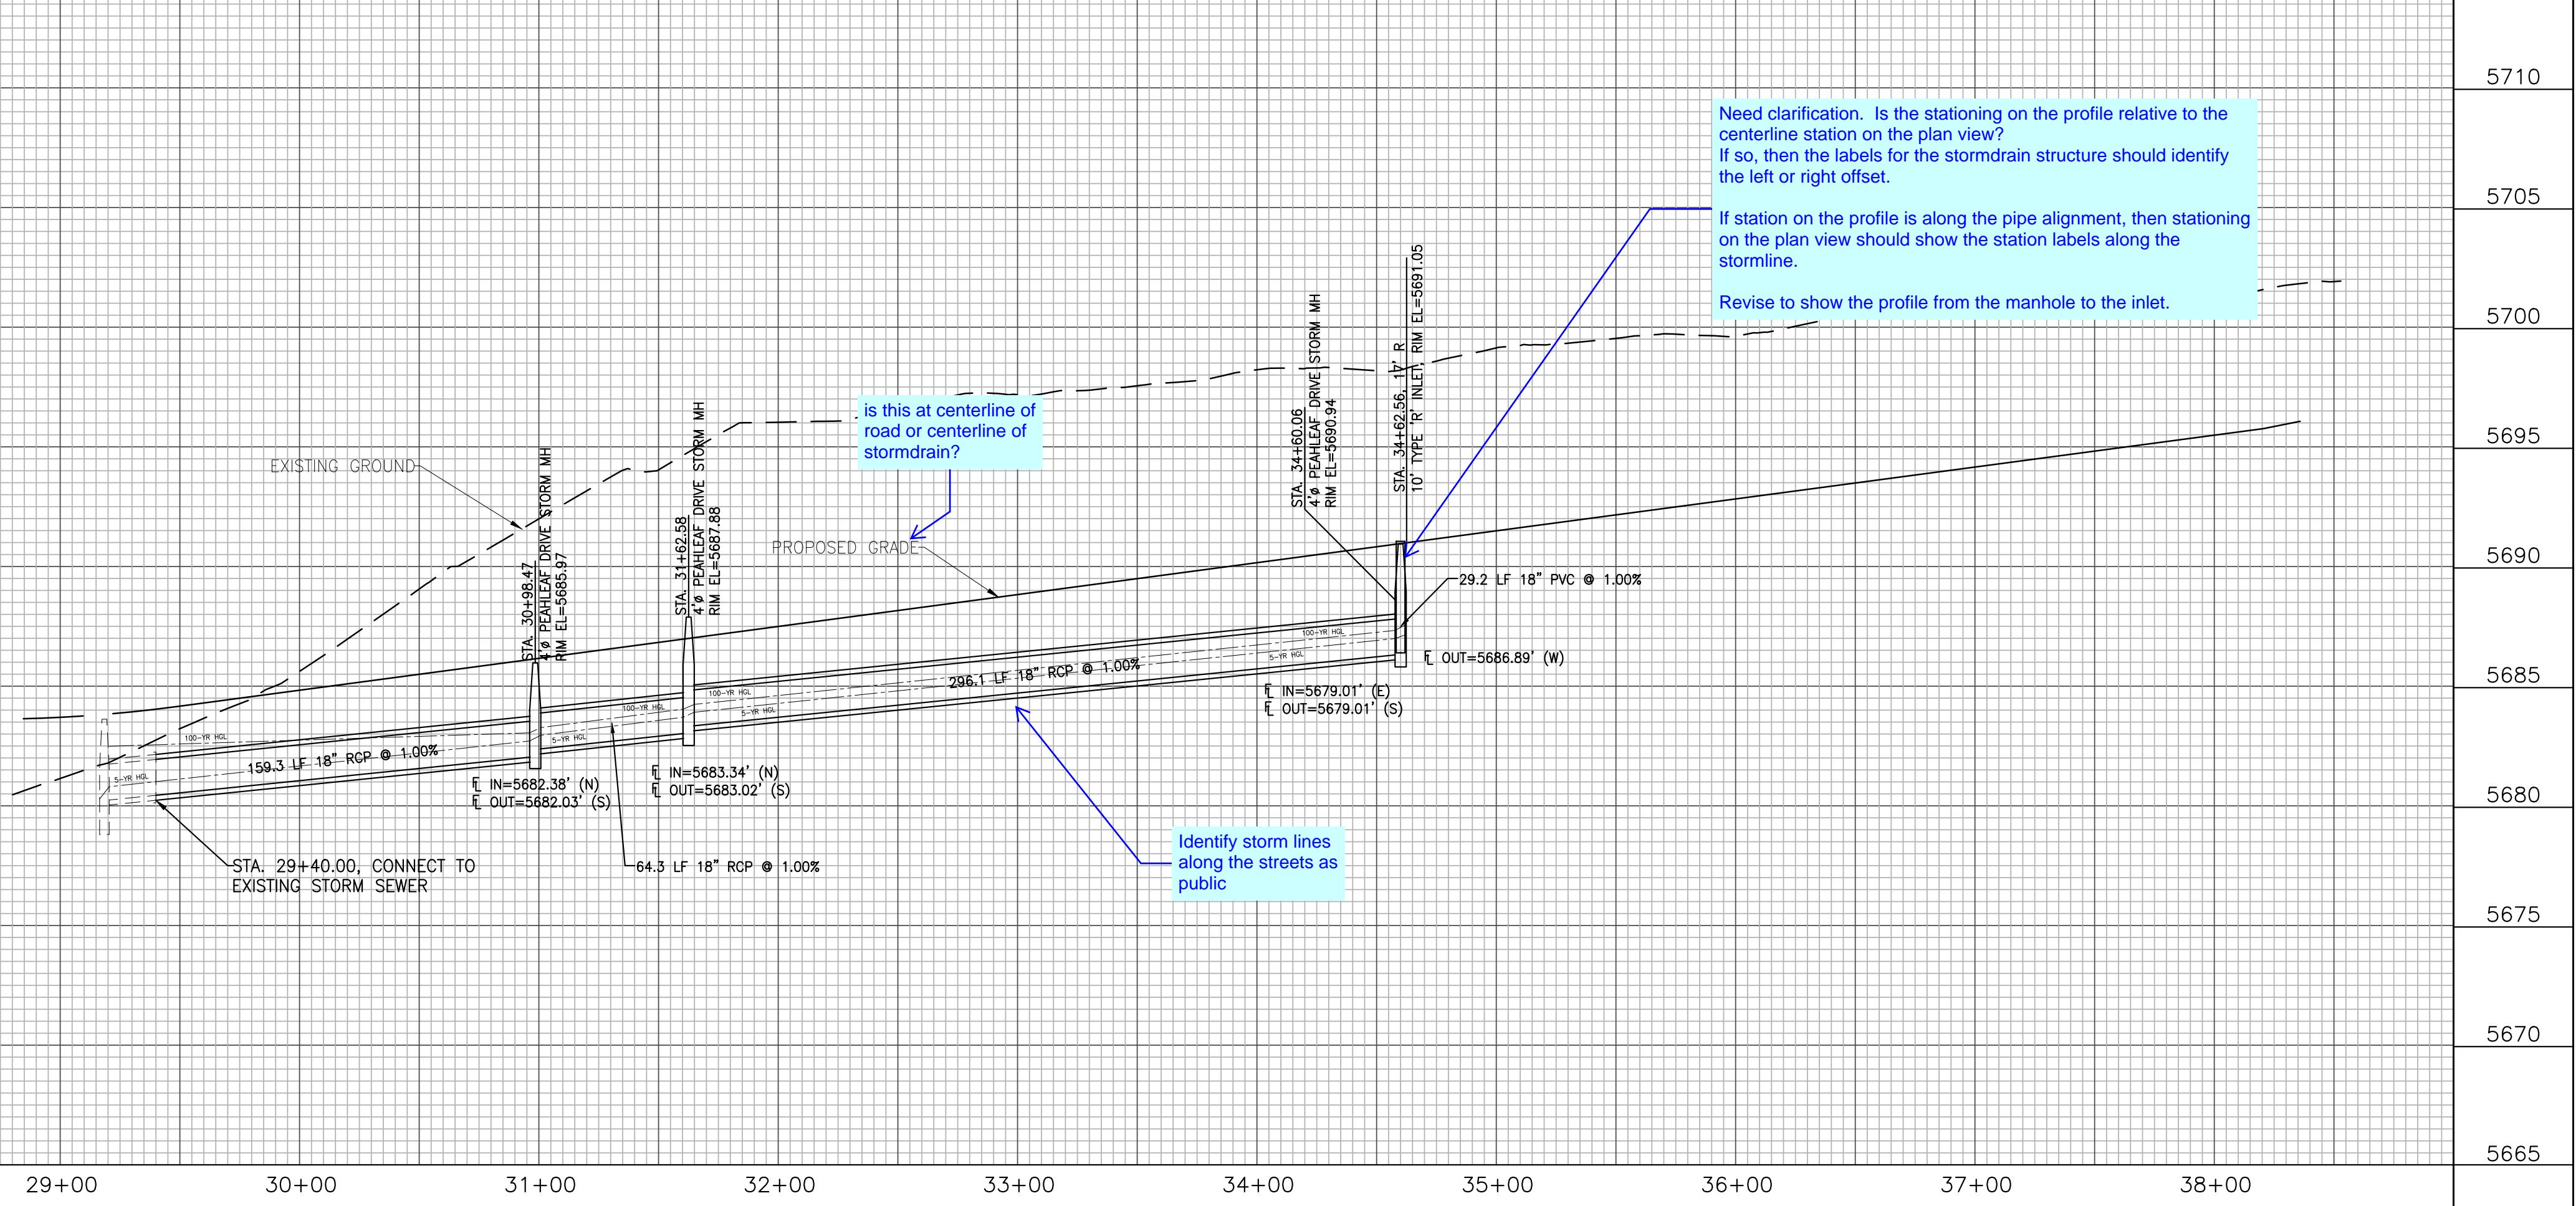

Project No.: 17038
Date: December XX, 2017
Design: AWMc
Drawn: JAK
Check: AWMc
Revisions:

SHEET

11

11 of 20 Sheets


GLEN AT WIDEFIELD FILING NO. 9 GRADING AND EROSION CONTROL PLAN GRADING AND EROSION CONTROL EL PASO COUNTY, COLORADO

PROJECT SPECIFIC GRADING AND EROSION CONTROL NOTES

- All earthwork required of this construction shall be completed in accordance with all applicable sections of the Project Specifications and Soil Investigation Report (Geotechnical Report).
- Rubbish including timber, concrete rubble, trees, brush, and asphalt shall not be backfilled adjacent to any of the structures or in the placement of any unclassified fill. The Contractor shall be responsible for the removal and hauling of such materials to a suitable spoil area. Costs associated with the removal of such materials shall be paid for as documented in the Project Specifications.
- Excavated material shall become the property of the Contractor and shall be disposed of at the Contractor's expense. The cost of haulage and spoiling of excess excavated materials shall be paid for as documented in the Project Specifications.
- Water shall be used as a dust palliative as required and shall be included in the cost for earthwork item(s). No separate payment will be made for dust control associated with the site construction.
- The road grades shall be cleared of vegetation and the topsoil stockpiled for later use.
- All grading shall be in conformance with the Geotechnical Report for the area.
- Placement of fill for roadway embankments shall be completed in conformance with the Geotechnical Report.
- Grading contours shown on this plan are to final grade.
- Compaction under filled areas, including roadway and detention basin embankments, shall be 95 percent of the maximum Standard Proctor Density (ASTM D698) at two (2) percent of optimum moisture content.
- No rubble or debris shall be placed in the backfill under any of the proposed buildings, streets, curb & gutter, sidewalks and driveways. Rubble will be placed (5') feet off the proposed footprint. Properly graded rubble may be used in some locations as specified and directed by the Geotechnical Engineer.
- Contractor is responsible for reviewing the site prior to bidding to verify site conditions.
- Contractor is responsible for providing erosion control measures as approved by the El Paso County DSD Engineering Division and as may be required by the El Paso County Inspector.
- All slopes equal to or greater than 3:1 shall require anchored soil retention blanket (SRB), Geocell 700 or equal.
- The Developer is responsible for maintaining erosion control measures until a mature stage of vegetation is established.
- All soils used for fill must be approved by the Geotechnical Engineer.
- All natural ground to receive fill must be properly scarified, watered and compacted prior to placing fill.
- The Contractor is solely responsible for the design, maintenance and operation of any required dewatering system. The Contractor shall perform such independent investigation as he deems necessary to satisfy himself to the subsurface groundwater conditions and unstable soil conditions to be encountered throughout the construction. Contractor shall coordinate the dewatering system with El Paso County when associated with public facilities.
- No fill shall be placed in the stream bed or channel. If the work is interrupted by heavy rain, fill operations shall not be resumed until a representative of the Geotechnical Engineer indicates that the moisture content and density of the previously placed fill are as specified. Fill surfaces may be scarified and recompaacted after rainfall if necessary, to obtain proper moisture density relation.
- Additional erosion control structures and/or grading may be required at the time of construction.
- Sediment removal for erosion control facilities shall be performed continuously for proper function.
- Base mapping was provided by Pinnacle Land Surveying. The date of the last survey update was January 2014.
- Proposed Construction Schedule:
Begin Construction: Autumn 2015
End Construction: Autumn 2018
- Area to be developed = 172.8 Acres (est.)
Existing 100-year runoff coefficient = 0.50
Proposed 100-year runoff coefficient = 0.51
Existing Hydrologic Soil Groups: B & C
(B=Neison-Tassel fine sandy loams; C=Stoneham sandy loam; C=Nunn clay loam)
- Site is currently undeveloped and covered with native grasses on moderate to steep slopes (3%-18%).
- Site is located in the West Fork Jimmy Camp Creek Drainage Basin.

OPINION OF COST FOR EROSION CONTROL REQUIREMENTS Additional Erosion Control for Glen at Widefield Filing No. 8

ITEM	QUANTITY	UNITS	PRICE	AMOUNT
PERMANENT SEEDING	0.1	AC	\$582	\$58.20
PERMANENT E.C. BLANKET	3,885	SY	\$6	\$23,310.00
VEHICLE TRACKING CONTROL	3	EA	\$1,625	\$4,875.00
INLET PROTECTION	9	EA	\$153	\$1,377.00
CONCRETE WASHOUT BASIN	2	EA	\$776	\$1,552.00
ROUGH CUT STREET CONTROL	670	LF	\$2	\$1,340.00
			TOTAL	\$23,056.20

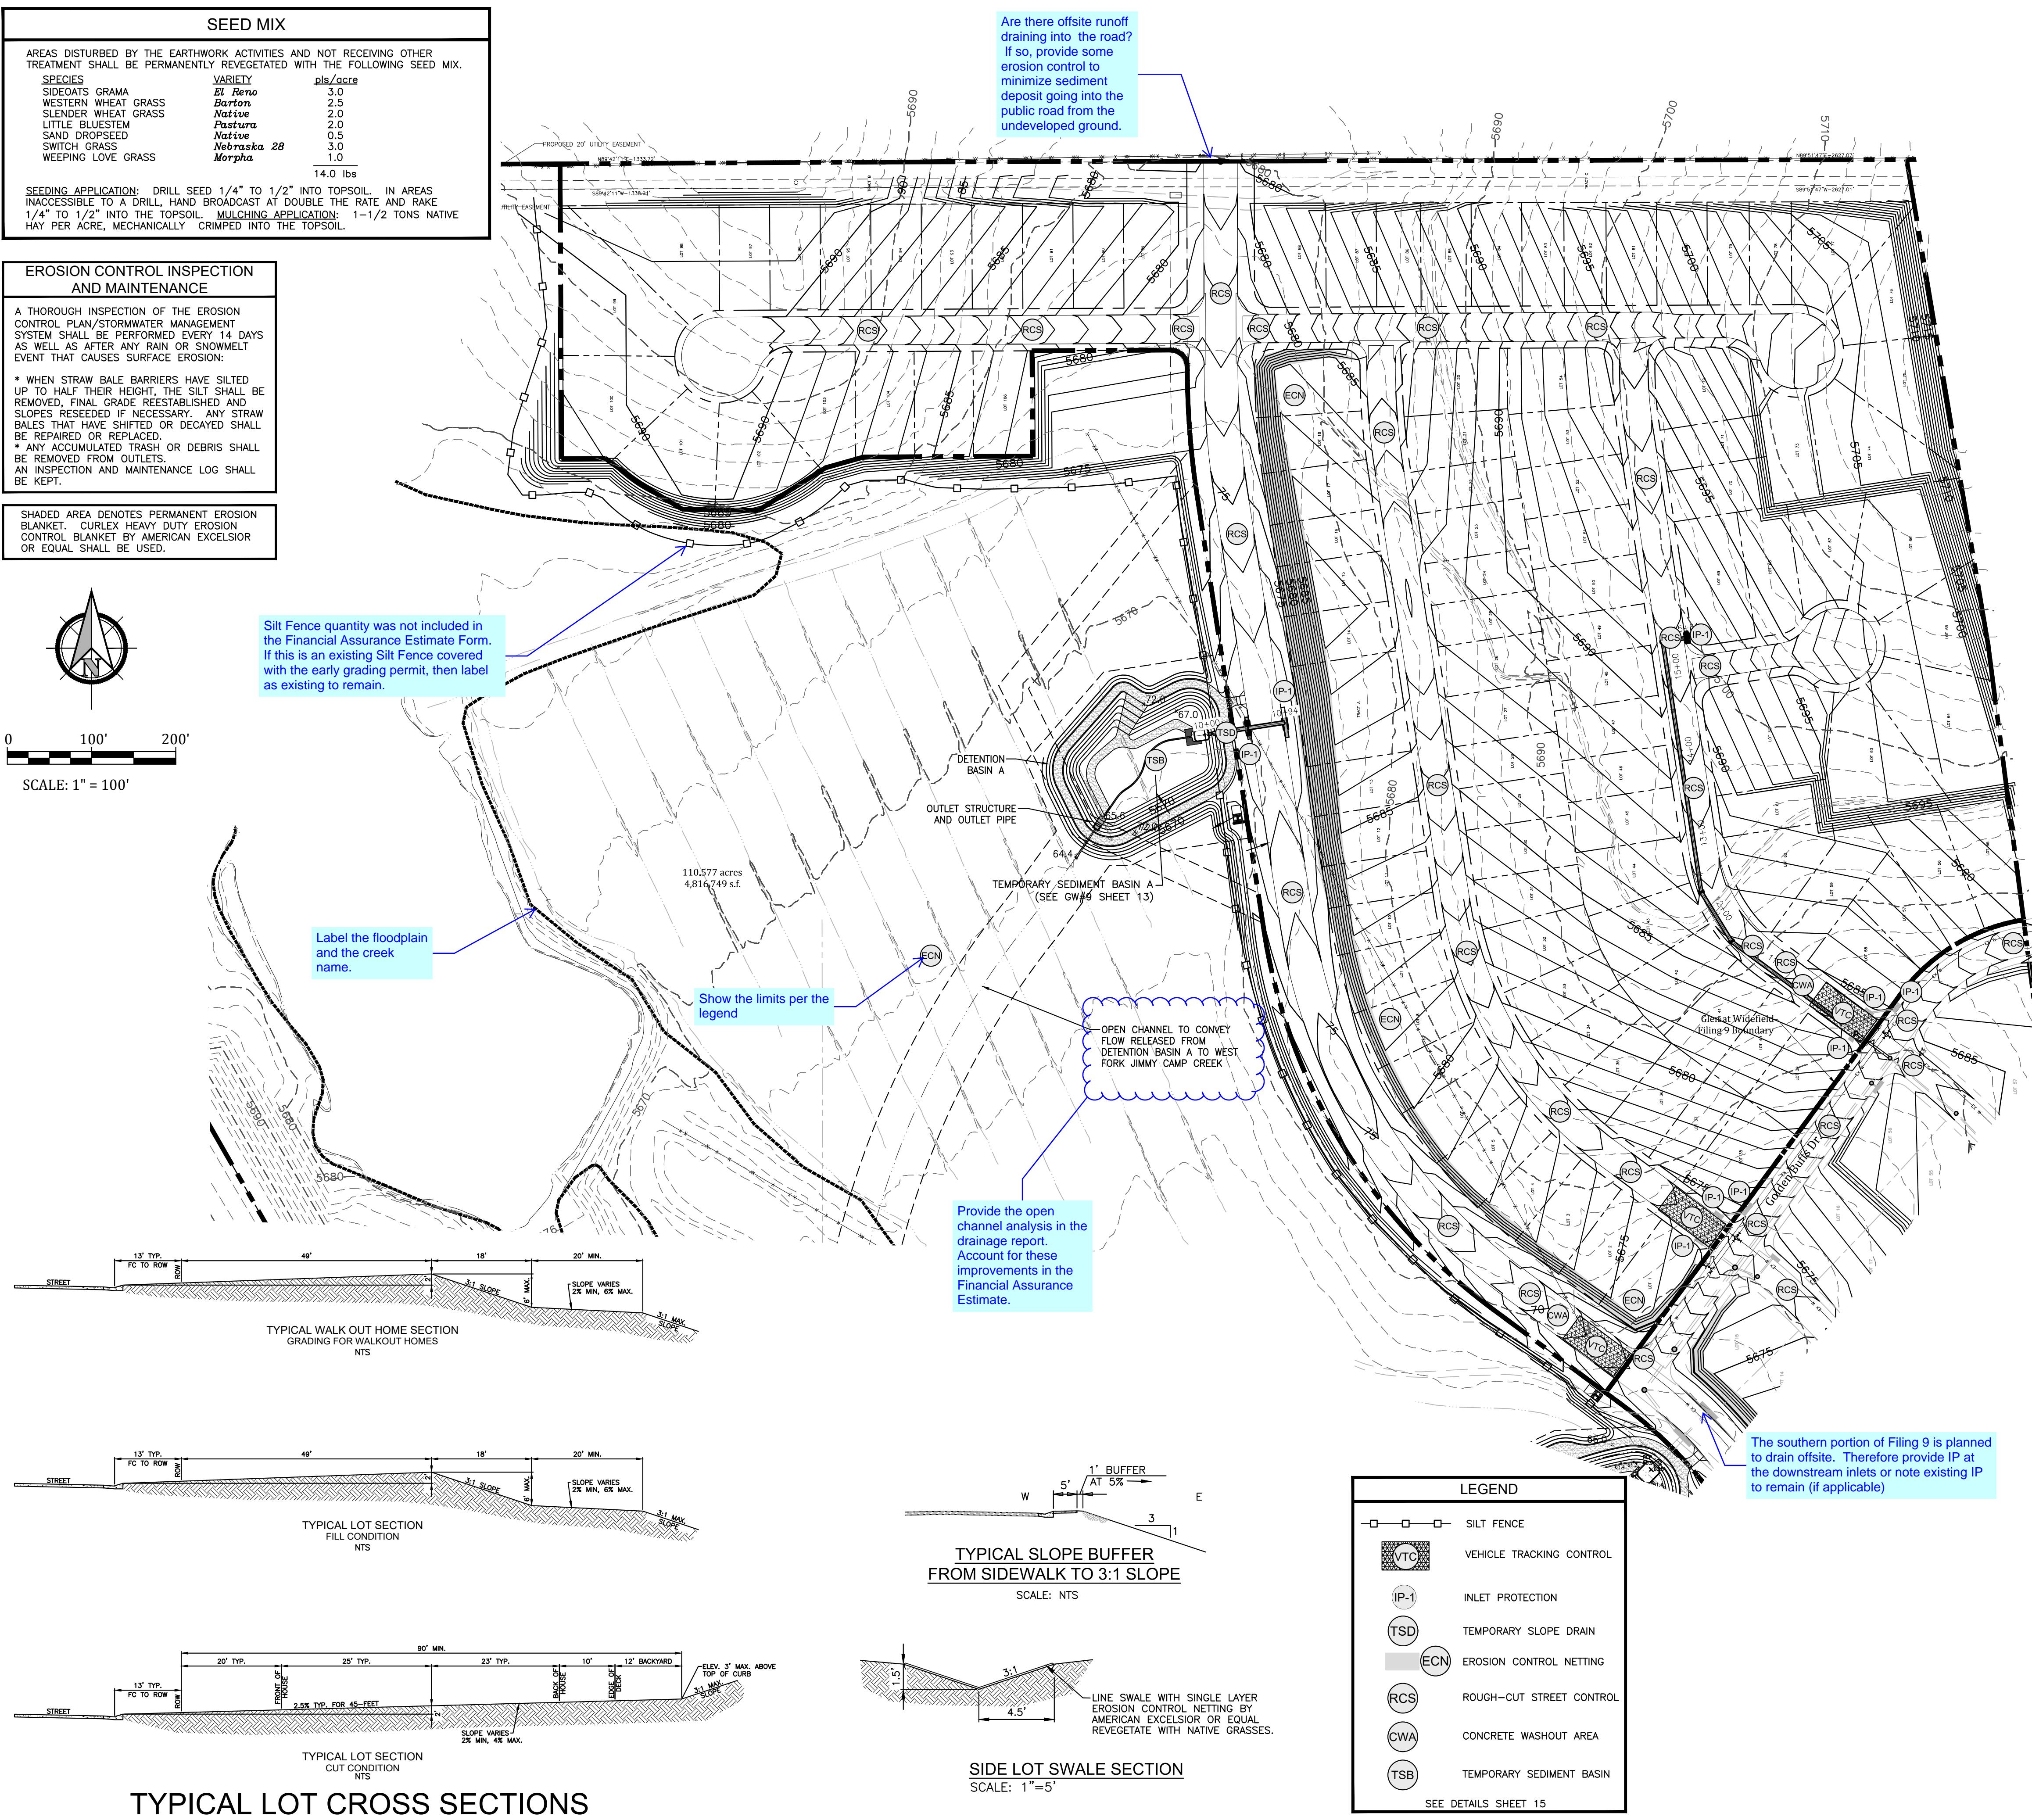

Project No.: 17038
Date: December 15, 2017
Design: AWMC
Drawn: JAK
Check: AWMC
Revisions:

SHEET

GLEN AT WIDEFIELD FILING NO. 9 GRADING AND EROSION CONTROL PLAN EL PASO COUNTY, COLORADO


Project No.: 17038
Date: December 15, 2016
Design: AWMC
Drawn: NRK
Check: AWMC
Revisions:

SHEET


13

TABLE ECB-1, ECB MATERIAL SPECIFICATIONS				
TYPE	COCONUT CONTENT	STRAW CONTENT	EXCLOSOR CONTENT	RECOMMENDED NETTING*
STRAW*	—	100%	—	DOUBLE/NATURAL
STRAW-COCONUT	30% MIN	70% MAX	—	DOUBLE/NATURAL
COCONUT	100%	—	—	DOUBLE/NATURAL
EXCLOSOR	—	—	100%	DOUBLE/NATURAL

STAKING PATTERNS BY SLOPE

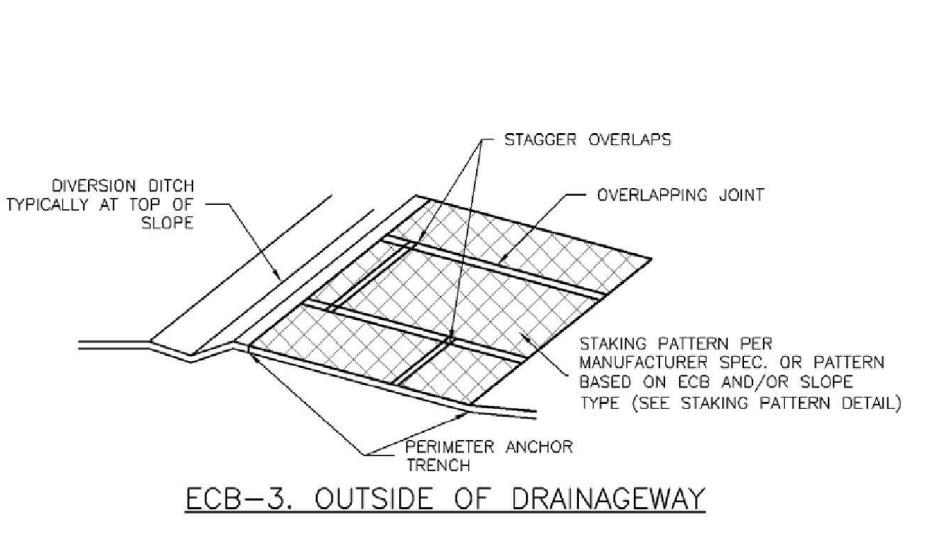

ECB-3, OUTSIDE OF DRAINAGEWAY

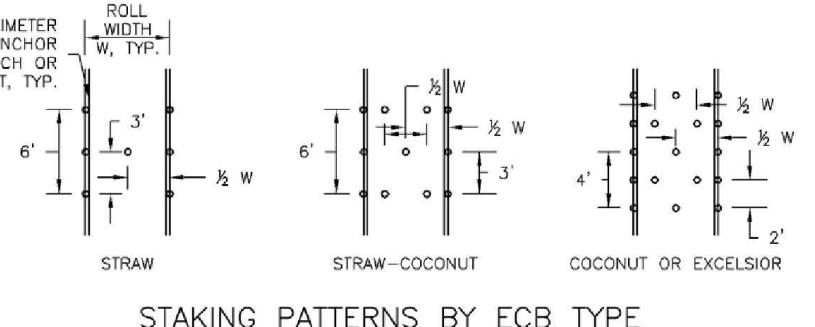

STAKING PATTERNS BY ECB TYPE


EROSION CONTROL BLANKET

NTS

TOTALY BOUNDARY

SEDIMENT BASIN "A"

- A. 0.38 ac-ft REQUIRED TO SPILLWAY CREST.
- B. 8" PVC PERFORATED RISER PIPE, PERFORATIONS VERTICALLY SPACED 4" APART, 1 COLUMN OF 5 2x3" Ø HOLES.
- C. 8" LONG SPILLWAY, 1' DEPTH, LINED WITH 24" THICK TYPE "M" RIPRAP TO TOE OF SLOPE.

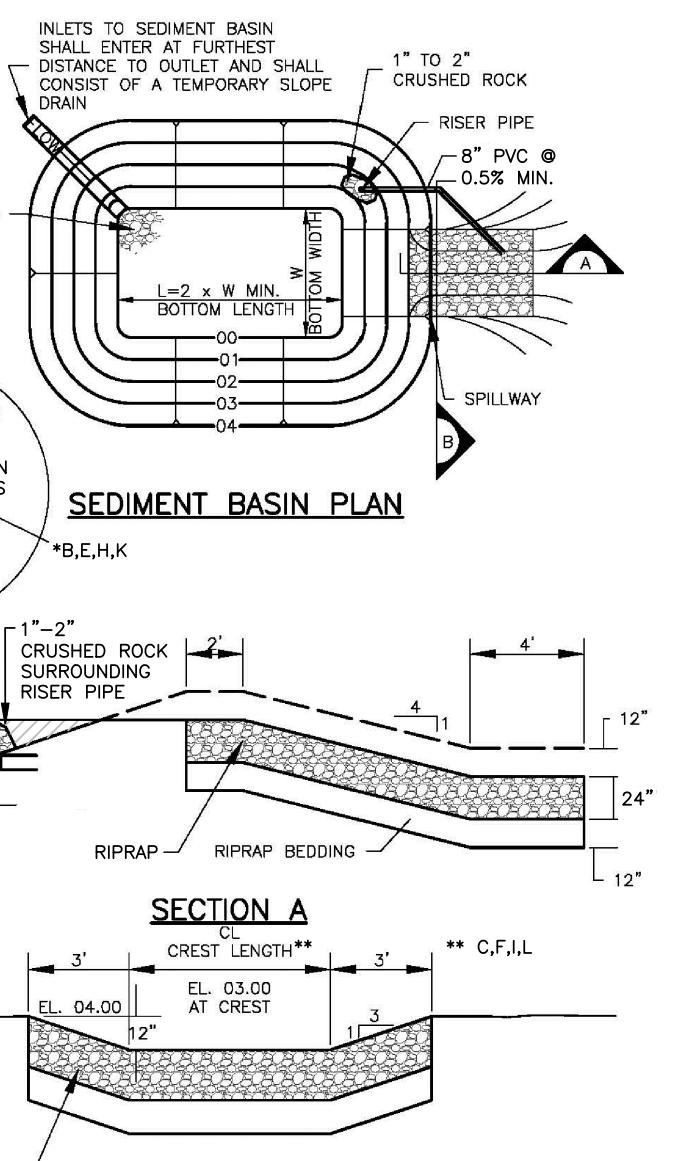

TEMPORARY SEDIMENT BASIN

NTS

SEDIMENT BASIN INSTALLATION NOTES

- SEE PLAN VIEW FOR:
-LOCATION AND LENGTH OF SLOPE DRAIN.
-TYPE OF INLET PROTECTION.
- INLET PROTECTION SHALL BE INSTALLED PROMPTLY AFTER INLET CONSTRUCTION OR PAVING IS COMPLETE (TYPICALLY WITHIN 48 HOURS). IF A RAINFALL/RUNOFF EVENT IS FORECAST, INSTALL INLET PROTECTION AS SOON AS POSSIBLE.
- MANUFACTURER'S HAVE BEEN CONSULTED THAT MAY VARY FROM LIDDED STANDARD DETAILS. CONSULT WITH LOCAL JURISDICTIONS AS TO WHICH DETAIL SHOULD BE USED WHEN DIFFERENCES ARE NOTED.
- INLET PROTECTION MAINTENANCE NOTES
- INSPECT BMPs EACH WORKDAY, AND MAINTAIN THEM IN EFFECTIVE OPERATING CONDITION. MAINTENANCE OF BMPs SHOULD BE PROACTIVE, NOT REACTIVE. INSPECT BMPs AS SOON AS POSSIBLE (AND ALWAYS WITHIN 24 HOURS) FOLLOWING A STORM THAT CAUSES SURFACE EROSION, AND PERFORM NECESSARY MAINTENANCE.
- FREQUENT OBSERVATIONS AND MAINTENANCE ARE NECESSARY TO MAINTAIN BMPs IN EFFECTIVE OPERATING CONDITION. INSPECTIONS AND CORRECTIVE MEASURES SHOULD BE DOCUMENTED THOROUGHLY.
- WHERE BMPs HAVE FAILED, REPAIR OR REPLACEMENT SHOULD BE INITIATED UPON DISCOVERY OF THE FAILURE.
4. EBCs SHALL BE LEFT IN PLACE TO EVENTUALLY BIODEGRADE, UNLESS REQUESTED TO BE REMOVED BY THE LOCAL JURISDICTION.
5. ANY ECB PULLED OUT, TORN, OR OTHERWISE DAMAGED SHALL BE REPAIRED OR RESEEDED AND MULCHED. IF A HOLE HAS BEEN DRILLED IN THE ECB, THE HOLE SHOULD BE CREADED A VOID UNDER THE BLANKET, OR THAT REMAIN DEVOID OF GRASS SHALL BE REPAIRED, RESEEDED AND MULCHED AND THE ECB REINSTALLED.

GENERAL INLET PROTECTION INSTALLATION NOTES


- SEE PLAN VIEW FOR:
-LOCATION AND LENGTH OF SLOPE DRAIN.
-PIPE DIAMETER, D, AND RIPRAPPIN SIZE, O50.
- SLOPE DRAIN SHALL BE DESIGNED TO CONVEY PEAK RUNOFF FOR 2-YEAR 24-HOUR STORM AT A MINIMUM. FOR LONGER DURATION PROJECTS, LARGER MAY BE APPROPRIATE.
- SLOPE DRAIN DIMENSIONS SHALL BE CONSIDERED MINIMUM DIMENSIONS; CONTRACTOR MAY ELECT TO INSTALL LARGER FACILITIES.
- SLOPE DRANS INDICATED SHALL BE INSTALLED PRIOR TO UPGRADE LAND-DISTURBING ACTIVITIES.
- CHECK HEADWATER DEPTHS FOR TEMPORARY AND PERMANENT SLOPE DRANS. DETAILS SHOW MINIMUM COVER; INCREASE AS NECESSARY FOR DESIGN HEADWATER DEPTH.
- RIPRAP SHAL BE PLACED AT SLOPE DRAIN OUTfall.
- ANCHOR PIPE BY COVERING WITH SOIL OR AN ALTERNATE SUITABLE ANCHOR MATERIAL.
- SLOPE DRAIN MAINTENANCE NOTES
- INSPECT BMPs EACH WORKDAY, AND MAINTAIN THEM IN EFFECTIVE OPERATING CONDITION. MAINTENANCE OF BMPs SHOULD BE PROACTIVE, NOT REACTIVE. INSPECT BMPs AS SOON AS POSSIBLE (AND ALWAYS WITHIN 24 HOURS) FOLLOWING A STORM THAT CAUSES SURFACE EROSION, AND PERFORM NECESSARY MAINTENANCE.
- FREQUENT OBSERVATIONS AND MAINTENANCE ARE NECESSARY TO MAINTAIN BMPs IN EFFECTIVE OPERATING CONDITION. INSPECTIONS AND CORRECTIVE MEASURES SHOULD BE DOCUMENTED THOROUGHLY.
- WHERE BMPs HAVE FAILED, REPAIR OR REPLACEMENT SHOULD BE INITIATED UPON DISCOVERY OF THE FAILURE.
4. SEDIMENT ACCUMULATED UPSTREAM OF THE SILT FENCE SHALL BE REMOVED AS NECESSARY TO MAINTAIN BMP EFFECTIVENESS, TYPICALLY WHEN STORAGE VOLUME REACHES 50% OF CAPACITY. A DEPTH OF 6" WHILE SILT FENCE IS USED, OR X% THE HEIGHT FOR STORMS WHERE SILT FENCE IS NOT USED.
5. INLET PROTECTION IS TO REMAIN IN PLACE UNTIL THE UPSTREAM DISTURBED AREA IS PERMANENTLY STABILIZED, UNLESS THE LOCAL JURISDICTION APPROVES EARLIER REMOVAL OF INLET PROTECTION.
6. WHEN INLET PROTECTION AT AREA INLETS IS REMOVED, THE DISTURBED AREA SHALL BE COVERED WITH TOP SOIL, SEEDED AND MULCHED, OR OTHERWISE STABILIZED IN A MANNER APPROVED BY THE LOCAL JURISDICTION.
- EMBANKMENT MATERIAL SHALL BE COMPACTED TO AT LEAST 95 PERCENT OF MAXIMUM DENSITY IN ACCORDANCE WITH ASTM D698.
- PVC SCH 40 OR GREATER SHALL BE USED.
- THE DETAILS SHOWN ON THESE SHEETS PERTAIN TO STANDARD SEDIMENT BASIN(S) FOR SEDIMENT AREAS THAT ARE NOT SUBJECT TO EROSION. FOR EMBANKMENT, STORE VOLVOL SPILLWAY, OUTLET, AND INLET PROTECTION DETAILS FOR ANY SEDIMENT BASIN(S) THAT HAVE BEEN INDIVIDUALLY DESIGNED FOR ORANGE AREAS LARGER THAN 15 ACRES.
- SEDIMENT BASIN MAINTENANCE NOTES
- INSPECT BMPs EACH WORKDAY, AND MAINTAIN THEM IN EFFECTIVE OPERATING CONDITION. MAINTENANCE OF BMPs SHOULD BE PROACTIVE, NOT REACTIVE. INSPECT BMPs AS SOON AS POSSIBLE (AND ALWAYS WITHIN 24 HOURS) FOLLOWING A STORM THAT CAUSES SURFACE EROSION, AND PERFORM NECESSARY MAINTENANCE.
- FREQUENT OBSERVATIONS AND MAINTENANCE ARE NECESSARY TO MAINTAIN BMPs IN EFFECTIVE OPERATING CONDITION. INSPECTIONS AND CORRECTIVE MEASURES SHOULD BE DOCUMENTED THOROUGHLY.
- WHERE BMPs HAVE FAILED, REPAIR OR REPLACEMENT SHOULD BE INITIATED UPON DISCOVERY OF THE FAILURE.
4. SEDIMENT ACCUMULATED IN BASIN SHALL BE REMOVED AS NEEDED TO MAINTAIN BMP EFFECTIVENESS, TYPICALLY WHEN SEDIMENT DEPTH REACHES ONE FOOT (I.E., TWO FEET BELOW THE SPILLWAY CREST).
5. SEDIMENT BASINS ARE TO REMAIN IN PLACE UNTIL THE UPSTREAM DISTURBED AREA IS STABILIZED AND GRASS COVER IS ACCEPTED BY THE LOCAL JURISDICTION.
- WHEN SEDIMENT BASINS ARE REMOVED, ALL DISTURBED AREAS SHALL BE COVERED WITH TOP SOIL, SEEDED AND MULCHED OR OTHERWISE STABILIZED AS APPROVED BY LOCAL JURISDICTION.

BLOCK AND ROCK SOCK INLET PROTECTION INSTALLATION NOTES

- SEE ROCK SOCK DESIGN DETAIL FOR INSTALLATION REQUIREMENTS.
- CONCRETE "CINDER" BLOCKS SHALL BE LAID ON THEIR SIDES AROUND THE INLET IN A SINGLE ROW, ABUTTING ONE ANOTHER WITH THE OPEN END FACING AWAY FROM THE CURB.
- GRAVEL BAGS SHALL BE PLACED AROUND CONCRETE BLOCKS, CLOSELY ABUTTING ONE ANOTHER AND JOINTED TOGETHER IN ACCORDANCE WITH ROCK SOCK DESIGN DETAIL.

INLET PROTECTION

NTS

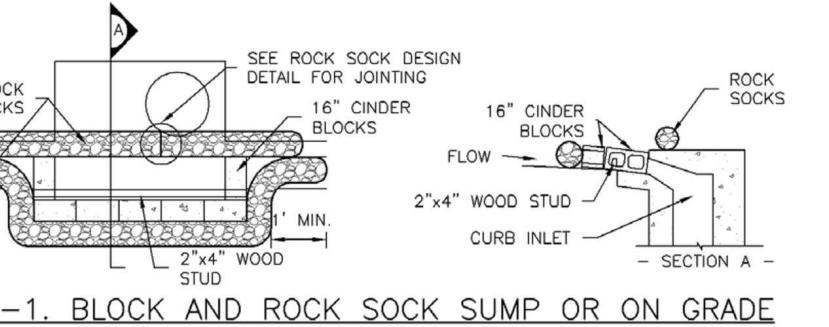

INLET PROTECTION

NTS

TEMPORARY SLOPE DRAIN PROFILE

NTS


TEMPORARY SLOPE DRAIN

NTS

TEMPORARY SLOPE DRAIN

NTS


SECTION A

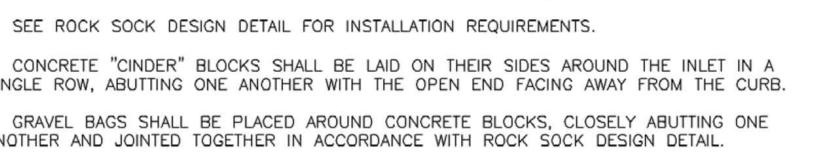

SILT FENCE DETAIL

NTS


SECTION A

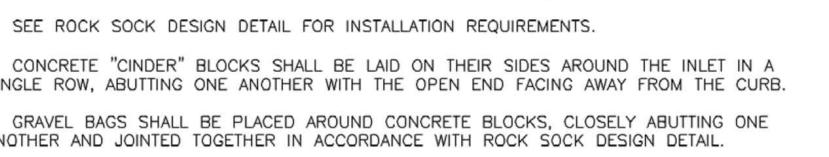

SILT FENCE DETAIL

NTS


SECTION A

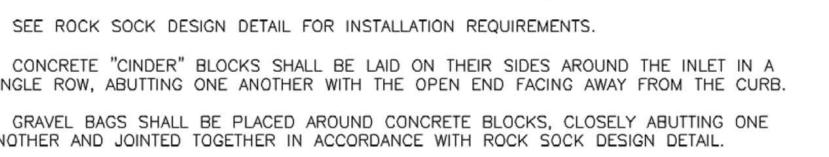

ROUGH CUT STREET CONTROL

NTS


SECTION A

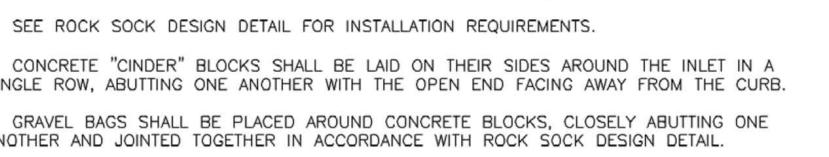

ROUGH CUT STREET CONTROL

NTS


SECTION A-A

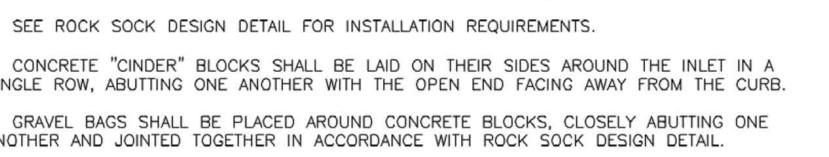

ROUGH CUT STREET CONTROL PLAN

NTS


SECTION B

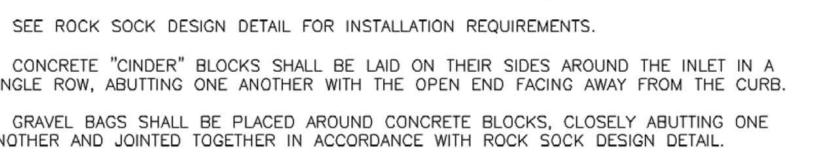

ROUGH CUT STREET CONTROL PLAN

NTS


SECTION B

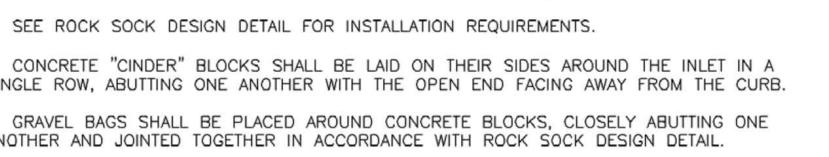

ROUGH CUT STREET CONTROL PLAN

NTS


SECTION A

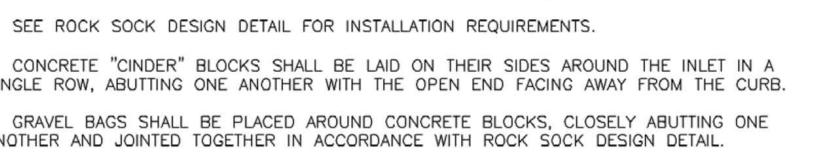

ROUGH CUT STREET CONTROL PLAN

NTS


SECTION A-A

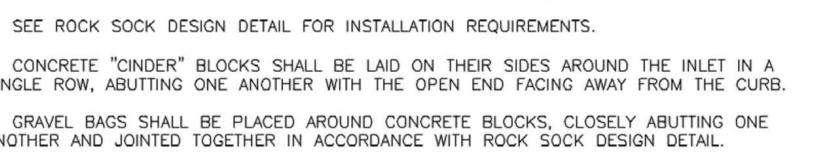

ROUGH CUT STREET CONTROL PLAN

NTS


SECTION A

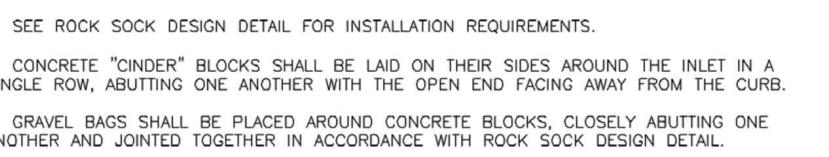

ROUGH CUT STREET CONTROL PLAN

NTS


SECTION A-A

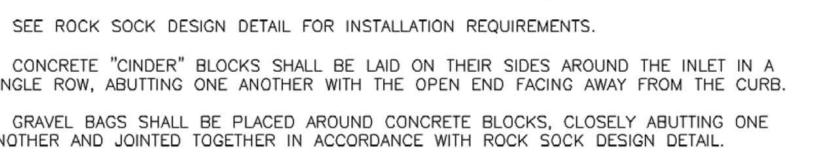

ROUGH CUT STREET CONTROL PLAN

NTS


SECTION B

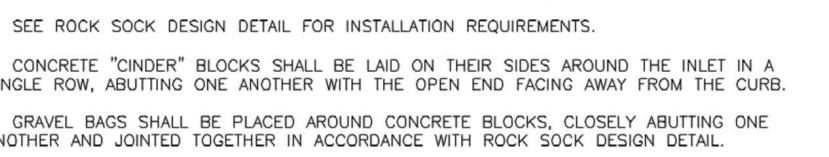

ROUGH CUT STREET CONTROL PLAN

NTS


SECTION A

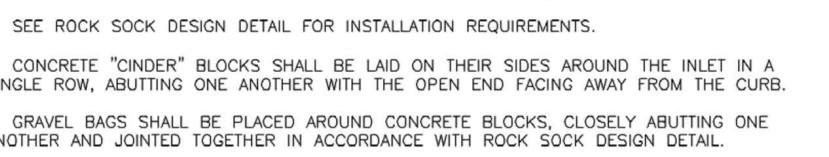

ROUGH CUT STREET CONTROL PLAN

NTS


SECTION A-A

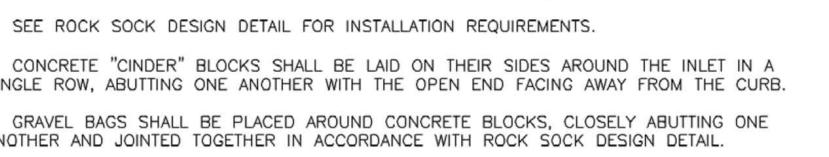

ROUGH CUT STREET CONTROL PLAN

NTS


SECTION B

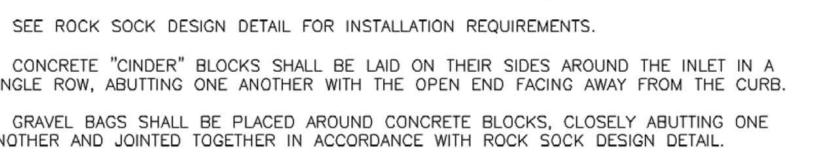



Know what's below.
Call before you dig.


FOR STORM SEWER DESIGN
SEE SHEETS 11-13

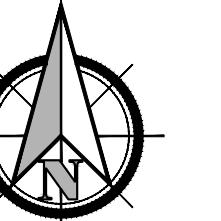

0 100' 200'
SCALE: 1"=100'

SUBSEQUENT TO STRIPPING AND GRUBBING THE FOLLOWING OVERLOT/PIPE INSTALLATION PROCEDURES ARE ANTICIPATED FOR THE SANITARY SEWER LOCATED ON PROPOSED EMBANKMENTS:

- THE REMOVAL AND REPLACEMENT OF METASTABLE SOIL.
- TESTING OF THE FILL SUBSEQUENT TO THE PENETRATION OF THE METASTABLE SOIL WILL CONTINUE UNTIL A MINIMUM OF 7 FEET OF STRUCTURAL FILL HAS BEEN PLACED ABOVE THE PROPOSED SEWER LINE ELEVATION.
- UTILITY TRENCHES SHALL BE EXCAVATED AND SANITARY SEWER LINE INSTALLED. THE PIPE SHALL BE PROPERLY BEDDED AND STRUCTURAL FILL PLACED AND TESTED TO THE PREVIOUS GRADE.
- THE OVERLOT AND EMBANKMENT FILL CAN BE COMPLETED.
- WHERE THE SANITARY SEWER IS PLACED IN EMBANKMENT FILL DURING THE OVERLOT PROCESS, STE SHALL MONITOR AND TEST ALL WORK ASSOCIATED WITH THE AFFECTED PORTIONS.

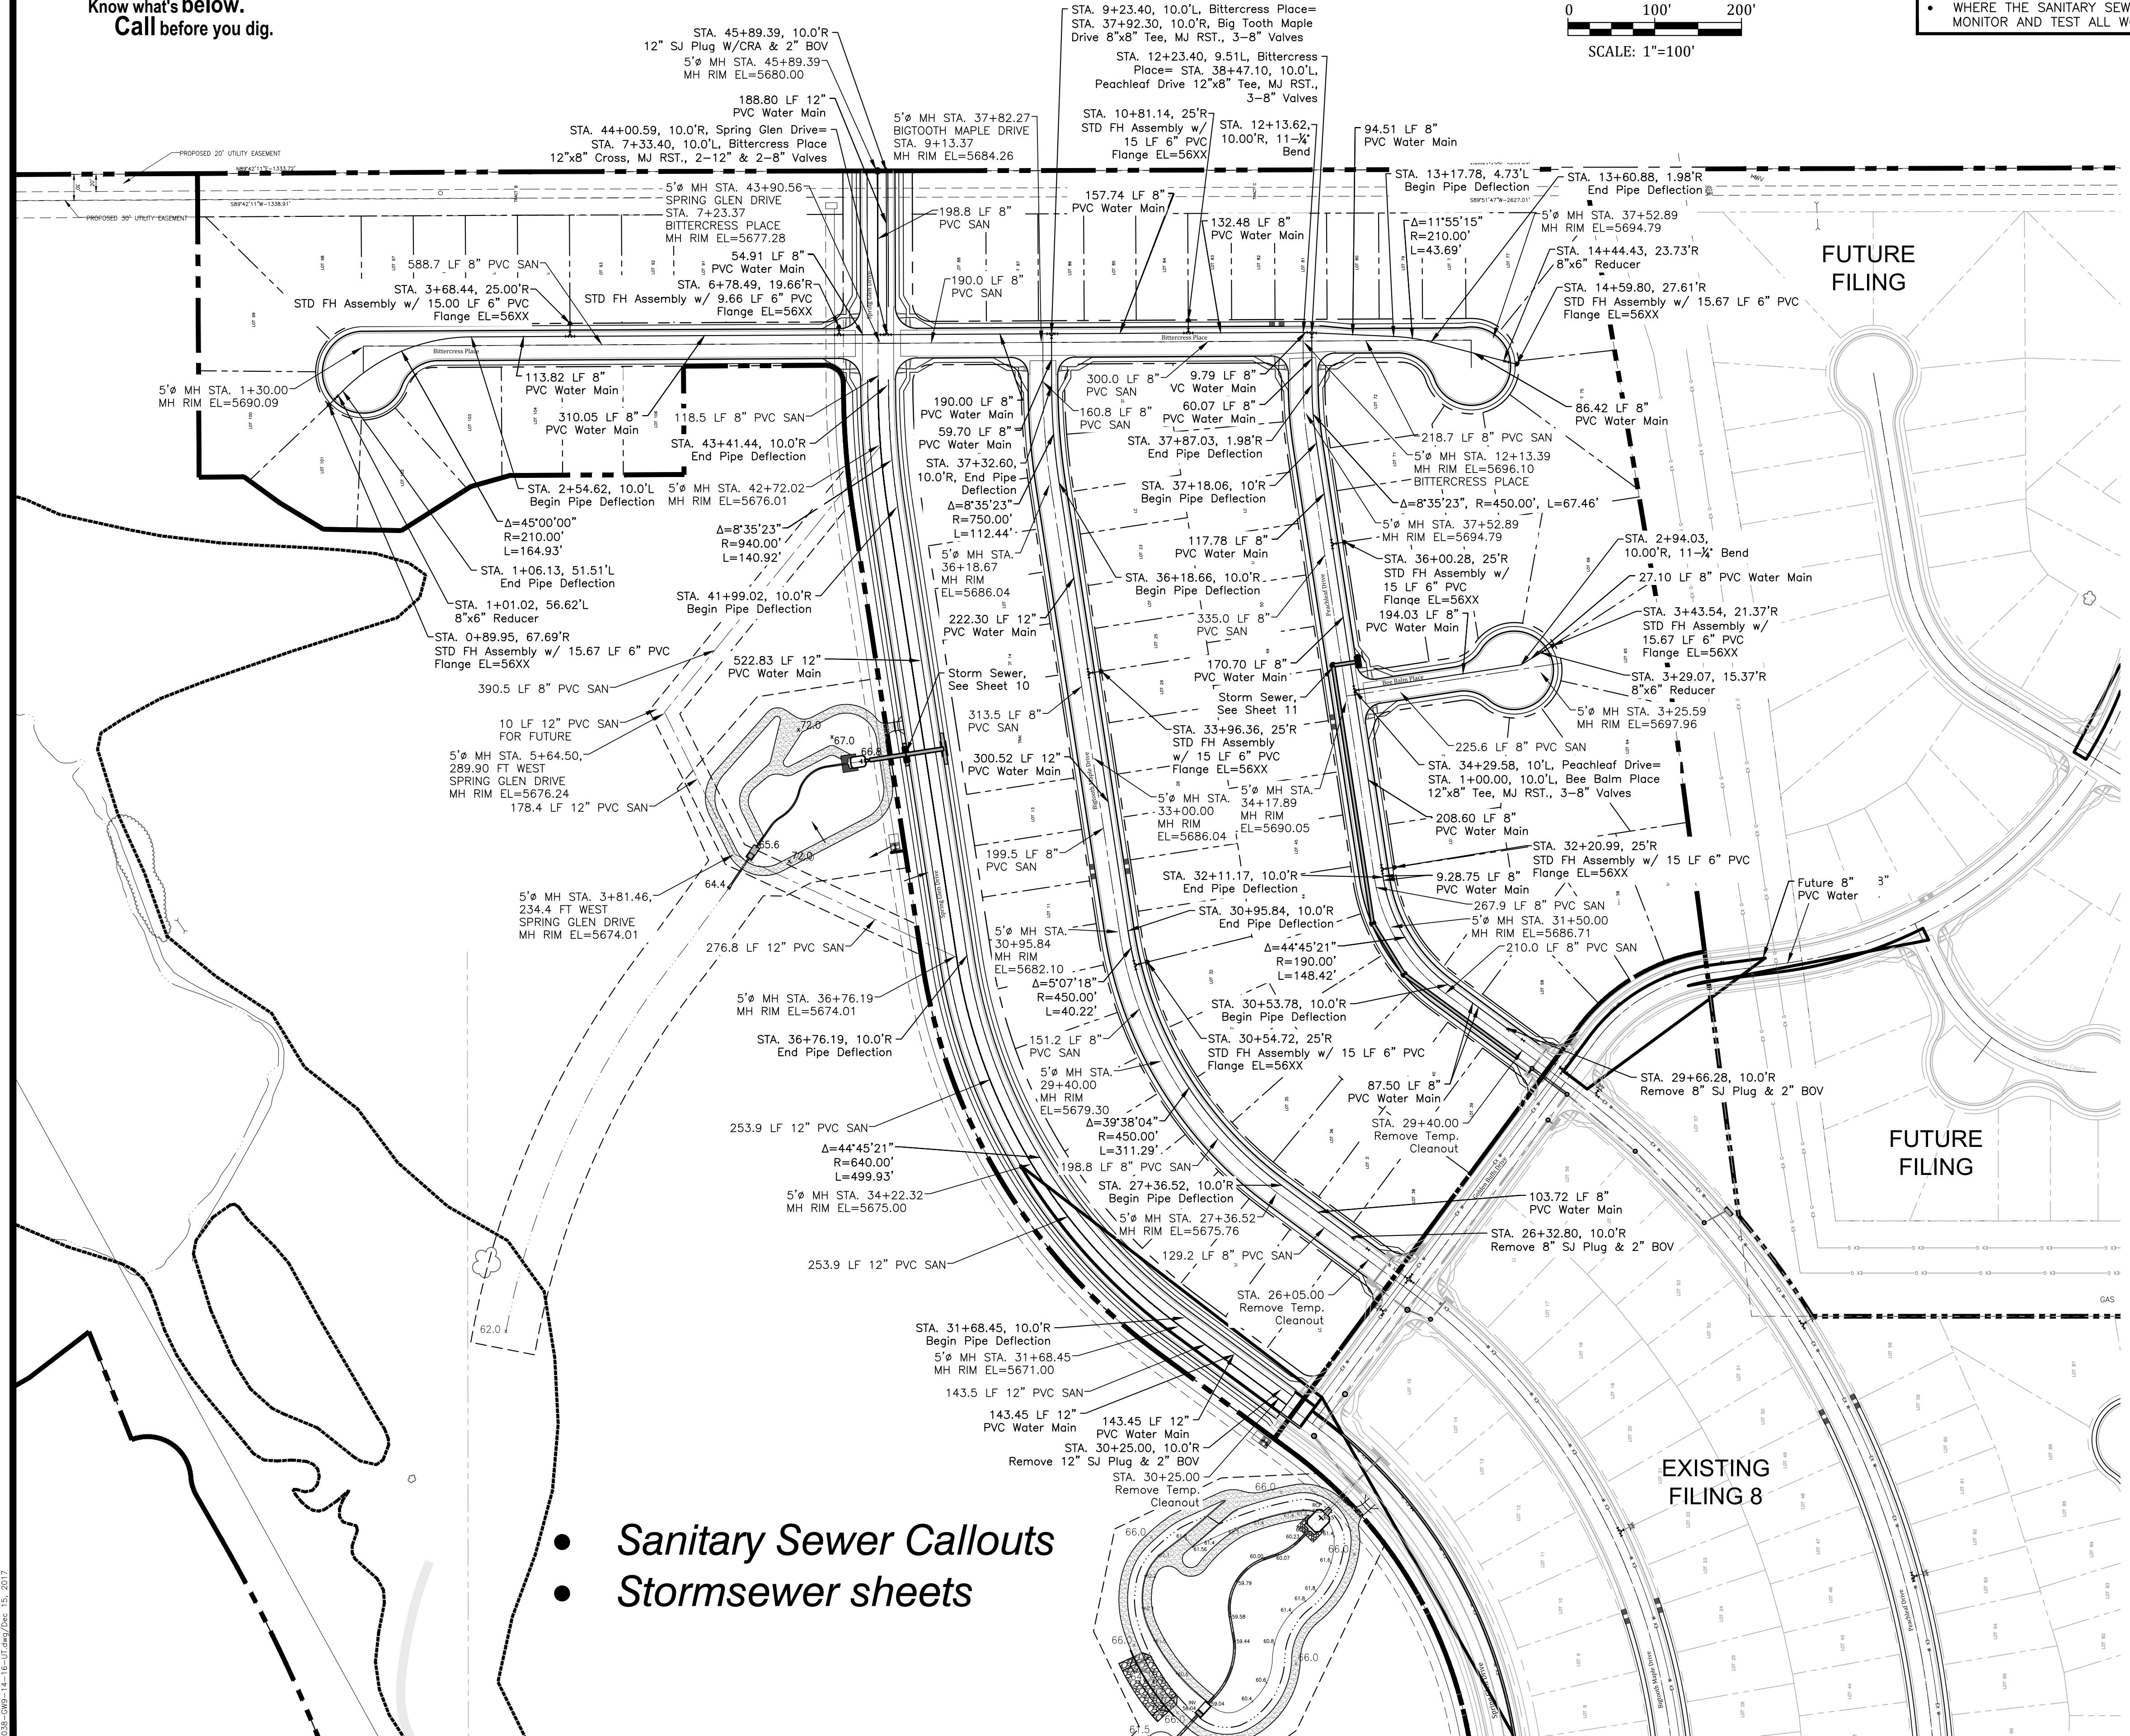

ADDITIONAL UTILITY NOTES	
GAS	- ALL GAS MAINS AND SERVICES ARE TO BE INSTALLED PER THE CITY OF COLORADO SPRINGS.
ELECTRIC	- ALL ELECTRIC SERVICES ARE TO BE INSTALLED PER THE CITY OF FOUNTAIN ELECTRIC DIVISION.
UTILITY CONTACTS	
SEWER:	WIDEFIELD W&S DISTRICT (WWSD) 390-7111
WATER:	WIDEFIELD W&S DISTRICT (WWSD) 390-7111
ELECTRIC:	MOUNTAIN VIEW ELECTRIC 495-2283
GAS:	PEOPLES NATURAL GAS 800-363-0752
PHONE:	US WEST 636-4632



LEGEND	
PROPOSED 8" PVC WATER MAIN (DR 18)	WITH MJ FITTINGS (UNLESS OTHERWISE NOTED)
WIDEFIELD WATER & SANITATION DISTRICT STANDARD FIRE HYDRANT ASSEMBLY. INSTALL PER WIDEFIELD WATER AND SANITATION DISTRICT CONSTRUCTION SPECIFICATIONS	
8" GATE VALVE (UNLESS OTHERWISE NOTED)	
TEE w/CONCRETE THRUST BLOCK	
MINIMUM RADIUS SHOWN FOR WATER MAIN = 290' PER WSSD SPECIFICATIONS AND EL PASO COUNTY ECM 4.3.6.A&2, THE MINIMUM COVER OVER WATER MAIN & SERVICES AND SANITARY SEWER MAINS & SERVICES IS 5 FEET.	

WATER AND SEWER MAIN EXTENSIONS	
Any changes or alterations affecting the grade, alignment, elevation and/or depth of cover of any water or sewer main(s) other than those shown on this drawing shall be the responsibility of the Owner/Developer. The Owner/Developer shall be responsible for all operational damages and defects in installation and material for mains and services from the date of approval until final acceptance is issued.	
Signed _____	Date _____
Print Name J. Mark Watson, President	
DBA: GLEN DEVELOPMENT COMPANY	
Address: 3 Widefield Boulevard Colorado Springs, CO 80911 (719) 392-0194	
FIRE AUTHORITY APPROVAL	
The number of fire hydrants and hydrant locations shown on this water installation plan are correct and adequate to satisfy the fire protection requirements as specified by the Security Fire District.	
Security Fire Department	
Signed _____	Date _____
Security Fire Department	

UTILITY APPROVALS	
DISTRICT APPROVALS	The Widefield Water and Sanitation District recognizes the design engineer as having responsibility for the design. The Widefield Water and Sanitation District has limited its scope of review accordingly.
WIDEFIELD WATER AND SANITATION DISTRICT WASTEWATER DESIGN APPROVAL	Date: _____ By: _____
PROJECT NO. _____	
In case of errors or omissions with the sewer design as shown on this document the standards as defined in the "Rules and Regulations for Installation of Sewer Mains and Services" shall rule. Approval expires 180 days from Design Approval.	
WIDEFIELD WATER AND SANITATION DISTRICT WATER DESIGN APPROVAL	Date: _____ By: _____
PROJECT NO. _____	
In case of errors or omissions with the sewer design as shown on this document the standards as defined in the "Rules and Regulations for Installation of Sewer Mains and Services" shall rule. Approval expires 180 days from Design Approval.	

GLEN AT WIDEFIELD FILING NO. 9 UTILITY PLAN UTILITIES EL PASO COUNTY, COLORADO

Project No.: 17038
Date: December 15, 2017
Design: AWMc
Drawn: JAK
Check: AWMc
Revisions: _____
SHEET 14
14 of 20 Sheets

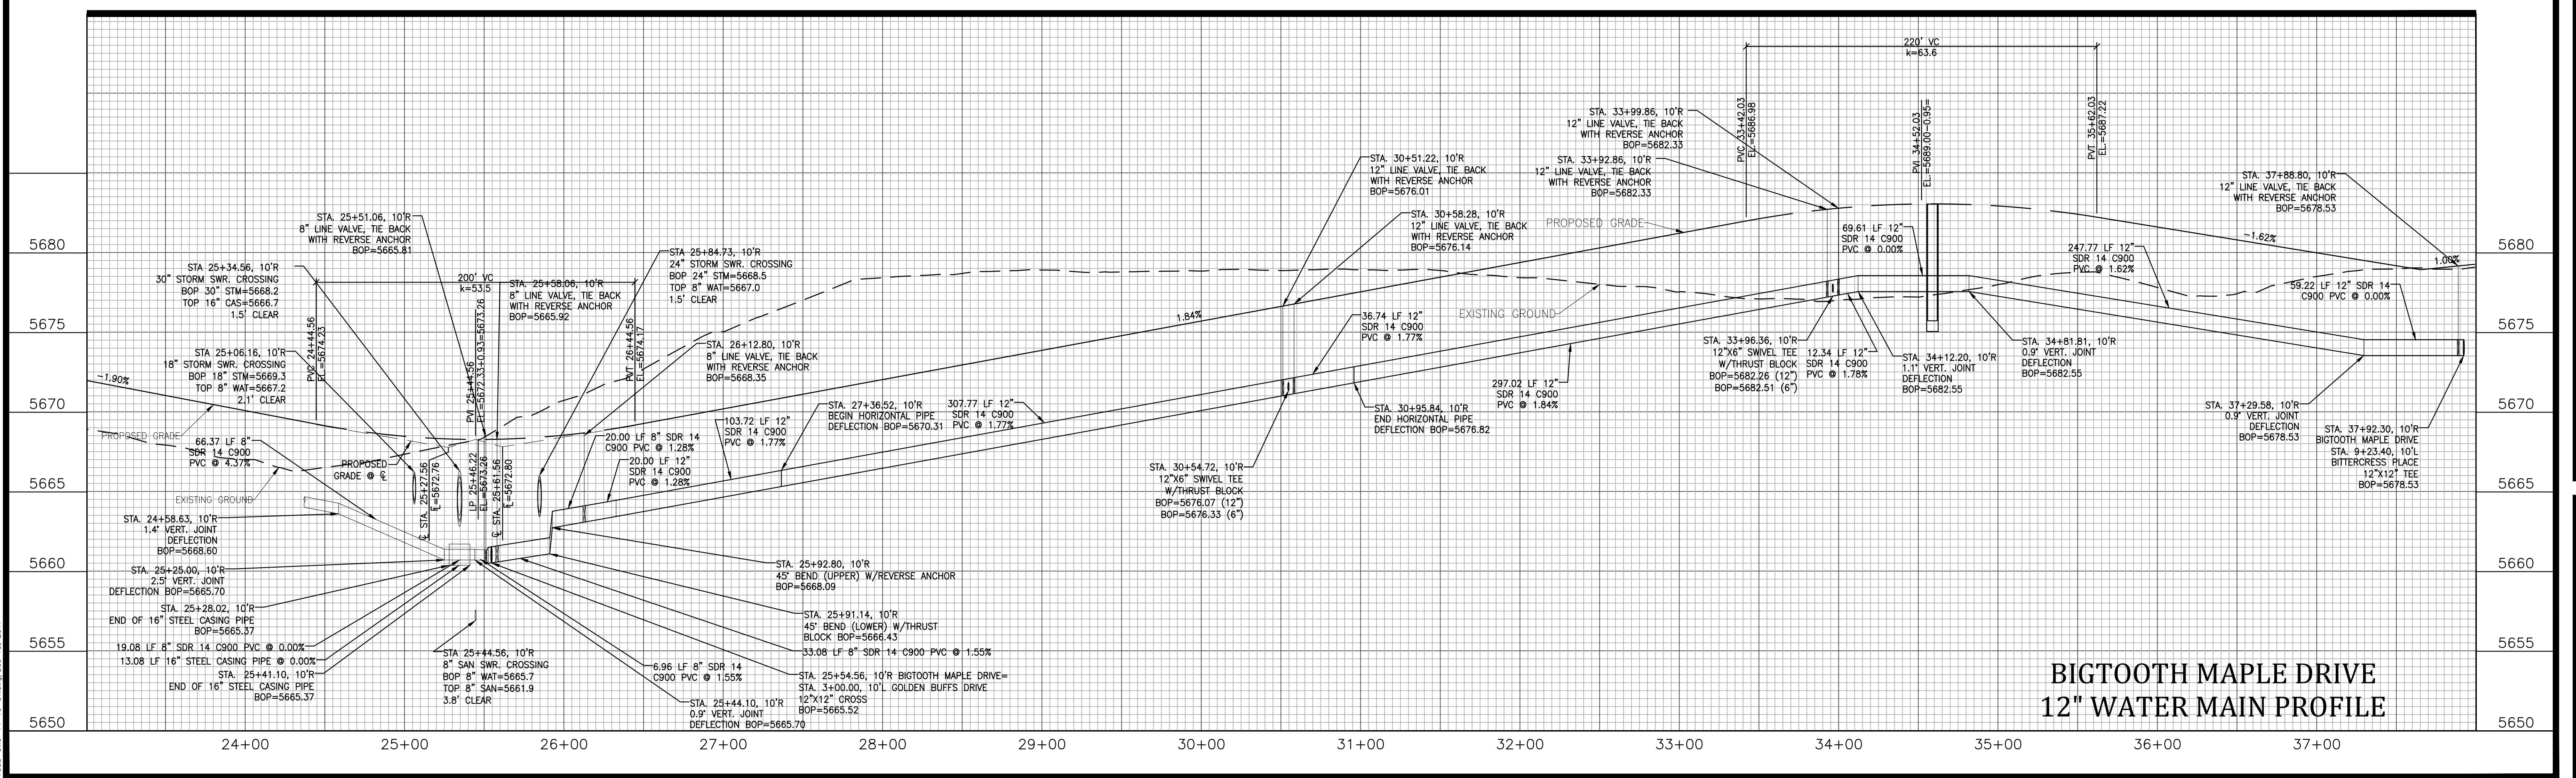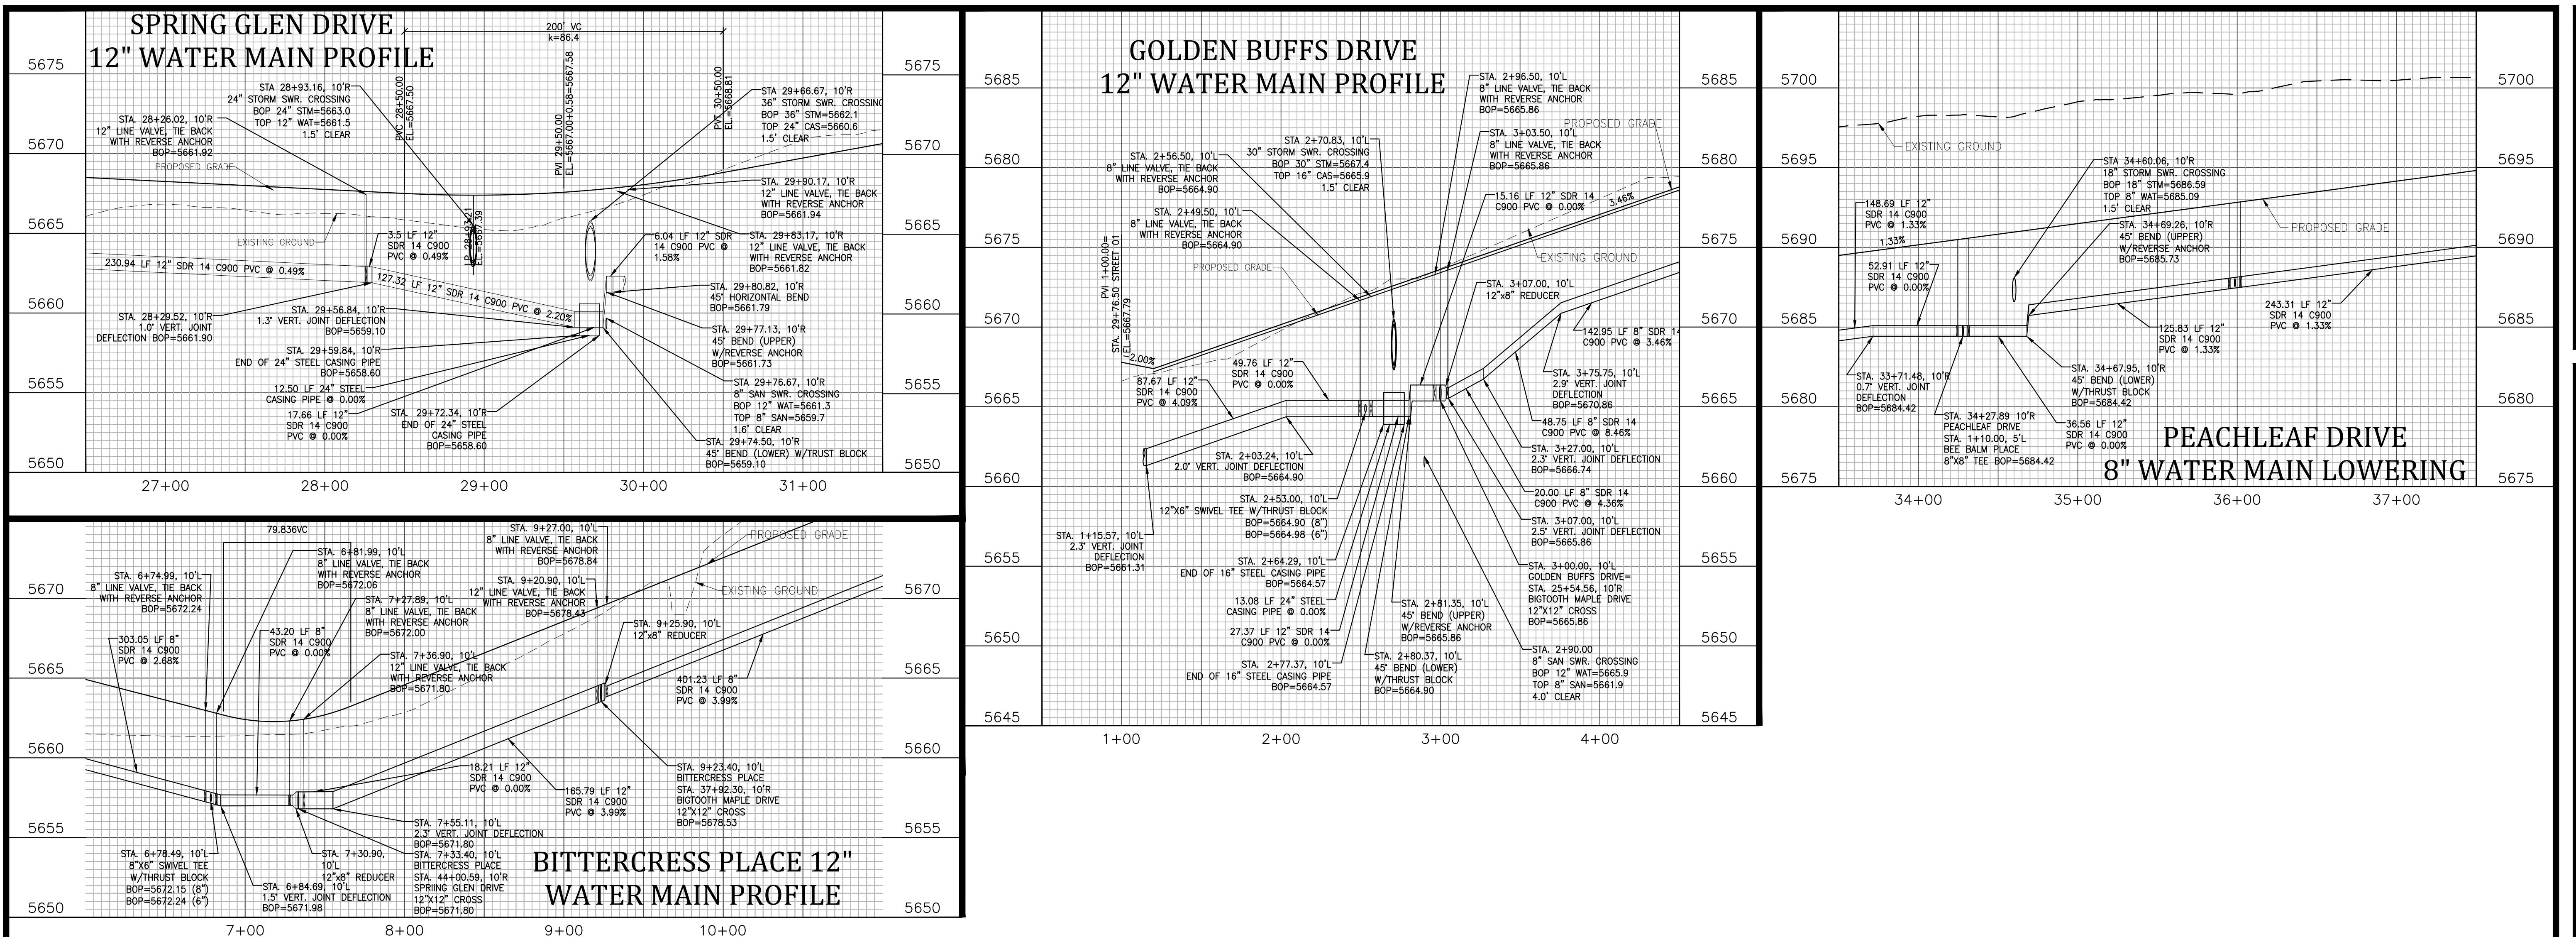

GLEN AT WIDEFIELD FILING NO. 9 SITE DETAIL PLAN DETENTION BASIN DETAILS EL PASO COUNTY, COLORADO


Project No.: 17038
Date: December 15, 2017
Design: JAK
Drawn: JAK
Check: AWMc
Revisions:

SHEET

17


17038-GW-17-18-DT.dwg/Dec 15, 2017

STRUCTURE NOTES:
1. PRIOR TO CONSTRUCTION, CONTRACTOR TO PROVIDE SHOP DRAWINGS FOR ALL COMPONENTS OF THE OUTLET STRUCTURE.
2. GRADE 60 REINFORCING STEEL REQUIRED. SEE TABLE FOR THE MINIMUM LAP SPLICING LENGTH FOR REINFORCING BARS. ALL REINFORCING BARS SHALL HAVE 2-INCH MINIMUM SPACING FROM EDGE OF CONCRETE AND 3-INCH MIN CLEARANCE TO EDGE OF CONCRETE PLACED AGAINST SOIL, UNLESS OTHERWISE NOTED.
BAR SIZE #4 #5 #6
MIN. SPLICE LENGTH 1'-3" 1'-7" 2'-0"
3. CONCRETE FOR THE OUTLET STRUCTURE AND FOREBAY SHALL BE CDOT CLASS D CONCRETE.
4. EXPANSION JOINT MATERIAL SHALL MEET ASHTO SPECIFICATION M-213. EXPANSION JOINT MATERIAL SHALL BE 1/2" THICK, SHALL EXTEND THE FULL DEPTH OF CONTACT SURFACE AND THE JOINT SHALL BE SEALED, REFER TO DETAILS.
5. EXPANSION COEFFICIENTS ARE A 1/12-INCH CONFER UNLESS OTHERWISE NOTED.
6. BACKFILLING AGAINST WALLS SHALL NOT COMMENCE UNTIL CONCRETE HAS OBTAINED ITS FULL SEVEN DAY STRENGTH.
7. SUBGRADE TO BE 12" THK CLEAN FILL COMPACTED TO 95% STANDARD PROCTOR DENSITY PER ASTM M698 UNDER STRUCTURES.
8. OUTLET STRUCTURE STEPS SHALL CONFORM TO ASHTO M199.
9. FOREBAY CONSTRUCTION JOINTS SHALL BE INSTALLED AT 10° O.C. MAXIMUM. THE JOINTS SHALL BE SEALED WITH A JOINT SEALANT.

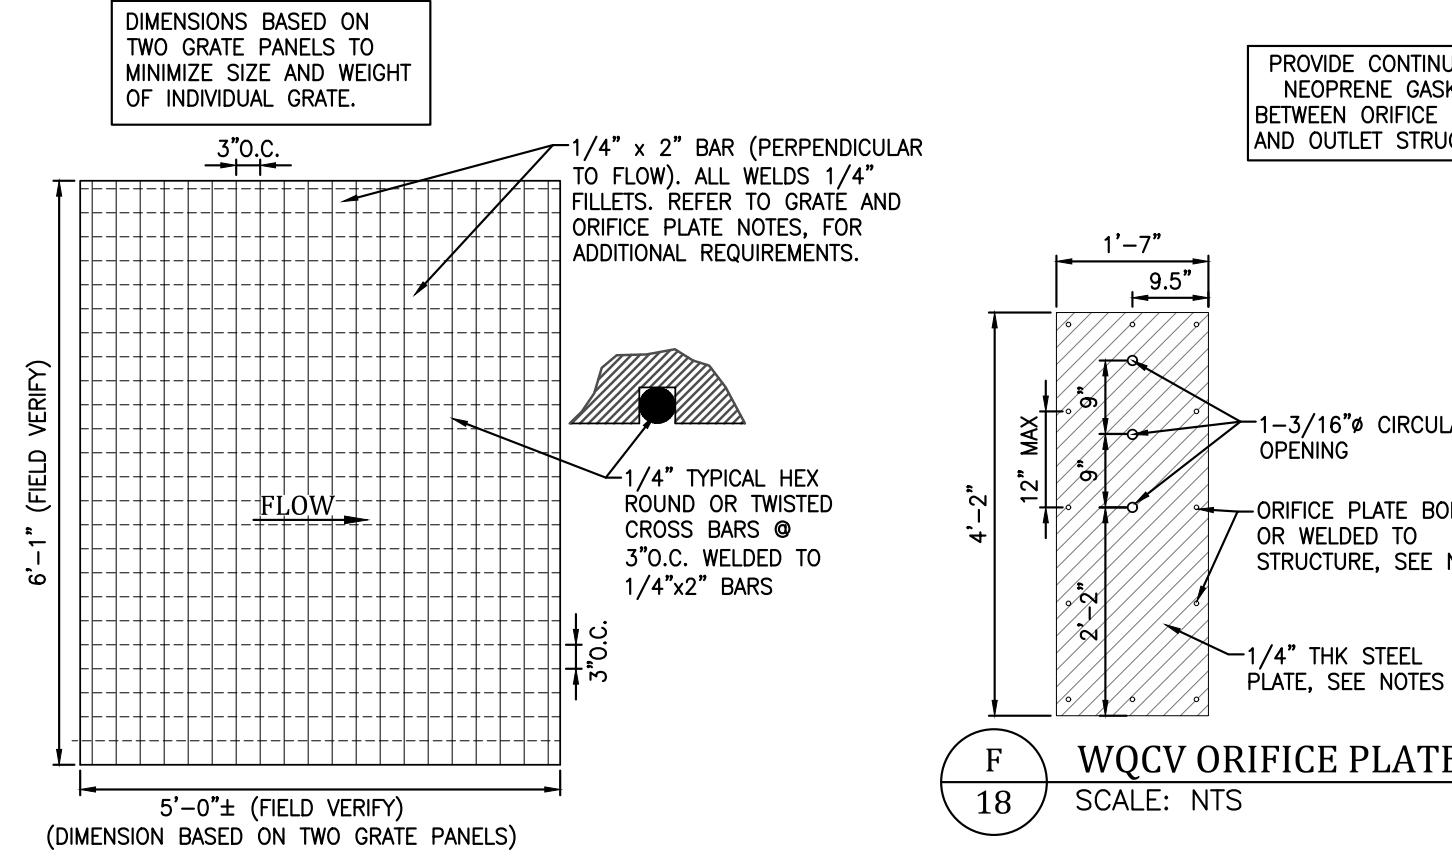


E MAJOR STORM GRATE DETAIL
18 SCALE: NTS

GRATE AND ORIFICE PLATE NOTES:
1. GRATES AND ORIFICE PLATES SHALL BE MOUNTED USING STAINLESS STEEL HARDWARE. GRATES TO BE HOT DIP GALVANIZED.
2. GRATES AND ORIFICE PLATES SHALL BE STAINLESS STEEL, ALUMINUM OR STEEL. STEEL TRASH RACKS SHALL BE HOT DIP GALVANIZED AND HOT POWDER PAINTED AFTER GALVANIZED.
3. FIELD VERIFY GRATE DIMENSION PRIOR TO FABRICATION.

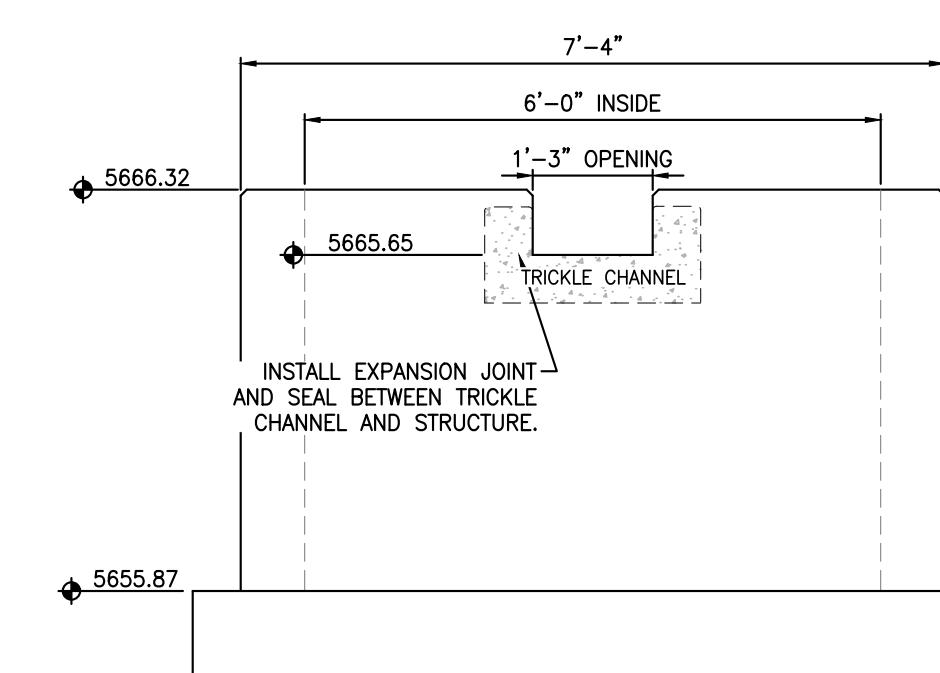

B SECTION B-B
18 SCALE: NTS

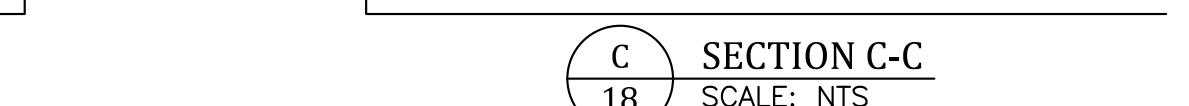


C SECTION C-C
18 SCALE: NTS




D SECTION D-D
18 SCALE: NTS


WQCV WELL-SCREEN NOTES:
1. WELL-SCREEN SHALL BE STAINLESS STEEL AND ATTACHED BY INTERMITTENT WELDS OR STAINLESS STEEL BOLTS ALONG EDGE OF THE MOUNTING FRAME.
2. WQCV WELL SCREEN
• TYPE OF SCREEN: STAINLESS STEEL #93 VEE WIRE (JOHNSON VEE WIRE TM)
• SCREEN SLOT OPENING DIMENSION: 0.139" (SCREEN #93 VEE WIRE SLOT OPENING)
• TYPE AND SIZE OF SUPPORT ROD: TE 0.074" x 0.50"
• SPACING OF SUPPORT ROD (O.C.): 1.0 INCH
• TOTAL SCREEN THICKNESS: 0.655"
• CARBON STEEL HOLDING FRAME TYPE: 3/4" x 1.0" ANGLE

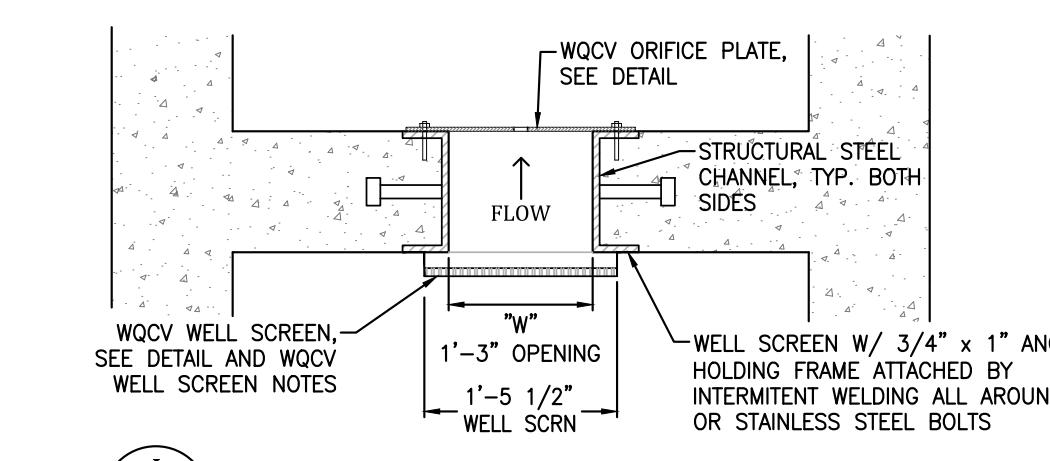


I 18 WQCV ORIFICE PLATE AND WELL SCREEN
SCALE: NTS

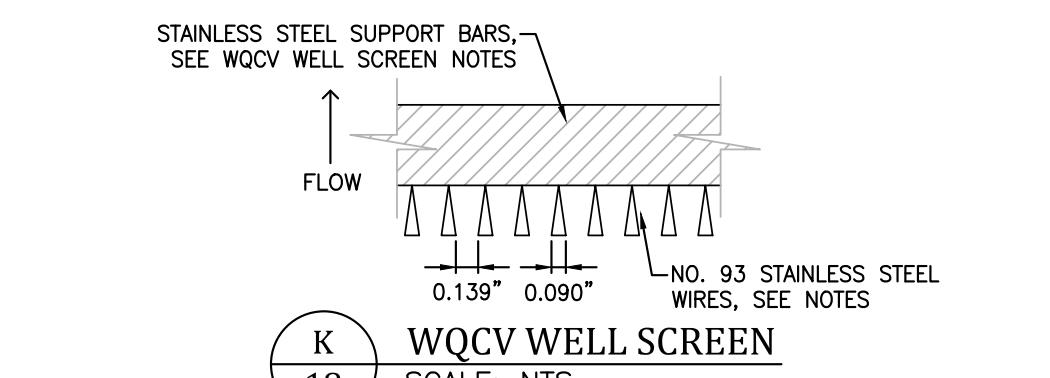


K 18 WQCV WELL SCREEN
SCALE: NTS

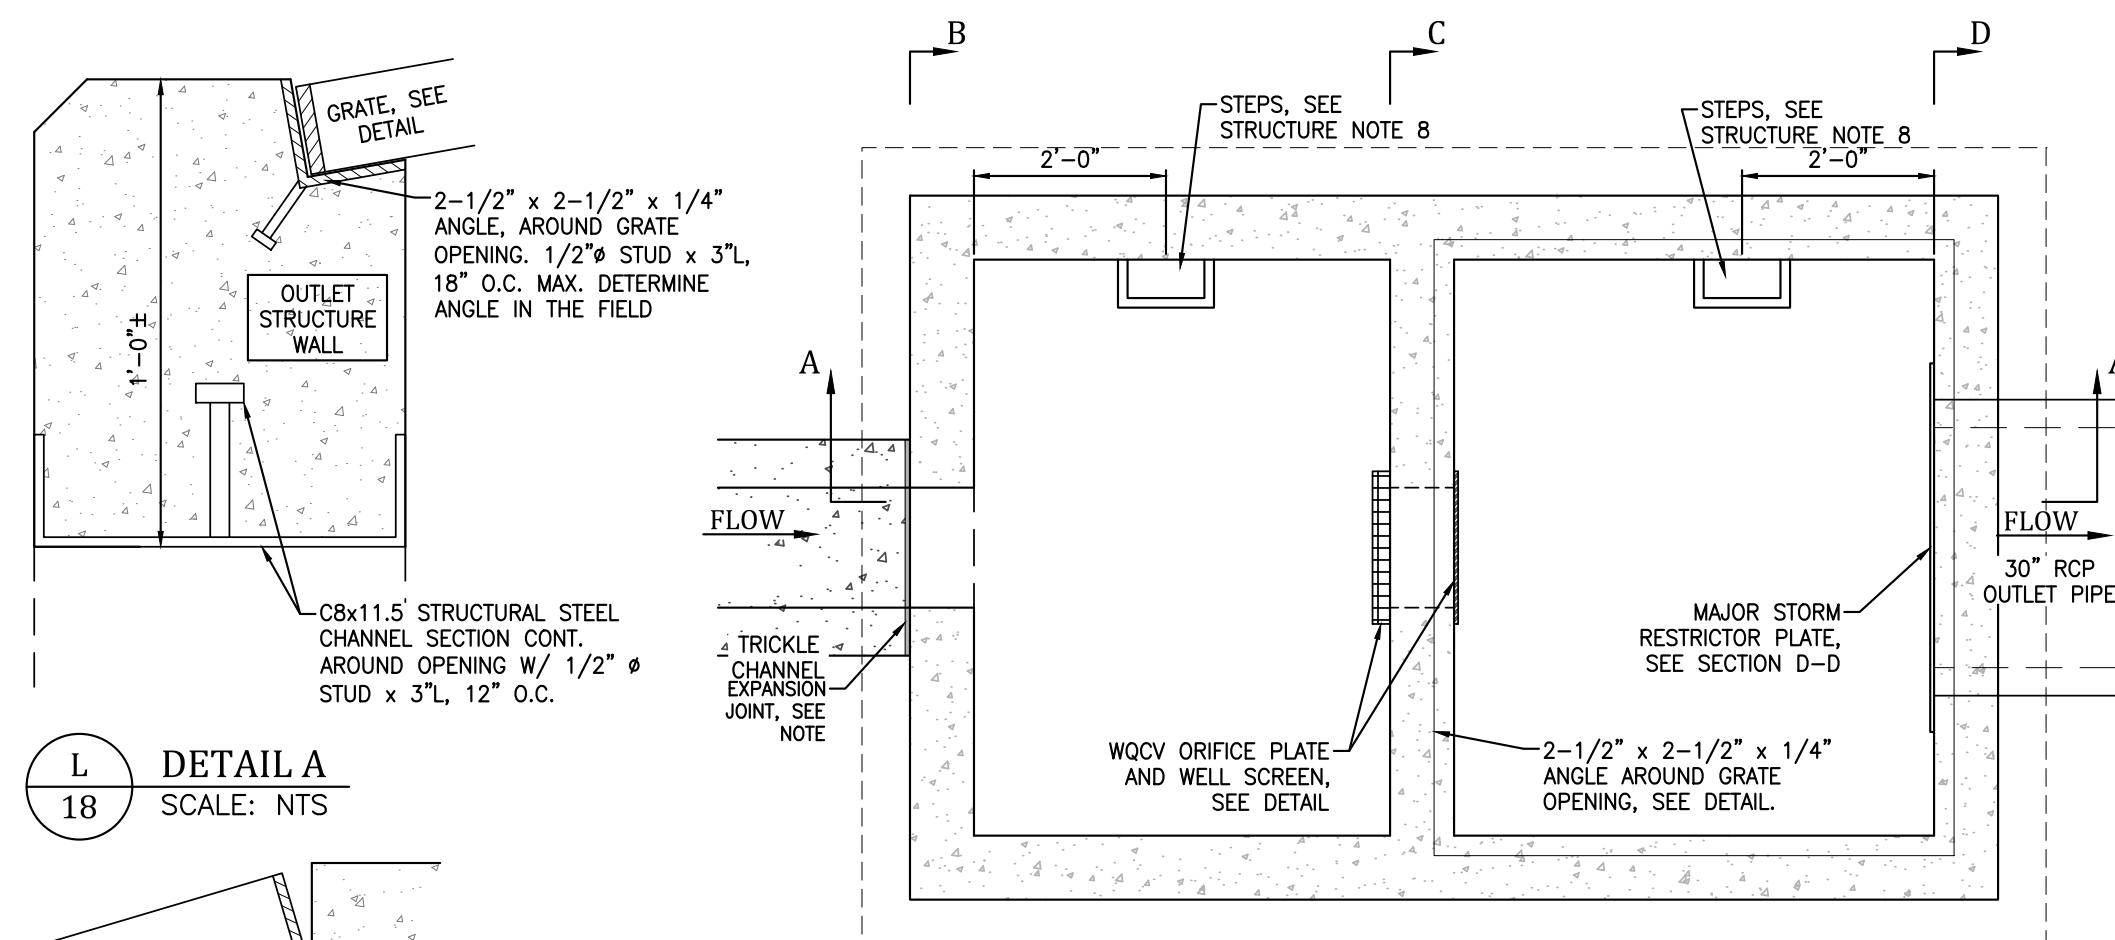

Z 18 OUTLET STRUCTURE DETAIL
PLAN VIEW
SCALE: NTS

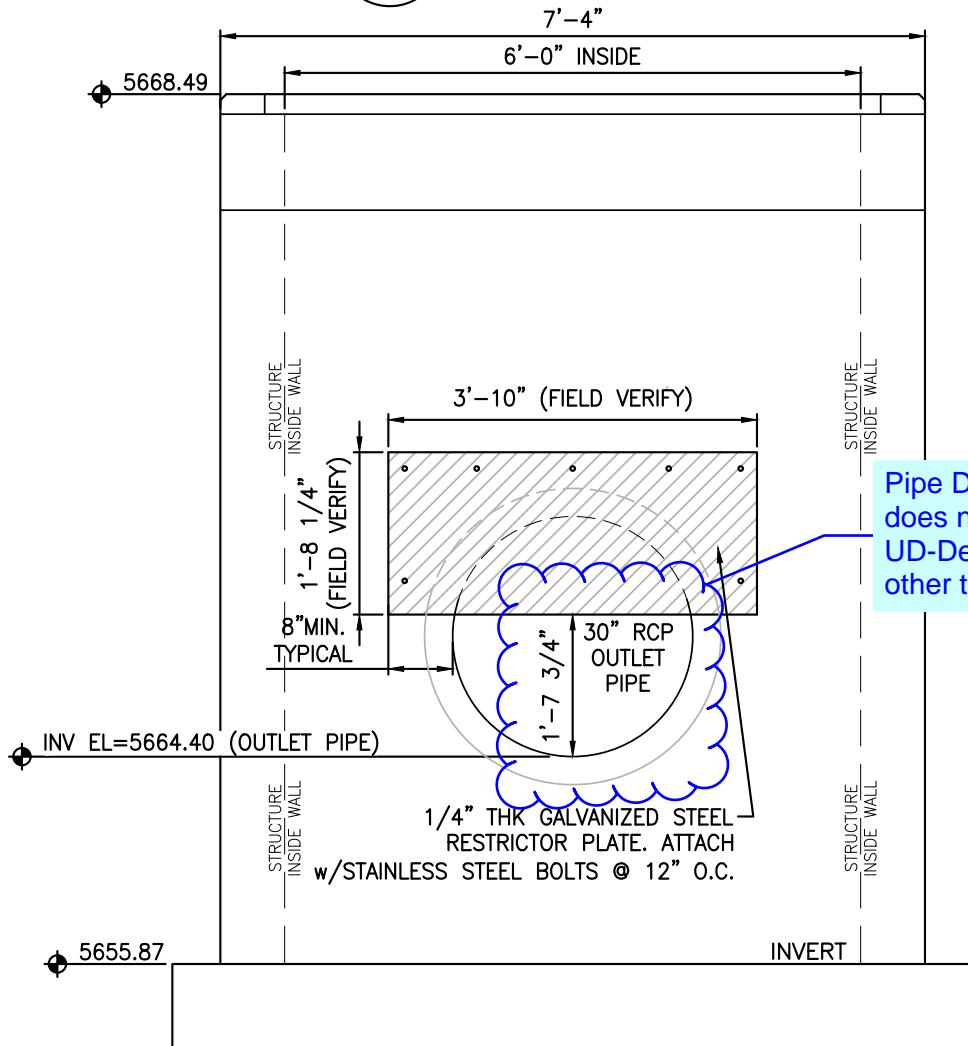


A SECTION A-A
18 SCALE: NTS

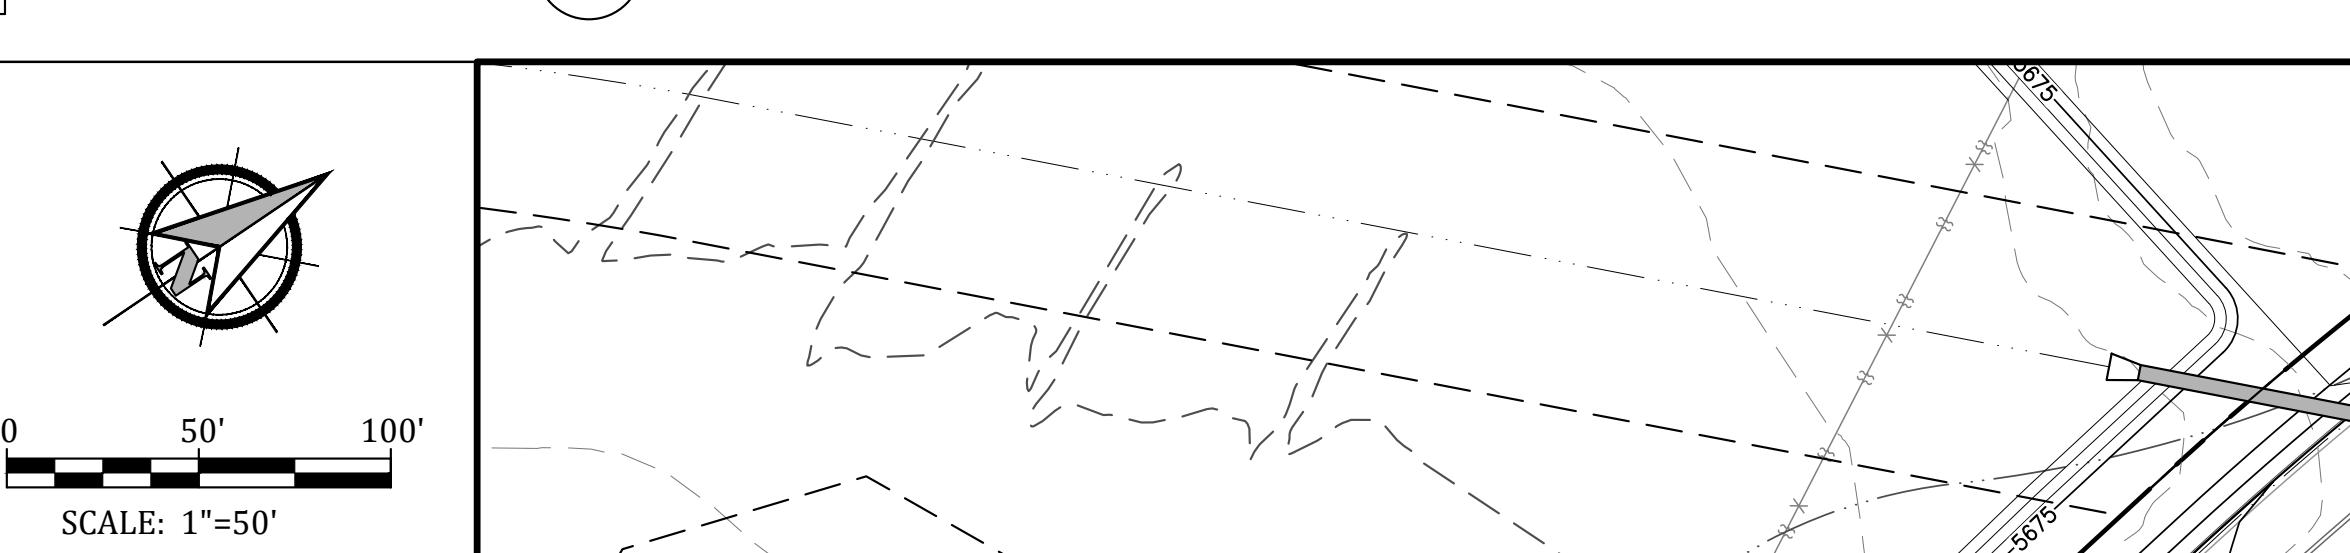


C SECTION C-C
18 SCALE: NTS


Pipe Diameter and height above pipe invert does not match the drainage report
UD-Detention calculation. Update one or the other to match.

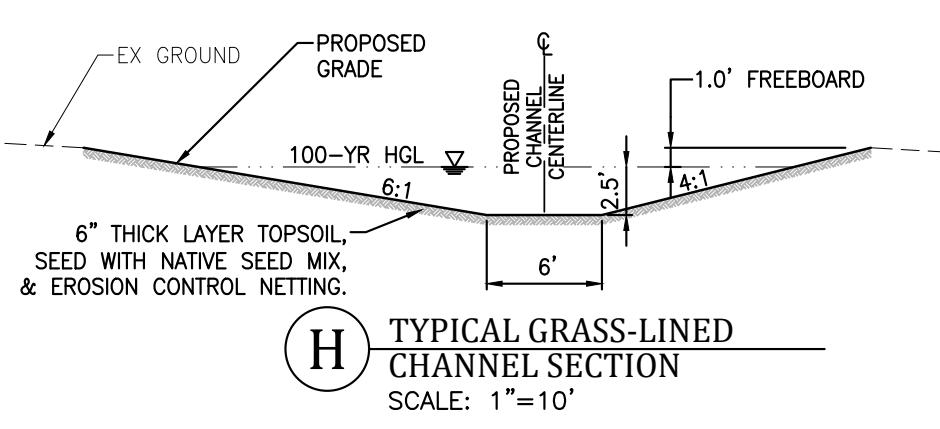

H TYPICAL GRASS-LINED
CHANNEL SECTION
SCALE: 1'=10'

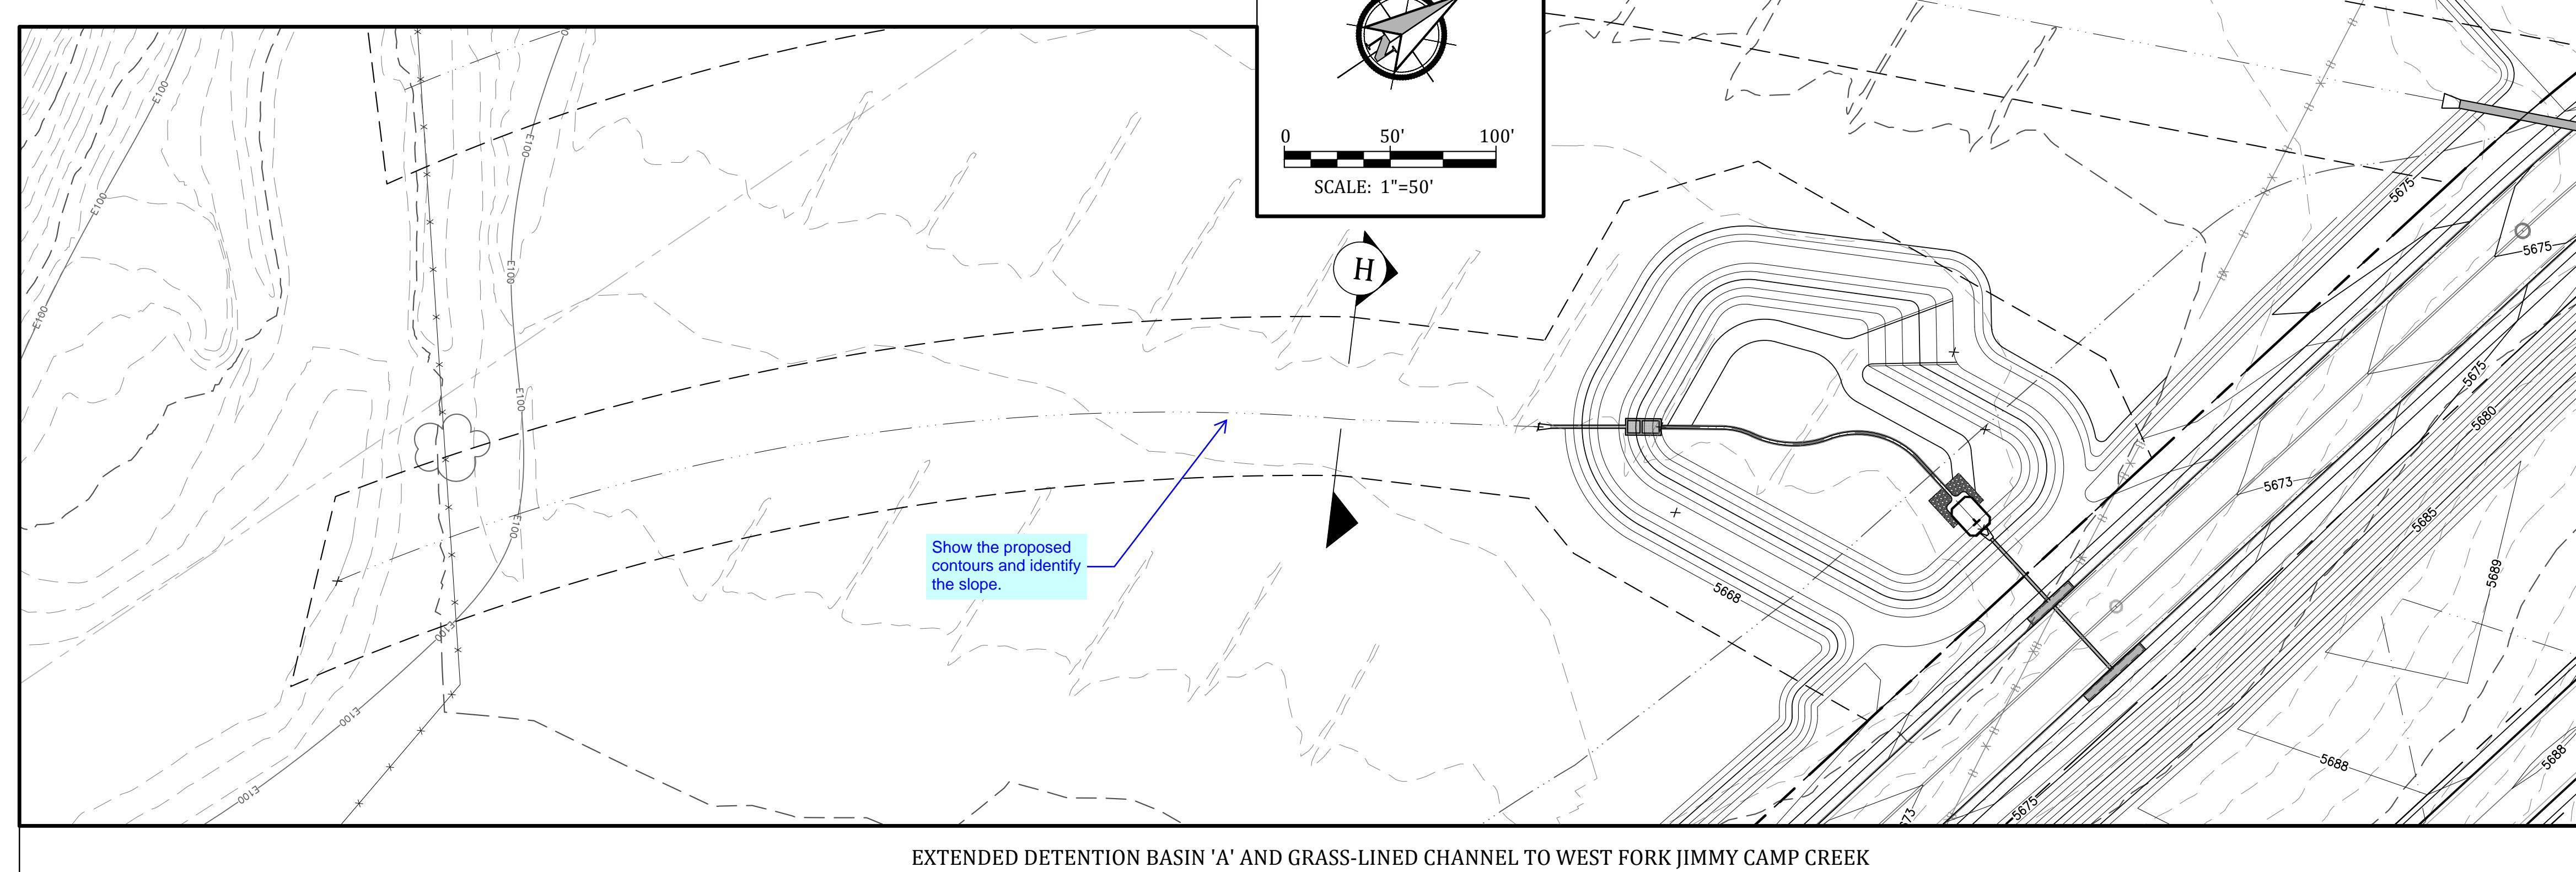

GLEN AT WIDEFIELD FILING NO. 9
SITE DETAIL PLAN
DETENTION BASIN DETAILS
EL PASO COUNTY, COLORADO

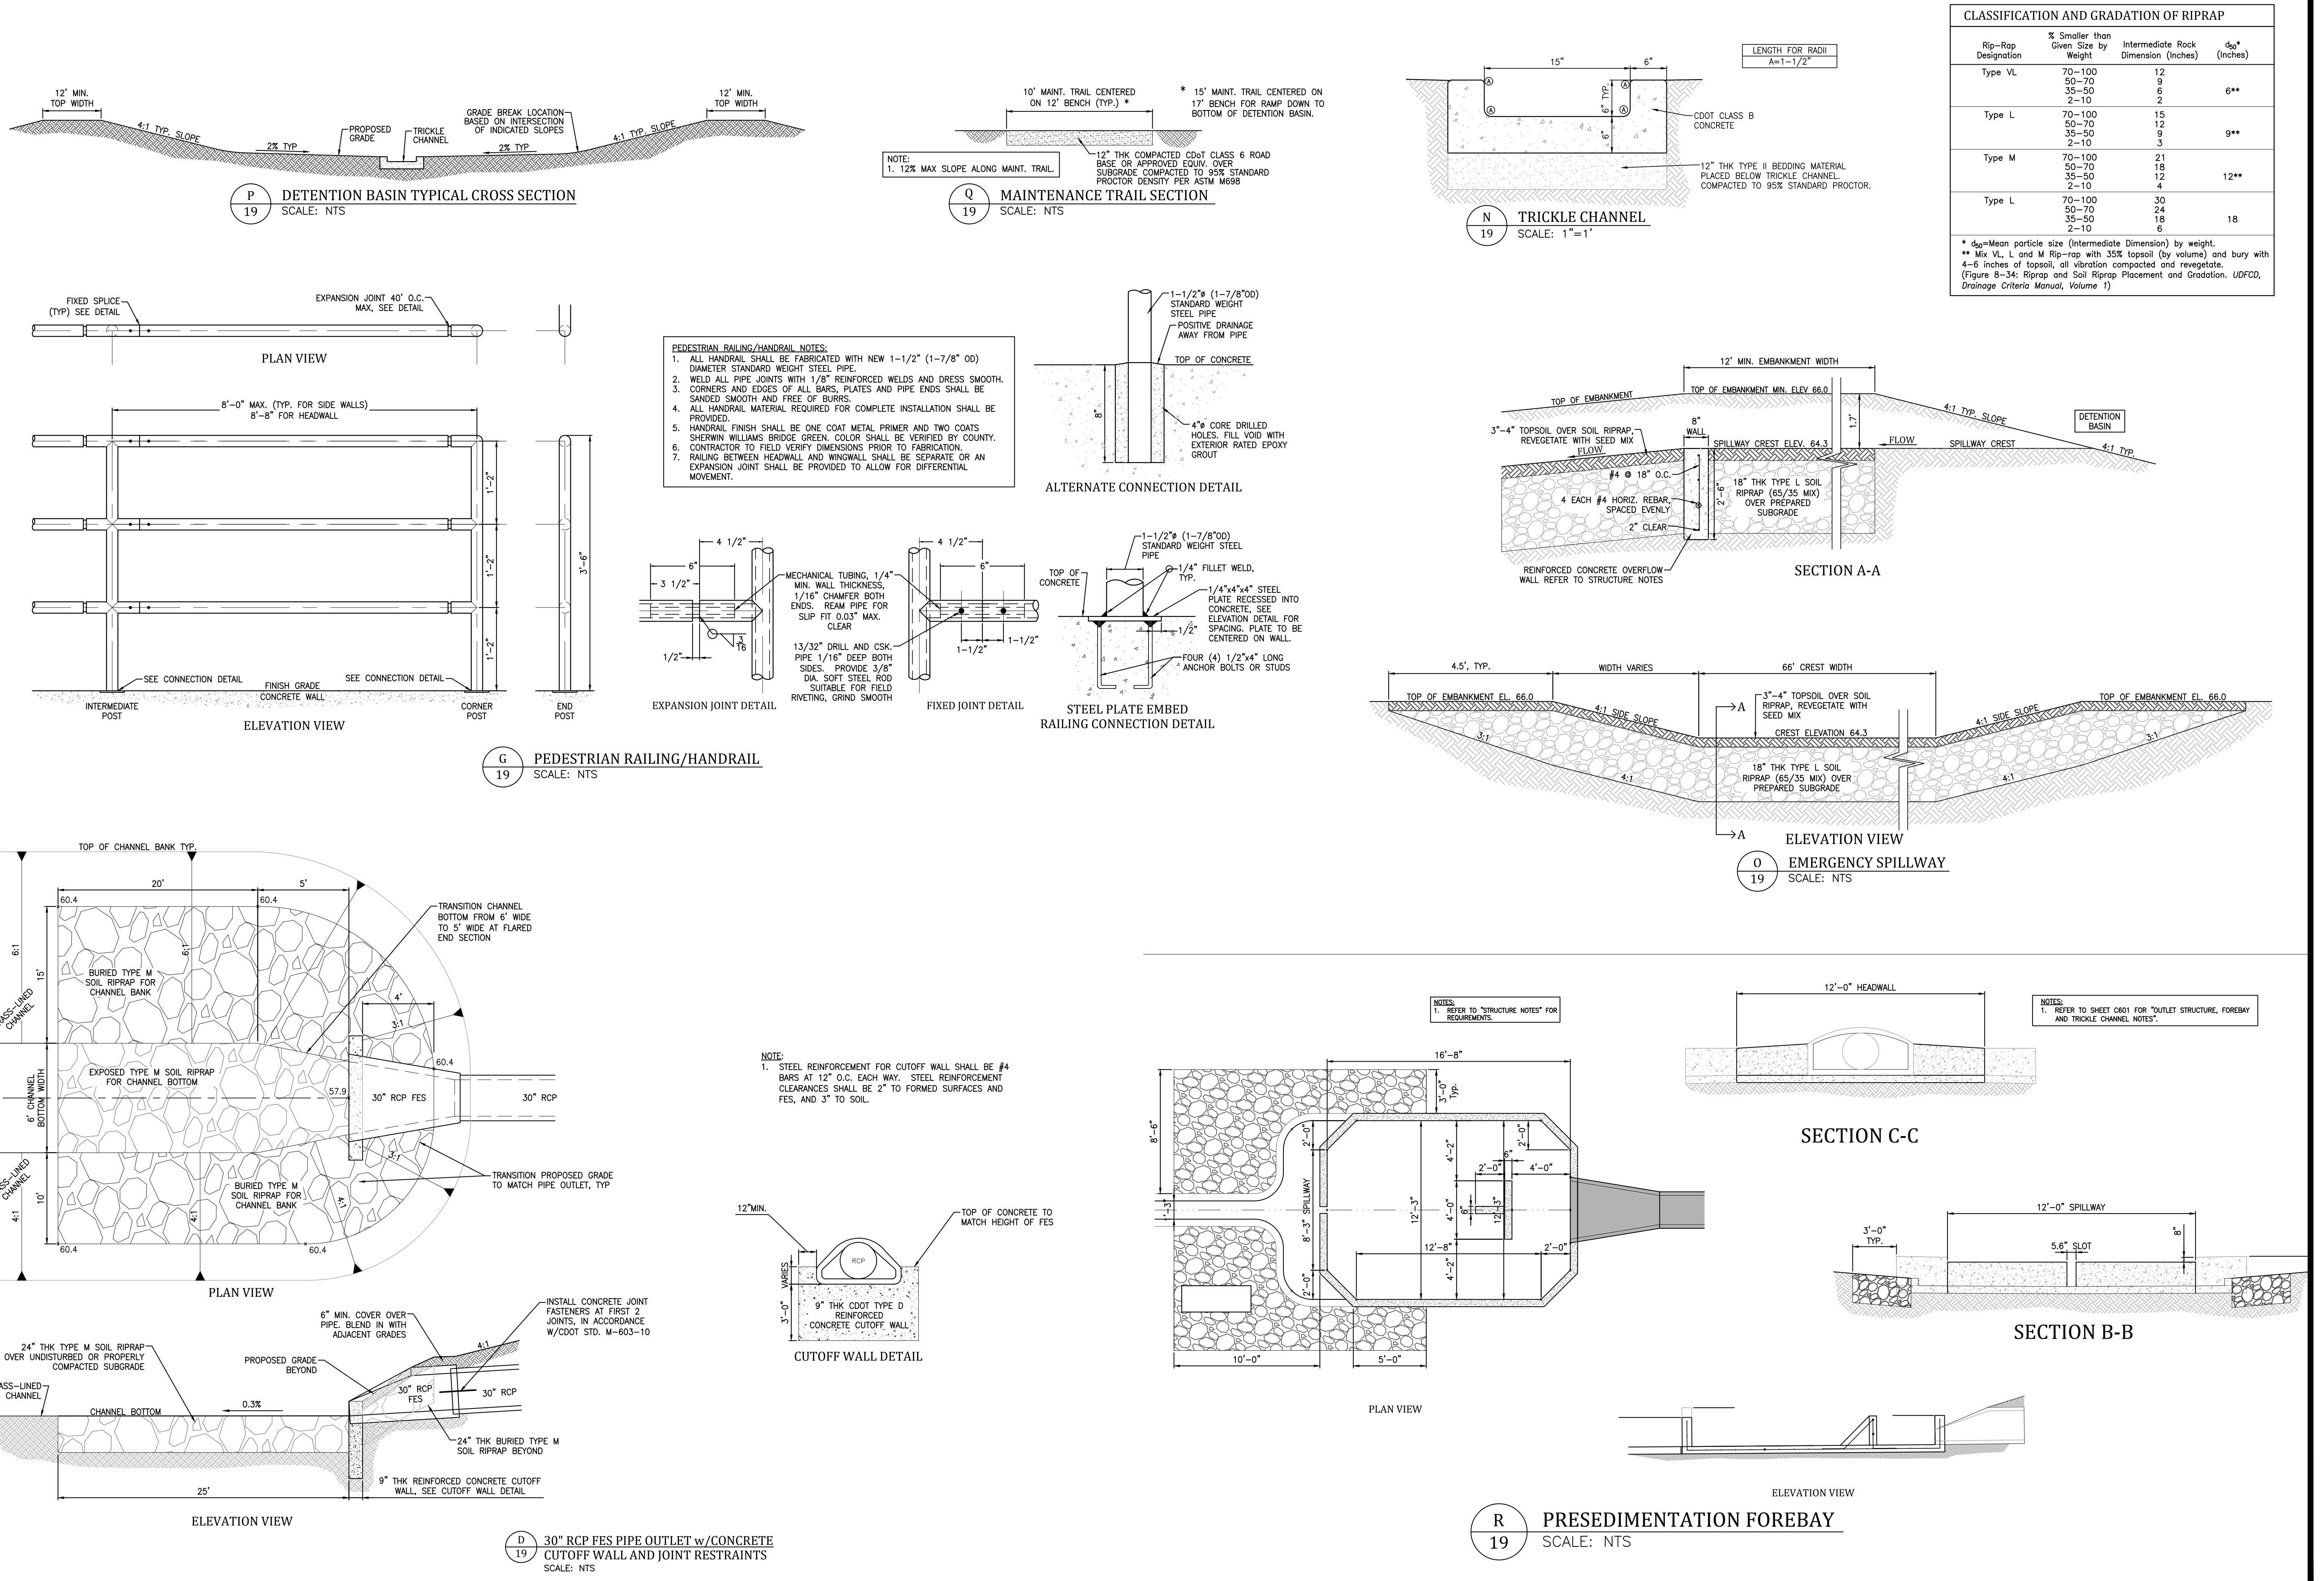

Project No.: 17038
Date: December 15, 2017
Design: JAK
Drawn: JAK
Check: AWMc
Revisions:

SHEET


18

18 of 20 Sheets

17038-GW9-17-18-DT.dwg/Dec 15, 2017

GLEN AT WIDEFIELD FILING NO. 9 SITE DETAIL PLAN EL PASO COUNTY, COLORADO

Project No.: 17038
Date: December 15, 2017
Design: AWMc
Drawn: JAK
Check: AWMc
Revisions:
SHEET

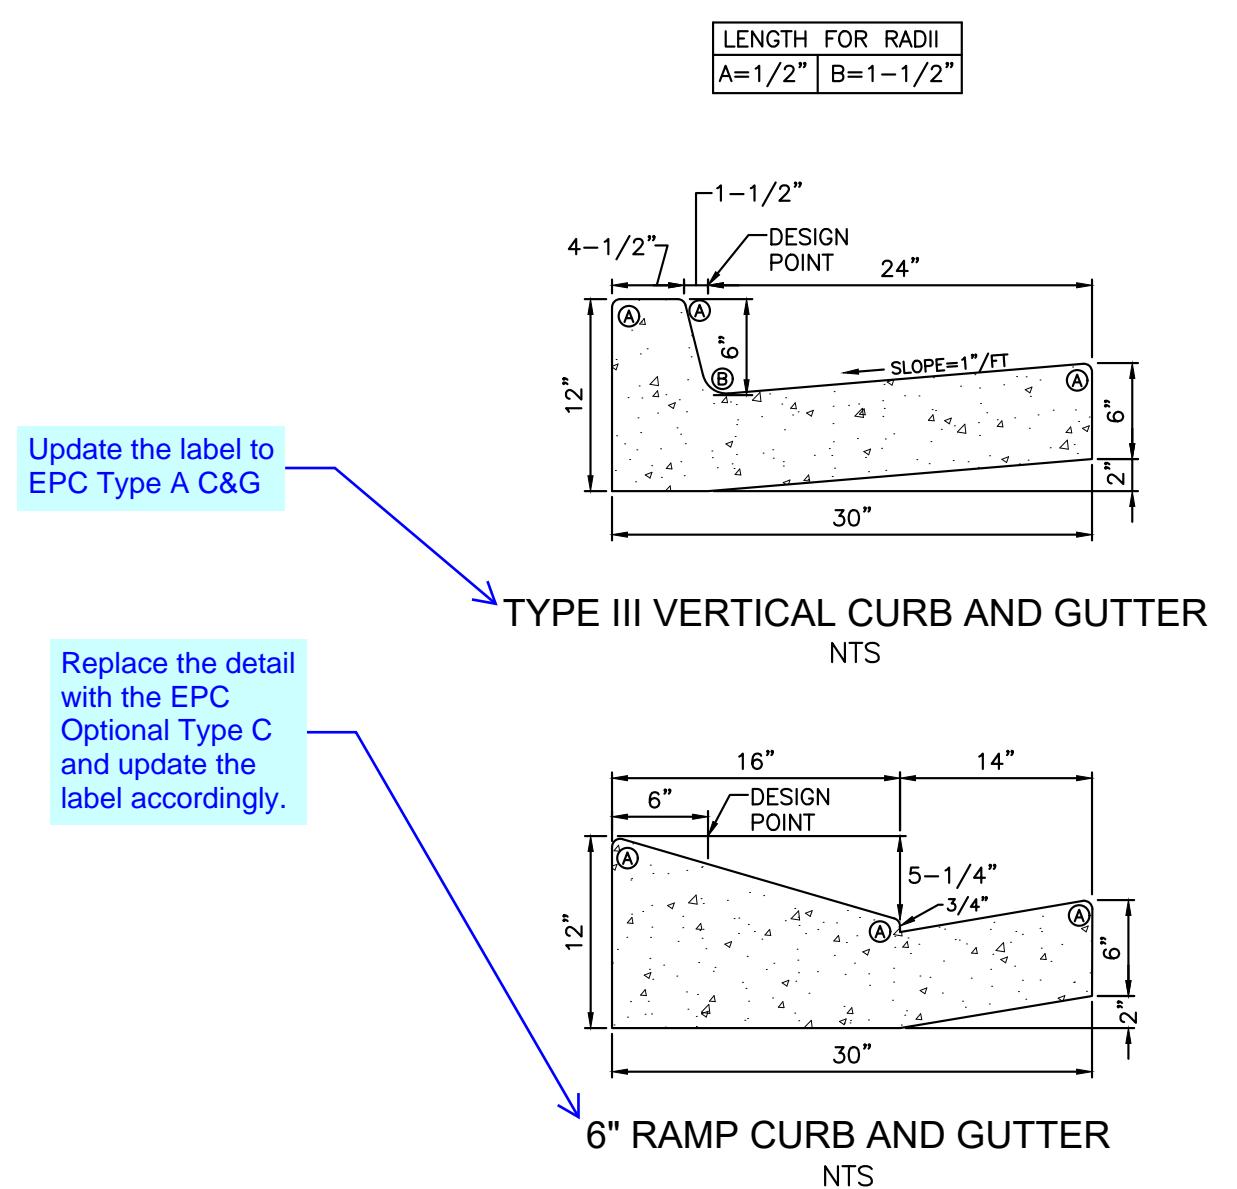


CURB & GUTTER DETAILS

EPC STD. SD_2-20
NOT TO SCALE

GENERAL NOTES

▲ EXPANSION JOINTS SHALL BE INSTALLED WHEN ABUTTING EXISTING CONCRETE OR FIXED STRUCTURE. EXPANSION JOINT MATERIAL SHALL BE 1/2" THICK AND SHALL EXTEND THE FULL DEPTH OF CONTACT SURFACE.

CONCRETE SHALL BE PER EL PASO COUNTY ENGINEERING DIVISION SPECIFICATIONS.

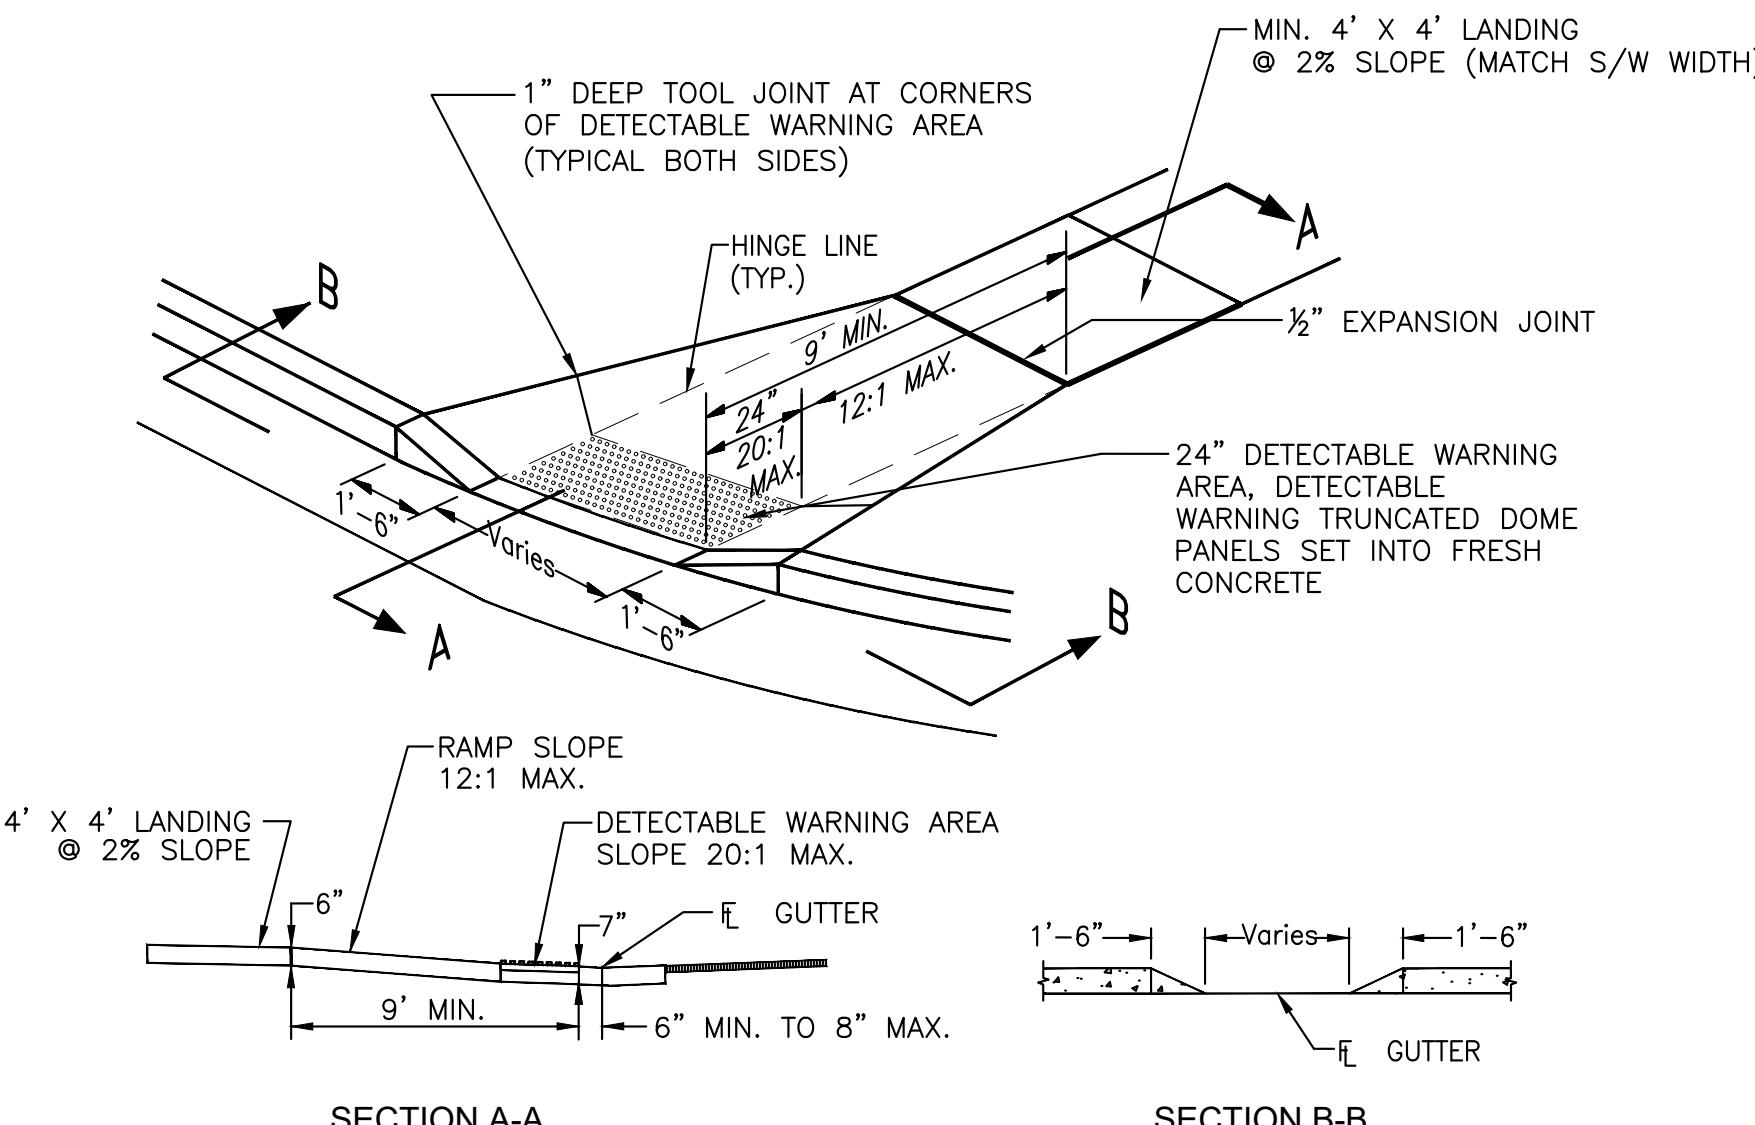


PEDESTRIAN RAMP DETAILS

EPC STD. SD_2-40
NOT TO SCALE

GENERAL NOTES

- All work shall be done in accordance with current Engineering Manual and ADA requirements.
- Contractor to notify Engineering Division inspection staff 48 hours prior to concrete placement.
- Pedestrian ramp construction shall be a minimum 3000 psi concrete, minimum 4" thick, non-colored, non-scored, coarse broom finish.
- Ramp location and length may require modification to maintain the 12:1 maximum running ramp slope and 20:1 detectable warning area due to street intersection grades and / or alignment.
- Detectable warning area shall start a minimum of 6" but not more than 8" from the flow line of the curb at any point.
- Detectable warning area shall be prefabricated reddish integrally colored truncated-dome surfaced thermoplastic.
- The detectable warning area shall be 24" in length and the full width of the ramp.
- Ramp width required is the same as approaching sidewalk, 4" minimum.
- all ramps will be perpendicular to traffic with the exception of mid-block or terminal ramps which may be parallel subject to approval.
- Avoid placing drainage structures, traffic signal / signage, utilities / junction boxes, or other obstructions within proposed ramp areas.
- Where 1'-6" flared side(s) of a perpendicular curb ramp is (are) contiguous with a pedestrian or hard surface area, the flare width shall be increased to 8" minimum and the maximum flare slope shall not exceed 10:1.
- Pedestrian walkway and / or location of existing or future pedestrian ramps on opposite corners shall be reviewed before construction new ramps. New ramps shall align with existing ramps and pedestrian walkway.
- At marked pedestrian crossings, the bottom of the ramps, exclusive of the flare sides, shall be totally contained within the markings.
- Sidewalk cross-slope: 1/4".
- Concrete mix design shall conform to the requirements of the color admixture manufacturer and the following:
 - 28-day compressive strength = 4,000 PSI (min.)
 - Water/cement ratio = 0.45 (max.)
 - Cement content = 6-1/2 sacks/C.Y. (min.) (Type II cement)
 - Maximum aggregate size = 3/4"
- Entrained air content = 6% - 10%
- Slump = 1 inch (min.) - 4 inches (max.)

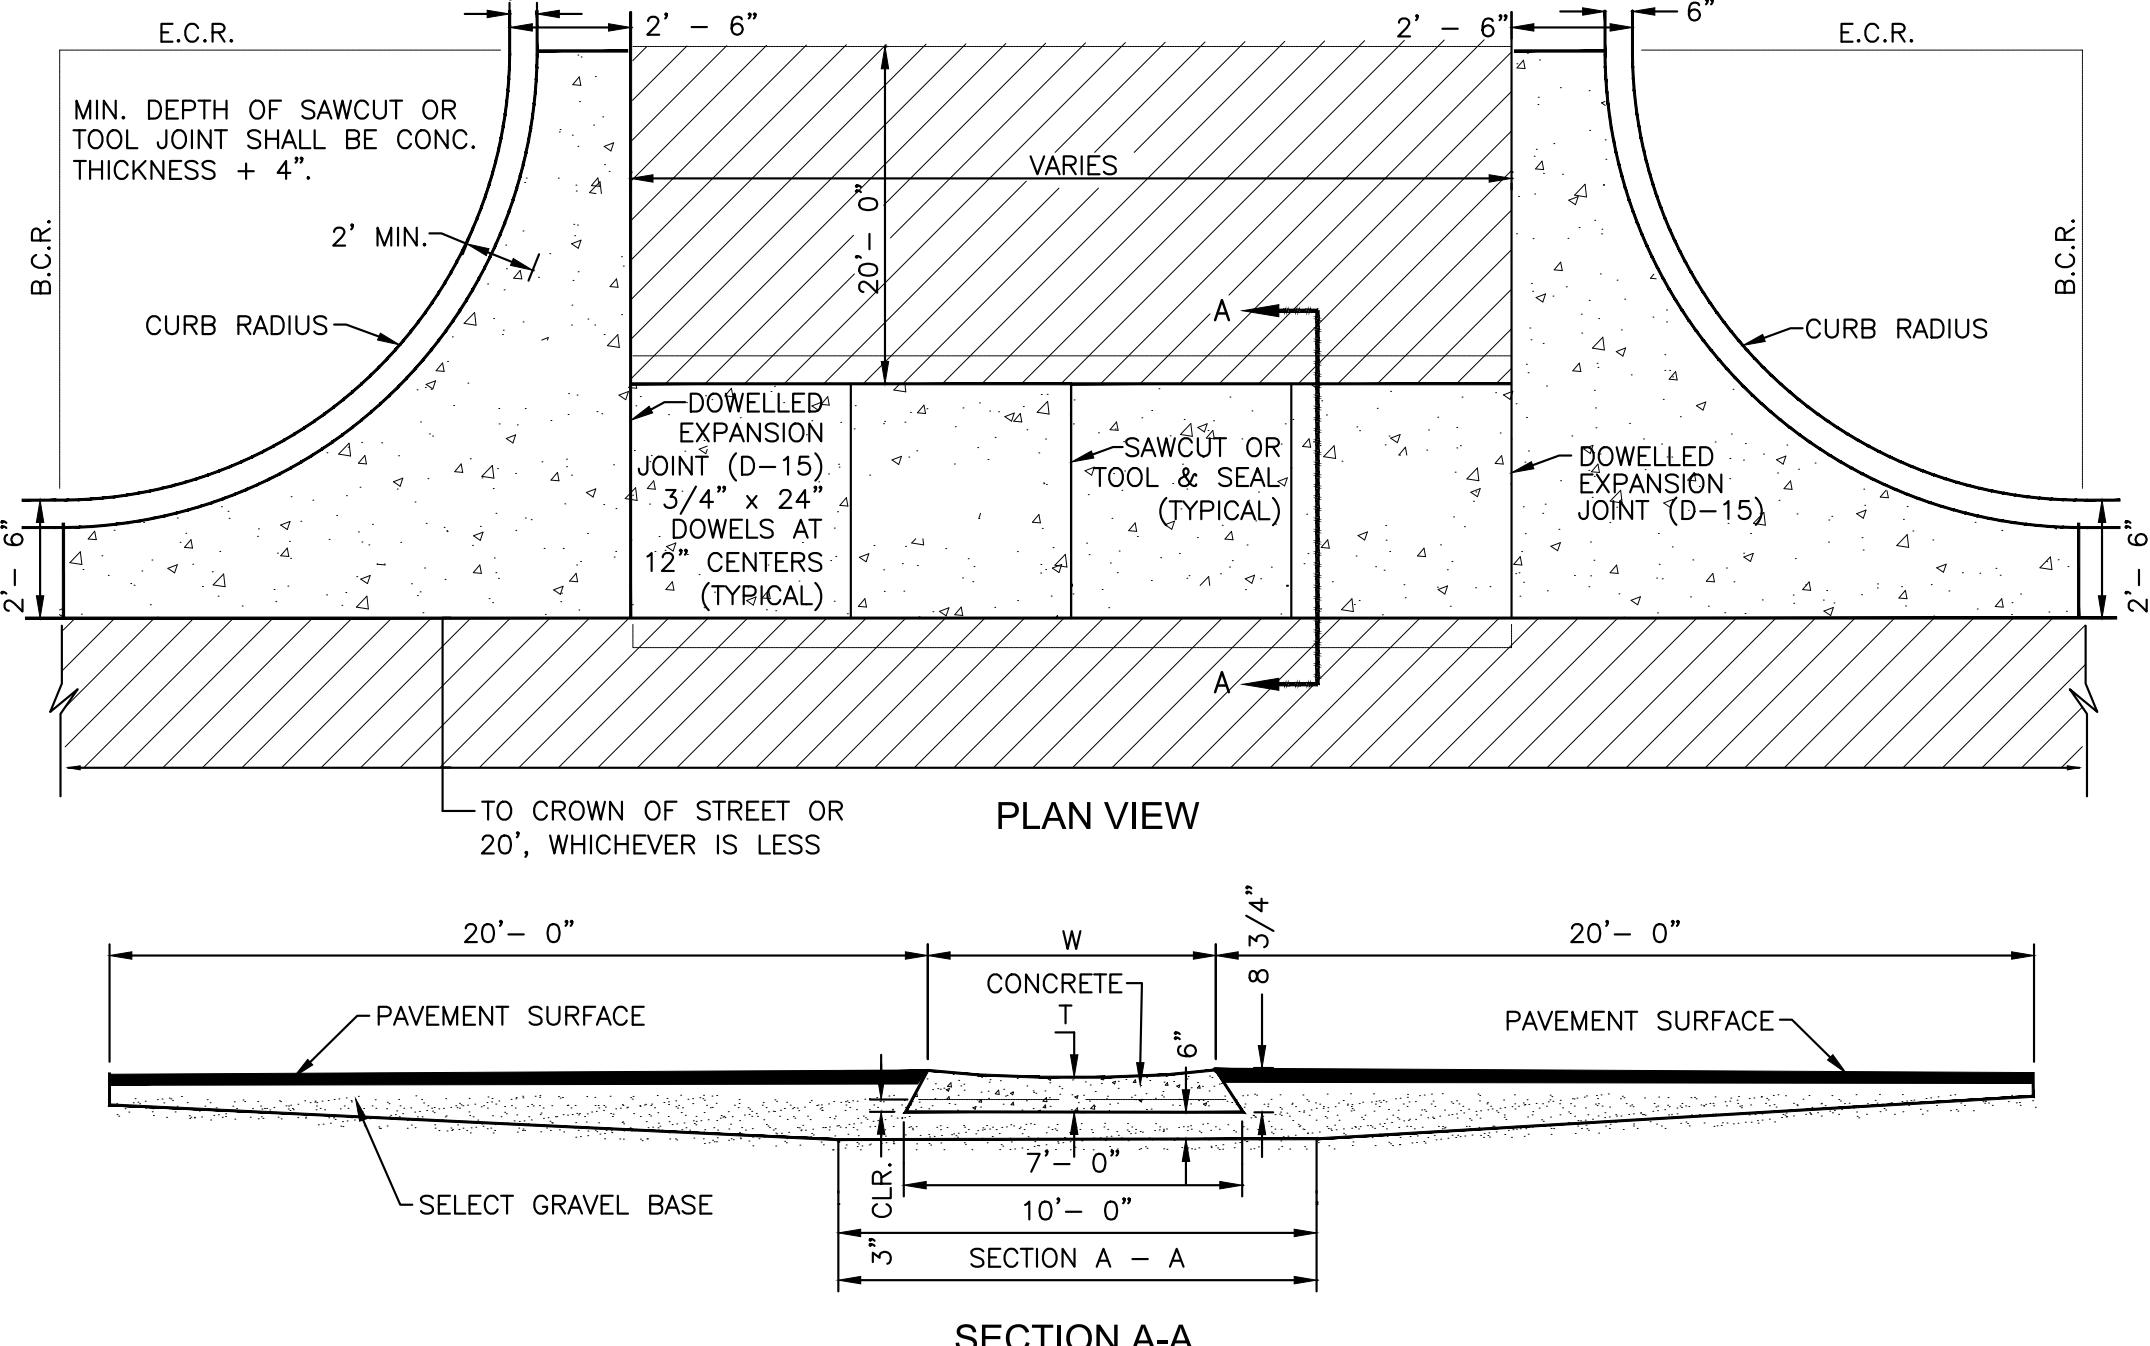


CROSS PAN DETAIL

EPC STD. SD_2-26
NOT TO SCALE

NOTES


- PROVIDE CENTERLINE CONSTRUCTION OR TOOL JOINT WHEN DRIVEWAY WIDTH (EDGE TO EDGE) IS 14' OR GREATER.
- ALL TOOL JOINTS SHALL BE A MINIMUM OF 1-1/2" DEEP.
- WHEN REPLACING EXISTING CURB AND GUTTER WITH NEW DRIVEWAY, ENTIRE CURB AND GUTTER SECTION SHALL BE REMOVED AND REPLACED WITH CURB AND GUTTER (VARIABLE-CURB-HEIGHT) AS SHOWN. DO NOT BREAK CURB FROM GUTTER SECTION.
- FLARED PORTION OF DRIVEWAY SHALL BE POURED MONOLITHIC WITH MAIN RECTANGULAR PORTION OF DRIVEWAY.
- WHERE THERE IS MORE THAN ONE DRIVEWAY ON A LOT, THE SPACING OF THE DRIVEWAYS SHALL MEET REQUIREMENTS IN ECM.

TOOL JOINT SPACING	DRIVEWAY WIDTH	A	B
	12'	6'	3'
	14'	7'	3'-6"
	16'	8'	4'
	18'	9'	4'-6"
	20'	10'	5'
	22'	11'	5'-5"
	24'	8'	4'-4"
	26'	8'-0"	4'-4"
	28'	9'-4"	4'-4"
	30'	10'-0"	5'

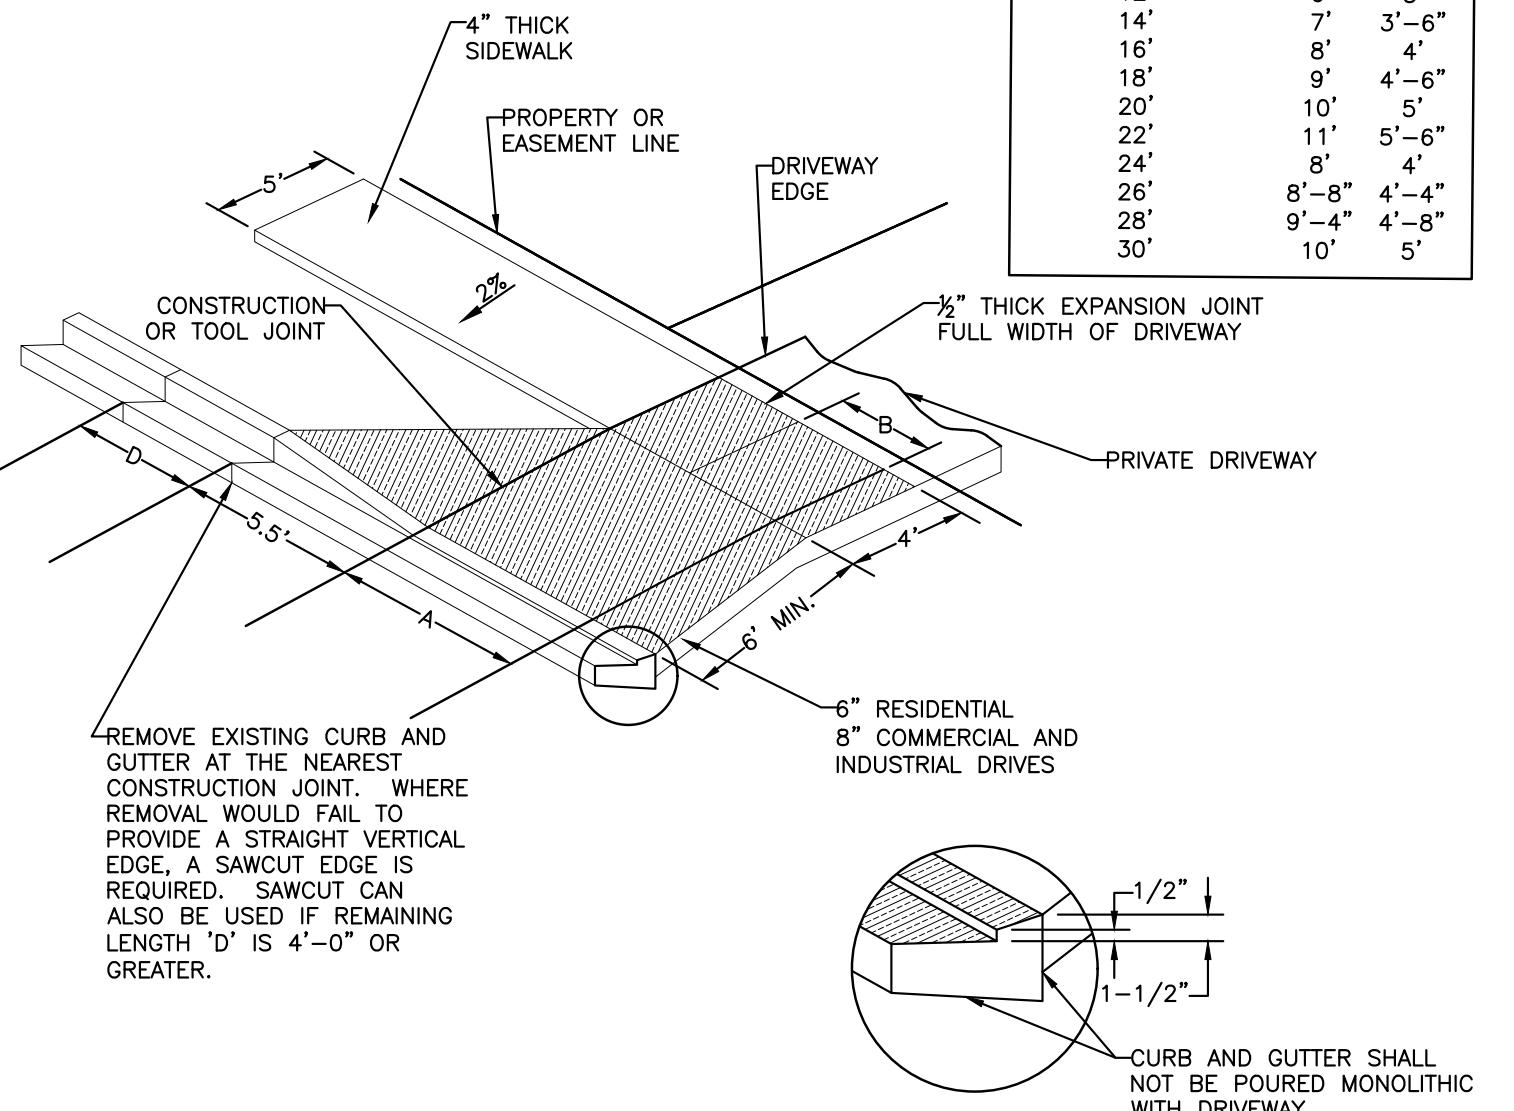


DRIVEWAY DETAIL WITH DETACHED SIDEWALK

EPC STD. SD_2-25
NOT TO SCALE

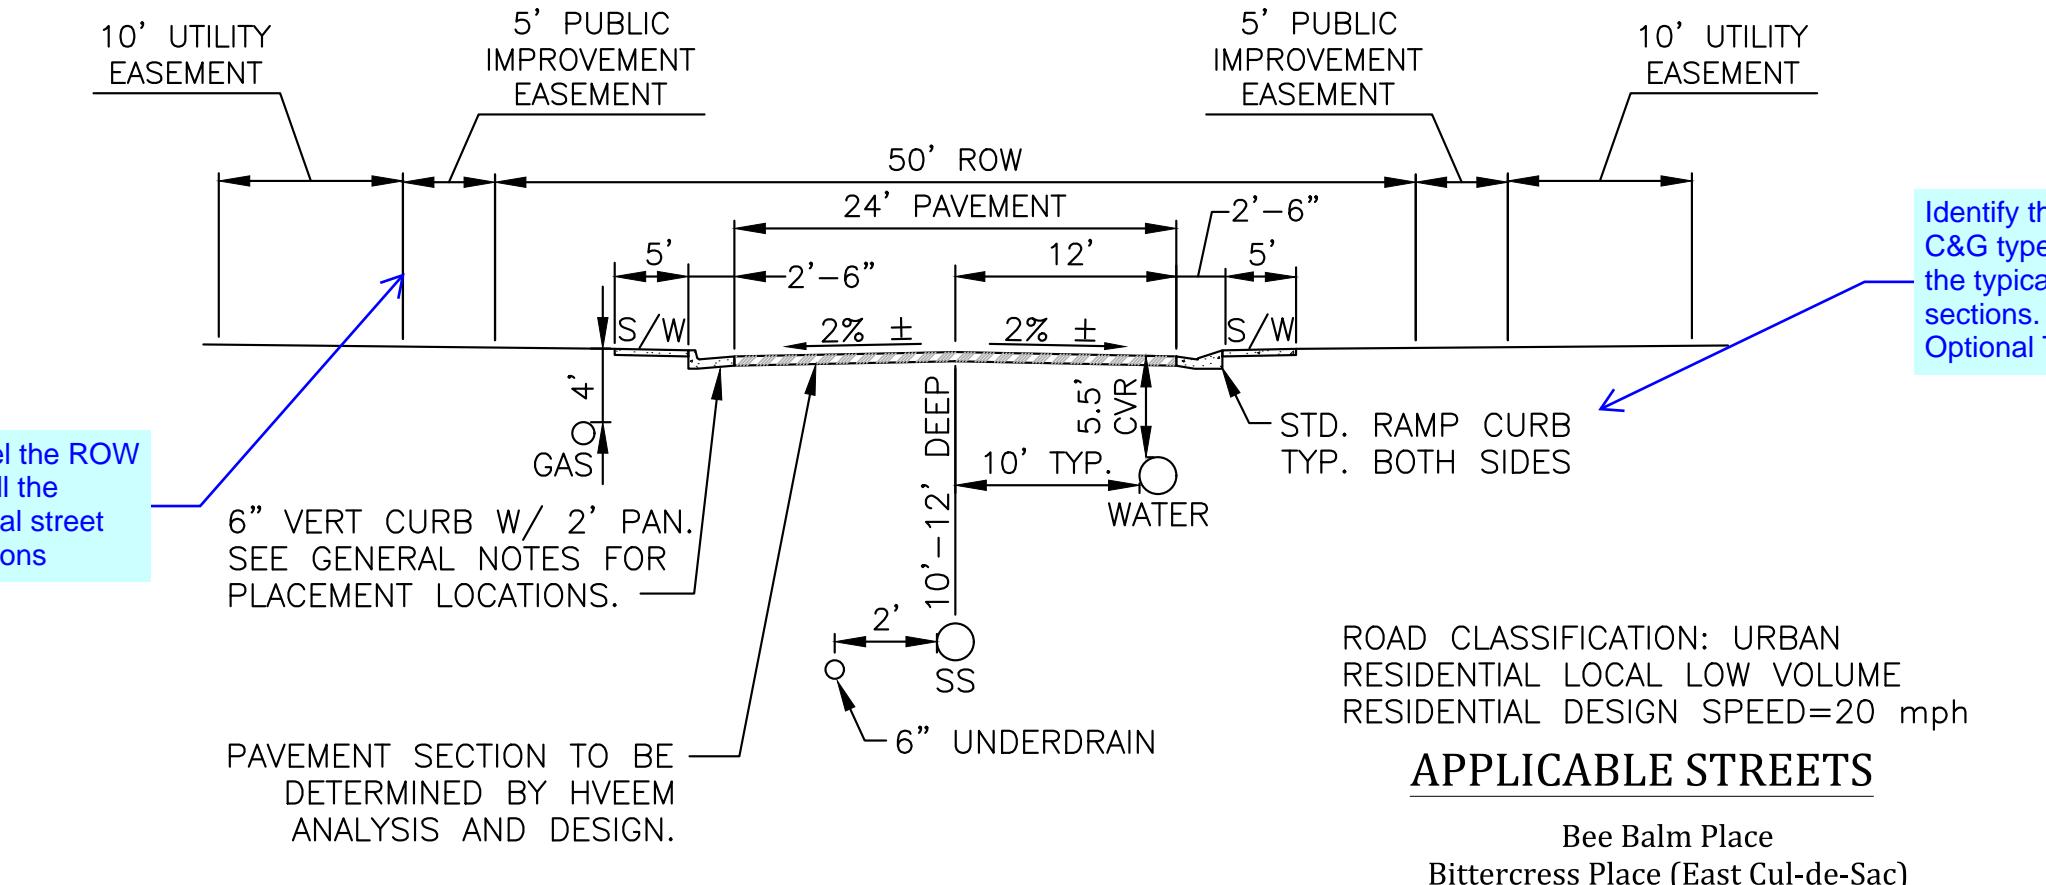


TYPICAL STREET SECTION GLEN AT WIDEFIELD FILING NO. 9

NOT TO SCALE

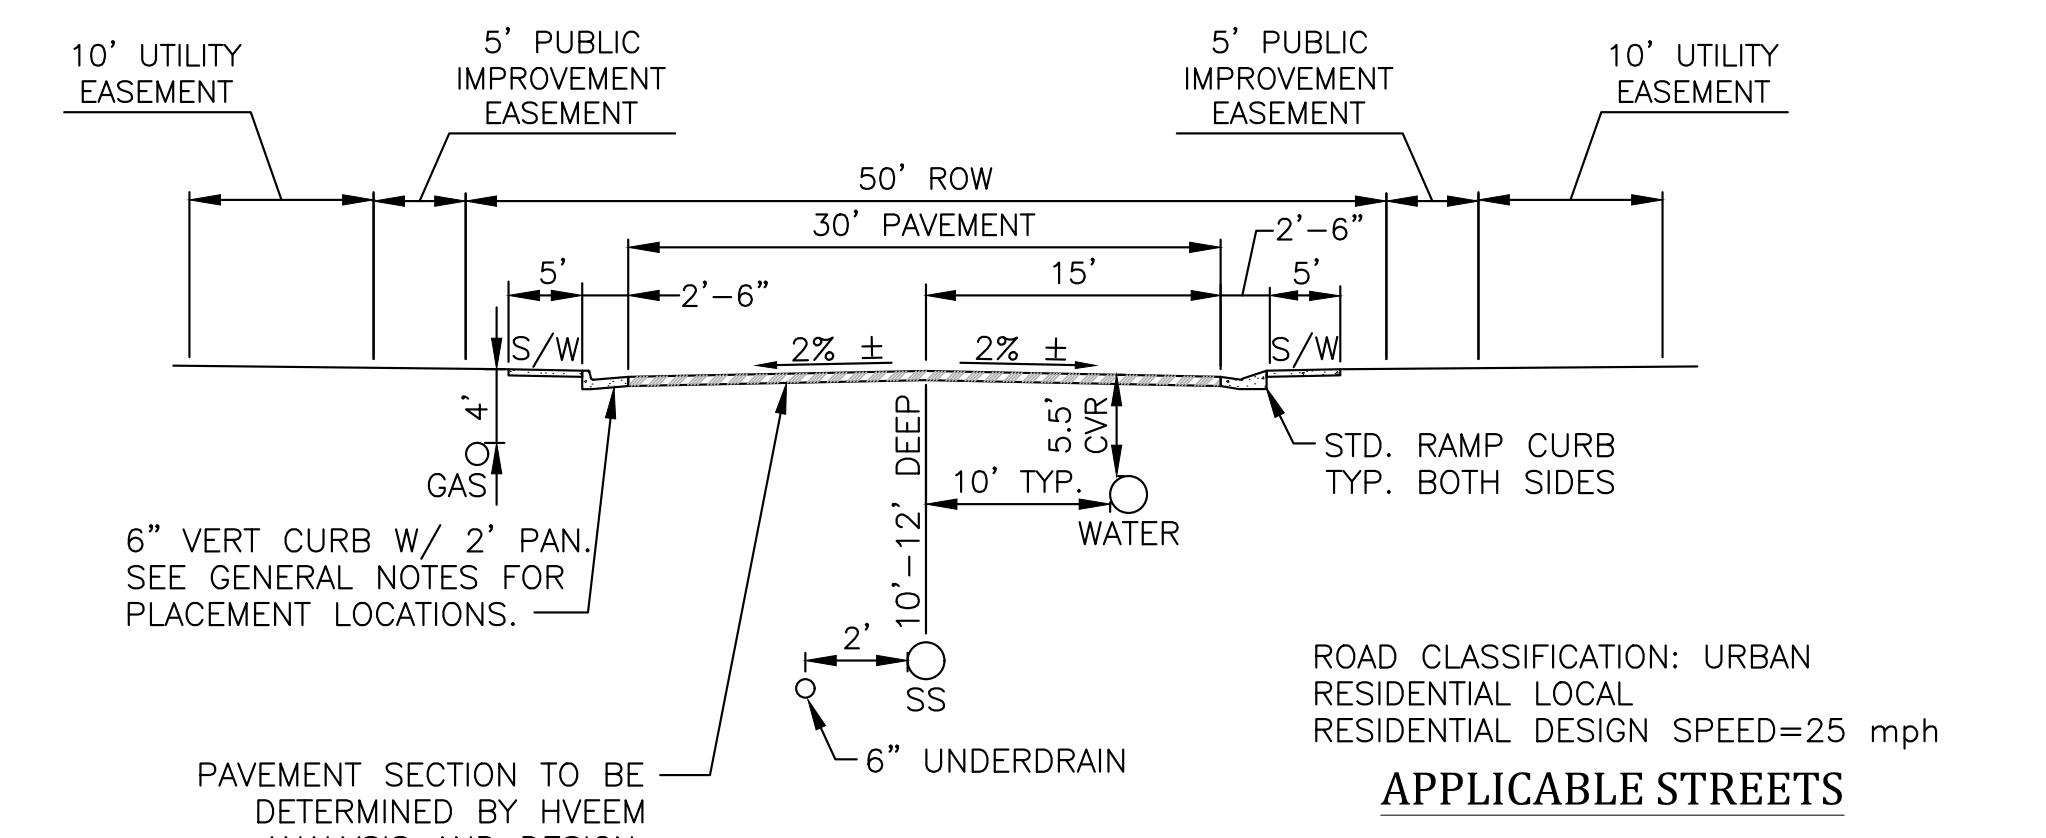

TYPICAL STREET SECTION GLEN AT WIDEFIELD FILING NO. 9

NOT TO SCALE

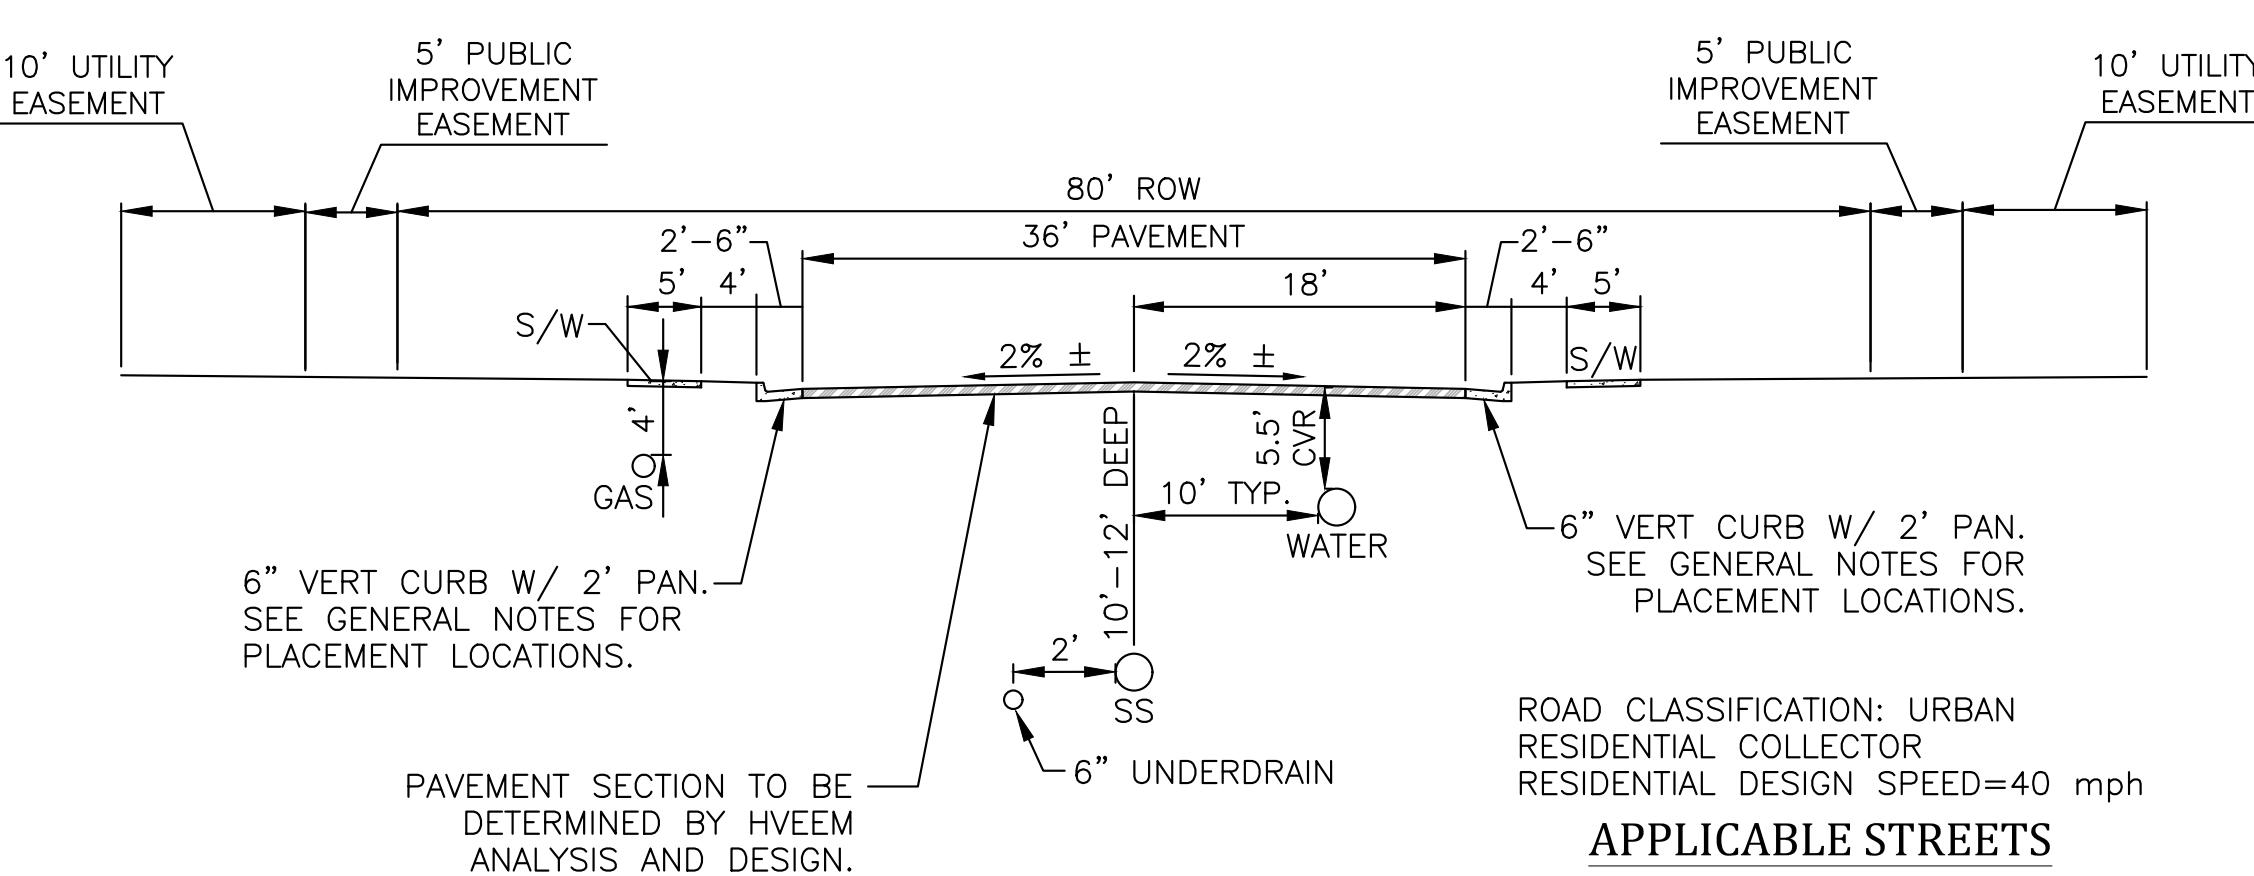


TYPICAL STREET SECTION GLEN AT WIDEFIELD FILING NO. 9

NOT TO SCALE


UNDERDRAIN NOTES

1. UNDERDRAIN TO BE CONSTRUCTED WHERE INDICATED BY A DASHED LINE (—).
2. SOLID DRAIN PIPE WILL BE USED IN AREAS AS SHOWN ON THE PLANS AND AS DIRECTED BY THE GEOTECHNICAL ENGINEER.
3. ALL UNDERDRAIN CONSTRUCTION SHALL CONFORM WITH THE LATEST CITY OF COLORADO SPRINGS STANDARDS.
4. ENGINEERING FABRIC TO HAVE A MINIMUM 12-INCH OVERLAP ABOVE UNDERDRAIN GRANULAR FILL.
5. UNDERDRAIN PIPE TO BE CONSTRUCTED WITH THE TOP OF PIPE EQUAL TO OR BELOW THE BOTTOM OF THE SANITARY SEWER PIPE.
6. GEOTECHNICAL ENGINEER TO DETERMINE EXTENT OF ACTIVE/PASSIVE UNDERDRAIN DEPENDING UPON CONDITIONS ENCOUNTERED DURING CONSTRUCTION.
7. THE OBJECTIVE OF THE ACTIVE AND PASSIVE PORTIONS OF THE UNDERDRAIN SYSTEM IS TO BE CONSTRUCTED WITH A NON-PERMEABLE BARRIER SO THAT ALL COLLECTED GROUNDWATER IS DIRECTED INTO THE PASSIVE PIPE SECTION.

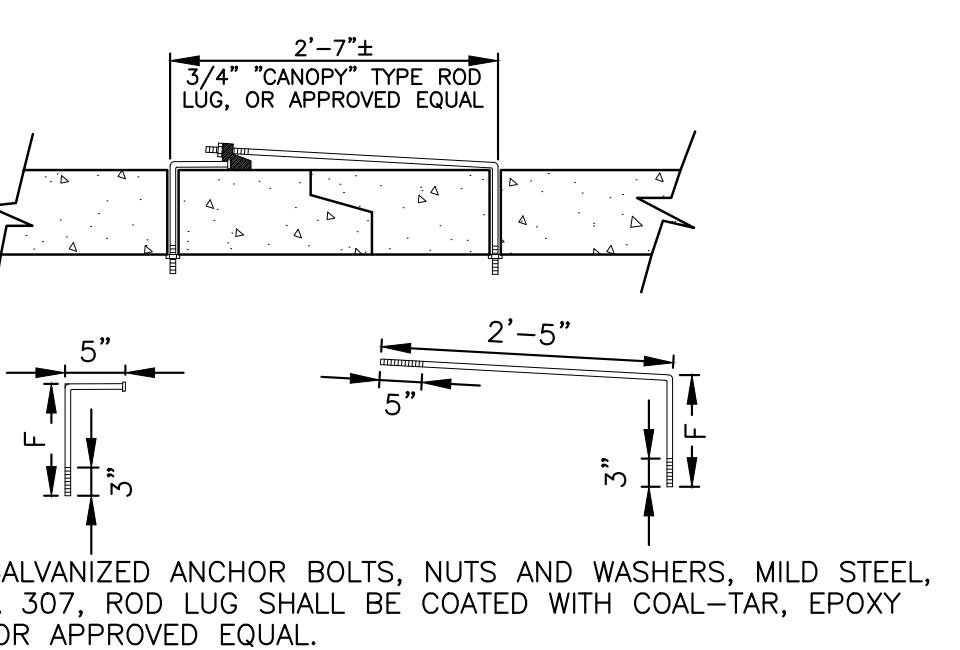


NOTE:
CONCRETE JOINT FASTENERS REQUIRED
ON THE FIRST TWO PIPE JOINTS FROM
A FLARED END SECTION.

PIPE DIAMETER	F
18"-30"	5"
36"-42"	6"
48"-60"	7"
72"-84"	9"

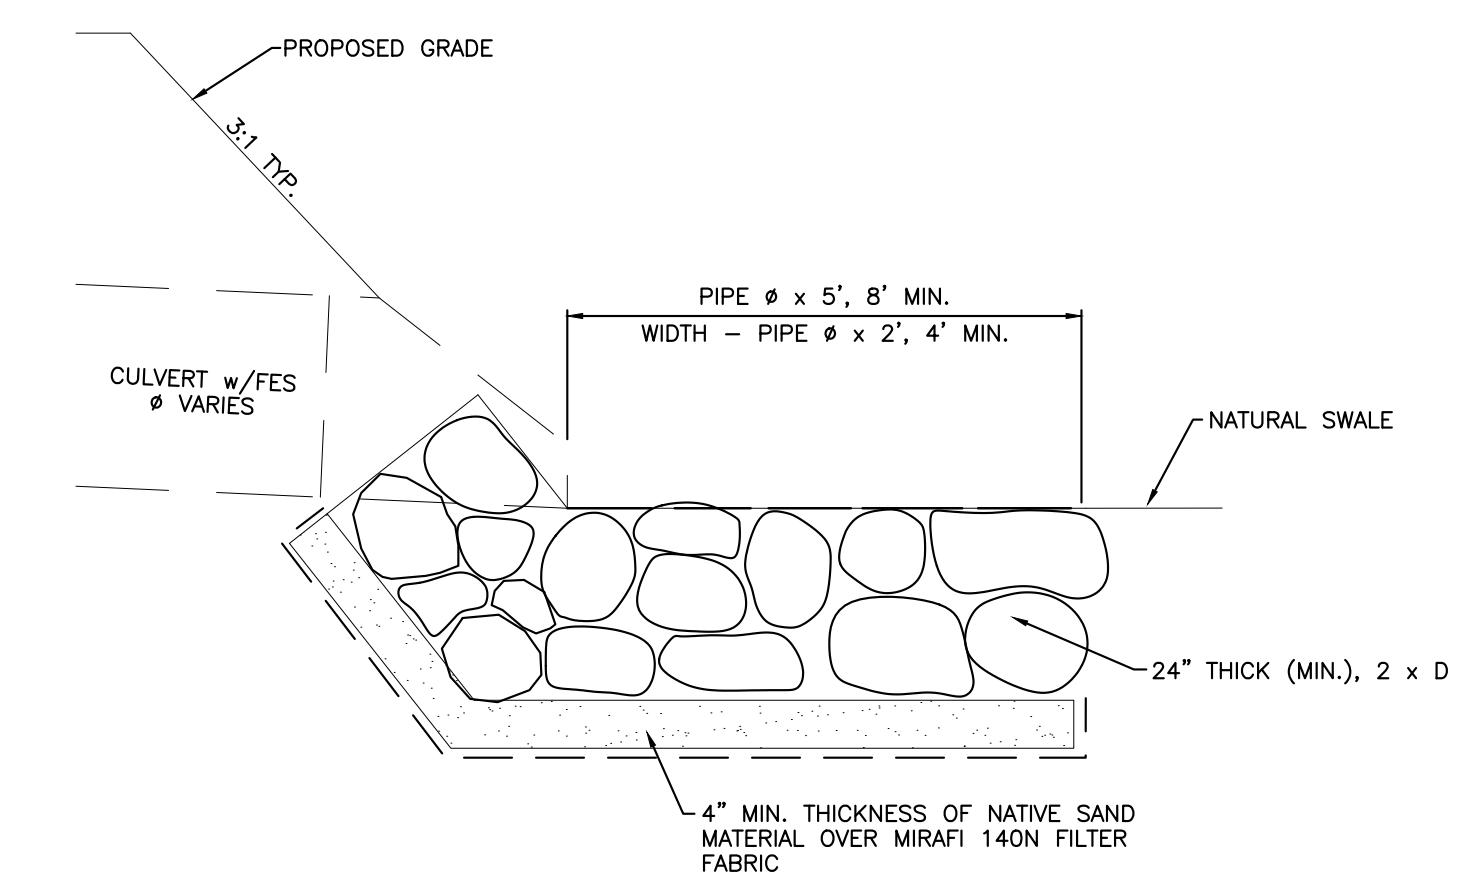


TYPICAL CULVERT OUTLET PROTECTION
NOT TO SCALE

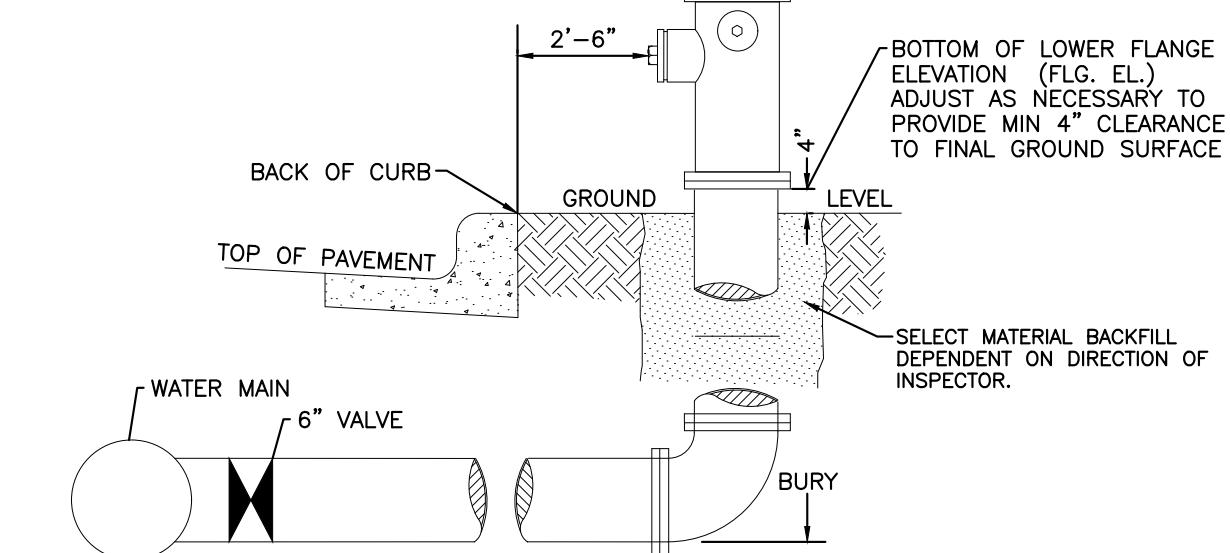


- GENERAL NOTES:**
1. Hydrant nozzles shall be positioned at right angles to curb. If no curb or sidewalk exists, nozzles shall be placed at right angle to street or alley.
 2. Hydrants shall be placed a minimum of 5.0 feet from any utility or drainage structure.
 3. Any hydrant being installed with conditions other than those mentioned and/or design below will require signed approval from the Widefield Water District and Sanitary Fire District.
 4. See Site Utility Plan for hydrant locations and flange elevations.
 5. The upper exposed section of the hydrant above ground shall be painted rustoleum 659 yellow or equal. The buried portion of the hydrant shall be given a bituminous coating in accordance with Section 10-B.1 of AWWA Standard C110.

FIRE HYDRANT DETAIL
NOT TO SCALE

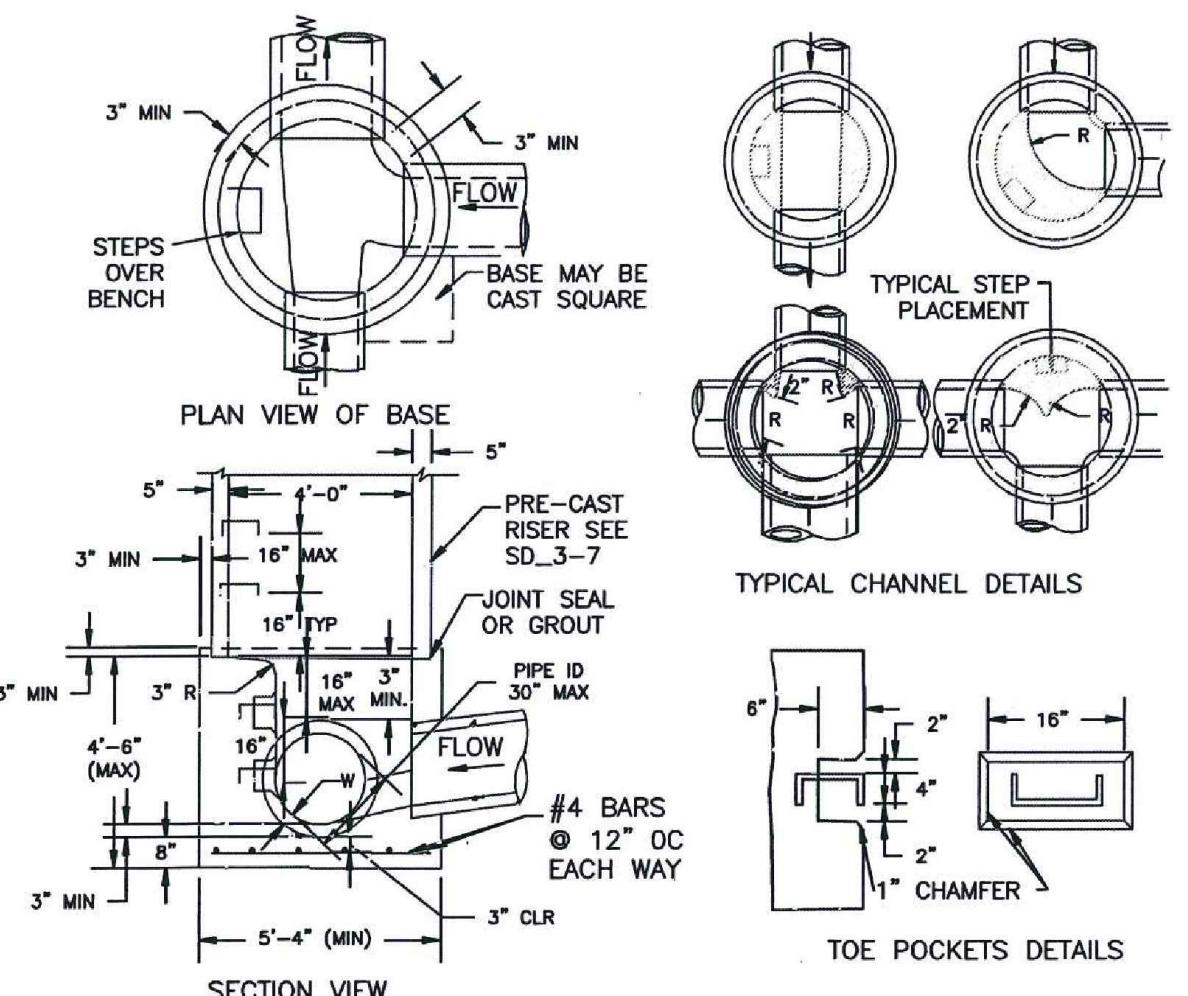


1. TYPE II MANHOLES SHALL BE USED WHEN APPROPRIATE AND TYPICALLY WHEN THE PIPE SIZES ARE 30" OR LESS INSIDE DIAMETER.
2. VIEW AND DETAILS ARE TYPICAL DESIGN. ENGINEER SHALL DETERMINE MANHOLE BASE CONFIGURATION AND DIMENSIONS FOR PARTICULAR PIPE SIZES AND ALIGNMENT.
3. EITHER LADDER OR STEPS SHALL BE INSTALLED WHEN MANHOLE DEPTH EXCEEDS 30". STEPS IN BASE SHALL BE INSTALLED IN "TOE POCKETS" (SEE DETAIL THIS SHEET). LOWEST STEP SHALL BE A MAXIMUM OF 16" ABOVE THE FLOOR.
4. PIPES SHALL BE TRIMMED TO FINAL SHAPE AND SET BEFORE MANHOLE IS Poured.
5. BENCH SHALL BE SLOPED TOWARD CENTER OF MANHOLE BASE (4:1 MAX., 1/2" PER FOOT, MIN.).
6. FLOOR OF MANHOLE SHALL BE TROWELLED TO A SMOOTH, HARD SURFACE AND SHALL SLOPE TOWARDS THE OUTLET (8:1, 1/2" PER FT. MIN.). FLOOR SHALL BE SHAPED AND CHANNELLED; SEE DETAILS THIS SHEET.

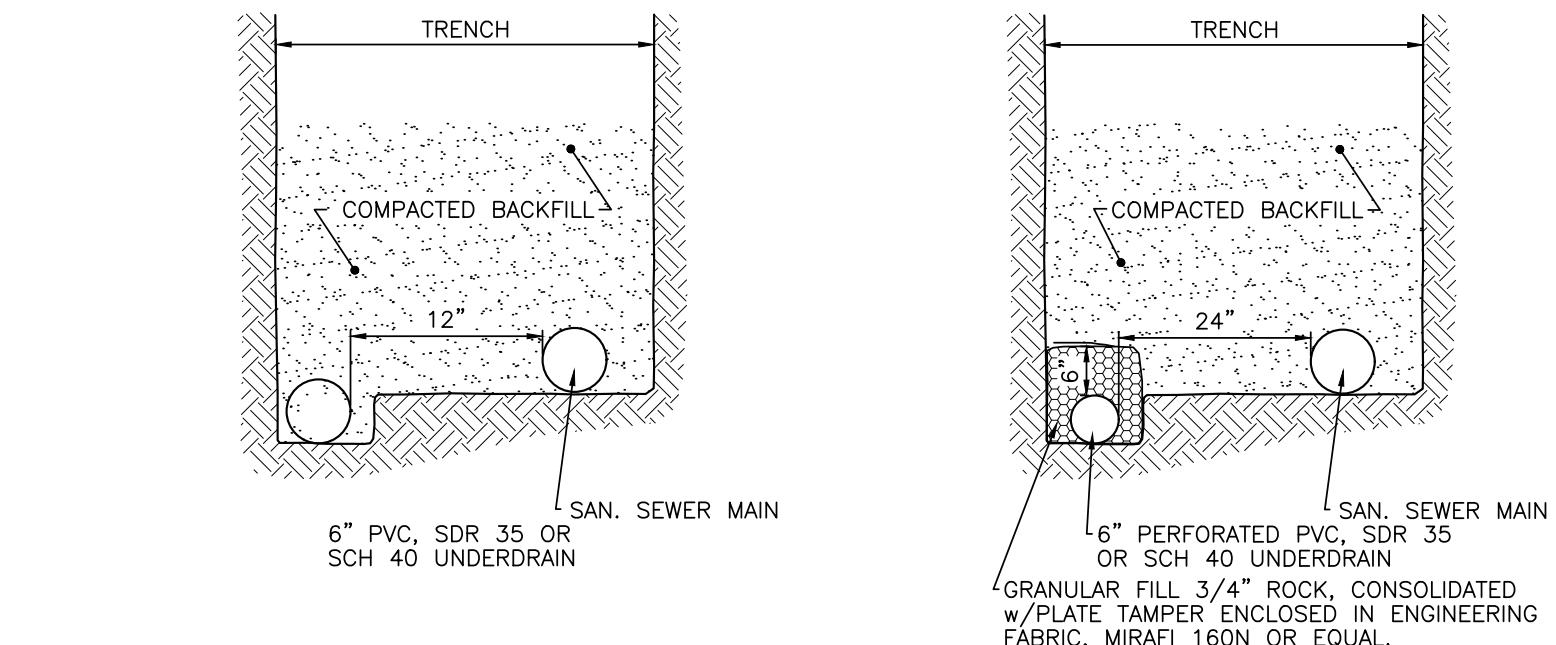


CONCRETE PIPE JOINT FASTENER DETAIL

NOT TO SCALE

LOCATION	B	W	Y
NORTH RUNDOWN	1'	7"	1'
SOUTH RUNDOWN	1'	7"	1'

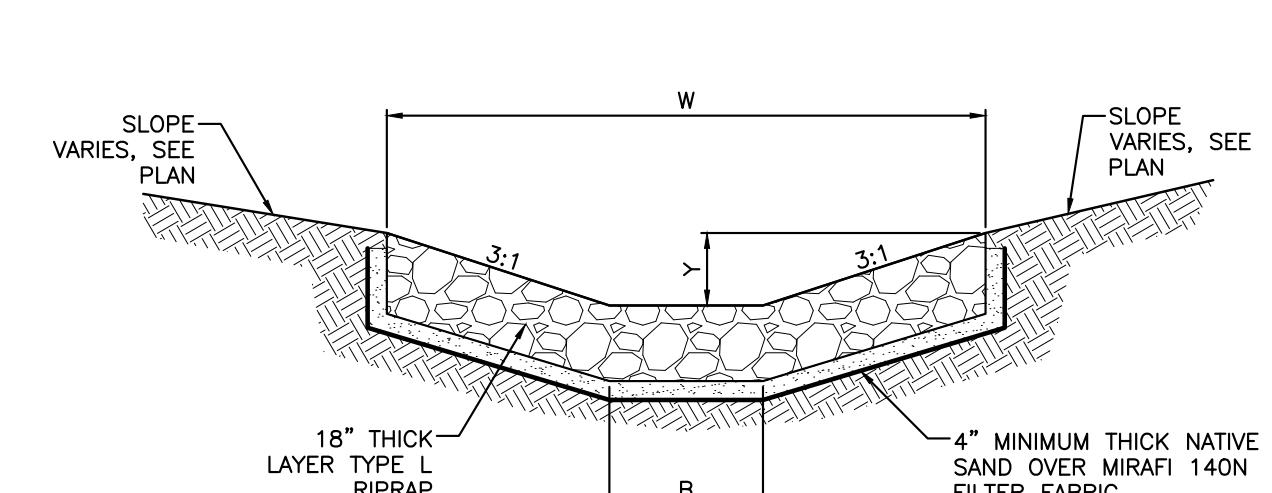


RIPRAP RUNDOWN DETAIL - PEACEFUL VALLEY ROAD AT MARKSHEFFEL ROAD
SCALE: NTS

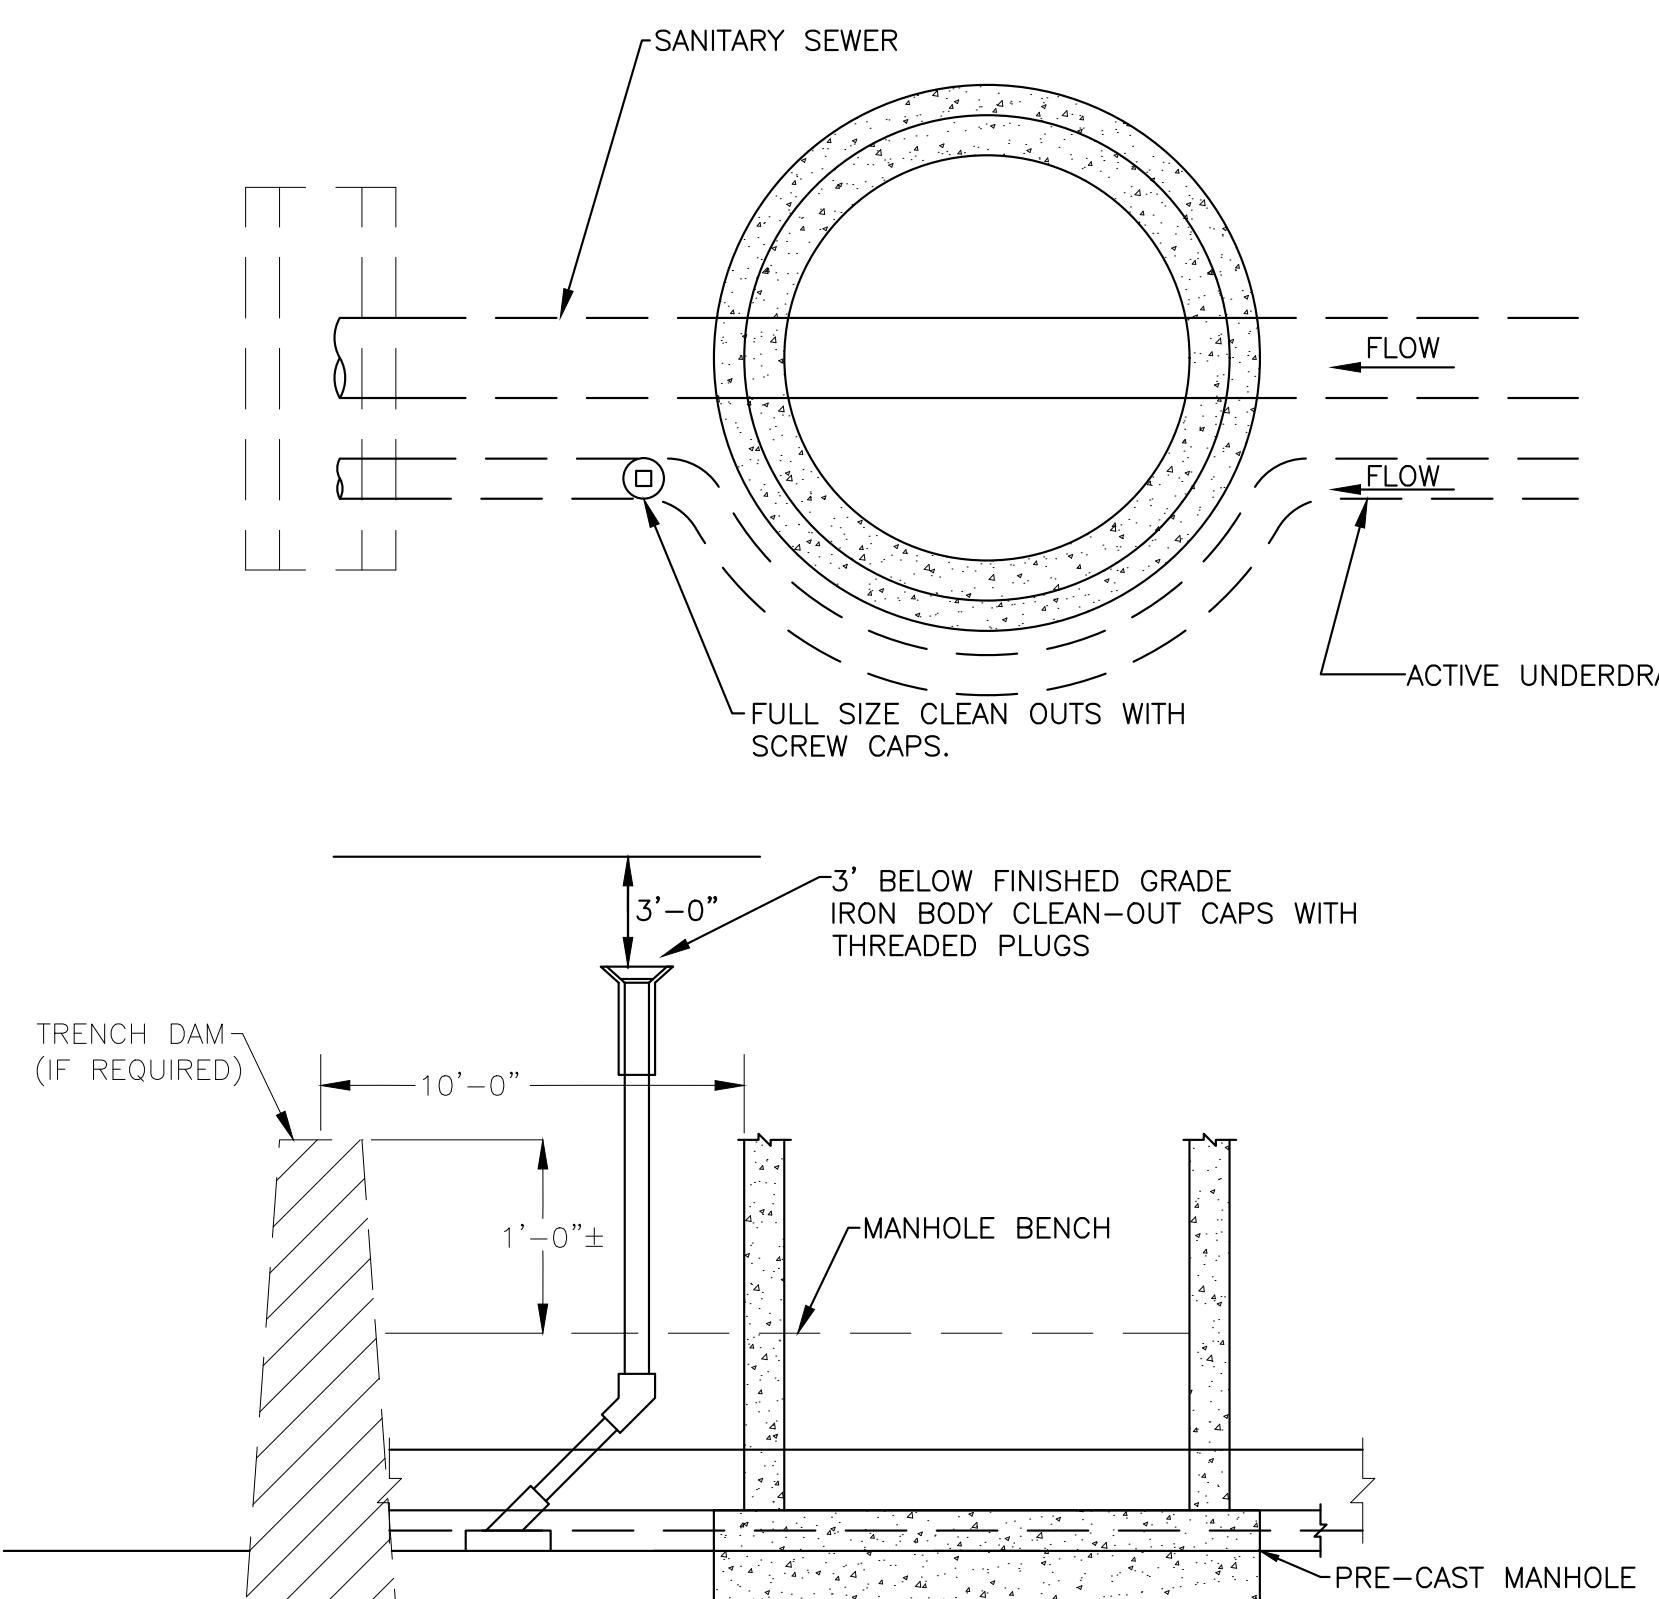

GROUNDWATER UNDERDRAIN DETAIL
CLEANOUT LOCATIONS OUTSIDE MANHOLE
NOT TO SCALE

STORM SEWER MANHOLE DETAIL TYPE II
EPC STD. SD_3-2
NOT TO SCALE

- SUBSEQUENT TO STRIPPING AND GRUBBING THE FOLLOWING OVERLOT/PIPE INSTALLATION PROCEDURES ARE ANTICIPATED FOR THE SANITARY SEWER LOCATED ON PROPOSED EMBANKMENTS:**
- THE REMOVAL AND REPLACEMENT OF METABLASTIC SOIL.
 - TESTING OF THE FILL SUBSEQUENT TO THE PENETRATION OF THE METABLASTIC SOIL WILL CONTINUE UNTIL A MINIMUM OF 7 FEET OF STRUCTURAL FILL HAS BEEN PLACED ABOVE THE PROPOSED SEWER LINE ELEVATION.
 - UTILITY TRENCHES SHALL BE EXCAVATED AND SANITARY SEWER LINE INSTALLED. THE PIPE SHALL BE PROPERLY BEDDED AND STRUCTURAL FILL PLACED AND TESTED TO THE PREVIOUS GRADE.
 - THE OVERLOT AND EMBANKMENT FILL CAN BE COMPLETED.
 - WHERE THE SANITARY SEWER IS PLACED IN EMBANKMENT FILL DURING THE OVERLOT PROCESS, STE SHALL MONITOR AND TEST ALL WORK ASSOCIATED WITH THE Affected PORTIONS.

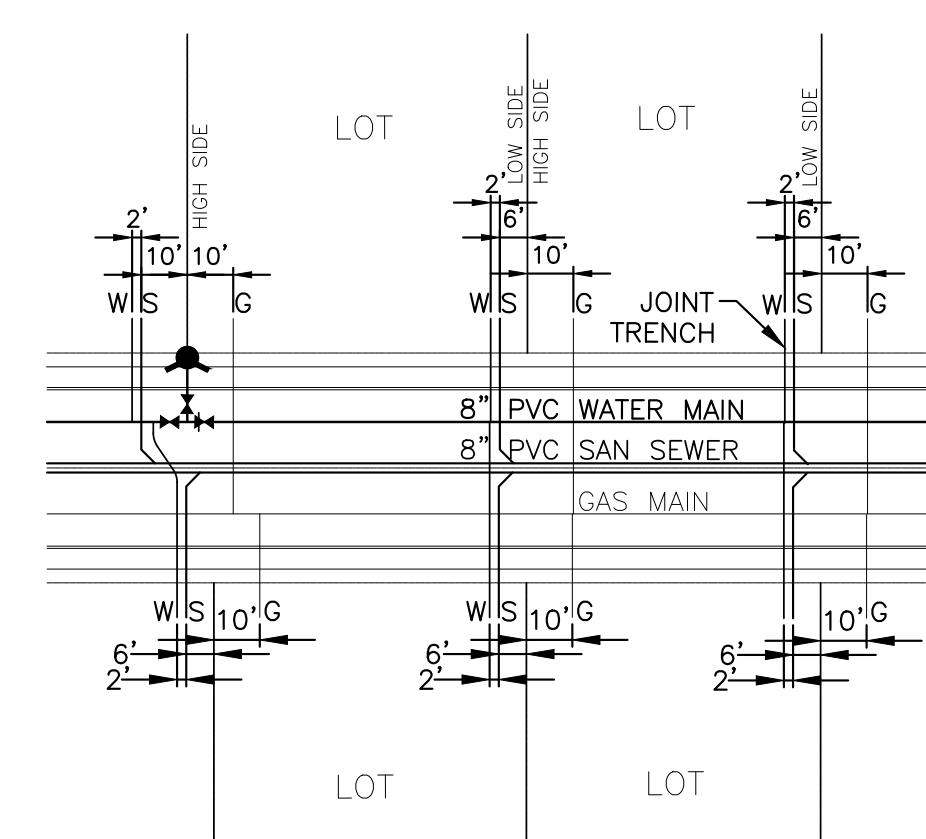

TYPICAL JOINT-TRENCH UTILITY SERVICE DETAIL
NOT TO SCALE