




NORTH ELEVATION

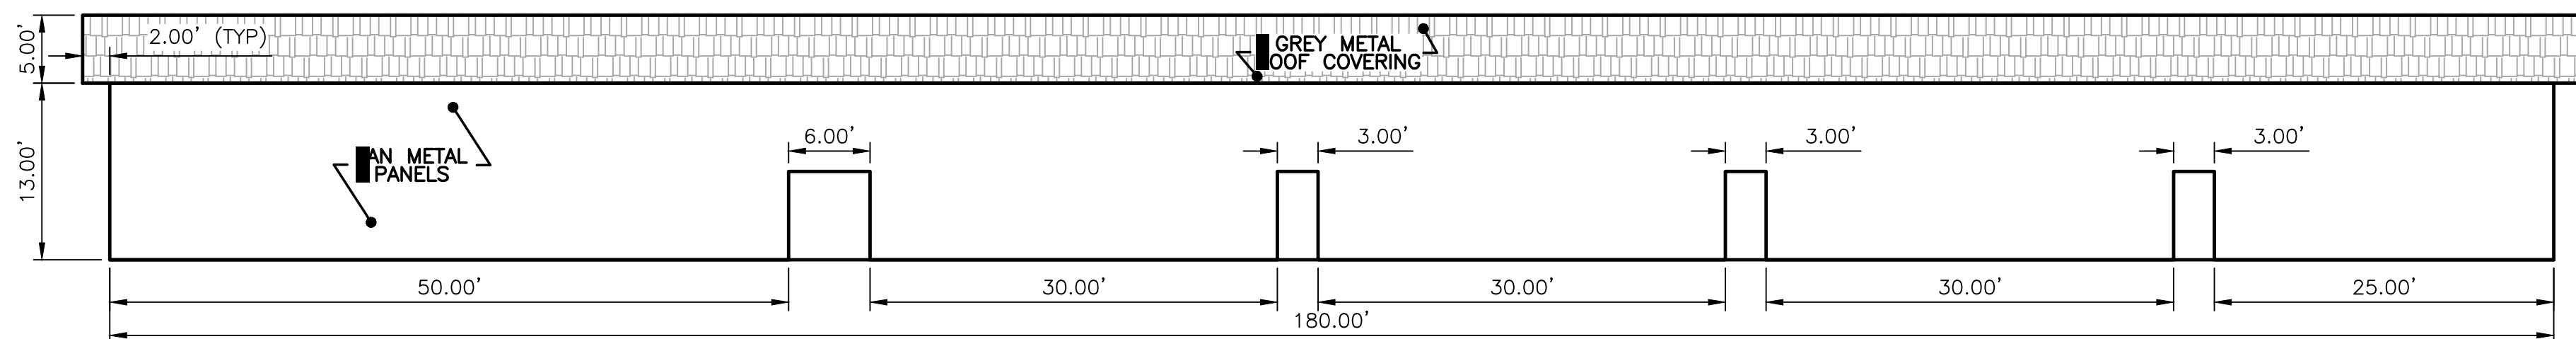


SOUTH ELEVATION

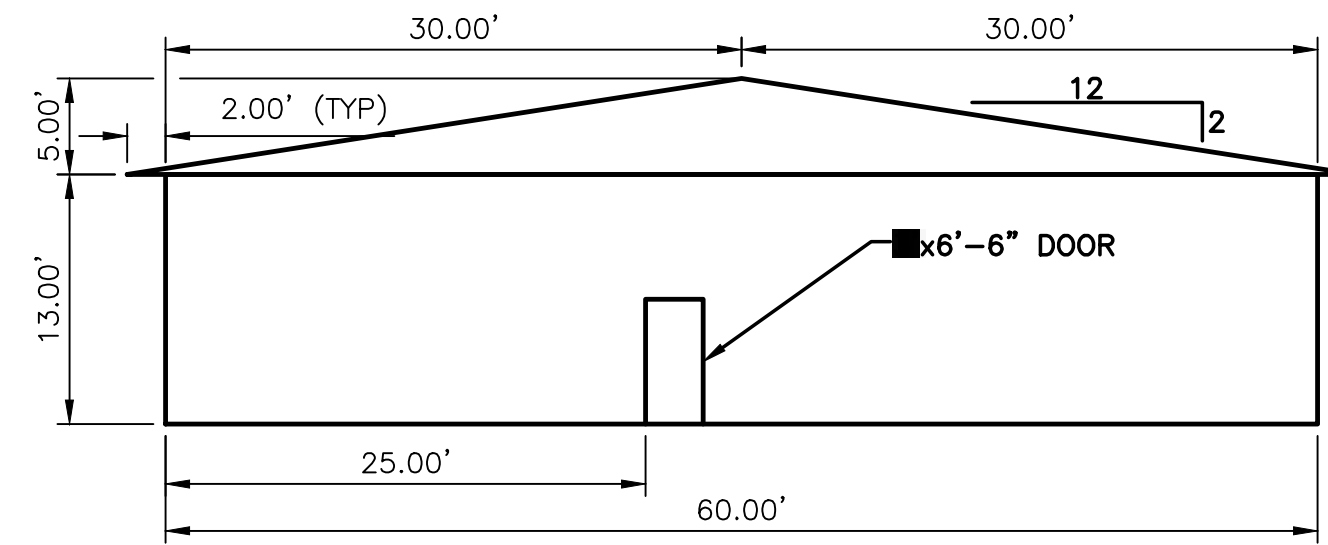


WEST ELEVATION

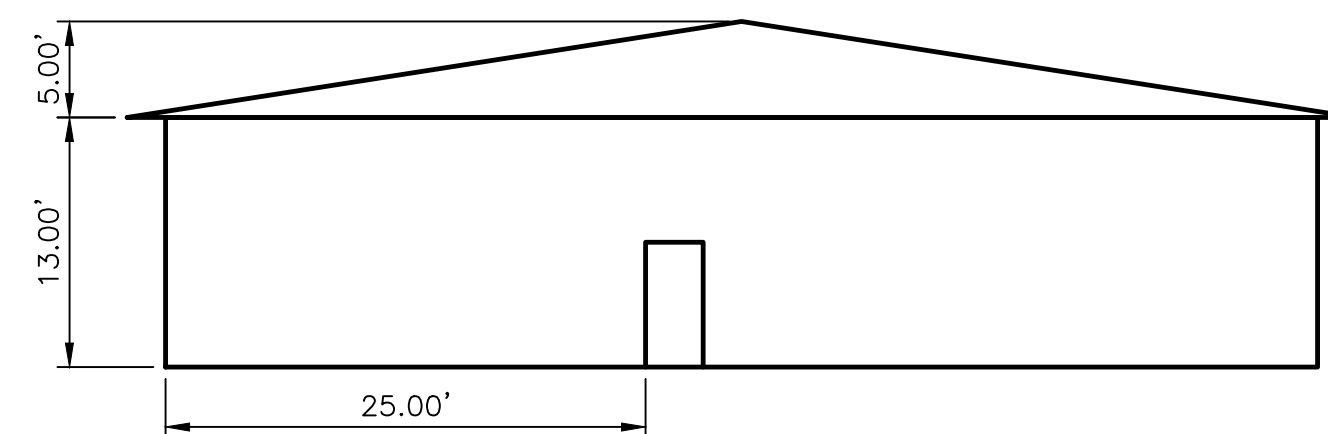

EAST ELEVATION

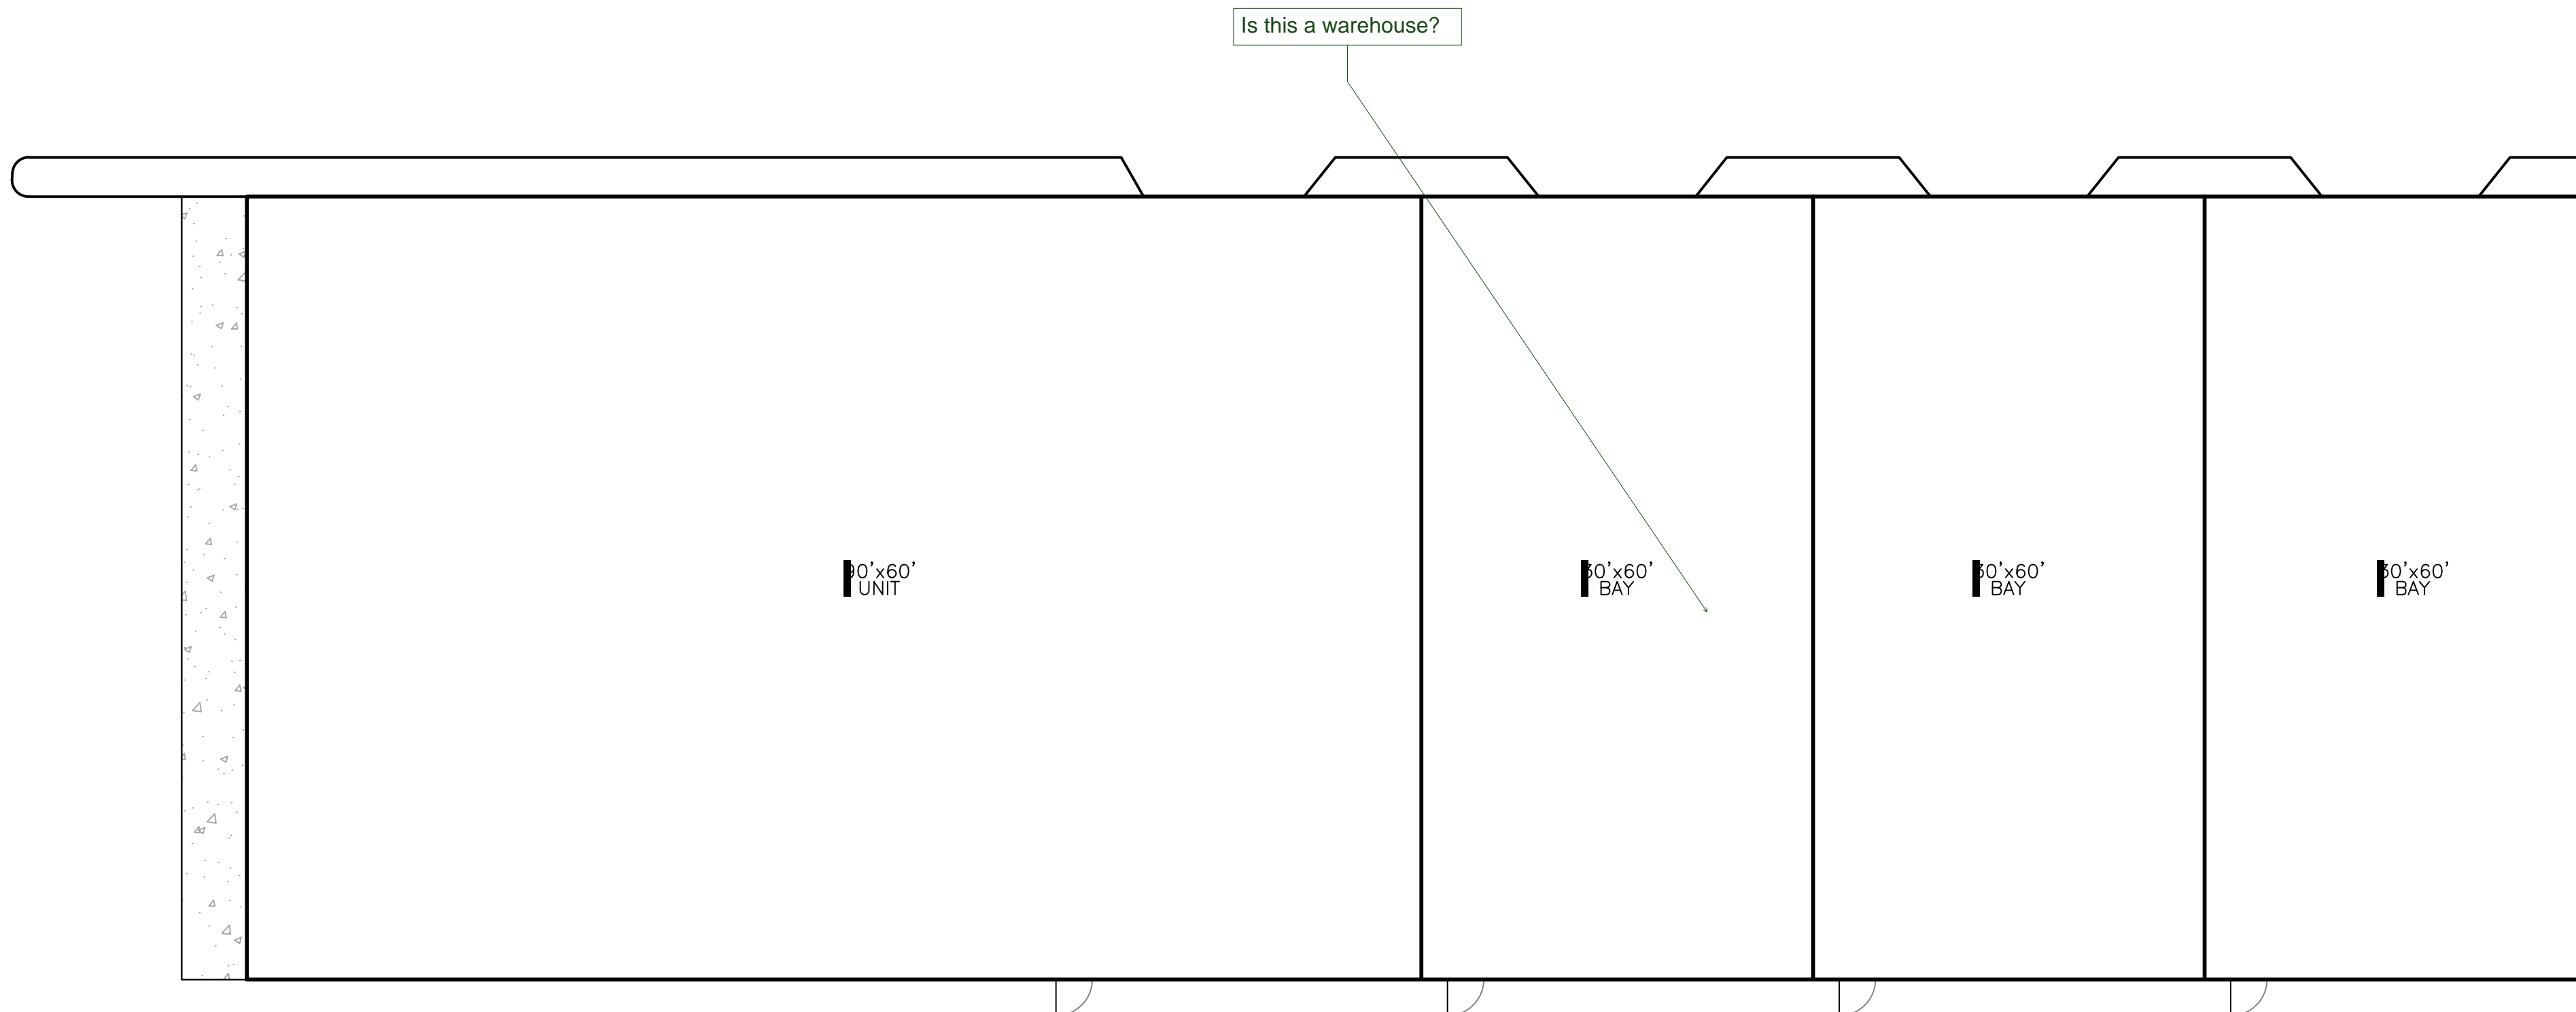


FLOOR PLAN

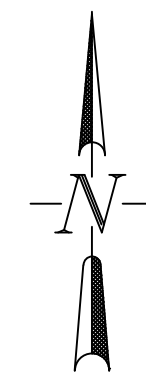

GRAPHIC SCALE




(IN FEET)
1 inch = 10 ft.

<div>DESIGNED</div> <div>DRAWN</div> <div>CHECKED</div> <div>DATE</div>	RESPEC	MAB
	8 COLORADO BLVD	HJG
	SUITE 411S	MAB
	DENVER, CO 80246	
	PHONE (303) 757-3655	7/6/18
<div>STAMP</div>		
<div><div></div><div>Know what's below. Call before you dig.</div></div>		
<div>PROJ NO. 03437 DWG NM. 03437-DEV</div>		
<div>COPESTONE GENERAL CONTRACTORS 1624 S. 21ST ST COLORADO SPRINGS, CO. 80904</div>		
<div>LOT 2, APPALOOSA HWY 24 SUBDIVISION FIL 1A</div>		
<div>BUILDING ELEVATIONS AND FLOOR PLAN</div>		
<div>DRAWING NUMBER: <div>C</div><div>SHEET 4</div></div>		

Markup Summary

dsdkendall (1)

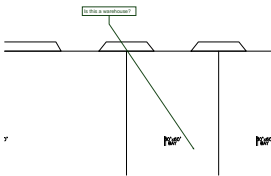

Subject: Callout
Page Label: [1] Arch Elev
Lock: Unlocked
Author: dsdkendall
Date: 2/13/2019 11:45:48 AM
Color:

Is this a warehouse?