

STEEL STRUCTURES AMERICA, INC.

1-800-833-9997

Appt. Time _____

Date 9/28/20

Name ERIC GUYER

Mailing Address SAME AS JOBSITE


City _____ State _____ Zip _____

Job Address 13010 CRUMP RD.


City COLORADO SPRINGS State CO

County EL PASO Zip 80908

Telephone Home _____ Work _____

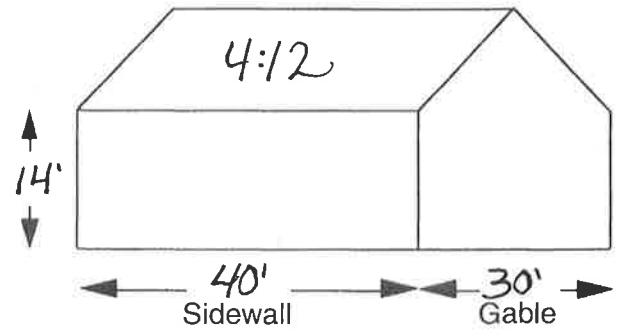

Building Size 30' x 40' x 14'

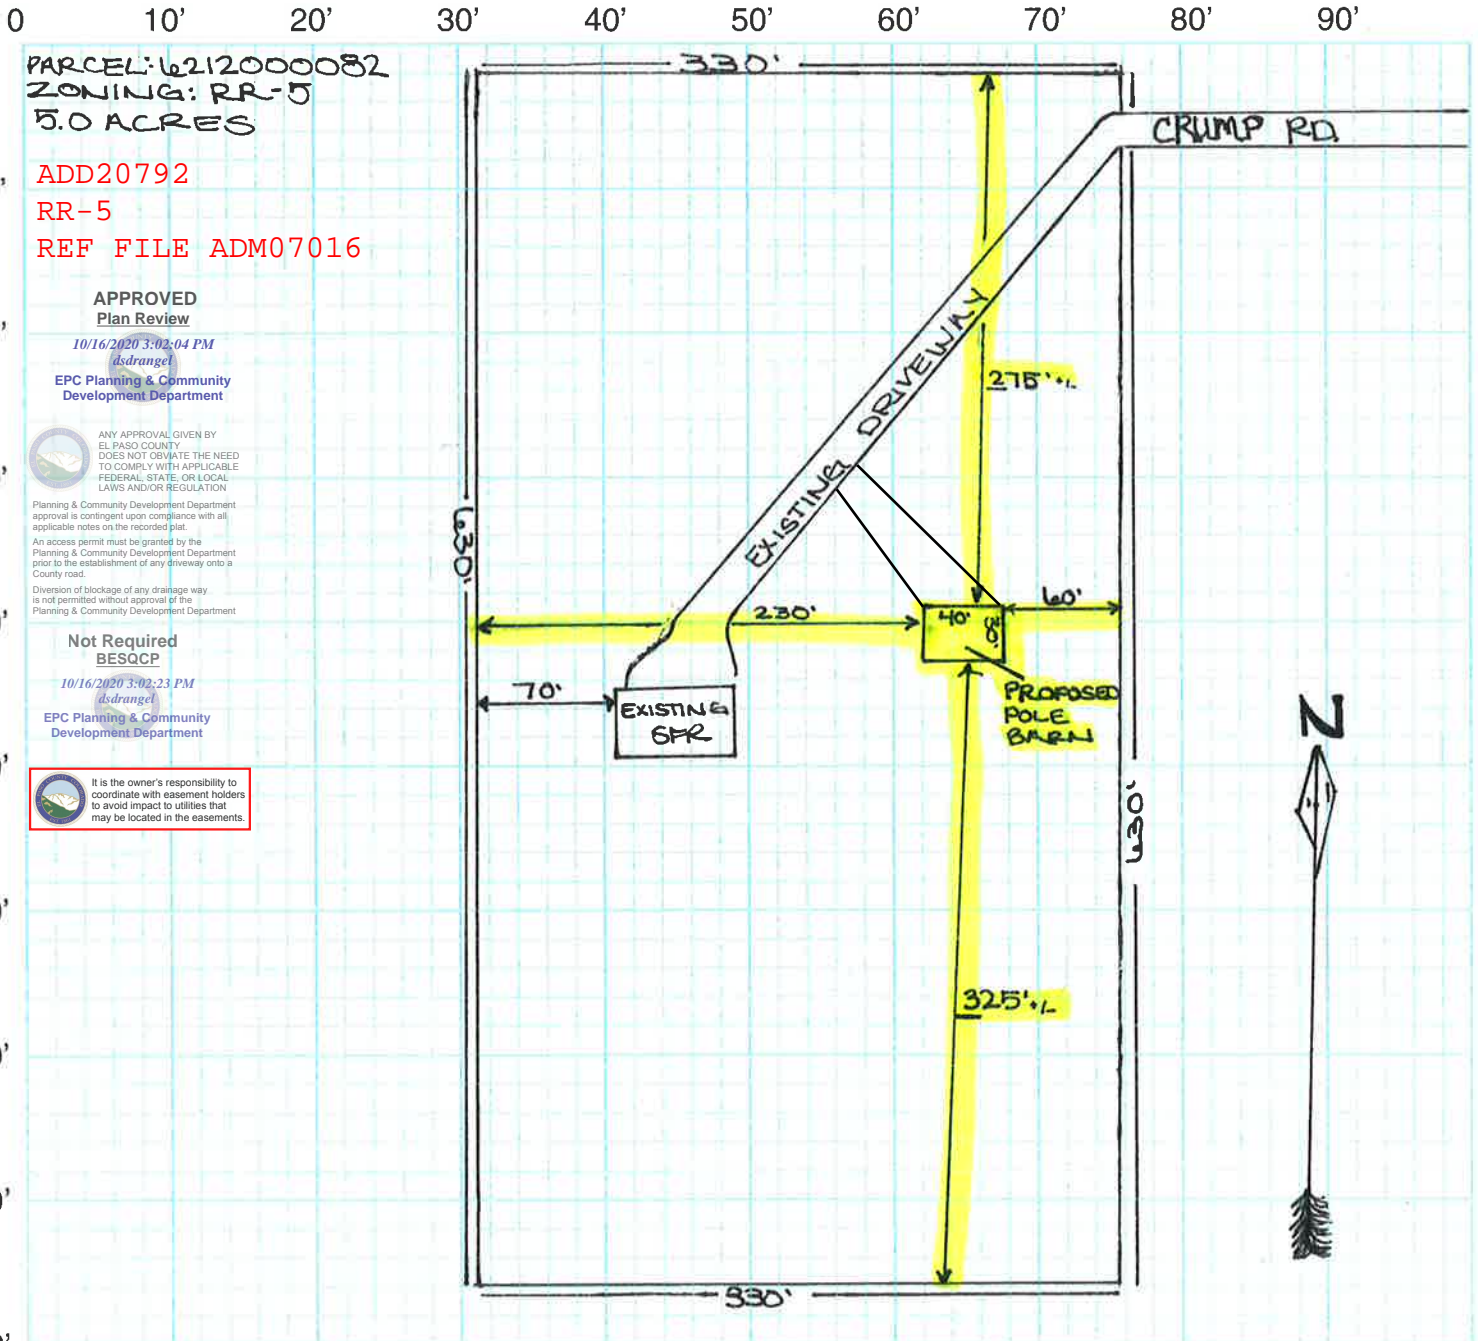

TR IN SW4NE4 SEC 12-12-66 DESC AS FOLS:THE WEST 330.0

Customer Signature _____

[Signature]
 Sales Signature

Scale: **1" = 100'**

RESIDENTIAL



2017 PPRBC

Address: 13010 CRUMP RD, COLORADO SPRINGS

Parcel: 6212000082

Plan Track #: 135765  Received: 15-Oct-2020 (GITA)

Description:

DETACHED ACCESSORY STRUCTURE

Contractor: STEEL STRUCTURES AMERICA INC.

Type of Unit:

Required PPRBD Departments (2)

Floodplain

(N/A) RBD GIS

Construction


Released for Permit
10/16/2020 14:30 PM

CONSTRUCTION

Required Outside Departments (1)

County Zoning

APPROVED
Plan Review

10/16/2020 3:03:05 PM

EPC Planning & Community
Development Department

Release of this plan does not preclude compliance with all applicable codes, ordinances and other pertinent regulations. This plan set must be present on the job site for every inspection.