


Please revise to show breakout of floor space dedicated to office uses/vs warehouse uses per comments on site development plan

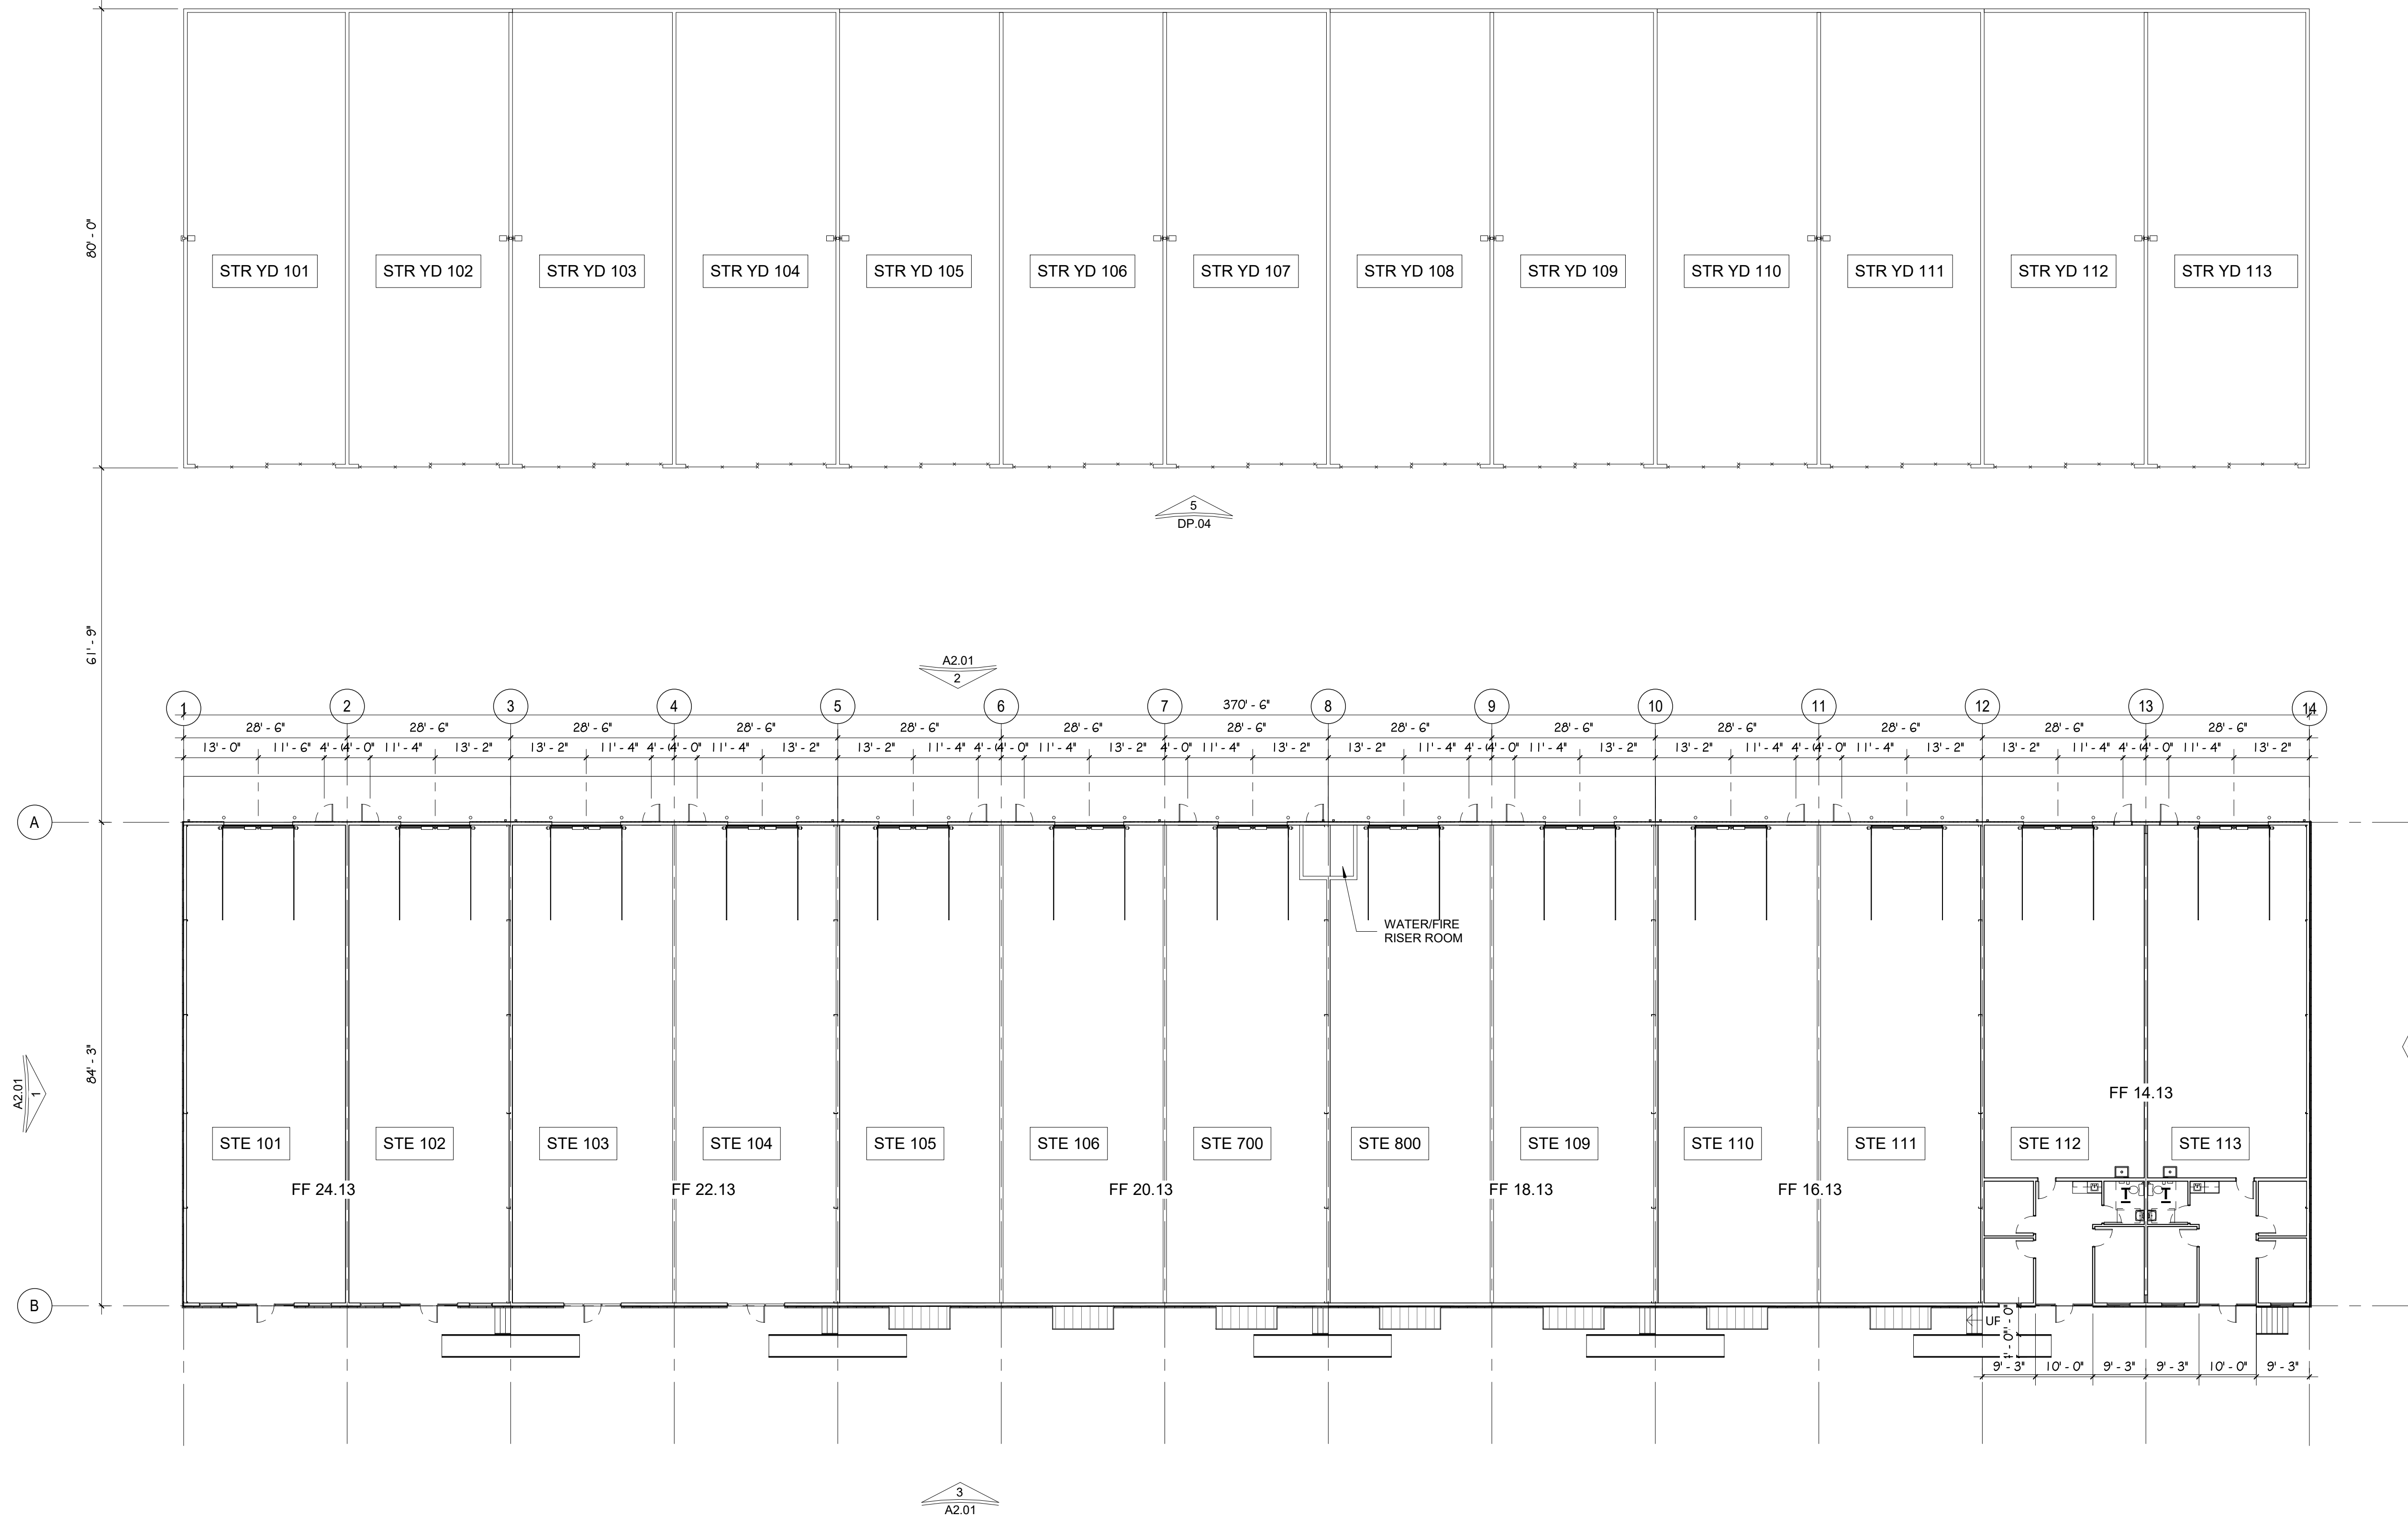

ARCHENGIN:	Designer
DRAWN:	Author
CHECKED:	Checker
DATE	06.18.21
REVISION	DATE
JOB NO.	180649
SHEET NO.	DP.03