


SITE MAP

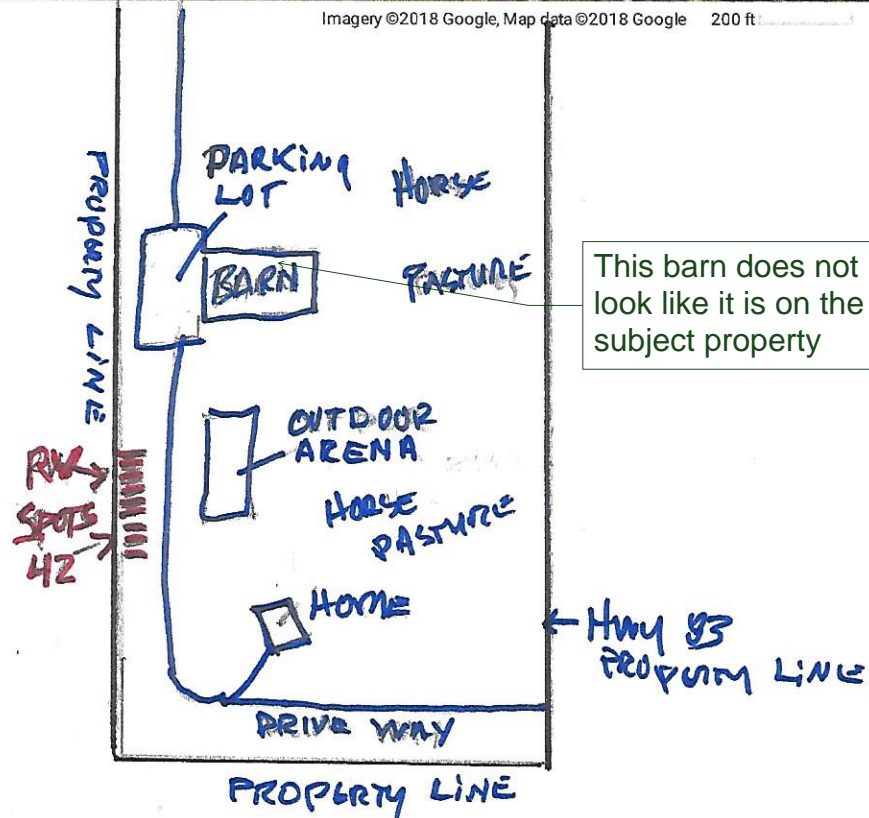

CANTERBURY
DEVELOPMENT

- Show an accurate depiction of the parcel shape in the site plan drawing and setbacks from all existing structures.
- Show easements
- Show setbacks from outside storage of RV's and indicate whether or not a Board of Adjustment Hearing will be applied for or the 50 foot setback met.
- Show the screening that is required.

Site Plan_v1-redline.pdf Markup Summary

dsdkendall (2)

Development

Show an accurate depiction of the parcel shape in the site plan drawing and setbacks from all existing structures.

Show easements

Show setbacks from outside storage of RV's and indicate whether or not a Board of Adjustment Hearing will be applied for or the 50 foot setback met.

Show the screening that is required.


*RV'S
SPACING
50'*

Subject: Text Box
Page Label: 1
Lock: Locked
Author: dsdkendall
Date: 7/30/2019 8:37:35 AM
Status:
Color: ■
Layer:
Space:

Show an accurate depiction of the parcel shape in the site plan drawing and setbacks from all existing structures.

Show easements

Show setbacks from outside storage of RV's and indicate whether or not a Board of Adjustment Hearing will be applied for or the 50 foot setback met.
Show the screening that is required.

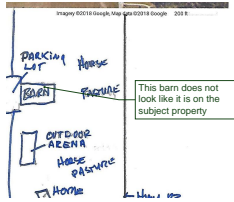

Subject: Callout
Page Label: 1
Lock: Locked
Author: dsdkendall
Date: 7/30/2019 8:37:37 AM
Status:
Color: ■
Layer:
Space:

This barn does not look like it is on the subject property