


DRIFTWOOD ESTATES FILING NO. 1

A SUBDIVISION IN THE NORTHEAST QUARTER OF THE NORTHEAST QUARTER OF SECTION 33, TOWNSHIP 11 SOUTH, RANGE 67 WEST OF THE 6TH P.M. EL PASO COUNTY, COLORADO

8.4.3 Division of Land Standards
(B)(1) Minimum Frontage for Division of Land. A division of land shall have a minimum of 60 feet frontage on a public road.
(B)(2)(e) Minimum Frontage. Lots shall have a minimum of 30 feet of frontage on and have access from a public road, except where private roads are approved by the BoCC pursuant to waiver granted under Section 8.4.4 (E).
A waiver will be required due to road access. Please review and address LDC Sec 7.3.3 Criteria for Approval of Waivers in the LOI.

The soils and geology report label this area as no build. Please clarify where the no build areas are.

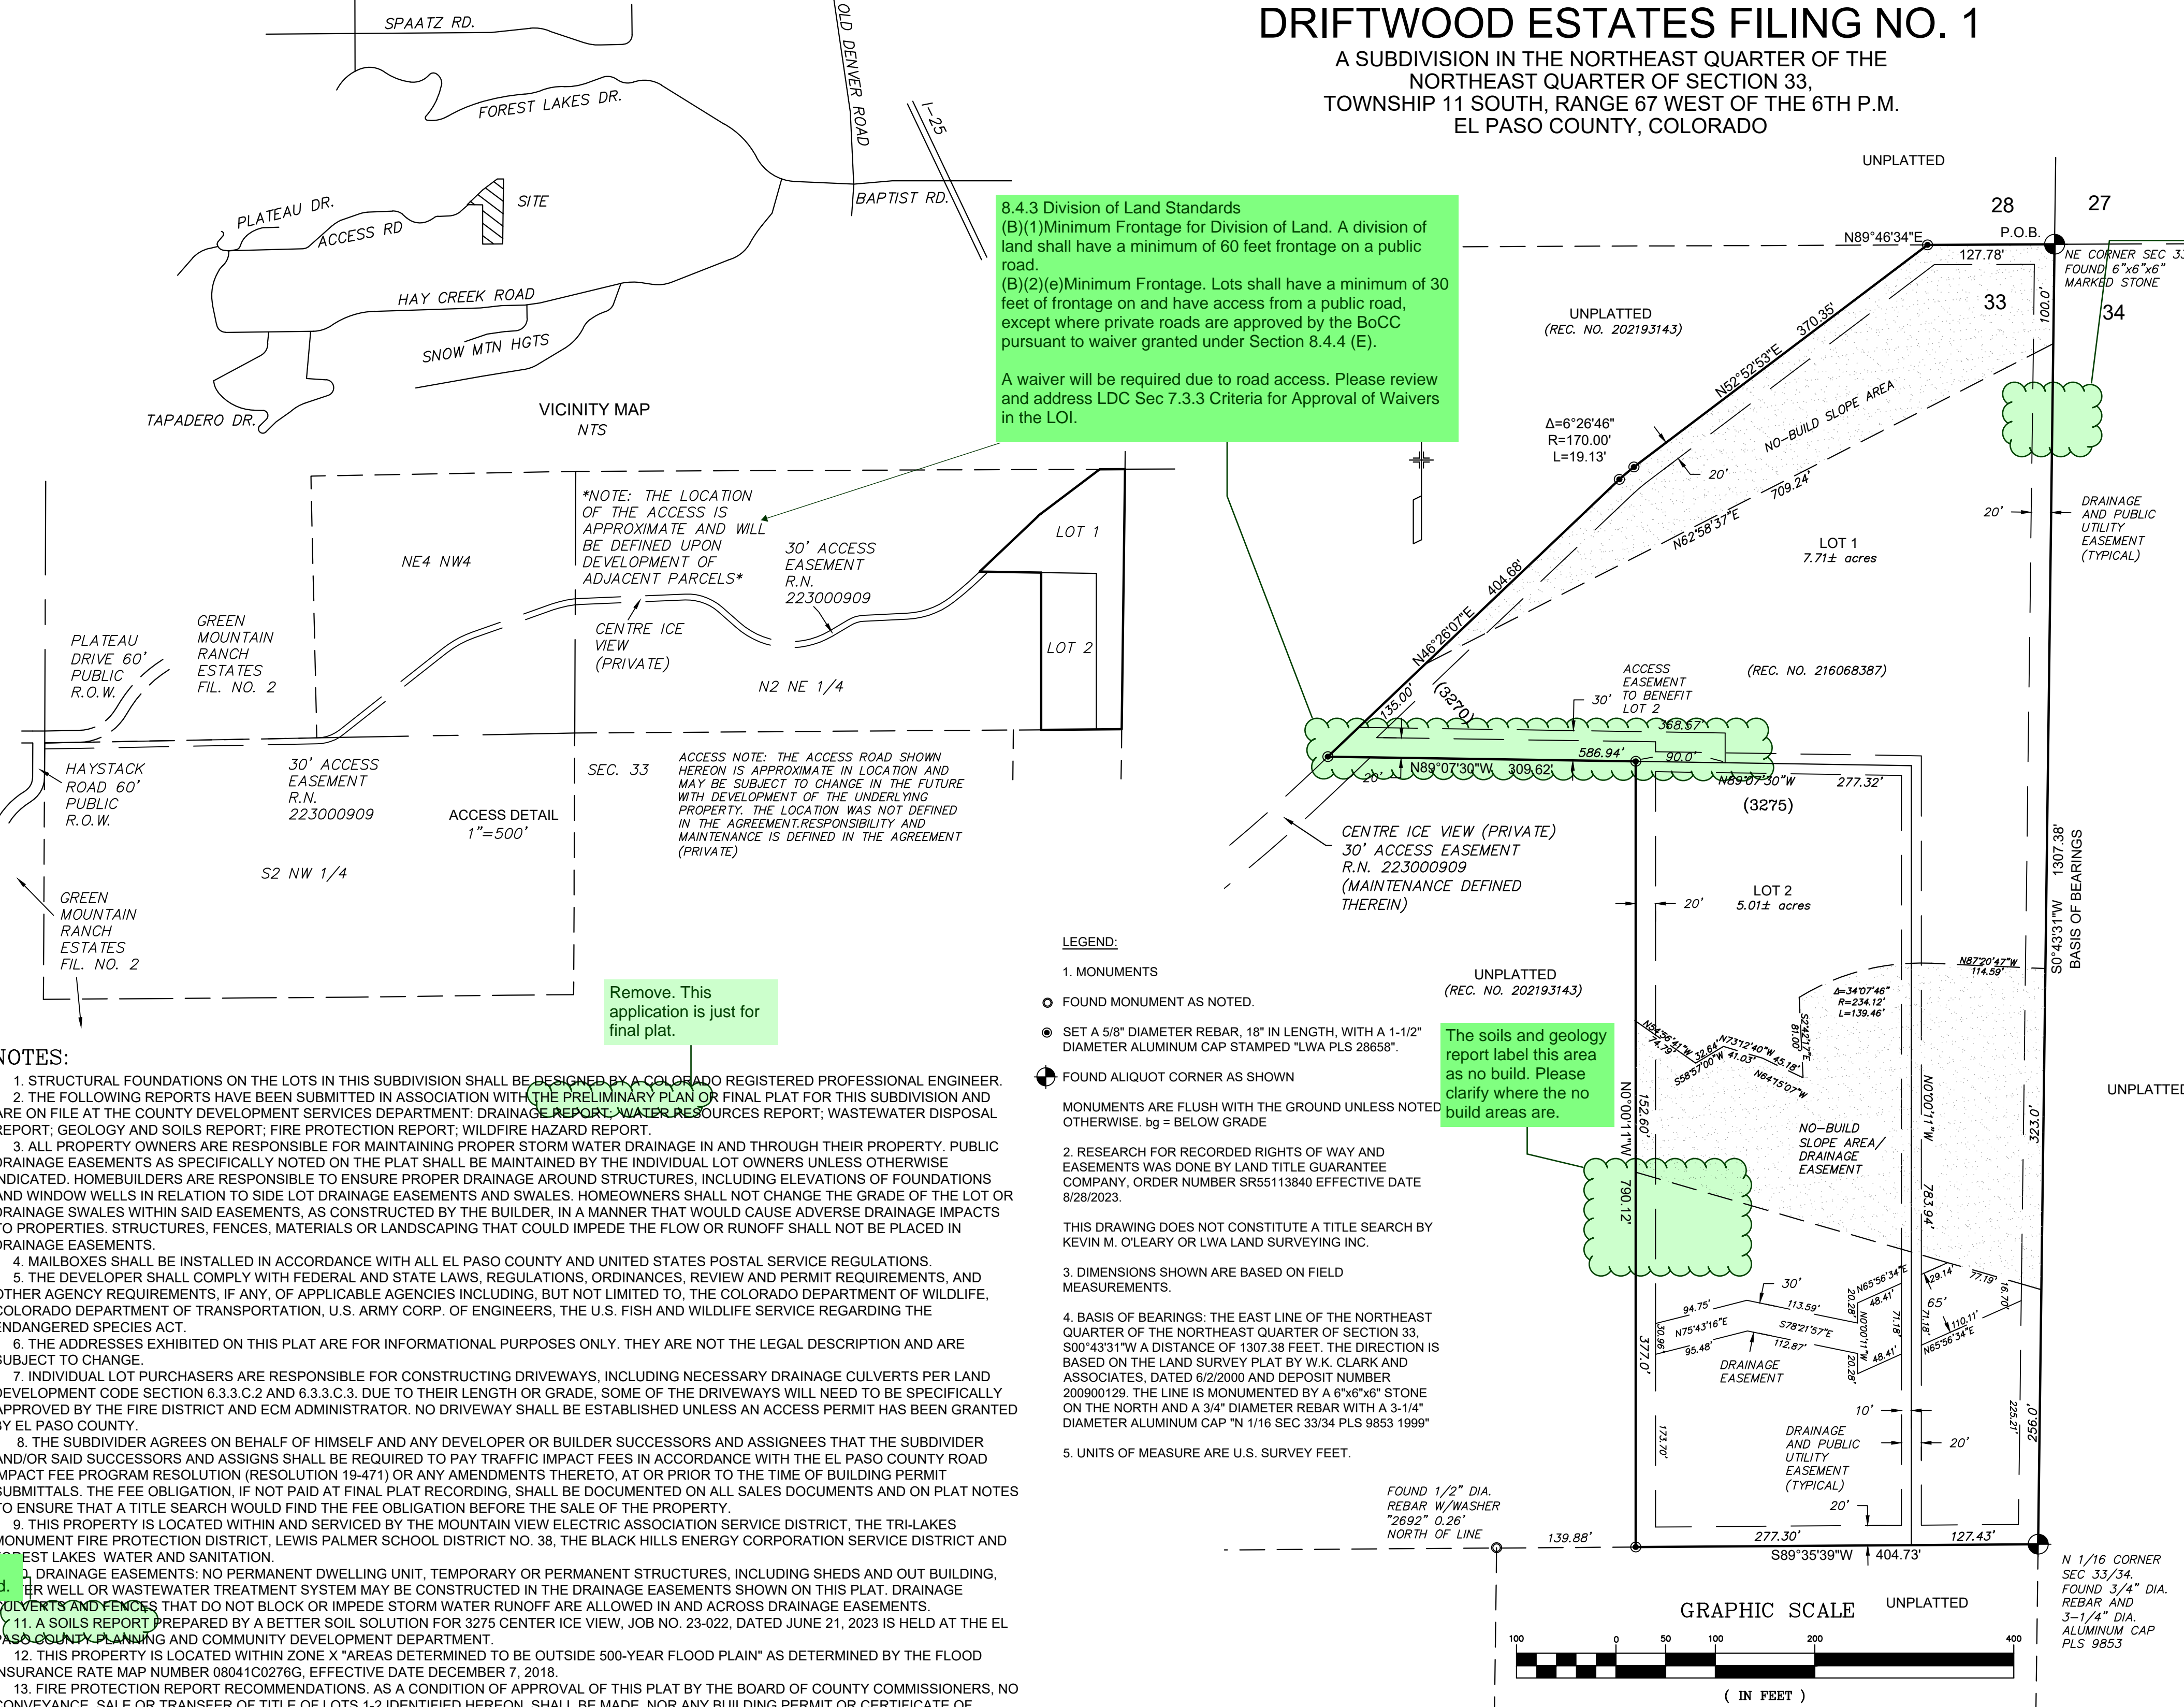


NOTES:

- STRUCTURAL FOUNDATIONS ON THE LOTS IN THIS SUBDIVISION SHALL BE DESIGNED BY A COLORADO REGISTERED PROFESSIONAL ENGINEER.
- THE FOLLOWING REPORTS HAVE BEEN SUBMITTED IN ASSOCIATION WITH THE PRELIMINARY PLAN OR FINAL PLAT FOR THIS SUBDIVISION AND ARE ON FILE AT THE COUNTY DEVELOPMENT SERVICES DEPARTMENT: DRAINAGE REPORT, WATER RESOURCES REPORT, WASTEWATER DISPOSAL REPORT, GEOLOGY AND SOILS REPORT, FIRE PROTECTION REPORT, WILDFIRE HAZARD REPORT.
- ALL PROPERTY OWNERS ARE RESPONSIBLE FOR MAINTAINING PROPER STORM WATER DRAINAGE IN AND THROUGH THEIR PROPERTY. PUBLIC DRAINAGE EASEMENTS AS SPECIFICALLY NOTED ON THE PLAT SHALL BE MAINTAINED BY THE INDIVIDUAL LOT OWNERS UNLESS OTHERWISE INDICATED. HOMEOWNERS ARE RESPONSIBLE TO ENSURE PROPER DRAINAGE AROUND STRUCTURES, INCLUDING ELEVATIONS OF FOUNDATIONS AND WINDOW WELLS IN RELATION TO SIDE LOT DRAINAGE EASEMENTS AND SWALES. HOMEOWNERS SHALL NOT CHANGE THE GRADE OF THE LOT OR DRAINAGE SWALES WITHIN SAID EASEMENTS, AS CONSTRUCTED BY THE BUILDER, IN A MANNER THAT WOULD CAUSE ADVERSE DRAINAGE IMPACTS TO PROPERTIES, STRUCTURES, FENCES, MATERIALS OR LANDSCAPING THAT COULD IMPEDE THE FLOW OR RUNOFF SHALL NOT BE PLACED IN DRAINAGE EASEMENTS.
- MAILBOXES SHALL BE INSTALLED IN ACCORDANCE WITH ALL EL PASO COUNTY AND UNITED STATES POSTAL SERVICE REGULATIONS.
- THE DEVELOPER SHALL COMPLY WITH FEDERAL AND STATE LAWS, REGULATIONS, ORDINANCES, REVIEW AND PERMIT REQUIREMENTS, AND OTHER AGENCY REQUIREMENTS, IF ANY, OF APPLICABLE AGENCIES INCLUDING, BUT NOT LIMITED TO, THE COLORADO DEPARTMENT OF WILDLIFE, COLORADO DEPARTMENT OF TRANSPORTATION, U.S. ARMY CORP. OF ENGINEERS, THE U.S. FISH AND WILDLIFE SERVICE REGARDING THE ENDANGERED SPECIES ACT.
- THE ADDRESSES EXHIBITED ON THIS PLAT ARE FOR INFORMATIONAL PURPOSES ONLY. THEY ARE NOT THE LEGAL DESCRIPTION AND ARE SUBJECT TO CHANGE.
- INDIVIDUAL LOT PURCHASERS ARE RESPONSIBLE FOR CONSTRUCTING DRIVEWAYS, INCLUDING NECESSARY DRAINAGE CULVERTS PER LAND DEVELOPMENT CODE SECTION 6.3.3.C.2 AND 6.3.3.C.3. DUE TO THEIR LENGTH OR GRADE, SOME OF THE DRIVEWAYS WILL NEED TO BE SPECIFICALLY APPROVED BY THE FIRE DISTRICT AND ECM ADMINISTRATOR. NO DRIVEWAY SHALL BE ESTABLISHED UNLESS AN ACCESS PERMIT HAS BEEN GRANTED BY EL PASO COUNTY.
- THE SUBDIVIDER AGREES ON BEHALF OF HIMSELF AND ANY DEVELOPER OR BUILDER SUCCESSORS AND ASSIGNEES THAT THE SUBDIVIDER AND/OR SAID SUCCESSORS OR ASSIGNS SHALL BE REQUIRED TO PAY TRAFFIC IMPACT FEES IN ACCORDANCE WITH THE EL PASO COUNTY ROAD IMPACT FEE PROGRAM RESOLUTION (RESOLUTION 19-471) OR ANY AMENDMENTS THERETO, AT OR PRIOR TO THE TIME OF BUILDING PERMIT SUBMITTALS. THE FEE OBLIGATION, IF NOT PAID AT FINAL PLAT RECORDING, SHALL BE DOCUMENTED ON ALL SALES DOCUMENTS AND ON PLAT NOTES TO ENSURE THAT A TITLE SEARCH WOULD FIND THE FEE OBLIGATION BEFORE THE SALE OF THE PROPERTY.
- THIS PROPERTY IS LOCATED WITHIN AND SERVED BY THE MOUNTAIN VIEW ELECTRIC ASSOCIATION SERVICE DISTRICT, THE TRI-LAKES MONUMENT FIRE PROTECTION DISTRICT, LEWIS PALMER SCHOOL DISTRICT NO. 38, THE BLACK HILLS ENERGY CORPORATION SERVICE DISTRICT AND WEST LAKES WATER AND SANITATION.
- DRAINAGE EASEMENTS: NO PERMANENT DWELLING UNIT, TEMPORARY OR PERMANENT STRUCTURES, INCLUDING SHEDS AND OUT BUILDING, OR WELL OR WASTEWATER TREATMENT SYSTEM MAY BE CONSTRUCTED IN THE DRAINAGE EASEMENTS SHOWN ON THIS PLAT. DRAINAGE CULVERTS AND FENCES THAT DO NOT BLOCK OR IMPEDE STORM WATER RUNOFF ARE ALLOWED IN AND ACROSS DRAINAGE EASEMENTS.
- A SOILS REPORT PREPARED BY A BETTER SOIL SOLUTION FOR 3275 CENTER ICE VIEW, JOB NO. 23-022, DATED JUNE 21, 2023 IS HELD AT THE EL PASO COUNTY PLANNING AND COMMUNITY DEVELOPMENT DEPARTMENT.
- THIS PROPERTY IS LOCATED WITHIN ZONE X "AREAS DETERMINED TO BE OUTSIDE 500-YEAR FLOOD PLAIN" AS DETERMINED BY THE FLOOD INSURANCE RATE MAP NUMBER 0804100276G, EFFECTIVE DATE DECEMBER 7, 2018.
- FIRE PROTECTION REPORT RECOMMENDATIONS, AS A CONDITION OF APPROVAL OF THIS PLAT BY THE BOARD OF COUNTY COMMISSIONERS, NO CONVEYANCE, SALE OR TRANSFER OF TITLE OF LOTS 1-2 IDENTIFIED HEREON, SHALL BE MADE, NOR ANY BUILDING PERMIT OR CERTIFICATE OF OCCUPANCY BE ISSUED BY EL PASO COUNTY, UNTIL SUCH TIMES AS THE FOLLOWING HAS BEEN ACCOMPLISHED BY THE PROPERTY OWNER, A LETTER OF COMPLIANCE HAS BEEN RECEIVED FROM THE COLORADO STATE FOREST SERVICE, FIRE DEPARTMENT, FIRE MARSHALL, OR OTHER QUALIFIED PROFESSIONAL STATING PRACTICES DESIGNATED TO REDUCE WILDFIRE HAZARDS HAS BEEN COMPLETED IN ACCORDANCE WITH THE WILDLAND FIRE AND HAZARD MITIGATION PLAN, SUCH WORK MAY INCLUDE, BUT IS NOT NECESSARILY LIMITED TO THE FOLLOWING: "FOREST WIDE THINNING, "FUELBREAK THINNING, "PRUNING, "DEBRIS DISPOSAL.
- ANY PERSON WHO KNOWINGLY REMOVES, ALTERS OR DEFACTO ANY PUBLIC LAND SURVEY MONUMENT OR LAND BOUNDARY MONUMENT OR ACCESSORY COMMITMENTS A CLASS TWO (2) MISDEMEANOR PURSUANT TO C.R.S. 18-4-508.
- INDIVIDUAL WELLS ARE THE RESPONSIBILITY OF EACH PROPERTY OWNER. PERMITS FOR INDIVIDUAL WELLS MUST BE OBTAINED FROM THE STATE ENGINEER WHO BY LAW HAS THE AUTHORITY TO SET CONDITIONS FOR THE ISSUANCE OF THESE PERMITS.
- WATER IN THE DENVER BASIN AQUIFERS IS ALLOCATED BASED ON A 100 YEAR AQUIFER LIFE; HOWEVER, FOR EL PASO COUNTY PLANNING PURPOSES, WATER IN THE DENVER BASIN AQUIFERS IS EVALUATED BASED ON A 300 YEAR AQUIFER LIFE. APPLICANTS AND ALL FUTURE OWNERS IN THE SUBDIVISION SHOULD BE AWARE THAT THE ECONOMIC LIFE OF A WATER SUPPLY BASED ON WELLS IN A GIVEN DENVER BASIN AQUIFER MAY BE LESS THAN EITHER THE 100 YEARS OR 300 YEARS USED FOR ALLOCATION INDICATED DUE TO ANTICIPATED WATER LEVEL DECLINES. FURTHERMORE, THE WATER SUPPLY PLAN SHOULD NOT RELY SOLELY UPON NON-RENEWABLE AQUIFERS. ALTERNATIVE RENEWABLE WATER RESOURCES SHOULD BE ACQUIRED AND INCORPORATED IN A PERMANENT WATER SUPPLY PLAN THAT PROVIDES FUTURE GENERATIONS WITH A WATER SUPPLY.
- SEWAGE TREATMENT IS THE RESPONSIBILITY OF EACH INDIVIDUAL PROPERTY OWNER. THE EL PASO COUNTY HEALTH DEPARTMENT MUST APPROVE EACH SYSTEM AND, IN SOME CASES THE DEPARTMENT MAY REQUIRE AN ENGINEERED DESIGNED PRIOR TO PERMIT APPROVAL. THESE SYSTEMS MAY COST MORE TO DESIGN, INSTALL AND MAINTAIN.
- THE PRIVATE ROADS SHOWN ON THIS PLAT WILL NOT BE MAINTAINED BY EL PASO COUNTY UNTIL AND UNLESS THE STREETS ARE CONSTRUCTED IN CONFORMANCE WITH EL PASO COUNTY STANDARDS IN EFFECT AT THE DATE OF THE REQUEST FOR DEDICATION AND MAINTENANCE.
- A SOIL AND GEOLOGY REPORT BY RMG ENGINEERS, JOB NO. 194552, DATED JANUARY 11, 2024 IS HELD UNDER THE DRIFTWOOD ESTATES FILING NO. 1 AT THE EL PASO COUNTY PLANNING AND COMMUNITY DEVELOPMENT DEPARTMENT. GEOLOGIC HAZARDS THAT WOULD PRECLUDE THE PROPOSED DEVELOPMENT WERE NOT FOUND TO BE PRESENT AT THIS SITE. GEOLOGIC CONSTRAINTS AND HAZARDS ARE POTENTIALLY PRESENT AND INCLUDE: COMPRESSIBLE SOILS; POTENTIALLY EXPANSIVE SOILS AND BEDROCK; UNSTABLE OR POTENTIALLY UNSTABLE SLOPES; SEASONALLY FLUCTUATING SURFACE WATER AND GROUNDWATER; SCOUR, EROSION, ACCELERATED EROSION; FAULTS AND SEISMICITY; RADON. THESE GEOLOGIC AND ENGINEERING CONDITIONS ARE RELATIVELY COMMON TO THE AREA AND CAN BE SATISFACTORILY MITIGATED THROUGH PROPER ENGINEERING, DESIGN, AND CONSTRUCTION PRACTICES.
- PER THE ECM SECTION 17.1.B.5, THE RESIDENTIAL LOTS IMPERVIOUS AREA MAY NOT EXCEED 10 PERCENT UNLESS A STUDY IS PREPARED IN COMPLIANCE WITH THE REQUIREMENTS LAID OUT IN THE ABOVE ECM SECTION AND THE IMPERVIOUS AREA MAY NOT EXCEED 20 PERCENT. THIS IMPERVIOUS AREA FOR EACH LOT MUST INCLUDE THE PROPOSED DRIVEWAY.

- ### LEGEND:
- MONUMENTS
 - FOUND MONUMENT AS NOTED.
 - SET A 5/8" DIAMETER REBAR, 18" IN LENGTH, WITH A 1-1/2" DIAMETER ALUMINUM CAP STAMPED "LWA PLS 28658".
 - FOUND ALIQUOT CORNER AS SHOWN
 - MONUMENTS ARE FLUSH WITH THE GROUND UNLESS NOTED OTHERWISE. bq = BELOW GRADE
 - RESEARCH FOR RECORDED RIGHTS OF WAY AND EASEMENTS WAS DONE BY LAND TITLE GUARANTEE COMPANY, ORDER NUMBER SR55113840 EFFECTIVE DATE 8/28/2023.
 - THIS DRAWING DOES NOT CONSTITUTE A TITLE SEARCH BY KEVIN M. O'LEARY OR LWA LAND SURVEYING INC.
 - DIMENSIONS SHOWN ARE BASED ON FIELD MEASUREMENTS.
 - BASIS OF BEARINGS: THE EAST LINE OF THE NORTHEAST QUARTER OF THE NORTHEAST QUARTER OF SECTION 33, S00°43'31"W A DISTANCE OF 1307.38 FEET. THE DIRECTION IS BASED ON THE LAND SURVEY PLAT BY W.K. CLARK AND ASSOCIATES, DATED 6/2/2000 AND DEPOSIT NUMBER 200900129. THE LINE IS MONUMENTED BY A 6"x6"x6" STONE ON THE NORTH AND A 3/4" DIAMETER REBAR WITH A 3-1/4" DIAMETER ALUMINUM CAP "N 1/16 SEC 33/34 PLS 9853 1999"
 - UNITS OF MEASURE ARE U.S. SURVEY FEET.

The soils and geology report label this area as no build. Please clarify where the no build areas are.

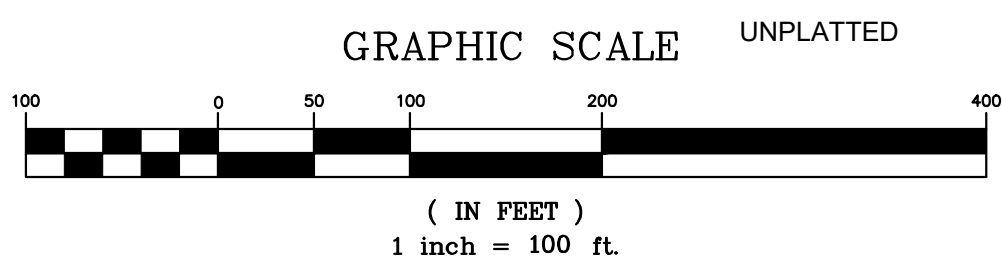

SURVEYOR'S CERTIFICATION:

I, KEVIN M. O'LEARY, A DULY REGISTERED PROFESSIONAL LAND SURVEYOR IN THE STATE OF COLORADO, DO HEREBY CERTIFY THAT THIS PLAT TRULY AND CORRECTLY REPRESENTS THE RESULTS OF A SURVEY MADE ON THE DATE OF THE SURVEY, BY ME OR UNDER MY DIRECT SUPERVISION AND THAT ALL MONUMENTS EXIST AS SHOWN HEREON, THAT MATHEMATICAL CLOSURE ERRORS ARE LESS THAN 1:10,000, AND THAT SAID PLAT HAS BEEN PREPARED IN FULL COMPLIANCE WITH ALL APPLICABLE LAWS OF THE STATE OF COLORADO DEALING WITH MONUMENTS, SUBDIVISION, OR SURVEYING OF LAND AND ALL APPLICABLE PROVISIONS OF THE EL PASO COUNTY LAND DEVELOPMENT CODE.

I ATTEST THE ABOVE ON THIS ____ DAY OF _____, 2024.

KEVIN M. O'LEARY
COLORADO REGISTERED PLS #28658
FOR AND ON BEHALF OF
LWA LAND SURVEYING, INC.

EASEMENTS:

THE SUBDIVISION BOUNDARY IS HEREBY PLATTED WITH A TWENTY (20) FOOT WIDE EASEMENT FOR DRAINAGE AND PUBLIC UTILITIES; FRONT AND SIDE LOT LINES ARE HEREBY PLATTED WITH A TEN (10) FOOT EASEMENT FOR DRAINAGE AND PUBLIC UTILITIES ONLY; THE SOLE RESPONSIBILITY FOR MAINTENANCE OF THE EASEMENT AREAS IS VESTED WITH THE PROPERTY OWNERS.

"NOTICE: ACCORDING TO COLORADO LAW YOU MUST COMMENCE ANY LEGAL ACTION BASED UPON ANY DEFECT IN THIS SURVEY WITHIN THREE YEARS* AFTER YOU FIRST DISCOVER SUCH DEFECT. IN NO EVENT MAY ANY ACTION BASED UPON ANY DEFECT IN THIS SURVEY BE COMMENCED MORE THAN TEN YEARS FROM THE DATE OF THE CERTIFICATION SHOWN HEREON."

BE IT KNOWN BY THESE PRESENTS:

THAT ANDREW C. ALM, IS THE OWNER OF THE FOLLOWING DESCRIBED TRACT OF LAND, TO WIT:

A PARCEL OF LAND BEING A PORTION OF THE NORTHEAST QUARTER OF THE NORTHEAST QUARTER OF SECTION 33, TOWNSHIP 11 SOUTH, RANGE 67 WEST OF THE SIXTH PRINCIPAL MERIDIAN, EL PASO COUNTY, COLORADO, BEING MORE PARTICULARLY AS FOLLOWS:

- BEGINNING AT THE NORTHEAST CORNER OF SECTION 33;
- THENCE S00° 43' 31" W, ON THE EAST LINE OF THE NORTHEAST QUARTER SAID SECTION 33, ALSO BEING THE EASTERLY BOUNDARY OF A PARCEL OF LAND DESCRIBED IN THE DOCUMENT RECORDED UNDER RECEPTION NO. 216068387 OF THE RECORDS OF EL PASO COUNTY, COLORADO, A DISTANCE OF 1307.38 FEET TO THE SOUTHEAST CORNER OF THE NORTHEAST QUARTER OF THE NORTHEAST QUARTER OF SECTION 33 AND OF SAID PARCEL DESCRIBED IN THE DOCUMENT RECORDED UNDER RECEPTION NO. 216068387;
- THENCE S89° 35' 39" W ON THE SOUTH LINE OF SAID PARCEL AND THE SOUTH LINE OF THE NORTHEAST QUARTER OF THE NORTHEAST QUARTER OF SECTION 33 A DISTANCE OF 404.73 FEET TO THE SOUTHWESTERLY CORNER OF SAID PARCEL;
- THENCE ON THE WESTERLY BOUNDARY OF SAID PARCEL OF LAND DESCRIBED IN THE DOCUMENT RECORDED UNDER RECEPTION NO. 216068387 THE FOLLOWING (5) COURSES:
- THENCE N00° 00' 11" W A DISTANCE OF 790.12 FEET;
 - THENCE N89° 07' 30" W A DISTANCE OF 309.62 FEET;
 - THENCE N46° 26' 07" E A DISTANCE OF 404.68 FEET TO A POINT OF CURVE;
 - THENCE ON THE ARC OF A CURVE TO THE RIGHT HAVING A RADIUS OF 170.00 FEET, THROUGH A CENTRAL ANGLE OF 06° 26' 46", AN ARC DISTANCE OF 19.13 FEET TO A POINT OF TANGENT;
 - THENCE N52° 52' 53" E A DISTANCE OF 370.35 FEET TO A POINT ON THE NORTH LINE OF THE NORTHEAST QUARTER OF THE NORTHEAST QUARTER OF SECTION 33 ;
- THENCE N89° 46' 34" E ON SAID NORTH LINE OF THE NORTHEAST QUARTER OF THE NORTHEAST QUARTER OF SAID SECTION 33 A DISTANCE OF 127.78 FEET TO THE POINT OF BEGINNING.
- CONTAINING A MEASURED AREA OF 12.72 ACRES, MORE OR LESS.

OWNERS CERTIFICATE

THE UNDERSIGNED, BEING THE OWNER, MORTGAGEE, BENEFICIARIES OF DEEDS OF TRUST AND HOLDERS OF OTHER INTERESTS IN THE LAND DESCRIBED HEREIN, HAVE LAID OUT, SUBDIVIDED AND PLATTED SAID LANDS INTO LOTS AND EASEMENTS AS SHOWN HEREON UNDER THE NAME AND SUBDIVISION OF DRIFTWOOD ESTATES FILING NO. 1. ALL PUBLIC IMPROVEMENTS REQUIRED BY THIS LAND USE ACTION ARE HEREBY DEDICATED TO PUBLIC USE AND SAID OWNER DOES HEREBY COVENANT AND AGREE THAT THESE PUBLIC IMPROVEMENTS WILL BE CONSTRUCTED TO EL PASO COUNTY STANDARDS AND THAT PROPER DRAINAGE AND EROSION CONTROL FOR THE SAME WILL BE PROVIDED AT SAID OWNER'S EXPENSE, ALL TO THE SATISFACTION OF THE BOARD OF COUNTY COMMISSIONERS OF EL PASO COUNTY, COLORADO. UPON ACCEPTANCE BY RESOLUTION, ALL PUBLIC IMPROVEMENTS SO DEDICATED WILL BECOME MATTERS OF MAINTENANCE BY EL PASO COUNTY, COLORADO. THE UTILITY EASEMENTS SHOWN HEREON ARE HEREBY DEDICATED FOR PUBLIC UTILITIES, COMMUNICATION SYSTEMS AND OTHER PURPOSES AS SHOWN HEREON. THE ENTITIES RESPONSIBLE FOR PROVIDING THE SERVICES FOR WHICH THE EASEMENTS ARE ESTABLISHED ARE HEREBY GRANTED THE PERPETUAL RIGHT OF INGRESS AND EGRESS FROM AND TO ADJACENT PROPERTIES FOR INSTALLATION, MAINTENANCE AND REPLACEMENT OF UTILITY LINES AND RELATED FACILITIES.

IN WITNESS WHEREOF:

THE FOREMENTIONED ANDREW C. ALM, INC HAS EXECUTED THIS INSTRUMENT THIS ____ DAY OF _____, 2024.

ANDREW C. ALM

NOTARIAL:

STATE OF COLORADO) SS
COUNTY OF EL PASO)

THE FOREGOING INSTRUMENT WAS ACKNOWLEDGED BEFORE ME THIS ____ DAY OF _____, 2024 BY ANDREW C. ALM

MY COMMISSION EXPIRES: _____ NOTARY PUBLIC

Board of County Commissioners Certificate

This plat for (name of subdivision or plat) was approved for filing by the El Paso County, Colorado Board of County Commissioners on the ____ day of _____, 2024, subject to any notes specified hereon and any conditions included in the resolution of approval. The dedications of land to the public (streets, tracts, easements: list those applicable) are accepted, but public improvements thereon will not become the maintenance responsibility of El Paso County until preliminary acceptance of the public improvements in accordance with the requirements of the Land Development Code and Engineering Criteria Manual, and the Subdivision Improvements Agreement.

Chair, Board of County Commissioners _____ DATE _____
DIRECTOR PLANNING AND COMMUNITY DEVELOPMENT _____ DATE _____

RECORDING:

STATE OF COLORADO) SS
COUNTY OF EL PASO)

I HEREBY CERTIFY THAT THIS INSTRUMENT WAS FILED FOR RECORD AT MY OFFICE AT ____ O'CLOCK ____ M., THIS ____ DAY OF _____, 2024, AND IS DULY RECORDED AT RECEPTION NO. _____ OF THE RECORDS OF EL PASO COUNTY, COLORADO.

STEVE SCHLEIKER

BY: _____ COUNTY CLERK AND RECORDER

FEE: _____

SURCHARGE: _____

FEES:

DRAINAGE FEES: _____

BRIDGE FEES: _____

SCHOOL FEES: _____

PARK FEES: _____

PREPARED BY
LWA LAND SURVEYING, INC.

953 E. FILLMORE STREET
COLORADO SPRINGS, COLORADO 80907
Phone (719) 636-5179

FILE NO. MS-23-009
OCTOBER 16, 2023
PROJECT 23054
SHEET 1 OF 1

Please add: Name, address and telephone number of the owner of record in the lower right hand corner.