



October 19, 2024

El Paso County
Planning & Community Development
2880 International Circle, Suite 110
Colorado Springs, CO 80910

Attn.: Project Manager

RE: Dwire Storage Yard Filing No.1
Private Detention/Stormwater Quality Pond 1

Dear Project Manager:

The construction drawings for "Dwire Yard – Stormwater & Detention Pond Plans" were made to construct a water quality and stormwater detention facility and associated outlet works for the development.

Based upon this information and periodic site visits to the project during significant/key phases of the stormwater BMP installation, M&S Civil Consultants, Inc. is of the opinion that the stormwater BMPs have been constructed in general compliance with the approved design plans, and specifications as filed with El Paso County.

Statement Of Engineer In Responsible Charge

To the best of my knowledge, information and belief, for the referenced project above, the improvements have been constructed in general compliance with the approved design plans and specifications as filed with El Paso County to provide the required storage volume and meet the required release rates documented by the SDI design form, the stage areas, elevations and outlet dimensions. In addition, to the best of my knowledge, information and belief, for the referenced project above, the site and adjacent properties (as affected by work performed under the County permit) are stable with respect to settlement and subsidence, sloughing of cut and fill slopes, revegetation or other ground cover, and that the improvements (public improvements, common development improvements, site grading and paving) meet or exceed the minimum design requirements.

Virgil A. Sanchez
Colorado P.E. No.37160
For and on behalf of M&S Civil Consultants, Inc.



DWIRE YARD - STORMWATER & DETENTION POND PLANS

EL PASO COUNTY, STATE OF COLORADO

A PORTION OF THE SOUTHWEST QUARTER OF SECTION 28, TOWNSHIP 13 SOUTH, RANGE 65 WEST OF THE 6TH PRINCIPAL MERIDIAN,

AS-BUILT ENGINEERING RECORD DRAWINGS



AGENCIES:

OWNER/DEVELOPER: DL HOLDINGS LLC
6547 N. ACADEMY BLVD #523
COLORADO SPRINGS, CO 80918
JEFF DWIRE (719) 574-7123

CIVIL ENGINEER: M & S CIVIL CONSULTANTS, INC.
102 E. PIKES PEAK AVE. SUITE 500
COLORADO SPRINGS, CO 80903
VIRGIL A. SANCHEZ P.E. (719) 955-5485

COUNTY ENGINEERING: EL PASO COUNTY PLANNING AND COMMUNITY
DEVELOPMENT DEPARTMENT
2880 INTERNATIONAL CIRCLE, SUITE 110
COLORADO SPRINGS, CO 80910
JEFF RICE, P.E. (719) 520-6300


WATER RESOURCES: CHEROKEE METRO DISTRICT
6250 PALMER PARK, BLVD
COLORADO SPRINGS, CO 80915
JEFF MUNGER (719) 597-5080

FIRE DISTRICT: FALCON FIRE DISTRICT
7030 OLD MERIDIAN ROAD
FALCON, CO 80831
CHIEF TRENT HARWIG (719) 495-4050

GAS DEPARTMENT: COLORADO SPRINGS UTILITIES
7710 DURANT DR.
COLORADO SPRINGS, CO 80947
TIM WENDT (719) 668-3556

ELECTRIC DEPARTMENT: MOUNTAIN VIEW ELECTRIC
11140 E. WOODMEN ROAD
FALCON, CO 80831
(719) 495-2283

COMMUNICATIONS: QWEST COMMUNICATIONS
(U.N.C.C. LOCATORS) (800) 922-1987
AT&T (LOCATORS) (719) 635-3674

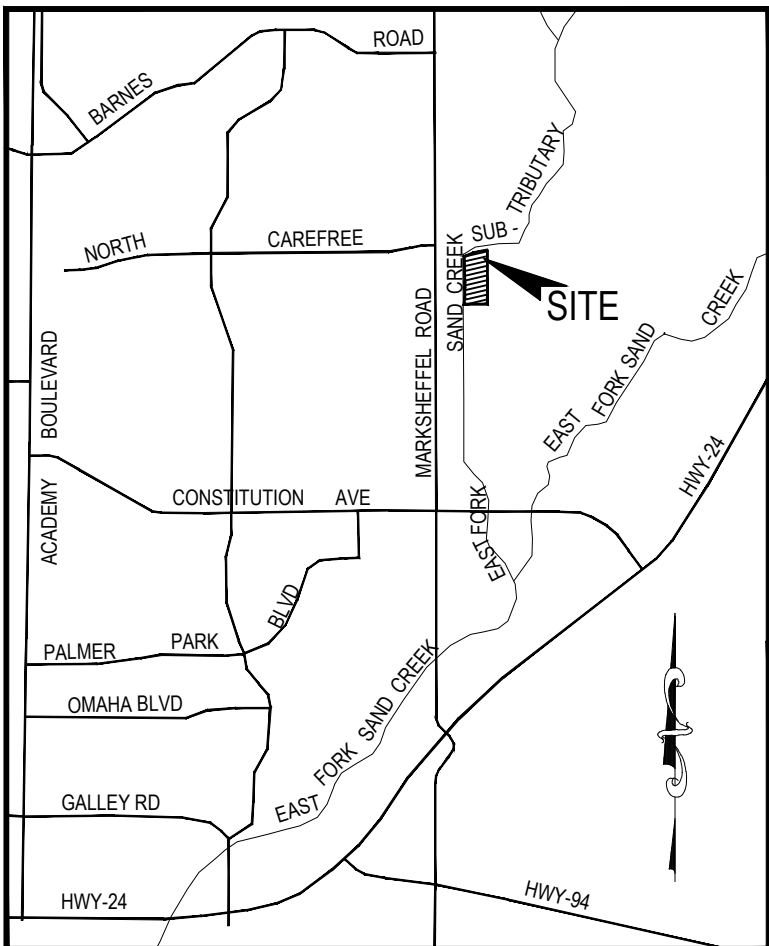

VICINITY MAP
N.T.S.

DESIGN ENGINEER'S STATEMENT

THESE DETAILED PLANS AND SPECIFICATIONS WERE PREPARED UNDER MY DIRECTION AND SUPERVISION. SAID PLANS AND SPECIFICATIONS HAVE BEEN PREPARED ACCORDING TO THE CRITERIA ESTABLISHED BY THE COUNTY FOR DETAILED ROADWAY, DRAINAGE, GRADING AND EROSION CONTROL PLANS AND SPECIFICATIONS, AND SAID PLANS AND SPECIFICATIONS ARE IN CONFORMITY WITH APPLICABLE MASTER DRAINAGE PLANS AND MASTER TRANSPORTATION PLANS. SAID PLANS AND SPECIFICATIONS MEET THE PURPOSES FOR WHICH THE PARTICULAR ROADWAY AND DRAINAGE FACILITIES ARE DESIGNED AND ARE CORRECT TO THE BEST OF MY KNOWLEDGE AND BELIEF. I ACCEPT RESPONSIBILITY FOR ANY LIABILITY CAUSED BY ANY NEGLIGENT ACTS, ERRORS OR OMISSIONS ON MY PART IN PREPARATION OF THESE DETAILED PLANS AND SPECIFICATIONS.




1-29-21

VIRGIL A. SANCHEZ, COLORADO P.E. #37160
FOR AND ON BEHALF OF M & S CIVIL CONSULTANTS, INC.

DATE

OWNER/DEVELOPER'S STATEMENT:

I, THE OWNER/DEVELOPER HAVE READ AND WILL COMPLY WITH ALL OF THE REQUIREMENTS SPECIFIED IN THESE DETAILED PLANS AND SPECIFICATIONS.

NAME:  2-1-21
DATE

DL Holdings, LLC
BUSINESS NAME:

6799 Bismark Rd. Suite A Colorado Springs, CO 80918
ADDRESS:

EL PASO COUNTY:

COUNTY PLAN REVIEW IS PROVIDED ONLY FOR GENERAL CONFORMANCE WITH COUNTY DESIGN CRITERIA. THE COUNTY IS NOT RESPONSIBLE FOR THE ACCURACY AND ADEQUACY OF THE DESIGN, DIMENSIONS, AND/OR ELEVATIONS WHICH SHALL BE CONFIRMED AT THE JOB SITE. THE COUNTY THROUGH THE APPROVAL OF THIS DOCUMENT ASSUMES NO RESPONSIBILITY FOR COMPLETENESS AND/OR ACCURACY OF THIS DOCUMENT.


FILED IN ACCORDANCE WITH THE REQUIREMENTS OF THE EL PASO COUNTY LAND DEVELOPMENT CODE, DRAINAGE CRITERIA, AND ENGINEERING CRITERIA MANUAL AS AMENDED.

IN ACCORDANCE WITH ECM SECTION 1.12, THESE CONSTRUCTION DOCUMENTS WILL BE VALID FOR CONSTRUCTION FOR A PERIOD OF 2 YEARS FROM THE DATE SIGNED BY THE EL PASO COUNTY ENGINEER. IF CONSTRUCTION HAS NOT STARTED WITHIN THOSE 2 YEARS, THE PLANS WILL NEED TO BE RESUBMITTED FOR APPROVAL, INCLUDING PAYMENT OF REVIEW FEES AT THE PLANNING AND COMMUNITY DEVELOPMENT DIRECTOR'S DISCRETION.

JENNIFER IRVINE, P.E.
COUNTY ENGINEER / ECM ADMINISTRATOR

APPROVED
Engineering Department
03/17/2021 12:26:08 PM
dsdnijkamp
EPC Planning & Community
Development Department

EL PASO COUNTY FILE NO. MS 20-002

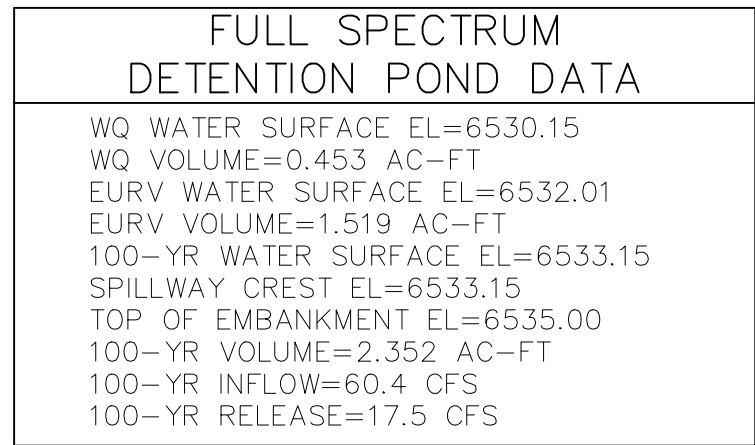

MAINTENANCE & ACCESS ROAD ABOVE EURV TYPICAL SECTION

MAINTENANCE & ACCESS ROAD BELOW EURV TYPICAL SECTION




SCALE 1"=20'

AS-DESIGNED

EPC 3/17/2021


DWIRE STORAGE YARD		SCALE:		DATE: 11/16/2020	
PROJECT NO. 43-117		DESIGNED BY: CMN		HORIZONTAL: 1"=20'	
DRAWN BY: CMN		CHECKED BY: VAS		VERTICAL: N/A	
				SHEET 2 OF 6	
				ST02	

20 BOULDER CRESCENT, SUITE 110
COLORADO SPRINGS, CO 80903
PHONE: 719.955.5485



FOR AND ON
BEHALF OF
M&S CIVIL
CONSULTANTS,
INC.

[illegible]

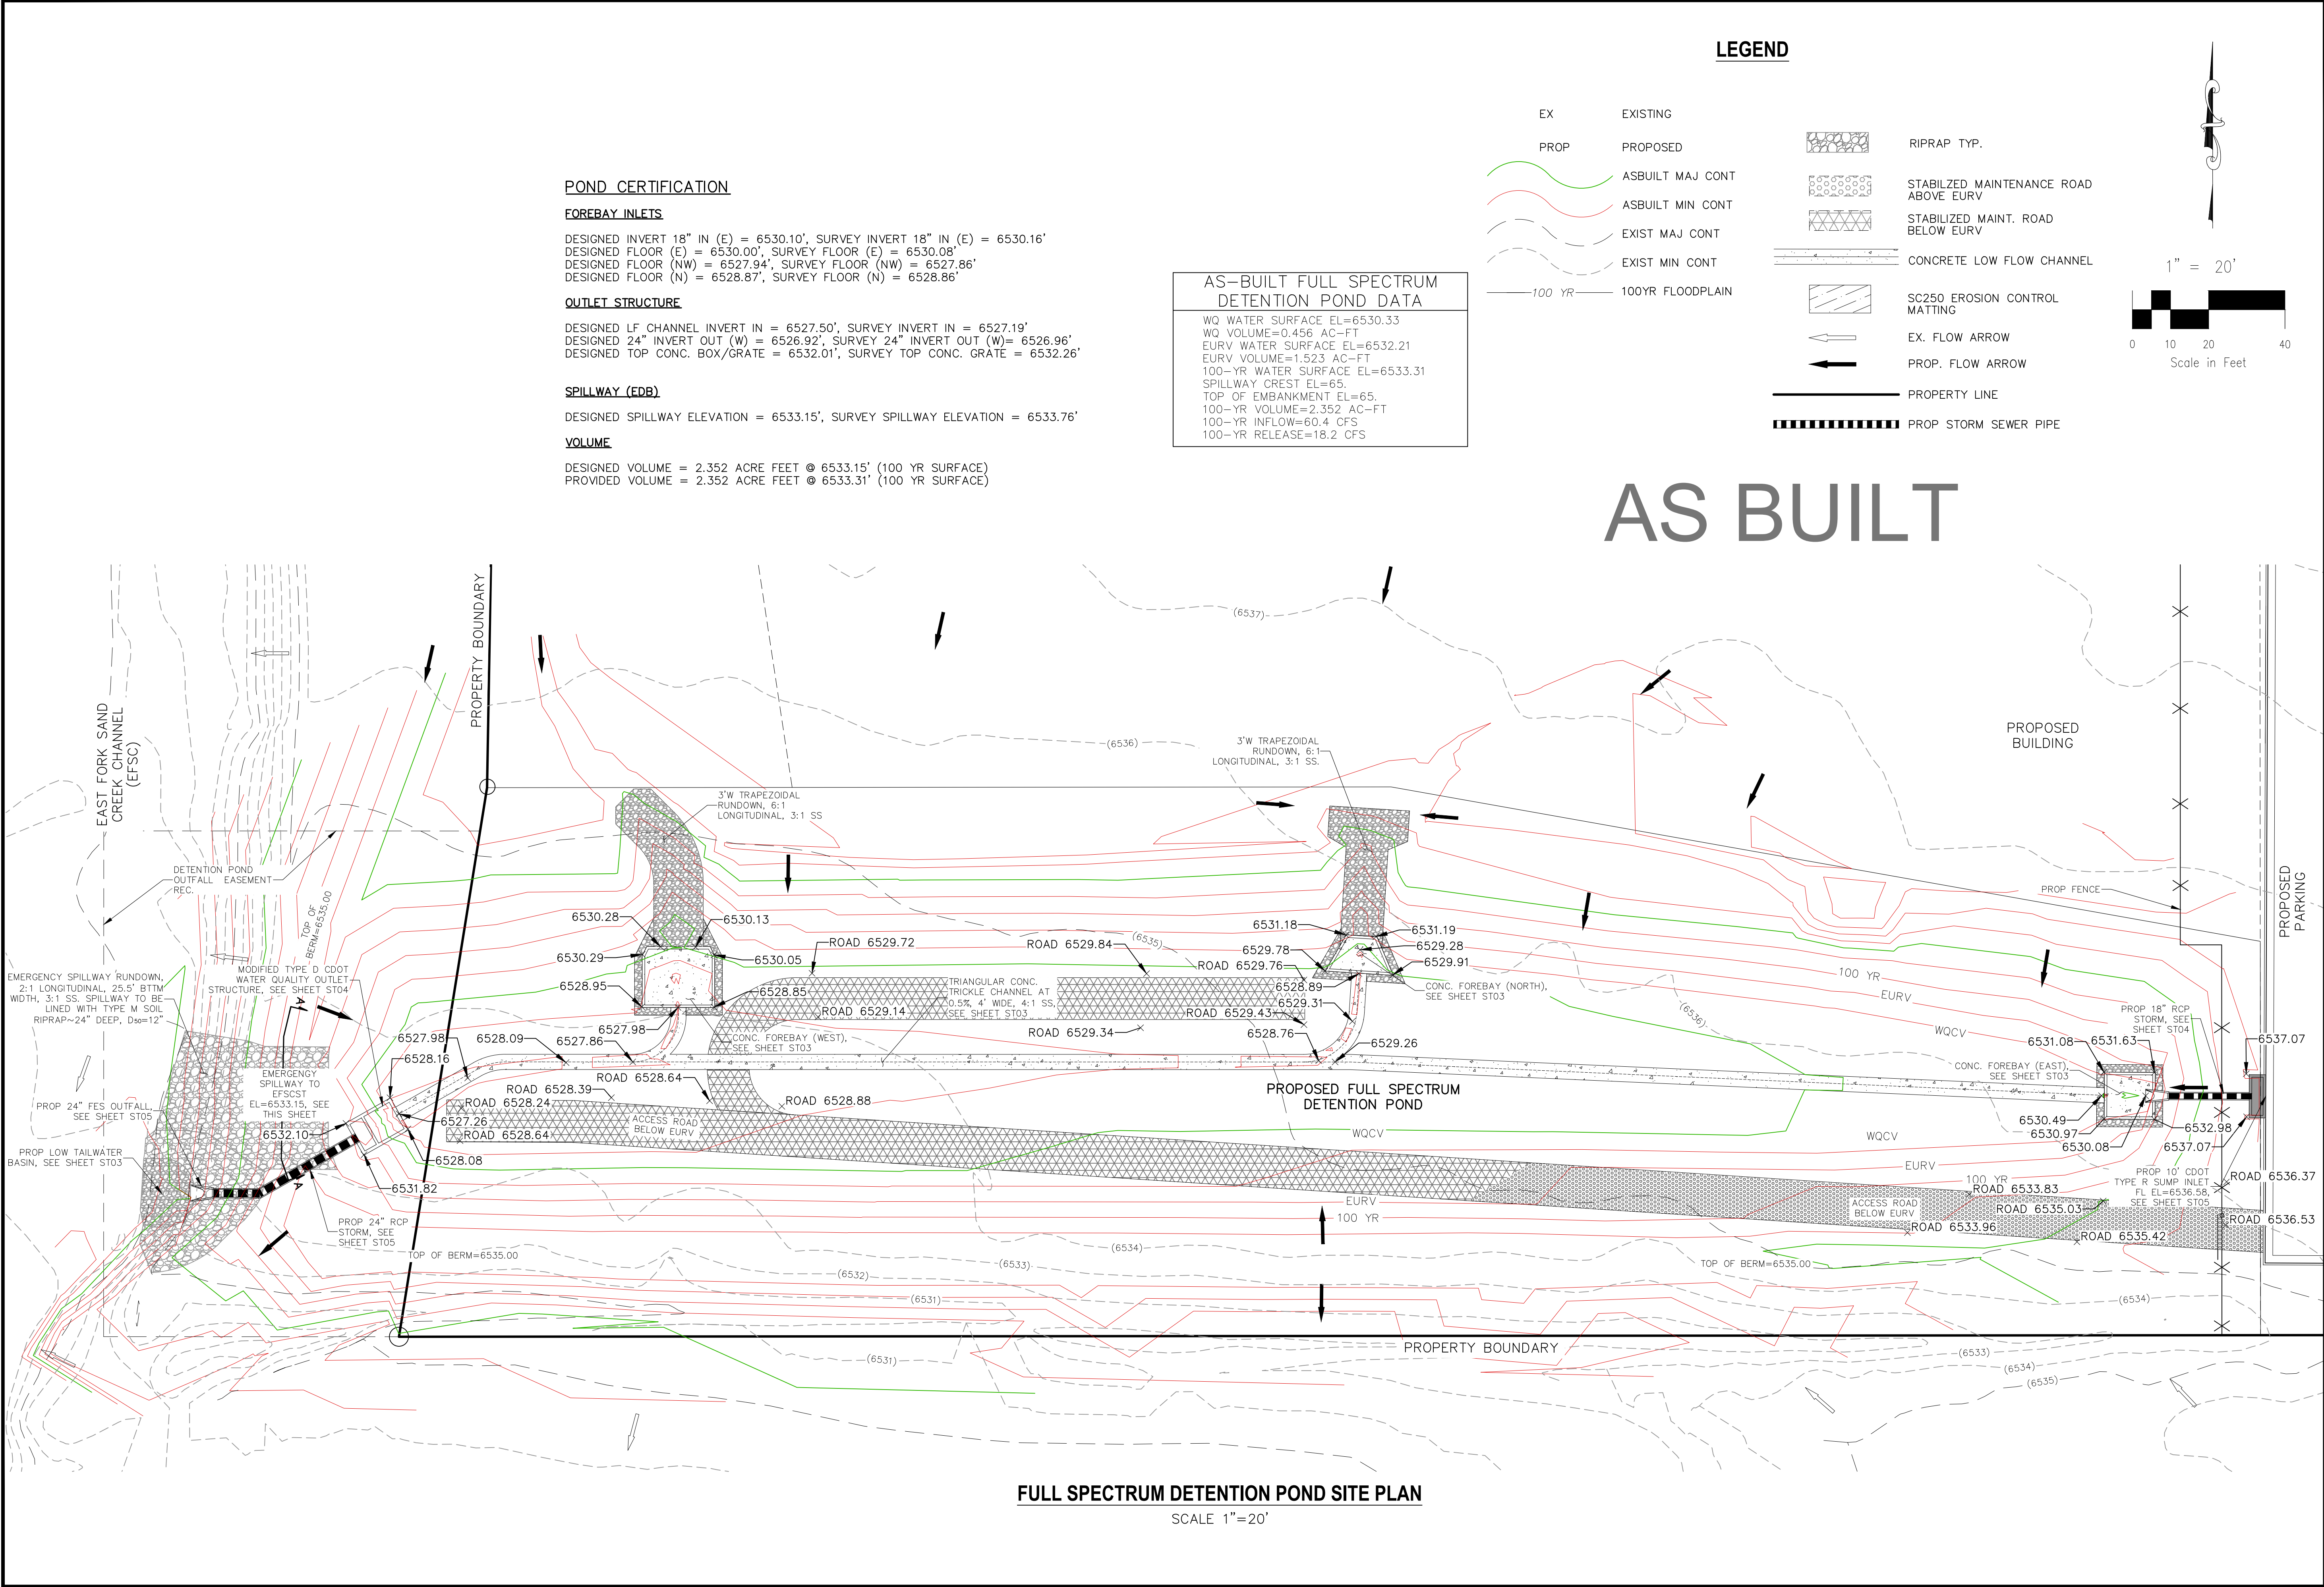

DWIRE STORAGE YARD

FULL SPECTRUM DETENTION POND SITE PLAN

PROJECT NO. 43-117

DATE: 05/18/2022

SCALE: HORIZONTAL: 1"=20' VERTICAL: N/A

DESIGNED BY: CWN

DRAWN BY: CWN

CHECKED BY: VAS

SHEET 3 OF

ST02AB

212 N. WAHATCH AVE., STE 305
COLORADO SPRINGS, CO 80903
PHONE: 719.955.5485


CIVIL CONSULTANTS, INC.

FOR AND ON BEHALF OF
VAS CIVIL CONSULTANTS, INC.


REVISIONS:
NO. DATE BY DESCRIPTION
1
2
THE ENGINEER PREPARING THESE PLANS WILL NOT BE RESPONSIBLE, OR LIABLE FOR, UNAUTHORIZED CHANGES TO OR USES OF THESE PLANS. ALL CHANGES TO THE PLANS MUST BE IN WRITING AND MUST BE APPROVED BY THE PREPARER OF THESE PLANS.


CAUTION

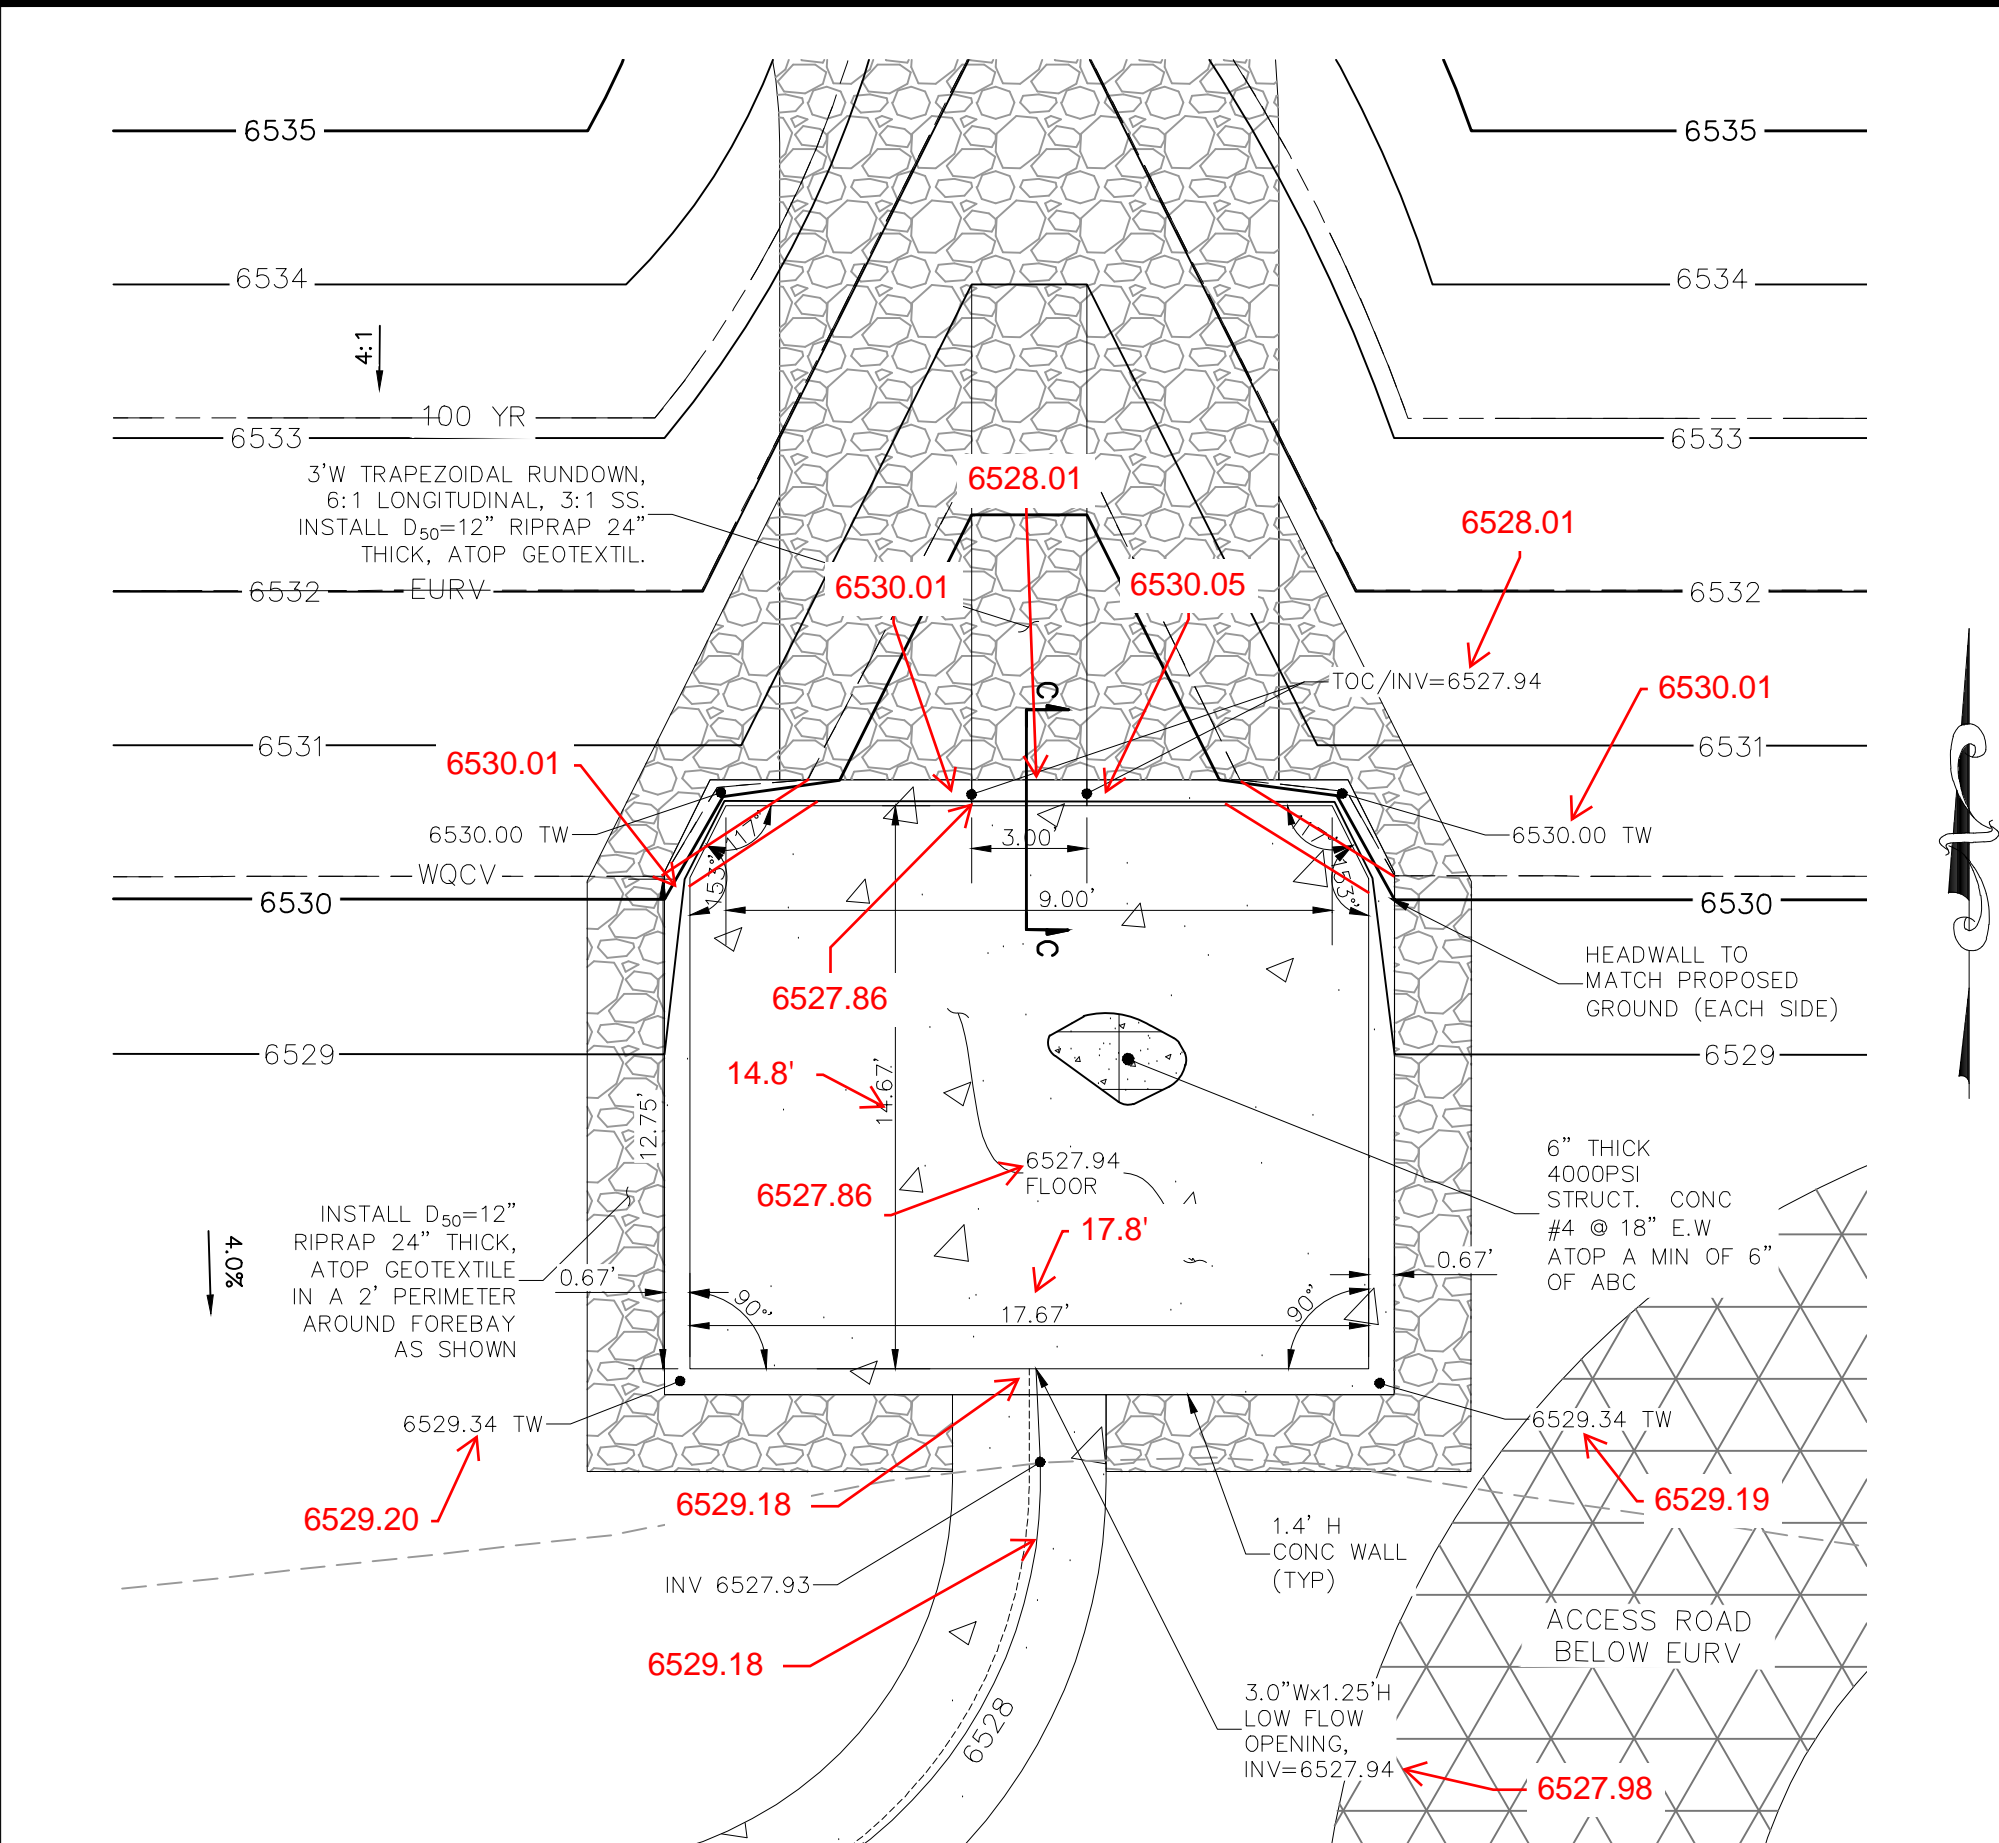

SECTION C-C
W FOREBAY RIPRAP RUNDOWN/FOREBAY INTERFACE
NOT TO SCALE

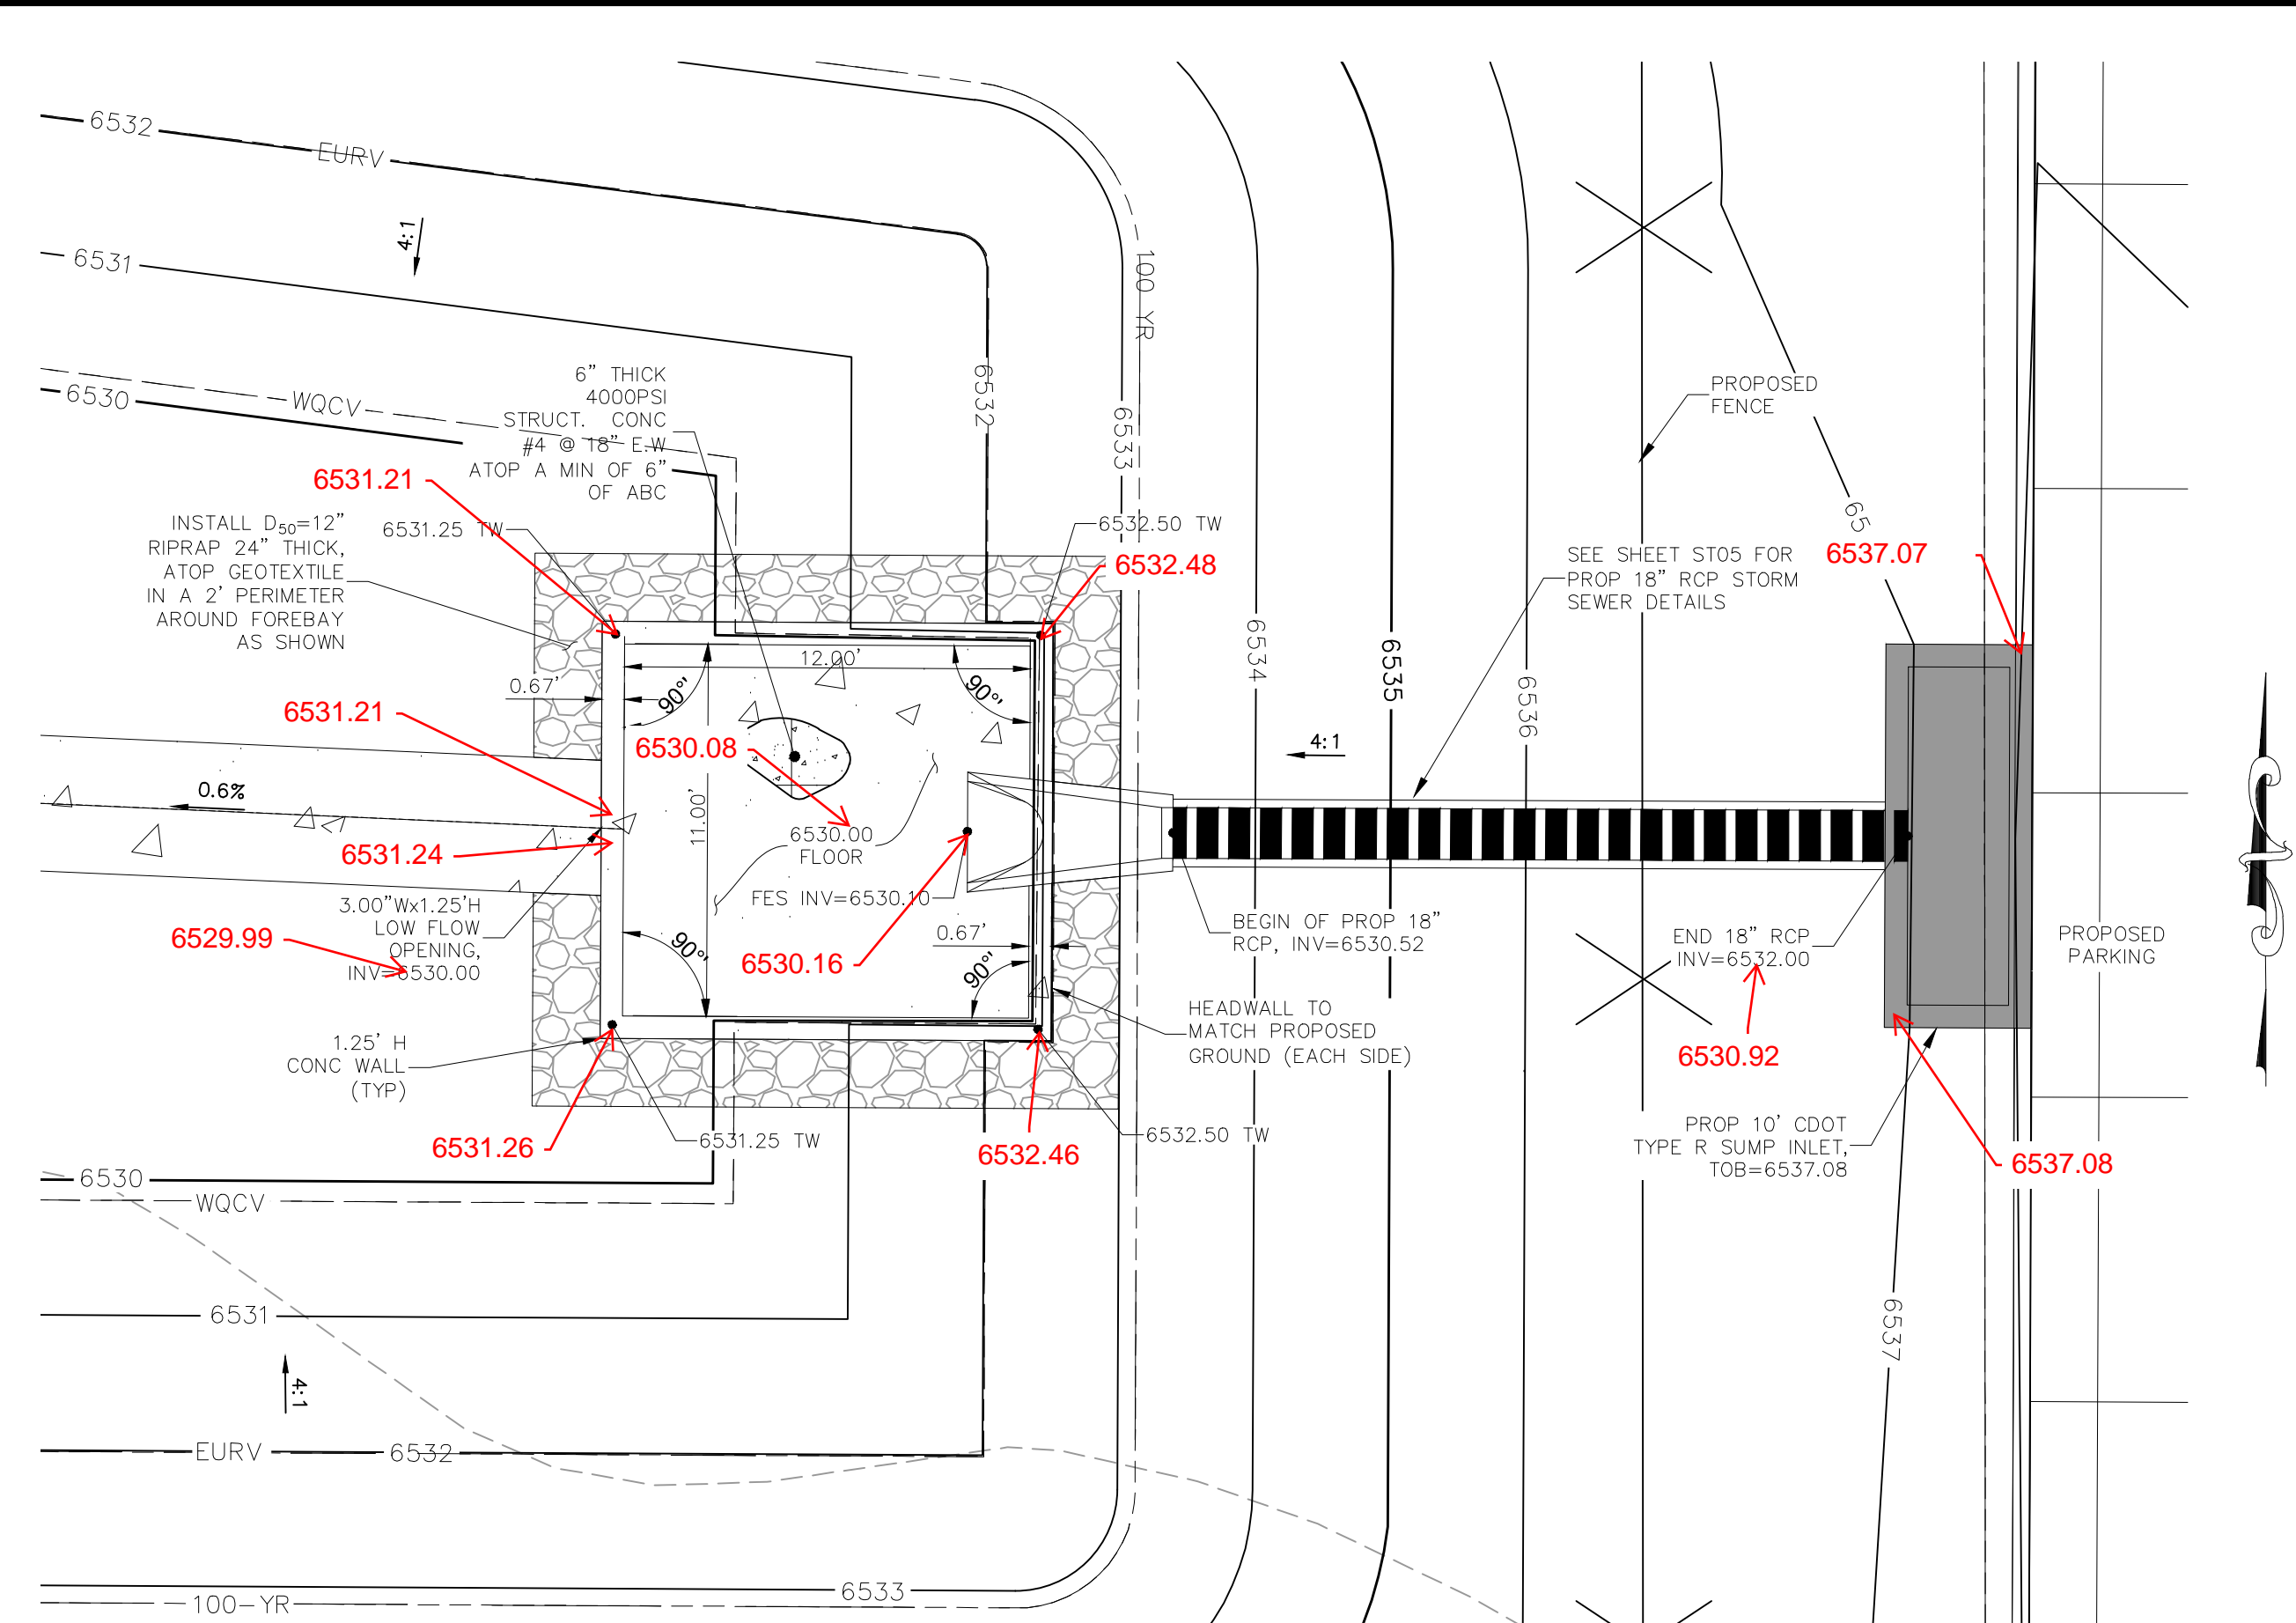

AS-BUILT ENGINEERING RECORD DRAWINGS

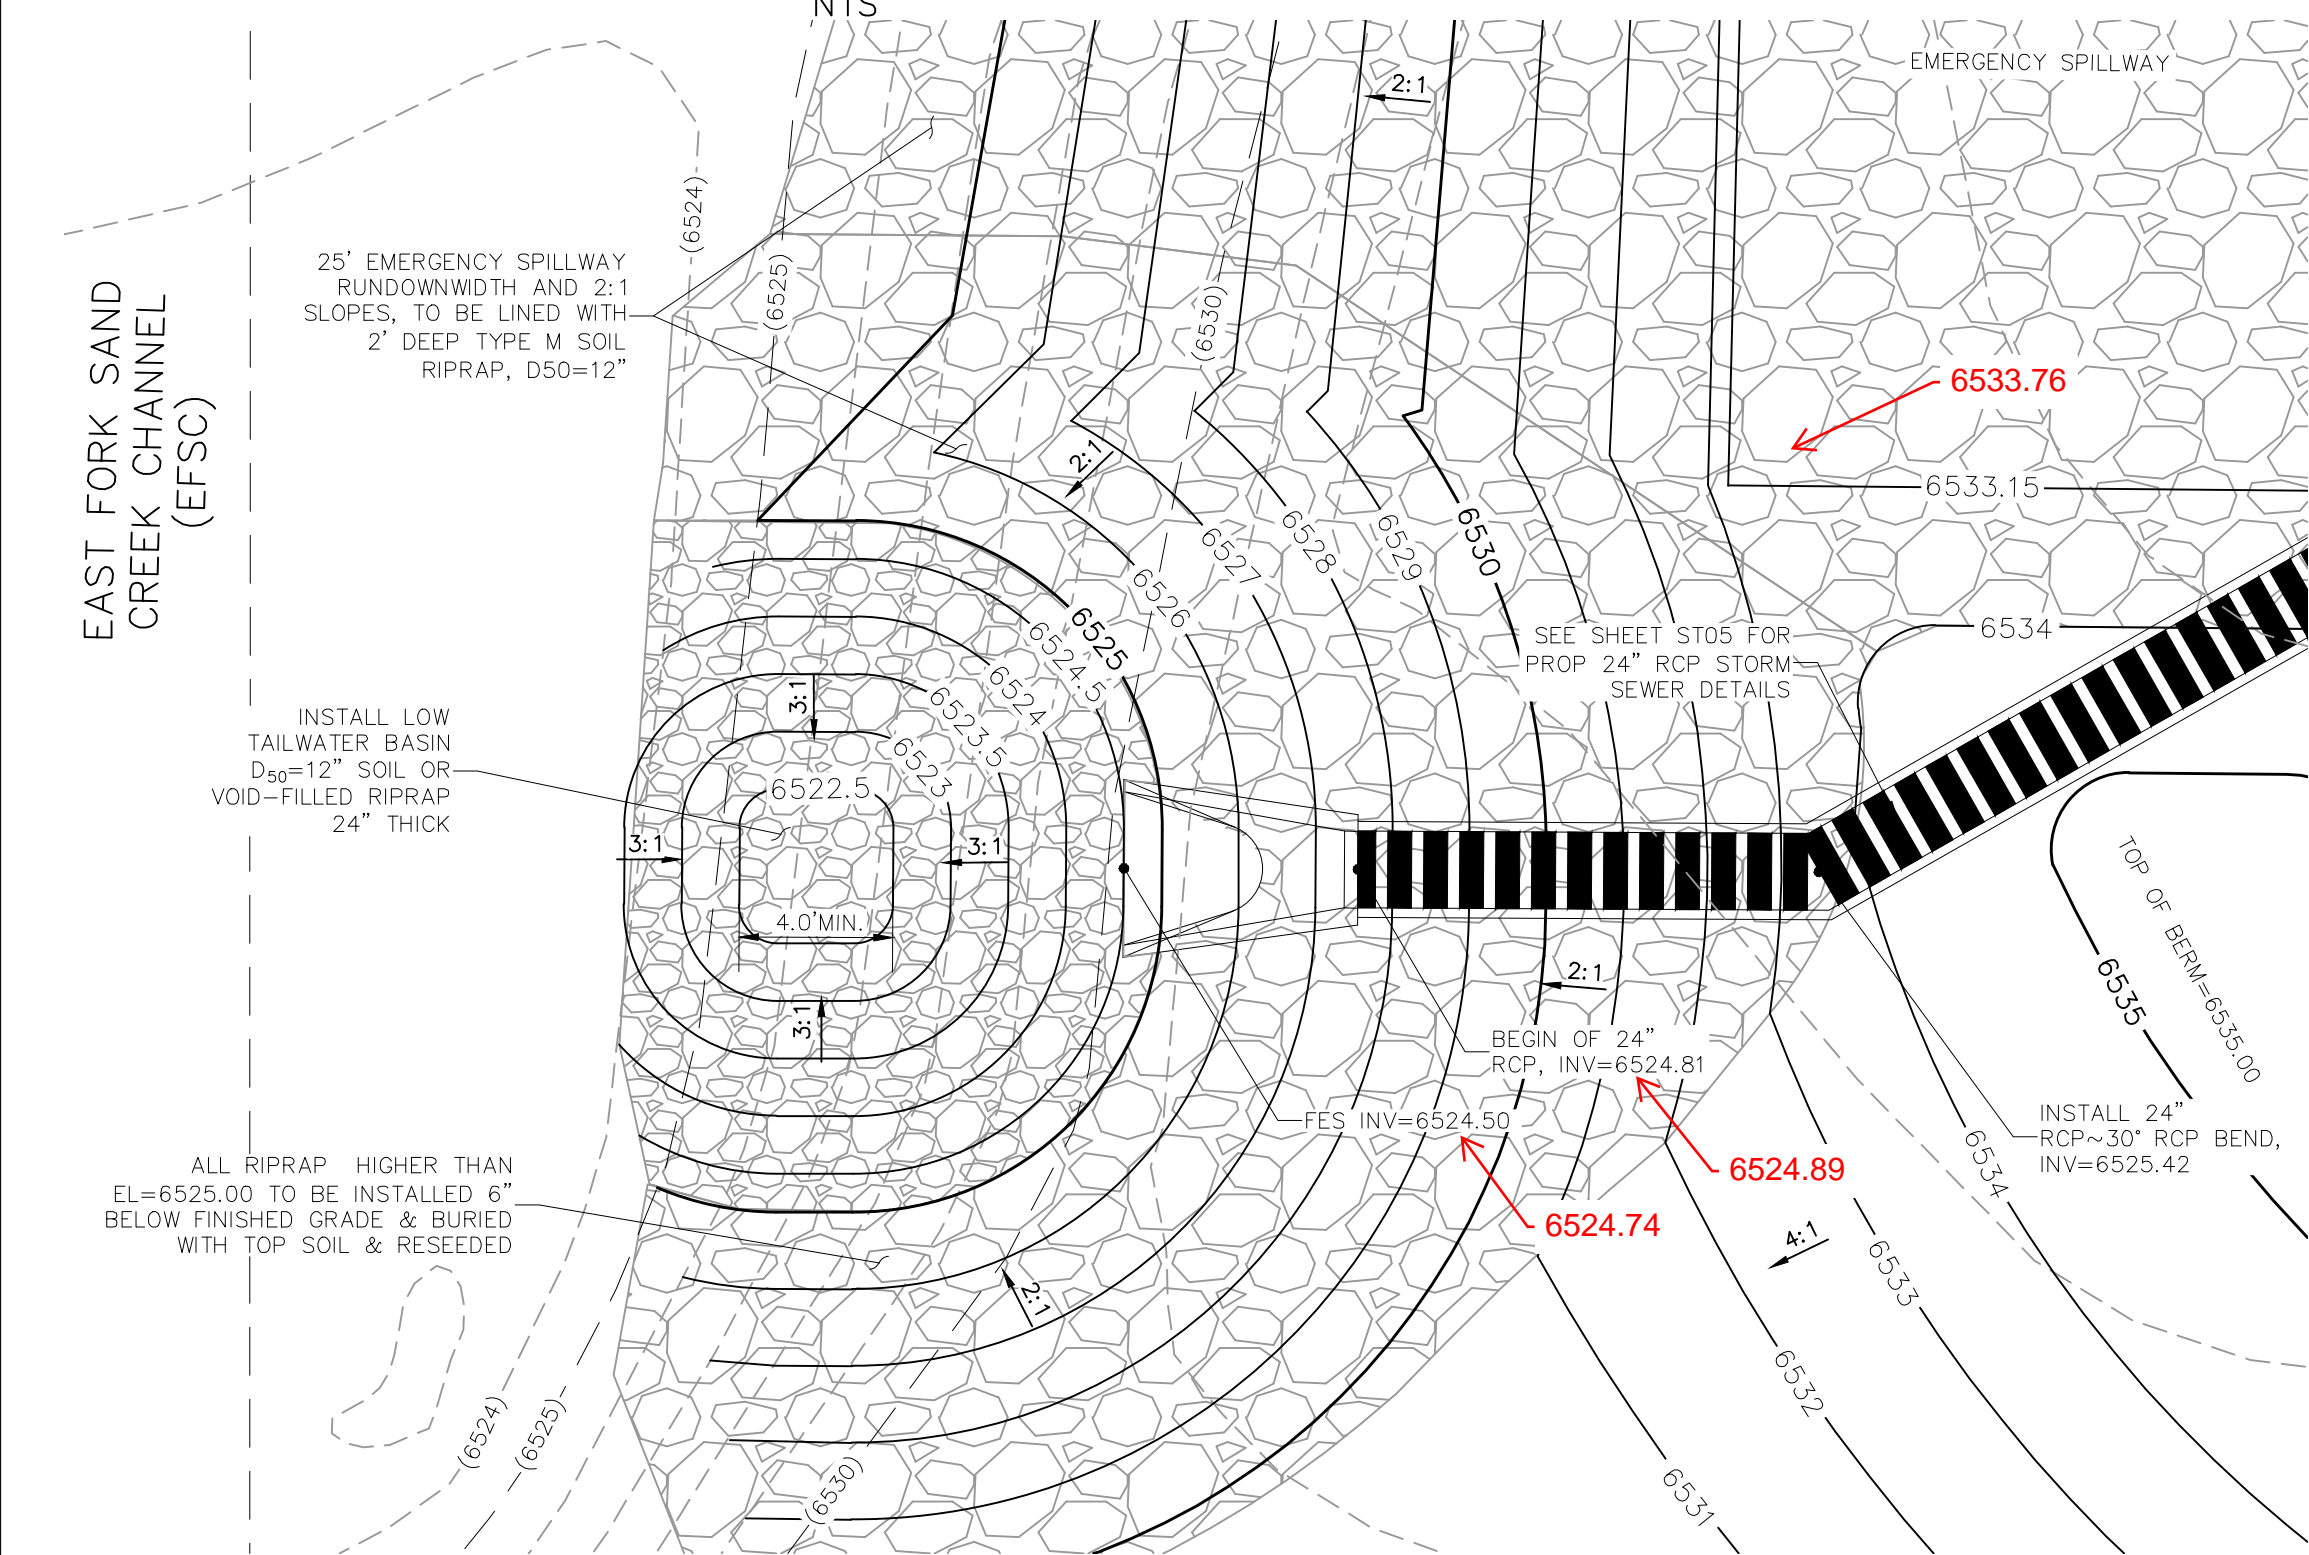

24" RCP OUTFALL TO EFSC
NTS



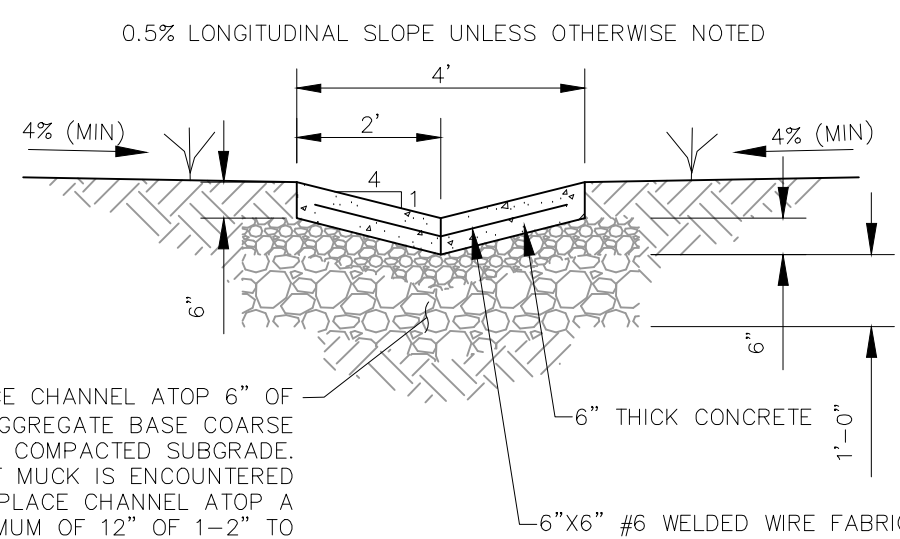



TABLE 1		
FOREBAY	WIDTH (W)	HEIGHT (H)
WEST	3.0' IN	1.4 FT
NORTH	3.0' IN	1.10 FT
EAST	3.0' IN	1.25 FT

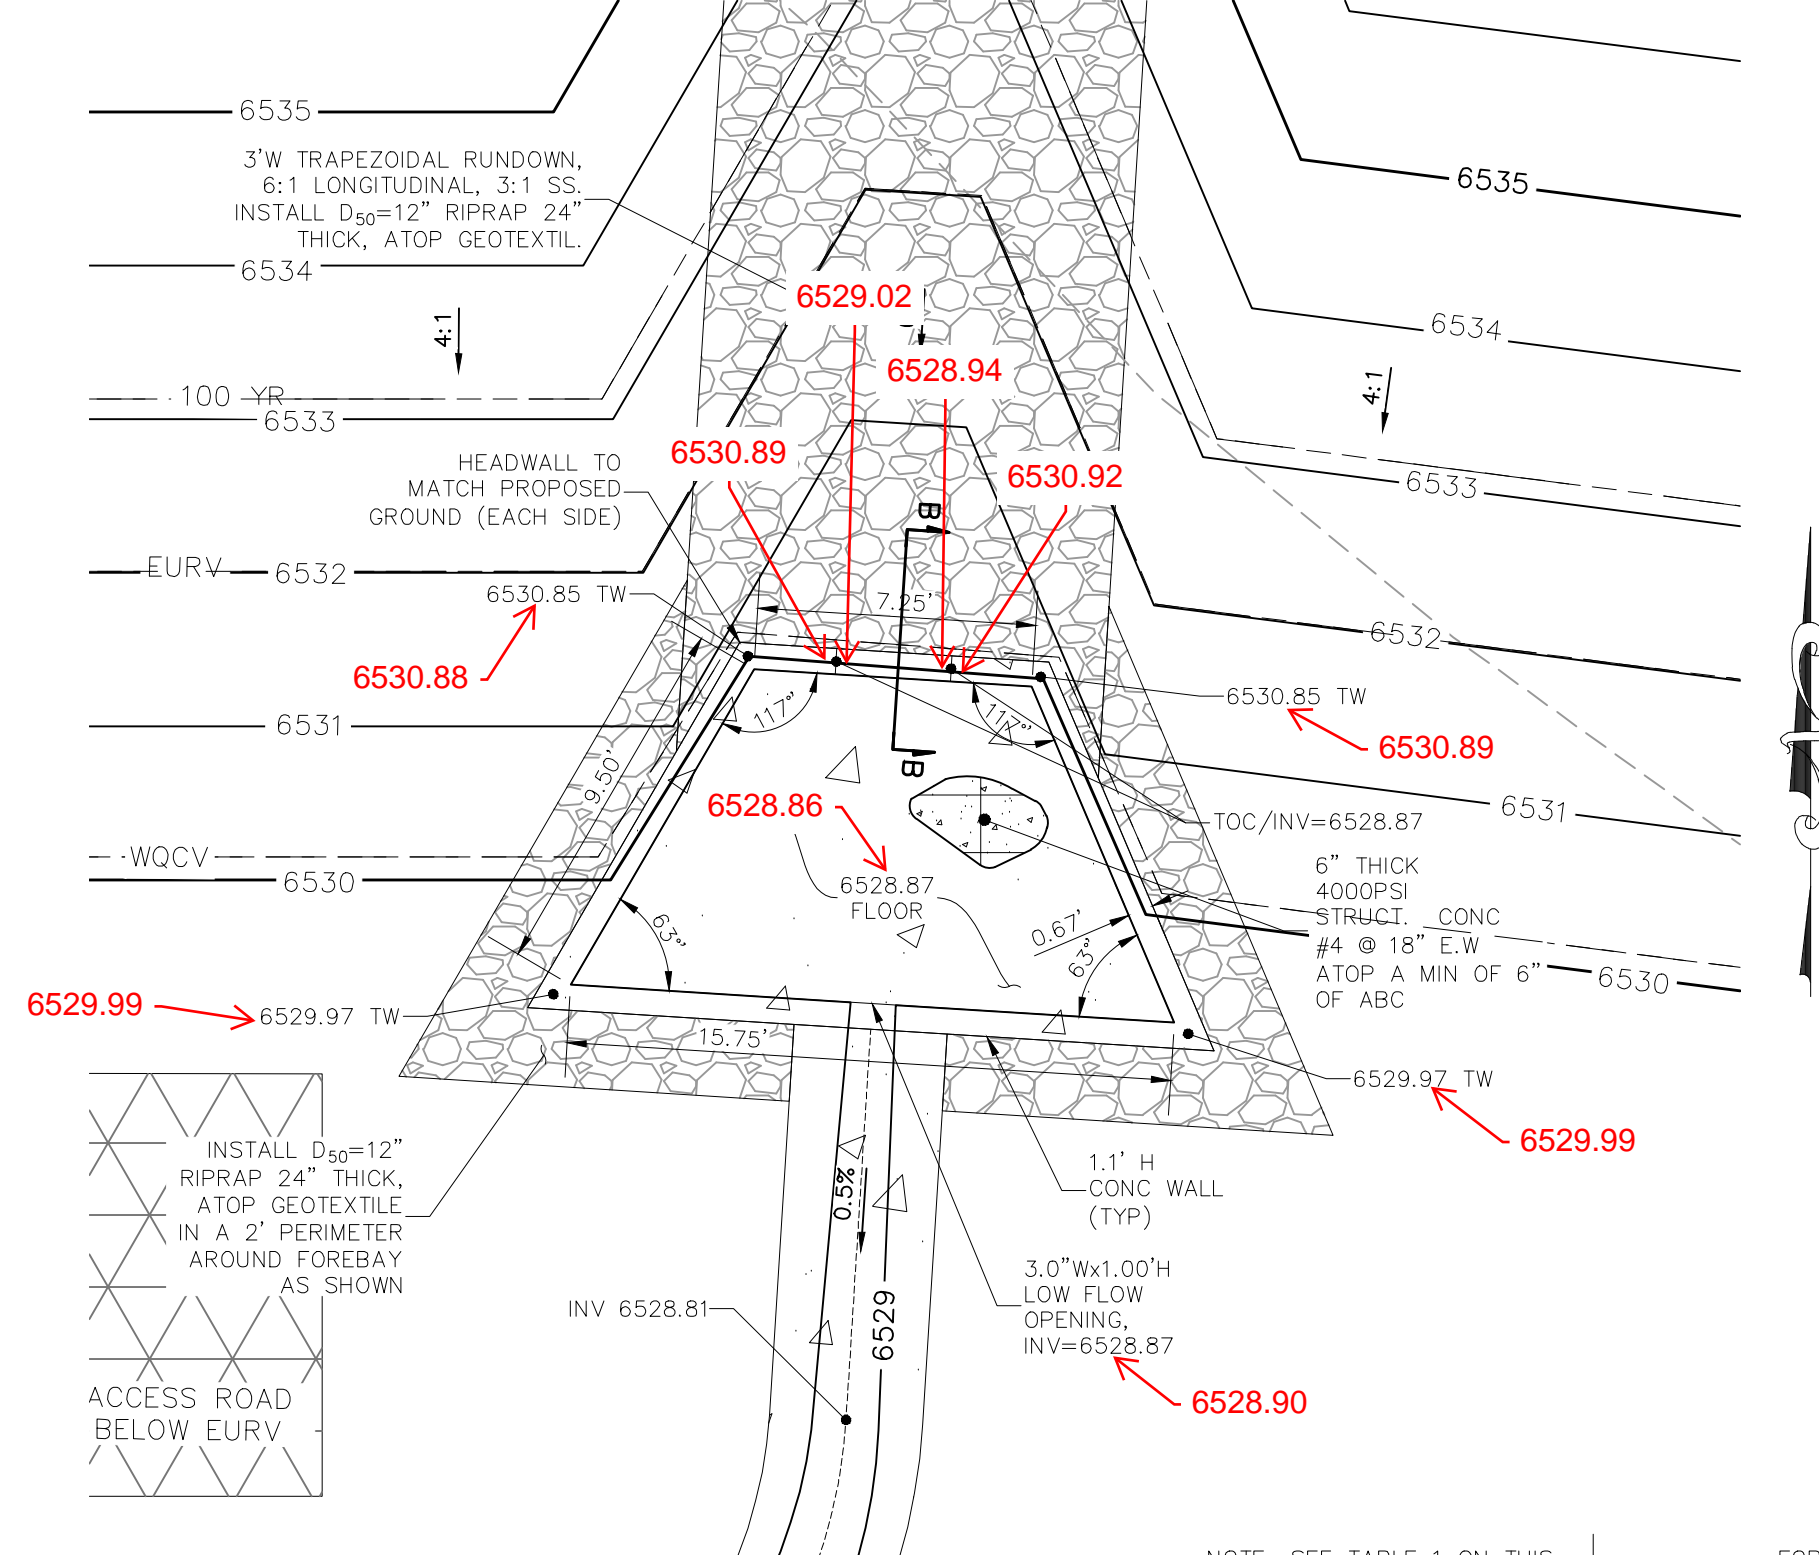

NORTH FOREBAY
NTS

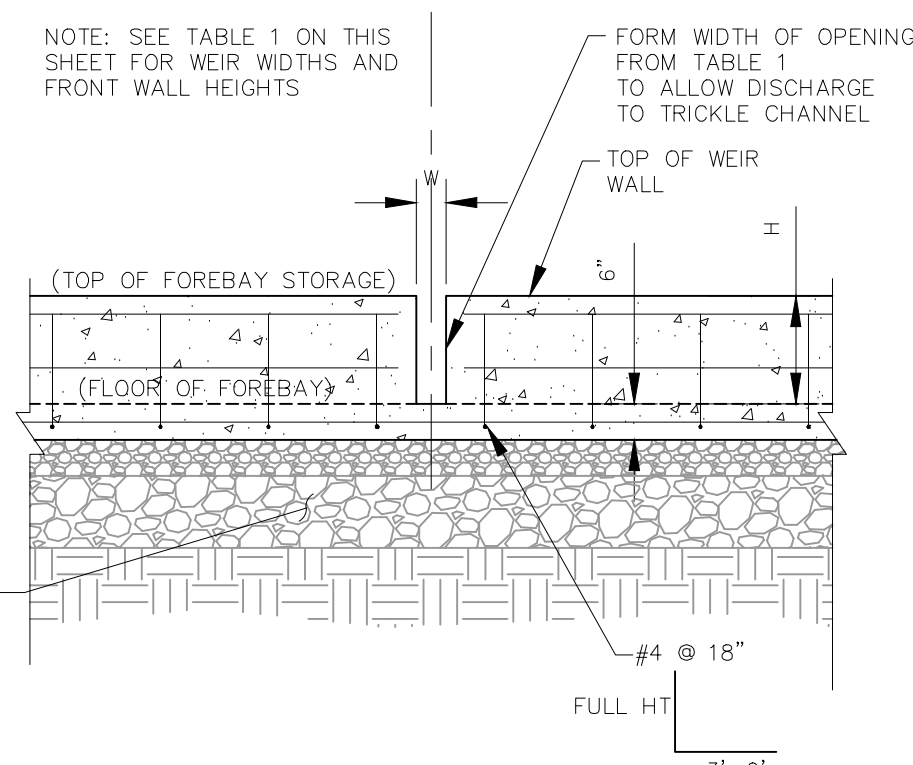

SECTION B-B
N FOREBAY RIPRAP RUNDOWN/FOREBAY INTERFACE
NOT TO SCALE

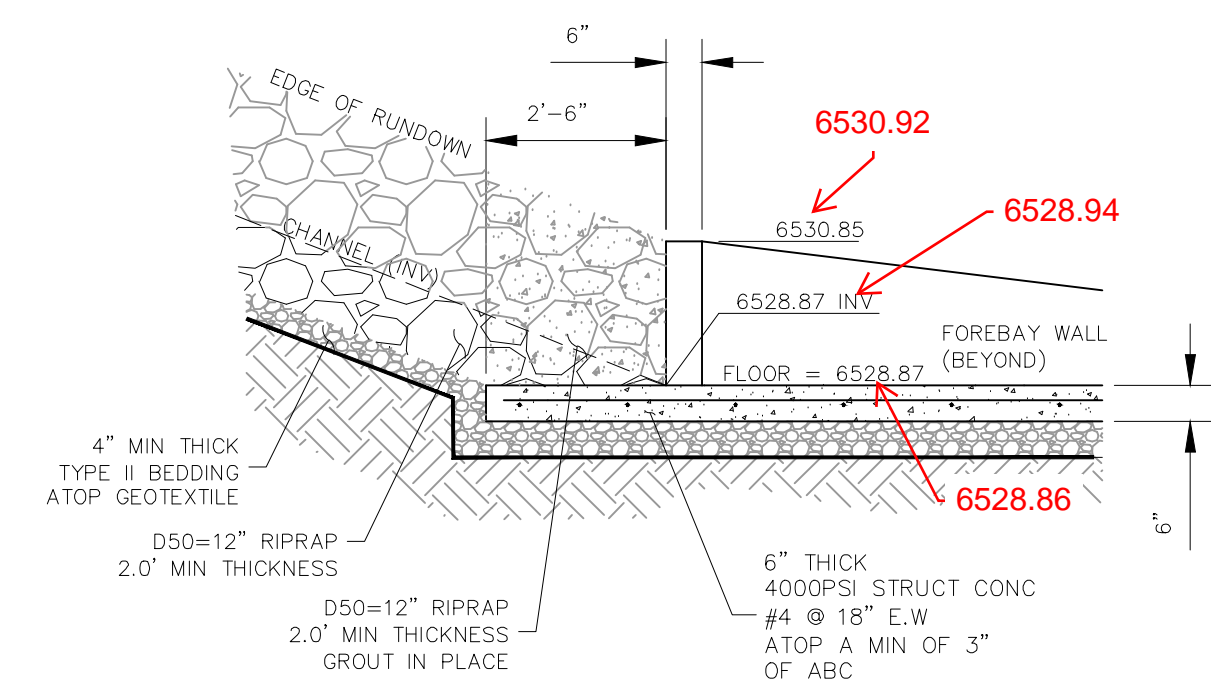

LEGEND

EX	EXISTING		STABILIZED MAINTENANCE ROAD ABOVE EURV
PROP	PROPOSED		STABILIZED MAINT. ROAD BELOW EURV
	PROP MAJ CONT		CONCRETE LOW FLOW CHANNEL
	PROP MIN CONT		SC250 EROSION CONTROL MATTING
	EXIST MAJ CONT		EX. FLOW ARROW
	EXIST MIN CONT		PROP. FLOW ARROW
	100YR FLOODPLAIN		PROPERTY LINE
	RIPRAP TYP.		PROP STORM SEWER PIPE EPC 3/17/2021

STATEMENT:

THE CITY OF COLORADO SPRINGS RECOGNIZES THE DESIGN ENGINEER AS HAVING RESPONSIBILITY FOR THE DESIGN; THE CITY HAS LIMITED ITS SCOPE OF REVIEW ACCORDINGLY. RESUBMITTAL REQUIRED IF CONSTRUCTION HAS NOT COMMENCED WITHIN 180 DAYS AFTER APPROVAL DATE.

FOR LOCATING & MARKING GAS, ELECTRIC, WATER & TELEPHONE LINES

FOR BURIED UTILITY INFORMATION
48 HRS BEFORE YOU DIG
CALL 1-800-922-1987

DWIRE STORAGE YARD

FSD FOREBAY AND OUTFALL DETAILS

PROJECT NO. 43-117
DATE: 05/21/2020
SCALE: N/A
DESIGNED BY: CMN
DRAWN BY: CMN
CHECKED BY: VAS

SHEET 3 OF 6
ST03

20 BOULDER CRESSENT SUITE 110
COLORADO SPRINGS, CO 80903
PHONE: 719.555.5485

CIVIL CONSULTANTS, INC.

FOR AND ON BEHALF OF
M&S CIVIL CONSULTANTS, INC.

Virgil A. Sanchez, P.E. No. 37160

REVISIONS:

NO.	DATE:	BY:	DESCRIPTION:

THE ENGINEER PREPARING THESE PLANS WILL NOT BE RESPONSIBLE FOR UNAUTHORIZED CHANGES TO OR USES OF THESE PLANS. ALL CHANGES TO THE PLANS MUST BE IN WRITING AND MUST BE APPROVED BY THE PREPARER OF THESE PLANS.

CAUTION

File: G:\4317A-Dwire Yard\dwg\Const\DWG\ST05.dwg Plotstamp: 11/16/2020 3:01 PM

STATEMENT:


THE CITY OF COLORADO SPRINGS
RECOGNIZES THE DESIGN ENGINEER
AS HAVING RESPONSIBILITY FOR
THE DESIGN; THE CITY HAS
LIMITED ITS SCOPE OF REVIEW
ACCORDINGLY. RESUBMITTAL
REQUIRED IF CONSTRUCTION HAS
NOT COMMENCED WITHIN 180 DAYS
AFTER APPROVAL DATE.



FOR LOCATING
& MARKING
GAS,
ELECTRIC,
WATER &
TELEPHONE
LINES


FOR BURIED UTILITY INFORMATION
48 HRS BEFORE YOU DIG
CALL 1-800-922-1987

AS-BUILT
ENGINEERING RECORD DRAWINGS

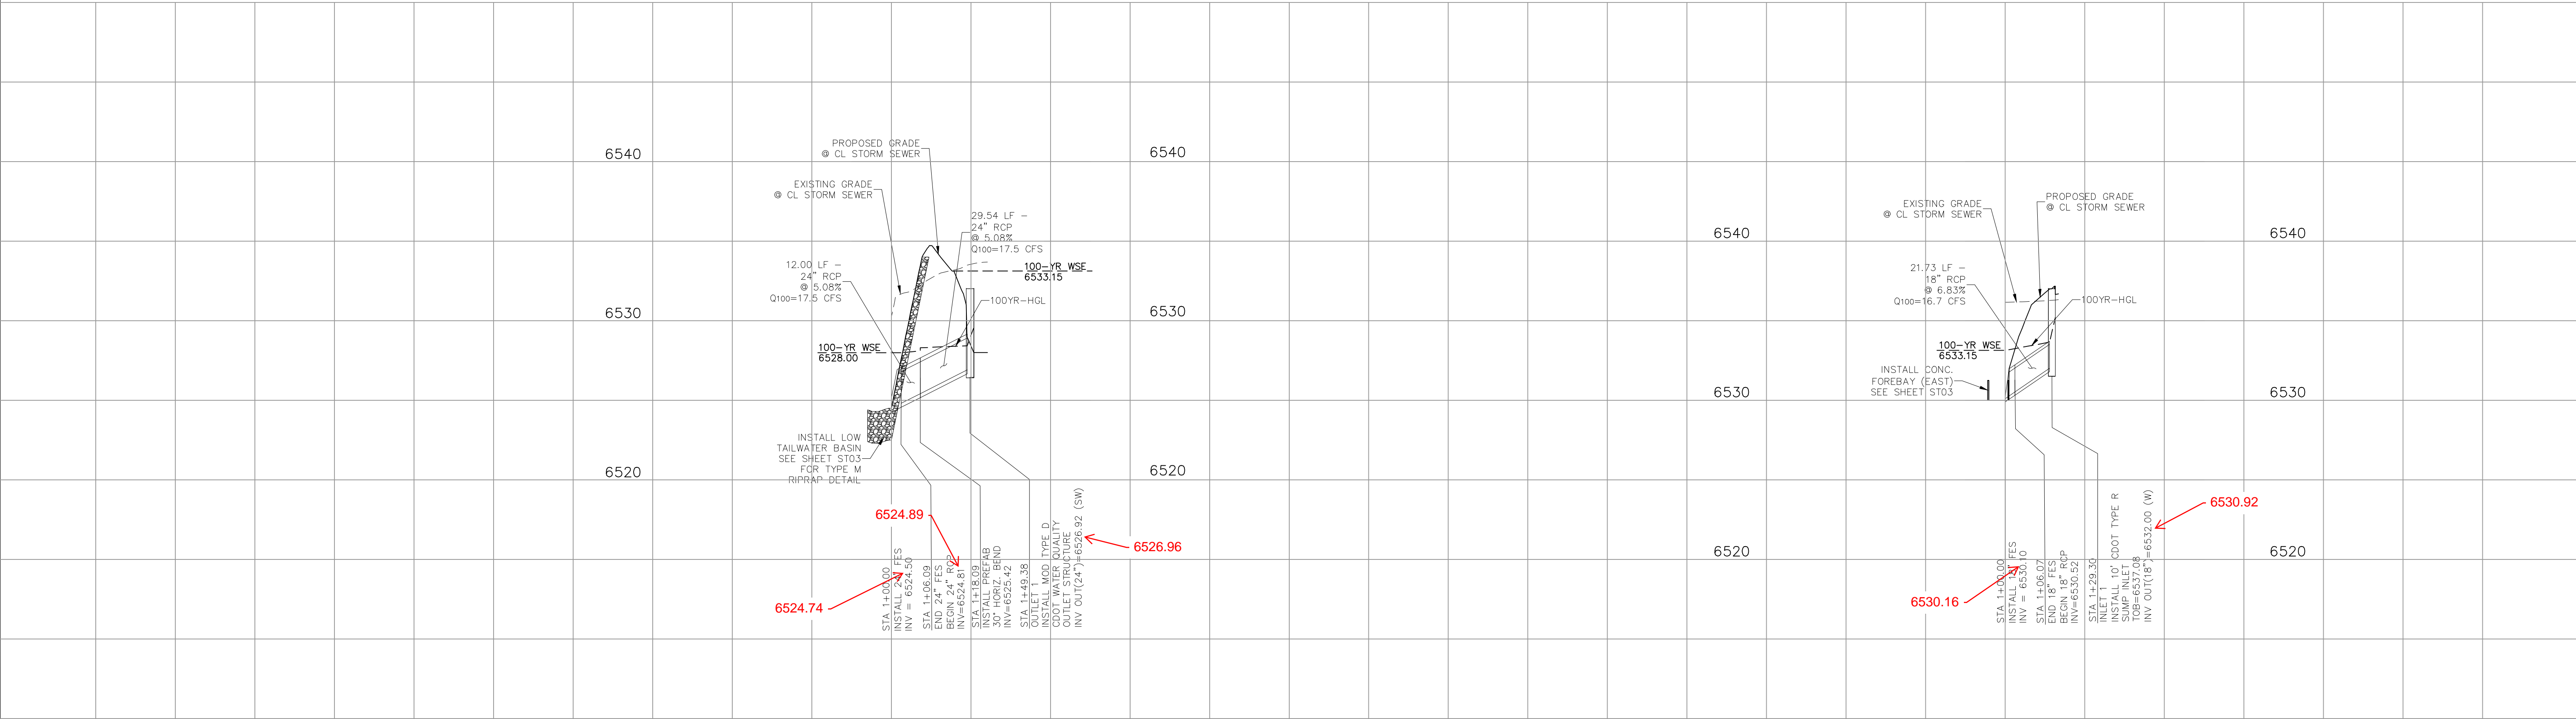


24" RCP OUTFALL STA 1+00.00 TO STA 1+49.38

18" STORM SEWER STA 1+00.00 TO STA 1+29.30

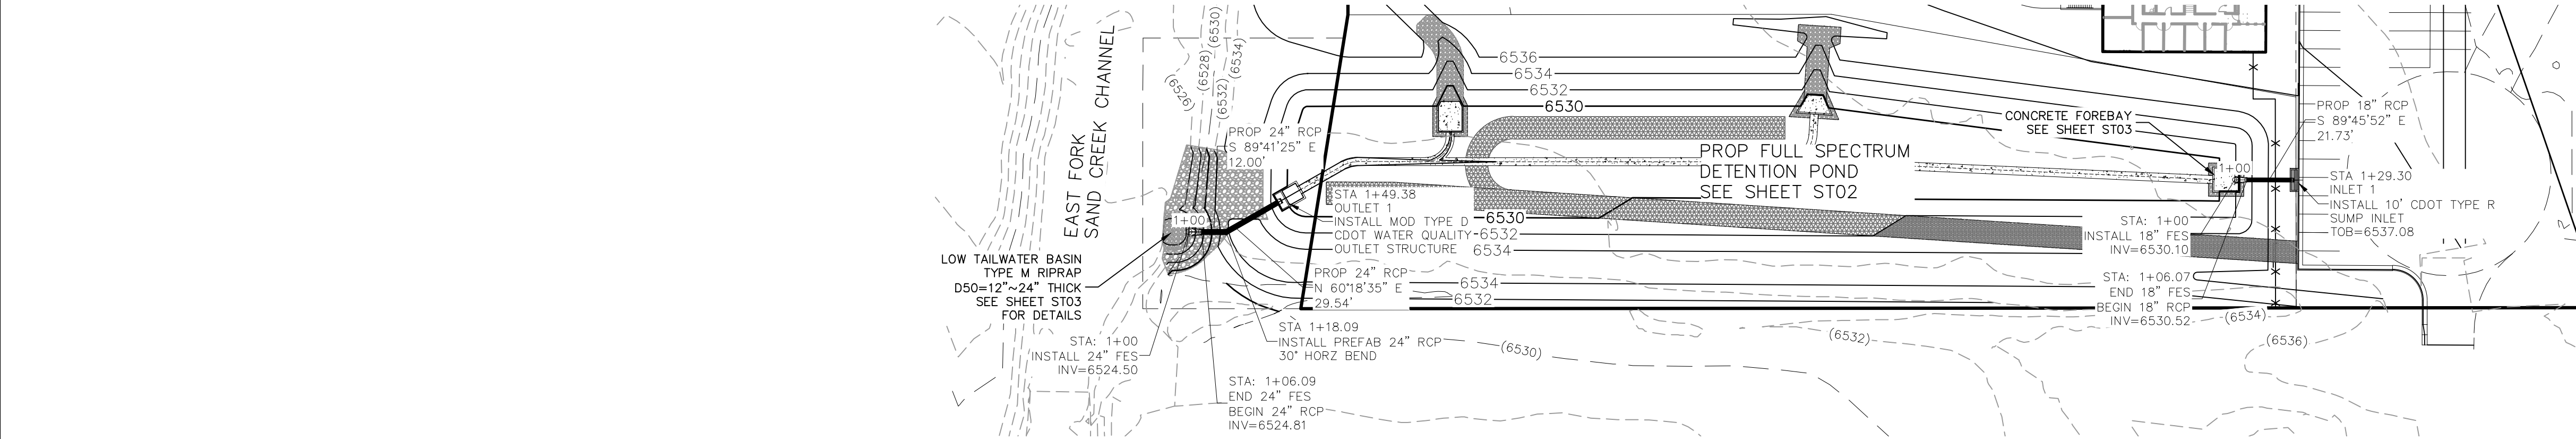

24" RCP OUTFALL STA 1+00.00 TO STA 1+49.38

18" STORM SEWER STA 1+00.00 TO STA 1+29.30

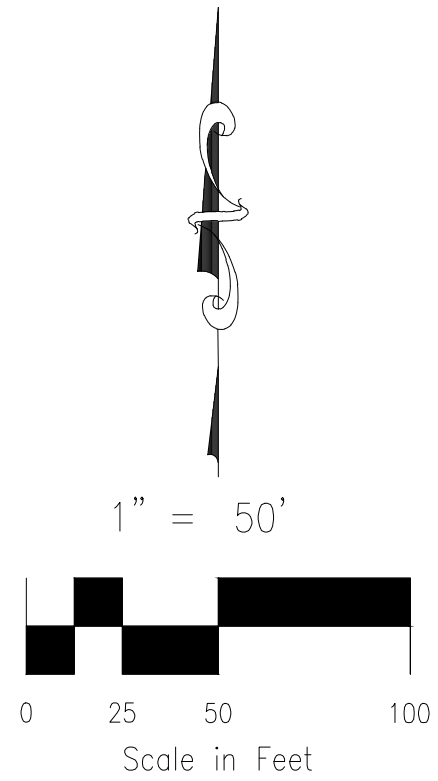

DWIRE STORAGE YARD

STORM SEWER PLAN AND PROFILE

PROJECT NO. 43-117

DATE: 11-16-20

SCALE: HORIZONTAL: 1"=50' VERTICAL: 1"=5'

DESIGNED BY: GT

DRAWN BY: JWP

CHECKED BY: GT

SHEET 5 OF 6

ST05

20 BOULDER CRESCENT, SUITE 110
COLORADO SPRINGS, CO 80903
PHONE: 719.555.5485

CIVIL CONSULTANTS, INC.

FOR AND ON
BEHALF OF
M&S CIVIL
CONSULTANTS,
INC.

REVISIONS:


NO.	DATE:	BY:	DESCRIPTION:	APPROVED BY:	DATE:

THE ENGINEER PREPARING THESE PLANS WILL NOT BE RESPONSIBLE, OR LIABLE FOR, UNAUTHORIZED CHANGES TO OR
USES OF THESE PLANS. ALL CHANGES TO THE PLANS MUST BE IN WRITING AND MUST BE APPROVED BY THE PREPARER
OF THESE PLANS.

CAUTION

MHFD-Detention, Version 4.03 (May 2020)

Basin ID: FSD Pond 1 (As-built)

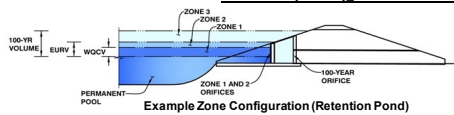

Example Zone Configuration (Retention Pond)

Selected BMP Type =	EDB	
Watershed Area =	19.36	acres
Watershed Length =	1,535	ft
Watershed Length to Centroid =	768	ft
Watershed Slope =	0.021	ft/ft
Watershed Imperviousness =	72.20%	percent
Percentage Hydrologic Soil Group A =	0.0%	percent
Percentage Hydrologic Soil Group B =	100.0%	percent
Percentage Hydrologic Soil Groups C/D =	0.0%	percent
Target WQCV Drain Time =	40.0	hours
Location for 1-hr Rainfall Depths = User Input		

Optional User Overrides

Water Quality Capture Volume (WQC)	0.453	acre-feet
Excess Urban Runoff Volume (EUCV)	1.518	acre-feet
2-yr Runoff Volume ($P1 = 1.19$ in.)	1.391	acre-feet
5-yr Runoff Volume ($P1 = 1.15$ in.)	1.867	acre-feet
10-yr Runoff Volume ($P1 = 1.75$ in.)	2.267	acre-feet
25-yr Runoff Volume ($P1 = 2.15$ in.)	2.732	acre-feet
50-yr Runoff Volume ($P1 = 2.25$ in.)	3.149	acre-feet
100-yr Runoff Volume ($P1 = 2.52$ in.)	3.640	acre-feet
500-yr Runoff Volume ($P1 = 3.14$ in.)	4.697	acre-feet
Approximate 2-yr Detention Volume	1.206	acre-feet
Approximate 5-yr Detention Volume	1.603	acre-feet
Approximate 10-yr Detention Volume	2.016	acre-feet
Approximate 25-yr Detention Volume	2.164	acre-feet
Approximate 50-yr Detention Volume	2.250	acre-feet
Approximate 100-yr Detention Volume	2.402	acre-feet


Zone 1 Volume (WQCV) =	0.453	acre-feet
Zone 2 Volume (EURV - Zone 1) =	1.065	acre-feet
Zone 3 Volume (100-year - Zones 1 & 2) =	0.884	acre-feet
Total Detention Basin Volume =	2.402	acre-feet
Initial Surge Volume (ISV) =	user	ft ³
Initial Surge Depth (ISD) =	user	ft
Total Available Detention Depth (H_{total}) =	user	ft
Depth of Trickle Channel (H_{TC}) =	user	ft
Slope of Trickle Channel (S_{TC}) =	user	ft/ft
Slopes of Main Basin Sides (S_{main}) =	user	H:V
Basin Length-to-Width Ratio (R_{LW}) =	user	

Initial Surcharge Area (A_{SV})	=	user	ft ²
Surcharge Volume Length (L_{SV})	=	user	ft
Surcharge Volume Width (W_{SV})	=	user	ft
Depth of Basin Floor (H_{FLOOR})	=	user	ft
Length of Basin Floor (L_{FLOOR})	=	user	ft
Width of Basin Floor (W_{FLOOR})	=	user	ft
Area of Basin Floor (A_{FLOOR})	=	user	ft ²
Volume of Basin Floor (V_{FLOOR})	=	user	ft ³
Depth of Main Basin (H_{MAIN})	=	user	ft
Length of Main Basin (L_{MAIN})	=	user	ft
Width of Main Basin (W_{MAIN})	=	user	ft
Area of Main Basin (A_{MAIN})	=	user	ft ²
Volume of Main Basin (V_{MAIN})	=	user	ft ³
Calculated Total Basin Volume (V_{TOTAL})	=	user	acre-feet

[illegible]

DETENTION BASIN STAGE-STORAGE TABLE BUILDER

MHFD-Detention, Version 4.03 (May 2020)

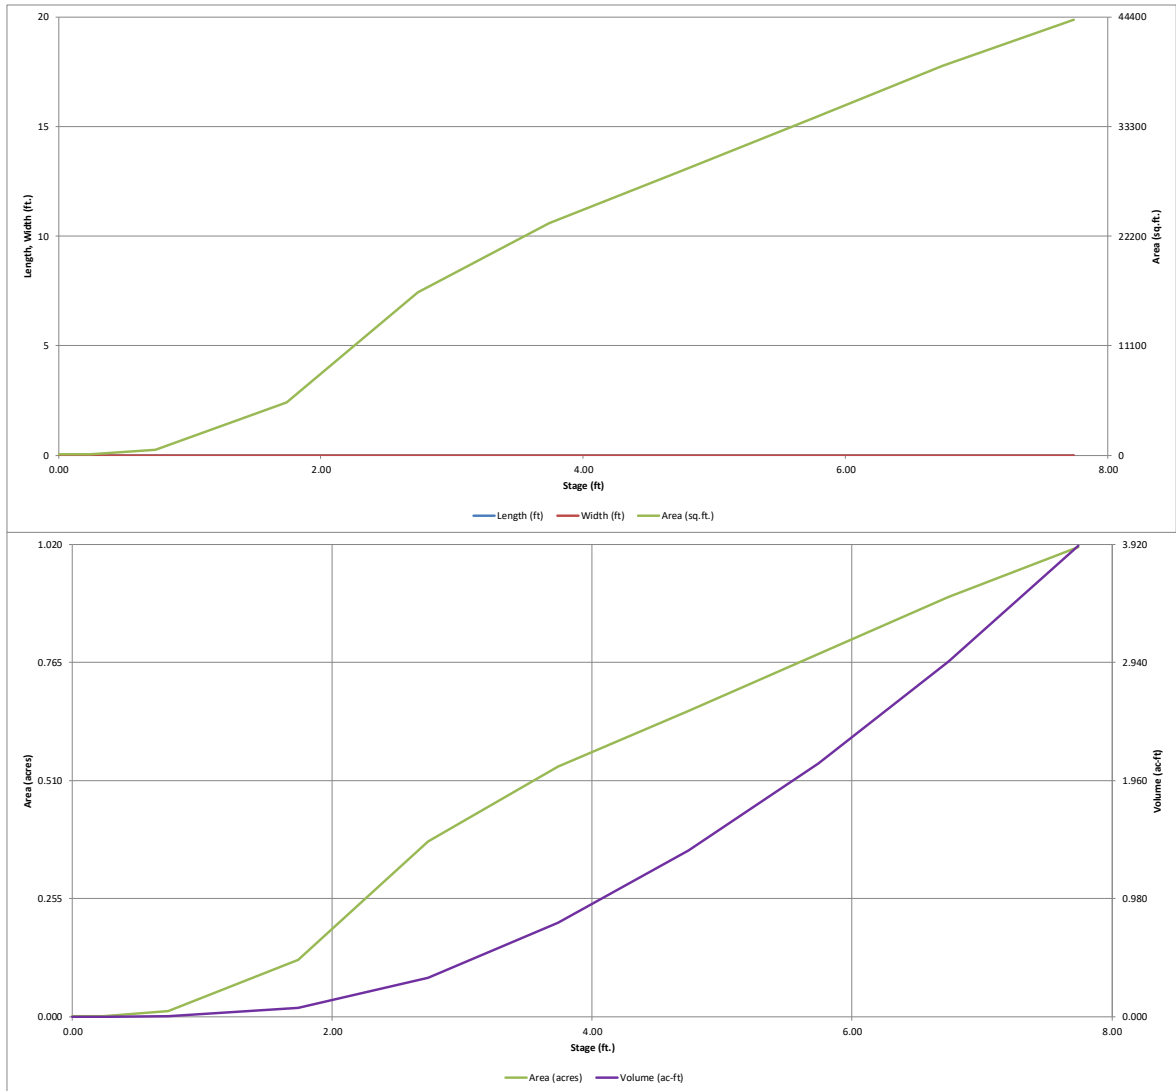


DETENTION BASIN OUTLET STRUCTURE DESIGN

MHFD-Detention, Version 4.03 (May 2020)

Project: DWIRE Storage Yard

Basin ID: FSD Pond 1 (As-built)

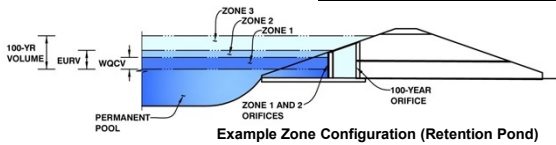

Example Zone Configuration (Retention Pond)

	Estimated Stage (ft)	Estimated Volume (ac-ft)	Outlet Type
Zone 1 (WQCV)	3.07	0.453	Orifice Plate
Zone 2 (EURV)	4.95	1.065	Orifice Plate
Zone 3 (100-year)	6.12	0.884	Weir&Pipe (Restrict)
Total (all zones)		2.402	

User Input: Orifice at Underdrain Outlet (typically used to drain WQCV in a Filtration BMP)

Underdrain Orifice Invert Depth = ft (distance below the filtration media surface)
Underdrain Orifice Diameter = inches

Calculated Parameters for Underdrain
Underdrain Orifice Area = ft²
Underdrain Orifice Centroid = feet

User Input: Orifice Plate with one or more orifices or Elliptical Slot Weir (typically used to drain WQCV and/or EURV in a sedimentation BMP)

Invert of Lowest Orifice = 0.00 ft (relative to basin bottom at Stage = 0 ft)
Depth at top of Zone using Orifice Plate = 4.95 ft (relative to basin bottom at Stage = 0 ft)
Orifice Plate: Orifice Vertical Spacing = N/A inches
Orifice Plate: Orifice Area per Row = N/A inches

Calculated Parameters for Plate
WQ Orifice Area per Row = N/A ft²
Elliptical Half-Width = N/A feet
Elliptical Slot Centroid = N/A feet
Elliptical Slot Area = N/A ft²

User Input: Stage and Total Area of Each Orifice Row (numbered from lowest to highest)

	Row 1 (required)	Row 2 (optional)	Row 3 (optional)	Row 4 (optional)	Row 5 (optional)	Row 6 (optional)	Row 7 (optional)	Row 8 (optional)
Stage of Orifice Centroid (ft)	0.00	1.65	3.20					
Orifice Area (sq. inches)	1.91	1.91	6.25					

	Row 9 (optional)	Row 10 (optional)	Row 11 (optional)	Row 12 (optional)	Row 13 (optional)	Row 14 (optional)	Row 15 (optional)	Row 16 (optional)
Stage of Orifice Centroid (ft)								
Orifice Area (sq. inches)								

User Input: Vertical Orifice (Circular or Rectangular)

Invert of Vertical Orifice = Not Selected Not Selected ft (relative to basin bottom at Stage = 0 ft)
Depth at top of Zone using Vertical Orifice = N/A N/A ft (relative to basin bottom at Stage = 0 ft)
Vertical Orifice Diameter = N/A N/A inches

Calculated Parameters for Vertical Orifice
Vertical Orifice Area = Not Selected Not Selected ft²
Vertical Orifice Centroid = N/A N/A feet

User Input: Overflow Weir (Dropbox with Flat or Sloped Grate and Outlet Pipe OR Rectangular/Trapezoidal Weir (and No Outlet Pipe))

Overflow Weir Front Edge Height, H_o = Zone 3 Weir Not Selected ft (relative to basin bottom at Stage = 0 ft)
Overflow Weir Front Edge Length = 5.00 N/A feet
Overflow Weir Grate Slope = 8.00 N/A H:V
Horiz. Length of Weir Sides = 0.00 N/A feet
Overflow Grate Open Area % = 3.50 N/A %, grate open area/total area
Debris Clogging % = 70% N/A %

Calculated Parameters for Overflow Weir
Height of Grate Upper Edge, H_u = Zone 3 Weir Not Selected feet
Overflow Weir Slope Length = 5.00 N/A feet
Grate Open Area / 100-yr Orifice Area = 3.50 N/A
Overflow Grate Open Area w/o Debris = 12.48 N/A ft²
Overflow Grate Open Area w/ Debris = 19.60 N/A ft²

User Input: Outlet Pipe w/ Flow Restriction Plate (Circular Orifice, Restrictor Plate, or Rectangular Orifice)

Depth to Invert of Outlet Pipe = Zone 3 Restrictor Not Selected ft (distance below basin bottom at Stage = 0 ft)
Outlet Pipe Diameter = 0.30 N/A inches
Restrictor Plate Height Above Pipe Invert = 24.00 N/A inches

Calculated Parameters for Outlet Pipe w/ Flow Restriction Plate
Outlet Orifice Area = Zone 3 Restrictor Not Selected ft²
Outlet Orifice Centroid = 1.57 N/A feet
Half-Central Angle of Restrictor Plate on Pipe = 0.58 N/A radians

User Input: Emergency Spillway (Rectangular or Trapezoidal)

Spillway Invert Stage = 6.50 ft (relative to basin bottom at Stage = 0 ft)
Spillway Crest Length = 25.00 feet
Spillway End Slopes = 4.00 H:V
Freeboard above Max Water Surface = 1.00 feet

Calculated Parameters for Spillway
Spillway Design Flow Depth = 0.78 feet
Stage at Top of Freeboard = 8.28 feet
Basin Area at Top of Freeboard = 1.01 acres
Basin Volume at Top of Freeboard = 3.91 acre-ft




Routed Hydrograph Results

The user can override the default CUHP hydrographs and runoff volumes by entering new values in the Inflow Hydrographs table (Columns W through AF).

	WQCV	EURV	2 Year	5 Year	10 Year	25 Year	50 Year	100 Year	500 Year
Design Storm Return Period	N/A	N/A	1.19	1.50	1.75	2.00	2.25	2.52	3.14
One-Hour Rainfall Depth (in)	N/A	N/A	1.19	1.50	1.75	2.00	2.25	2.52	3.14
CUHP Runoff Volume (acre-ft)	0.453	1.518	1.391	1.867	2.267	2.732	3.149	3.640	4.697
Inflow Hydrograph Volume (acre-ft)	N/A	N/A	1.391	1.867	2.267	2.732	3.149	3.640	4.697
CUHP Predevelopment Peak Q (cfs)	N/A	N/A	1.8	5.1	7.8	14.1	17.7	22.6	31.6
OPTIONAL Override Predevelopment Peak Q (cfs)	N/A	N/A							
Predevelopment Unit Peak Flow, q (cfs/acre)	N/A	N/A	0.10	0.27	0.40	0.73	0.91	1.17	1.63
Peak Inflow Q (cfs)	N/A	N/A	22.9	30.6	36.1	44.8	51.6	60.4	77.4
Peak Outflow Q (cfs)	0.2	0.5	0.5	3.3	7.2	15.3	17.5	18.2	27.7
Ratio Peak Outflow to Predevelopment Q	N/A	N/A	N/A	0.6	0.9	1.1	1.0	0.8	0.9
Structure Controlling Flow	Plate	Plate	Plate	Overflow Weir 1	Overflow Weir 1	Overflow Weir 1	Outlet Plate 1	Outlet Plate 1	Spillway
Max Velocity through Grate 1 (fps)	N/A	N/A	N/A	0.1	0.3	0.7	0.9	0.9	0.9
Max Velocity through Grate 2 (fps)	N/A	N/A	N/A	N/A	N/A	N/A	N/A	N/A	N/A
Time to Drain 97% of Inflow Volume (hours)	39	67	66	70	68	67	66	64	62
Time to Drain 99% of Inflow Volume (hours)	40	72	70	76	75	75	74	73	72
Maximum Ponding Depth (ft)	3.07	4.95	4.64	5.15	5.26	5.44	5.63	6.05	6.73
Area at Maximum Ponding Depth (acres)	0.43	0.69	0.65	0.71	0.72	0.75	0.77	0.82	0.90
Maximum Volume Stored (acre-ft)	0.456	1.523	1.310	1.656	1.742	1.874	2.010	2.352	2.930

DETENTION BASIN OUTLET STRUCTURE DESIGN

MHFD-Detention, Version 4.00 (December 2019)

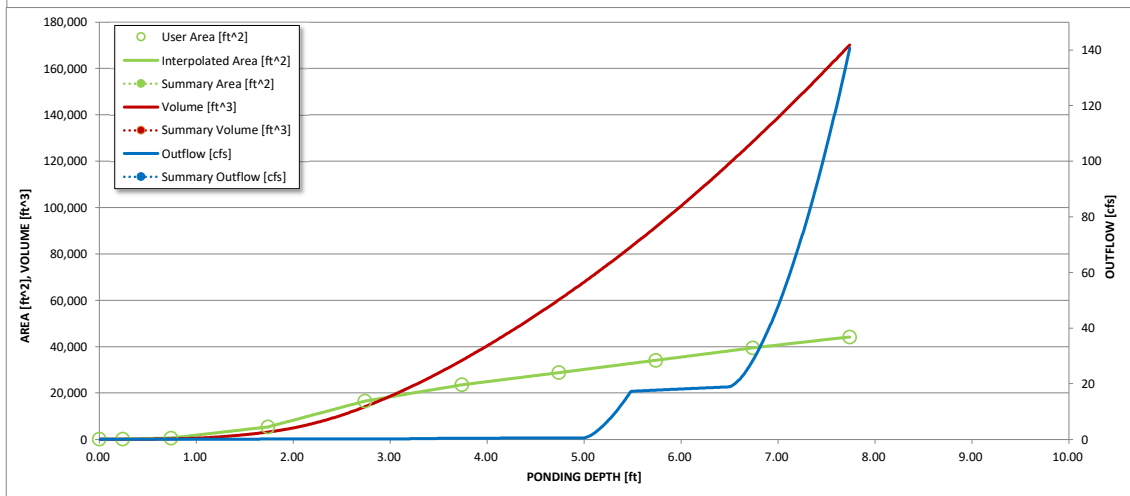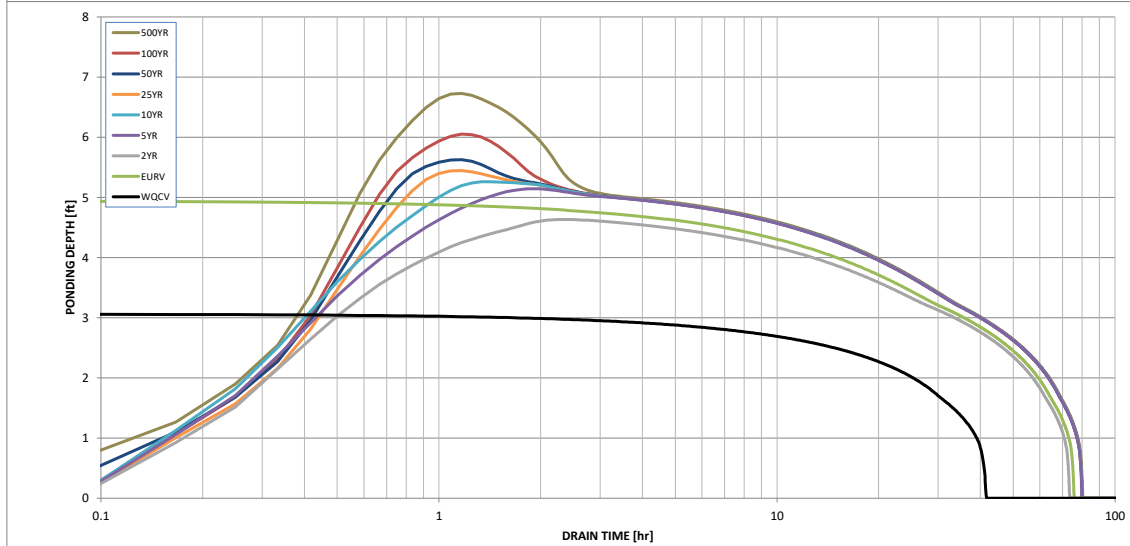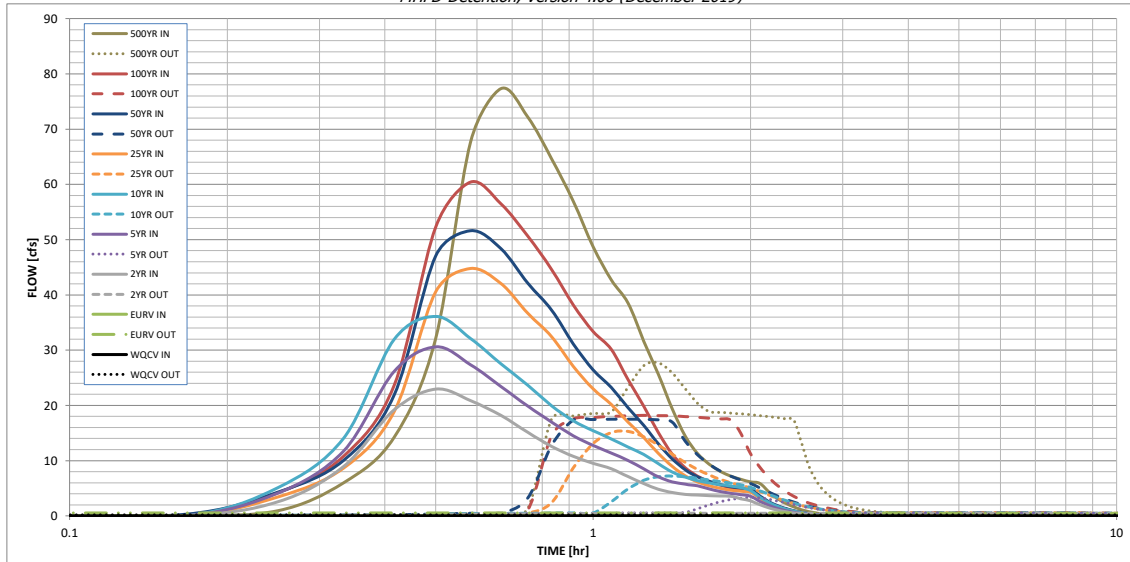

S-A-V-D Chart Axis Override	X-axis	Left Y-Axis	Right Y-Axis
minimum bound			
maximum bound			

DETENTION BASIN OUTLET STRUCTURE DESIGN

Outflow Hydrograph Workbook Filename: _____

Inflow Hydrographs

The user can override the calculated inflow hydrographs from this workbook with inflow hydrographs developed in a separate program.

Time Interval	SOURCE	CUHP	CUHP	CUHP	CUHP	CUHP	CUHP	CUHP	CUHP	CUHP
	TIME	WQCV [cfs]	EURV [cfs]	2 Year [cfs]	5 Year [cfs]	10 Year [cfs]	25 Year [cfs]	50 Year [cfs]	100 Year [cfs]	500 Year [cfs]
5.00 min	0:00:00	0.00	0.00	0.00	0.00	0.00	0.00	0.00	0.00	0.00
	0:05:00	0.00	0.00	0.00	0.00	0.00	0.00	0.00	0.00	0.00
	0:10:00	0.00	0.00	0.00	0.00	0.00	0.00	0.29	0.03	0.92
	0:15:00	0.00	0.00	2.54	4.15	5.13	3.44	4.28	4.18	5.97
	0:20:00	0.00	0.00	8.95	11.71	14.04	8.64	10.04	10.77	14.20
	0:25:00	0.00	0.00	19.18	26.13	31.94	18.82	21.83	23.58	32.07
	0:30:00	0.00	0.00	22.93	30.59	36.11	40.54	47.02	52.26	67.64
	0:35:00	0.00	0.00	20.86	27.37	32.12	44.77	51.61	60.40	77.36
	0:40:00	0.00	0.00	18.19	23.43	27.53	42.07	48.36	56.49	72.18
	0:45:00	0.00	0.00	15.10	19.86	23.65	36.65	42.12	50.62	64.66
	0:50:00	0.00	0.00	12.58	16.99	19.93	32.45	37.28	44.60	56.93
	0:55:00	0.00	0.00	10.76	14.49	17.21	27.05	31.10	38.15	48.74
	1:00:00	0.00	0.00	9.52	12.77	15.42	22.98	26.45	33.37	42.69
	1:05:00	0.00	0.00	8.52	11.38	13.92	20.15	23.22	30.11	38.54
	1:10:00	0.00	0.00	7.12	10.05	12.46	16.98	19.58	24.65	31.65
	1:15:00	0.00	0.00	5.85	8.51	11.11	14.19	16.38	19.87	25.61
	1:20:00	0.00	0.00	4.84	7.05	9.42	11.30	13.03	15.07	19.40
	1:25:00	0.00	0.00	4.23	6.18	7.94	8.97	10.33	11.19	14.43
	1:30:00	0.00	0.00	3.92	5.72	7.02	7.25	8.34	8.71	11.28
	1:35:00	0.00	0.00	3.75	5.44	6.40	6.16	7.06	7.22	9.36
	1:40:00	0.00	0.00	3.66	4.86	5.95	5.46	6.24	6.23	8.08
	1:45:00	0.00	0.00	3.60	4.41	5.64	4.98	5.67	5.56	7.20
	1:50:00	0.00	0.00	3.54	4.08	5.42	4.66	5.30	5.09	6.59
	1:55:00	0.00	0.00	3.08	3.84	5.11	4.44	5.03	4.75	6.16
	2:00:00	0.00	0.00	2.71	3.55	4.60	4.29	4.85	4.55	5.89
	2:05:00	0.00	0.00	2.02	2.63	3.40	3.20	3.61	3.38	4.37
	2:10:00	0.00	0.00	1.46	1.89	2.43	2.29	2.59	2.43	3.14
	2:15:00	0.00	0.00	1.05	1.36	1.74	1.65	1.86	1.76	2.27
	2:20:00	0.00	0.00	0.74	0.95	1.24	1.17	1.32	1.26	1.63
	2:25:00	0.00	0.00	0.51	0.65	0.86	0.81	0.92	0.88	1.13
	2:30:00	0.00	0.00	0.34	0.44	0.59	0.56	0.63	0.61	0.78
	2:35:00	0.00	0.00	0.22	0.29	0.39	0.38	0.43	0.41	0.53
	2:40:00	0.00	0.00	0.12	0.18	0.23	0.23	0.26	0.25	0.32
	2:45:00	0.00	0.00	0.06	0.09	0.11	0.12	0.14	0.13	0.17
	2:50:00	0.00	0.00	0.02	0.03	0.04	0.05	0.05	0.05	0.06
	2:55:00	0.00	0.00	0.00	0.00	0.00	0.01	0.01	0.01	0.01
	3:00:00	0.00	0.00	0.00	0.00	0.00	0.00	0.00	0.00	0.00
	3:05:00	0.00	0.00	0.00	0.00	0.00	0.00	0.00	0.00	0.00
