



ENT CREDIT UNION SITE DEVELOPMENT PLAN


LOT 1, BLOCK 1, CLAREMONT RANCH FILING NO. 9B
PART OF THE NORTHWEST 1/4 OF SECTION 4, TOWNSHIP 14 SOUTH, RANGE 65 WEST OF THE 6TH P.M.,
CITY OF COLORADO SPRINGS, COUNTY OF EL PASO, STATE OF COLORADO

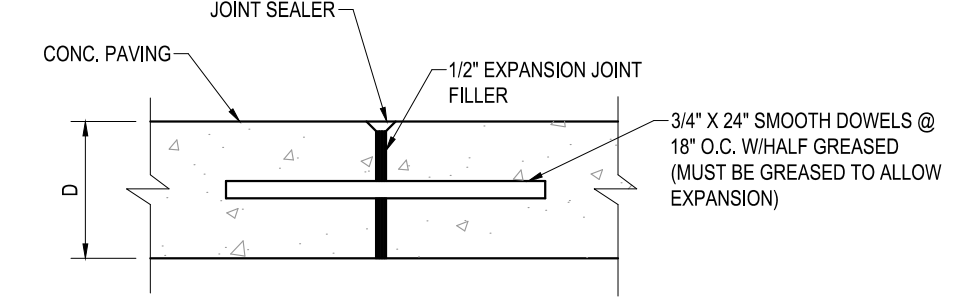

4 EXPANSION JOINT DETAIL
NOT TO SCALE

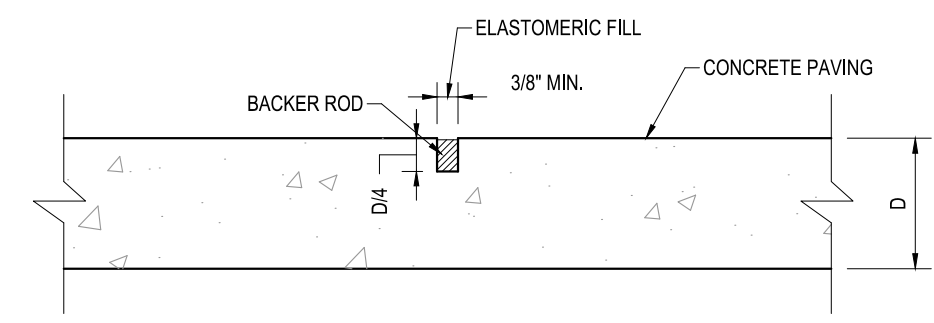

5 CONTROL JOINT DETAIL
NOT TO SCALE

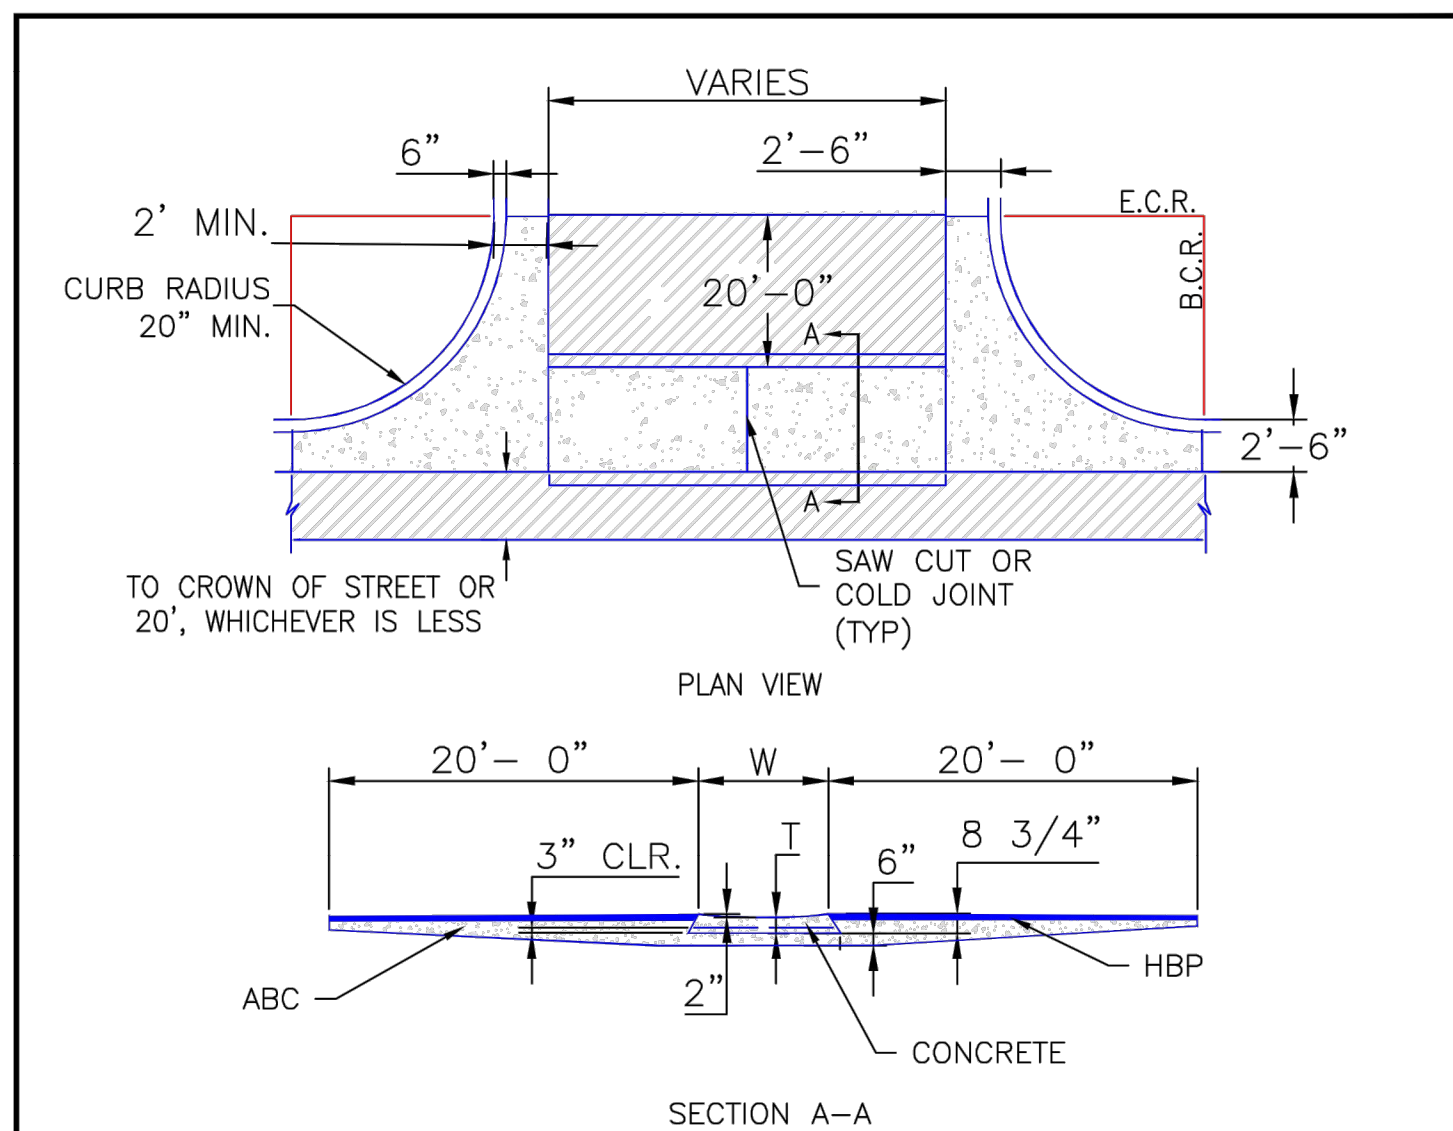


- NOTES**
1. W - WIDTH SHALL BE 6' FOR LOCAL, 8' FOR COLLECTORS, AND 10' FOR ARTERIAL ROADS.
 2. T - SQUARED-OFF RETURN TO BE POURED MONOLITHICALLY, 8" PCC FOR LOCAL ROADS, 9" FOR COLLECTORS WITH 6x6 - 4.4 W.W.F. OR #4 REINFORCING BAR @ 18" EACH WAY.
 3. = 3" MINIMUM ASPHALT DEPTH (2 LIFTS).
 4. DESIGN TO SPECIFY ELEVATIONS AT PI AND PCR.

SCALE: NOT TO SCALE


DATE APPROVED: 8/11/11	FILE NAME: SD_2-26
DESIGNER: André P. Brackin	REVISION DATE: 12/8/15
DEPARTMENT OF TRANSPORTATION	DEPARTMENT OF TRANSPORTATION

1 CROSS PAN DETAIL
NOT TO SCALE


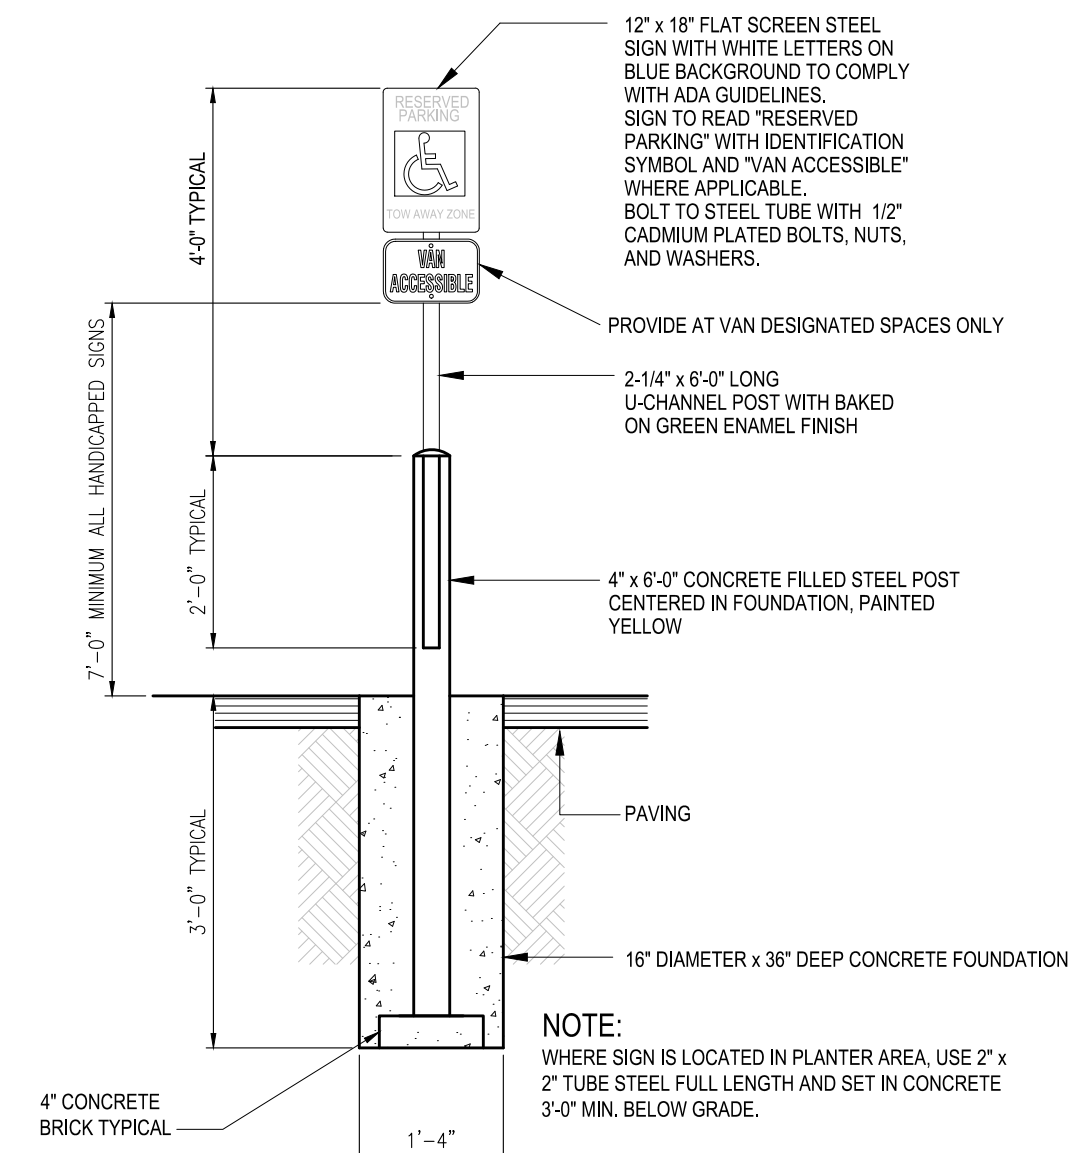


12 HANDICAP PARKING SIGN
NOT TO SCALE


2 CATCH CURB AND 1' WIDE GUTTER (PRIVATE)
SCALE: 1 1/2" = 1'-0"

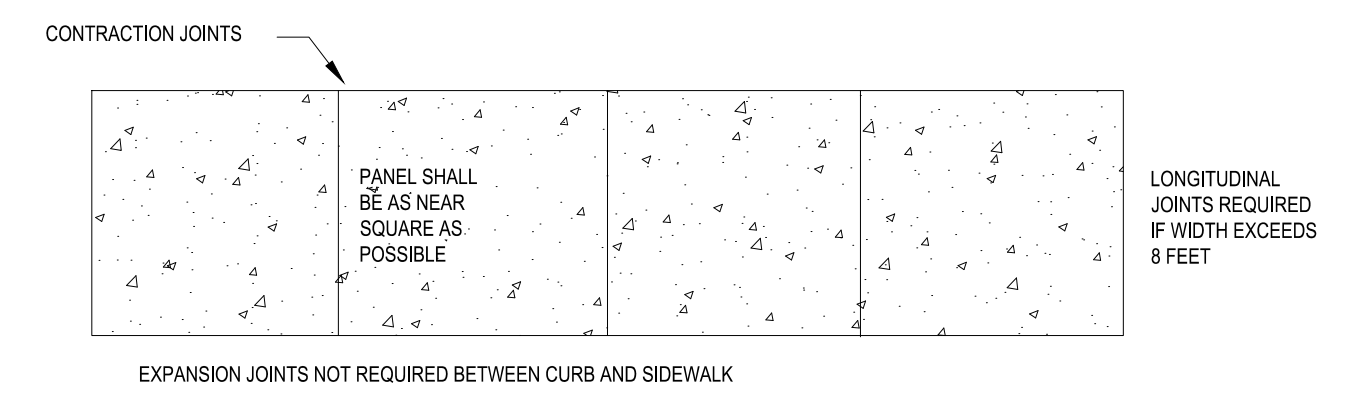


3 SPILL CURB AND 1' WIDE GUTTER (PRIVATE)
SCALE: 1 1/2" = 1'-0"

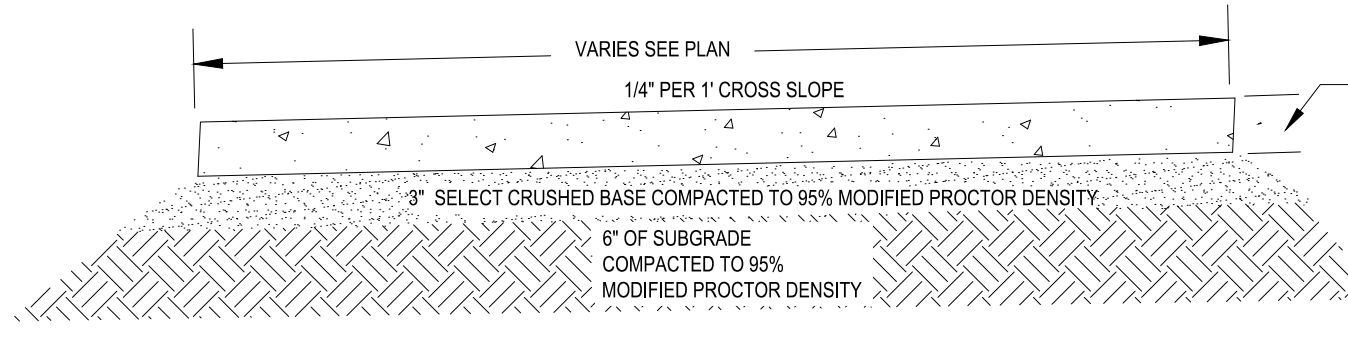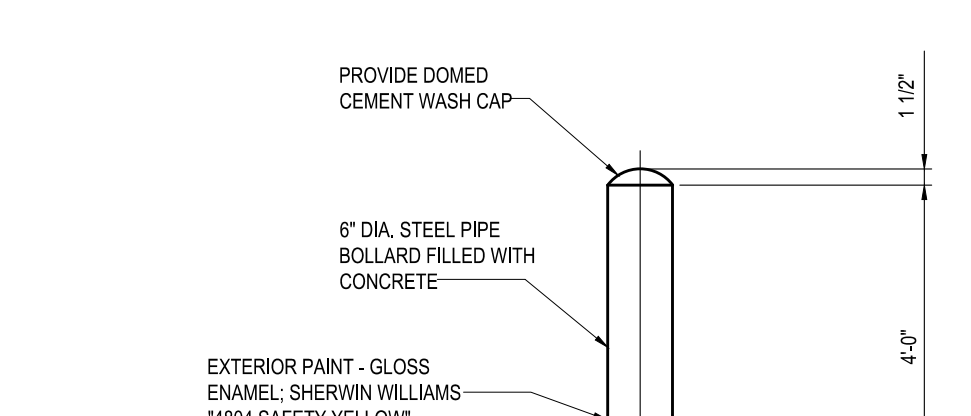


6 CONCRETE SIDEWALK DETAIL
NOT TO SCALE

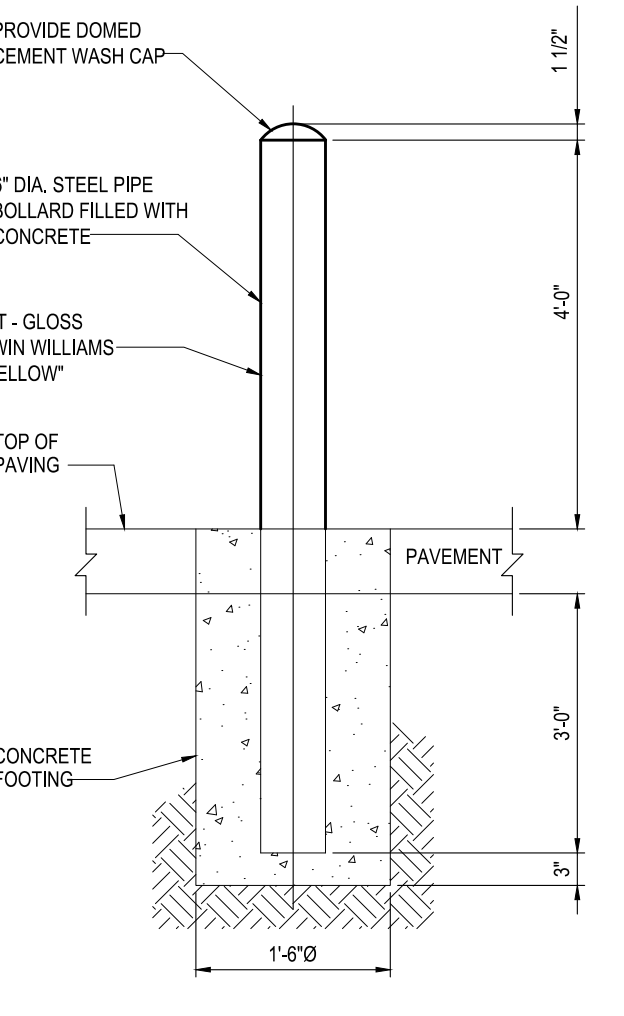


7 PIPE BOLLARD DETAIL (TRANSFORMER)
NOT TO SCALE

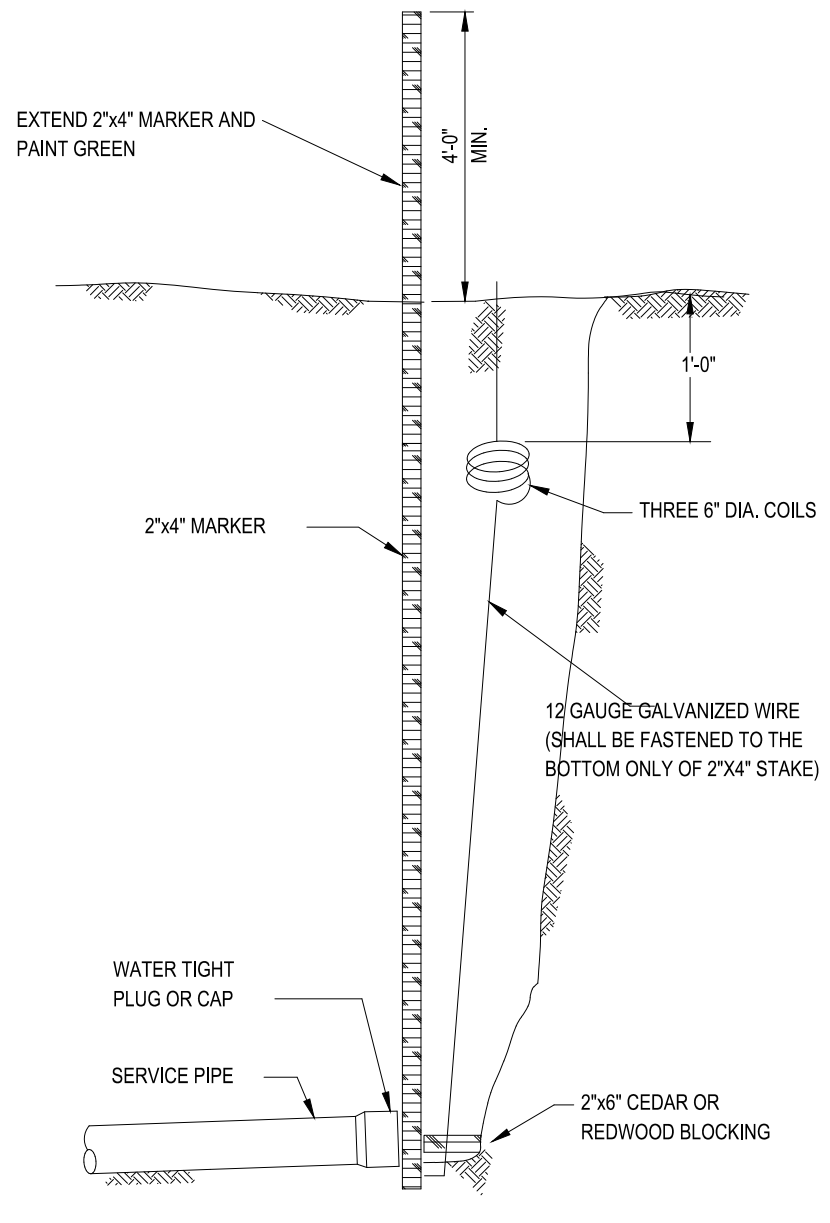


8 SERVICE MARKER
NOT TO SCALE

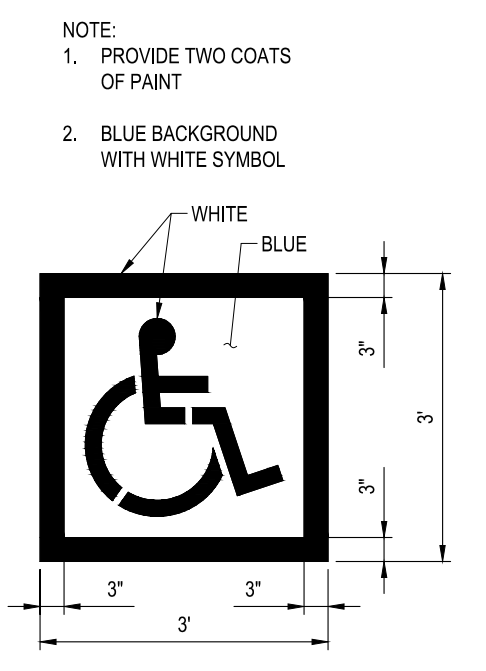


9 HANDICAPPED SYMBOL
SCALE: 1/2" = 1'-0"

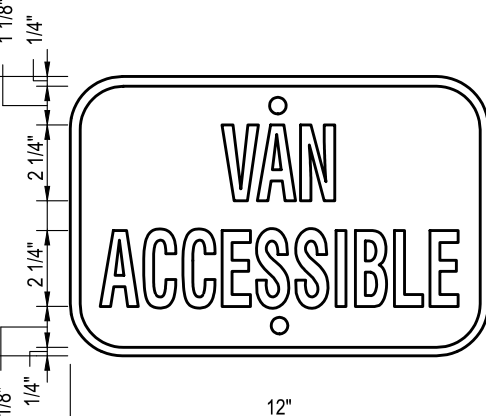


10 'VAN ACCESSIBLE' SIGN DETAIL
SCALE: NOT TO SCALE

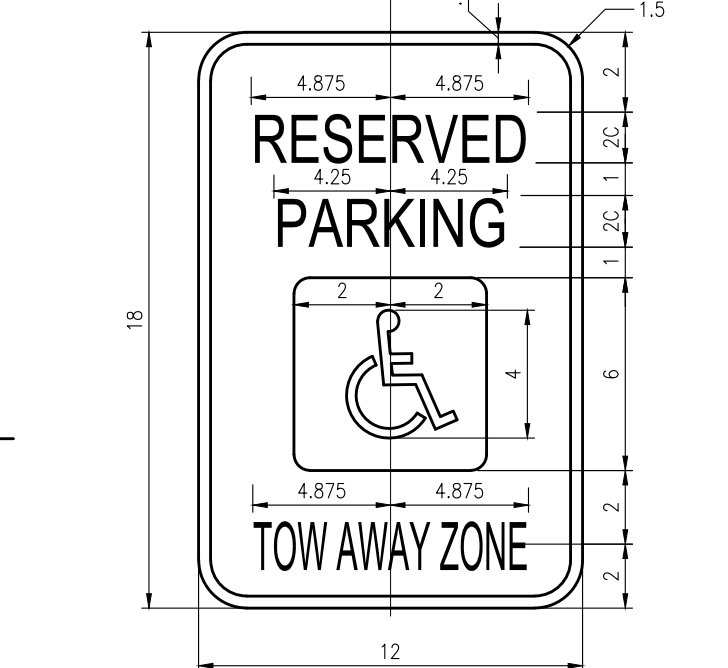

11 'PARKING ONLY' SIGN DETAIL
SCALE: NOT TO SCALE

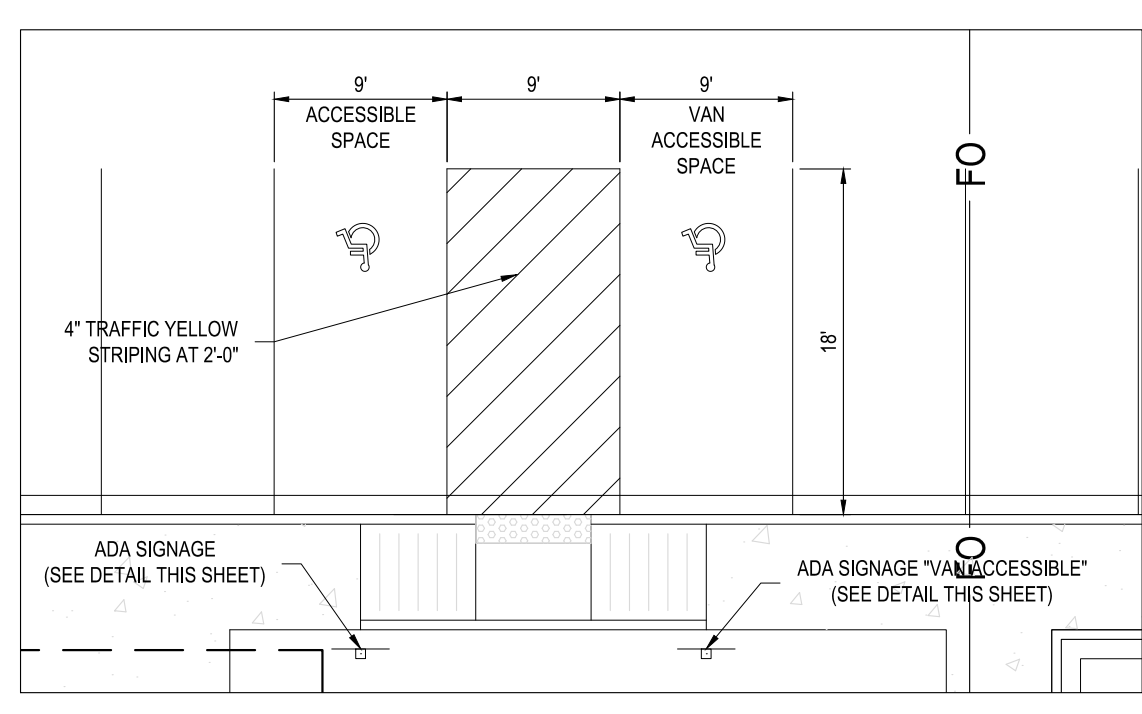


15 ADA PARKING DETAILS
SCALE: 1" = 10'
*ADA PARKING SHALL COMPLY WITH LATEST LATEST ADA REQUIREMENTS.

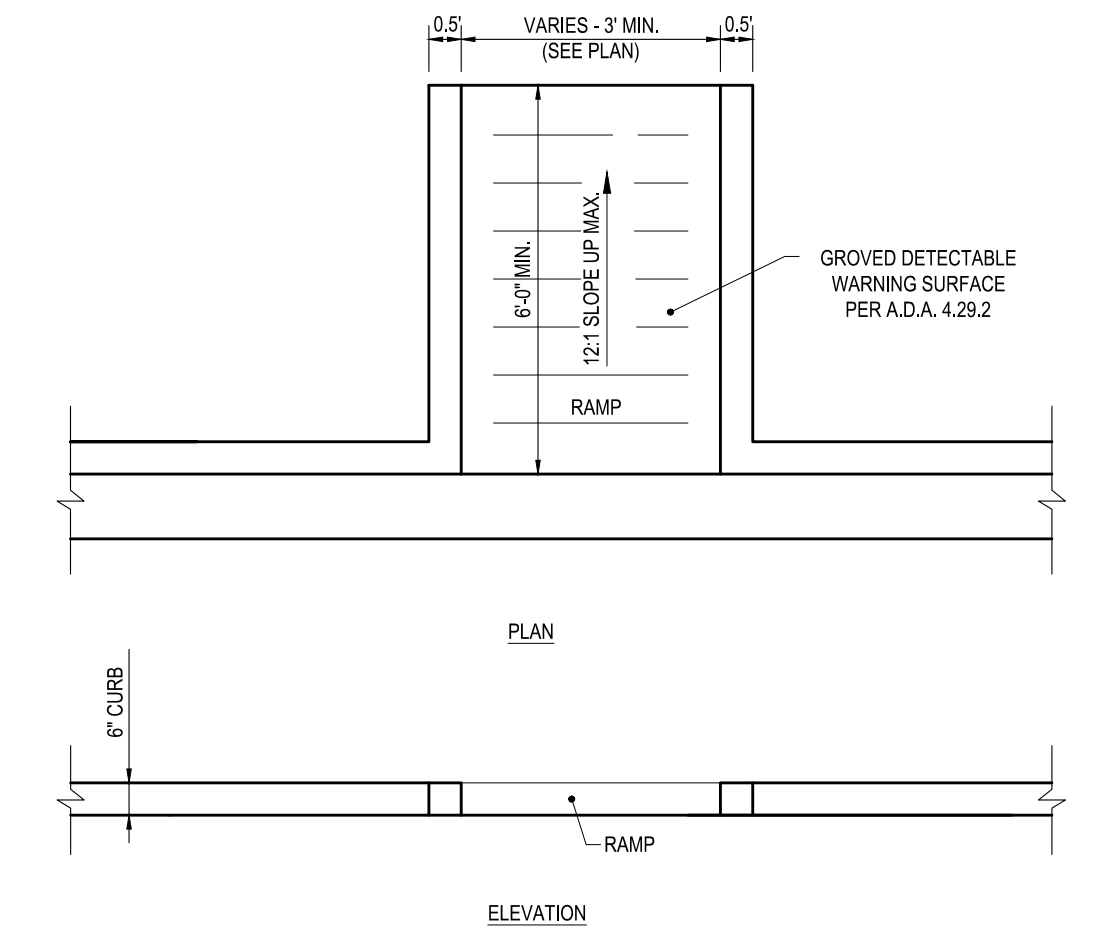


16 ADA HANDICAP RAMP DETAIL
NOT TO SCALE

13 STOP SIGN DETAIL
NOT TO SCALE

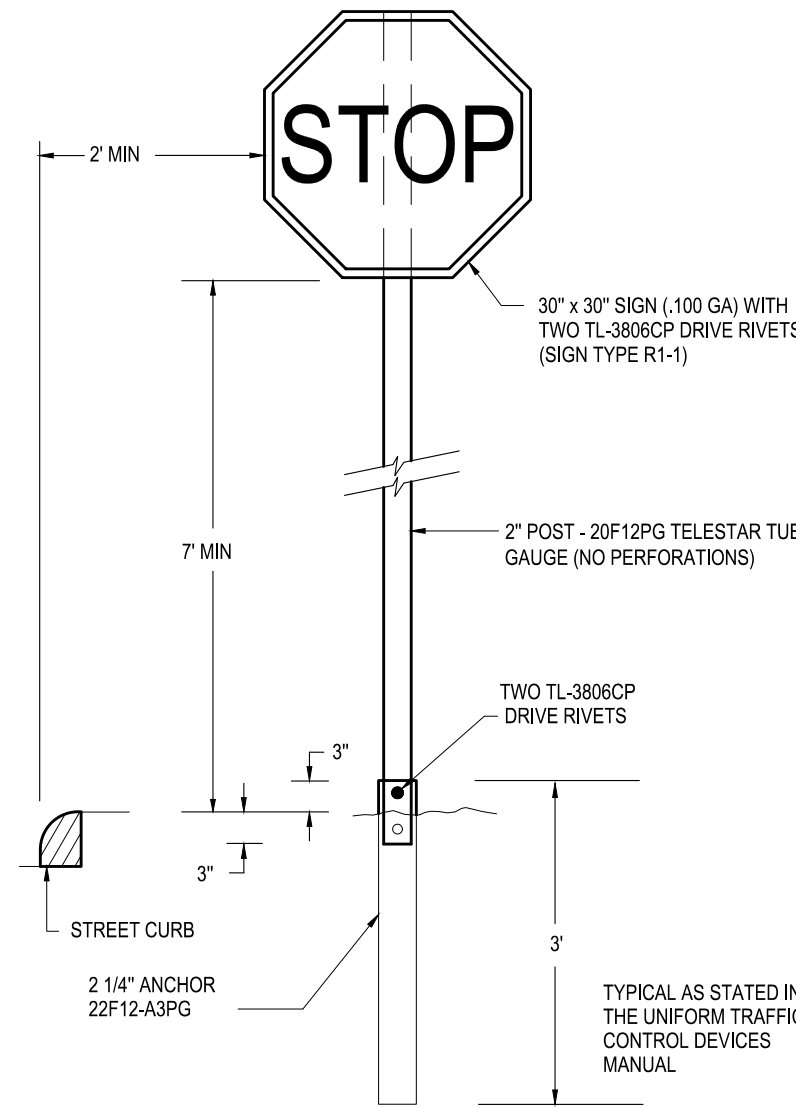

14 "K-1833" SIGN DETAIL
NOT TO SCALE

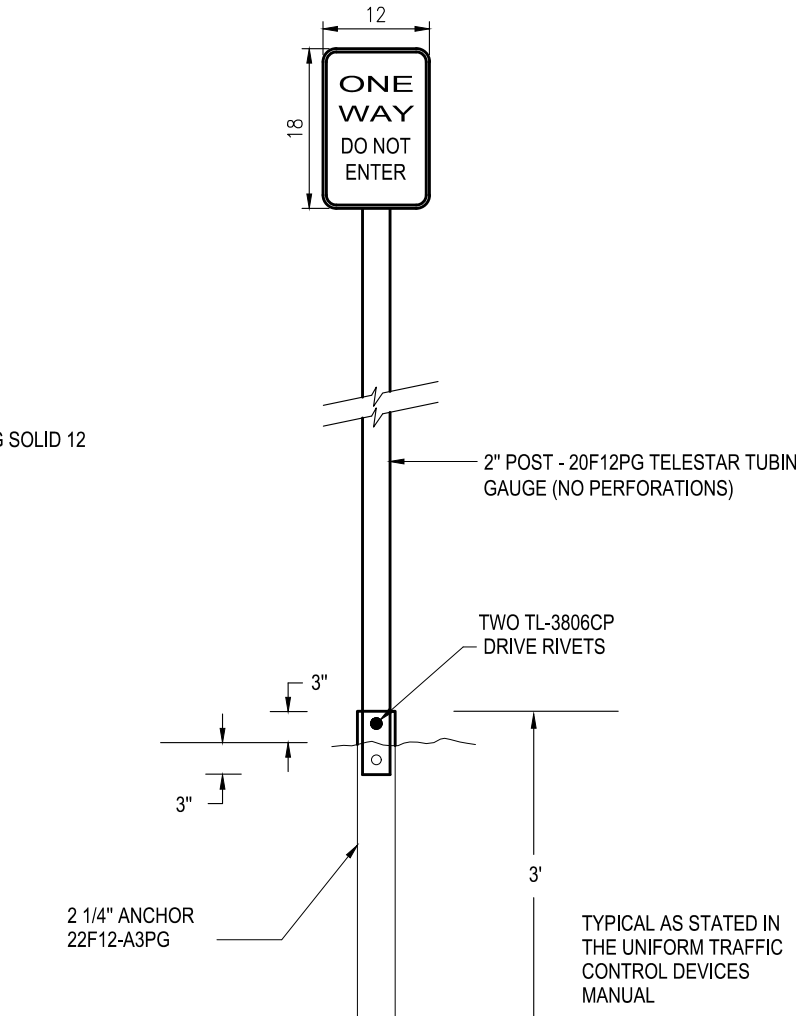

ENT CREDIT UNION
SITE DEVELOPMENT PLAN
LOT 1, BLOCK 1,
CLAREMONT RANCH FILING NO. 9B
MARKSHEFFEL RD. AND CONSTITUTION AVE
COLORADO SPRINGS, COLORADO

#	Date	Issue / Description	Int.

Project No:	ECU007
Drawn By:	JSB
Checked By:	JRR
Date:	05/03/18


SITE DETAILS

PLANTING NOTES

GENERAL

- ALL WORK SHALL CONFORM TO ALL APPLICABLE STATE AND LOCAL CODES, STANDARDS, AND SPECIFICATIONS.
- LANDSCAPE DESIGN IS DIAGRAMMATIC IN NATURE. THE CONTRACTOR SHALL BE RESPONSIBLE FOR HIS OWN TAKEOFFS AND QUANTITY CALCULATIONS. IN THE EVENT OF A DISCREPANCY BETWEEN THE PLAN AND THE LANDSCAPE LEGEND, THE PLANT QUANTITY AS SHOWN ON THE PLAN SHALL TAKE PRECEDENCE AND NOTIFY THE LANDSCAPE ARCHITECT OF THESE DISCREPANCIES. MINOR ADJUSTMENTS TO THE LANDSCAPE MATERIAL AND LOCATIONS MAY BE PROPOSED FOR CITY CONSIDERATION AT THE CONSTRUCTION DOCUMENT STAGE TO RESPOND TO MARKET AND FIELD CONDITIONS. HOWEVER, THERE SHALL BE NO REDUCTION IN THE NUMBER AND SIZE OF MATERIALS.
- THE CONTRACTOR SHALL MAKE HIMSELF AWARE OF THE LOCATIONS OF EXISTING AND PROPOSED UTILITIES, AND SHALL BE RESPONSIBLE FOR ANY DAMAGE TO THE UTILITIES AND/OR ANY INJURY TO ANY PERSON.
- ALL UTILITY EASEMENTS SHALL REMAIN UNOBSTRUCTED AND FULLY ACCESSIBLE ALONG THEIR ENTIRE LENGTH FOR MAINTENANCE EQUIPMENT.
- THE CONTRACTOR SHALL TAKE EXTREME CARE NOT TO DAMAGE ANY EXISTING PLANTS INDICATED AS "TO REMAIN". ANY SUCH PLANTS DAMAGED BY THE CONTRACTOR SHALL BE REPLACED WITH THE SAME SPECIES, SIZE, AND QUANTITY AT THE CONTRACTOR'S OWN EXPENSE, AND AS ACCEPTABLE TO THE OWNER. REFER TO THE TREE PROTECTION NOTES ON THE PLANS (AS APPLICABLE).
- LANDSCAPE CONTRACTOR SHALL EXAMINE THE SITE CONDITIONS UNDER WHICH THE WORK IS TO BE PERFORMED AND NOTIFY THE GENERAL CONTRACTOR IN WRITING OF UNSATISFACTORY CONDITIONS. IF SITE CONDITIONS OR PLANT AVAILABILITY REQUIRE CHANGES TO THE PLAN, THEN AN APPROVAL WILL BE OBTAINED FROM THE CITY. DO NOT PROCEED UNTIL CONDITIONS HAVE BEEN CORRECTED.
- ALL CONSTRUCTION DEBRIS AND MATERIAL SHALL BE REMOVED AND CLEANED OUT PRIOR TO INSTALLATION OF TOPSOIL, TREES, SHRUBS, AND TURF.
- FOR ALL INFORMATION ON SURFACE MATERIAL OF WALKS, DRIVES, AND PARKING LOTS, SEE THE SITE PLAN. SEE PHOTOMETRIC PLAN FOR FREE STANDING LIGHTING INFORMATION.
- THE LANDSCAPE CONTRACTOR SHALL NOTIFY THE LANDSCAPE ARCHITECT ONE WEEK PRIOR TO BEGINNING CONSTRUCTION.
- WINTER WATERING SHALL BE AT THE EXPENSE OF THE CONTRACTOR UNTIL SUCH TIME AS FINAL ACCEPTANCE IS RECEIVED.
- ALL LANDSCAPE CONSTRUCTION PRACTICES, WORKMANSHIP, AND ETHICS SHALL BE IN ACCORDANCE WITH INDUSTRY STANDARDS SET FORTH IN THE CONTRACTORS HANDBOOK PUBLISHED BY THE COLORADO LANDSCAPE CONTRACTORS ASSOCIATION.
- LANDSCAPE AND IRRIGATION WORK SHALL BE COMPLETED PRIOR TO THE ISSUANCE OF THE FINAL CERTIFICATE OF OCCUPANCY.
- FINISH GRADING AND SOIL PREPARATION
 - CONTRACTOR SHALL CONSTRUCT AND MAINTAIN FINISH GRADES AS RECOMMENDED BY THE GEOTECHNICAL REPORT. ALL LANDSCAPE AREAS SHALL HAVE POSITIVE DRAINAGE AWAY FROM STRUCTURES AT THE MINIMUM SLOPE SPECIFIED IN THE REPORT, AND AREAS OF POTENTIAL PONDING SHALL BE REGRADED TO BLEND IN WITH THE SURROUNDING GRADES AND ELIMINATE PONDING POTENTIAL. SHOULD ANY CONFLICTS AND/OR DISCREPANCIES ARISE BETWEEN THE GEOTECHNICAL REPORT, THE GRADING PLANS, THESE NOTES, AND ACTUAL CONDITIONS, THE CONTRACTOR SHALL IMMEDIATELY BRING SUCH ITEMS TO THE ATTENTION OF THE LANDSCAPE ARCHITECT AND OWNER.
 - AFTER FINISH GRADES HAVE BEEN ESTABLISHED, IT IS RECOMMENDED THAT THE CONTRACTOR SHALL HAVE SOIL SAMPLES TESTED BY AN ESTABLISHED SOIL TESTING LABORATORY FOR THE FOLLOWING: GENERAL SOIL FERTILITY, PH, ORGANIC MATTER CONTENT, SALT (CEC), LIME, SODIUM ADSORPTION RATIO (SAR) AND BORON CONTENT. EACH SAMPLE SUBMITTED SHALL CONTAIN NO LESS THAN ONE QUART OF SOIL. CONTRACTOR TO SUBMIT THE PROJECT'S PLANT LIST TO THE LABORATORY ALONG WITH THE SOIL SAMPLES. THE SOIL REPORT PRODUCED BY THE LABORATORY SHALL CONTAIN RECOMMENDATIONS FOR THE FOLLOWING (AS APPROPRIATE): GENERAL SOIL PREPARATION AND BACKFILL MIXES, PRE-PLANT FERTILIZER APPLICATIONS, AND ANY OTHER SOIL RELATED ISSUES. THE REPORT SHALL ALSO PROVIDE A FERTILIZER PROGRAM FOR THE ESTABLISHMENT PERIOD AND FOR LONG-TERM MAINTENANCE.
 - THE CONTRACTOR SHALL REQUIRE INSTALLATION OF SOIL AMENDMENTS AND FERTILIZERS PER THE SOILS REPORT FOR THE OWNER/OWNER'S REPRESENTATIVE CONSIDERATION.
 - AT A MINIMUM, ALL TOPSOIL SHALL BE AMENDED WITH NITROGEN STABILIZED ORGANIC AMENDMENT COMPOST AT A RATE OF 5.0 CUBIC YARDS AND AMMONIUM PHOSPHATE 16-20-0 AT A RATE OF 15 POUNDS PER THOUSAND SQUARE FEET OF LANDSCAPE AREA. COMPOST SHALL BE MECHANICALLY INTEGRATED INTO THE TOP 6" OF SOIL BY MEANS OF ROTOTILLING AFTER CROSS-RIPPING. GROUND COVER & PERENNIAL BED AREAS SHALL BE AMENDED AT A RATE OF 8 CUBIC FEET PER THOUSAND SQUARE FEET OF NITROGEN STABILIZED ORGANIC AMENDMENT AND 10 LBS. OF 12-12-12 FERTILIZER PER CU. YD. ROTOTILLED TO A DEPTH OF 8". NO MANURE OR ANIMAL-BASED PRODUCTS SHALL BE USED FOR ORGANIC AMENDMENTS.
- PLANTING
 - ALL DECIDUOUS TREES SHALL HAVE FULL, WELL-SHAPED HEADS/SHALL EVERGREENS SHALL BE UNSHEARED AND FULL TO THE GROUND, UNLESS OTHERWISE SPECIFIED. TREES WITH CENTRAL LEADERS WILL NOT BE ACCEPTED IF LEADER IS DAMAGED OR REMOVED. PRUNE ALL DAMAGED TWIGS AFTER PLANTING.
 - ALL PLANTS WITHIN A SPECIES SHALL HAVE SIMILAR SIZE, AND SHALL BE OF A FORM TYPICAL FOR THE SPECIES. ANY PLANT DEEMED UNACCEPTABLE BY THE LANDSCAPE ARCHITECT SHALL BE IMMEDIATELY REMOVED FROM THE SITE AND SHALL BE REPLACED WITH AN ACCEPTABLE PLANT OF LIKE TYPE AND SIZE AT THE CONTRACTOR'S OWN EXPENSE. ANY PLANTS APPEARING TO BE UNHEALTHY, EVEN IF DETERMINED TO STILL BE ALIVE, SHALL NOT BE ACCEPTED. THE LANDSCAPE ARCHITECT SHALL BE THE SOLE JUDGE AS TO THE ACCEPTABILITY OF PLANT MATERIAL.
 - ALL TREES SHALL BE GUYED AND WOOD STAKED AS PER DETAILS. NO "T-STAKES" SHALL BE USED FOR TREES.
 - ALL PLANT MATERIALS SHALL BE TRUE TO TYPE, SIZE, SPECIES, QUALITY, AND FREE OF INJURY, BROKEN ROOT BALLS, PESTS, AND DISEASES, AS WELL AS CONFORM TO THE MINIMUM REQUIREMENTS DESCRIBED IN THE "AMERICAN STANDARD FOR NURSERY STOCK". FOLLOW GREENCO TREE PLANTING RECOMMENDATIONS FOR MINIMUM QUALITY REQUIREMENTS FOR TREES.
 - ALL TREE AND SHRUB BED LOCATIONS ARE TO BE STAKED OUT ON SITE FOR APPROVAL BY THE LANDSCAPE ARCHITECT PRIOR TO INSTALLATION.
 - ALL TREES PLANTED ADJACENT TO PUBLIC AND/OR PEDESTRIAN WALKWAYS SHALL BE PRUNED CLEAR OF ALL BRANCHES BETWEEN GROUND AND A HEIGHT OF EIGHT (8) FEET FOR THAT PORTION OF THE PLAN LOCATED OVER THE SIDEWALK AND/OR ROAD.
 - IF TURF IS TO BE USED, IT IS RECOMMENDED THROUGH GREEN VALLEY TURF COMPANY, 13159 N. US HIGHWAY 85, LITTLETON, CO 80125, (303) 798-6764. RTF TALL FESCUE HAS BEEN APPROVED IN MANY JURISDICTIONS AS A LOW HYDROZONE PLANT MATERIAL. INSTALL AND MAINTAIN IN ACCORDANCE WITH MANUFACTURER'S SPECIFICATIONS.
 - ALL PLANT MATERIAL SHALL NOT BE PLANTED PRIOR TO INSTALLATION OF TOPSOIL.
 - ALL PLANT BEDS SHALL BE CONTAINED WITH STEEL EDGER. STEEL EDGER IS NOT REQUIRED ALONG CURBS, WALKS OR BUILDING FOUNDATIONS. ALL EDGING SHALL OVERLAP AT JOINTS A MINIMUM OF 6 INCHES, AND SHALL BE FASTENED WITH A MINIMUM OF 4 PINS PER EACH 10 FOOT SECTION. THE TOP OF ALL EDGING MATERIAL SHALL BE A ROLLED TOP AND 1/2 INCH ABOVE THE FINISHED GRADE OF ADJACENT LAWN OR MULCH AREAS. COLOR: GREEN.
 - THE DEVELOPER, HIS SUCCESSOR, OR ASSIGNEE SHALL BE RESPONSIBLE FOR ESTABLISHING AND CONTINUING A REGULAR PROGRAM OF MAINTENANCE FOR ALL LANDSCAPED AREAS. SEE LANDSCAPE GUARANTEE AND MAINTENANCE NOTE.
 - A 3-FOOT CLEAR SPACE SHALL BE MAINTAINED AROUND THE CIRCUMFERENCE OF ALL FIRE HYDRANTS.
 - LANDSCAPE CONTRACTOR TO SUBMIT SAMPLES OF MISCELLANEOUS LANDSCAPING MATERIALS TO THE LANDSCAPE ARCHITECTS AND OWNER'S REPRESENTATIVE FOR APPROVAL PRIOR TO INSTALLATION, I.E.: MULCH, EDGER, LANDSCAPE FABRIC, ETC.
 - AFTER ALL PLANTING IS COMPLETE, THE CONTRACTOR SHALL INSTALL A MINIMUM 4" THICK LAYER OF MULCH AS SPECIFIED IN THE PLANTING LEGEND. INSTALL A 4" THICK RING OF DOUBLE SHREDED CEDAR BARK MULCH AROUND ALL PLANT MATERIAL IN ROCK MULCH BEDS WHERE LANDSCAPING IS SHOWN ON THE PLANS. WOOD MULCH RING SIZE SHALL BE 1.5X THE CONTAINER SIZE OF THE SHRUBS, PERENNIALS, AND ORNAMENTAL GRASSES. TREE RING SIZE SHALL BE GREEN INDUSTRIES OF COLORADO INDUSTRY STANDARD WIDTH.
 - ALL MULCH SHALL BE HARVESTED IN A SUSTAINABLE MANNER FROM A LOCAL SOURCE.
 - INSTALL DEWITT PRO-5 WEED BARRIER FABRIC UNDER ALL ROCK MULCH SHRUB BEDS SPECIFIED ON THE PLANS ONLY. NO LANDSCAPE FABRIC SHALL BE USED IN WOOD MULCH AREAS. NO PLASTIC WEED BARRIERS SHALL BE SPECIFIED.
 - ABSOLUTELY NO EXPOSED GROUND SHALL BE LEFT SHOWING ANYWHERE ON THE PROJECT AFTER MULCH HAS BEEN INSTALLED.
 - ALL PLANTING AREAS WITH LESS THAN A 4:1 GRADIENT SHALL RECEIVE A LAYER OF MULCH, TYPE AND DEPTH PER PLANS. SUBMIT 1 CUBIC FOOT SAMPLE OF MULCH (ONE SAMPLE PER TYPE) TO LANDSCAPE ARCHITECT FOR APPROVAL PRIOR TO INSTALLATION. THE MULCH SHALL BE SPREAD EVENLY THROUGHOUT ALL PLANTING AREAS EXCEPT SLOPES 4:1 OR STEEPER, OR AS OTHERWISE DENOTED ON THE PLAN. ABSOLUTELY NO EXPOSED GROUND SHALL REMAIN IN AREAS TO RECEIVE MULCH AFTER MULCH HAS BEEN INSTALLED.
 - ALL PLANTING AREAS ON SLOPES OVER 4:1 SHALL RECEIVE COCONUT FIBER EROSION CONTROL NETTING FROM ROLLS. NETTING SHALL BE #CT-125, AS MANUFACTURED BY NORTH AMERICAN GREEN (OR EQUAL), INSTALL AND STAKE PER MANUFACTURER'S SPECIFICATIONS. SEE ALSO THE CIVIL ENGINEER'S EROSION CONTROL PLAN.

CAUTION
UTILITIES EXIST WITHIN CONSTRUCTION LIMITS. CONTRACTOR IS RESPONSIBLE FOR IDENTIFYING THEIR LOCATION PRIOR TO CONSTRUCTION.

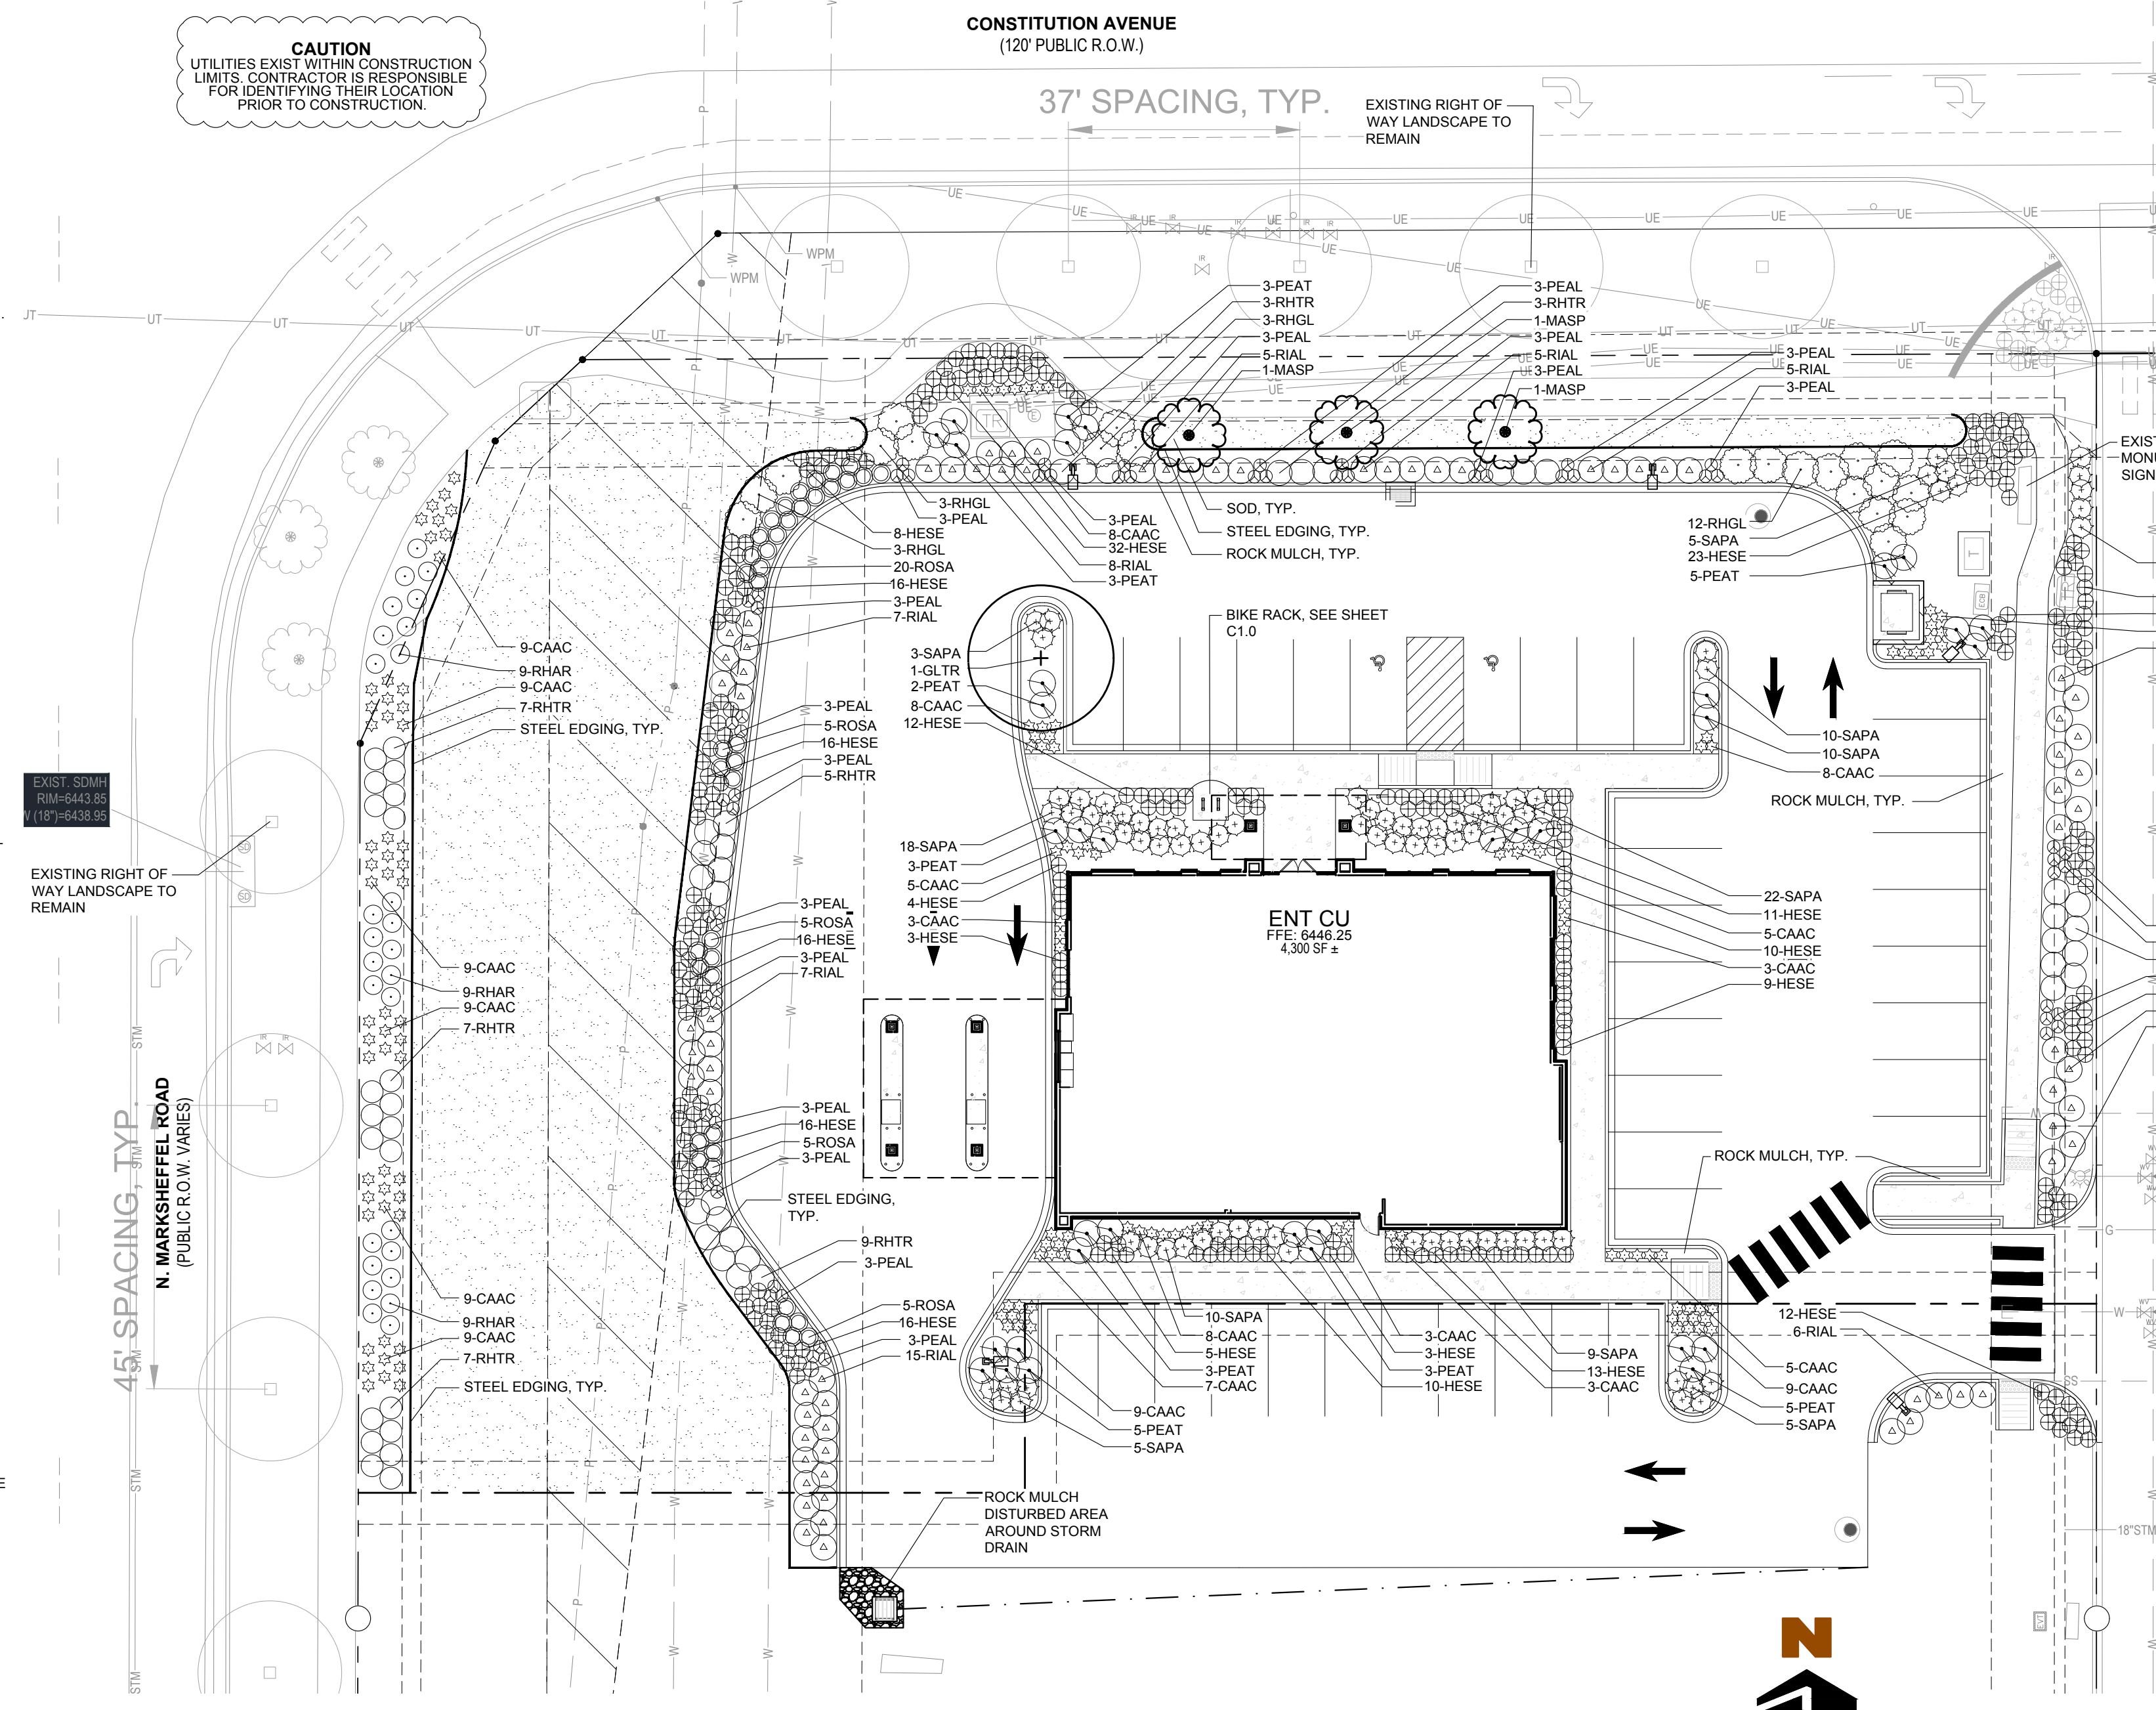

ENT CREDIT UNION SITE DEVELOPMENT PLAN

LOT 1, BLOCK 1, CLAREMONT RANCH FILING NO. 9B
PART OF THE NORTHWEST 1/4 OF SECTION 4, TOWNSHIP 14 SOUTH, RANGE 65 WEST OF THE 6TH P.M.,
CITY OF COLORADO SPRINGS, COUNTY OF EL PASO, STATE OF COLORADO

CONSTITUTION AVENUE
(120' PUBLIC R.O.W.)

37' SPACING, TYP.

EXISTING RIGHT OF WAY LANDSCAPE TO REMAIN

BIKE RACK, SEE SHEET C1.0

ENT CU
FFE: 6446 25
4,300 SF ±

ROCK MULCH, TYP.

ROCK MULCH DISTURBED AREA AROUND STORM DRAIN

LANDSCAPE GUARANTEE AND MAINTENANCE


- THE LANDSCAPE CONTRACTOR SHALL GUARANTEE ALL TREES, SHRUBS, PERENNIALS, SOD, SEEDED AREAS, AND IRRIGATION SYSTEMS FOR A PERIOD OF ONE YEAR FROM THE DATE OF THE OWNER'S ACCEPTANCE. THE CONTRACTOR SHALL REPLACE, AT HIS OWN EXPENSE, ANY PLANTS WHICH DIE IN THAT TIME, OR REPAIR ANY PORTIONS OF THE IRRIGATION SYSTEM WHICH OPERATE IMPROPERLY.
- THE LANDSCAPE CONTRACTOR SHALL MAINTAIN THE LANDSCAPE IN A NEAT, CLEAN, AND HEALTHY CONDITION FOR A PERIOD OF 90 DAYS. THIS SHALL INCLUDE PROPER PRUNING, MOWING AND AERATION OF LAWNS, WEEDING, REPLACEMENT OF MULCH, REMOVAL OF LITTER, AND THE APPROPRIATE WATERING OF ALL PLANTINGS. IRRIGATION SHALL BE MAINTAINED IN PROPER WORKING ORDER, WITH SCHEDULING ADJUSTMENTS BY SEASON AND TO MAXIMIZE WATER CONSERVATION. IF SITE OPENS DURING WINTER, TO AVOID FREEZE DAMAGE ON PLANTINGS, THE 90 DAYS SHOULD BEGIN AFTER ACCEPTANCE OF THE WORK.
- DURING THE LANDSCAPE MAINTENANCE PERIOD, THE LANDSCAPE CONTRACTOR SHALL MAINTAIN POSITIVE DRAINAGE AWAY FROM STRUCTURES IN ALL LANDSCAPE AREAS AT THE MINIMUM SLOPE SPECIFIED IN THE GEOTECHNICAL REPORT. LANDSCAPE AREAS WHICH SETTLE AND CREATE THE POTENTIAL FOR PONDING SHALL BE REPAIRED TO ELIMINATE PONDING POTENTIAL AND BLEND IN WITH THE SURROUNDING GRADES. SHOULD ANY CONFLICTS AND/OR DISCREPANCIES ARISE BETWEEN THE GEOTECHNICAL REPORT, THE GRADING PLANS, THESE NOTES, AND ACTUAL CONDITIONS, THE CONTRACTOR SHALL IMMEDIATELY BRING SUCH ITEMS TO THE ATTENTION OF THE LANDSCAPE ARCHITECT AND OWNER.

UTILITY NOTES


- THE LANDSCAPE CONTRACTOR IS REQUIRED TO CONTACT THE COUNTY PUBLIC WORKS DEPARTMENT, AND ANY OTHER PUBLIC OR PRIVATE AGENCY NECESSARY FOR UTILITY LOCATION PRIOR TO ANY CONSTRUCTION.
- THIS DRAWING IS A PART OF A COMPLETE SET OF BID DOCUMENTS, SPECIFICATIONS, ADDITIONAL DRAWINGS, AND EXHIBITS. UNDER NO CIRCUMSTANCES SHOULD THESE PLANS BE USED FOR CONSTRUCTION PURPOSES WITHOUT EXAMINING ACTUAL LOCATIONS OF UTILITIES ON SITE, AND REVIEWING ALL RELATED DOCUMENTS.
- THE LOCATION OF THE ALL UNDERGROUND UTILITIES ARE LOCATED ON THE ENGINEERING DRAWINGS FOR THIS PROJECT. THE MOST CURRENT REVISION IS HEREIN MADE PART OF THIS DOCUMENT. UNDERGROUND UTILITIES EXIST THROUGHOUT THIS SITE AND MUST BE LOCATED PRIOR TO ANY CONSTRUCTION ACTIVITY. WHERE UNDERGROUND UTILITIES EXIST, FIELD ADJUSTMENT MAY BE NECESSARY AND MUST BE APPROVED BY A REPRESENTATIVE OF THE OWNER. NEITHER THE OWNER NOR THE LANDSCAPE ARCHITECT ASSUMES ANY RESPONSIBILITY WHATSOEVER, IN RESPECT TO THE CONTRACTOR'S ACCURACY IN LOCATING THE INDICATED PLANT MATERIAL, AND UNDER NO CIRCUMSTANCES SHOULD THESE PLANS BE USED WITHOUT REFERENCING THE ABOVE MENTIONED DOCUMENTS.

IRRIGATION CONCEPT

- AN AUTOMATIC IRRIGATION SYSTEM SHALL BE INSTALLED AND OPERATIONAL BY THE TIME OF FINAL INSPECTION. THE ENTIRE IRRIGATION SYSTEM SHALL BE INSTALLED BY A QUALIFIED IRRIGATION CONTRACTOR.
- THE IRRIGATION SYSTEM SHALL TAP OFF BUILDING'S POTABLE WATER SERVICE AFTER THE WATER METER, BEFORE BUILDING'S DOUBLE CHECK VALVE.
- THE IRRIGATION SYSTEM WILL OPERATE ON POTABLE WATER, AND THE SYSTEM WILL HAVE APPROPRIATE BACKFLOW PREVENTION DEVICES INSTALLED TO PREVENT CONTAMINATION OF THE POTABLE SOURCE.
- ALL NON-TURF/SEEDED PLANTED AREAS WILL BE DRIP IRRIGATED. TURF SOD/SEED SHALL RECEIVE POP-UP SPRAY IRRIGATION FOR HEAD TO HEAD COVERAGE.
- ALL PLANTS SHARING SIMILAR HYDROZONE CHARACTERISTICS SHALL BE PLACED ON A VALVE DEDICATED TO PROVIDE THE NECESSARY WATER REQUIREMENTS SPECIFIC TO THAT HYDROZONE.
- THE IRRIGATION SYSTEM SHALL BE DESIGNED AND INSTALLED, TO THE MAXIMUM EXTENT POSSIBLE, TO CONSERVE WATER BY USING THE FOLLOWING DEVICES AND SYSTEMS: MATCHED PRECIPITATION RATE TECHNOLOGY ON ROTOR AND SPRAY HEADS (WHEREVER POSSIBLE), RAIN SENSORS, AND SMART MULTI-PROGRAM COMPUTERIZED IRRIGATION CONTROLLERS FEATURING SENSORY INPUT CAPABILITIES.


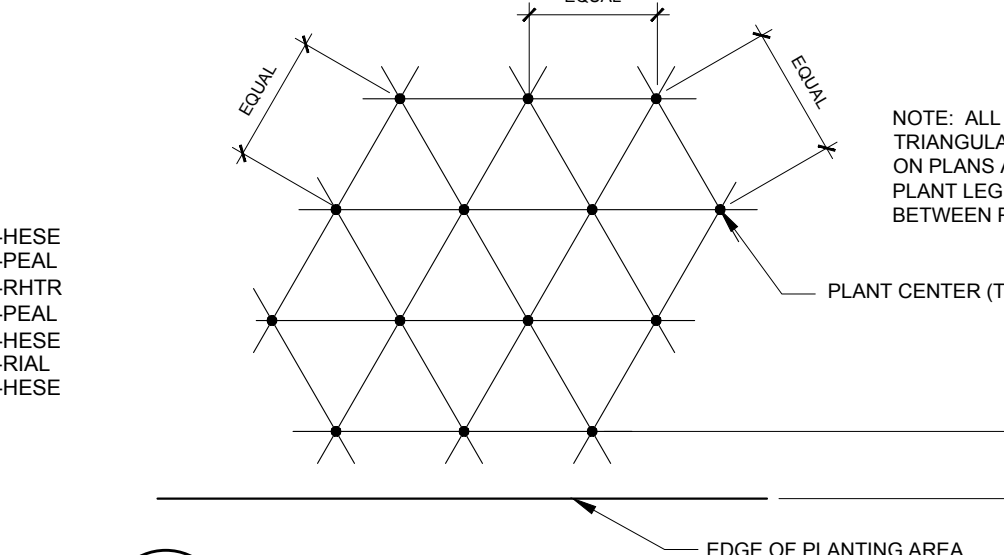


1 PLANT SPACING
SCALE: NTS

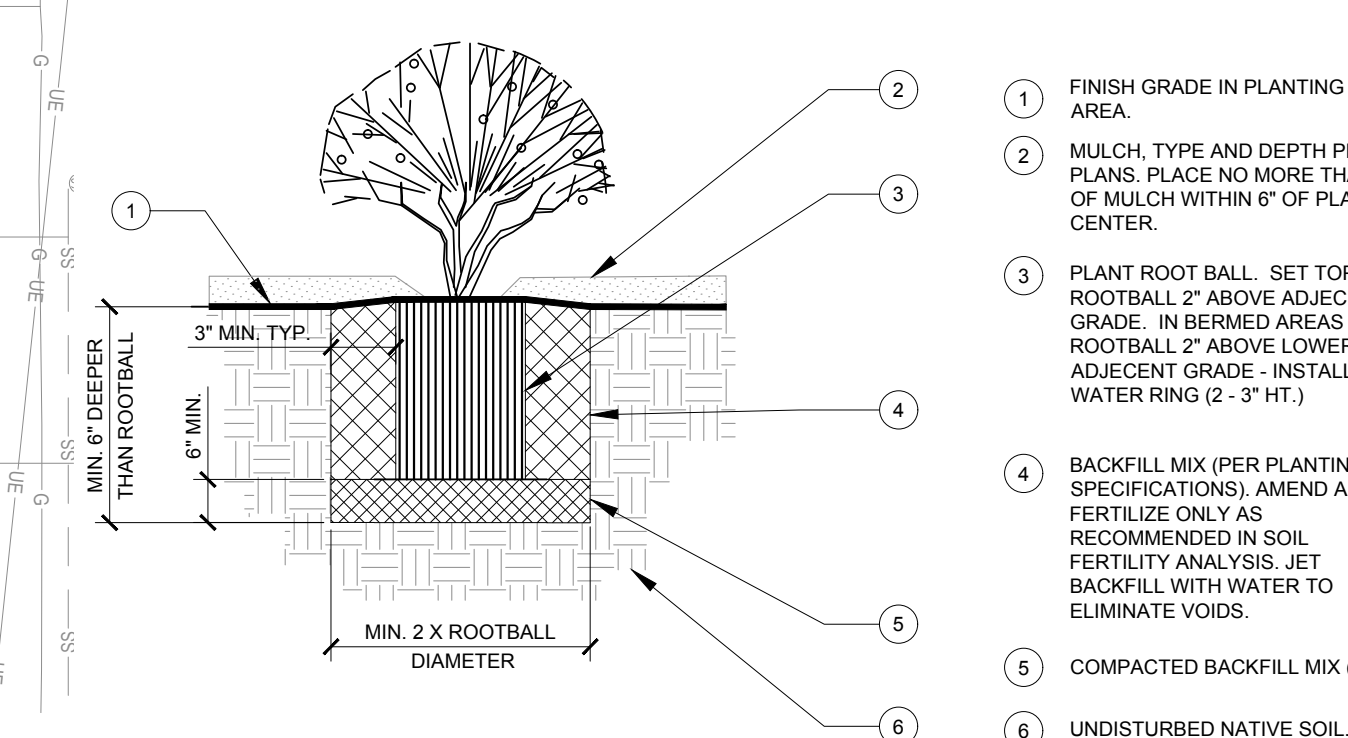

2 SHRUB AND PERENNIAL DETAIL
SCALE: NOT TO SCALE

SYMBOL	LEGEND ABBREV.	BOTANIC NAME	COMMON NAME	QUANTITY	MATURE SIZE	WATER USE	PLANTING SIZE
OVERSTORY DECIDUOUS TREES							
	GLTR	GLEDITSIA TRIACANTHOS INERMIS SHADEMASTER	SHADEMASTER LOCUST	1	50' X 35'	LOW	2.5' CAL B&B
ORNAMENTAL DECIDUOUS TREES							
	MASP	MALUS SPECIOSA	SPRING SNOW CRABAPPLE	3	25' X 20'	LOW	2.5' CAL B&B
DECIDUOUS SHRUBS							
	PEAT	PEROVSKIA ATRIPPLICIFOLIA	RUSSIAN SAGE	31	4' X 4'	LOW	5 GALLON 18" 24"
	RHAR	RHUS AROMATICA 'GRO-LOW'	GRO-LOW SUMAC	47	2' X 6'	LOW	5 GALLON 12"-15"
	RHTR	RHUS TRILOBATA	THREE LEAF SUMAC	55	4' X 4'	LOW	5 GALLON 18" 24"
	RIAL	RIBES ALPINUM	ALPINE CURRANT	74	4' X 4'	LOW	5 GALLON 18" 24"
	ROSA	ROSA 'RADCON'	PINK KNOCK OUT ROSE	40	4' X 3'	LOW	5 GALLON 18" 24"
ORNAMENTAL GRASSES							
	CAAC	CALAMAGROSTIS ACUTIFLORA 'KARL FOERSTER'	FEATHER REED GRASS	146	4.5' X 2'	LOW	1 GALLON
	HESA	HELICTOTRICHON SEMPERVIRENS	BLUE AVENA GRASS	273	2.5' X 2.5'	LOW	1 GALLON
	MIGR	MISCANTHUS SINENSIS 'GRAZIELLA'	GRAZIELLA MAIDEN GRASS	61	4.5' X 3'	LOW	1 GALLON
PERENNIALS							
	SAPA	SALVIA PACHYPHYLLA	MOJAVE SAGE	84	3' X 3'	LOW	1 GALLON
SEED AND MULCH							
	SOD	RTF SOD	SOD	8,854 SF		MODERATE	
	MULCH	2"-4" DIA. MULTI-CANYON GRANITE ROCK MULCH W/ SHREDED BARK MULCH RING, SEE MULCH NOTES	ROCK MULCH	8,017 SF			
		STEEL EDGING		527 LF			

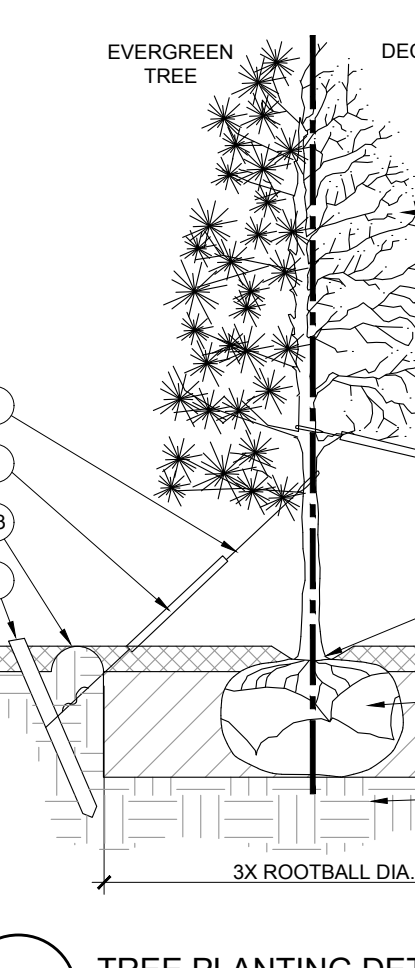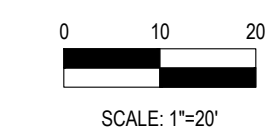

3 TREE PLANTING DETAIL
SCALE: NOT TO SCALE


ENT CREDIT UNION
SITE DEVELOPMENT PLAN
LOT 1, BLOCK 1,
CLAREMONT RANCH FILING NO. 9B
MARKSHEFFEL RD. AND CONSTITUTION AVE
COLORADO SPRINGS, COLORADO

#	Date	Issue / Description	Int.


Project No: ECU007
Drawn By: DTT
Checked By:
Date: 05/03/18

LANDSCAPE PLAN


ALL DRAWINGS, SPECIFICATIONS AND COPIES THEREOF ARE AND SHALL REMAIN THE PROPERTY OF THE ARCHITECT. THEY ARE TO BE USED ONLY WITH RESPECT TO THIS PROJECT AND ARE NOT TO BE USED ON ANY OTHER PROJECT OR EXTENSIONS TO THIS PROJECT, EXCEPT BY WRITTEN AGREEMENT AND APPROPRIATE COMPENSATION TO THE ARCHITECT. SUCH DOCUMENTS ARE TO BE RETURNED OR SUITABLY ACCOUNTED FOR BY THE ARCHITECT ON REQUEST AT THE COMPLETION OF WORK.

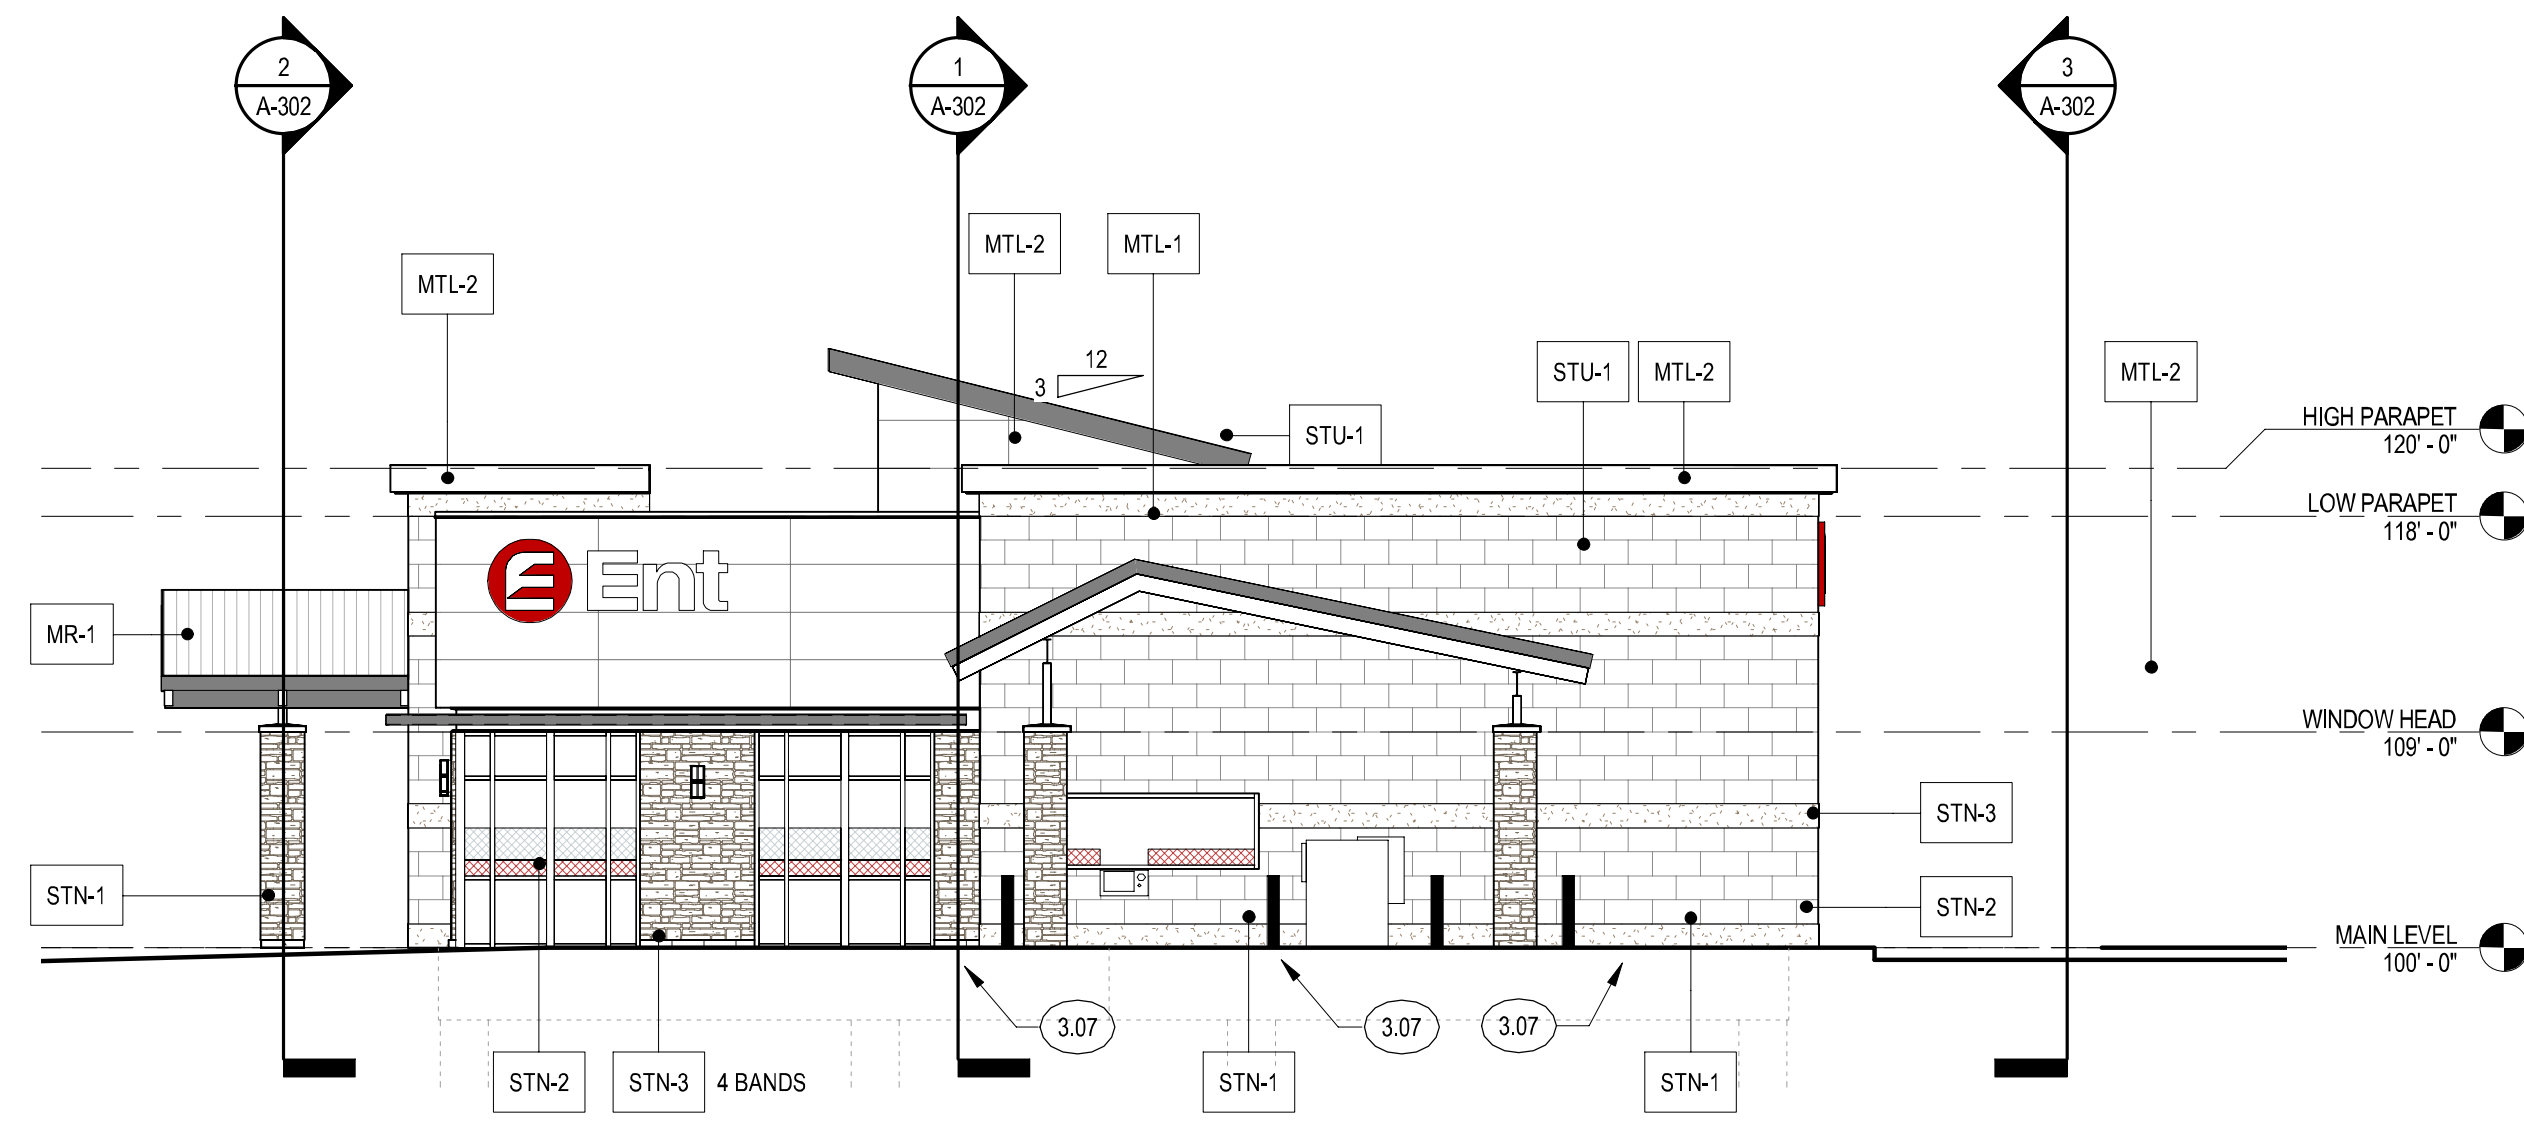


4 EXTERIOR ELEV - SOUTH
1/8" = 1'-0"

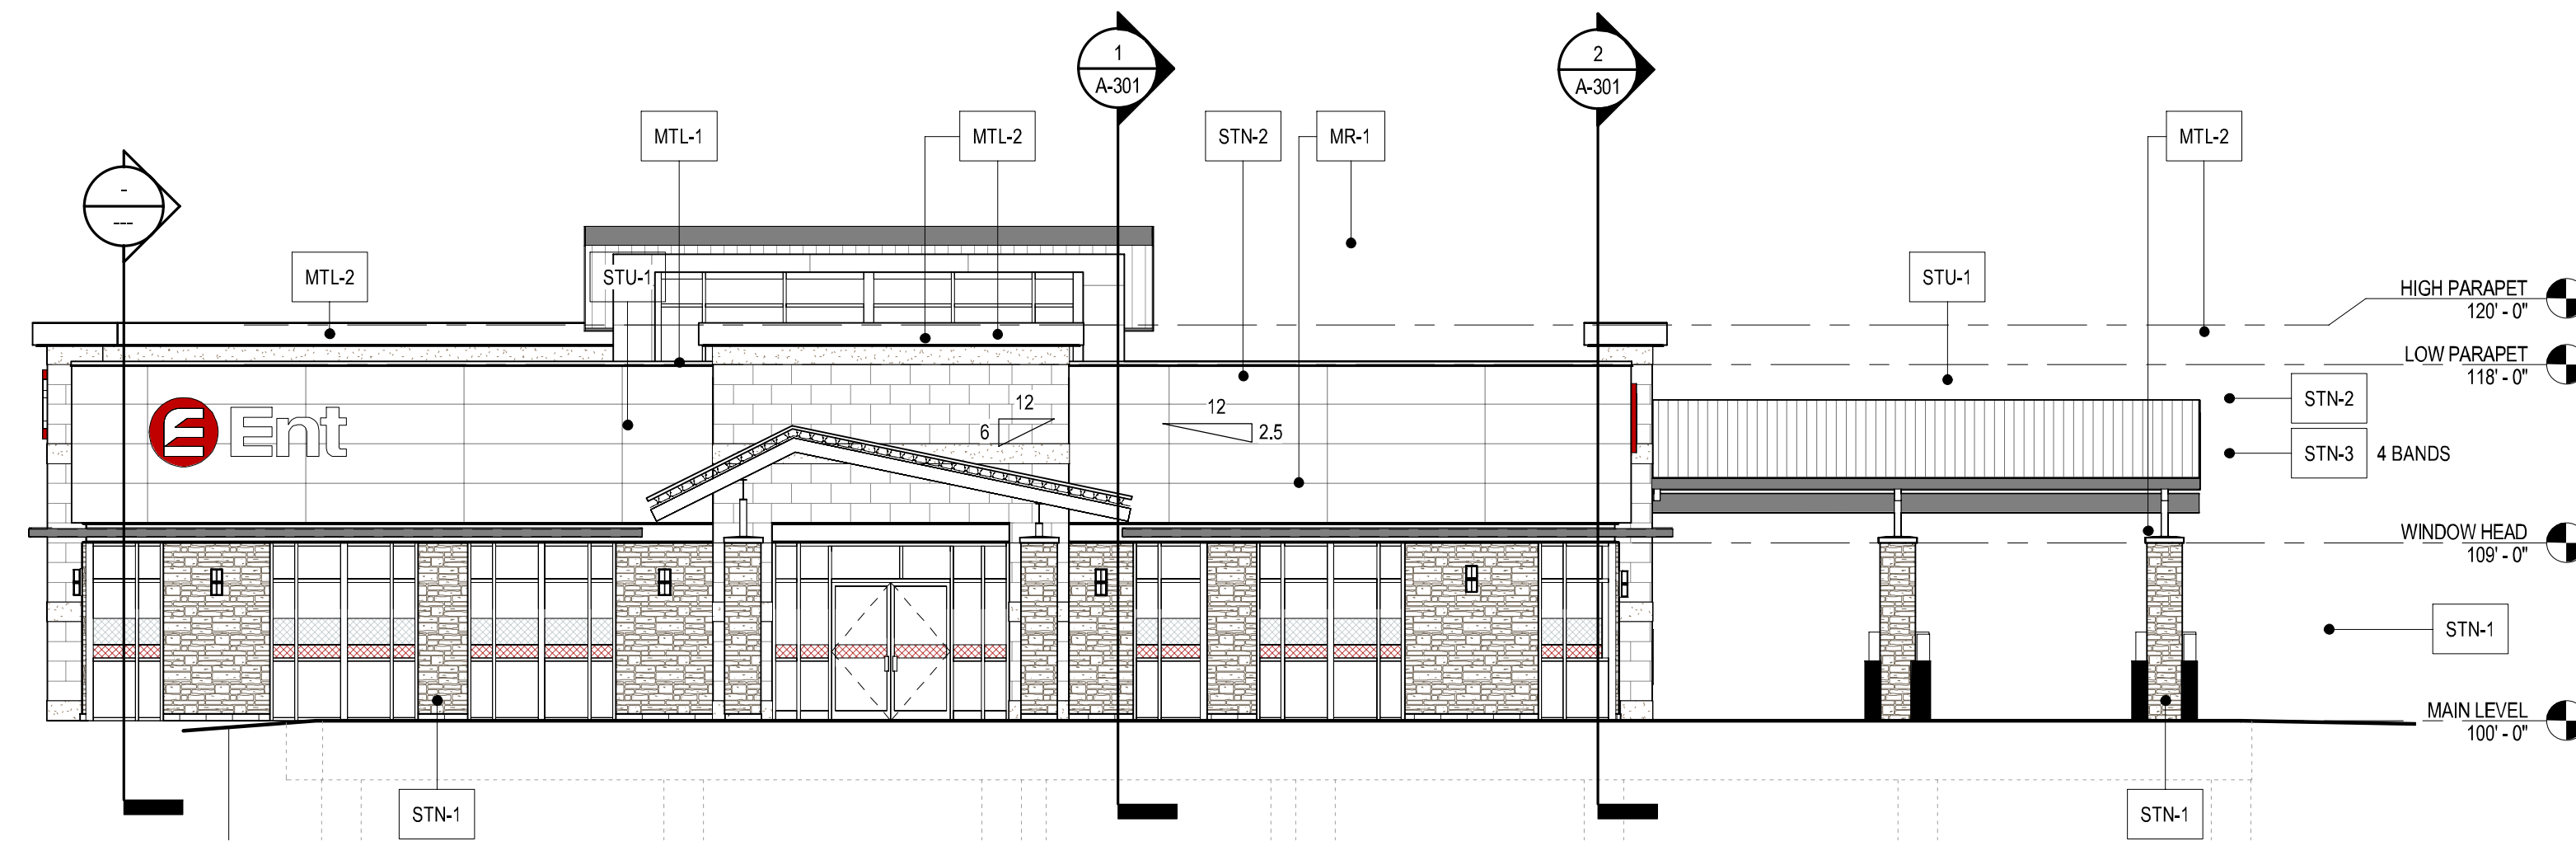

1 EXTERIOR ELEV - WEST (FRONT)
1/8" = 1'-0"

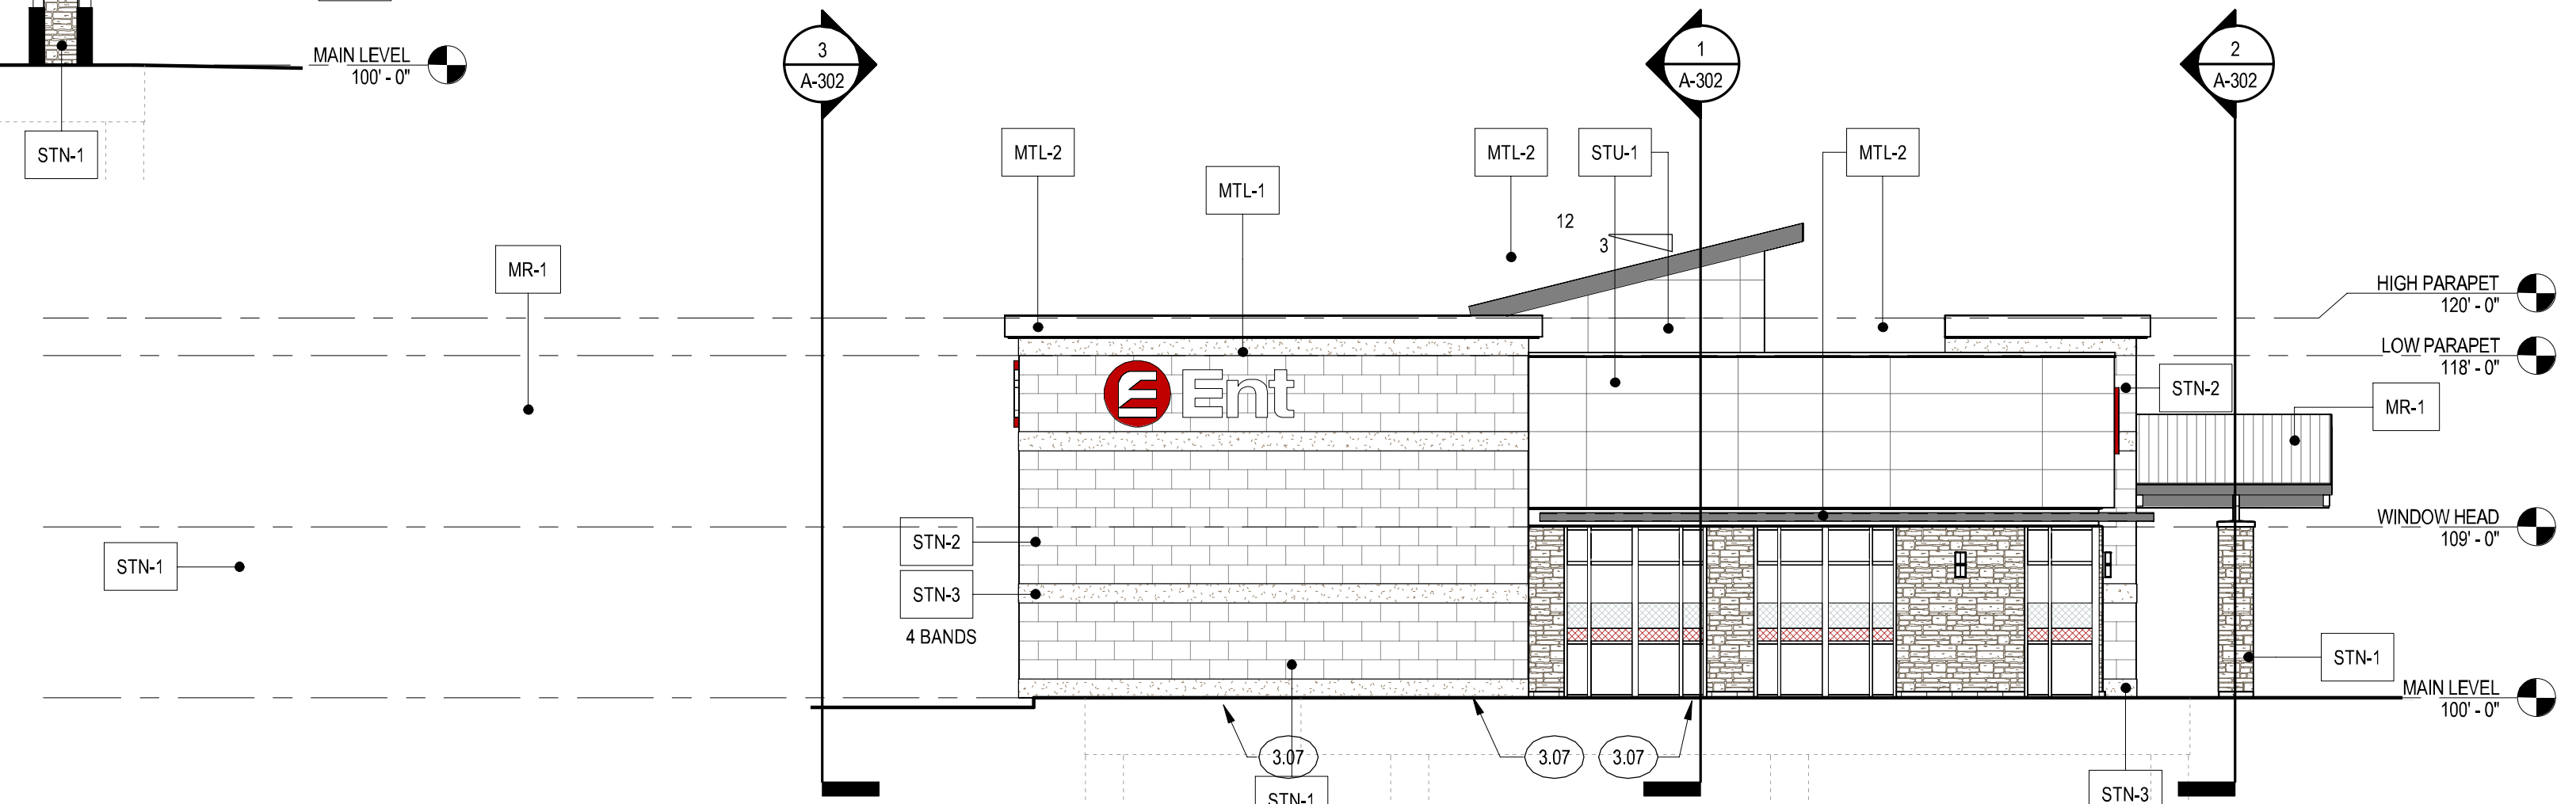

2 EXTERIOR ELEV - EAST (BACK)
1/8" = 1'-0"

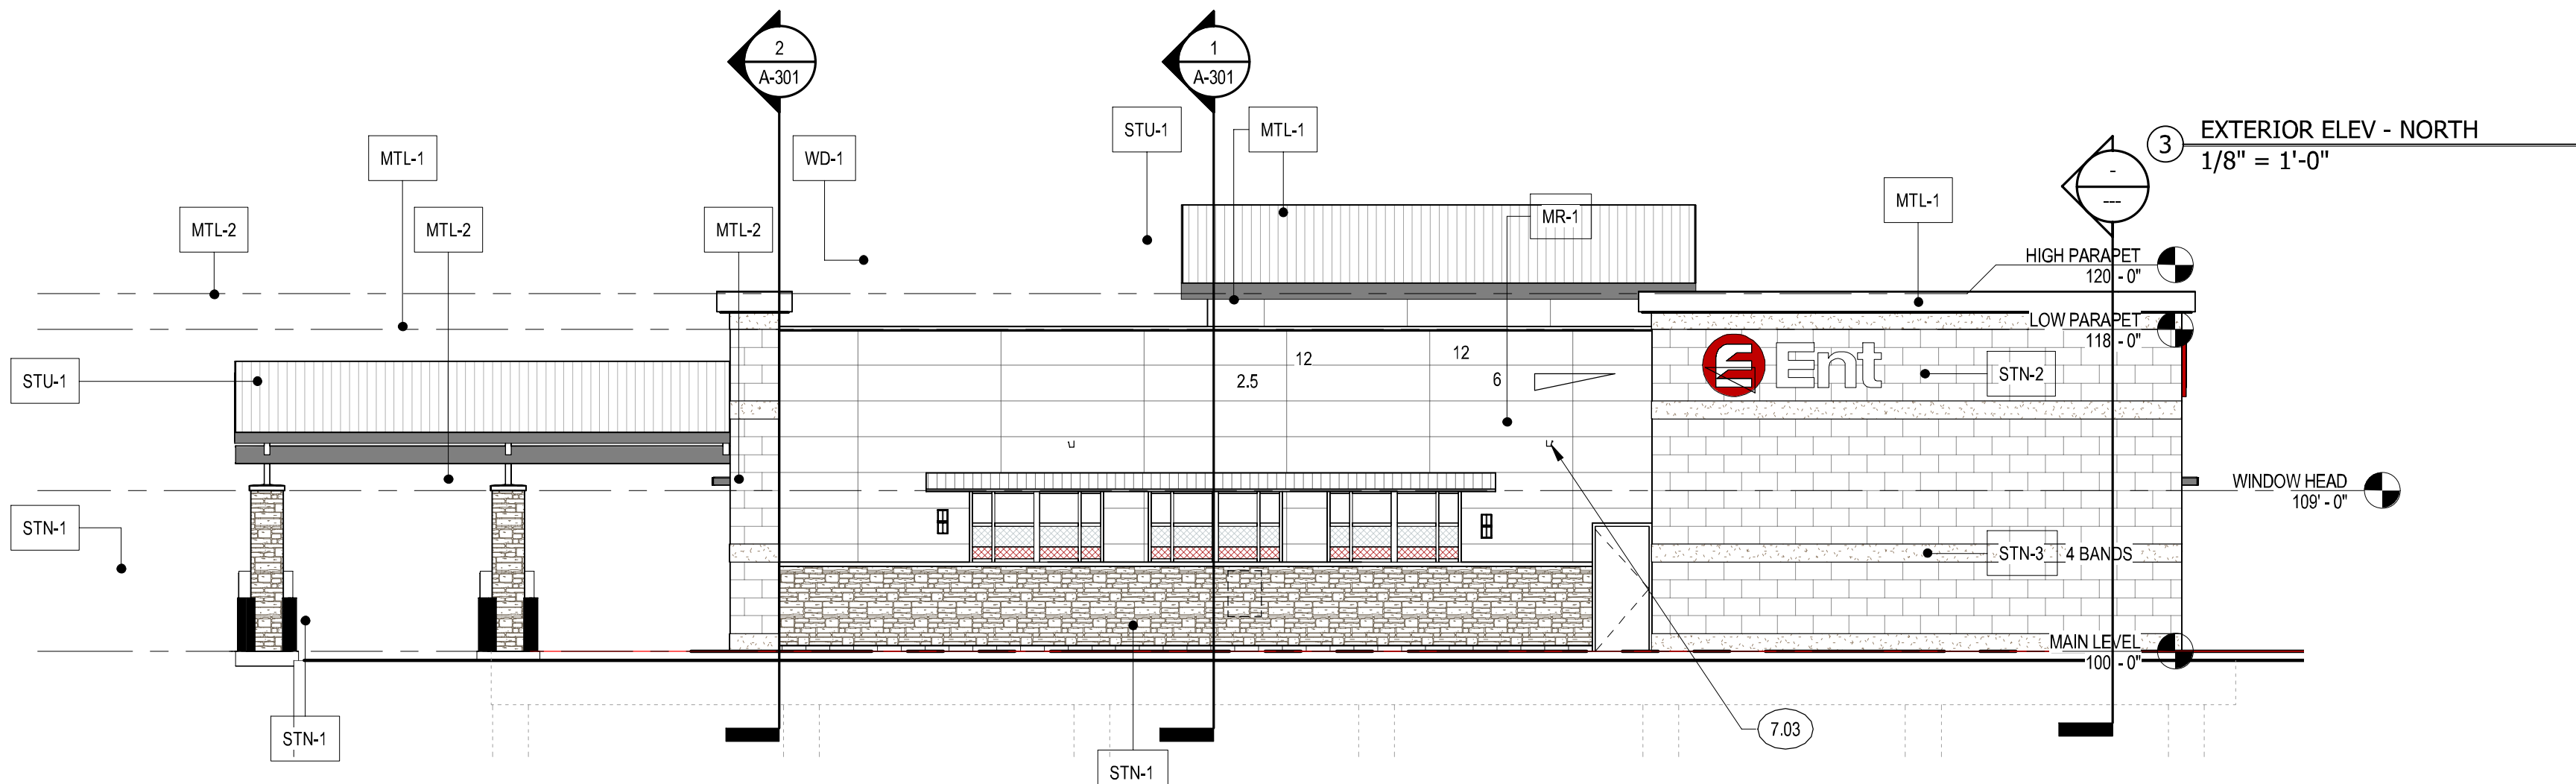

3 EXTERIOR ELEV - NORTH
1/8" = 1'-0"

ELEVATION GENERAL NOTES

1. WINDOW GRAPHICS PROVIDED AND INSTALLED BY OTHERS

EXTERIOR MATERIAL LEGEND

- STN-1: ARRISCRAFT STONE VENEER
ARRIS-STACK, COLOR: BEACH
- STN-2: ARRISCRAFT STONE VENEER
THIN-CLAD RENAISSANCE, SMOOTH FACE
COLOR: GINGER
- STN-3: ARRISCRAFT STONE VENEER
THIN-CLAD RENAISSANCE, ROUGH FACE
COLOR: GINGER
- STN-4: ARRISCRAFT RENAISSANCE MASONRY UNIT
3 5/8" DEPTH STANDARD MASONRY UNIT
COLOR: GINGER
- STU-1 (E-5): STANDARD STUCCO SYSTEM
COLOR TO MATCH DRYVIT #142 (SPECTRUM BROWN)
- MTL-1: METAL FLASHING AND TRIM
COLOR PAINTED/FINISHED TO MATCH BENJAMIN
MOORE AC-33
- MTL-2: METAL FLASHING AND ACCENTS
COLOR PAINTED/FINISHED CHARCOAL GRAY
- MR-1: STANDING SEAM METAL ROOF
CHARCOAL GREY
- AG: APPLIED WINDOW GRAPHICS
TRANSPARENT WHITE AND RED
- WD-1: WOOD CEILING BOARDS
BROWN RECLAIMED BOARDS
- STOREFRONT COLOR: LIGHT BRONZE
- GLASS: SOLAR GRAY (G-1)
- SPANDREL PANELS: LIGHT BRONZE

KEYNOTES

- 3.07 CONCRETE ISLAND, TYPICAL CURB AND GUTTER, NO STRUCTURAL REINFORCEMENT
- 7.03 GUTTER

ENT CREDIT UNION
LOT 1 BLK 1 CLAREMONT RANCH FIL NO 9A

2477 MARKSHEFFEL ROAD
COLORADO SPRINGS, CO 80927

KEYS + LAUER
ARCHITECTS

417 S. CASCADE
COLORADO SPRINGS, CO 80903
(719) 634 - 3751
www.KeysLauerArchitects.com

REVISIONS:	DATE	DESCRIPTION
#		

PROJECT #: 1723
ISSUE DATE: 12/26/2017
ISSUED FOR: PERMIT & BID
DRAWN BY: LC
CHECKED BY: VL
COPYRIGHT © 2015


SHEET TITLE:
EXTERIOR ELEVATIONS

SHEET #:
A-201
SHEET 7 OF 7

H:\Ent Credit Union\CO - El Paso Only - ECU000007.00 - Marksheffel\CADD\Consult\Keys & Lauer Arch\Revised\02-21-18\1723 - Constitution\GALEDT.rvt

Markup Summary


dsdkendall (8)

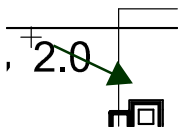


Subject: Arrow
Page Label: [4] 4 PHOTOMETRIC PLAN
Author: dsdkendall
Date: 5/30/2018 10:08:09 AM
Color: ■



Subject: Arrow
Page Label: [4] 4 PHOTOMETRIC PLAN
Author: dsdkendall
Date: 5/30/2018 10:08:14 AM
Color: ■

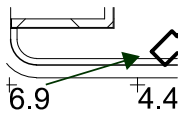


Subject: Arrow
Page Label: [4] 4 PHOTOMETRIC PLAN
Author: dsdkendall
Date: 5/30/2018 10:08:31 AM
Color: ■

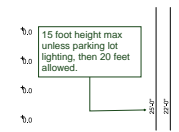


Subject: Callout
Page Label: [4] 4 PHOTOMETRIC PLAN
Author: dsdkendall
Date: 5/30/2018 10:09:38 AM
Color: ■

15 foot height max unless parking lot lighting, then 20 feet allowed.

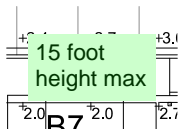

Subject: Text Box
Page Label: [4] 4 PHOTOMETRIC PLAN
Author: dsdkendall
Date: 5/30/2018 10:10:26 AM
Color: ■

15 foot height max

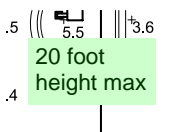


Subject: Text Box
Page Label: [4] 4 PHOTOMETRIC PLAN
Author: dsdkendall
Date: 5/30/2018 10:10:32 AM
Color: ■

20 foot height max



Subject: Text Box
Page Label: [4] 4 PHOTOMETRIC PLAN
Author: dsdkendall
Date: 5/30/2018 10:10:35 AM
Color: ■

20 foot height max

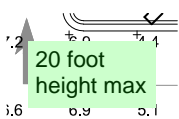

Subject: Text Box
Page Label: [4] 4 PHOTOMETRIC PLAN
Author: dsdkendall
Date: 5/30/2018 10:10:38 AM
Color: ■

20 foot height max