

According to the El Paso County Assessors office this parcel is rectangle as well as "TOG Nevada Lane". Please correct your site plan to reflect the addition of Nevada Lane as a part of your property. Please show/include all easements

Please call out all adjacent property owners, as can be found on the El Paso County Assessors page.

an access easement for the property to the north where your driveway encroaches onto their property is required.



provide easement here.

Show Easements on the property.

what is this additional rectangle suppose to represent?

Please provide additional information on this structure. Will it be used for this operation?

Show 25 foot building setback (structures included in this i.e. connex's) around the entire property.

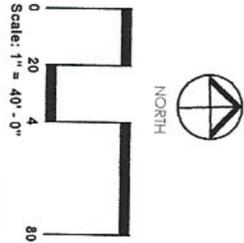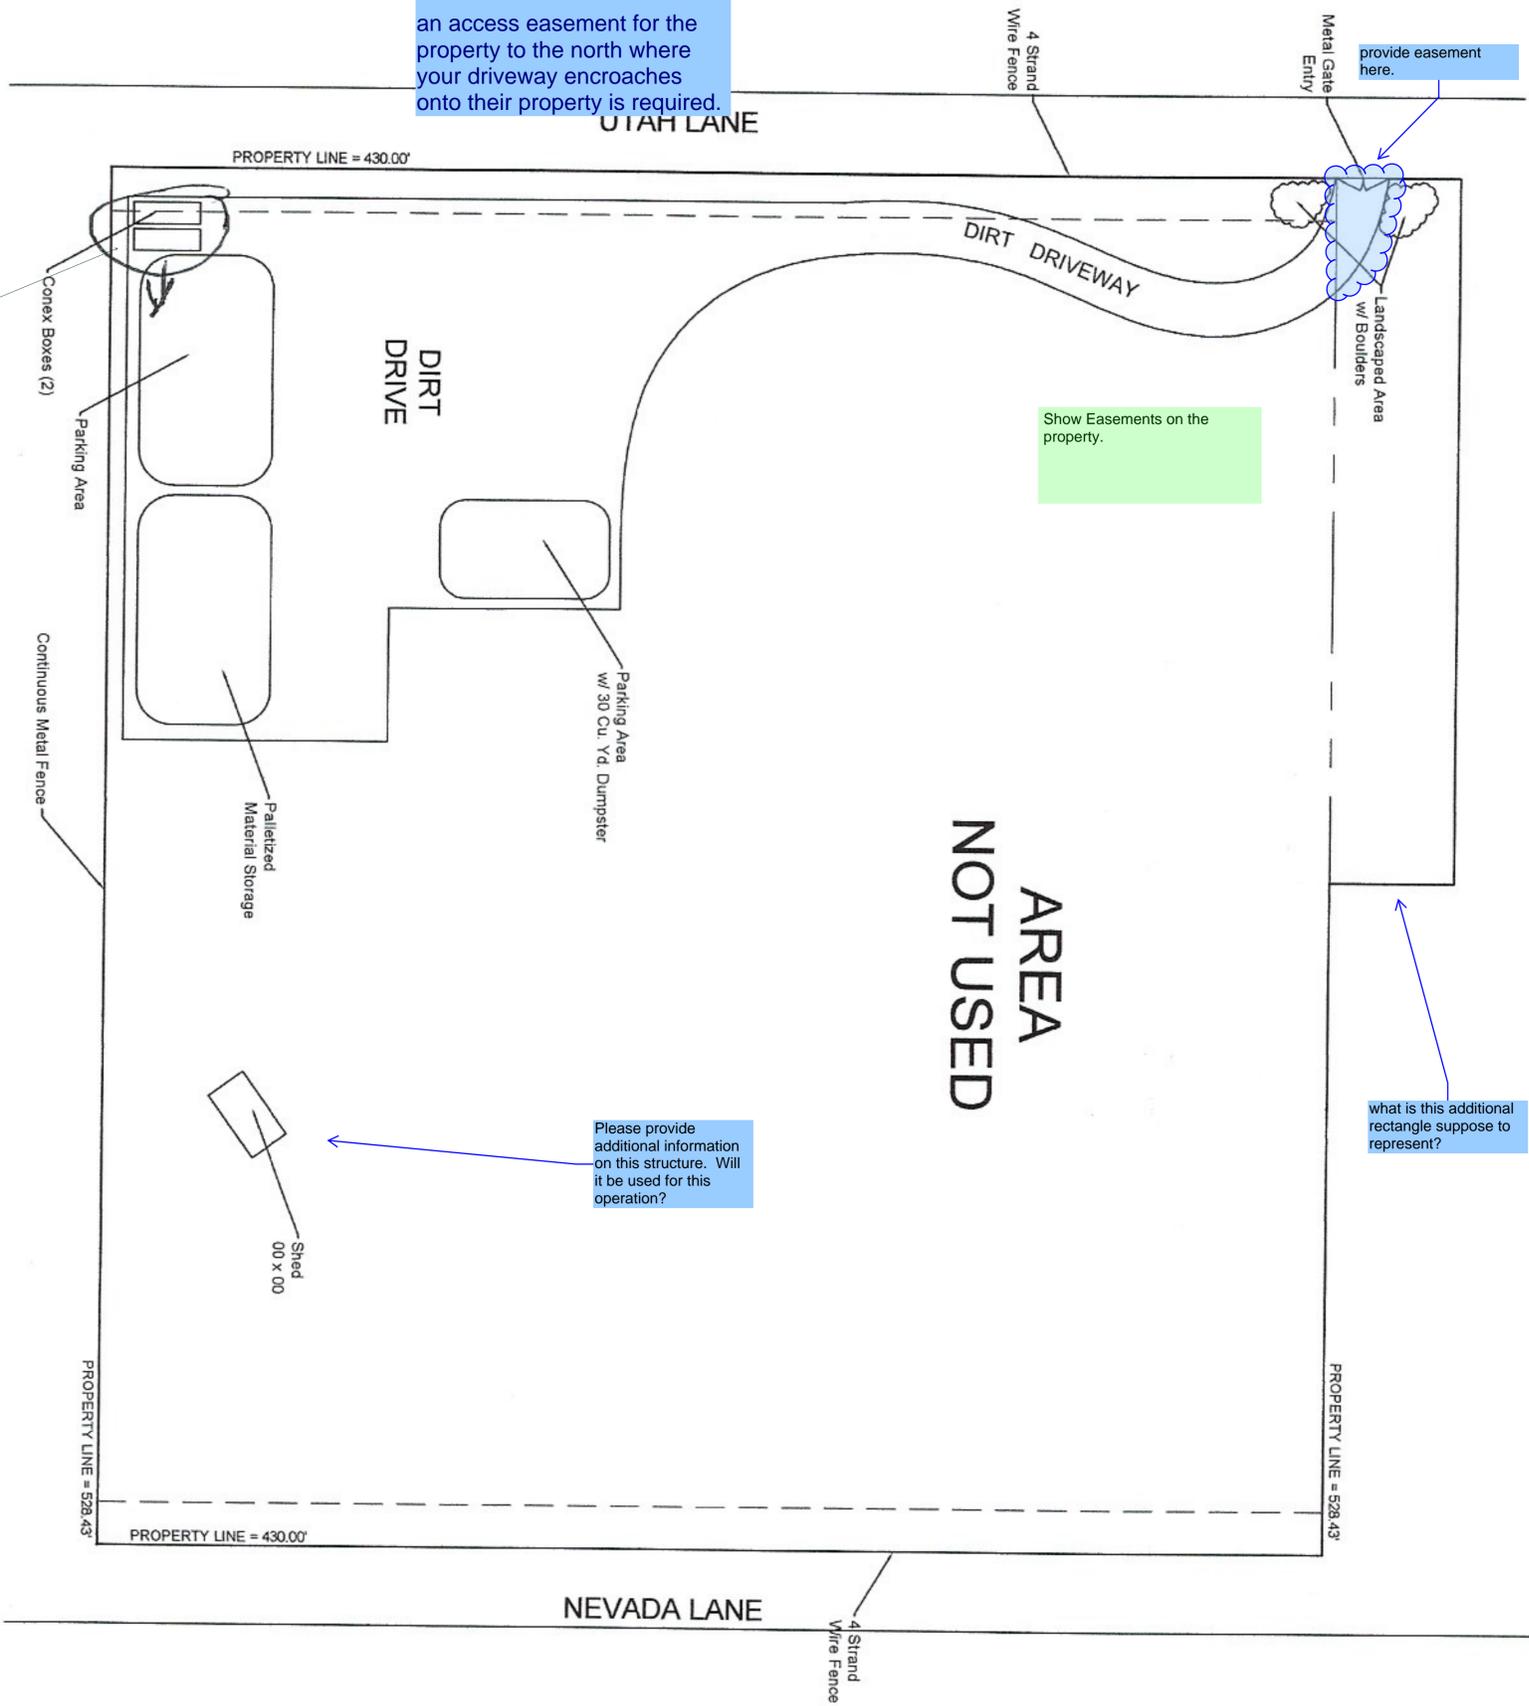


PLOT PLAN

○ NEVADA LANE
COLORADO SPRINGS, COLORADO


Markup Summary

dsdkendall (2)

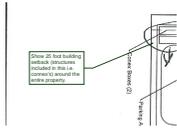

Subject: Callout
Page Label: 1
Author: dsdkendall
Date: 6/25/2018 4:03:44 PM
Color: ■

Show 25 foot building setback (structures included in this i.e. connex's) around the entire property.

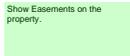


Subject: Text Box
Page Label: 1
Author: dsdkendall
Date: 6/25/2018 4:04:20 PM
Color: ■

Show Easements on the property.

dsdnijkamp (6)




Subject: Text Box
Page Label: 1
Author: dsdnijkamp
Date: 6/28/2018 3:13:56 PM
Color: ■

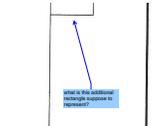


Subject: Engineer
Page Label: 1
Author: dsdnijkamp
Date: 6/28/2018 3:49:00 PM
Color: ■

what is this additional rectangle suppose to represent?

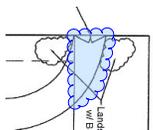

Subject: Engineer
Page Label: 1
Author: dsdnijkamp
Date: 6/28/2018 3:56:23 PM
Color: ■

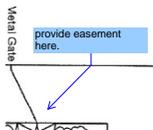

Subject: Engineer
Page Label: 1
Author: dsdnijkamp
Date: 6/28/2018 3:56:45 PM
Color: ■

provide easement here.



Subject: Engineer
Page Label: 1
Author: dsdnijkamp
Date: 6/28/2018 4:22:18 PM
Color: ■

According to the El Paso County Assessors office this parcel is rectangle as well as "TOG Nevada Lane". Please correct your site plan to reflect the addition of Nevada Lane as a part of your property. Please show/include all easements

Please call out all adjacent property owners, as can be found on the El Paso County Assessors page.

an access easement for the property to the north where your driveway encroaches onto their property is required.



Subject: Engineer
Page Label: 1
Author: dsdnijkamp
Date: 6/28/2018 4:26:39 PM
Color: ■

Please provide additional information on this structure. Will it be used for this operation?