


WOODMAN-UTAH LLC  
C/O VANTAGE HOMES CORP  
7425 ADVENTURE WAY

For county record keeping purposes, please submit a driveway access waiver (may be obtained at the front counter at planning and community development).

MOUNTAIN SPRINGS CHURCH  
7345 ADVENTURE WAY

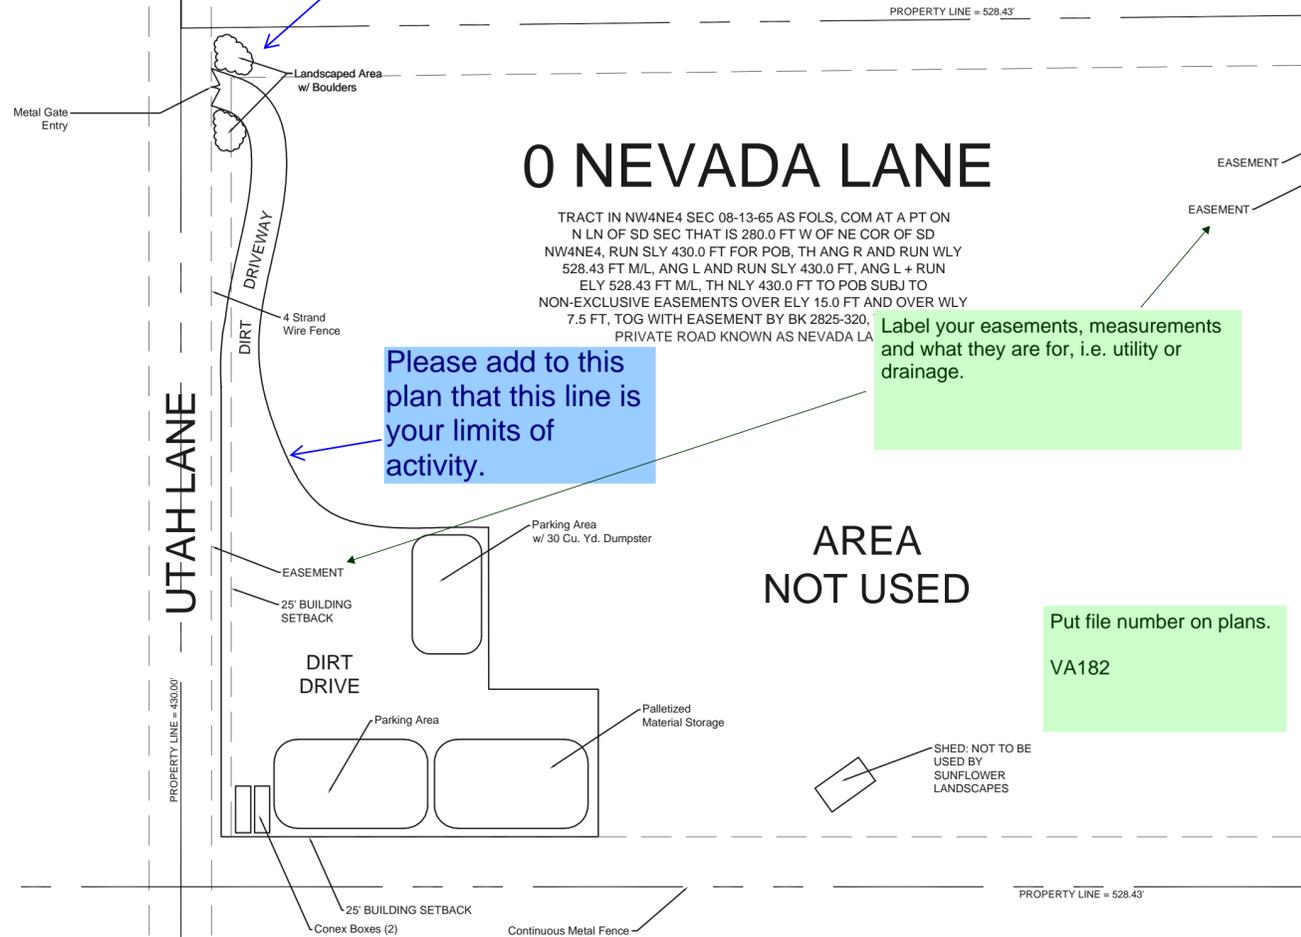

Please add to this plan that this line is your limits of activity.

Label your easements, measurements and what they are for, i.e. utility or drainage.

Put file number on plans.  
VA182

WOODMAN-UTAH LLC  
C/O VANTAGE HOMES CORP  
7525 ADVENTURE WAY


BSK INVESTMENTS LLC  
7340 UTAH LANE

GREENER PASTURES LLC  
7280 ADVENTURE WAY

PLOT PLAN  
O NEVADA LANE  
COLORADO SPRINGS, COLORADO



NORTH

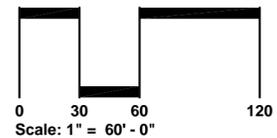

# Markup Summary


## dsdgrimm (3)

E.L.T. 0425-4-4 P 1 R.M.L.  
 NON-EXCLUSIVE EASEM  
 7.5 FT. TOG WITH E<sup>2</sup>  
 PRIVATE RO<sup>2</sup>  
 Please add to this plan that this line is your limits of activity.


**Subject:** Engineer  
**Page Label:** 1  
**Author:** dsdgrimm  
**Date:** 7/26/2018 2:57:18 PM  
**Color:** ■

Please add to this plan that this line is your limits of activity.

Parking Area  
 w/ 30 Cu. Yd. Dumpster

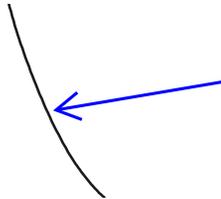


**Subject:** Arrow  
**Page Label:** 1  
**Author:** dsdgrimm  
**Date:** 7/26/2018 2:58:24 PM  
**Color:** ■

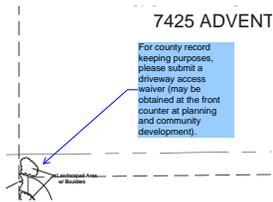


**Subject:** Engineer  
**Page Label:** 1  
**Author:** dsdgrimm  
**Date:** 8/1/2018 4:10:08 PM  
**Color:** ■

For county record keeping purposes, please submit a driveway access waiver (may be obtained at the front counter at planning and community development).

## dsdkendall (4)

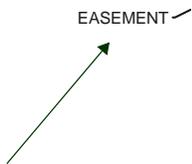


**Subject:** Arrow  
**Page Label:** 1  
**Author:** dsdkendall  
**Date:** 8/1/2018 4:07:40 PM  
**Color:** ■

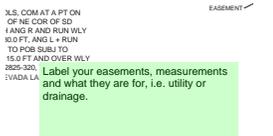

**Subject:** Text Box  
**Page Label:** 1  
**Author:** dsdkendall  
**Date:** 8/1/2018 4:08:33 PM  
**Color:** ■

Label your easements, measurements and what they are for, i.e. utility or drainage.

## AREA

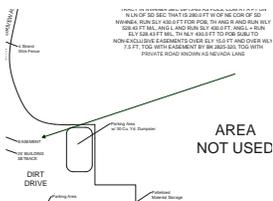

**Subject:** Arrow  
**Page Label:** 1  
**Author:** dsdkendall  
**Date:** 8/1/2018 4:08:53 PM  
**Color:** ■

Put file number on plans.

VA182

**Subject:** Text Box  
**Page Label:** 1  
**Author:** dsdkendall  
**Date:** 8/1/2018 4:09:43 PM  
**Color:** ■

Put file number on plans.

VA182

TO BE  
2