On the submitted PBMP form, Exclusion E "Large Lot Single Family Sites" was selected to exclude the site from a PBMP. The qualifications for this exclusions is presented in the ECM section I.7.1.B.5:

"Large Lot Single Family Sites. A single-family residential lot, or agricultural zoned lands, greater than or equal to 2.5 acres in size per dwelling and having a total lot impervious area of less than 10 percent. A total lot imperviousness greater than 10 percent is allowed when a study specific to the watershed and/or MS4 shows that expected soil and vegetation conditions are suitable for infiltration/filtration of the WQCV for a typical site, and the permittee accepts such study as applicable within its MS4 boundaries. The maximum total lot impervious covered under this exclusion shall be 20 percent."

Add a plat note acknowledging that per ECM section I.7.1.B.5, the residential lots impervious area may not exceed 10 percent unless a study is prepared in compliance with the requirements laid out in the above ECM section and the impervious area may not exceed 20 percent. This impervious area for each lot must include the proposed driveway.

KNOW ALL MEN BY THESE PRESENTS:

THAT GARRETT GRAUPNER AND CHRISTOPHER VILLANUEVA BEING THE OWNERS OF THE FOLLOWING DESCRIBED TRACT OF LAND. TO WIT:

LEGAL DESCRIPTION:

THAT PORTION OF THE NORTH HALF OF THE SOUTHEAST QUARTER AND THE NORTH HALF OF THE SOUTHWEST QUARTER OF SECTION 32, TOWNSHIP 11 SOUTH, RANGE 64 WEST OF THE 6TH P.M., BEING MORE PARTICULARLY DESCRIBED AS FOLLOWS:

BEGINNING AT A POINT WHICH IS ON THE SOUTHERLY LINE OF THE NORTH HALF OF THE SOUTHWEST QUARTER OF SECTION 32 AND IS THE MOST SOUTHEASTERLY CORNER OF WOODLAKE FILING NO. 3 AS RECORDED IN PLAT BOOK G-3 AT PAGE 60 OF THE RECORDS OF EL PASO COUNTY, COLORADO;

THENCE FOLLOWING ALONG THE EAST BOUNDARY OF SAID FILING NO. 3 FOR ONE COURSE; (1) THENCE NORTH OO DEGREES 33 MINUTES 14 SECONDS WEST, 569.89 FEET TO THE SOUTHERLY RIGHT-OF-WAY LINE OF TANNER TRAIL:

THENCE EASTERLY FOLLOWING ALONG SAID RIGHT-OF-WAY LINE FOR THE NEXT TWO (2) COURSES;

(1) THENCE ANGLE RIGHT 79 DEGREES 47 MINUTES 36 SECONDS TO THE TANGENT OF A CURVE TO THE RIGHT, WHOSE RADIUS IS 670.00 FEET, THROUGH A CENTRAL ANGLE OF 06 DEGREES 57 MINUTES 50 SECONDS, AN ARC LENGTH OF 81.43 FEET TO A POINT OF CURVATURE:

THENCE ANGLE RIGHT 60 DEGREES 05 MINUTES 38 SECONDS TO THE TANGENT OF A CURVE TO THE LEFT WHOSE RADIUS IS 50.00 FEET, THROUGH A CENTRAL ANGLE OF 49 DEGREES 53 MINUTES 14 SECONDS, AN ARC LENGTH OF 43.53 FEET;

THENCE NORTH 89 DEGREES 26 MINUTES 46 SECONDS EAST 1739.61 FEET;

THENCE NORTH 00 DGREES 59 MINUTES 53 SECONDS WEST, 567.20 FEET;

THENCE NORTH 87 DEGREES 37 MINUTES 00 SECONDS EAST, 653.67 FEET;

THENCE SOUTH 00 DEGREES 44 MINUTES 06 SECONDS EAST, 1148.01 FEET TO INTSERSECT THE SOUTHERLY LINE OF THE NORTH HALF OF THE SOUTHEAST QUARTER OF SECTION 32;

THENCE FOLLOWING ALONG SAID SOUTHERLY LINE SOUTH 89 DEGREES 22 MINUTES 15 SECONDS WEST, 1279.05 FEET;

THENCE ALONG THE SOUTHERLY LINE OF THE NORTH HALF OF THE SOUTHWEST QUARTER. SOUTH 89 DEGREES 26 MINUTES 46 SECONDS WEST, 1232.19 FEET TO THE POINT OF BEGINNING, COUNTY OF EL PASO, STATE OF COLORADO.

BASIS OF BEARINGS: THE NORTH-SOUTH LINE AS DESCRIBED IN THE LEGAL DESCRIPTION AS BEARING N 00°59'53" W, BEING MONUMENTED AT BOTH ENDS BY A NUMBER 5 REBAR, HAVING A RECORD DISTANCE OF 567.20 FEET AND A MEASURED DISTANCE OF 566.57 FEET.

THE UNDERSIGNED OWNERS HAVE CAUSED SAID TRACT OF LAND TO BE PLATTED INTO LOTS, AND EASEMENTS, AS SHOWN ON THE PLAT. THIS TRACT OF LAND AS PLATTED HEREIN SHALL BE KNOWN AS "GRAUPNER SUBDIVISION", EL PASO COUNTY, COLORADO.

OWNER:

THAT, THE AFOREMENTIONED GARRETT GRAUPNER, HAS EXECUTED THIS INSTRUMENT THIS

Add to Notes

_____, DAY OF ______, 20___, A.D.

STATE OF COLORADO COUNTY OF EL PASO

depends upon the language of the water decree and/or augmentation plan, and will be reviewed and approved by the County Attorney's Office) Individual wells are the responsibility of each property owner. NOTARY: Permits for individual wells must be obtained from the State

OF _____, 20__, A.D.

THE FOREGOING INSTRUMENT WAS ACK issuance of these permits. Water in the Denver Basin Aquifers is allocated based on a 100-year aquifer life; however, for El Paso County planning purposes, water in the Denver Basin Aquifers is evaluated based on a 300-year aquifer life. Applicants and all future owners in the subdivision should be

aware that the economic life of a water supply based on wells in a given Denver Basin Aquifer may be less than either the 100 years or 300 years indicated due to anticipated water level declines. Furthermore, the water supply plan should not rely solely upon non-renewable aquifers. Alternative renewable water resources should be acquired and incorporated in a permanent water supply plan that provides future generations with a water supply. (Utilized when there is a joint well agreement for common use of

Permits for individual wells must be obtained from the State Engineer who by law has the authority to set conditions for the WITNESS MY HAND AND OFFICIAL SEAL issuance of these permits. Two (2) existing well permits Nos.

MY COMMISSION EXPIRES: _____

NOTARY PUBLIC

each. Well permit No. _____ will serve Lots __ and __, Block _ subject to a joint Use Water Well Agreement as recorded under Reception No. ______. Well permit No. ______ will serve Lot _, Block __ and Lot __, Block __, subject to a Joint Use Water Well Agreement as recorded under Reception No. _____, which limits production to the _____ Aguifer at an interval between ___ and ___ feet below ground surface. Lot __ and __, Block __ and Lots __ through __, Block __ will limit production to the Aquifer at an interval between ____ and ____ feet below ground surface. Owner, its successors and assigns shall advise the Property Owners Association (or Homeowners Association) and all future owners of these lots of all applicable requirements of the decree entered in Case No. (Division), and their costs of operating the plan for augmentation and responsibility for metering and collecting data regarding water withdrawals from wells. Owner shall reserve in any deeds of the property __

acre-feet of _____ Aquifer and _____

(Division) for use in this augmentation plan.

augmentation plan.

___ and _____ will serve two (2) single family dwellings

Water Supply: (utilized when the water supply is individual wells)

Engineer who by law has the authority to set conditions for the

(Note: The exact wording of plat notes regarding well water supply

DATE OF PREPARATION: 8/09/20 JOB NUMBER: 22140-02

_ acre feet total of Aguifer water as decreed in Case No. Water withdrawal and wells are subject to limitations, restrictions and augmentation requirements and responsibilities as found within the Covenants for this subdivision recorded in Reception No. , of the Office of the El Paso County Clerk and Recorder and the terms of the water court approved water

GRAUPNER SUBDIVISION

A SUBDIVISION OF A PART OF THE SOUTH 1/2 OF SECTION 32 TOWNSHIP 11 SOUTH, RANGE 64 WEST OF THE 6TH P.M., COUNTY OF EL PASO, STATE OF COLORADO. AREA = 41.021 ACRES, MORE OR LESS

MURPHY ROAD

VICINITY MAP

All public improvements so platted are hereby dedicated to public use and

(name(s) of individual(s) making statement).

Add to Notes:

Statement that maintenance of easements

shall be the responsibility of the property

The undersigned, being all the owners, mortgagees, beneficiaries of deeds of trust and holders of other

streets, and easements (use which are applicable) as shown hereon under the name and subdivision of

said owner does hereby covenant and agree that the public improvements will be constructed to El Paso

County standards and that proper drainage and erosion control for same will be provided at said owner's

maintenance by El Paso County, Colorado. The utility easements shown hereon are hereby dedicated

responsible for providing the services for which the easements are established are hereby granted the

perpetual right of ingress and egress from and to adjacent properties for installation, maintenance, and

expense, all to the satisfaction of the Board of County Commissioners of El Paso County, Colorado.

for public utilities and communication systems and other purposes as shown hereon. The entities

Upon acceptance by resolution, all public improvements so dedicated will become matters of

Signatures of officers signing for a corporation shall be acknowledged as follows:

B Signatures of managers/members for a LLC shall be acknowledged as follows:

(print name) as Manager/Member of company, a state limited liability company.

Geologic Hazard Note-Final Plat: (to be customized based upon the individual circumstances)

The following lots have been found to be impacted by geologic hazards. Mitigation measures and a map

of the hazard area can be found in the report (Title of Report, generally from the Preliminary Plan file) by

(author of the report) (date of report) in file (name of file and file number) available at the El Paso County

Due to high groundwater in the area, all foundations shall incorporate an underground drainage system.

(print name) as President/Vice President and print name as Secretary/Treasurer, name of corporation, a

(Note: Required when separate ratification statements for deed of trust holders, mortgagees are not

replacement of utility lines and related facilities.

Owners/Mortgagee (Signature)

T ATTEST: (if corporation)

- Secretary/Treasurer

State of Colorado

Signed before me on

(Notary's official signature)

Commission Expiration)

WITNESS MY HAND AND OFFICIAL SEAL.

Planning and Community Development Department:

Downslope Creep: (name lots or location of area)

Rockfall Runout Zone:(name lots or location of area)

Potentially Seasonally High Groundwater:(name lots or location of area)

•Rockfall Source:(name lots or location of area)

MY COMMISSION EXPIRES: _____

DEMICIONIC

Soil and Geology Conditions:

In Areas of High Groundwater:

NOTARY PUBLIC

Add to Notes

Other Hazard:

County of ___

(Title of office)

interests in the land described herein, have laid out, subdivided, and platted said lands into lots, tracts,

Insert signature line and date for PCD director under BoCC signature line

(5) FOOT EASEMENT

A SEVEN (7) FOOT


DLE RESPONSIBILITY

UMENT RECORDED AT

RADO. ALL OTHER

POSES SHALL BE

You can remove title commitment notes

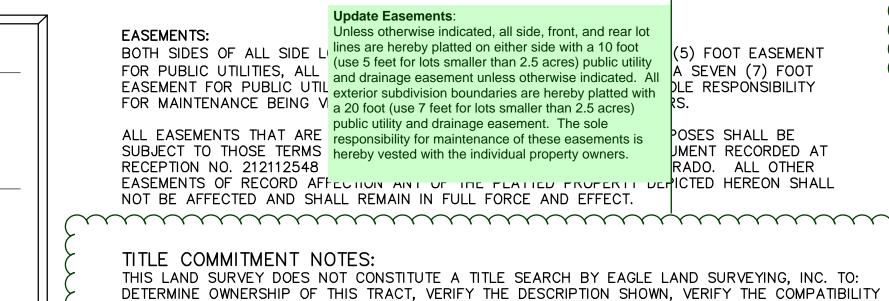

TITLE COMMITMENT NOTES:

THIS LAND SURVEY DOES NOT CONSTITUTE A TITLE SEARCH BY EAGLE LAND SURVEYING, INC. TO: DETERMINE OWNERSHIP OF THIS TRACT, VERIFY THE DESCRIPTION SHOWN, VERIFY THE COMPATIBILITY OF THIS DESCRIPTION WITH THAT OF ADJACENT TRACTS, OR VERIFY EASEMENTS OF RECORD. FOR ALL INFORMATION REGARDING EASEMENTS, RIGHT-OF-WAY OR TITLE OF RECORD, EAGLE LAND SURVEYING, INC. RELIED UPON TITLE COMMITMENT NO. 202793, PREPARED BY STEWART TITLE GUARANTY COMPANY FOR CAPSTONE TITLE, DATED SEPTEMBER 01, 2020 AT 8:00 A.M.

Unless otherwise indicated, all side, front, and rear lot

use 5 feet for lots smaller than 2.5 acres) public utility

lines are hereby platted on either side with a 10 foot

public utility and drainage easement. The sole

responsibility for maintenance of these easements is

THE FOLLOWING COMMENTS ARE IN REGARDS TO SAID TITLE COMMITMENT. THE NUMBERS IN OUR COMMENTS CORRESPOND TO THE NUMBERING SYSTEM USED IN SAID TITLE COMMITMENT.

SCHEDULE B - SECTION 2 (EXCEPTIONS)

ITEM COMMENT

RESERVATIONS CONTAINED IN PATENT(S) DATED DECEMBER 05, 1884 CERTIFICATE NO. 2800 AND FEL PASO COUNTY APPROVAL: DATED FEBRUARY 14, 1891 CERTIFICATE NO. 4933 OF THE GENERAL LAND OFFICE RECORDS AS FOLLOWS: SUBJECT TO THE RIGHT OF THE PROPRIETOR OF A VEIN OR LODE TO EXTRACT AND REMOVE HIS ORE THEREFROM, SHOULD THE SAME BE FOUND TO PENETRATE OR INTERSECT THE PREMISES HEREBY GRANTED, AS PROVIDED BY LAW. COULD NOT BE SHOWN ON THE SURVEY BECAUSE IT IS BLANKET IN NATURE

10. COVENANTS, CONDITIONS AND RESTRICTIONS RECORDED JUNE 06, 1979 IN BOOK 3184 AT PAGE 228. WHICH ARE UNACCOMPANIED BY A RIGHT OF FORFEITURE OR REVERTER, DELETING THEREFROM ANY RESTRICTIONS INDICATING ANY PREFERENCE, LIMITATION OR DISCRIMINATION BASED ON RACE, COLOR, RELIGION, SEX, HANDICAP, FAMILIAL STATUS OR NATIONAL ORIGIN. COULD NOT BE SHOWN ON THE SURVEY BECAUSE IT IS BLANKET IN NATURE

11. THE EFFECT OF INCLUSION OF THE SUBJECT PREMISES WITHIN THE UPPER BLACK SQUIRREL CREEK GROUNDWATER MANAGEMENT DISTRICT AS DISCLOSED BY THE INSTRUMENT RECORDED DECEMBER 11, 1979 IN BOOK 3260 AT PAGE 701. COULD NOT BE SHOWN ON THE SURVEY BECAUSE IT IS BLANKET IN NATURE

12. THE EFFECT OF INCLUSION OF THE SUBJECT PREMISES WITHIN THE FALCON FIRE PROTECTION DISTRICT AS DISCLOSED BY THE INSTRUMENT RECORDED JULY 30, 1980 AT RECEPTION NO. COULD NOT BE SHOWN ON THE SURVEY BECAUSE IT IS BLANKET IN NATURE

13. TERMS, AGREEMENTS, PROVISIONS, CONDITIONS, OBLIGATIONS AND EASEMENTS AS CONTAINED IN GRANT OF RIGHT OF WAY GRANTED TO MOUNTAIN VIEW ELECTRIC ASSOCIATION, INCORPORATED RECORDED DECEMBER 21, 1981 IN BOOK 3514 AT PAGE 427. COULD NOT BE SHOWN ON THE SURVEY BECAUSE IT IS BLANKET IN NATURE

14. THE EFFECT OF NOTICE CONCERNING UNDERGROUND FACILITIES FOR MOUNTAIN VIEW ELECTRIC ASSOCIATION, INC. RECORDED MAY 08, 1983 IN BOOK 3718 AT PAGE 812. COULD NOT BE SHOWN ON THE SURVEY BECAUSE IT IS BLANKET IN NATURE

GENERAL NOTES: 1. FLOODPLAIN STATEMENT:

THIS SITE, GRAUPNER SUBDIVISION, IS NOT WITHIN A DESIGNATED F.E.M.A. FLOODPLAIN AS DETERMINED BY THE FLOOD INSURANCE RATE MAP FOR EL PASO COUNTY, COLORADO, COMMUNITY PANEL NUMBER 08041C 0340 G, WITH AN EFFECTIVE DATE DECEMBER 7,

2. APPROVAL OF THIS PLAT HEREBY VACATES ALL EXISTING EASEMENTS NOT SHOWN

ANY PERSON WHO KNOWINGLY REMOVES, ALTERS OR DEFACES ANY PUBLIC LAND SURVEY MONUMENT OR LAND MONUMENT OR ACCESSORY, COMMITS A CLASS TWO (2) MISDEMEANOR PURSUANT TO STATE STATUTE 18-4-508, C.R.S.

4. LOT 1 IS TO BE ACCESSED FROM TANNER TRAIL

5. LOTS 2, 3 AND 4 ARE TO BE ACCESSED VIA ACCESS EASEMENT AS SHOWN, AND MAINTAINED BY THE INDIVIDUAL PROPERTY OWNERS.

6. PER C.R.S. 38-51-106, "ALL LINEAL UNITS DEPICTED ON THIS LAND SURVEY PLAT ARE U.S. SURVEY FEET. ONE METER EQUALS 39.37/12U.S. SURVEY FEET, EXACTLY ACCORDING TO THE NATIONAL INSTITUTE OF STANDARDS AND TECHNOLOGY."

7. ALL PROPERTY OWNERS ARE RESPONSIBLE FOR MAINTAINING PROPER STORM WATER DRAINAGE IN AND THROUGH THEIR PROPERTY. PUBLIC DRAINAGE EASEMENTS AS SPECIFICALLY NOTED ON THE PLAT SHALL BE MAINTAINED BY THE INDIVIDUAL LOT OWNERS UNLESS OTHERWISE INDICATED. STRUCTURES, FENCES, MATERIALS OR LANDSCAPING THAT COULD IMPEDE THE FLOW OF RUNOFF SHALL NOT BE PLACED IN DRAINAGE EASEMENTS.

MAILBOXES SHALL BE INSTALLED IN ACCORDANCE WITH ALL EL PASO COUNTY AND

NAILED STATES POSTAL SERVICE REGULATIONS.

Add to Notes:

including, but not limited to, the Colorado

Engineers and the U.S. Fish and Wildlife

Act, particularly as it relates to the listed

species (e.g., Preble's Meadow Jumping

Transportation, U.S. Army Corps of

Division of Wildlife, Colorado Department of

Service regarding the Endangered Species

MENT THIS

THE RESPONSIBILITY OF EACH PROPERTY OWNER. PERMITS FOR Developer shall comply with federal and state; T BE OBTAINED FROM THE STATE ENGINEER WHO BY LAW HAS laws, regulations, ordinances, review and T CONDITIONS FOR THE ISSUANCE OF THESE PERMITS. permit requirements, and other agency Add to Notes requirements, if any, of applicable agencies

Add to Notes The addresses exhibited on this plat are for informational purposes only. They are not the legal description and are subject to

Mailboxes: Mailboxes shall be installed in accordance with all El Paso County and United States Postal Service regulations.

Are you dedicating public streets, if not remove

BOARD OF COUNTY COMMISSIONERS CERTIFICATE:

THIS "GRAUPNER SUBDIVISION" WAS APPROVED FOR FILING BY THE EL PASO COUNTY, COLORADO BOARD OF COUNTY COMMISSIONERS ON THE ____ DAY OF _____, 20__, SUBJECT TO ANY NOTES SPECIFIED HEREON AND ANY CONDITIONS INCLUDED IN THE RESOLUTION OF APPROVAL. THE DEDICATIONS OF LAND TO THE PUBLIC STREETS & EASEMENTS ARE ACCEPTED, BUT PUBLIC IMPROVEMENTS THEREON WILL NOT BECOME THE MAINTENANCE RESPONSIBILITY OF EL PASO COUNTY UNTIL PRELIMINARY ACCEPTANCE OF THE PUBLIC IMPROVEMENTS IN ACCORDANCE WITH THE REQUIREMENTS OF THE LAND DEVELOPMENT CODE AND ENGINEERING CRITERIA MANUAL, AND THE SUBDIVISION IMPROVEMENTS

 \sim

EPC STORMWATER REVIEW COMMENTS

IN ORANGE BOXES WITH BLACK TEXT

 \sim DATE

I, SHAWN RICHARDS, A DULY REGISTERED PROFESSIONAL LAND SURVEYOR IN THE STATE OF COLORADO, DO HEREBY CERTIFY THAT THIS PLAT TRULY AND CORRECTLY REPRESENTS THE RESULTS OF A SURVEY MADE ON DATE OF SURVEY, BY ME OR UNDER MY DIRECT SUPERVISION AND THAT ALL MONUMENTS EXIST AS SHOWN HEREON; THAT MATHEMATICAL CLOSURE ERRORS ARE LESS THAN 1:10,000; AND THAT SAID PLAT HAS BEEN PREPARED IN FULL COMPLIANCE WITH ALL APPLICABLE LAWS OF THE STATE OF COLORADO DEALING WITH MONUMENTS, SUBDIVISION, OR SURVEYING OF LAND AND ALL APPLICABLE PROVISIONS OF THE EL PASO COUNTY LAND DEVELOPMENT CODE.

HAWN RICHARDS, PROFESSIONAL LAND SURVEYOR	DATE	
OLOPADO DIS NO 37634		

NOTICE: ACCORDING TO COLORADO LAW YOU MUST COMMENCE ANY LEGAL ACTION BASED UPON ANY DEFECT IN THIS SURVEY WITHIN THREE YEARS AFTER YOU FIRST DISCOVER SUCH DEFECT. IN NO EVENT. MAY ANY ACTION BASED UPON ANY DEFECT IN THIS SURVEY BE COMMENCED MORE THAN TEN YEARS FROM THE DATE OF THE CERTIFICATION SHOWN HEREON.

 \sim

FOR AND ON BEHALF OF EAGLE LAND SURVEYING, INC.

THIS PLAT FOR "GRAUPNER SUBDIVISION" WAS APPROVED FOR FILING BY THE EL PASO COUNTY, COLORADO PLANNING AND COMMUNITY DEVELOPMENT DEPARTMENT DIRECTOR ON THE _____ DAY OF _____, 20____, SUBJECT TO ANY NOTES OR CONDITIONS SPECIFIED HEREON.

PLANNING & COMMUNITY DEVELOPMENT DIRECTOR

CLERK AND RECORDER:

Remove planning STATE OF COLORADO director is not approving the plat **Update Clerk and Recorder:** COUNTY OF EL STATE OF COLORADO COUNTY OF EL PASO I hereby certify that this instrument was filed in my office on I HEREBY CERT this ____ day of _____, 20__, and was recorded at __ of the records of ___.M. THIS Reception Number DAY El Paso County ORDED AT RECEPTION NO.

STEVE SCHLEIK	ER, RECORDER	Add to Notes
		Mostowotor

Add to Notes Note Regarding Reports on File: The following reports have been submitted in association with the Preliminary Plan or SURCHARGE: ____ Final Plat for this subdivision and are on file at the County Planning and Community SCHOOL FEE: ——— Development Department: Transportation Impact Study; Drainage Report; Water ---- Resources Report; Wastewater Disposal Report; Geology and Soils Report; Fire ---- Protection Report; Wildfire Hazard Report; DRAINAGE FEE: ____ based upon specific reports) Natural Features Report; (other; modify

El Paso County Clerk and Recorder

OWNE INFORMATION

GARRETT GRAUPNER ADDRESS: 14710 TANNER TRAIL FLBFRT_CO_ 80106

access permit has been granted by El ADDRES Paso County.

OF THE SIXTH

ERIDIAN

Individual lot purchasers are responsible for constructing driveways, including necessary drainage culverts from _____ Road per Land Development Code Section 6.3.3.C.2 and 6.3.3.C.3. Due to their length, some of the driveways will need to be specifically approved by the (name of Fire District). When a Section Line Road encumbers the property, which would be eliminated as part of the subdivision plat.

The 60 foot wide public highway contained within this plat as ordered by the Board of County Commissioners for El Paso County on (date) and recorded in Road Book (X) and Page (X) of the records of El Paso County, is hereby vacated upon recordation of this plat.

providers)

PHONE: OWNER: No driveway shall be established unless an

(TOU) ZZ3-3/00 Add to Notes

COLORADO SPRINGS, CO 80931-5365 PHONE: (719) 382-4150 FAX: (719) 382-3290

Sewage treatment is the responsibility of each

individual property owner. The El Paso County

Department of Health and Environment must

approve each system and, in some cases the

Department may require an engineer designed

system prior to permit approval. These systems

may cost more to design, install, and maintain.

Soils and Geology conditions on site require that

all (or certain lots)On-Site Wastewater Systems

shall be located and designed by a Professional

Engineer, currently registered in the State of

Colorado. (Note: this note used in special

(District or provider name(s)) subject to the

District's (Providers) rules, regulations and

specifications. (Combined note, which can be

The subdivider/developer is responsible for

extending utilities to each lot, tract or building

Gas and electric service for this subdivision is

name(s)) subject to the District's (Providers)

for gas or electric in the case of different

P.O. BOX 5365

rules, regulations and specifications. (Combined

note, which can be broken into separate notes

__ (Provider

broken into separate notes for water or sewer in

cases only when requested by the Health

Department or pursuant to a condition of

Water and wastewater service for this

subdivision is provided by the _

the case of different providers)

Add to Notes

Gas and Electric:

