

100'-0" x 30'-0"

MESA TOP DRIVE SOUTH BRIDGE ELITE PROPERTIES of AMERICA, INC

DRAWING INDEX

SHEET NO.	DESCRIPTION
1	TITLE PAGE
2	GENERAL NOTES & ANCHOR DETAILS
3	PLAN VIEW
4	CROSS SECTION
5	ANCHOR DETAILS
6	DETAILS
7	DETAILS
8	SPLICE DETAILS
9	DETAILS
10	DETAILS



Engineering
Record Drawings

The design and information shown on this drawing is the property of Contech Engineered Solutions, LLC and is to be used only for the project and location specified herein. No part of this drawing may be reproduced or transmitted in any form or by any means, electronic or mechanical, including photocopying, recording, or by any information storage and retrieval system, without the prior written permission of Contech Engineered Solutions, LLC. Contech Engineered Solutions, LLC expressly disclaims any liability or responsibility for any damages, including consequential, special, or punitive damages, arising out of the use of this drawing. If discrepancies between the supplied information upon which the drawing is based and actual field conditions are noted, the user must immediately notify Contech Engineered Solutions, LLC. Contech Engineered Solutions, LLC immediately for re-evaluation of the design. Contech Engineered Solutions, LLC accepts no liability for designs based on missing, incomplete or inaccurate information supplied by others.

MARK	DATE	BY	REVISION DESCRIPTION
AB-1	10/29/2021	TLF	AS-BUILT FINALS
AB	9/28/2021	TLF	AS-BUILT FINALS
E0	7/22/2021	TLF	APPROVED FOR CONSTRUCTION

100'-0" x 30'-0"
MESA TOP DRIVE SOUTH BRIDGE
ELITE PROPERTIES of AMERICA, INC
FOUNTAIN, CO

CONTECH
ENGINEERED SOLUTIONS LLC
www.conteches.com
15500 G Street, Denver, CO 80231
800-328-3047 303-345-9120 303-565-3148 FAX

BIG R
BRIDGE

DATE: 7/24/2020	
DESIGNED: NBE	DRAWN: RDH
CHECKED: NBE	APPROVED: NBE
PROJECT No.: 621715	SEQUENCE No.: 030
SHEET: 1 OF 12	

GENERAL NOTES:


- CONTECH ENGINEERED SOLUTIONS HAS AISC QUALITY CERTIFIED BRIDGE FABRICATION - ADVANCED (MAJOR) WITH A FRACTURE CRITICAL AND SOPHISTICATED PAINT ENDORSEMENT AND CWB CERTIFIED TO CSA STANDARD W47.1 DIVISION 2.
- DESIGN IS IN ACCORDANCE WITH THE AASHTO LRFD BRIDGE DESIGN SPECIFICATIONS, 8th EDITION 2017.
- MATERIALS (UNLESS NOTED OTHERWISE):
 - STRUCTURAL STEEL: ASTM A588 WEATHERING STEEL
 - ELASTOMERIC PADS: GRADE 4, 60 DUROMETER
 - SHEET PILING: ASTM A929 (GALV)
STRUCTURAL BOLTS: ASTM F3125 GRADE A325 (TYPE 1)
GUARDRAIL BOLTS: ASTM A307 (GALV)
- DESIGN LOADINGS:
 - BRIDGE DEAD LOAD PLUS 37.5 FUTURE WEARING SURFACE.
 - VEHICLE LIVE LOAD: HL-93, MAX ADTT = 160
 - WIND LOADING PER AASHTO LRFD BRIDGE DESIGN SPECIFICATIONS SECTION 3.8:
WIND SPEED = 115 MPH
WIND EXPOSURE CATEGORY = C
MAX HEIGHT OF STRUCTURE = 33 FT.
 - BRIDGE RAIL DESIGNED FOR TL-1 LOADING IN ACCORDANCE WITH AASHTO LRFD BRIDGE DESIGN SPECIFICATIONS APPENDIX A13.2 (RAIL HAS NOT BEEN CRASH TESTED)
 - SEISMIC LOADING PER AASHTO LRFD BRIDGE DESIGN SPECIFICATIONS SECTION 3.10:
SITE CLASS: D
PGA = 0.058
S_s = 0.125
S₁ = 0.035
PERIOD OF BRIDGE = T_m = 0.076 SEC
- BRIDGE TO BE BUILT TO THE REQUIREMENTS OF AWS D1.5.
- ALL SHOP WELDING SHALL USE THE GAS METAL ARC WELDING OR FLUX CORED ARC WELDING PROCESS.
- FINISH:
ALL EXPOSED SURFACES OF STEEL TO BE CLEANED IN ACCORDANCE WITH STEEL STRUCTURES PAINTING COUNCIL SURFACE PREPARATION SPECIFICATIONS NO. 1, SSPC-SP1 SOLVENT CLEANING. EXPOSED SURFACES OF STEEL SHALL BE DEFINED AS THOSE SURFACES SEEN FROM THE DECK OR FROM THE OUTSIDE (AND BOTTOM) OF THE STRUCTURE. ALL OTHER SURFACES TO HAVE STANDARD MILL FINISH.
- ALL BOLTED CONNECTIONS ARE CONSIDERED TO BE PRETENSIONED OR SLIP-CRITICAL CONNECTIONS. ALL BOLTS ARE TO BE PRETENSIONED PER THE REQUIREMENTS OF SECTION 8.2 OF THE SPECIFICATION FOR STRUCTURAL JOINTS USING HIGH-STRENGTH BOLTS BY RCSC.
- ALL BOLTS, NUTS AND WASHERS SHALL BE FURNISHED IN THE AMOUNT OF 5% IN EXCESS OF THE NUMBER REQUIRED FOR EACH SIZE AND LENGTH.
- IF BOLTS DO NOT SMOOTHLY ENGAGE UP TO SNUG-TIGHT, THERE MAY BE AN OBSTRUCTION WITHIN THE THREADS. THE BOLTS SHOULD BE REMOVED, THE THREADS ON THE BOLT AND NUT CLEANED AND RETAPPED IF NECESSARY TO ALLOW SMOOTH INSTALLATION OF THE BOLT. (IF APPLICABLE)
- MAINTENANCE NOTE: CONTECH RECOMMENDS NOT APPLYING DE-ICING OR DUST PROHIBITIVE CHEMICALS OR SALTS TO ANY PART OF THE BRIDGE STRUCTURE. IF DE-ICING OR DUST PROHIBITIVE CHEMICALS OR SALTS ARE APPLIED TO ANY PART OF THE BRIDGE STRUCTURE, CONTECH WILL NOT BE RESPONSIBLE FOR ANY RESULTANT ACCELERATED CORROSION.

CONCRETE NOTES

- BIG R BRIDGE IS RESPONSIBLE FOR THE STRUCTURAL DESIGN OF THE CONCRETE DECK. ALL ISSUES RELATED TO MATERIAL SUPPLY, TESTING AND INSTALLATION ARE OUTSIDE OF BIG R BRIDGE'S RESPONSIBILITY.
- CONCRETE MIX DESIGN, MATERIALS, MIXING, PLACEMENT, FINISHING AND TESTING SHALL BE IN ACCORDANCE WITH THE REQUIREMENTS OF SECTION 601 OF CDOT STANDARD SPECIFICATIONS FOR ROAD AND BRIDGE CONSTRUCTION, 2017 EDITION.
- MINIMUM MATERIAL REQUIREMENTS:
 - CONCRETE: CLASS D OR H; f_c = 4500 psi AT 28 DAY
AIR CONTENT OF 5.5% +/- 1%
UNIT WEIGHT OF 145 PCF MAX
 - REINFORCING: ASTM A615 GRADE 60 OR ASTM A775 FOR EPOXY COATING
- THE USE OF EPOXY COATED REBAR, GALVANIZED REBAR, DECK SEALERS OR ANY OTHER FORM OF PROTECTION OF THE REBAR SHALL BE DONE AS NEEDED FOR LOCAL CONDITIONS OR AS REQUIRED PER THE PROJECT CONTRACT DOCUMENTS AND IS NOT THE RESPONSIBILITY OF BIG R BRIDGE.
- THE CONTRACTOR MUST EXERCISE CARE TO CONTROL TRAFFIC AND STORAGE OF MATERIALS ON THE FORM DECK BEFORE CONCRETE IS PLACED.
- LONGITUDINAL BARS MAY BE SPLICED IF REQUIRED. SPLICES SHALL BE STAGGERED EVERY OTHER LONGITUDINAL BAR. SPLICES SHALL BE LOCATED AT OR NEAR THE ONE-THIRD POINT OF THE BAY SPANS FROM FLOOR BEAM TO FLOOR BEAM. REQUIRED SPLICE LENGTHS ARE AS FOLLOWS:

BAR SIZE	NORMAL WEIGHT CONCRETE (145 PCF)	LIGHT WEIGHT CONCRETE (120 PCF)
#4	29"	35"
#5	36"	43"
#6	43"	52"
#7	50"	60"
#8	57"	69"
#9	70"	85"

- STAY IN PLACE GALVANIZED FORM DECK SHALL BE USED ON THE BRIDGE. FORM DECK SHALL BE SHOP ATTACHED TO FLOOR BEAMS VIA SELF-DRILLING FASTENERS, WELDING OR POWER ACTUATED FASTENERS. LONGITUDINAL SHEET LAPS SHALL BE ATTACHED WITH SELF-DRILLING FASTENERS AT 36" MAXIMUM SPACING. THE ATTACHMENT OF THE FORM DECK TO THE FLOOR BEAMS IS ONLY NECESSARY TO KEEP THE FORM DECK IN PLACE DURING TRANSPORTATION AND DURING THE CONCRETE PLACEMENT. THE FORM DECK IS NOT REQUIRED FOR DIAPHRAGM ACTION OR COMPOSITE ACTION AND PROVIDES NO STRUCTURAL BENEFIT TO THE TRUSS OR THE DECK AFTER THE CONCRETE IS SET.
- CONCRETE TO BE FINISHED WITH A TRANSVERSE BROOM FINISH.
- THE USE OF GROOVED CONTRACTION JOINTS SHALL BE PUT IN PER THE PROJECT CONTRACT DOCUMENTS OR AT THE DISCRETION OF THE ENGINEER AND OWNER. IF CONTRACTION JOINTS ARE USED, THEY SHALL BE PLACED OVER THE CENTERLINE OF THE FLOOR BEAMS AS NEEDED.

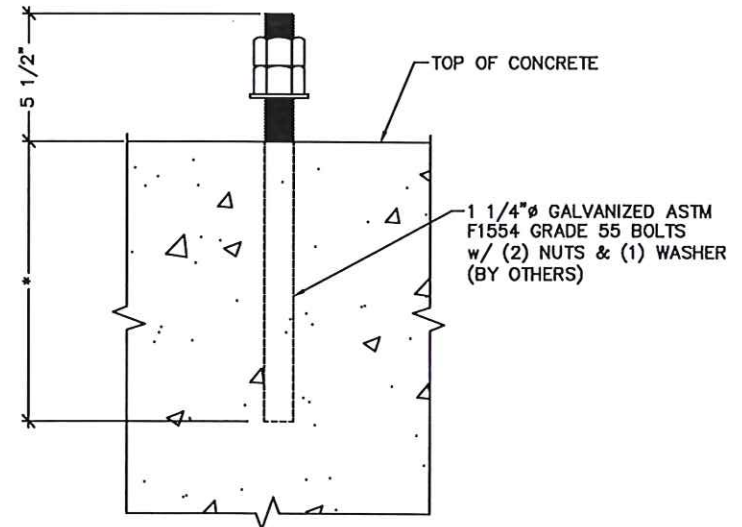

ANCHOR BOLT DETAIL

***NOTE:**
ANCHOR BOLTS ARE DESIGNED BY CONTECH FOR STEEL STRENGTH IN SHEAR AND TENSION OF THE ANCHOR BOLT ONLY. ALL DESIGN CONSIDERATIONS REGARDING CONCRETE BREAKOUT STRENGTH IN SHEAR AND TENSION, PULLOUT STRENGTH, CONCRETE SIDE-FACE BLOWOUT STRENGTH, CONCRETE PRYOUT STRENGTH, EMBEDMENT DEPTH, TYPE OF ANCHORAGE OR ANY OTHER CONCRETE FAILURE MODES ARE NOT CONSIDERED AND ARE NOT THE RESPONSIBILITY OF CONTECH. IF LARGER DIAMETER BOLTS ARE REQUIRED TO MEET ANY OF THESE REQUIREMENTS, THAT INFORMATION MUST BE PROVIDED TO CONTECH PRIOR TO BEGINNING ANY FABRICATION ON THE BRIDGE.

ITEM	QTY	UNIT WEIGHT (LBS)	TOTAL WEIGHT (LBS)
BRIDGE SECTION 1A	1	32,311	32,311
BRIDGE SECTION 2A	1	47,349	47,349
BRIDGE SECTION 1B	1	21,710	21,710
BRIDGE SECTION 2B	1	31,920	31,920
LOOSE ITEMS	-	-	18,000
TOTAL BRIDGE WEIGHT:			151,290

ITEM	QTY	UNIT WEIGHT (LBS)	TOTAL WEIGHT (LBS)
BRIDGE SECTION 1A	1	21,710	21,710
BRIDGE SECTION 2A	1	31,920	31,920
BRIDGE SECTION 1B	1	32,311	32,311
BRIDGE SECTION 2B	1	47,349	47,349
LOOSE ITEMS	-	-	18,000
TOTAL BRIDGE WEIGHT:			151,290

BEARING REACTION IN KIPS	MAX AT INTERIOR STRINGER			MAX AT EXTERIOR STRINGER			TOTAL AT ABUTMENT		
	P	H	L	P	H	L	P	H	L
DEAD LOAD (DC)	53.78			39.77			240.89		
WEARING SURFACE LOAD (DW)	13.44			34.42			109.14		
VEHICLE LOAD (LL)	90.43			68.83			193.83		
VEHICLE LOAD + DYNAMIC LOAD ALLOWANCE (LL+IM)	104.99			79.91			236.87		
WIND LOAD (WS)	-30.00*	3.00			3.00		-30.00*	15.00	
THERMAL LOAD (TU)			13.32			13.32			66.59
BREAKING FORCE (BR)			7.20			7.20			36.00
SEISMIC LOAD (EQ)		13.36	26.72		13.36	26.72		66.79	133.59

"P": VERTICAL LOAD
 "H": HORIZONTAL LOAD TRANSVERSE TO THE STRUCTURE
 "L": HORIZONTAL LOAD LONGITUDINAL TO THE STRUCTURE
 * WIND LOAD UPLIFT ASSUMES FULL 20 PSF TO DECK AREA IS APPLIED TO ONE STRINGER LINE

The design and information shown on this drawing is provided as a service to the project owner, engineer or contractor. Neither this drawing, nor any part thereof, may be used, reproduced or modified in any manner without the prior written consent of Contech. Failure to comply with the terms of this disclaimer shall constitute an acknowledgment of the user's responsibility for any and all consequences arising from the use of this drawing.

DATE	BY	REVISION DESCRIPTION
7/22/2021	EO	APPROVED FOR CONSTRUCTION
9/28/2021	AB	AS-BUILT FINALS
10/29/2021	AB-1	AS-BUILT FINALS

100'-0" x 30'-0"
 MESA TOP DRIVE SOUTH BRIDGE
 ELITE PROPERTIES OF AMERICA, INC
 FOUNTAIN, CO

CONTECH
 ENGINEERED SOLUTIONS LLC
 www.conteches.com
 1800 Grand County, CO 80631
 970-328-3047 320-566-3148 FAX

BIG R
 BRIDGE







9-20-22

Engineering Record Drawings



DESIGNED: NBE	DRAWN: RDH
CHECKED: NBE	APPROVED: NBE
PROJECT No.: 621715	SEQUENCE No.: 030
SHEET: 2	OF 12

C:\AUTODESK\VAULT\WORKING\2020\BEA\M621715\CAD\FABRICATION\REV AB-1621715-030 REV-0.DWG 10/29/2021 12:24 PM

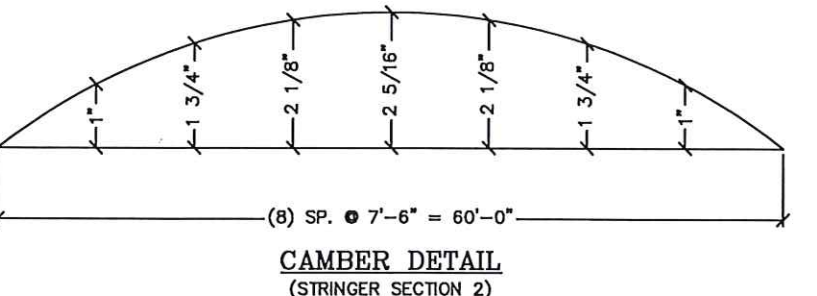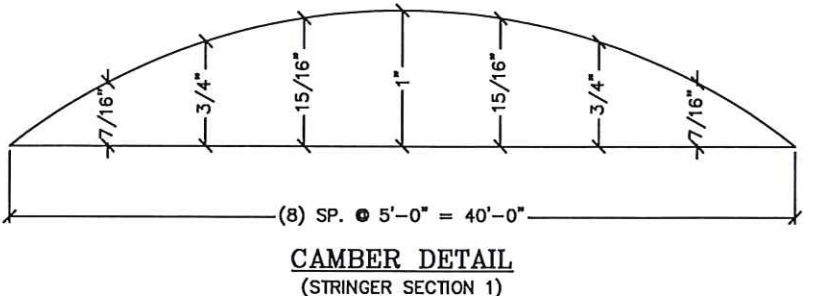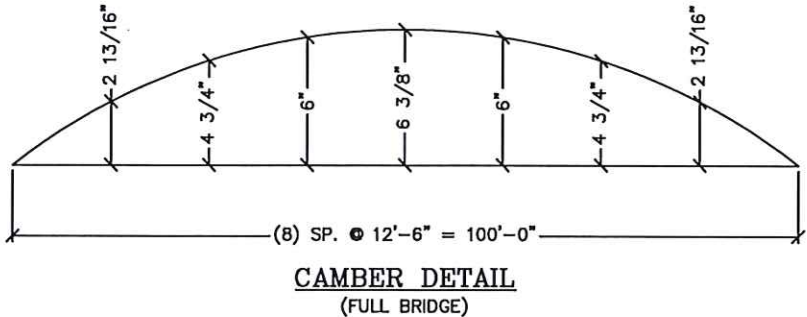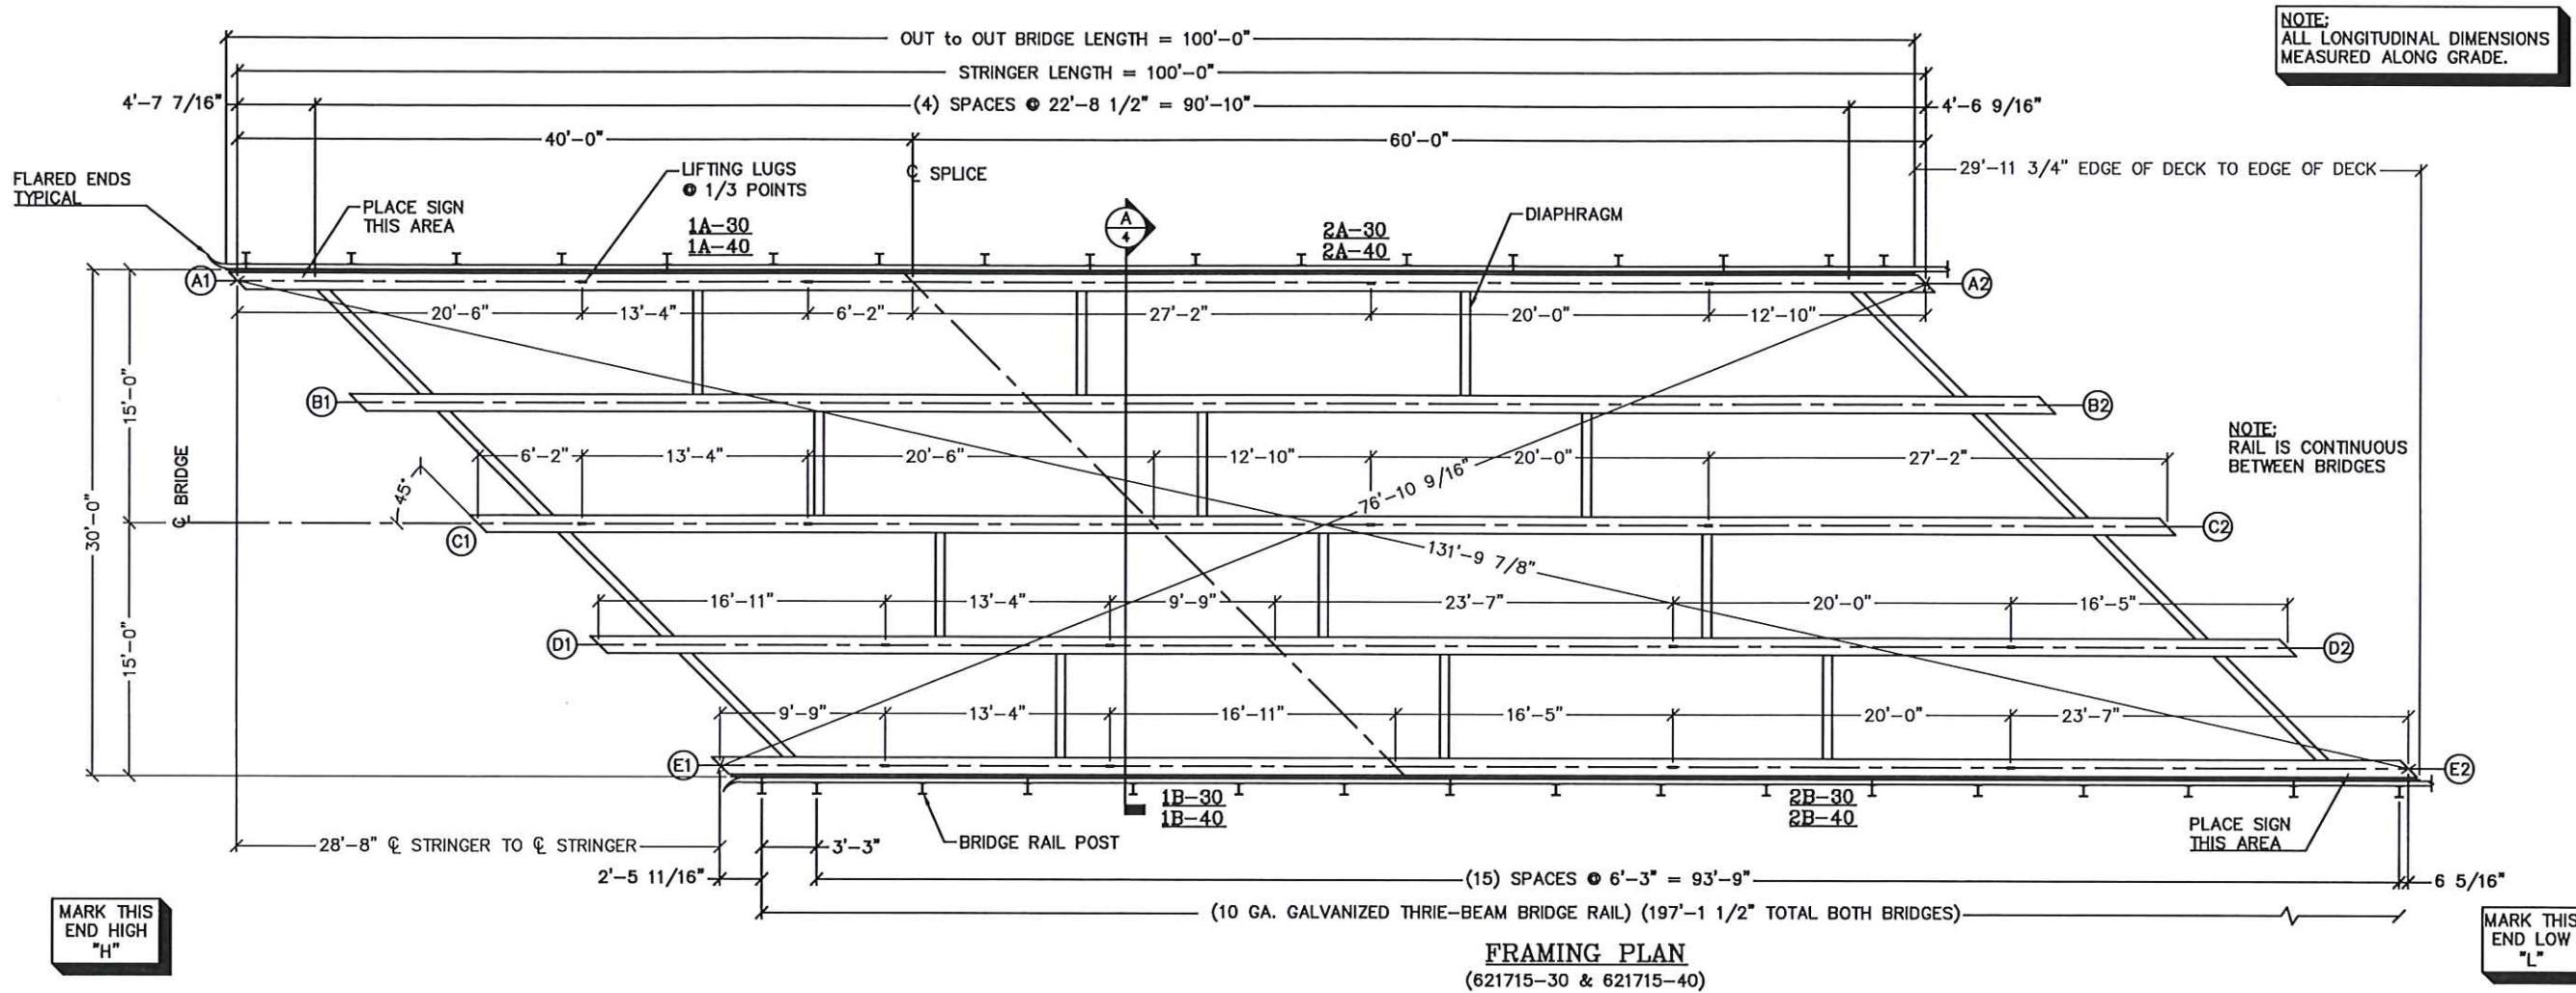

MEMBERS	DESCRIPTION
GIRDER	W 36x232
DIAPHRAGM	W 21x44
POST BLOCK	W 14x22
SIDE DAM	PL 1/4"

BUILD 2 AS SHOWN
621715-30
621715-40

Engineering
Record Drawings



The design and information shown on this drawing is provided as a service to the project owner, engineer or contractor. Neither this drawing, nor any part thereof, may be used, reproduced or modified in any manner without the express written consent of Contech. Contech expressly disclaims any liability or responsibility for such use.

If discrepancies between the supplied information upon which the drawing is based and actual field conditions are encountered as site work progresses, the contractor shall immediately notify Contech. Contech accepts no liability for designs based on missing, incomplete or inaccurate information supplied by others.

MARK	DATE	REVISION DESCRIPTION	BY
AB-1	10/29/2021	AS-BUILT FINALS	TLF
AB	9/28/2021	AS-BUILT FINALS	TLF
E0	7/22/2021	APPROVED FOR CONSTRUCTION	TLF





100'-0" x 30'-0"
MESA TOP DRIVE SOUTH BRIDGE
ELITE PROPERTIES of AMERICA, INC
FOUNTAIN, CO

CONTECH
ENGINEERED SOLUTIONS LLC
www.conteches.com
900-326-3047
1700 S. GARDEN ST. SUITE 100
DENVER, CO 80202

BIG R
BRIDGE

DATE: 7/24/2020
DESIGNED: NBE
DRAWN: RDH
CHECKED: NBE
APPROVED: NBE
PROJECT No.: 621715
SEQUENCE No.: 030
SHEET: 3 OF 12

C:\AUTODESK\VAULT\WORKING\2020\BEAM\621715\CAD\FABRICATION\REV AB-1621715-030 REV-L0.DWG 10/29/2021 12:24 PM

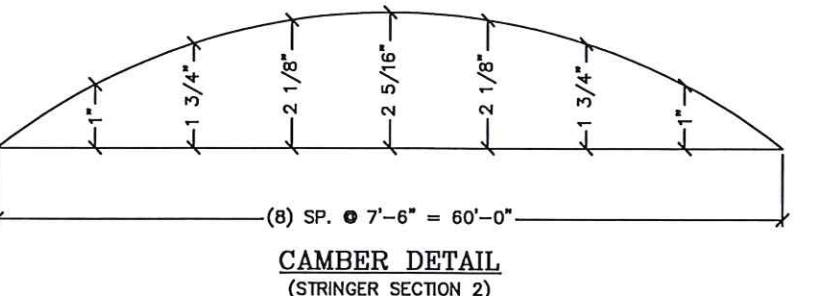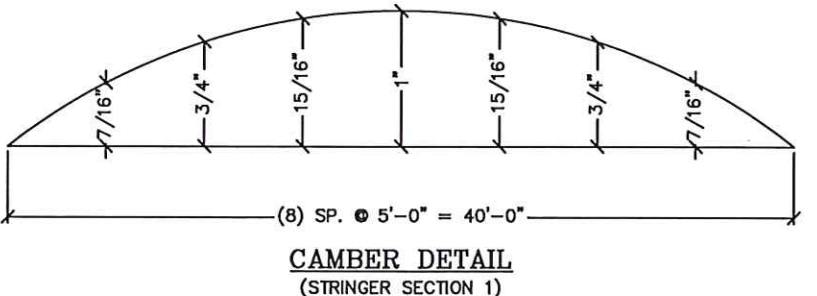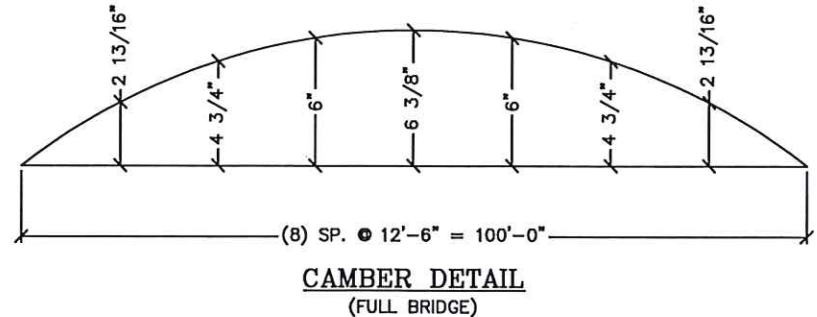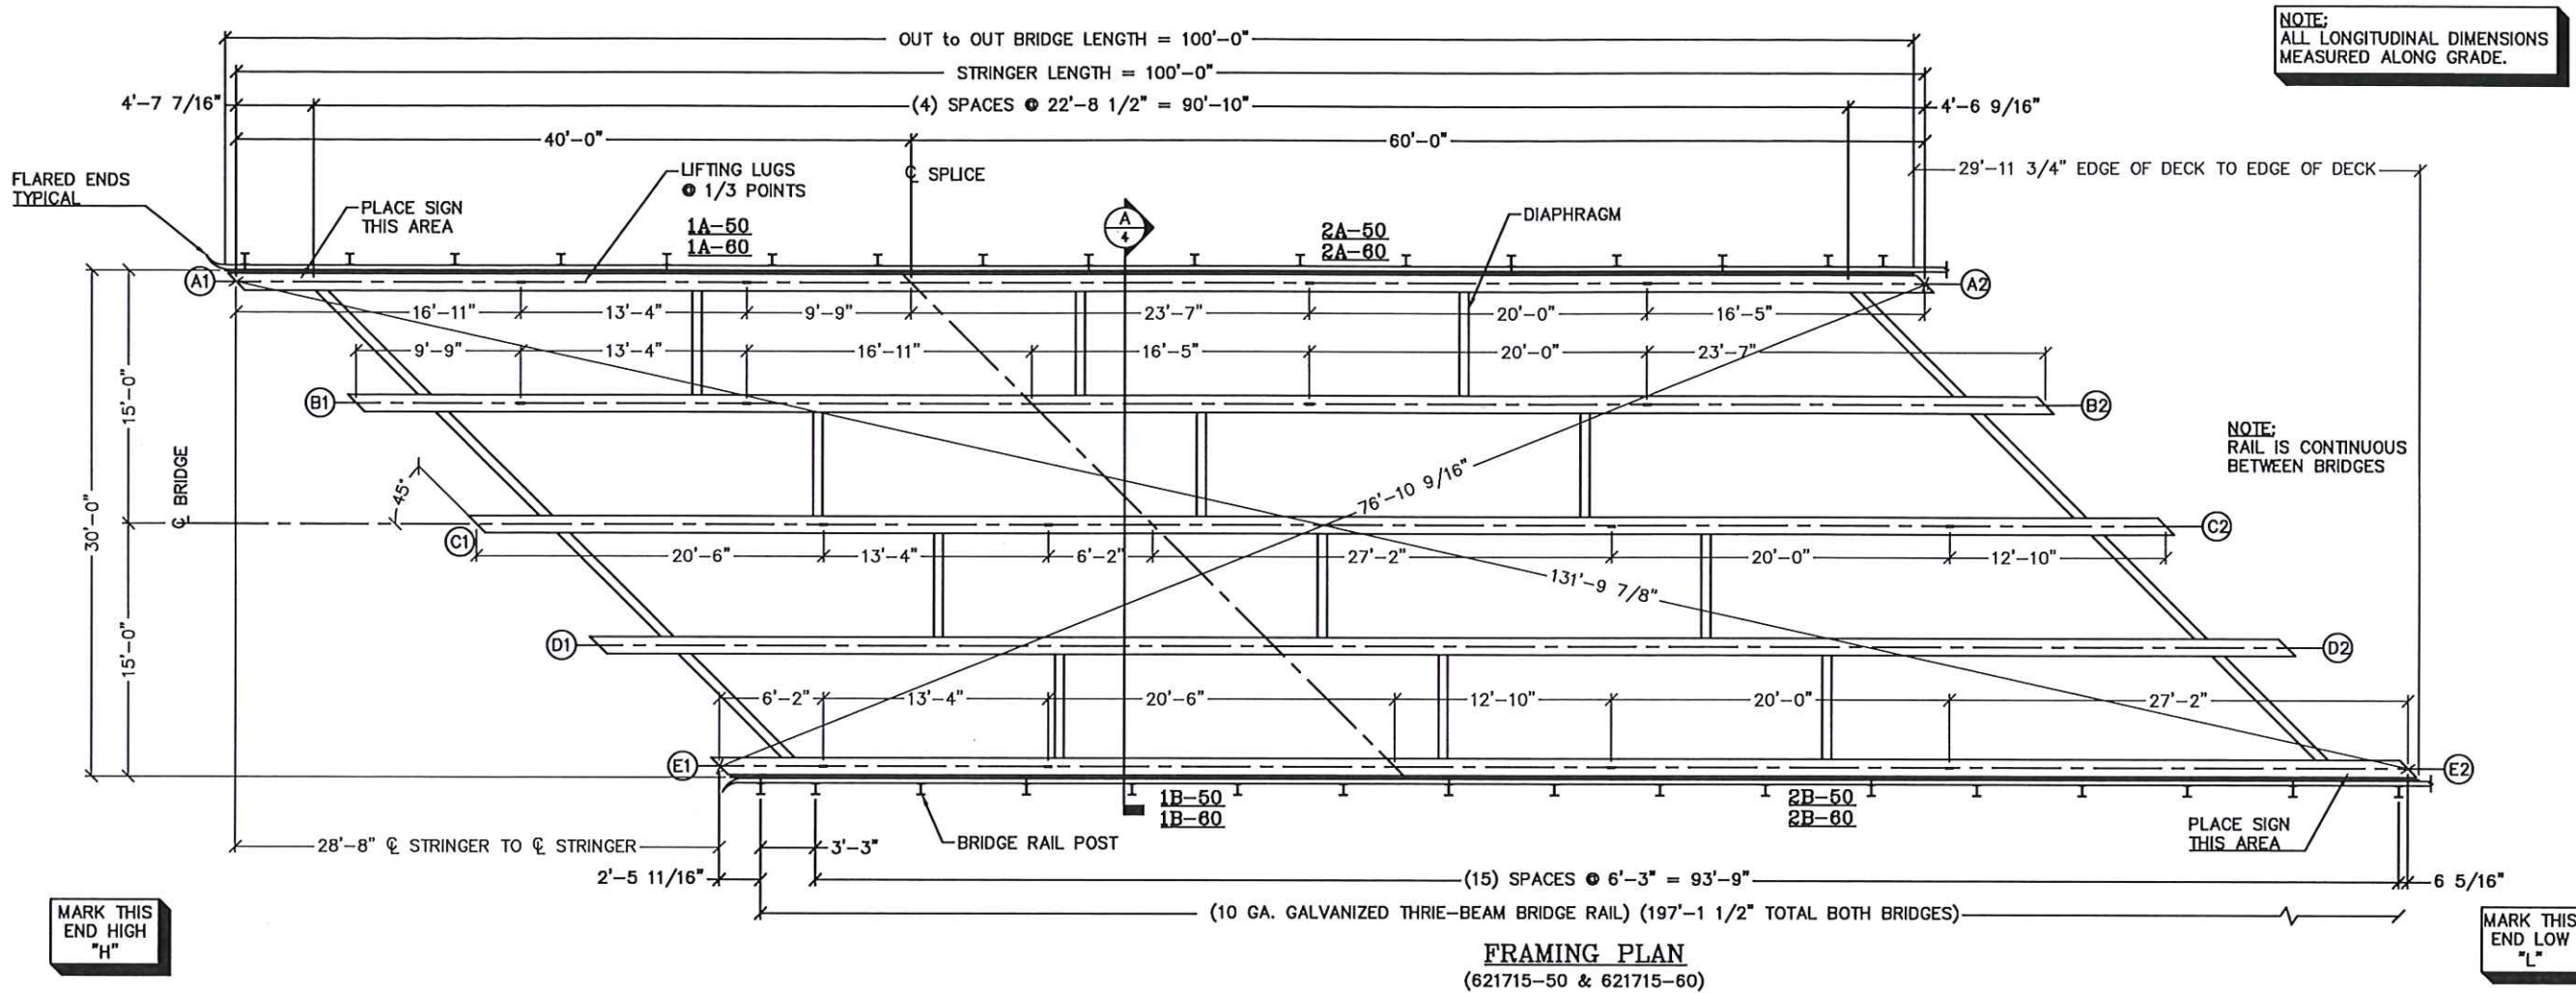

MEMBERS	DESCRIPTION
GIRDER	W 36x232
DIAPHRAGM	W 21x44
POST BLOCK	W 14x22
SIDE DAM	PL 1/4"

BUILD 2 AS SHOWN
621715-50
621715-60

Engineering
Record Drawings



NOTE: ALL LONGITUDINAL DIMENSIONS MEASURED ALONG GRADE.

NOTE: RAIL IS CONTINUOUS BETWEEN BRIDGES

The design and information shown on this drawing is the property of Contech Engineered Solutions, LLC and is to be used for the project and location only. It may be used, reproduced or modified in any manner without the written consent of Contech Engineered Solutions, LLC. Contech Engineered Solutions, LLC expressly disclaims any liability or responsibility for such use. If discrepancies between the supplied information upon which the drawing is based and actual field conditions are encountered as site work progresses, the contractor is to immediately notify Contech immediately for re-evaluation of the design. Contech accepts no liability for designs based on missing, incomplete or inaccurate information supplied by others.

MARK	DATE	REVISION DESCRIPTION	BY
AB-1	10/29/2021	AS-BUILT FINALS	TLF
AB	9/28/2021	AS-BUILT FINALS	TLF
E0	7/22/2021	APPROVED FOR CONSTRUCTION	TLF

100'-0" x 30'-0"
MESA TOP DRIVE SOUTH BRIDGE
ELITE PROPERTIES of AMERICA, INC
FOUNTAIN, CO



CONTECH
ENGINEERED SOLUTIONS LLC
www.conteches.com
1700 S. WASHINGTON ST. SUITE 100
FOUNTAIN, CO 80026
900-328-3047 303-345-9720 303-366-3148 FAX

BIG R
BRIDGE

DATE: 7/24/2020

DESIGNED: NBE	DRAWN: RDH
CHECKED: NBE	APPROVED: NBE
PROJECT No.: 621715	SEQUENCE No.: 030
SHEET: 4	OF 12

C:\AUTODESK\VAULT\WORKING\2020\BEAM\621715\CAD\FABRICATION\REV AB-1621715-035 REV 10/29/2021 12:24 PM

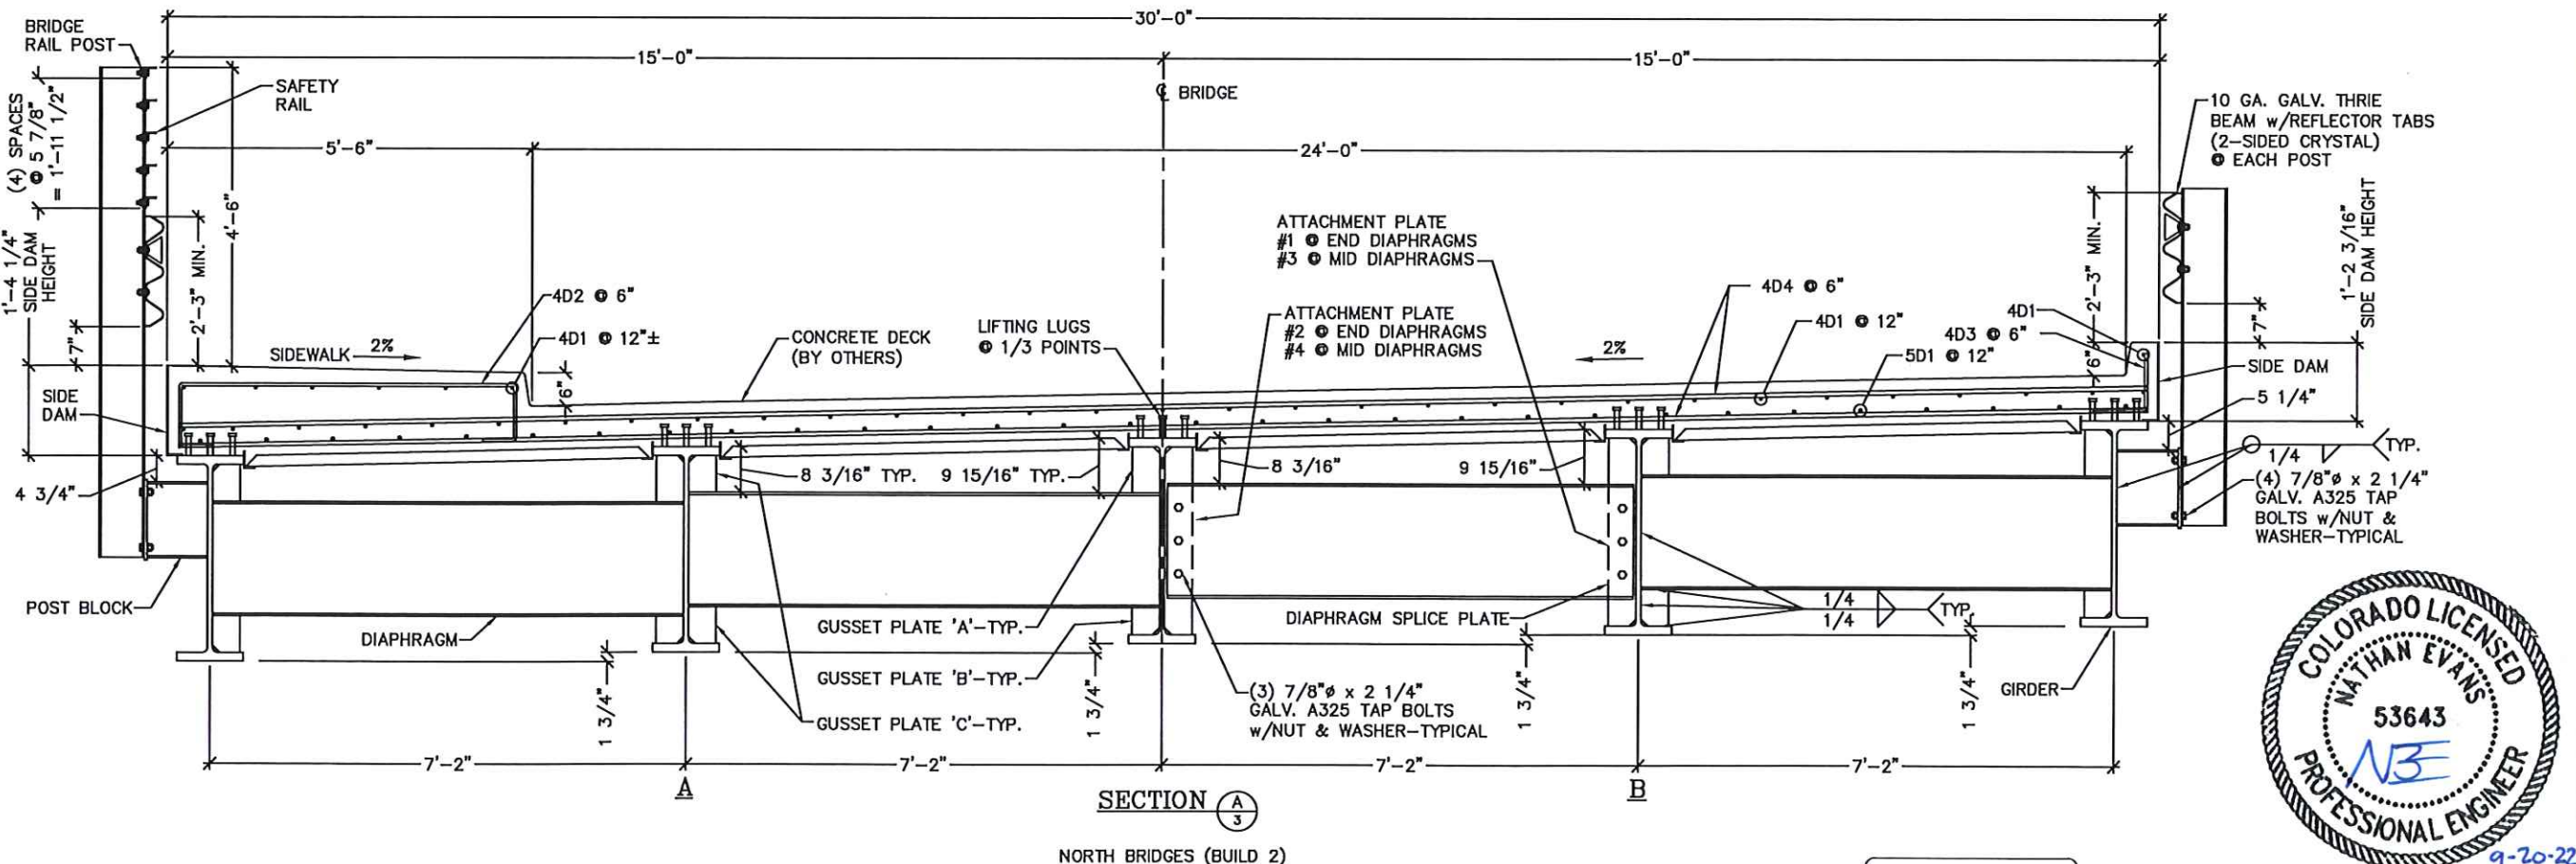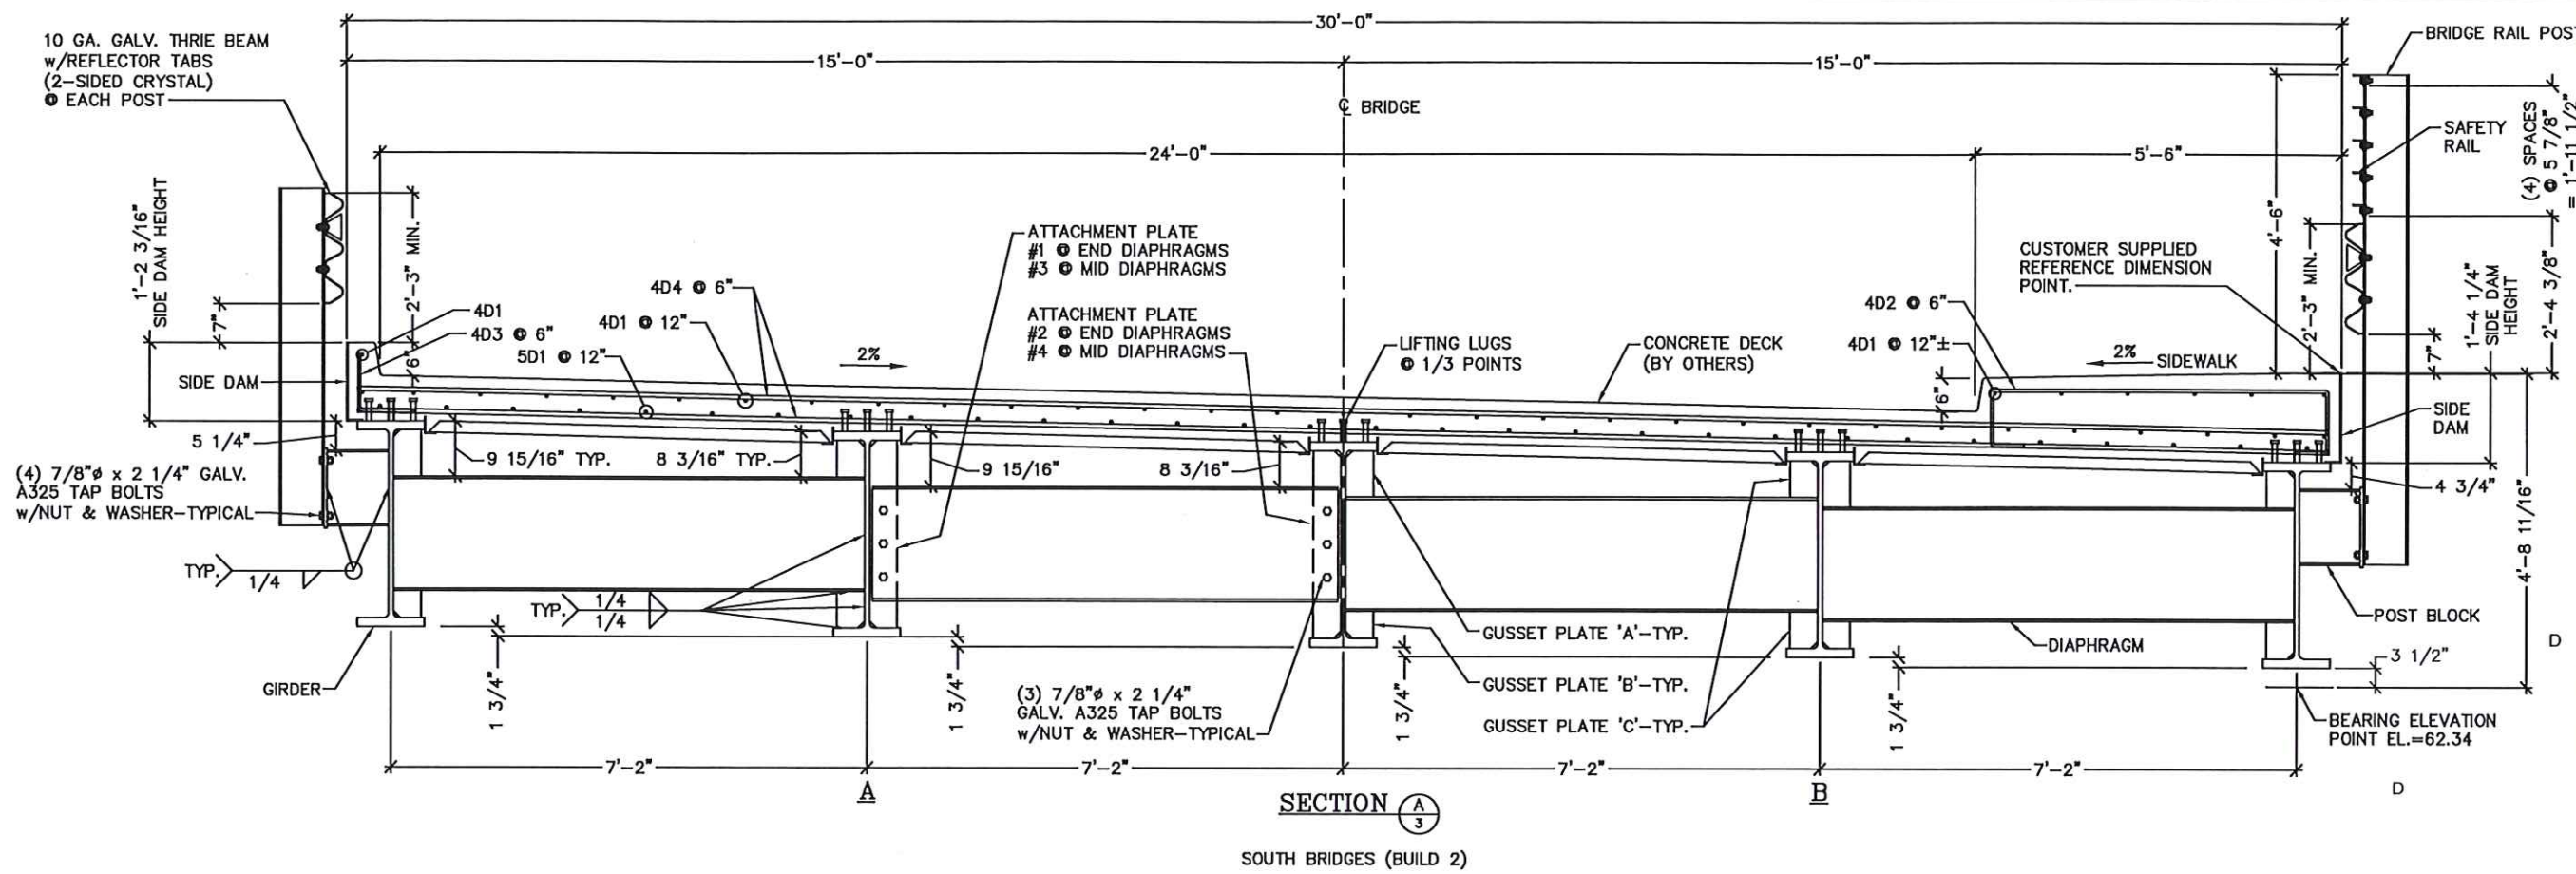

Engineering Record Drawings

<p>The design and information shown on this drawing is the property of Contech Engineered Solutions, LLC and is to be used only for the project and location specified. It is not to be used, reproduced or modified in any manner without the written consent of Contech Engineered Solutions, LLC. Contech Engineered Solutions, LLC expressly disclaims any liability or responsibility for such use.</p> <p>If discrepancies between the supplied information upon which the drawing is based and actual field conditions are noted, the contractor shall immediately report such discrepancies to Contech Engineered Solutions, LLC for re-evaluation of the design. Contech Engineered Solutions, LLC shall not be held responsible for any discrepancies or inaccuracies in the design or information supplied by the contractor.</p>		
MARK	DATE	REVISION DESCRIPTION
AB-1	10/29/2021	AS-BUILT FINALS
AB	9/28/2021	AS-BUILT FINALS
EO	7/22/2021	APPROVED FOR CONSTRUCTION
TLF		BY
TLF		DATE
TLF		REVISION DESCRIPTION

100'-0" x 30'-0"
MESA TOP DRIVE SOUTH BRIDGE
ELITE PROPERTIES of AMERICA, INC
FOUNTAIN, CO


CONTECH
ENGINEERED SOLUTIONS LLC
www.conteches.com
10500 E. Colfax, CO 80031
303-566-9128
303-566-9148 FAX

BIG BIRD
BRIDGE

DATE: 7/24/2020

DESIGNED: NBE	DRAWN: RDH
CHECKED: NBE	APPROVED: NBE
PROJECT No.: 621715	SEQUENCE No.: 030
SHEET: 5	OF 12

C:\AUTODESK\VAULT\WORKING\2020\BEAMER21715\CAD\FABRICATION\REV AB-1\621715-030 REV.LO.DWG 10/29/2021 12:24 PM

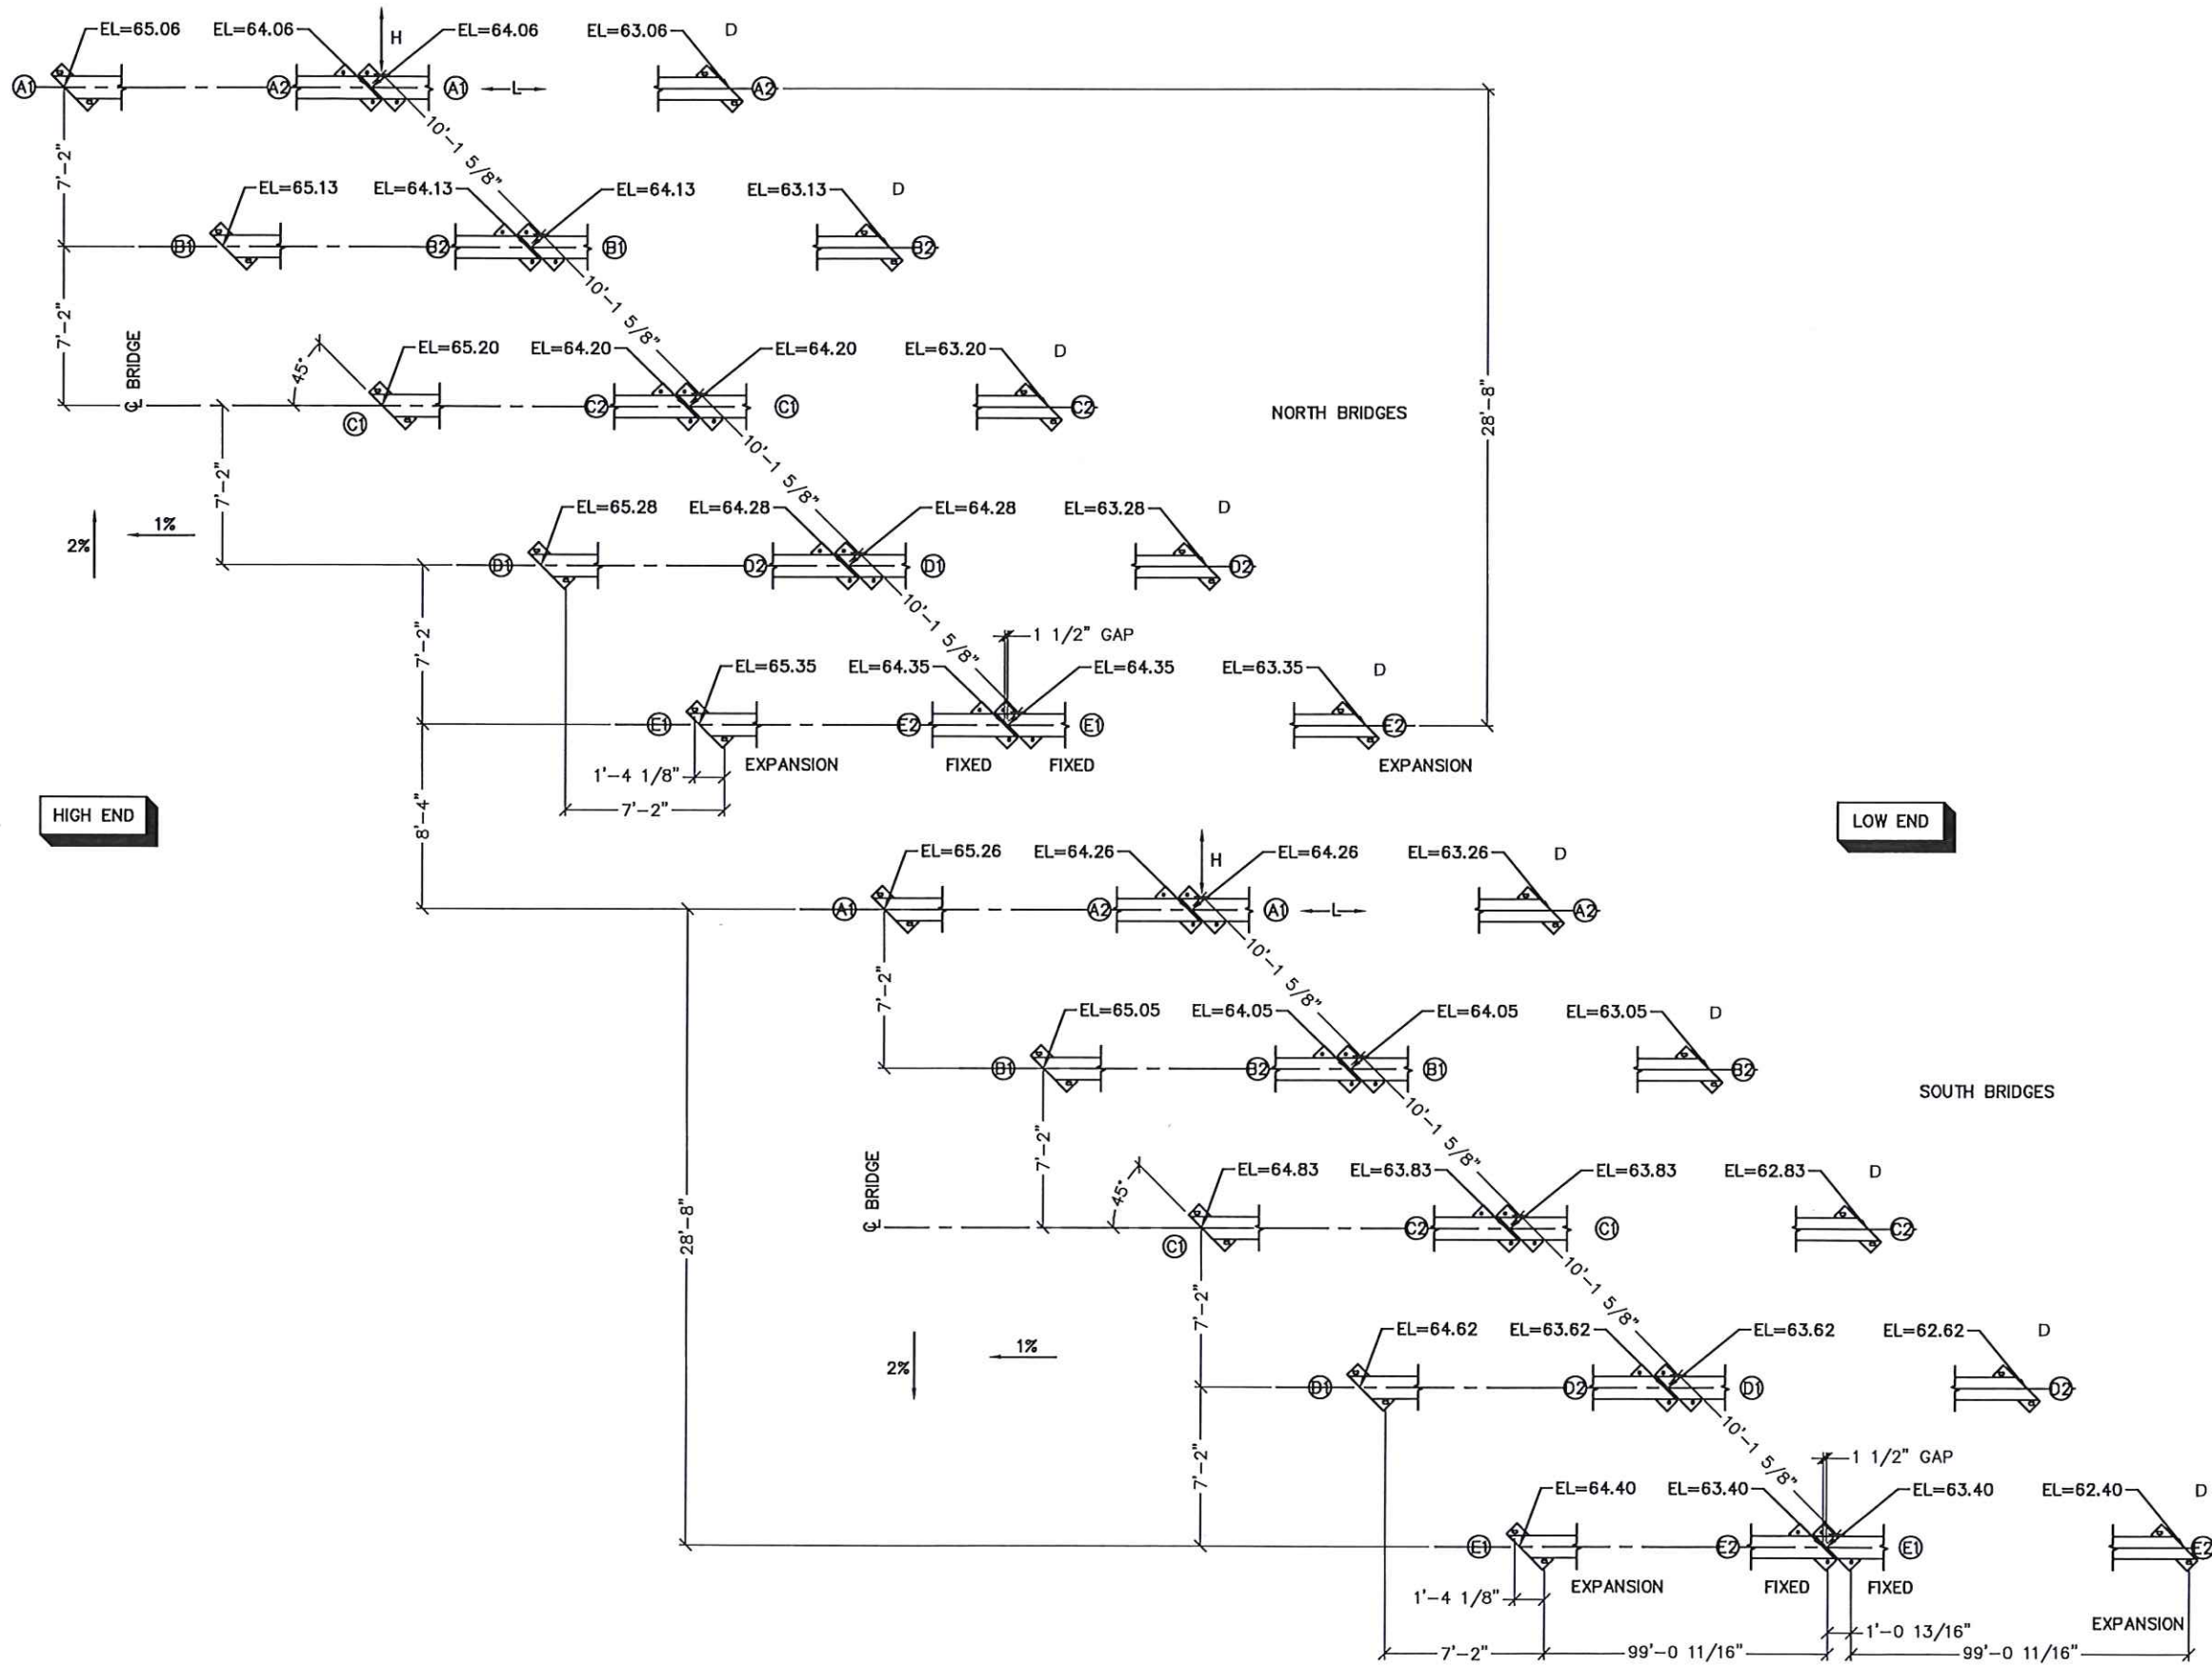

ANCHOR BOLT LAYOUT
(ELEVATIONS ARE AT BEARING SEATS)

Engineering
Record Drawings



The design and information shown on this drawing is the property of Contech Engineered Solutions LLC and contractor by Contech Engineered Solutions LLC ("Contech"). Neither the drawing, nor any part thereof, may be used, reproduced or modified in any manner without the written consent of Contech. Contech expressly disclaims any liability or responsibility for any use.

If discrepancies between the supplied information upon which the drawing is based and actual field conditions are noted, the user must report to Contech immediately for re-evaluation of the design. Contech accepts no liability for design based on missing, incomplete or inaccurate information supplied by others.


MARK	DATE	REVISION DESCRIPTION	BY
AB-1	10/29/2021	AS-BUILT FINALS	TLF
AB	9/28/2021	AS-BUILT FINALS	TLF
E0	7/22/2021	APPROVED FOR CONSTRUCTION	TLF

100'-0" x 30'-0"
MESA TOP DRIVE SOUTH BRIDGE, INC
ELITE PROPERTIES OF AMERICA, INC
FOUNTAIN, CO


CONTECH
ENGINEERED SOLUTIONS LLC
www.conteches.com
15500 C-16 Dr., Greeley, CO 80631
800-328-2047 303-345-9120 303-566-3148 FAX

BIG R
BRIDGE


DATE:	7/24/2020		
DESIGNED:	NBE	DRAWN:	RDH
CHECKED:	NBE	APPROVED:	NBE
PROJECT No.:	621715	SEQUENCE No.:	030
SHEET:	6 OF 12		

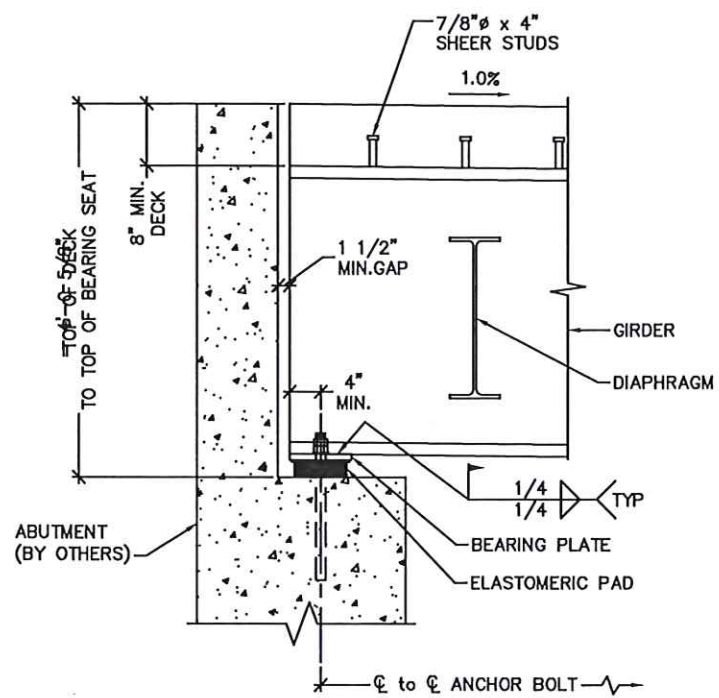


BEARING DETAIL

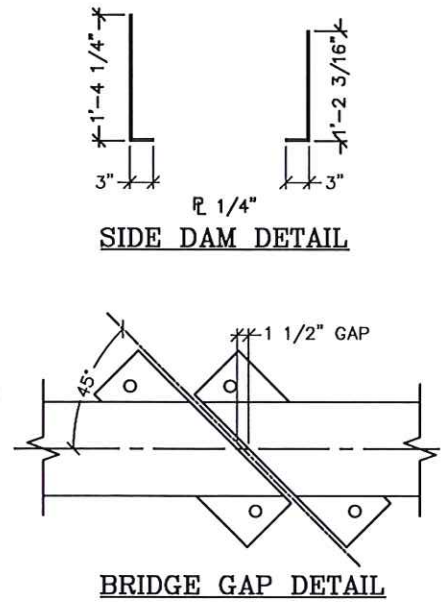


BRIDGE GAP DETAIL

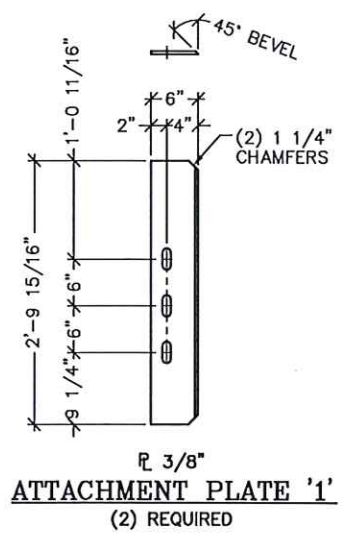


ATTACHMENT PLATE '1'
(2) REQUIRED

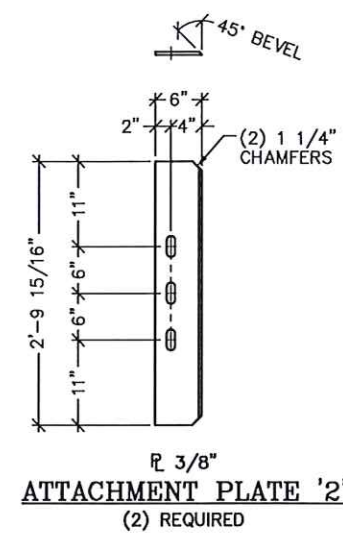


ATTACHMENT PLATE '2'
(2) REQUIRED

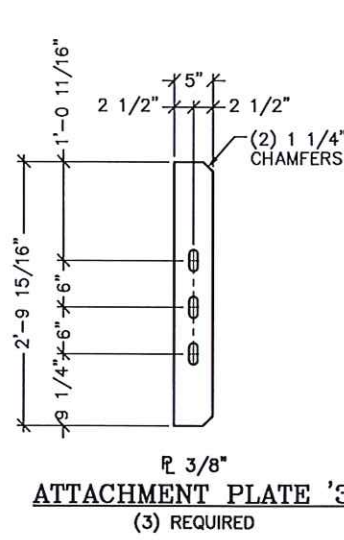


ATTACHMENT PLATE '3'
(3) REQUIRED

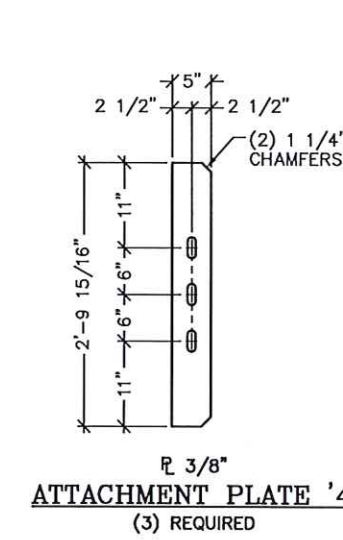

ATTACHMENT PLATE '4'
(3) REQUIRED

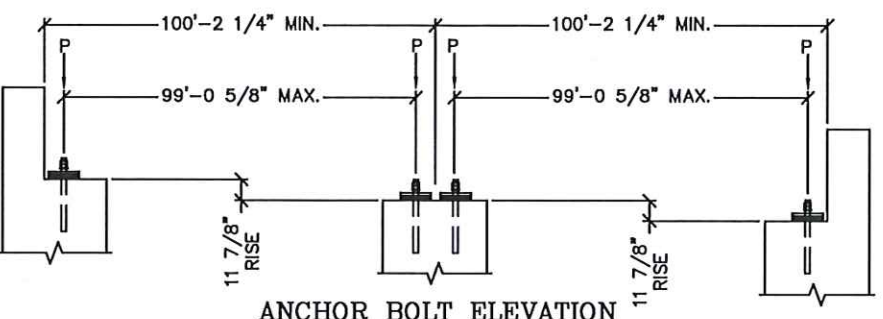


ANCHOR BOLT ELEVATION

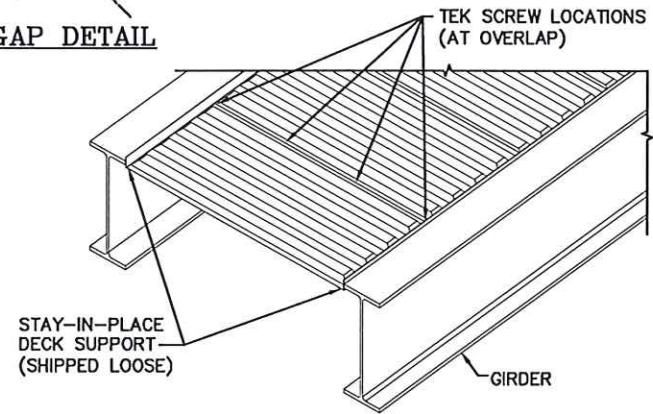


NOTES:
1) STAY-IN-PLACE DECK PANS TO BE ATTACHED IN THE FIELD TO THE SUPPC ANGLE WITH SELF-TAPPING TEK SCREWS PLACED AT THE FOUR PAN CORNERS AND AT THE 1/3 POINTS ALONG THE LONGITUDINAL OVERLAPS. (4 PER SHEET)


TYPICAL STAY-IN-PLACE DECK MOUNTING DETAIL

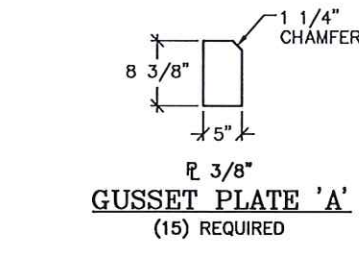


GUSSET PLATE 'A'
(15) REQUIRED

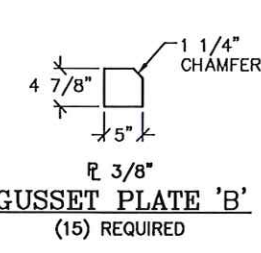


GUSSET PLATE 'B'
(15) REQUIRED

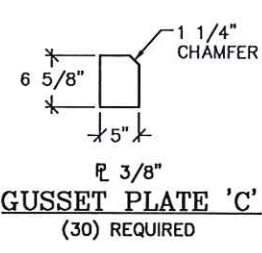


GUSSET PLATE 'C'
(30) REQUIRED

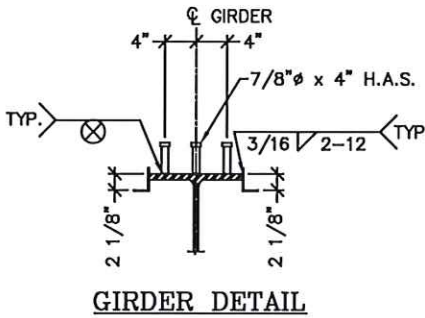


GIRDER DETAIL

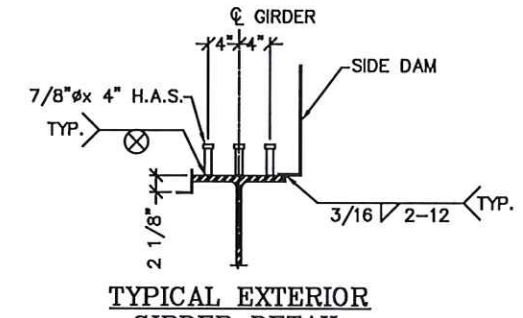


TYPICAL EXTERIOR GIRDER DETAIL

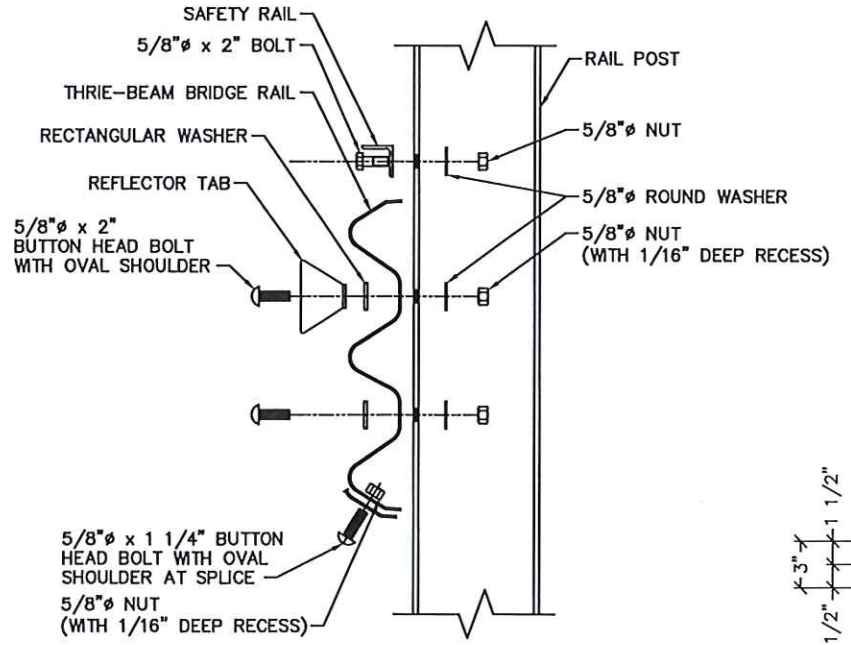


THREE-BEAM RAIL ATTACHMENT DETAIL
(W 8x18 POSTS)

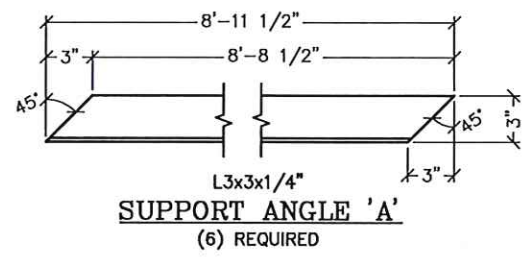


SUPPORT ANGLE 'A'
(6) REQUIRED

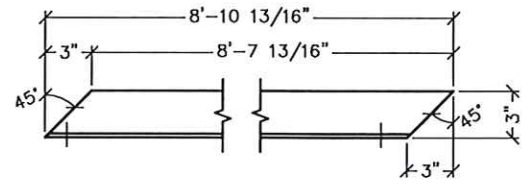

SUPPORT ANGLE 'B'
(2) REQUIRED

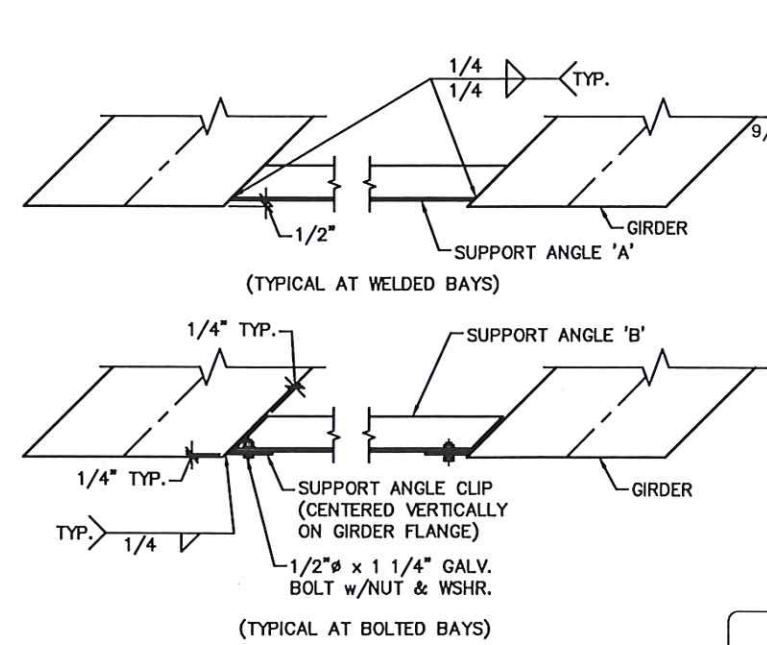

S.I.P. DECKING END SUPPORT DETAILS

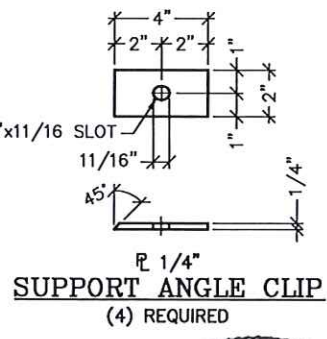

SUPPORT ANGLE CLIP
(4) REQUIRED



Engineering Record Drawings

The design and information shown on this drawing is the property of Contech Engineering Solutions, LLC and is to be used only for the project and location specified. It is not to be used, reproduced or modified in any manner without the written consent of Contech Engineering Solutions, LLC. Contech Engineering Solutions, LLC expressly disclaims any liability or responsibility for any errors or omissions on this drawing.

MARK	DATE	REVISION DESCRIPTION
AB-1	10/29/2021	AS-BUILT FINALS
AB	9/28/2021	AS-BUILT FINALS
E0	7/22/2021	APPROVED FOR CONSTRUCTION
		BY



100'-0" x 30'-0"
MESA TOP DRIVE SOUTH BRIDGE
ELITE PROPERTIES OF AMERICA, INC
FOUNTAIN, CO

CONTECH
ENGINEERED SOLUTIONS LLC
www.conteches.com
1500 CLARK ROAD, CO 80021
303-566-3148 FAX
303-566-3047


DATE:	7/24/2020
DESIGNED:	NBE
DRAWN:	RDH
CHECKED:	NBE
APPROVED:	NBE
PROJECT No.:	621715
SEQUENCE No.:	030
SHEET:	7 OF 12

C:\AUTODESK\VAULT\WORKING\2020\BEA\M62715\CAD\FABRICATION\REV AB-162715-030 REV-D.DWG 10/29/2021 12:24 PM


C:\AUTODESK VAULT\WORKING\2020\BEM\1715\CAD\FABRICATION\REV AB-11821715-030 REV-0.DWG 10/29/2021 12:24 PM

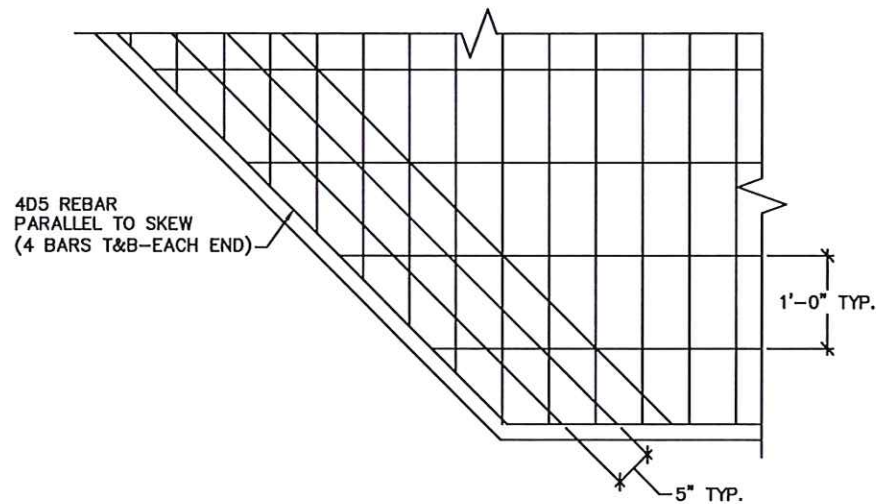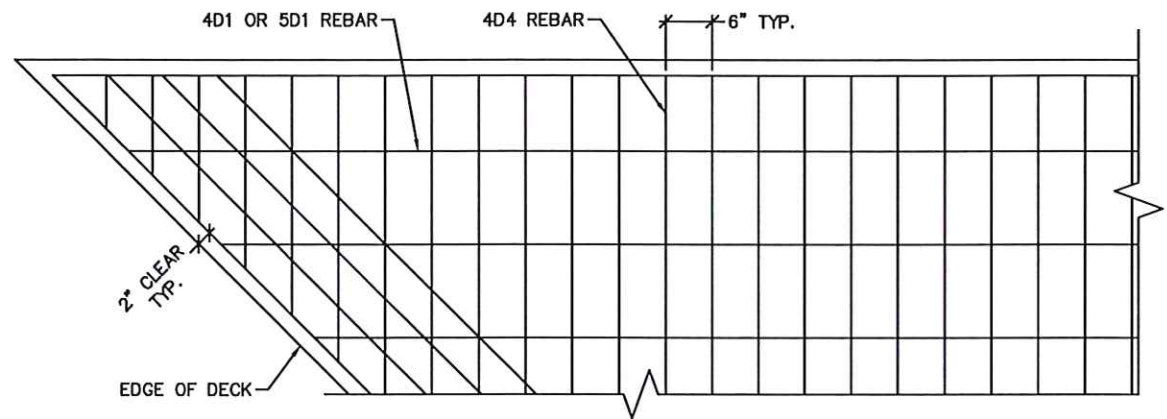


END REBAR LAYOUT

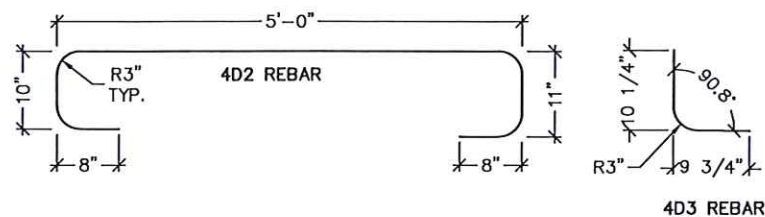

BENT REBAR DETAILS

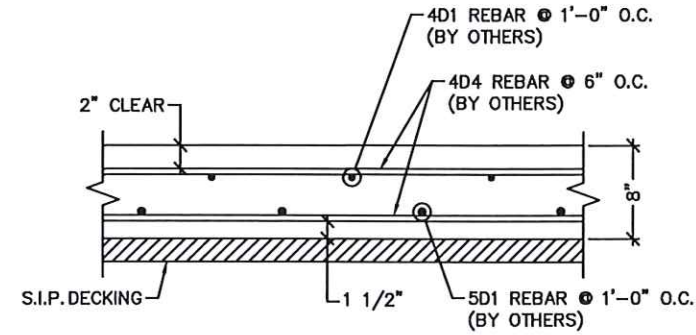

TYPICAL DECK SECTION

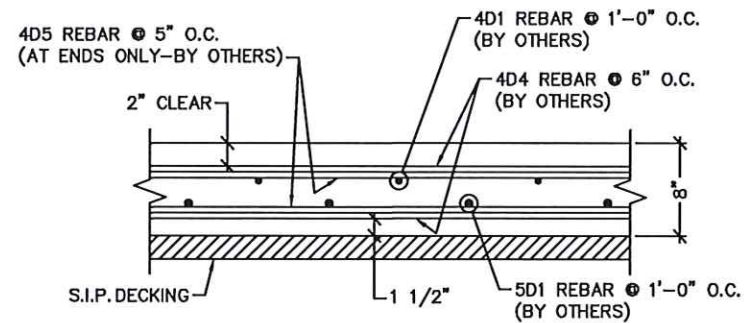

TYPICAL DECK SECTION AT ENDS

- NOTES:
 1. ALL CONCRETE & REBAR BY OTHERS
 2. ALL QUANTITIES ARE FOR ONE BRIDGE

MARK	TYPE	QUANTITY	LENGTH	REMARKS
4D1	STRAIGHT	38	99'-6"	EPOXY*
4D2	BENT	202	8'-1"	EPOXY
4D3	BENT	202	1'-8"	EPOXY
4D4	STRAIGHT	405	29'-7"	EPOXY
4D5	STRAIGHT	16	41'-11"	EPOXY
5D1	STRAIGHT	31	99'-6"	EPOXY*

DIGIT PRECEDING LETTER DENOTES SIZE OF REBAR
 * SEE CONCRETE NOTE 6 ON PG. 2 FOR SPLICING

Engineering Record Drawings



100'-0" x 30'-0"
 MESA TOP DRIVE SOUTH BRIDGE
 ELITE PROPERTIES of AMERICA, INC
 FOUNTAIN, CO

DATE:	7/24/2020
DESIGNED:	NBE
DRAWN:	RDH
CHECKED:	NBE
APPROVED:	NBE
PROJECT No.:	621715
SEQUENCE No.:	030
SHEET:	8 OF 12












9-20-22

The design and information shown on this drawing is provided as a service to the project owner, engineer, contractor, and other parties. It is not to be used, reproduced or modified in any manner without the written consent of the engineer. The engineer expressly disclaims any liability or responsibility for such use.

If discrepancies between the supplied information upon which the drawing is based and actual field conditions are encountered as site work progresses, the contractor shall immediately notify the engineer in writing for re-evaluation of the design. The engineer accepts no liability for designs based on missing, incomplete or inaccurate information supplied by others.

MARK	DATE	REVISION DESCRIPTION
AB-1	10/29/2021	AS-BUILT FINALS
AB	9/28/2021	AS-BUILT FINALS
E0	7/22/2021	APPROVED FOR CONSTRUCTION
		BY

C:\AUTODESK VAULT\WORKING\2020\BEBAM621715\CAD\FABRICATION\REV AB-11621715-030 REV:0.DWG 10/29/2021 12:24 PM

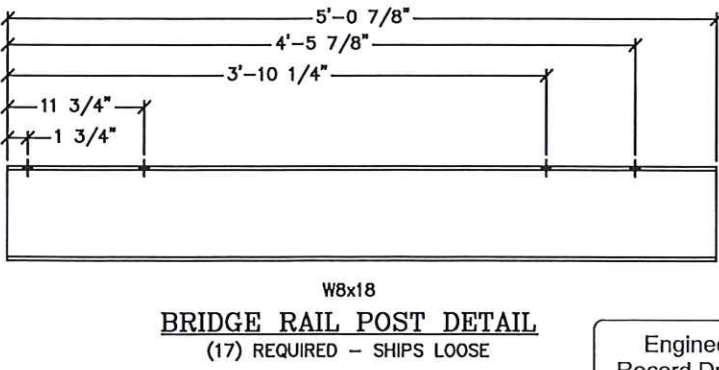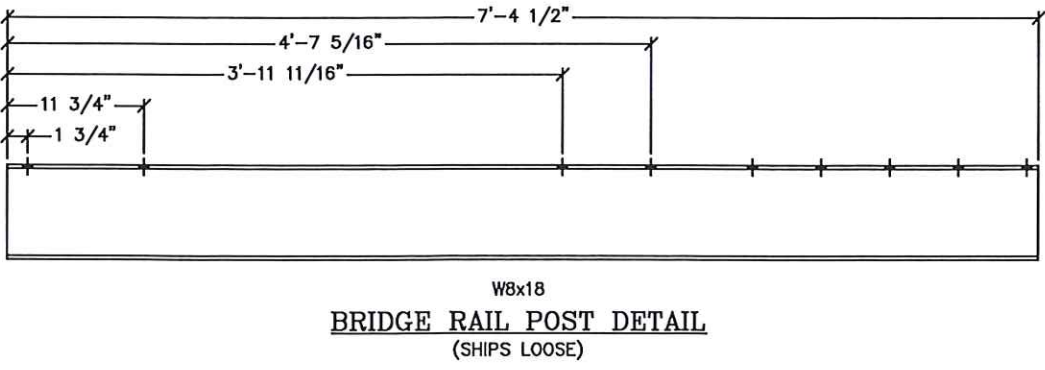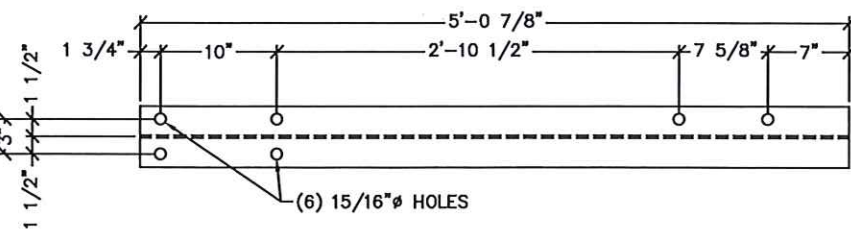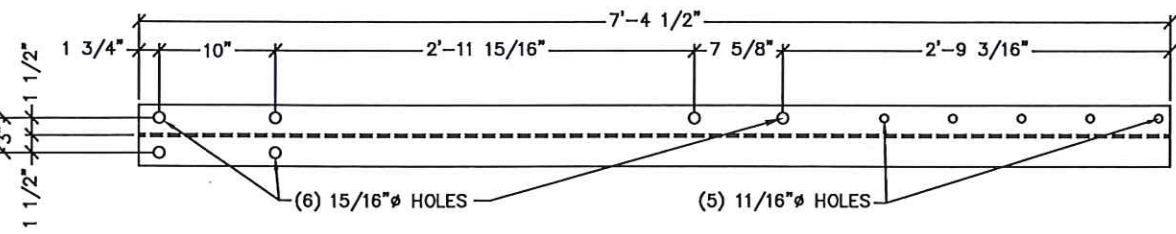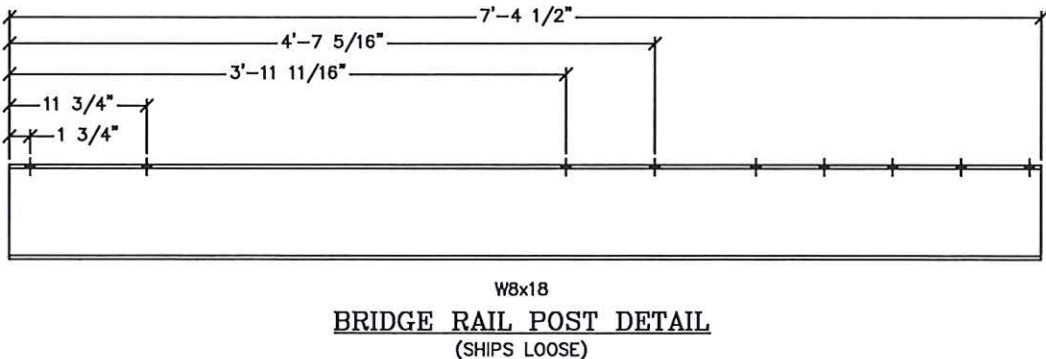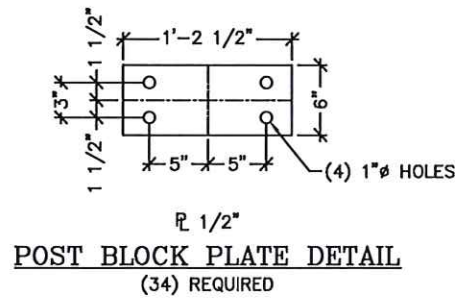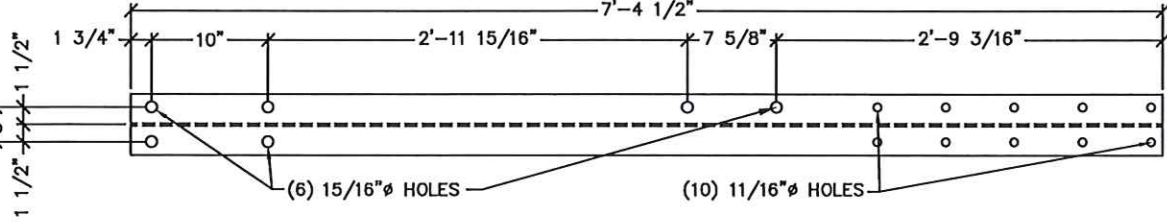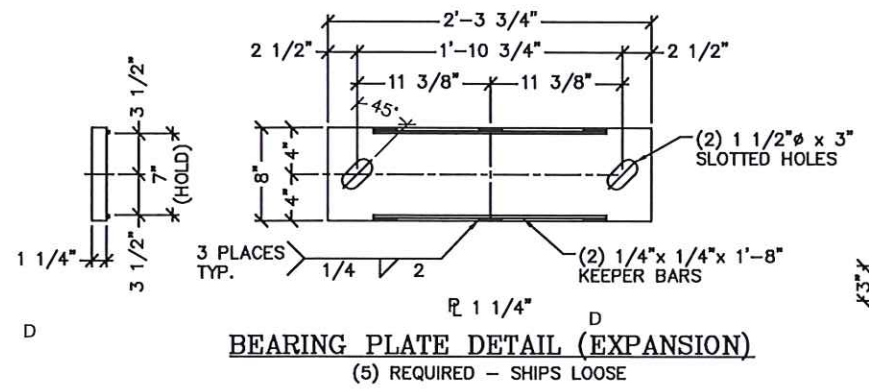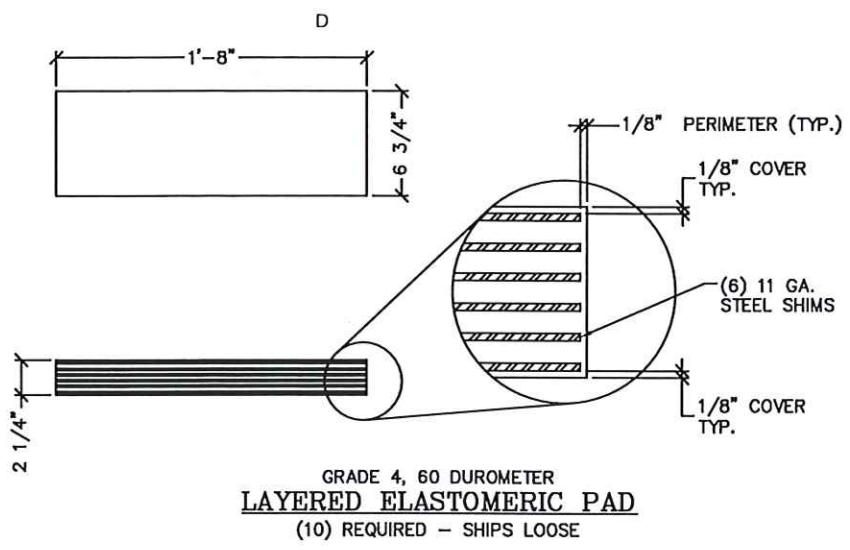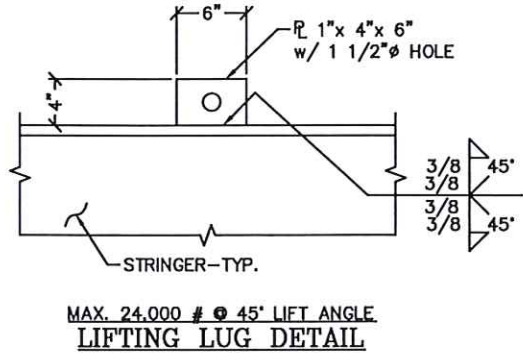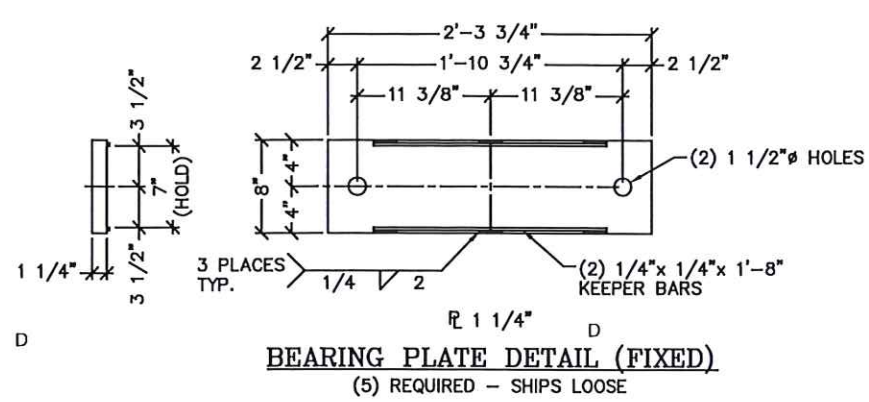

Engineering Record Drawings



<p>The design and information shown on this drawing is the property of Contech Engineered Solutions, LLC and is to be used only for the project and location specified. It is not to be used, reproduced or modified in any manner without the written consent of Contech Engineered Solutions, LLC. Contech Engineered Solutions, LLC expressly disclaims any liability or responsibility for such use.</p> <p>If discrepancies between the supplied information upon which the drawing is based and actual field conditions are encountered as site work progresses, the contractor shall immediately notify Contech immediately for re-evaluation of the design. Contech accepts no liability for design based on missing, incomplete or inaccurate information supplied by others.</p>	
DATE:	7/24/2020
DESIGNED:	NBE
DRAWN:	RDH
CHECKED:	NBE
APPROVED:	NBE
PROJECT No.:	621715
SEQUENCE No.:	030
SHEET:	9 OF 12

100'-0" x 30'-0"
 MESA TOP DRIVE SOUTH BRIDGE
 ELITE PROPERTIES of AMERICA, INC
 FOUNTAIN, CO


CONTECH
 ENGINEERED SOLUTIONS LLC
 www.conteches.com
 900-282-3247
 320-966-3148 FAX
 1100 S. G. Street, CO 80001

BIG R
 BRIDGE

9-20-22


C:\AUTODESK\VAULT\WORKING\2020\BEAM\621715\CAD\FABRICATION\REV AB-11621715-030 REV-C.DWG 10/29/2021 12:25 PM

MEMBERS	QTY	THICKNESS	SIZE	HOLES	BOLTS w/NUT & WASHER	BOLT QTY
WEB SPLICE PLATE	10	3/4"	1'-5" x 2'-3"	15/16"	7/8"φ x 3 3/4" A325 GALV	240
INSIDE BTM FLANGE SPLICE PLATE	10	1 1/4"	4 3/8" x 4'-7"	15/16"	-	-
OUTSIDE BTM FLANGE SPLICE PLATE	5	1"	1'-0" x 4'-7"	15/16"	7/8"φ x 5 1/2" A325 GALV	200
INSIDE TOP FLANGE SPLICE PLATE	10	1 1/4"	4 3/8" x 4'-7"	15/16"	-	-
OUTSIDE TOP FLANGE SPLICE PLATE	5	1"	1'-0" x 4'-7"	15/16"	7/8"φ x 5 1/2" A325 GALV	200

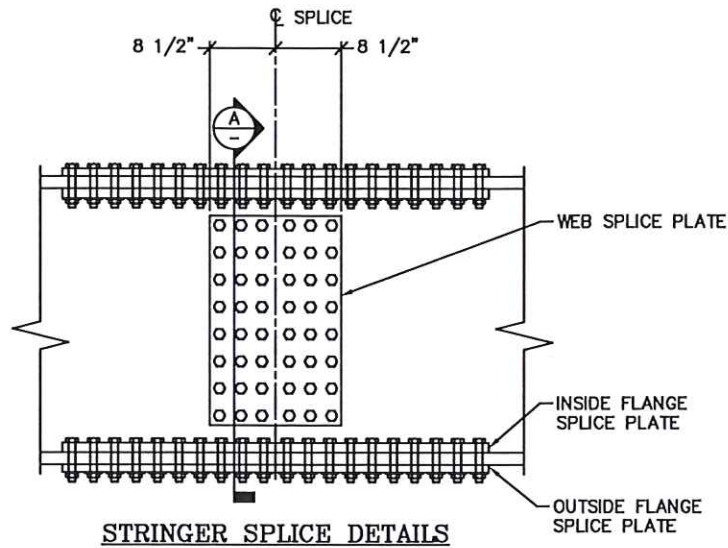


STRINGER SPLICE DETAILS

SHOP NOTE:
15/16"φ HOLES IN STRINGER FLANGE AND WEB

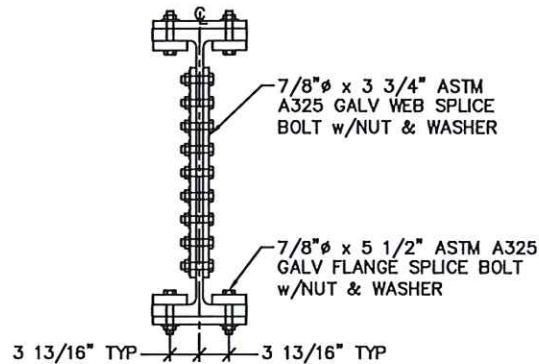


SECTION A


CONTRACTOR NOTE:
FIELD WELDING TO BE PERFORMED BY A WELDER CERTIFIED PER AWS D1.5 BRIDGE WELDING CODE.

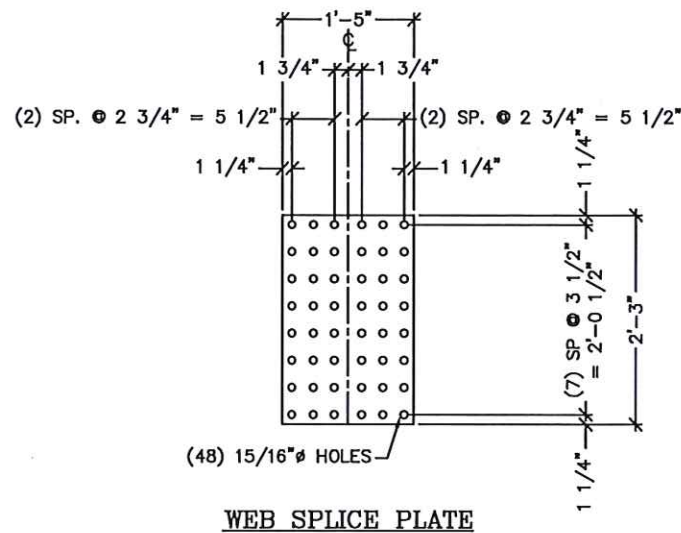

WEB SPLICE PLATE

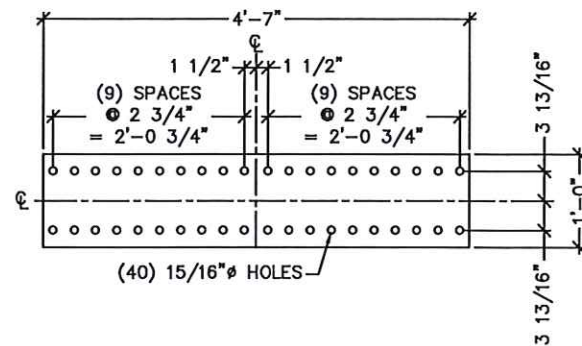

OUTSIDE TOP & BTM FLANGE SPLICE PLATE

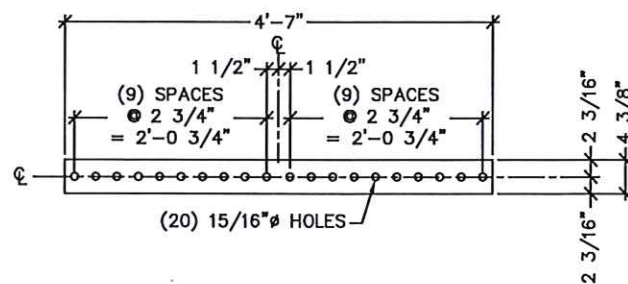

INSIDE TOP & BTM FLANGE SPLICE PLATE

Engineering Record Drawings



The design and information shown on this drawing is the property of Contech Engineered Solutions, LLC ("Contech"). Neither the drawing, nor any part thereof, may be used, reproduced or modified in any manner without the prior written consent of Contech. Contech expressly disclaims any liability or responsibility for such use.

If discrepancies between the supplied information upon which the drawing is based and actual field conditions are discovered, the contractor shall immediately notify Contech in writing. Contech shall immediately re-evaluate the design. Contech accepts no liability for design based on missing, incomplete or inaccurate information supplied by others.

MARK	DATE	REVISION DESCRIPTION
AB-1	10/29/2021	AS-BUILT FINALS
AB	9/28/2021	AS-BUILT FINALS
E0	7/22/2021	APPROVED FOR CONSTRUCTION


100'-0" x 30'-0"
MESA TOP DRIVE SOUTH BRIDGE
ELITE PROPERTIES of AMERICA, INC
FOUNTAIN, CO

CONTECH
ENGINEERED SOLUTIONS LLC
www.conteches.com
1650 OLYMPIA BLVD, SUITE 100
FOUNTAIN, CO 80026
800-320-2047 303-345-9728 303-668-3148 FAX


BIG R
BRIDGE

DATE: 7/24/2020
DESIGNED: NBE DRAWN: RDH
CHECKED: NBE APPROVED: NBE
PROJECT No.: 621715 SEQUENCE No.: 030
SHEET: 10 OF 12


C:\AUTODESK\VAULT\WORKING\2020\BEAM\21715\CAD\FABRICATION\REV AB-1\21715-030 REV-0.DWG - 10/29/2021 12:35 PM

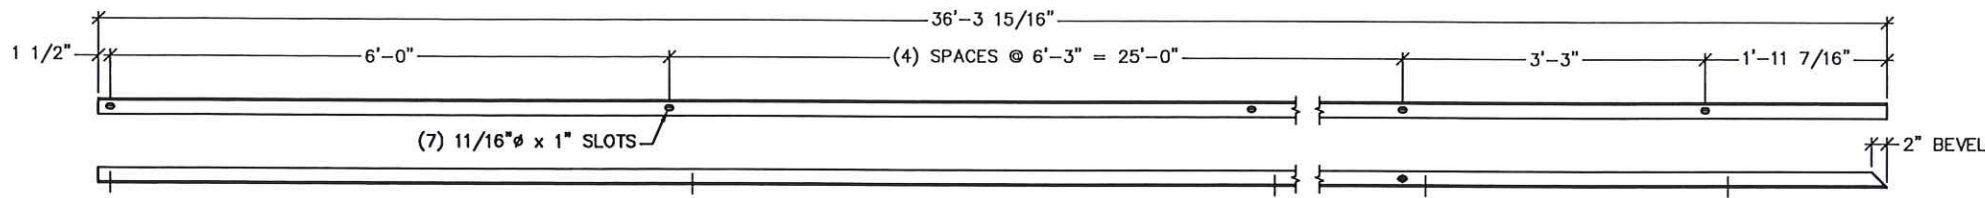


**L2x2x3/16
SAFETY RAIL #1 DETAIL**
(20) REQUIRED - SHIPS LOOSE

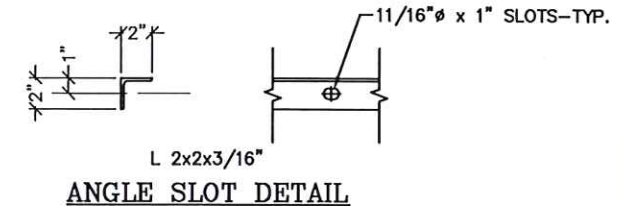


**L 2x2x3/16"
ANGLE SLOT DETAIL**

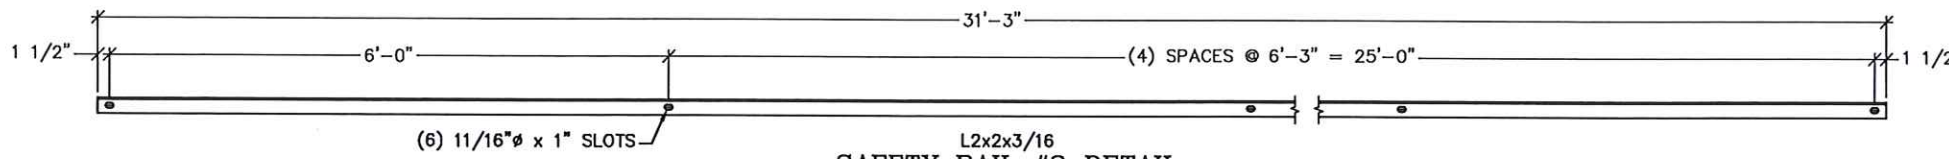



**L2x2x3/16
SAFETY RAIL #2 DETAIL**
(60) REQUIRED - SHIPS LOOSE

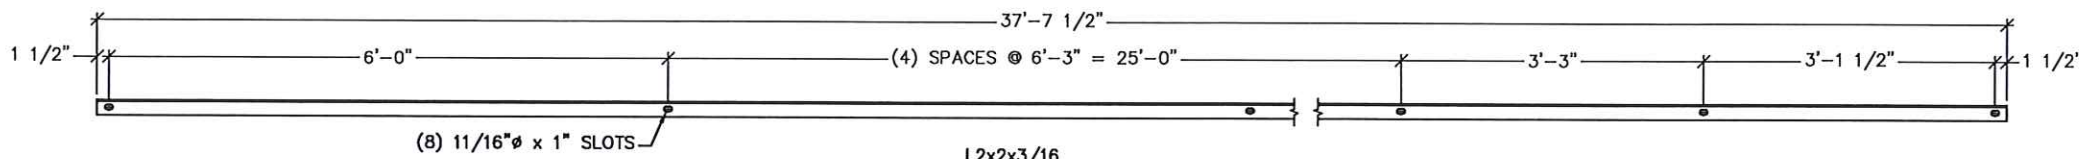


**L2x2x3/16
SAFETY RAIL #3 DETAIL**
(20) REQUIRED - SHIPS LOOSE

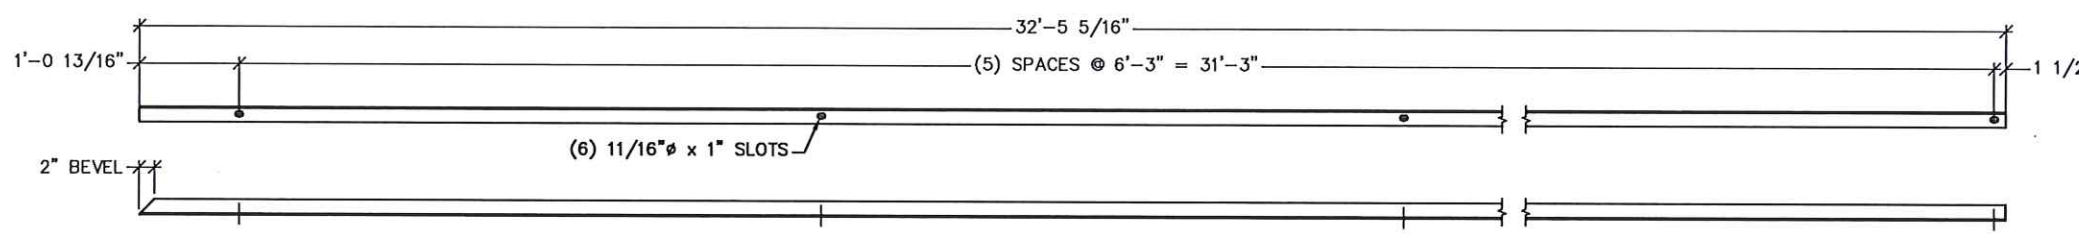


**L2x2x3/16
SAFETY RAIL #4 DETAIL**
(20) REQUIRED - SHIPS LOOSE

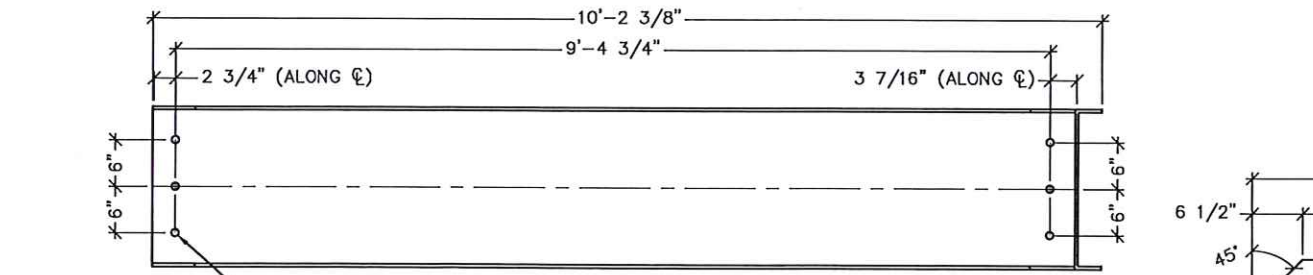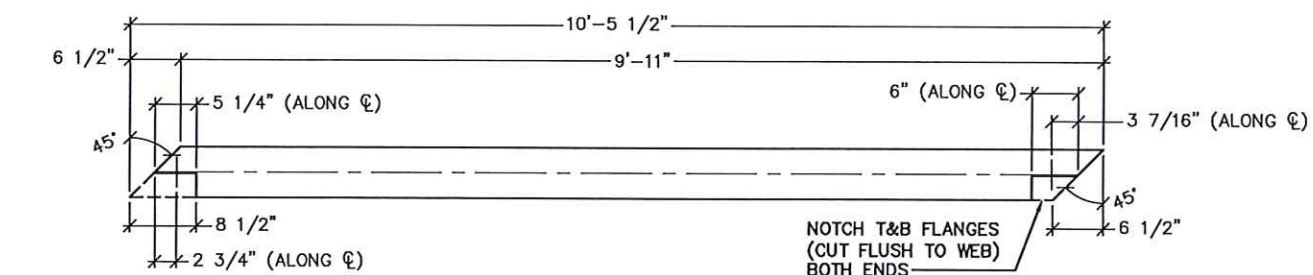


**W21x44
BOLTED MID DIAPHRAGM DETAIL**
(2) REQUIRED - SHIPS LOOSE

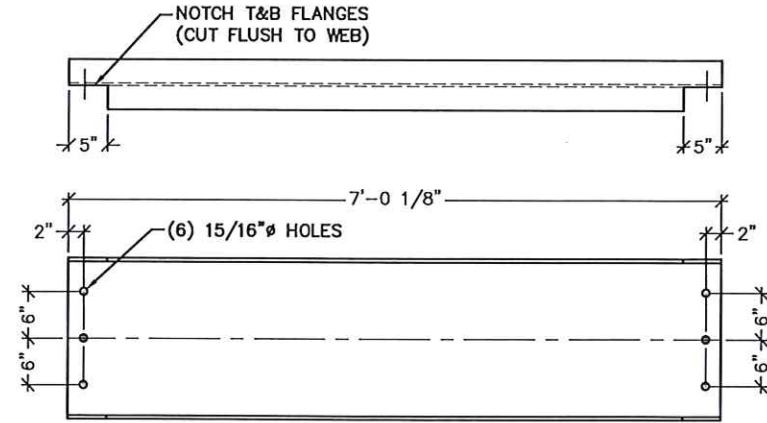

**W21x44
BOLTED MID DIAPHRAGM DETAIL**
(3) REQUIRED - SHIPS LOOSE

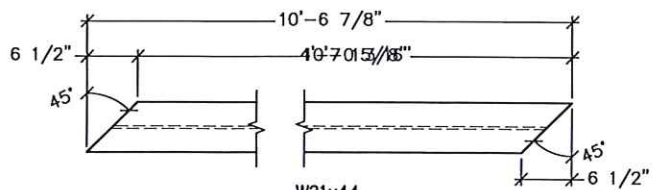

**W21x44
WELDED END DIAPHRAGM DETAIL**
(6) REQUIRED - SHIPS LOOSE

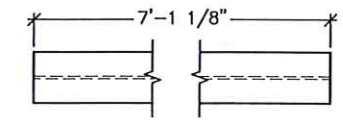

**W21x44
WELDED MID DIAPHRAGM DETAIL**
(9) REQUIRED - SHIPS LOOSE

Engineering
Record Drawings



The design and information shown on this drawing is the property of Contech Engineered Solutions LLC and contractor by Contech Engineered Solutions LLC ("Contech"). Neither this drawing, nor any part thereof, is to be reproduced or transmitted in any form or by any means, electronic or mechanical, including photocopying, recording, or by any information storage and retrieval system, without the prior written permission of Contech. Failure to comply is done at the user's own risk and Contech expressly disclaims any liability or responsibility for such use. If discrepancies between the supplied information upon which the drawing is based and actual field conditions are noted, the user must immediately report these discrepancies to the design engineer. Contech immediately reserves the right to revise the design, without notice, and the user must accept the design as shown. Contech is not responsible for any errors or omissions in this drawing or for any consequences arising therefrom.

NO.	DATE	REVISION DESCRIPTION	BY
AB-1	10/29/2021	AS-BUILT FINALS	TLF
AB	9/28/2021	AS-BUILT FINALS	TLF
EO	7/22/2021	APPROVED FOR CONSTRUCTION	TLF

100'-0" x 30'-0"
MESA TOP DRIVE SOUTH BRIDGE
ELITE PROPERTIES of AMERICA, INC
FOUNTAIN, CO

CONTECH
ENGINEERED SOLUTIONS LLC
www.conteches.com
16620 C-160, Fountain, CO 80015
800-228-2047 320-345-9130 320-966-3148 FAX


BIG R
BRIDGE

DATE: 7/24/2020


DESIGNED: NBE	DRAWN: RDH
CHECKED: NBE	APPROVED: NBE

PROJECT No.: 621715 SEQUENCE No.: 030


SHEET: 11 OF 12

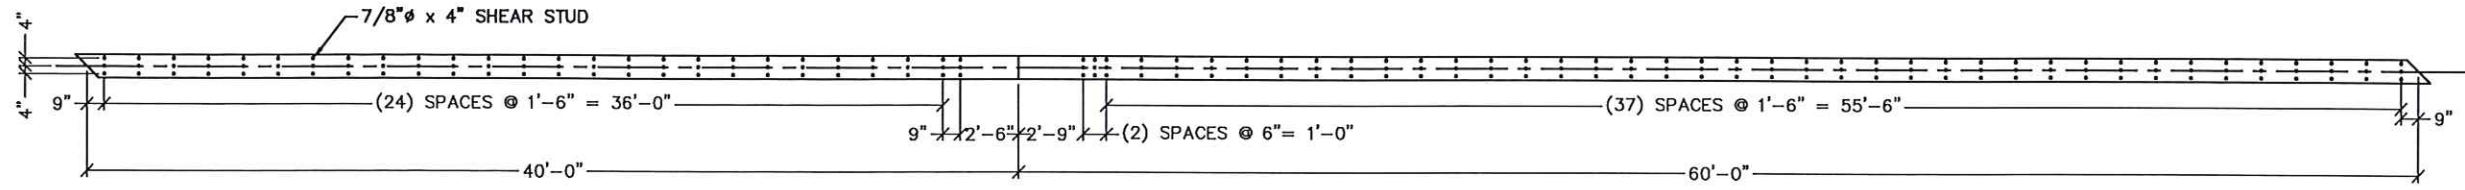


SHEAR STUD DETAIL

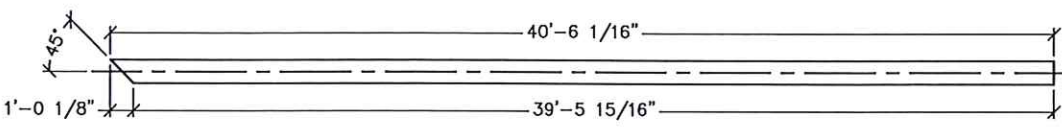


W36x232 GIRDER DETAIL (5) REQUIRED

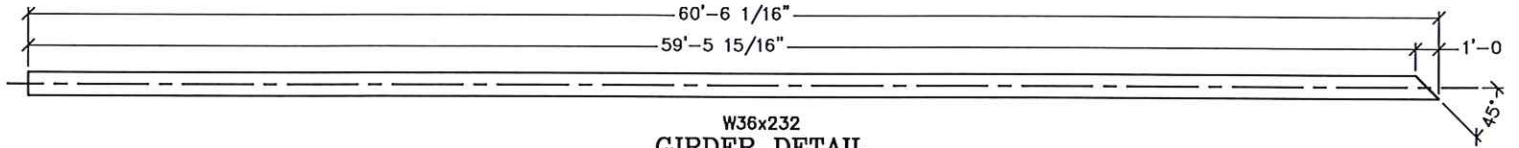


W36x232 GIRDER DETAIL (5) REQUIRED

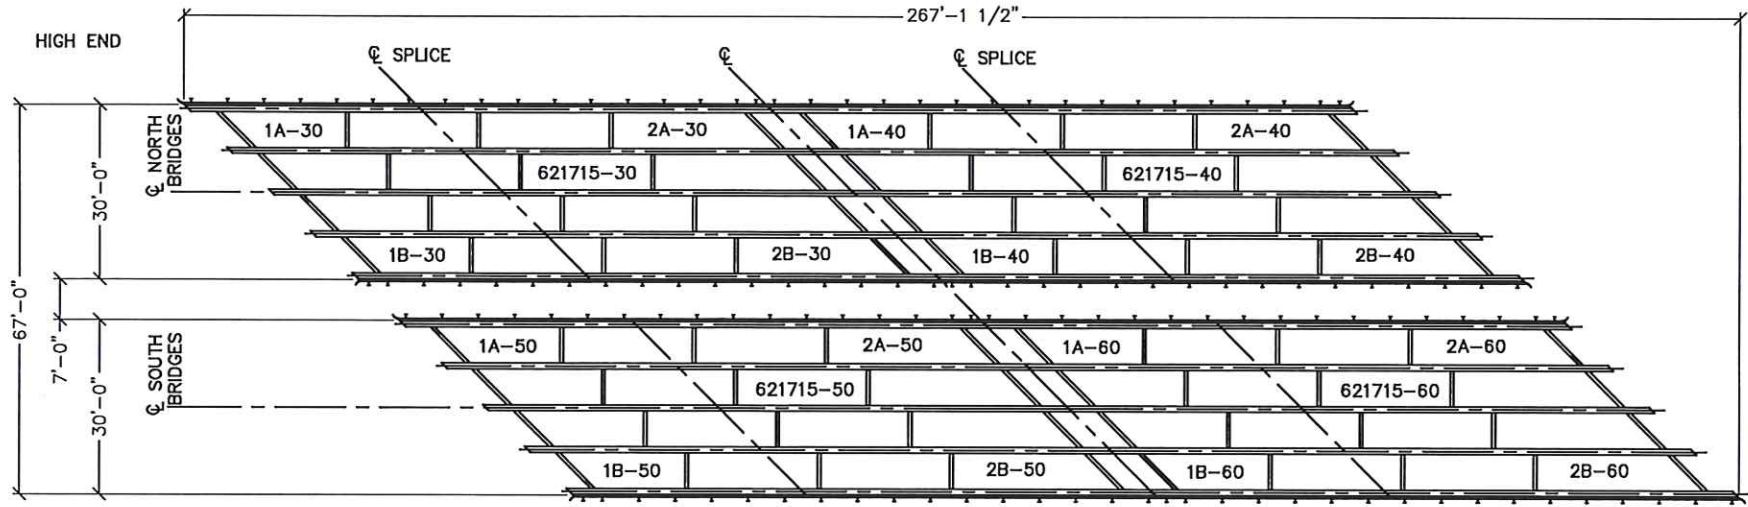


PROJECT LAYOUT

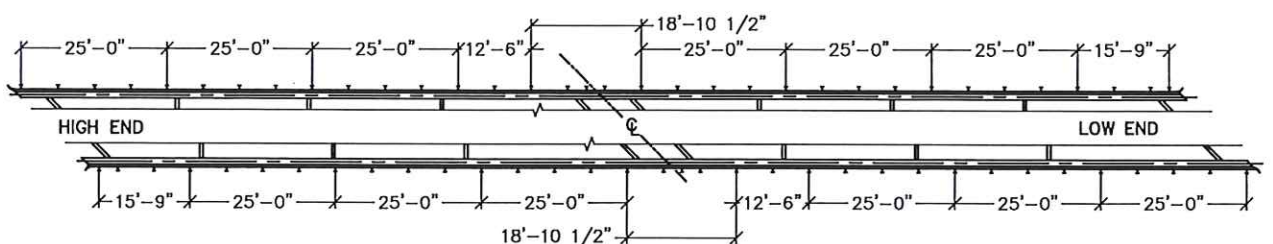


THRIE-BEAM BRIDGE RAIL LAYOUT
TYPICAL 621715-30 & 621715-40
TYPICAL 621715-50 & 621715-60

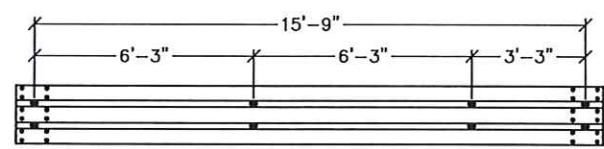

END THRIE-BEAM RAIL LAYOUT (TYPICAL AT SHORT CORNER OF EACH BRIDGE) (4) REQUIRED

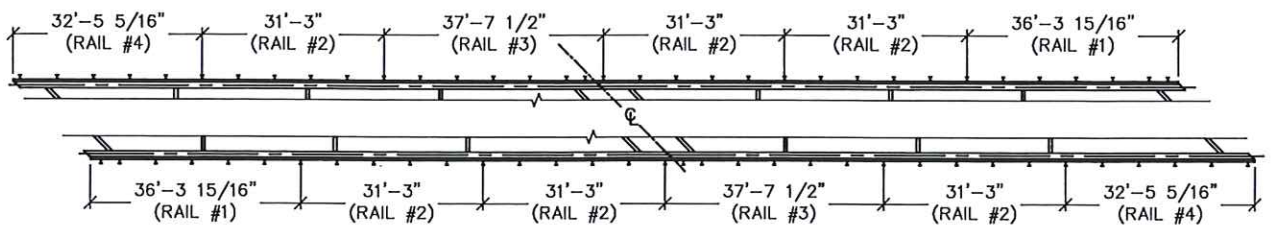

ANGLE SAFETY RAIL LAYOUT
TYPICAL 621715-30 & 621715-40
TYPICAL 621715-50 & 621715-60

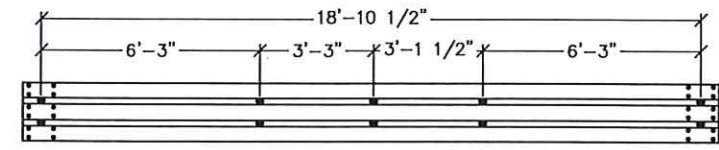

THRIE-BEAM RAIL AT BRIDGE GAP LAYOUT (TYPICAL BETWEEN 621715-30 & 621715-40) (TYPICAL BETWEEN 621715-50 & 621715-60) (4) REQUIRED

NOTE: ALL RAIL SECTIONS NOT SHOWN ARE STANDARD MILL PUNCH.

Engineering Record Drawings



9-20-22



The design and information shown on this drawing is the property of Contech Engineered Solutions, LLC and is to be used only for the project and location specified. Any reproduction or use of this drawing without the written consent of Contech Engineered Solutions, LLC is strictly prohibited. Contech Engineered Solutions, LLC expressly disclaims any liability or responsibility for any damages, including consequential, special, or punitive damages, arising from any reliance on the information contained herein. If discrepancies between the supplied information and the information on this drawing are noted, the information on this drawing shall prevail. Contech Engineered Solutions, LLC is not responsible for any errors or omissions in this drawing. Contech Engineered Solutions, LLC is not responsible for any delays or interruptions in the design process. Contech Engineered Solutions, LLC is not responsible for any delays or interruptions in the construction process. Contech Engineered Solutions, LLC is not responsible for any delays or interruptions in the project schedule. Contech Engineered Solutions, LLC is not responsible for any delays or interruptions in the project budget. Contech Engineered Solutions, LLC is not responsible for any delays or interruptions in the project completion. Contech Engineered Solutions, LLC is not responsible for any delays or interruptions in the project performance. Contech Engineered Solutions, LLC is not responsible for any delays or interruptions in the project quality. Contech Engineered Solutions, LLC is not responsible for any delays or interruptions in the project safety. Contech Engineered Solutions, LLC is not responsible for any delays or interruptions in the project health. Contech Engineered Solutions, LLC is not responsible for any delays or interruptions in the project environment. Contech Engineered Solutions, LLC is not responsible for any delays or interruptions in the project community. Contech Engineered Solutions, LLC is not responsible for any delays or interruptions in the project stakeholders. Contech Engineered Solutions, LLC is not responsible for any delays or interruptions in the project success.

MARK	DATE	REVISION DESCRIPTION	BY
AB-1	10/29/2021	AS-BUILT FINALS	TLF
AB	9/28/2021	AS-BUILT FINALS	TLF
E0	7/22/2021	APPROVED FOR CONSTRUCTION	TLF

100'-0" x 30'-0"
MESA TOP DRIVE SOUTH BRIDGE
ELITE PROPERTIES of AMERICA, INC
FOUNTAIN, CO

CONTECH
ENGINEERED SOLUTIONS LLC
www.conteches.com
1500 G Street, Fountain, CO 80015
303-345-9125 303-560-3148 FAX
800-328-3047

BIG R
BRIDGE



DATE: 7/24/2020

DESIGNED: NBE	DRAWN: RDH
CHECKED: NBE	APPROVED: NBE
PROJECT No.: 621715	SEQUENCE No.: 030
SHEET: 12	OF 12


C:\AUTODESK\VAULT\WORKING\2020\BEAM\21715\030\FABRICATION\REV\AB-1\21715-030 REV-0.DWG 10/29/2021 12:25 PM

GENERAL NOTES:




1. CONTECH ENGINEERED SOLUTIONS HAS AISC QUALITY CERTIFIED BRIDGE FABRICATION - ADVANCED (MAJOR) WITH A FRACTURE CRITICAL AND SOPHISTICATED PAINT ENDORSEMENT.
2. MATERIALS: (UNLESS NOTED OTHERWISE):
 - a. STRUCTURAL STEEL: ASTM A588 WEATHERING STEEL
3. ALL WELDING SHALL USE THE GAS METAL ARC WELDING OR FLUX CORED ARC WELDING PROCESS.

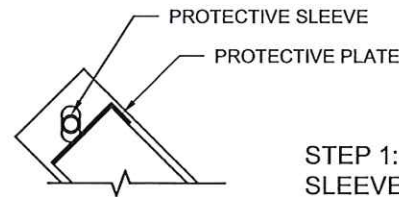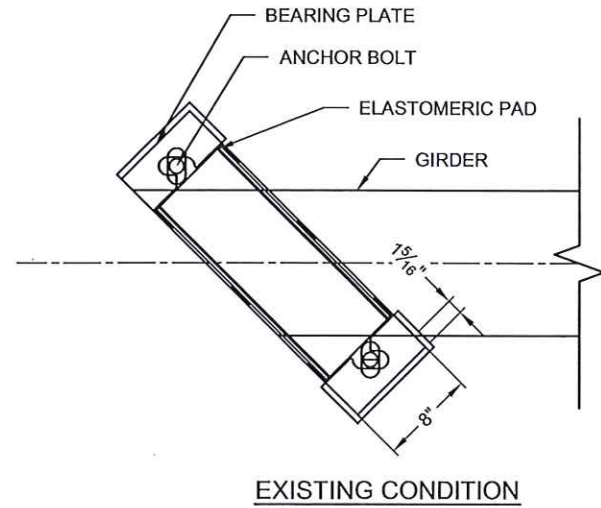


STEP 1: APPLY PROTECTIVE SLEEVE TO ANCHOR BOLT AND PLATE TO SIDE OF BEARING PAD

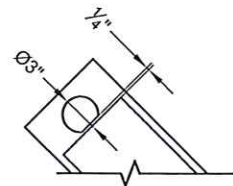


STEP 2: CUT 3" DIA. HOLE CENTERED AT ANCHOR BOLT TAKING CARE TO STAY 1/4" AWAY FROM ELASTOMERIC BEARING PAD.

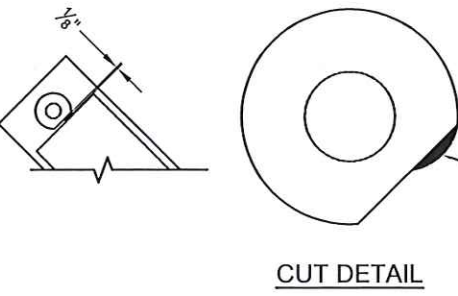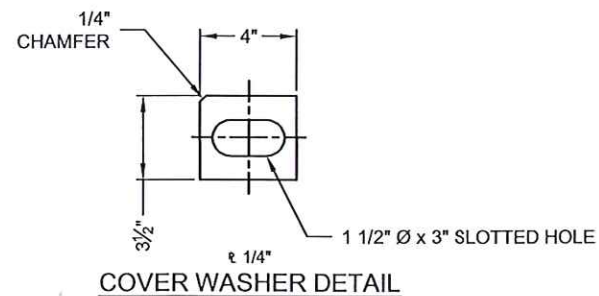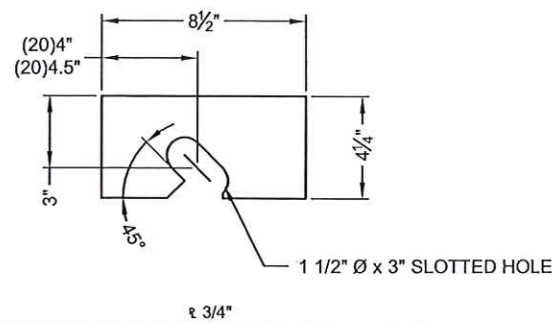


STEP 3: GRIND 1/8" AT TOP OF FLAT CUT TO PROVIDE FULL SLOT DIMENSIONS

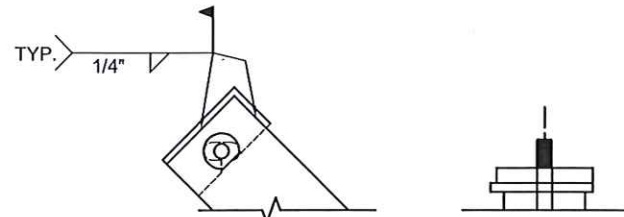


STEP 4: INSERT ANCHOR BOLT GUIDE PLATE UNDERNEATH BEARING PLATE AND WELD ALONG EXPOSED SIDES.

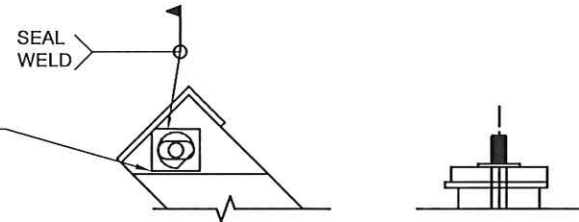

STEP 5: PLACE COVER WASHER ON TOP OF BEARING PLATE AND SEAL WELD INTO PLACE.

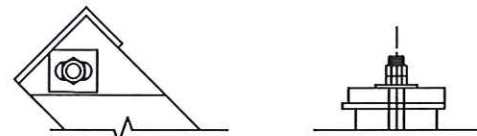

STEP 6: REMOVE PROTECTIVE SLEEVE AND PLATE, INSTALL NUTS ON ANCHOR BOLTS PER ORIGINAL PLANS.

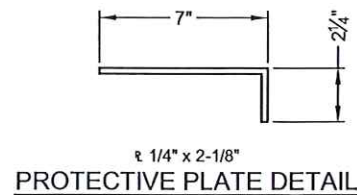

Engineering Record Drawings



5-2-22



The design and information shown on this drawing is provided as a service to the project owner, engineer or contractor. It is not to be used, reproduced or modified in any manner without the prior written consent of Contech. Contech expressly disclaims any liability or responsibility for such use. If discrepancies between the supplied information upon which the drawing is based and actual field conditions are encountered as site work progresses, these discrepancies must be reported to Contech immediately. Contech shall not be held liable for designs based on missing, incomplete or inaccurate information supplied by others.

MARK	DATE	REVISION DESCRIPTION	BY
RP	4/29/2022	BRIDGE BEARING FIELD REPAIR	NBE
AB-1	10/29/2021	AS-BUILT FINALS	TLF
AB	9/28/2021	AS-BUILT FINALS	TLF
EO	7/22/2021	APPROVED FOR CONSTRUCTION	TLF

100'-0" x 30'-0"
MESA TOP DRIVE SOUTH BRIDGE
ELITE PROPERTIES of AMERICA, INC
FOUNTAIN, CO

CONTECH
ENGINEERED SOLUTIONS LLC
www.ContechES.com

BIG R
BRIDGE

DATE: 7/24/2020

DESIGNED: NBE	DRAWN: RDH
CHECKED: NBE	APPROVED: NBE
PROJECT No.: 621715	SEQUENCE No.:
SHEET:	1 OF 1