



1 NEW NORTHEAST SITE ELEVATION

SCALE: 1/16" = 1'-0"

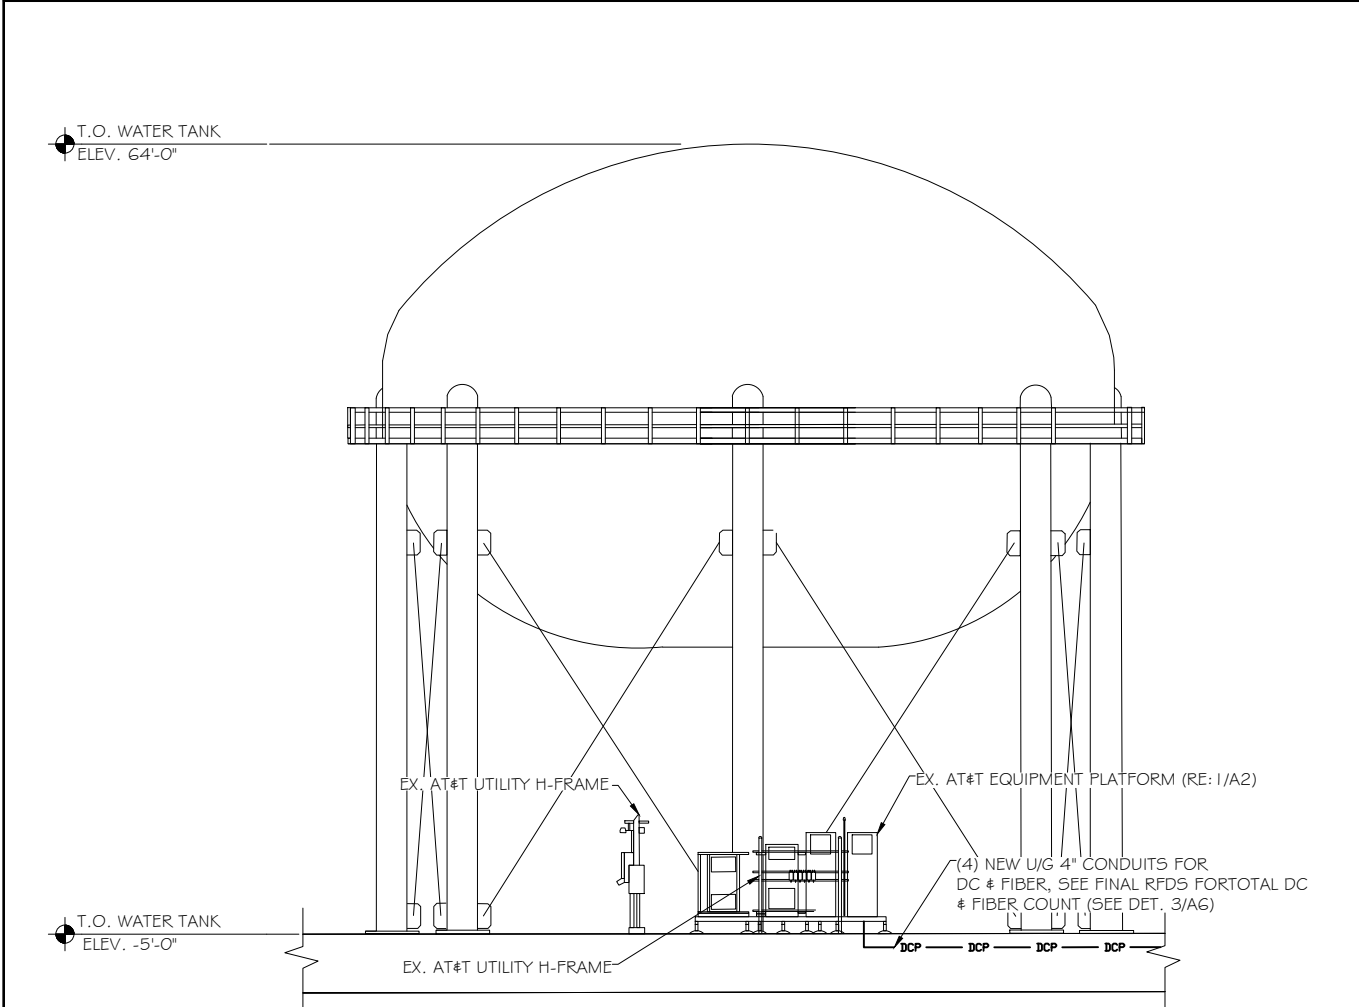

2 NEW PARTIAL NORTHEAST ELEVATION

SCALE: 1/8" = 1'-0"

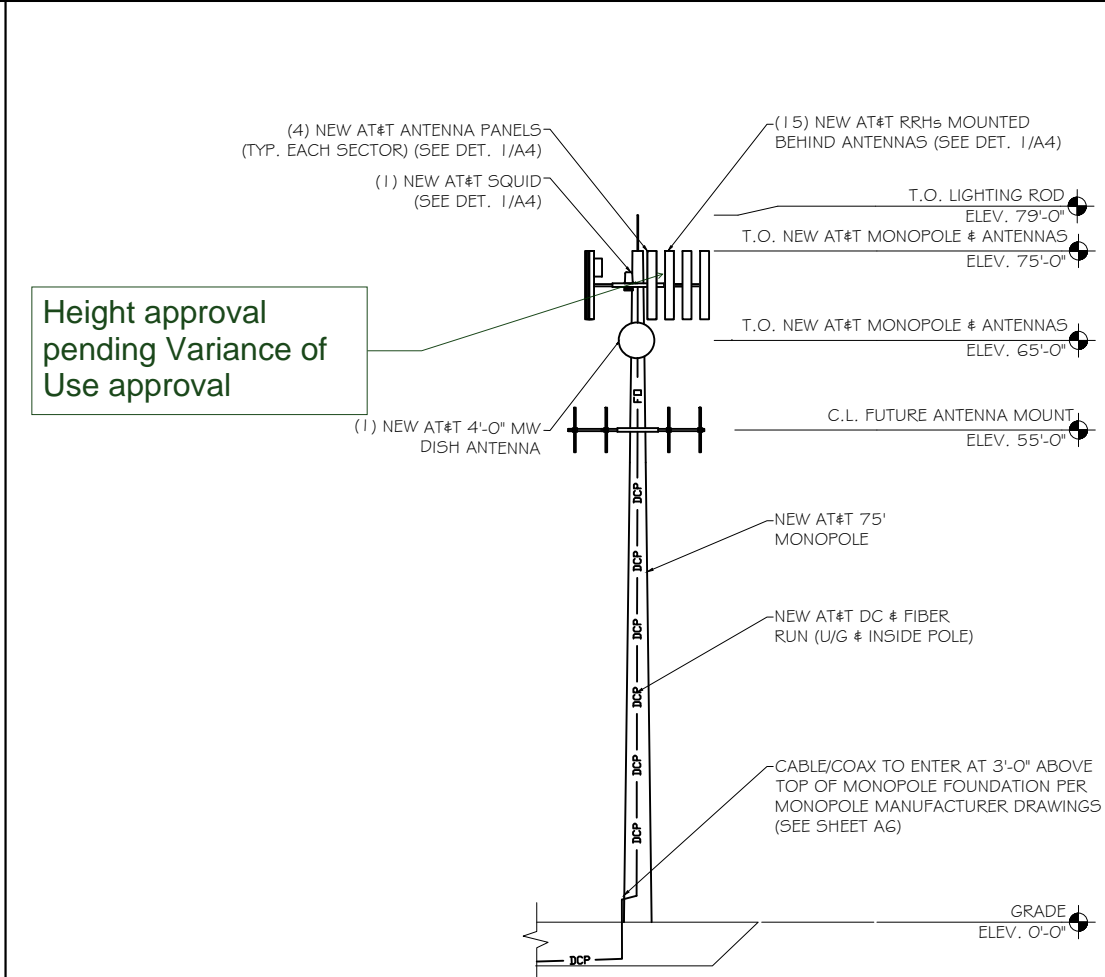

3 NEW NORTHEAST ELEVATION (NEW RELO SITE AT MONOPOLE)

SCALE: 3/32" = 1'-0"



PROJECT INFORMATION:

SITE NAME:  
FOUNTAIN VALLEY  
SITE ID:  
COUG000-RELO  
COLO6000  
13250 RAY NIXON RD.  
FOUNTAIN, CO 80817  
EL PASO

Rev:	Date:	Description:	By:
1	05/31/16	PRELIM. CONST.	GW
2	06/20/16	CLIENT COMMENTS	GW
3	10/17/16	RF. DESIGN UPDATE	AM
4	02/22/17	RF DESIGN UPDATE	AM
5	03/09/17	CONSTRUCTION	AM

PLANS PREPARED BY:

**CENTERLINE SOLUTIONS**  
Advancing Wireless Networks  
16035 TABLE MOUNTAIN PARKWAY  
Golden, CO 80403  
303-993-3293  
WWW.CENTERLINESOLUTIONS.COM

LICENSURE NO:



ALL SCALES ARE SET FOR 24"x36" SHEET



DRAWN BY:	CHK BY:	APV BY:
GW	AM	KS

Sheet Title:

NEW NORTHEAST  
ELEVATION

Sheet Number:

A3.1

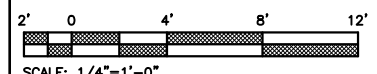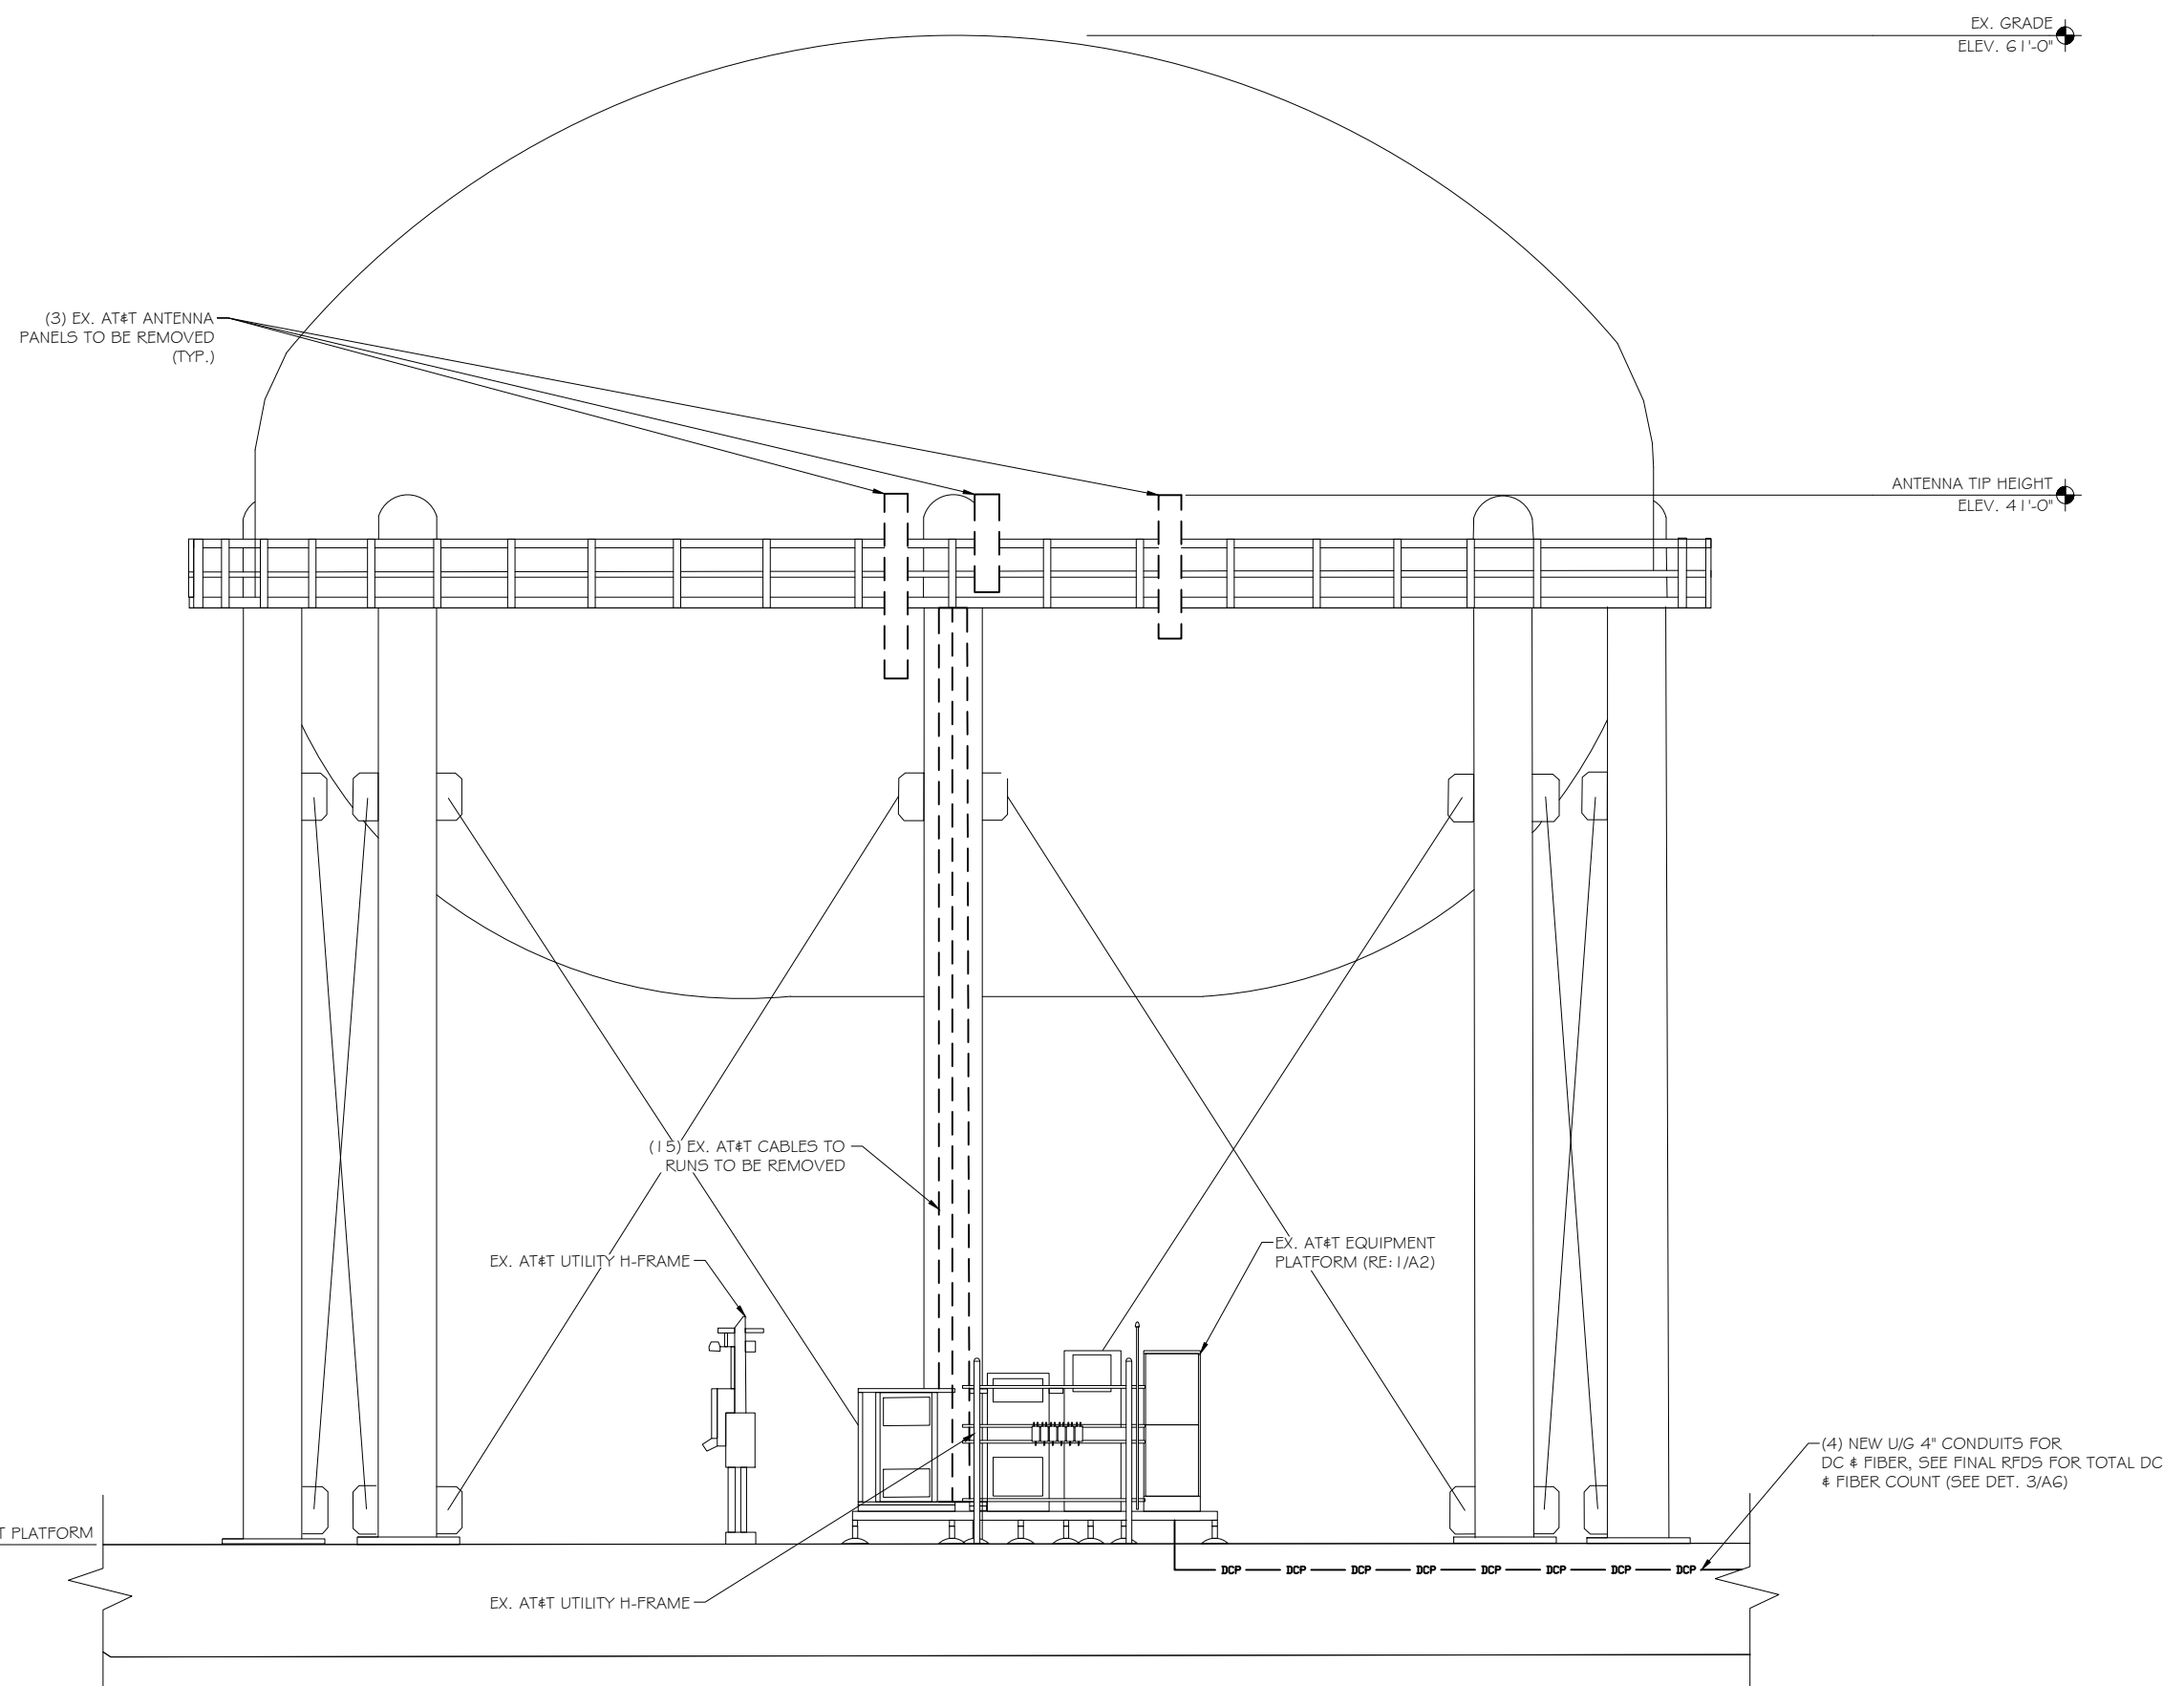

SCALE: 1/4"=1'-0"

1 | NORTHEAST ELEVATION (EX. WATER TANK)

SCALE: 1/4" = 1'-0"



PROJECT INFORMATION:

SITE NAME:  
FOUNTAIN VALLEY  
SITE ID:  
COUG000-RELO  
COLO6000  
13250 RAY NIXON RD.  
FOUNTAIN, CO 80817  
EL PASO

Rev:	Date:	Description:	By:
1	05/31/16	PRELIM. CONST.	GW
2	06/20/16	CLIENT COMMENTS	GW
3	10/17/16	RF. DESIGN UPDATE	AM
4	02/22/17	RF DESIGN UPDATE	AM
5	03/09/17	CONSTRUCTION	AM

PLANS PREPARED BY:



**CENTERLINE**  
SOLUTIONS  
*Advancing Wireless Networks*

16035 TABLE MOUNTAIN PARKWAY  
Golden, CO 80403  
303-993-3293  
WWW.CENTERLINESOLUTIONS.COM

LICENSURE NO:



ALL SCALES ARE SET FOR 24"x36" SHEET

DRAWN BY:	CHK BY:	APV BY:
GW	AM	KS

Sheet Title:


EX. NORTHEAST  
ELEVATION

Sheet Number:

A3

# Markup Summary

dsdsevigny (1)

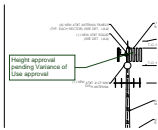

**Subject:** Callout  
**Page Label:** [7] COU6000 CDs.dwg COPY-A3.1  
**Lock:** Locked  
**Status:**  
**Checkmark:** Unchecked  
**Author:** dsdsevigny  
**Date:** 11/16/2017 11:16:58 AM  
**Color:** █

Height approval pending Variance of Use approval