# SANCTUARY OF PEACE RESIDENTIAL COMMUNITY PUD DEVELOPMENT PLAN / PRELIMINARY PLAN

## PERMITTED USES AND STRUCTURES USE NOTES PRINCIPAL USES Wellings - Single Family Attached LOTS 2 - 27 WITH ATTACHED GARAGES ONLY LOT 1 - PRIVATE BUSINESS EVENT CENTER W/ FOUR GUEST ROOMS FOR OVERNIGHT PRIVATE SANCTUARY CLUBHOUSE ACCOMMODATIONS TO BE USED BY THE RESIDENTS OF "SANCTUARY OF PEACE RESIDENTIAL COMMUNITY" AND BENET HILL MONASTERY OF COLORADO SPRINGS. ECREATIONAL AMENITIES TRACTS B, C, & D - TO INCLUDE TRAILS, BENCHES, GAZEBOS, COMMUNITY GARDEN TRACTS A, B, C, & D - TO INCLUDE WATER LINES, WELLS, PUMP HOUSES, TREATMENT FACILITIES, DISTRICT UTILITIES, DETENTION PONDS CISTERNS, WASTEWATER LINES / FACILITIES, DETENTION FACILITIES AND ASSOCIATED ACCESS roads and utility lines OT 1 DETACHED GARAGE ACCESSORY USES HOUSEHOLD PETS ARE ALLOWED IN ACCORDANCE WITH THE APPROVED OR AMENDED ANIMAL KEEPING DECLARATION OF PROTECTIVE AND RESTRICTIVE COVENANTS FOR SANCTUARY OF PEACE RESIDENTIAL COMMUNITY. RESIDENTIAL HOME OFFICES ARE ALLOWED IN ACCORDANCE WITH THE APPROVED OR RESIDENTIAL HOME OFFICE AMENDED DECLARATION OF PROTECTIVE AND RESTRICTIVE COVENANTS FOR SANCTUARY OF PEACE RESIDENTIAL COMMUNITY. SOLAR COLLECTORS ARE ALLOWED IN ACCORDANCE WITH THE APPROVED OR AMENDED SOLAR COLLECTORS DECLARATION OF PROTECTIVE AND RESTRICTIVE COVENANTS FOR SANCTUARY OF PEACE **RESIDENTIAL COMMUNITY** DECK (ATTACHED, COVERED OR UNCOVERED) RETAINING WALLS ALLOWED IN SIDE AND REAR SETBACKS. FENCING IS NOT ALLOWED ON LOTS WALLS, HEDGES, RETAINING WALLS, & FENCES 2 - 27. AIL BOXES a single mail kiosk for all 27 lots. **TRASH ENCLOSURES** . ALL PERMITTED PRINCIPAL AND ACCESSORY STRUCTURES ARE SUBJECT TO THE DEVELOPMENT STANDARD OF THE SANCTUARY OF PEACE RESIDENTIAL COMMUNITY DEVELOPMENT PLAN 2. PERMITTED ACCESSORY USES ARE SUBJECT TO THE USE-SPECIFIC DEVELOPMENT STANDARD SET OUT IN CHAPTER 5.1.7 OF THE EL PASO COUNTY LAND DEVELOPMENT CODE (AS AMENDED) 3. PERMITTED TEMPORARY USES ARE SUBJECT TO THE USE-SPECIFIC DEVELOPMENT STANDARD SET OUT IN CHAPTER 5.2.1 OF THE EL PASO COUNTY LAND DEVELOPMENT CODE (AS AMENDED)

# DEVELOPMENT STANDARDS AND GUIDELINES

- MINIMUM LOT SIZE IS 3,900 SF.
- 2. MAXIMUM LOT COVERAGE SHALL BE 45%.
- 3. MAXIMUM BUILDING HEIGHT: THIRTY FIVE FEET (35').
- 4. SETBACK REQUIREMENTS (SINGLE FAMILY DWELLINGS, PRIVATE SANCTUARY CLUB HOUSE & DETACHED GARAGE):
- a. FRONT YARD: FIFTEEN FEET (15') 20 FEET MIN. DRIVEWAY LENGTH FIVE FEET (5') / ZERO FEET (0') WHERE ATTACHED b. SIDE YARD:
- c. REAR YARD: FIVE FEET (5') delete RETAINING WALLS ARE ALLOWED IN THE SIDE AND REAR SETBACKS 8.4.3.B.2.f 5. LOT NOTES: THE PUD DEVELOPMENT/PRELIMINARY PLAN AND THE PLAT ESTABLISH THE LOT SIZES FOR EACH LOT. delete: beef up line FOLLOWING INITIAL SUBDIVISION, NO VACATIONS AND REPLATS SHALL BE ALLOWED IF THESE WOULD RESULT IN THE ADDITION OF LOTS IN A MANNER NOT WORK for ER access CONSISTENT WITH THE PUD DEVELOPMENT/PRELIMINARY PLAN. MINOR ADJUSTMENTS TO LOT LINES AND TRACTS AREAS CAN BE MADE WITH THE FINAL PLATS WITHOUT REQUIRING AN AMENDMENT TO THIS PUD delete; allow loop of DEVELOPMENT/PRELIMINARY PLAN. benet hill from LANDSCAPE promise point to HWY

83; no culdesac dev 1. AREAS OF REQUIRED ROADWAY LANDSCAPING ADJACENT TO STATE HIGHWAY 83 AND THE PRIVATE BENET LANE HAVE BEEN SATISFIED BY THE EXISTING ADJACENT TO STATE HIGHWAY 83 AND THE PRIVATE BENET LANE HAVE BEEN SATISFIED BY THE EXISTING ADJACENT TO STATE HIGHWAY 83 AND THE PRIVATE BENET LANE HAVE BEEN SATISFIED BY THE EXISTING ADJACENT TO STATE HIGHWAY 83 AND THE PRIVATE BENET LANE HAVE BEEN SATISFIED BY THE EXISTING ADJACENT TO STATE HIGHWAY 83 AND THE PRIVATE BENET LANE HAVE BEEN SATISFIED BY THE EXISTING ADJACENT TO STATE HIGHWAY 83 AND THE PRIVATE BENET LANE HAVE BEEN SATISFIED BY THE EXISTING ADJACENT TO STATE HIGHWAY 83 AND THE PRIVATE BENET LANE HAVE BEEN SATISFIED BY THE EXISTING ADJACENT TO STATE HIGHWAY 83 LOCATED IN THESE LANDSCAPE BUFFER AREAS AS DEPICTED ON THE LANDSCAPE PLAN (SHEET DP-6). supported by ECM admim. ARCHITECTURAL CONTROL

ARCHITECTURAL CONTROL SHALL BE IN ACCORDANCE WITH THE APPROVED OR AMENDED DECLARATION OF PROTECTIVE AND RESTRICTIVE COVENANTS FOR SANCTUARY OF PEACE RESIDENTIAL COMMUNITY. General notes

ALL RESIDENTIAL LOTS WILL HAVE DIRECT ACCESS TO A PRIVATE ROAD OR SHALL BE CONNECTED TO A PRIVATE ROAD VIA AN ACCESS EASEMENT. THE PRIVATE ROAD AS SHOWN ON THIS PUD PRELIMINARY PLAN WILL NOT BE MAINTAINED BY EL PASO COUNTY UNTIL AND UNLESS THE STREETS ARE CONSTRUCTED IN CONFORMANCE WITH EL PASO COUNTY STANDARDS IN EFFECT AT THE DATE OF THE REQUEST FOR DEDICATION AND MAINTENANCE. ALL WATER SYSTEM ELEMENTS AND SANITARY SEWERAGE CONVEYANCE CONDUITS AND THEIR ASSOCIATED APPURTENANCES SHALL BE DEDICATED TO THE

SANCTUARY OF PEACE HOME OWNERS ASSOCIATION. ALL OTHER UTILITIES SHALL BE OWNED AS APPROPRIATED. 3. ALL ELECTRIC SERVICE SHALL BE PROVIDED BY MOUNTAIN VIEW ELECTRIC ASSOCIATION. ALL TRACTS THROUGH WHICH MVEA UTILITIES WILL BE LOCATED WILL BE

GIVEN UTILITY EASEMENTS AS REQUIRED MVEA. STREET LIGHTS WILL BE RESTRICTED TO MOUNTAIN VIEW ELECTRIC ASSOCIATIONS DETAILS AND SPECIFICATIONS. 4. ALL NATURAL GAS SERVICE SHALL BE PROVIDED BY BLACK HILLS ENERGY. ALL TRACTS THROUGH WHICH BLACK HILLS ENERGY UTILITIES WILL BE LOCATED WILL BE GIVEN UTILITY FASEMENTS AS REQUIRED.

5. PUBLIC UTILITY/ DRAINAGE EASEMENTS SHALL BE PROVIDED ON ALL LOTS AND TRACTS AS FOLLOWS: a. FRONT: TEN FEET (10')

SIDE: FIVE FEET (5') - RETAINING WALLS FROM 0'-6' IN HEIGHT ALLOWED IN EASEMENT REAR: TEN FEET (5') - RETAINING WALLS FROM 0'-6' IN HEIGHT ALLOWED IN EASEMENT

6. AN EASEMENT OVER AND ACROSS THE ENTIRETY OF TRACTS A, B, C & D SHALL BE GRANTED TO THE SANCTUARY OF PEACE HOME OWNERS ASSOCIATION FOR UNLIMITED ACCESS AND USE TO CONSTRUCT AND MAINTAIN THE PRIVATE ROADWAY, OPEN SPACE, RETAINING WALLS, LANDSCAPE, TRAILS, SIGNAGE, PARKING IN DESIGNATED AREAS, DRIVEWAYS, MAILBOXES, WATER AND WASTEWATER SYSTEMS, OR OTHER AMENITIES AS DESIRED BY THE SANCTUARY OF PEACE HOME OWNERS ASSOCIATION.

7. THE DEVELOPMENT HAS BEEN DESIGNED TO LIMIT THE NUMBER OF BEDROOMS THAT COULD BE SERVED ON FOUR SEPARATE ONSITE WATER TREATMENT SYSTEM (OWTS) ON 59.58 ACRES. THE SYSTEMS WERE DESIGNED FOR THIS PURPOSE IN COORDINATION WITH STATE AND COUNTY HEALTH DEPARTMENT STAFF AND UNDER THE GUIDANCE OF THE STATE WATER QUALITY SITE APPLICATION POLICY 6. THE SYSTEMS CAN SERVE UP TO 40 BEDROOMS. THE PLAN PROPOSES FOURTEEN (14) ONE BEDROOM, TWELVE (12) IWO BEDROOM SINGLE STORY RESIDENCES, AND ONE (1) PRIVATE SANCTUARY CLUB HOUSE HAVING FOUR (4) GUEST BEDROOMS TAKEN AT THE HOTEL/MOTEL OCCUPANCY RATE OF ONE HALF BEDROOM PER ROOM. THE DEVELOPMENT AREA HAS BEEN CLUSTERED WITH CONSIDERATION GIVEN TO WHAT THE SITING THE SYSTEMS WHERE TO AVOID IMPACTS TO ADJACENT PROPERTIES. THE OWTS SYSTEMS EXTERIOR OF ANY BUILDING SHALL BE OWNED AND MAINTAINED BY THE SANCTUARY OF PEACE HOME OWNERS ASSOCIATION

8. THE BENET HILL MONASTERY OF COLORADO SPRINGS IS RESPONSIBLE FOR MAINTAINING PROPER STORM WATER DRAINAGE IN AND THROUGHOUT ALL OTS AND TRACTS. PUBLIC DRAINAGE EASEMENTS AS SPECIFICALLY NOTED ON THE PLAT SHALL BE MAINTAINED BY BENET HILL MONASTERY OF COLORADO SPRINGS UNLESS OTHERWISE INDICATED. STRUCTURES, FENCES, MATERIALS OR LANDSCAPING THAT COULD IMPEDE THE FLOW OF RUNOFF SHALL NOT BE PLACED IN DRAINAGE EASEMENTS.

9. DEVELOPER SHALL COMPLY WITH FEDERAL AND STATE LAWS, REGULATIONS, ORDINANCES, REVIEW AND PERMIT REQUIREMENTS, AND OTHER AGENCY REQUIREMENTS, IF ANY, OF APPLICABLE AGENCIES INCLUDING, BUT NOT LIMITED TO, THE COLORADO DIVISION OF WILDLIFE, COLORADO DEPARTMENT OF TRANSPORTATION, U.S. ARMY CORPS OF ENGINEERS AND THE U.S. FISH AND WILDLIFE SERVICE REGARDING THE ENDANGERED SPECIES ACT, PARTICULARLY AS IT RELATES TO THE LISTED SPECIES (E.G., PREBLE'S MEADOW JUMPING MOUSE).

10. THE FOLLOWING REPORTS HAVE BEEN SUBMITTED IN ASSOCIATION WITH THE PRELIMINARY PLAN FOR THIS SUBDIVISION AND ARE ON FILE AT THE COUNTY DEVELOPMENT SERVICES DEPARTMENT: TRANSPORTATION MEMORANDUM; DRAINAGE REPORT; WATER RESOURCES REPORT; ONSITE WASTEWATER TREATMENT SYSTEM (OWTS) EVALUATION: GEOLOGY & SOILS REPORT: FIRE PROTECTION REPORT: WILDFIRE HAZARD REPORT: NATURAL FEATURES REPORT.

11. A DRIVEWAY PERMIT SHALL BE ISSUED BY EL PASO COUNTY DEVELOPMENT SERVICES PRIOR TO THE ESTABLISHMENT OF ANY DRIVEWAY.

12. MAILBOXES SHALL BE INSTALLED IN ACCORDANCE WITH ALL EL PASO COUNTY AND UNITED STATES POSTAL SERVICE REGULATIONS.

LOCATED IN THE THE SOUTH HALF OF SECTION 27, TOWNSHIP 11 SOUTH, RANGE 66 WEST OF THE 6TH P.M., EL PASO COUNTY, COLORADO

# GENERAL PROVISIONS

STATEMENT OF PURPOSE: SANCTUARY OF PEACE RESIDENTIAL COMMUNITY PUD IS INTENDED TO ACCOMMODATE CLUSTER DEVELOPMENT THAT PROMOTES OPEN SPACE PRESERVATION, REDUCED AUTOMOBILE DEPENDENCE WITH 1-2 BEDROOM SINGLE STORY ATTACHED UNITS. THE OWNER'S EXPRESSED INTENT IS TO MAINTAIN THE NATURAL AND NATIVE BEAUTY AND CHARACTERISTICS OF THE OPEN SPACE TRACTS, PROHIBITING THE CONSTRUCTION OF PERMANENT STRUCTURES THEREON, AND UTILIZING SUSTAINABLE AND FIRE WISE LAND MANAGEMENT ON THE LOTS AND OPEN SPACE TRACTS. HOWEVER, NOTWITHSTANDING THE FOREGOING, CERTAIN PORTIONS OF THE OPEN SPACE TRACTS SHALL BE AND ARE INTENDED TO BE UTILIZED FOR CONSTRUCTION OF A CENTRAL WATER SYSTEMS/WELLS/WELL FIELDS AND WASTEWATER TREATMENT SYSTEMS. NO FURTHER SUBDIVISION LAND USE APPLICATIONS AND APPROVALS IN ACCORDANCE WITH THE PROVISIONS OF THE OF EL PASO COUNTY LAND DEVELOPMENT CODE.

## AUTHORITY: THIS PUD IS AUTHORIZED BY CHAPTER 4 OF THE EL PASO COUNTY LAND DEVELOPMENT CODE, AS AMENDED, ADOPTED PURSUANT TO THE COLORADO PLANNED UNIT DEVELOPMENT ACT OF 1972, AS AMENDED.

APPLICABILITY: THE PROVISIONS OF THIS PUD SHALL RUN WITH THE LAND. THE LANDOWNER, THEIR SUCCESSORS, HEIRS, ON ASSIGNS SHALL BE BOUND BY THIS DEVELOPMENT PLAN, OR AS OTHERWISE AMENDED BY AND APPROVED BY THE PLANNING AND COMMUNITY DEVELOPMENT DEPARTMENT DIRECTOR OR BOARD OF COUNTY COMMISSIONERS.

ADOPTION: THE ADOPTION OF THIS DEVELOPMENT PLAN SHALL EVIDENCE THE FINDINGS AND DECISIONS OF THE EL PASO COUNTY BOARD OF COUNTY COMMISSIONERS THAT THIS DEVELOPMENT FOR SANCTUARY OF PEACE RESIDENTIAL COMMUNITY IS IN GENERAL CONFORMITY WITH THE EL PASO COUNTY MASTER PLAN, EL PASO COUNTY POLICY PLAN AND APPLICABLE SMALL AREA PLAN(S); IS AUTHORIZED UNDER THE PROVISION OF THE EL PASO COUNTY LAND DEVELOPMENT CODE, AS AMENDED; AND THIS DEVELOPMENT PLAN COMPLIES WITH THE COLORADO WITH THE COLORADO PLANNED UNIT DEVELOP ACT OF 1972, AS AMENDED.

RELATIONSHIP TO THE COUNTY REGULATIONS: THE PROVISIONS OF THIS DEVELOPMENT PLAN SHALL PREVAIL AND GOVERN THE DEVELOPMENT PLAN OF SANCTUARY OF PEACE RESIDENTIAL COMMUNITY PROVIDED, HOWEVER, THAT WERE THE PROVISIONS OF THIS DEVELOPMENT PLAN DO NOT ADDRESS A PARTICULAR SUBJECT, THE RELEVANT PROVISIONS OF THE EL PASO COUNTY LAND DEVELOPMENT CODE. AS AMENDED AND IN EFFECT AT THE TIME OF THE PUD PLAN APPROVAL (OR OWNER ACKNOWLEDGE THE PUD CHANGES WITH THE CODE), OR ANY OTHER APPLICABLE RESOLUTIONS OR REGULATIONS OF EL PASO COUNTY ,SHALL BE APPLICABLE.

ENFORCEMENT: TO FURTHER THE MUTUAL INTEREST OF THE RESIDENTS, OCCUPANTS, AND OWNERS OF THE PUD AND OF THE PUBLIC IN THE PRESERVATIONS OF THE INTEGRITY OF THIS DEVELOPMENT PLAN, THE PROVISIONS OF THIS PLAN RELATING TO THE USE LAND AND THE LOCATION OF COMMON OPEN SPACE SHALL RUN IN FAVOR OF EL PASO COUNTY AND SHALL BE ENFORCEABLE AT LAW OR IN EQUITY BY THE COUNTY WITHOUT LIMITATIONS ON ANY POWER OR REGULATION OTHERWISE GRANTED BY LAW.

CONFLICT: WHERE THERE IS MORE THAN ONE PROVISION WITHIN THE DEVELOPMENT PLAN WHICH GOVERNS THE SAME SUBJECT MATTER, THE PROVISION WHICH IS MOST RESTRICTIVE OR IMPOSES HIGHER STANDARDS OR REQUIREMENTS SHALL GOVERN.

# STREETS

TRACT NOTES

THE EL PASO COUNTY STREET STANDARDS ARE EXEMPT AS MODIFIED BY THIS PUD DEVELOPMENT PLAN AND SHALL BE OWNED AND MAINTAINED BY SANCTUARY OF PEACE HOME OWNERS ASSOCIATION.

2. STREETS WITHIN THIS DEVELOPMENT PROVIDE FOR LEVELS OF VEHICULAR CIRCULATION REQUIRED BY THE TRAFFIC STUDY.

3. THERE ARE NO NOISE WALLS REQUIRED ALONG STATE HIGHWAY 83.

## 4. THERE SHALL BE NO DIRECT VEHICULAR ACCESS TO STATE HIGHWAY 83 ADD ER ACCESS ROUTE IS TO BENET LANE, OT FOOLS GOLD AND OUT TO x, Y, z. A EASMENT HAS BEEN RECORED AT

TRACT A (30,089 SF. / 0.691 AC.) SHALL BE FOR PRIVATE ROADWAY AND SHALL BE OWNED BY BENET HILL MONASTERY OF COLORADO SPRINGS AND MAINTAINED BY THE SANCTUARY OF PEACE HOME OWNERS ASSOCIATION.

TRACT B (153,122 SF. / 3.515 AC.), TRACT C (22,909 SF. / 0.526 AC.) & TRACT D (1,819,053 SF. / 41.760 AC.) SHALL BE FOR OPEN SPACE, RETAINING WALLS, LANDSCAPE, TRAILS, SIGNAGE, PARKING IN DESIGNATED AREAS, DRIVEWAYS, AND MAILBOXES, AND SHALL BE OWNED BY BENET HILL MONASTERY OF COLORADO SPRINGS AND MAINTAINED BY THE SANCTUARY OF PEACE HOME OWNERS ASSOCIATION. WATER AND WASTEWATER SYSTEMS EXTERIOR OF ANY BUILDING SHALL BE OWNED AND MAINTAINED BY THE THE SANCTUARY OF PEACE HOME OWNERS ASSOCIATION.

STORMWATER FACILITIES EXTERIOR OF ANY BUILDING SHALL BE OWNED AND MAINTAINED BY BENET HILL MONASTERY OF COLORADO SPRINGS. AN EASEMENT WILL BE GRANTED BY THE BENET HILL MONASTERY OF COLORADO SPRINGS FOR THE BENEFIT OF THE SANCTUARY OF PEACE HOME OWNERS ASSOCIATION ON, OVER, UNDER AND ACROSS FOR THE ENTIRETY OF EACH TRACT FOR THE OWNERSHIP AND MAINTENANCE OF THE WASTEWATER SYSTEMS. SAID EASEMENT WILL BE ESTABLISHED AT TIME OF FINAL PLAT.

# PUD MODIFICATIONS

	LDC / ECM SECTION	CATEGORY	STANDARD	MODIFICATION	JUSTIFICATION
				PRIVATE ROADS & DRIVEWAY	
	> LD C OF HOLC		JU WIIN. LIVE	ACCESS EASEMENTS	
2	LDC 8.4.3.€.2.f	lot design	LOTS W/OWTS REQUIRE 2.5 ACRES	CLUSTERED LOTS SURROUNDED BY LARGER TRACTS FOR OWTS	
3	LDC 8.4.4.C	TRANSPORTATION SYSTEM	PUBLIC ROADS REQUIRED	USE PRIVATE RD CONNECTING TO EXIST. PRIVATE BENET LN.	
<u>⁄</u> 4		SYSTEM	MORE THAN 25 LOTS	USE NEW EMERGENCY-ONLY ACCESS TO FOOLS GOLD DR.	PROVIDE A UNIQUELY INTIMATE CLUSTERED LOT DEVELOPMENT THAT COMPLEMENTS THE
5	LDC 8.4.4.E	TRANSPORTATION SYSTEM	PRIVATE ROADS TO MEET COUNTY STDS	REDUCE ROADWAY WIDTH & MODIFY DESIGN CRITERIA	EXISTING BENET LANE
6	LDC 8.4.8.C.2	WASTEWATER DISPOSAL	two potential owts sites required On plan	PROVIDE ONE SET OF FULLY ENGINEERED OWTS SITES	PRESERVING SIGNIFICANT OPEN SPACE TAKING CONSIDERATION
7	ECM 2.3.8A →	CUL-DE-SACS	MAX. LENGTH OF RURAL DEAD END ROAD IS 1600 FT	PROVIDE EMERGENCY-ONLY ACCESS	OF THE NATURAL TERRAIN AND FEATURES TO PROMOTE PRESERVATION AND
8	ECM 2.3.1	roadway design	DESIGN SPEED	REDUCE DESIGN SPEED TO 20 MPH FOR PRIVATE ROADWAY	ENJOYMENT OF THE FORESTED AREA COMPRISING THE SITE.
9	ECM 2.3.1	ROADWAY DESIGN	RIGHT-OF-WAY WIDTH	PROVIDE 28 FT PRIVATE TRACT WIDTH FOR ROADWAY & SIDEWALK	THE PROPOSED FACILITIES ARE ADEQUATE TO SERVE THE DEVELOPMENT AND ARE NOT
10	ECM 2.3.1	ROADWAY DESIGN	MIN. CURVE RADIUS	REDUCE CURVE RADIUS APPROPRIATE WITH DESIGN SPEED	ADVERSE TO THE HEALTH, SAFETY AND WELFARE OF THE RESIDENTS OR PUBLIC.
11	ECM 2.3.1	ROADWAY DESIGN	MIN. LANE WIDTH	USE 10 FT LANE WIDTHS MATCHING EXISTING BENET LN	
12	ECM 2.5.2.B.3	PEDESTRIAN FACILITIES	SIDEWALK REQUIRED ON BOTH SIDES OF ROADWAY	PROVIDE SIDEWALK ON ONE SIDE OF THE PRIVATE RD	
13	ECM 2.5.2.B.6	PEDESTRIAN FACILITIES	SIDEWALK REQUIRED TO 5" THICK CONCRETE	PROVIDE ASPHALT SIDEWALK ADJACENT TO ASPHALT ROADWAY	

# FLOODPLAIN STATEMENT

NO PORTION OF THE SUBJECT PROPERTY IS LOCATED WITHIN FEMA DESIGNATED SPECIAL FLOOD HAZARD AREA (SFHA'S) AS INDICATED ON THE FLOOD INSURANCE RATE MAP (FIRM) FOR EL PASO COUNTY, COLORADO AND INCORPORATED AREAS - MAP NUMBER 08041C0295G, EFFECTIVE DECEMBER 7, 2018.

# SOIL & GEOLOGY CONDITIONS

GEOLOGIC HAZARD NOTE: LOTS 1 THRU 27, TRACTS A, B, C, & D HAVE BEEN FOUND TO BE IMPACTED BY GEOLOGIC HAZARDS MITIGATION MEASURES AND A MAP OF THE HAZARD AREAS CAN BE FOUND IN THE SOIL, GEOLOGY AND GEOLOGIC HAZARD STUDY FOR SANCTUARY OF PEACE FILING NO. 1 PREPARED BY ENTECH ENGINEERING, FEBRUARY 11, 2019, JOB NO. 190118, IN THE SANCTUARY OF PEACE RESIDENTIAL COMMUNITY FILE (PUDSP-19-002) AVAILABLE AT THE EL PASO COUNTY PLANNING AND COMMUNITY DEVELOPMENT

## DEPARTMENT - EXPANSIVE SOILS (LOTS 1 THRU 27, TRACTS A, B, C, & D)

- POTENTIALLY SEASONAL SHALLOW GROUND WATER (LOTS 1 THRU 27, TRACTS A, B, C, & D) - POTENTIALLY UNSTABLE SLOPE (TRACT D & LOT 2)

# LAND USE TABLE

USE	SQUARE FEET	ACRES	PERCENTAGE	OWNER	MAINTENANCE
26 RESIDENTIAL LOTS (LOTS 2-27)	118,794 SF	2.73 AC	5.50%	Individual lot owners	
1 PRIVATE SANCTUARY CLUBHOUSE LOT (LOT 1) 1 PRIVATE ROADWAY (TRACT A)	15,593 SF 30,089 SF	0.36 AC 0.69 AC	0.72% 1.39%	BENET HILL MONASTERY BENET HILL MONASTERY	HOA HOA
3 OPEN SPACE/LANDSCAPE/UTILITIES/DRAINAGE		0.07 AC	1.37/0	DEINET HILL MONASTERT	ПОА
(TRACTS B, C & D)	1,995,084 SF	45.93 AC	92.39%	BENET HILL MONASTERY	HOA
TOTAL AREA	2,159,560 SF	9.58 AC	100.00%		
LAND USE	SITE DATA	TABLE	-		
RESIDENTIAL RURAL (RR-5)	OTAL SITE ACREAGE PROPOSED SINGLE-FA PROPOSED GROSS RE			ED	49.58 AC 26 D.U 0.52 D.U./AC
	PROPOSED PRIVATE SA PROPOSED GROSS CO		•	TE BUSINESS EVENT CENTER)	1 UNIT 0.02 UNITS/AC
	OTAL DENSITY (27 D.I	J. / 49.58 AC.	)		0.55 UNITS/AC

## OWNER BENET HILL MONASTERY OF COLORADO SPRINGS 3190 BENET LANE

COLORADO SPRINGS CO 80921-1509 CONSULTANT/ENGINEER

M.V.E., INC. 1903 LELARAY STREET, SUITE 200 COLORADO SPRINGS, CO 80909 (719) 635-5736

# SURVEYOR

POLARIS SURVEYING, INC. 1903 LELARAY STREET, SUITE 102 COLORADO SPRINGS, CO 80909 (719) 448-0844

# LEGAL DESCRIPTION

COUNTY, COLORADO MORE PARTICULARLY DESCRIBED AS FOLLOWS:

BEGINNING AT A POINT ON THE
THENCE N 89°50'41" W, 1128.12 F
THENCE N 89°30'57" W, 322.69 FE
THENCE N 89°33'46" W, 329.97 FE
THENCE \$ 89°47'37" W, 671.98 FE
THENCE N 89°36'01" W, 988.45 FE
THENCE \$ 00°02'48" E, 200.41 FEE
THENCE \$ 89°59'47" W, 300.12 FE
THENCE N 00°06'48" W, 201.90 FE
THENCE N 89°42'15" W, 30.00 FEE
THENCE N 00°06'25" E, 208.79 FEE
THENCE N 00°06'28" E, 199.97 FEE
THENCE N 00°29'25" W, 251.26 FE
THENCE \$ 88°29'37" E, 573.94 FEE
THENCE N 89°04'04'' E, 84.80 FEET
THENCE \$ 89°53'38" E, 630.57 FEE
THENCE \$ 89°55'15" E, 605.10 FEE
THENCE \$ 89°54'25" E, 742.84 FEE
THENCE \$ 00°10'16" E, 331.15 FEE
THENCE \$ 89°54'49" E, 1197.11 FE
THENCE \$ 07°22'10" W, 171.45 FE
THENCE 134.02 FEET ALONG SAID
CHORD BEARS \$13°41'34"W, 133.
THENCE \$ 19°38'03" W, 25.12 FEE

# LAND OWNERS CERTIFICATION

\_\_\_\_\_ DAY OF \_\_\_\_\_

## BENET HILL MONASTERY OF COLORADO SPRINGS AUTHORIZED AGENT, MANAGER

STATE OF COLORADO ) EL PASO COUNTY )

THE ABOVE AND FOREGOING STATEMENT WAS ACKNOWLEDGED BEFORE ME THIS \_\_\_\_\_ DAY OF \_\_\_\_\_ 2020 A.D. BY

## NOTARY PUBLIC

# OWNERSHIP CERTIFICATION

APPLICATION

STATE OF COLORADO ) ) SS EL PASO COUNTY )

THE ABOVE AND FOREGOING STATEMENT WAS ACKNOWLEDGED BEFORE ME THIS \_\_\_\_\_ DAY OF \_\_\_\_\_ 2020 A.D. BY \_ WITNESS MY HAND AND SEAL:

# NOTARY PUBLIC

THIS REZONING REQUEST TO PUD HAS BEEN REVIEWED AND FOUND TO BE COMPLETE AND IN ACCORDANCE WITH THE (BOARD RESOLUTION \_ APPROVING THE PUD AND ALL APPLICABLE EL PASO COUNTY REGULATIONS \_\_\_AND DATE\_\_\_\_\_

PRESIDENT, BOARD OF COUNTY COMMISSIONERS

DIRECTOR, PLANNING AND COMMUNITY DEVELOPMENT DEPARTMENT

# CLERK & RECORDER

STATE OF COLORADO ) EL PASO COUNTY ) RECORDED AT RECEPTION NO.

EL PASO COUNTY CLERK AND RECORDER

# SHEET INDEX:

DP-1	COVER SHEET
DP-2	PUD DEVELOPMENT SITE PLAN (OVERALL)
DP-3	PUD DEVELOPMENT SITE PLAN (DETAIL)
DP-4	PRELIMINARY GRADING / UTILITIES PLAN
DP-5	LANDSCAPE PLAN
DP-6	GENERAL SITE DETAILS

CONSTRUCTION SCHEDULE

START: FALL 2019

FINISH: SPRING 2020

# SITE DATA

TAX SCHEDULE NO. 6127000063 Property addres 15760 COLORADO HIGHWAY 83

A TRACT OF LAND LOCATED IN THE THE SOUTH HALF OF SECTION 27, TOWNSHIP 11 SOUTH, RANGE 66 WEST OF THE 6TH PRINCIPAL MERIDIAN, EL PASO

EWEST LINE OF COLORADO HIGHWAY 83;

EET TO A NON-TANGENT CURVE TO THE RIGHT: D CURVE CONVEX TO THE WEST, HAVING A RADIUS OF 1382.50 FEET, A CENTRAL ANGLE OF 5°33'15", AND WHOSE LONG .96 FEET TO A POINT NON-TANGENT; ET TO THE **POINT OF BEGINNING** 

CONTAINING A CALCULATED AREA OF 49.58± ACRES (2,159,785.± SF) MORE OR LESS

IN WITNESS WHEREOF: THE AFOREMENTIONED BENET HILL MONASTERY AS NOMINEE HAS EXECUTED THESE PRESENTS THIS

2020 A.D

) SS

\_\_\_ WITNESS MY HAND AND SEAL:

MY COMMISSION EXPIRES:


I/WE A (ONE OF THE FOLLOWING: QUALIFIED TITLE INSURANCE COMPANY, TITLE COMPANY, TITLE ATTORNEY, OR ATTORNEY AT LAW) DULY QUALIFIED, INSURED, OR LICENSED BY THE SATE OF COLORADO, DO HEREBY CERTIFY THAT I/WE HAVE EXAMINED THE TITLE OF ALL LANDS DEPICTED AND DESCRIBED HEREON AND THAT TITLE TO SUCH LAND IS OWNER IN FEE SIMPLE BY BENET HILL MONASTERY AT THE SAME TIME OF THIS

MY COMMISSION EXPIRES:

# COUNTY CERTIFICATION

I HEREBY CERTIFY THAT THIS PLAN WAS FILED IN MY OFFICE ON THIS OF \_\_\_\_\_, 2020 AT \_\_\_\_\_O'CLOCK A.M./P.M. AND WAS DULY

PUDSP-19-002

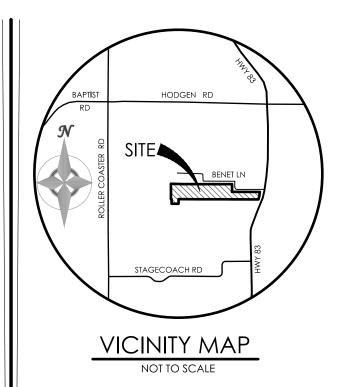

BENCHMARK



revisions

DESIGNED BY DRAWN BY CHECKED BY AS-BUILTS BY CHECKED BY

DEVELOPMENT PLAN COVER SHEET

SANCTUARY OF PEACE RESIDENTIA




MVE DRAWING


DECEMBER 16


# PUD DEVELOPMENT PLAN / PRELIMINARY PLAN

EL PASO COUNTY, COLORADO

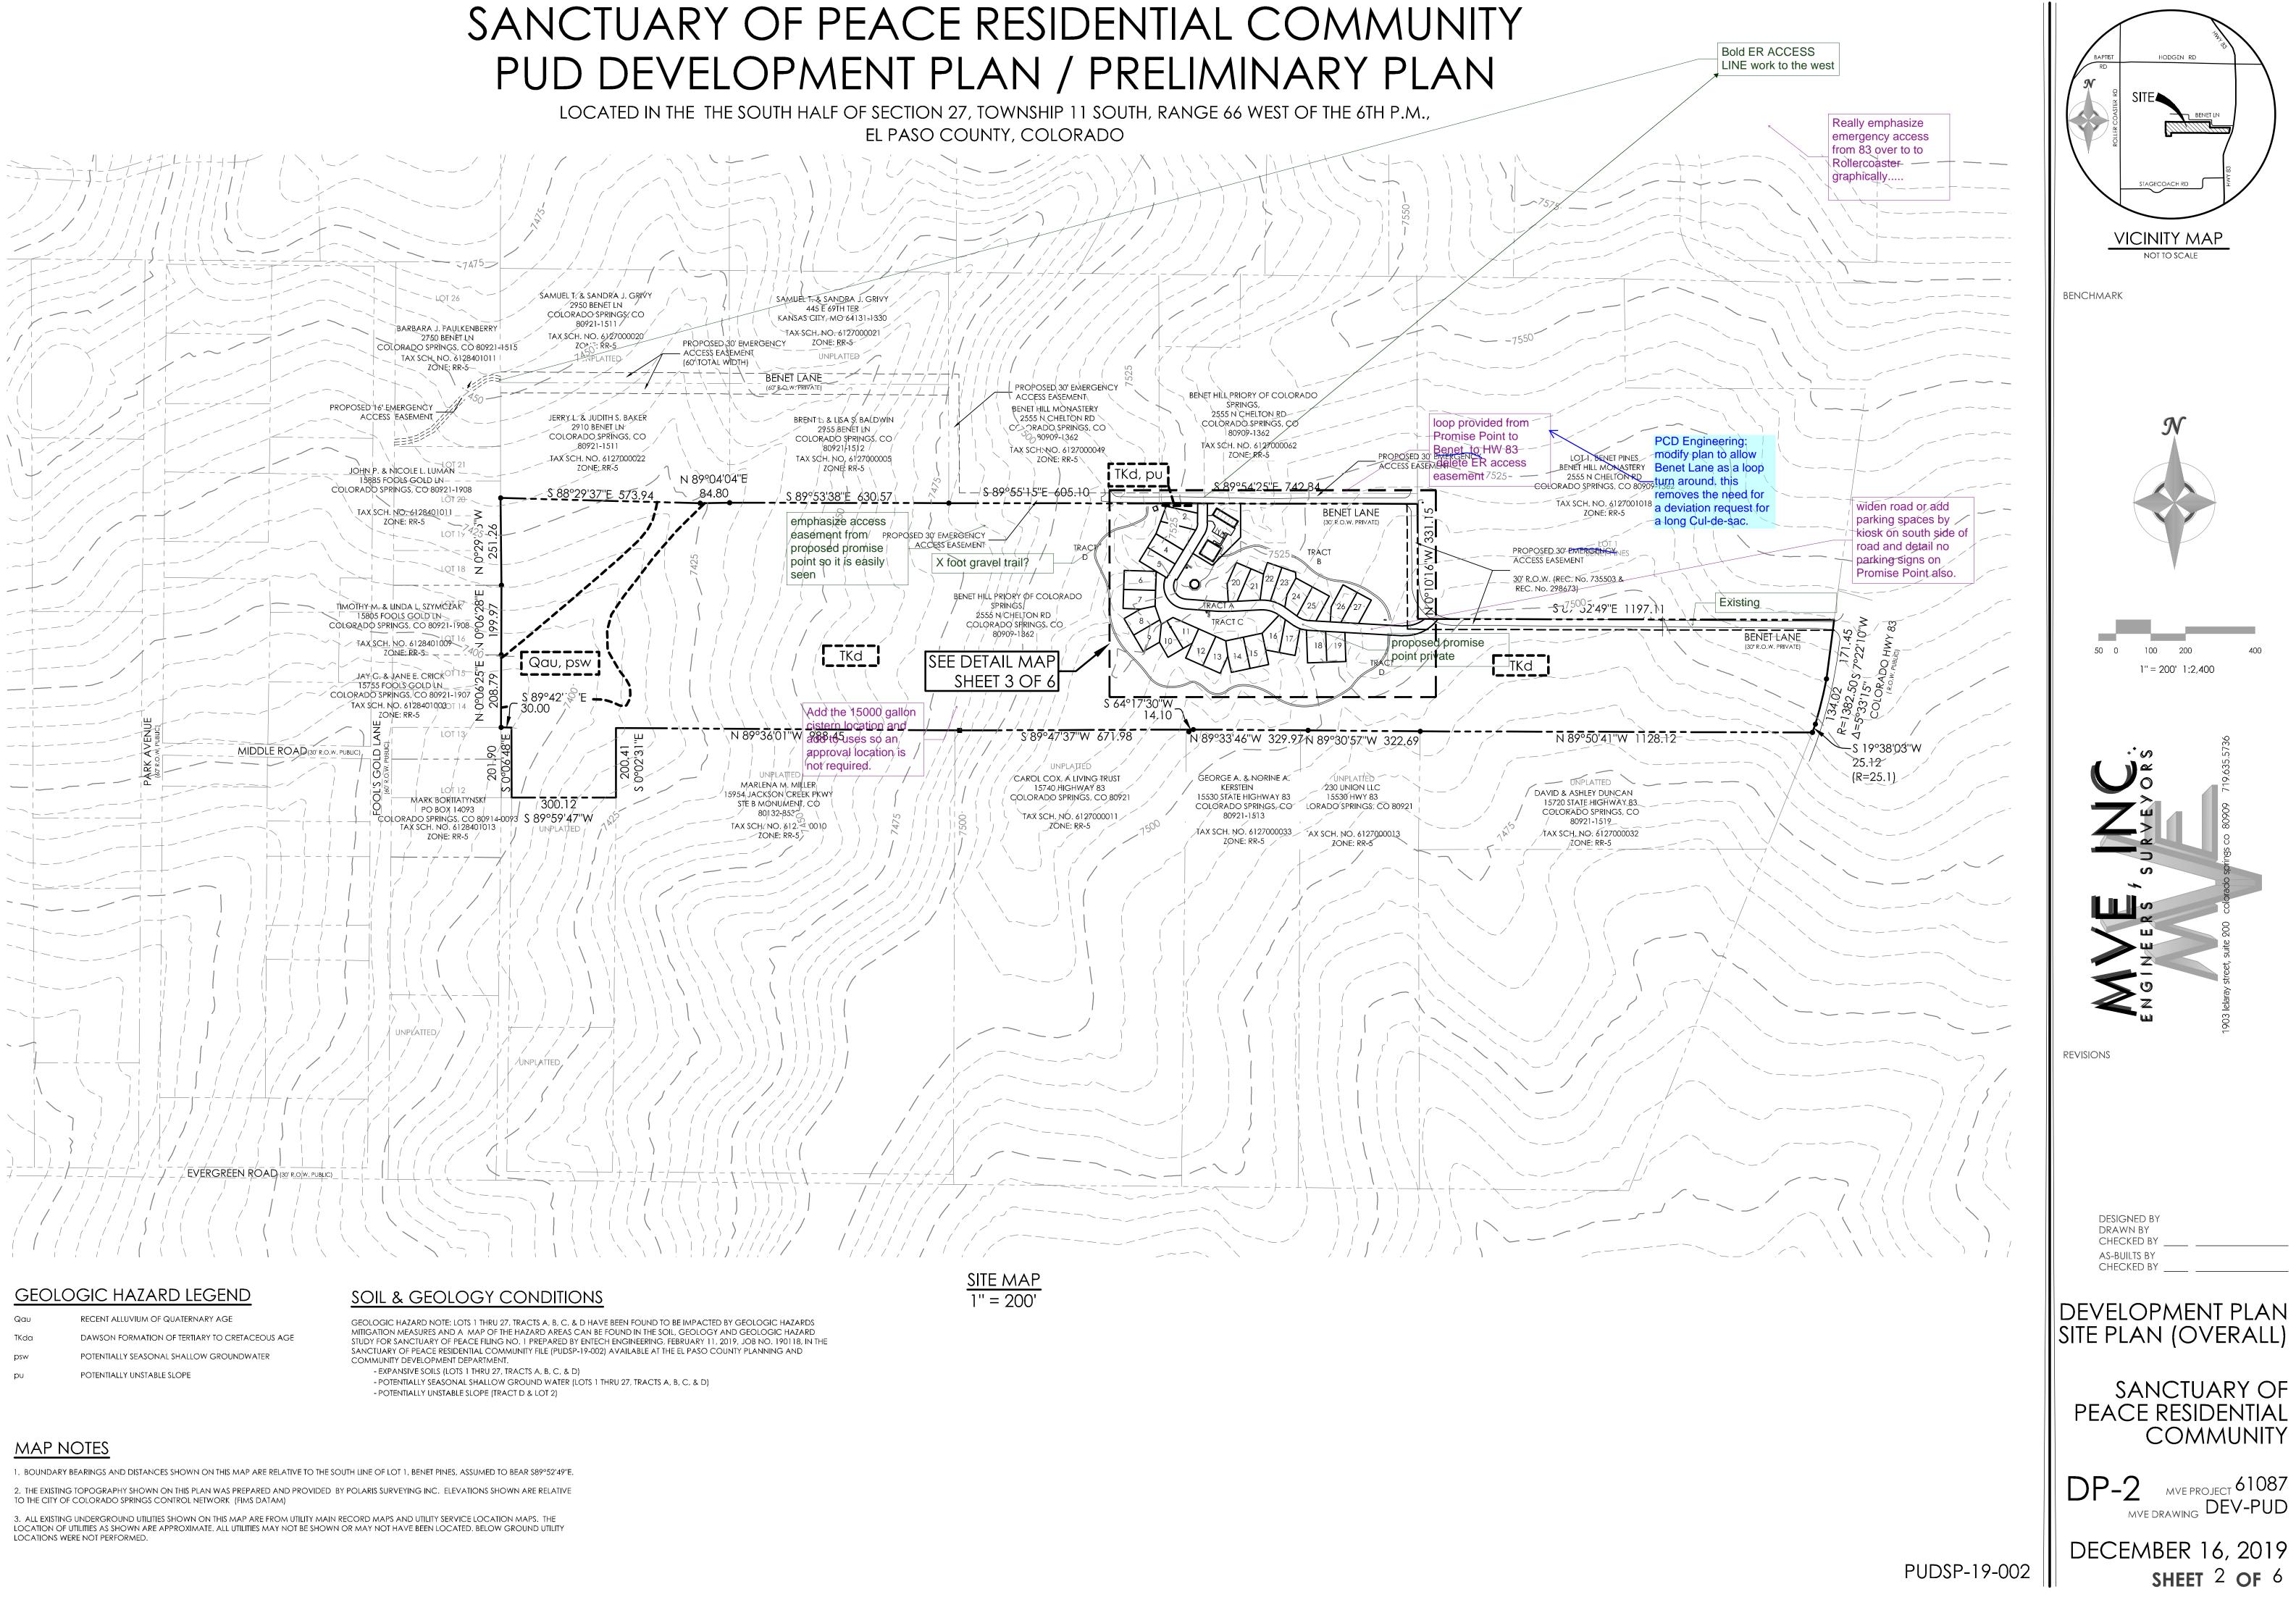


Qau	RECENT ALLUVIUM OF QUATERNARY AGE
TKda	DAWSON FORMATION OF TERTIARY TO CRETACEO
psw	POTENTIALLY SEASONAL SHALLOW GROUNDWATER

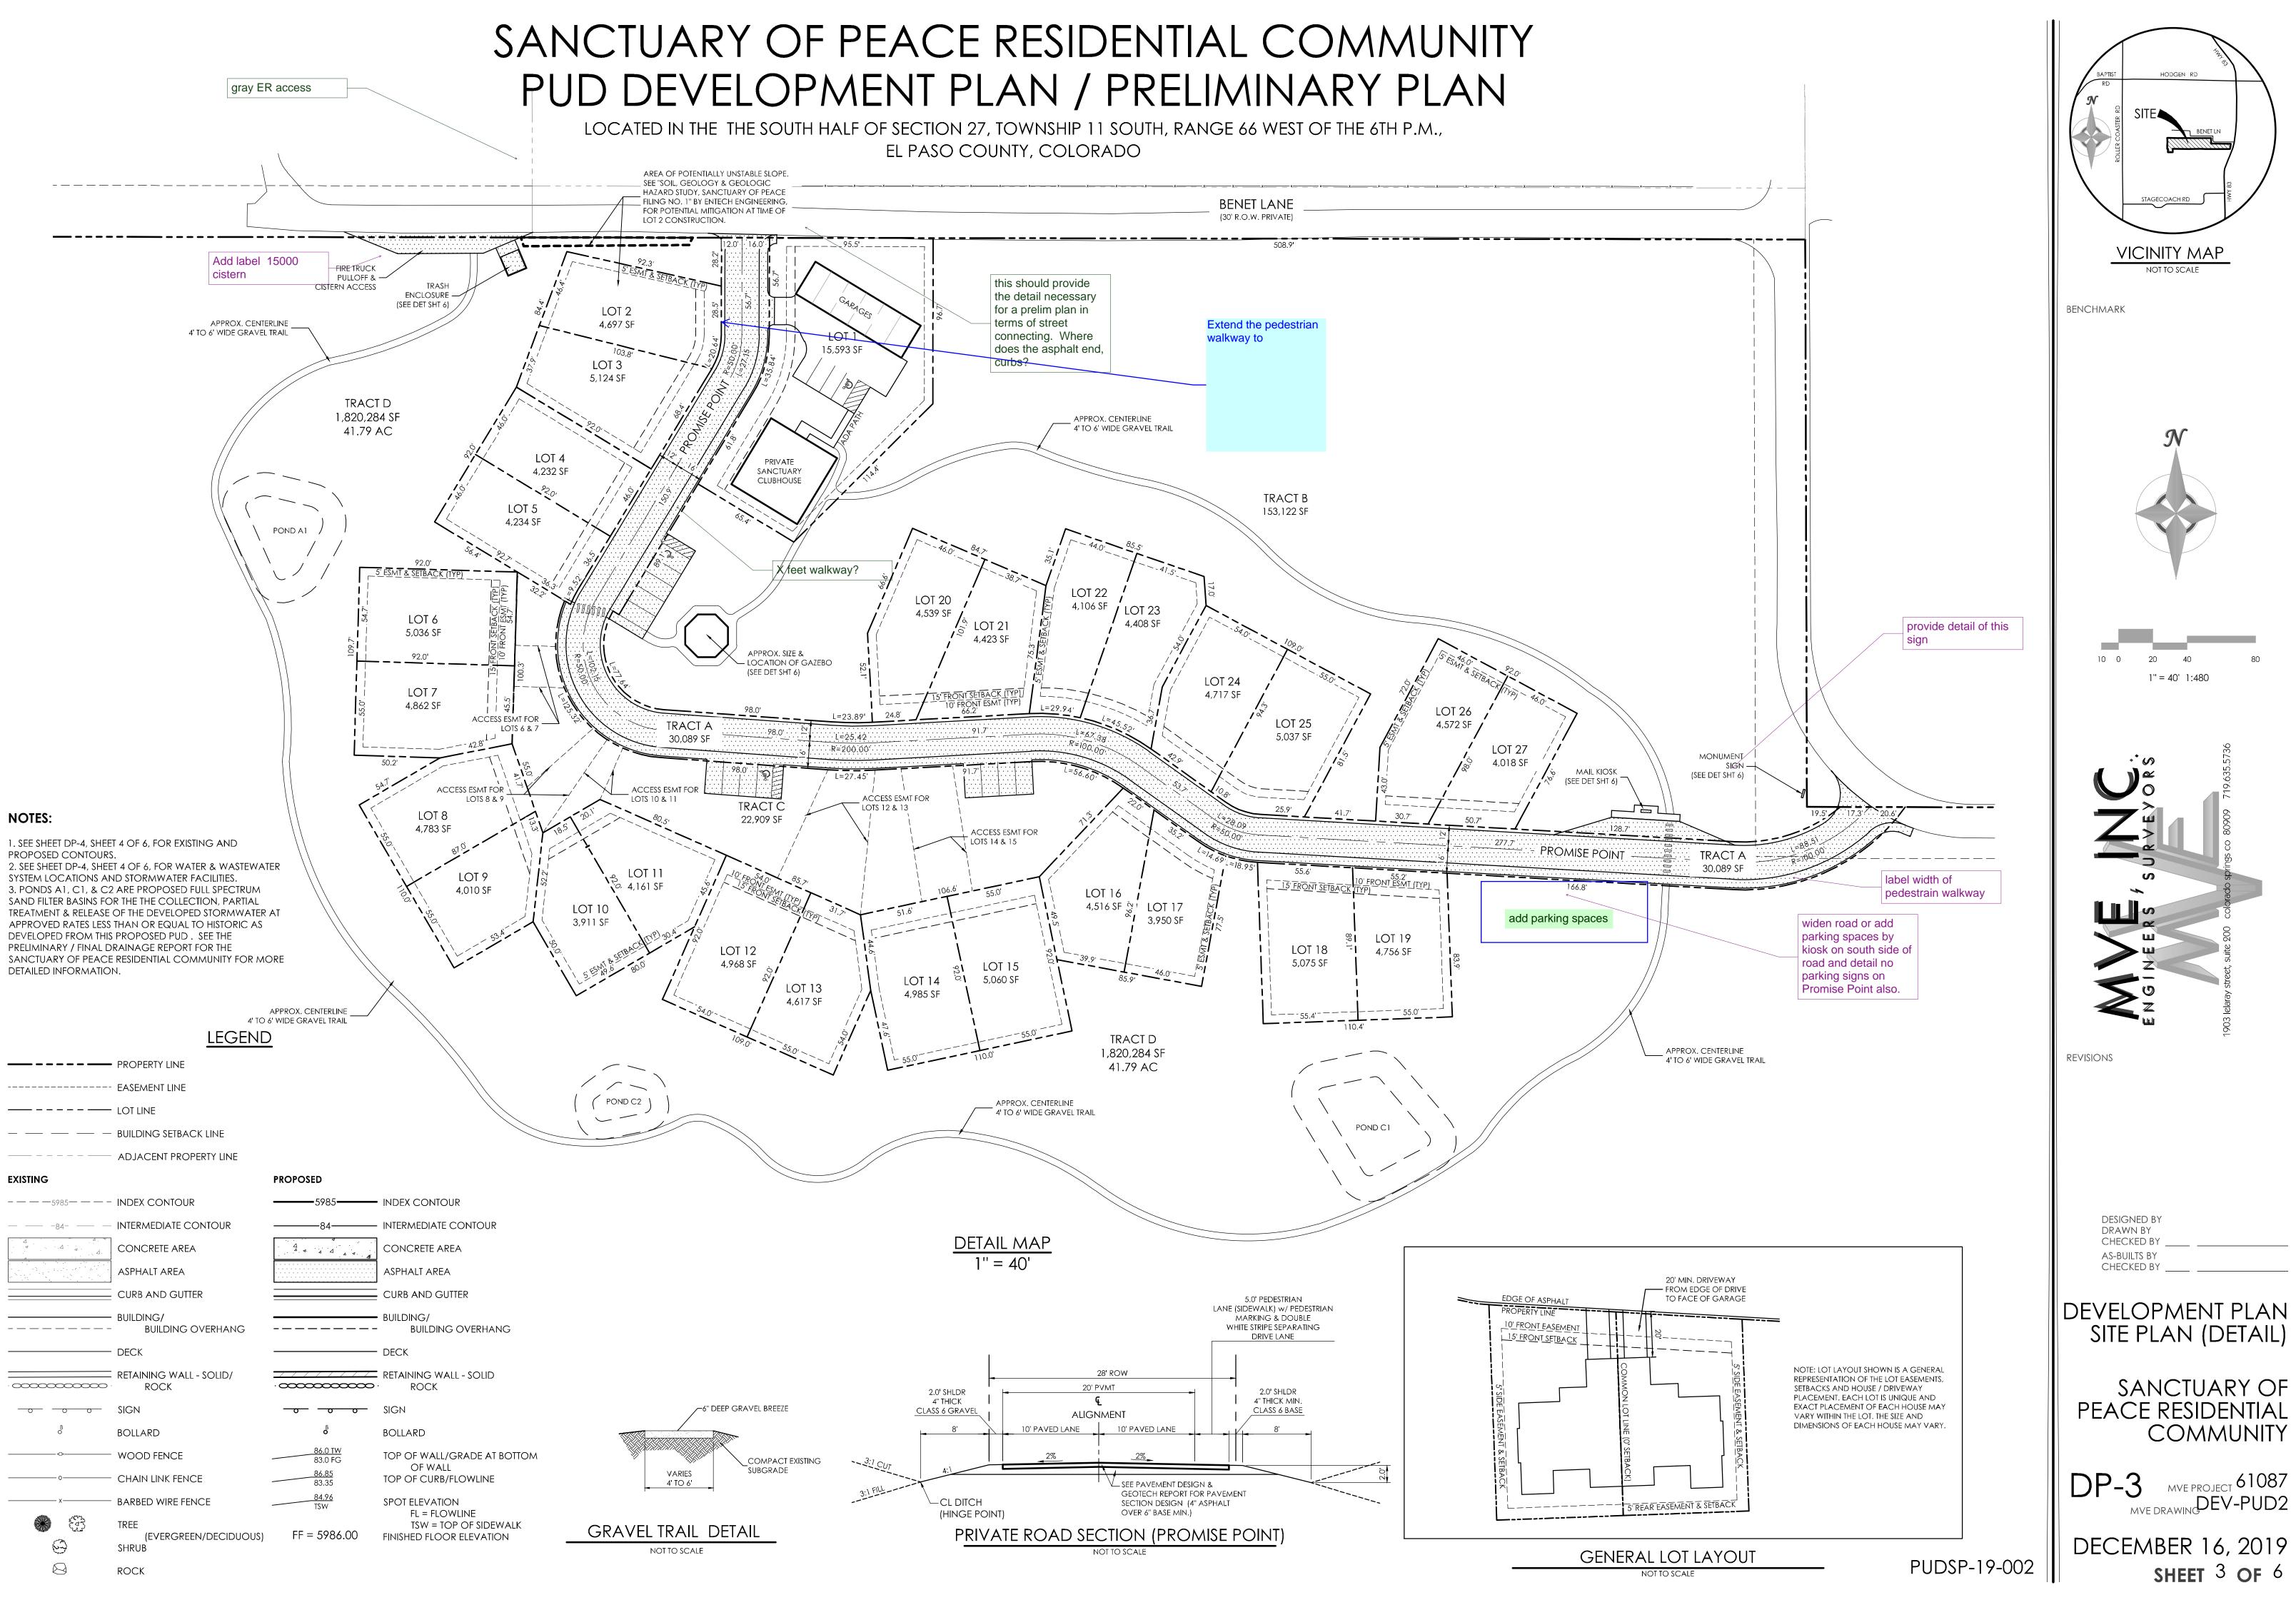

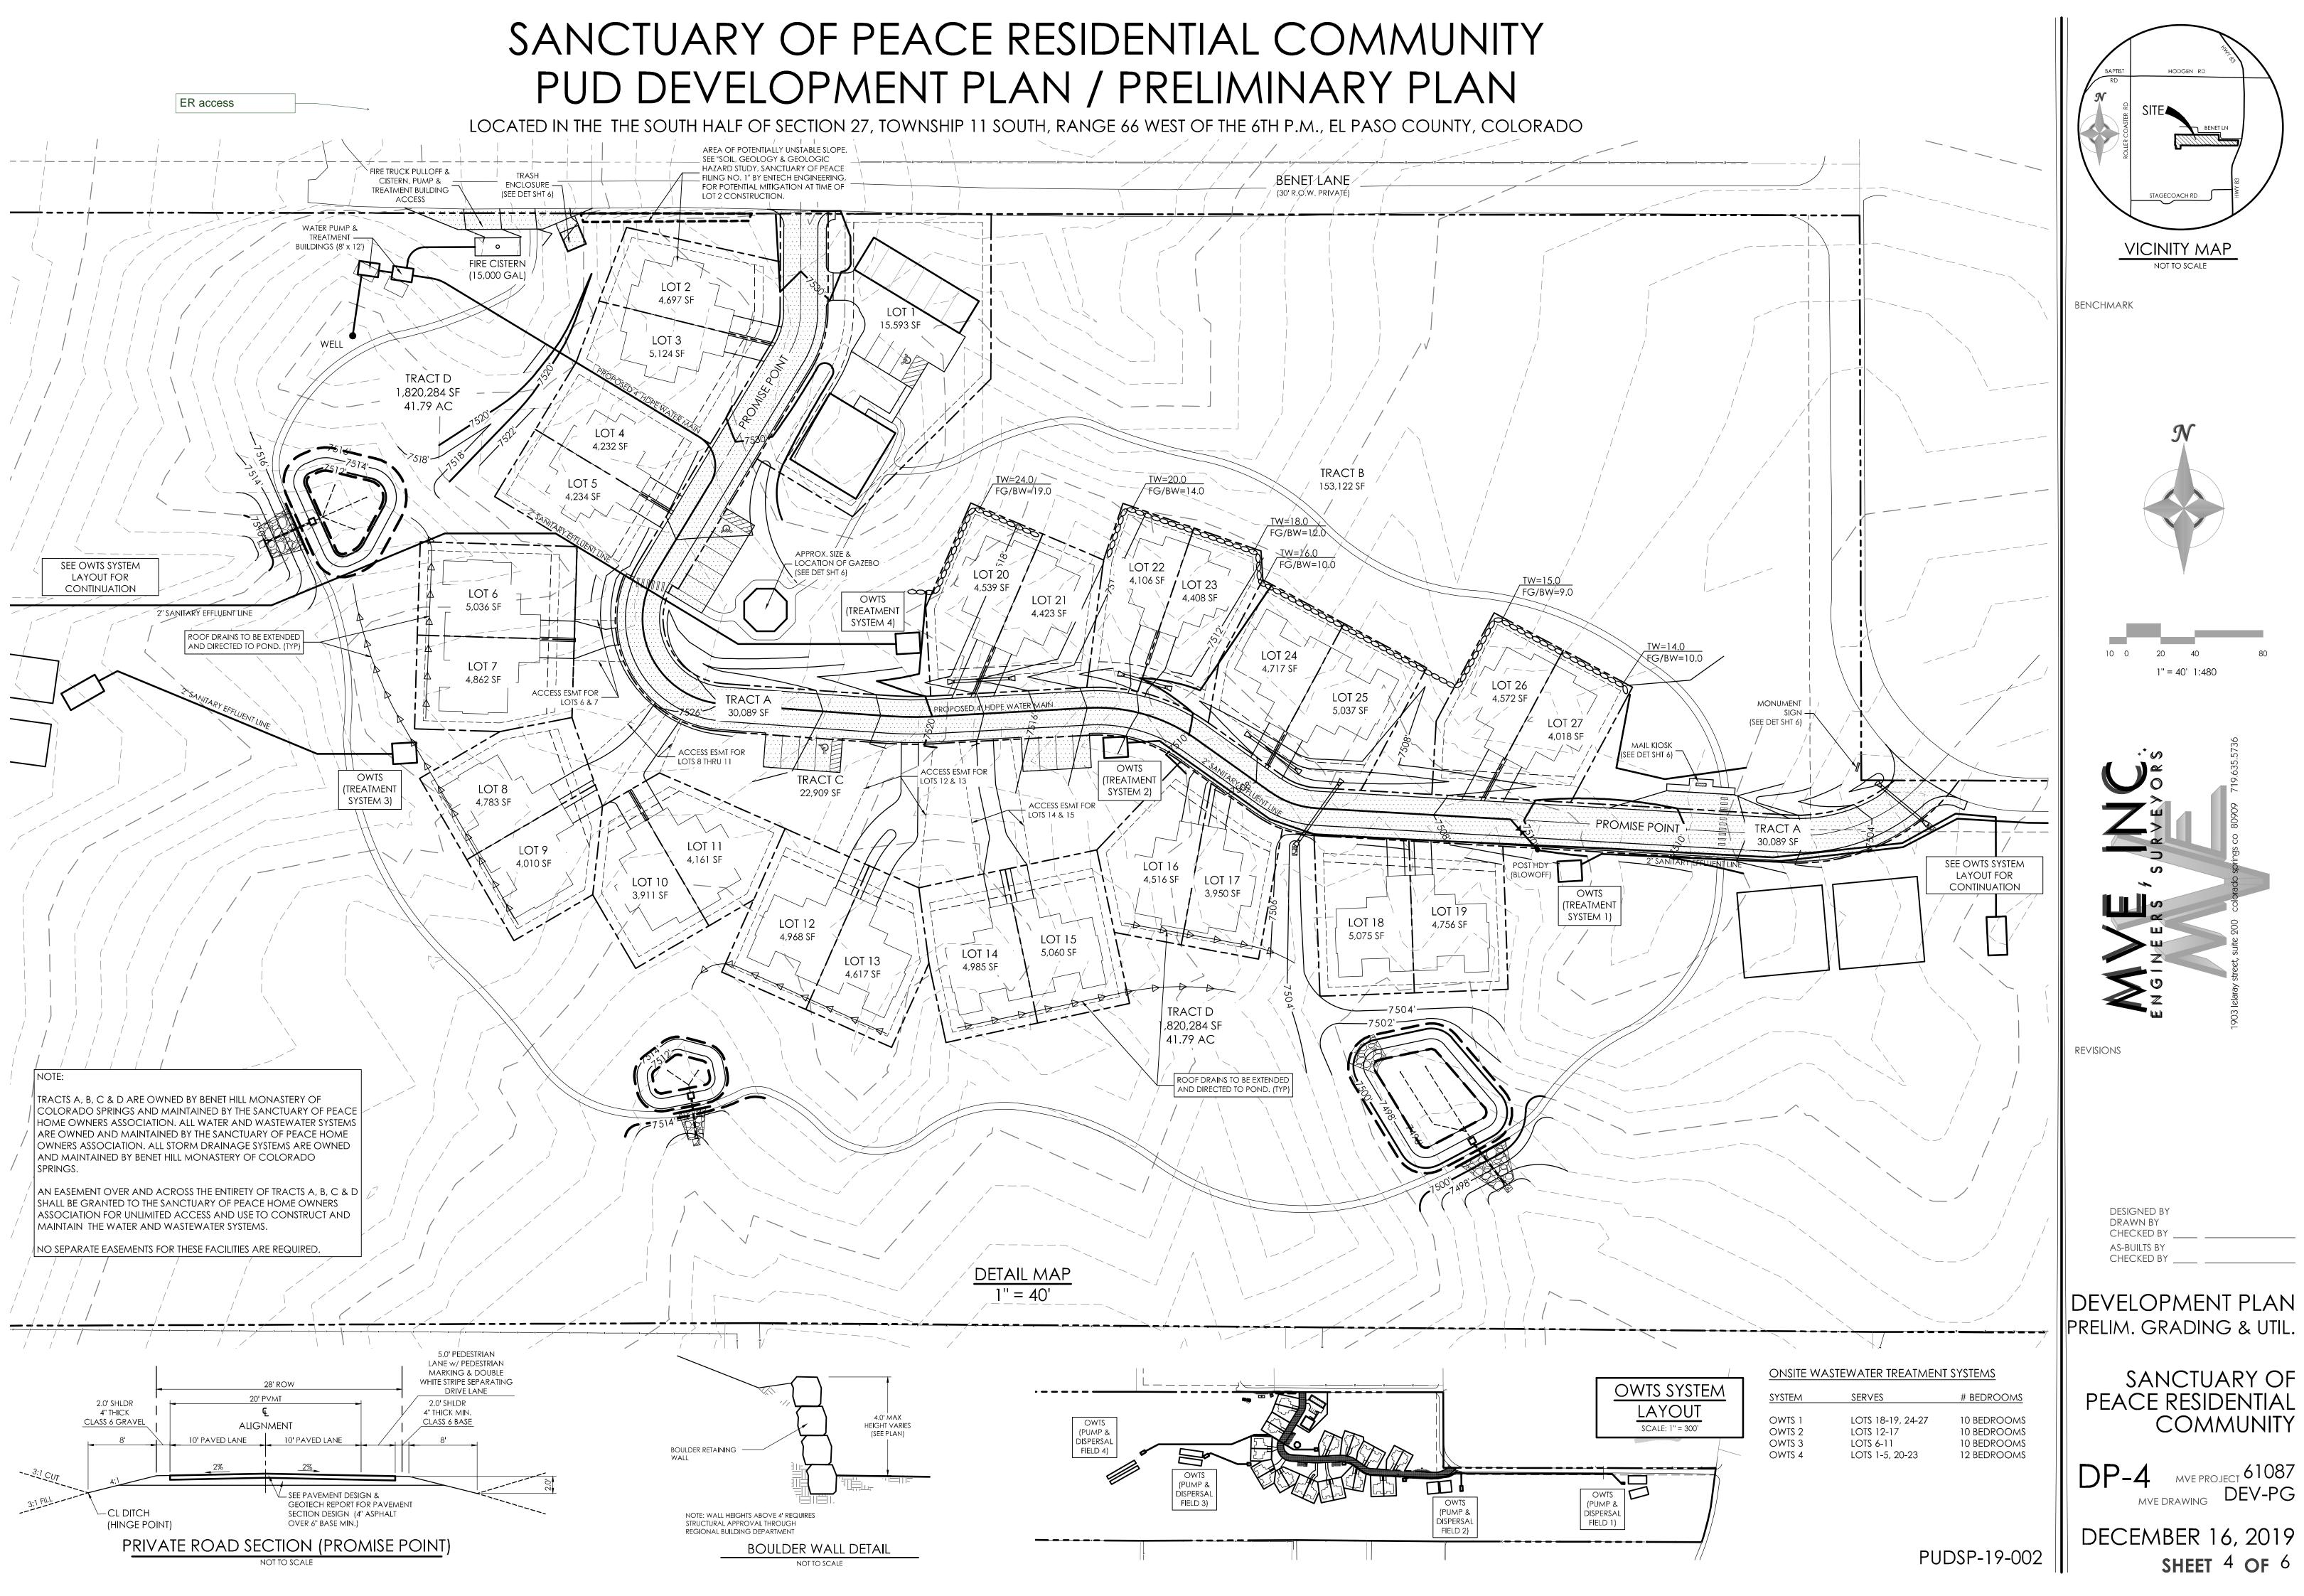


# PUD DEVELOPMENT PLAN / PRELIMINARY PLAN




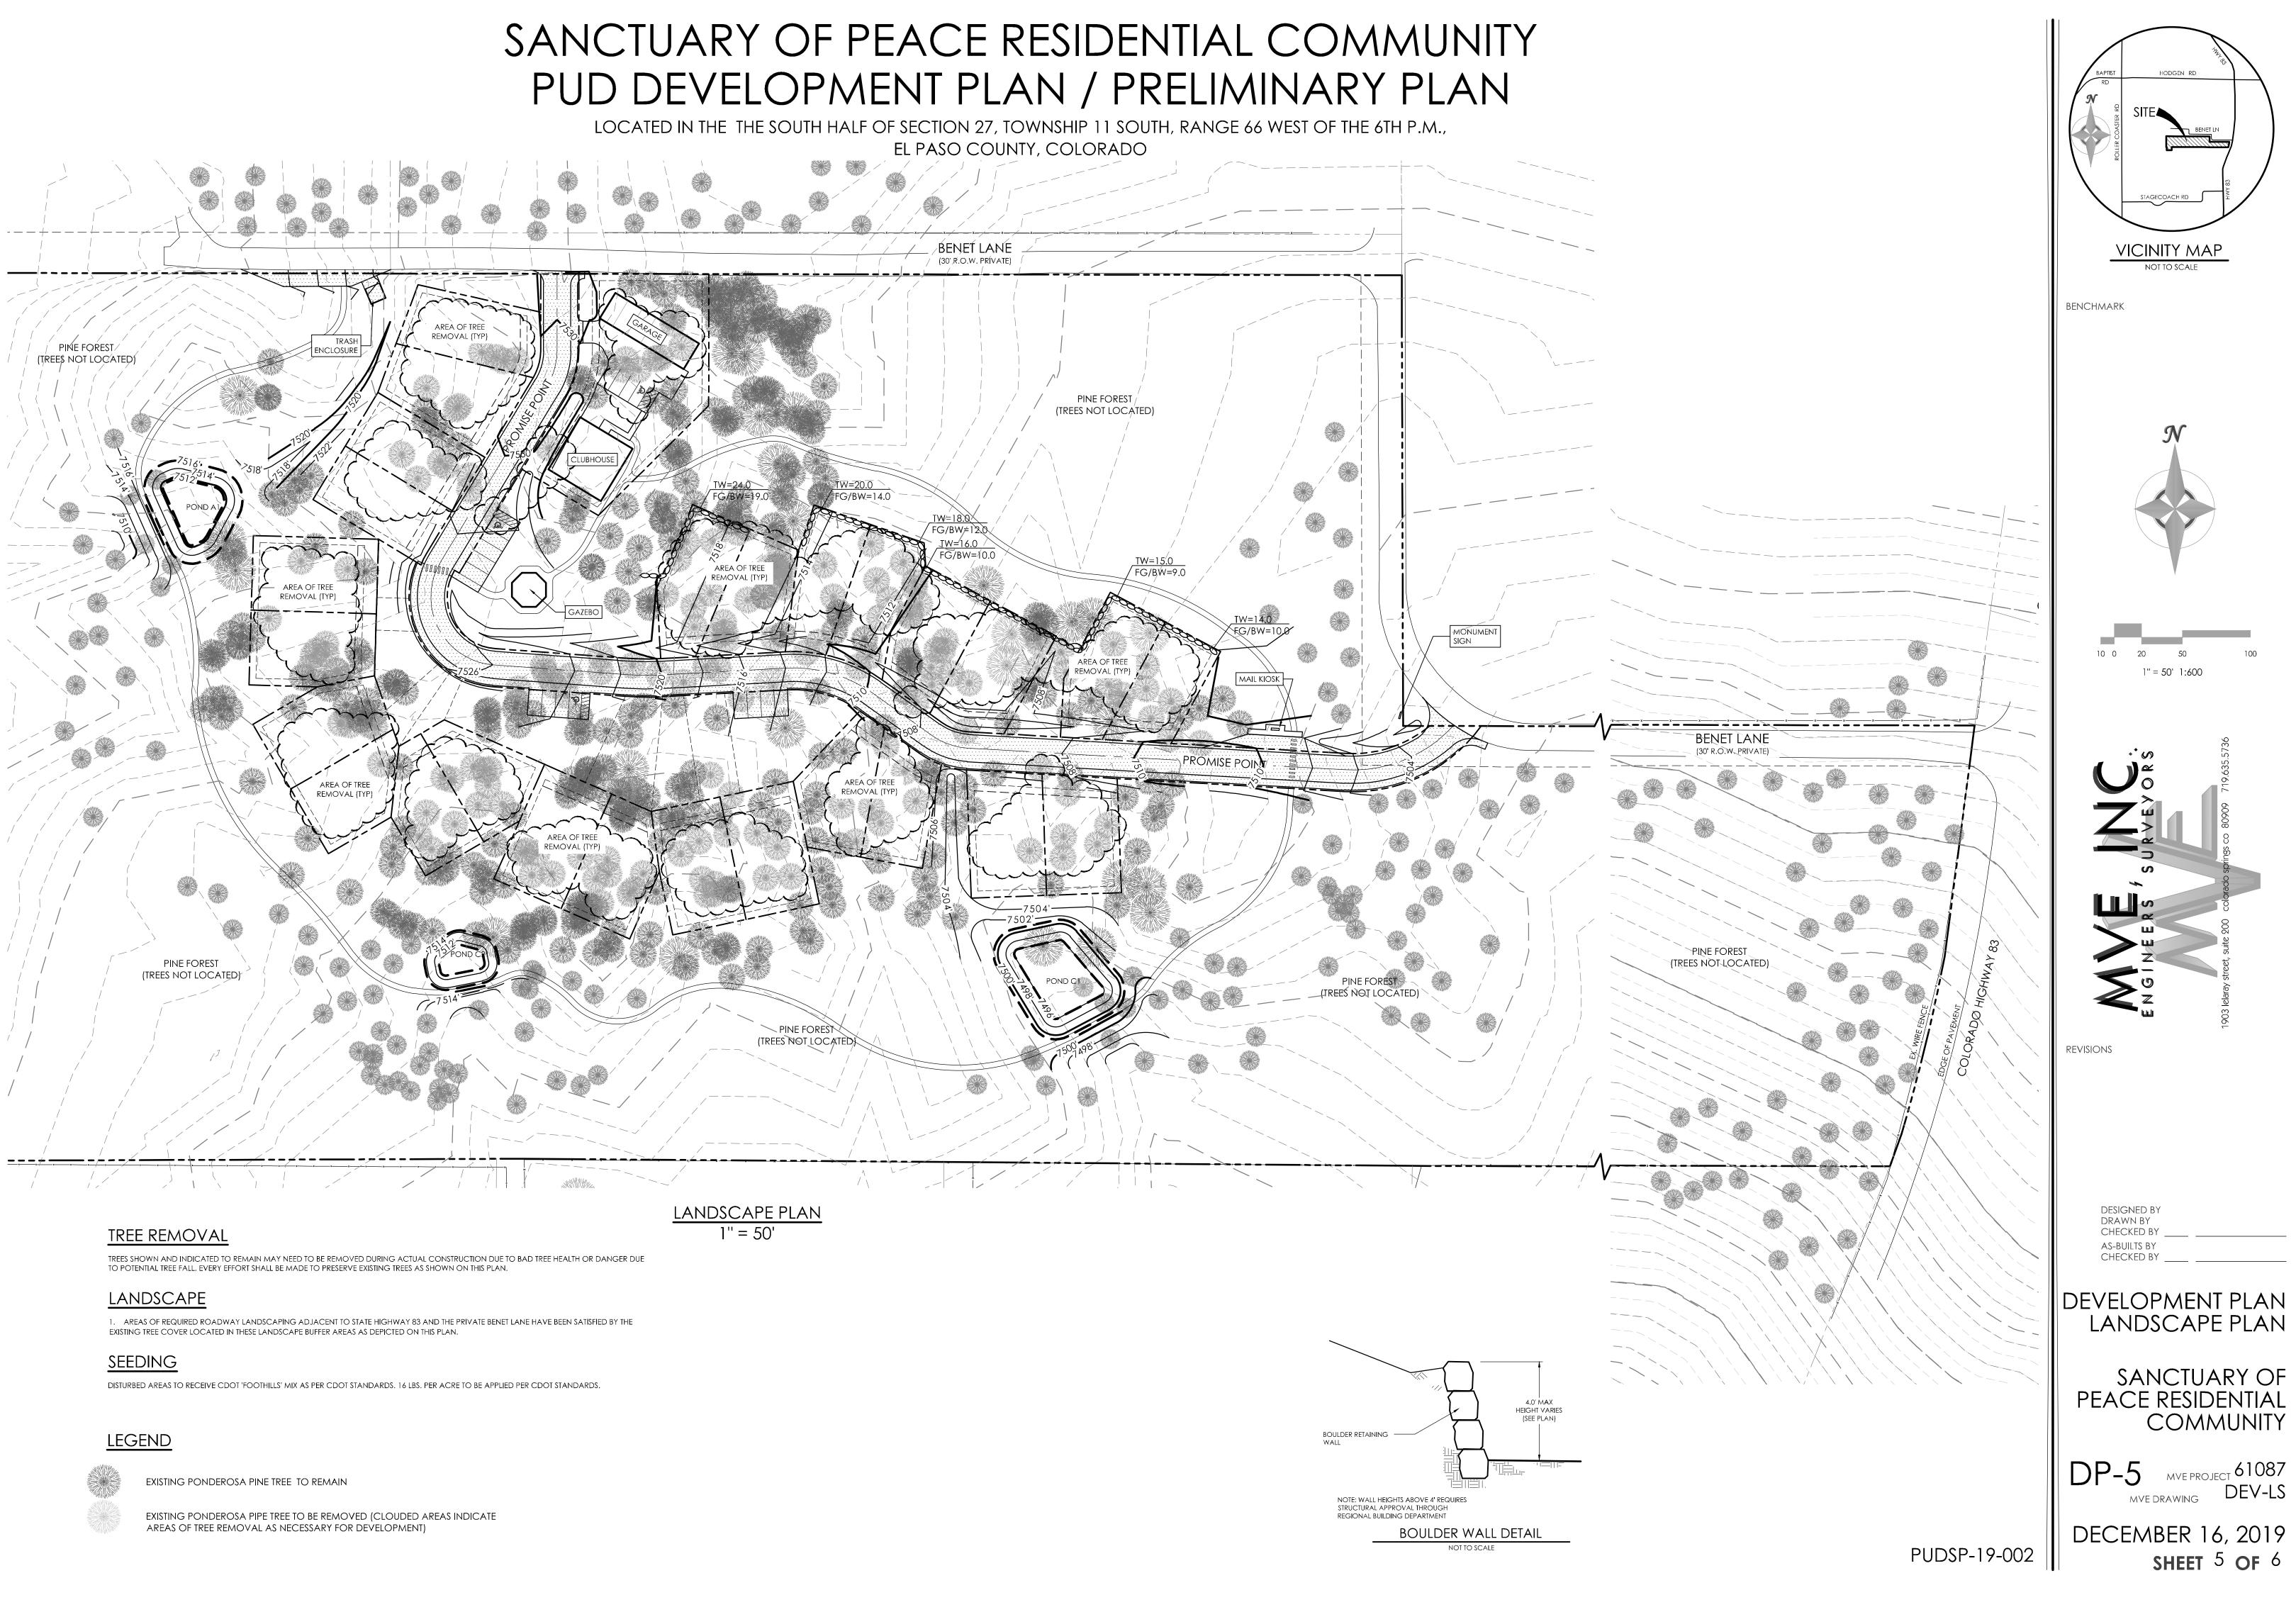




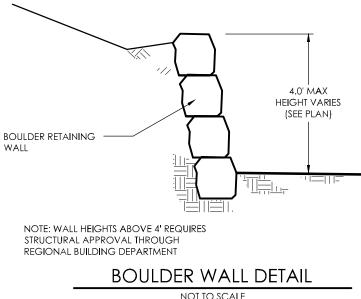

# SANCTUARY OF PEACE RESIDENTIAL COMMUNITY PUD DEVELOPMENT PLAN / PRELIMINARY PLAN LOCATED IN THE THE SOUTH HALF OF SECTION 27, TOWNSHIP 11 SOUTH, RANGE 66 WEST OF THE 6TH P.M.,

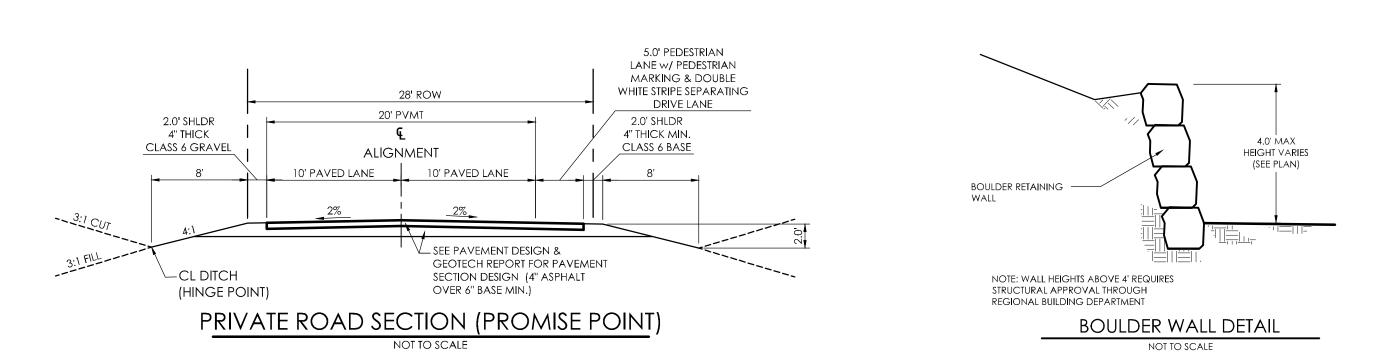



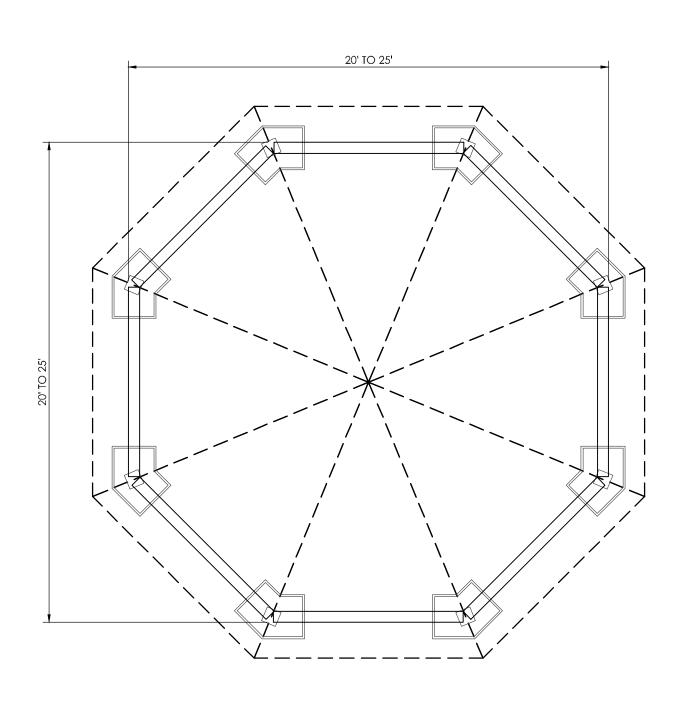

GAZEBO PLAN / CONCEPT




EL PASO COUNTY, COLORADO


metal sign "SANCTUARY OF PEACE"

3' X 3' STACKED BLOCK PEDESTAL






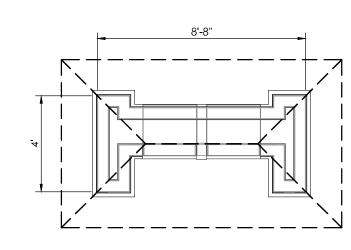

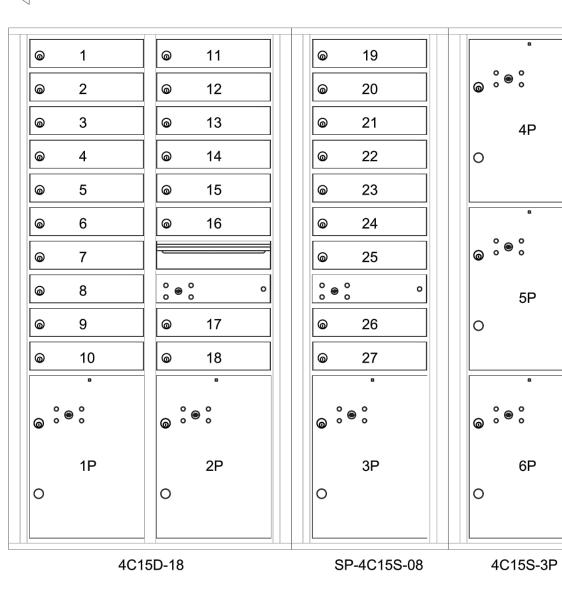


TRASH ENCLOSURE PLAN / CONCEPT NOT TO SCALE

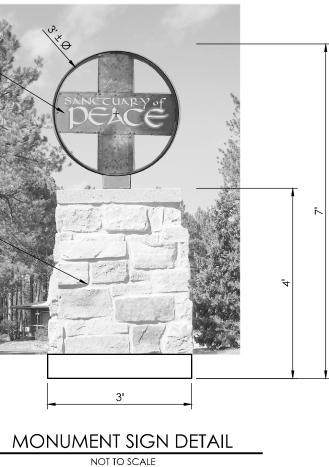

**Option 1 Dimensions** Overall Width: 5' 6-9/16" (R.O. MIN/MAX: 5' 5-7/16" / 5' 5-11/16")

MAILBOX PLAN / DETAILS

PUDSP-19-002

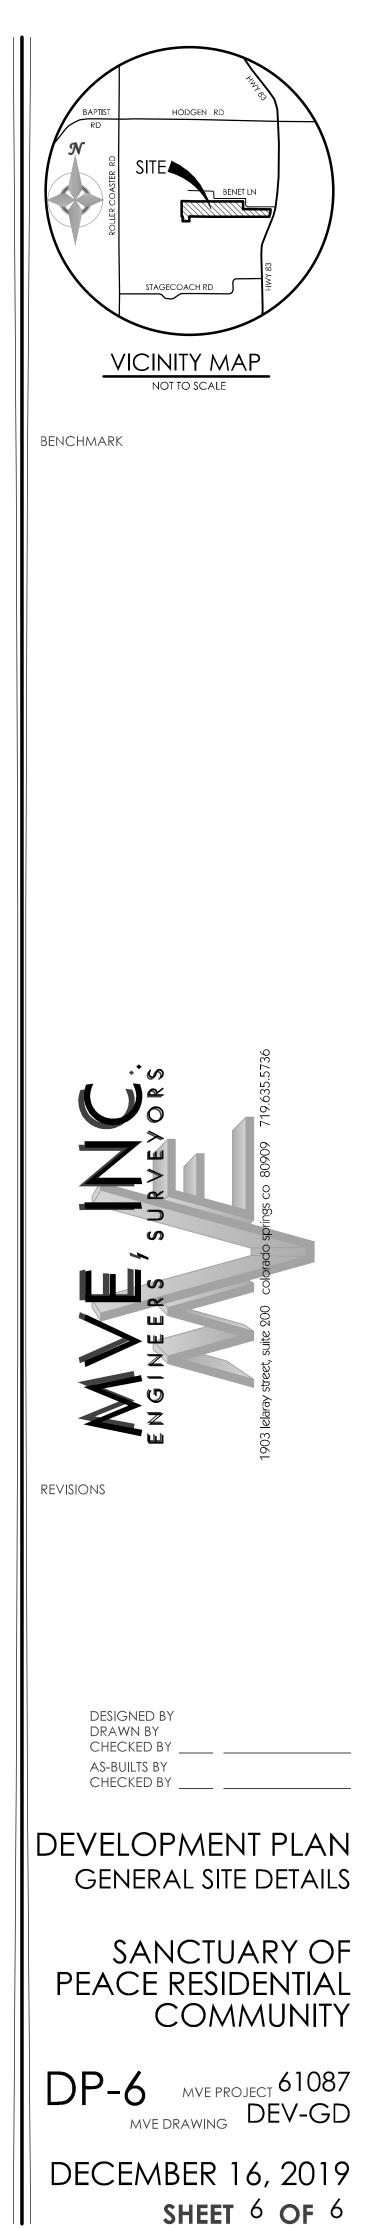

# PUDSP V\_3 Redlines.pdf Markup Summary

dsdparsons (27)		
UDC / KC   1 UDC / KC   2 UDC 8A   3 UDC 8A   4 UDC 8A	Subject: Callout Page Label: [1] 61087-DEV-PUD-DP-2 Author: dsdparsons Date: 1/21/2020 4:23:06 PM Status: Color: ■ Layer: Space:	delete
delete: beef up line eren retwark for ER access 3 3 3 3	Subject: Callout Page Label: [1] 61087-DEV-PUD-DP-2 Author: dsdparsons Date: 1/21/2020 4:23:26 PM Status: Color: Layer: Space:	delete; beef up line work for ER access
PUD MODIFICA with the second ALSB-21	Subject: Callout Page Label: [1] 61087-DEV-PUD-DP-2 Author: dsdparsons Date: 1/21/2020 4:23:52 PM Status: Color: Layer: Space:	8.4.3.B.2.f
	Subject: Callout Page Label: [2] 61087-DEV-PUD2-DP-3 Author: dsdparsons Date: 1/21/2020 4:24:29 PM Status: Color: Layer: Space:	gray ER access
	Subject: Callout Page Label: [3] 61087-DEV-PG-DP-4 Author: dsdparsons Date: 1/21/2020 4:24:41 PM Status: Color: Layer: Space:	ER access
	Subject: Callout Page Label: [1] 61087-DEV-PUD-DP-2 Author: dsdparsons Date: 1/21/2020 4:27:42 PM Status: Color: Layer: Space:	ADD ER ACCESS ROUTE IS TO BENET LANE, OT FOOLS GOLD AND OUT TO x,Y, z. A EASMENT HAS BEEN RECORED AT

OLUMELATION Mathematical Mathematical   0110000 010000 010000 010000   0110000 010000 010000 010000 010000   0110000 0100000 01000000 01000000 01000000 01000000 01000000 01000000 01000000 010000000 0100000000000 0100000000000000000000000000000000000	Subject: Owner Certification Page Label: [1] 61087-DEV-PUD-DP-2 Author: dsdparsons Date: 1/21/2020 4:28:14 PM Status: Color: Layer: Space:	
	Subject: Owner Certification Page Label: [1] 61087-DEV-PUD-DP-2 Author: dsdparsons Date: 1/21/2020 4:28:18 PM Status: Color: Layer: Space:	-
DENTIAL COMMUNITY PRELIMINARY PLAN	Subject: Arrow Page Label: [1] 61087-DEV-PUD-DP-2 Author: dsdparsons Date: 1/22/2020 7:36:42 AM Status: Color: ■ Layer: Space:	
Estating BENTELANE DESTENSION CONSISTENT CON	Subject: Callout Page Label: [1] 61087-DEV-PUD-DP-2 Author: dsdparsons Date: 1/22/2020 7:37:15 AM Status: Color: Layer: Space:	Existing
	Subject: Callout Page Label: [1] 61087-DEV-PUD-DP-2 Author: dsdparsons Date: 1/22/2020 7:37:45 AM Status: Color: Layer: Space:	proposed promise point private
A conference on an and a conference of a confe	Subject: Callout Page Label: [1] 61087-DEV-PUD-DP-2 Author: dsdparsons Date: 1/22/2020 7:38:07 AM Status: Color: Layer: Space:	X foot gravel trail?

A second	Subject: Callout Page Label: [1] 61087-DEV-PUD-DP-2 Author: dsdparsons Date: 1/22/2020 7:38:48 AM Status: Color: Layer: Space:	emphasize access easement from proposed promise point so it is easily seen
	Subject: Callout Page Label: [2] 61087-DEV-PUD2-DP-3 Author: dsdparsons Date: 1/22/2020 7:41:46 AM Status: Color: ■ Layer: Space:	this should provide the detail necessary for a prelim plan in terms of street connecting. Where does the asphalt end, curbs?
	Subject: Callout Page Label: [2] 61087-DEV-PUD2-DP-3 Author: dsdparsons Date: 1/22/2020 7:42:14 AM Status: Color: Layer: Space:	X feet walkway?
Image: state	Subject: Callout Page Label: [1] 61087-DEV-PUD-DP-2 Author: dsdparsons Date: 1/23/2020 11:11:51 AM Status: Color: Layer: Space:	delete; allow loop of benet hill from promise point to HWY 83; no culdesac dev required and not supported by ECM admim.
	Subject: Callout Page Label: [1] 61087-DEV-PUD-DP-2 Author: dsdparsons Date: 1/23/2020 11:12:35 AM Status: Color: Layer: Space:	loop provided from Promise Point to Benet to HW 83 delete ER access easement
	Subject: Callout Page Label: [1] 61087-DEV-PUD-DP-2 Author: dsdparsons Date: 1/23/2020 11:12:53 AM Status: Color: Layer: Space:	Bold ER ACCESS LINE work to the west

	Subject: Callout Page Label: [1] 61087-DEV-PUD-DP-2 Author: dsdparsons Date: 1/23/2020 11:24:02 AM Status: Color: Layer: Space:	widen road or add parking spaces by kiosk on south side of road and detail no parking signs on Promise Point also.
	Subject: Callout Page Label: [2] 61087-DEV-PUD2-DP-3 Author: dsdparsons Date: 1/23/2020 11:24:16 AM Status: Color: Layer: Space:	widen road or add parking spaces by kiosk on south side of road and detail no parking signs on Promise Point also.
g	Subject: Rectangle Page Label: [2] 61087-DEV-PUD2-DP-3 Author: dsdparsons Date: 1/23/2020 11:24:32 AM Status: Color: Layer: Space:	
La Contraction of Con	Subject: Callout Page Label: [2] 61087-DEV-PUD2-DP-3 Author: dsdparsons Date: 1/23/2020 11:25:06 AM Status: Color: Layer: Space:	label width of pedestrain walkway
add parking spaces	Subject: Text Box Page Label: [2] 61087-DEV-PUD2-DP-3 Author: dsdparsons Date: 1/23/2020 11:26:06 AM Status: Color: ■ Layer: Space:	add parking spaces
	Subject: Callout Page Label: [2] 61087-DEV-PUD2-DP-3 Author: dsdparsons Date: 1/23/2020 11:27:04 AM Status: Color: Layer: Space:	provide detail of this sign

Andrew Scotlog and Street Scotlog and Scotlog and Street Scotlog and Scotlog and Street Scotlog and Scotlog and Street Scotlog and Scotlog and Street Scotlog and Street Scotlog and Street Scotlog and Street Scotlog and Scotlog and Scotlog and Scotlog and Scotlog and Street Scotlog and	Subject: Callout Page Label: [1] 61087-DEV-PUD-DP-2 Author: dsdparsons Date: 1/23/2020 8:31:17 AM Status: Color: Layer: Space:	Add the 15000 gallon cistern location and add to uses so an approval location is not required.
Add label 1500 Provide Mark Add Bala Provide Gaves Bala Provide Gaves Bala	Subject: Callout Page Label: [2] 61087-DEV-PUD2-DP-3 Author: dsdparsons Date: 1/23/2020 8:31:51 AM Status: Color: Layer: Space:	Add label 15000 cistern
Reatly emphasize energing access models and access preparations (Reprint Pre-	Subject: Callout Page Label: [1] 61087-DEV-PUD-DP-2 Author: dsdparsons Date: 1/23/2020 9:03:49 AM Status: Color: Layer: Space:	Really emphasize emergency access from 83 over to to Rollercoaster graphically
Steve Kuehster	(5)	
1 30' EMERGENSEN ASEMENT IDEC NO 735503 8	Subject: Pen Page Label: [1] 61087-DEV-PUD-DP-2 Author: Steve Kuehster Date: 1/23/2020 11:19:24 AM Status: Color: Layer: Space:	-
30' EMERGENCX SEMENT 75;	Subject: Pen Page Label: [1] 61087-DEV-PUD-DP-2 Author: Steve Kuehster Date: 1/23/2020 11:19:34 AM Status: Color: Layer: Space:	_
•	Subject: Pen Page Label: [1] 61087-DEV-PUD-DP-2 Author: Steve Kuehster Date: 1/23/2020 11:19:44 AM Status: Color: Layer: Space:	



Space:

. . . . . . . . .

Subject: arrow & box Page Label: [1] 61087-DEV-PUD-DP-2 Author: Steve Kuehster Date: 1/23/2020 11:25:41 AM Status: Color: Layer:

PCD Engineering: modify plan to allow Benet Lane as a loop turn around. this removes the need for a deviation request for a long Cul-de-sac.

-----



Subject: arrow & box Page Label: [2] 61087-DEV-PUD2-DP-3 Author: Steve Kuehster Date: 1/23/2020 11:52:44 AM Status: Color: Layer: Space:

-----

Extend the pedestrian walkway to