


PREPARED FOR:



REVISIONS:

#	DATE	COMMENT
A	02/27/19	Issued for Review (30%)
B	03/27/19	Issued for Review (60%)
C	04/22/19	Permit Submittal Revisions
D	04/29/19	Issued for Grading Permit

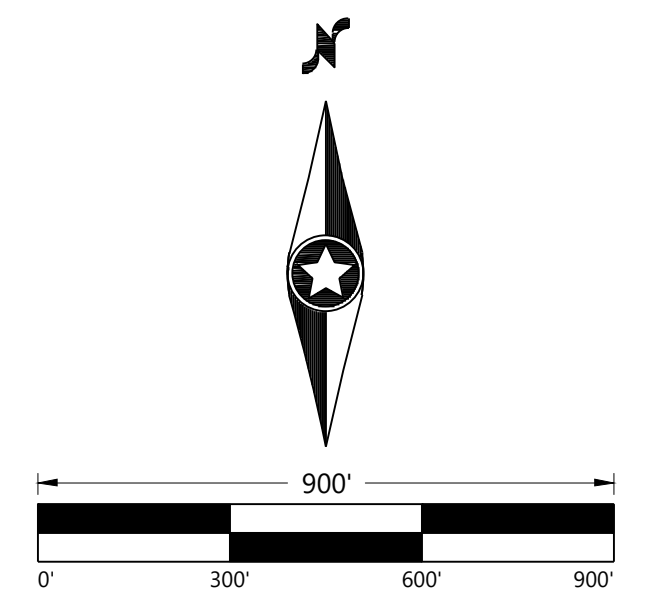

Grazing Yak Solar

El Paso County, Colorado

Re-Seeding Plan

DATE: 04/29/2019

SHEET: PL.01

See Plan View 2 (This Sheet)

LEGEND & ABBREVIATIONS


---	EX. PROJECT BOUNDARY LINE
---	INVERTER BLOCK BOUNDARY
P-PUG-1	PROPOSED UNDERGROUND CIRCUIT 1
P-PUG-2	PROPOSED UNDERGROUND CIRCUIT 2
X	PROPOSED FENCE LINE
---	PROPOSED SOLAR TRACKER
---	BOUNDARY SET BACK LINE 10M
---	BOUNDARY SET BACK LINE 15M
---	PROPOSED GRAVEL ACCESS RD. (2500 FT.)
---	PROPOSED DIRT ACCESS RD. (13,425 FT.)
---	PROPOSED CAB
---	PROPOSED LAYDOWN AREA
---	PROPOSED PROTECTED CROSSING
---	RE-SEEDING
---	RE-SEEDING AS REQUIRED
DL	PROPOSED LIMITS OF DISTURBANCE
---	PROPOSED INDEX CONTOUR LINE
---	PROPOSED INTERVAL CONTOUR LINE
---	EX. INDEX CONTOUR LINE
---	EX. INTERVAL CONTOUR LINE
---	EX. SECTION LINE
---	EX. EASEMENT LINE
X	EX. FENCE LINE
POH	EX. OVERHEAD POWERLINE
PUG	EX. UNDERGROUND POWERLINE
FO	EX. FIBER OPTIC LINE
---	EX. GRAVEL ROAD
---	EX. ASPHALT PAVEMENT ROAD

Specify mix(s) and methods include, blanket, watering plan etc... The details must be provided.

Include in the FAE


Identify these setback, fence re-seeding, boundary lines with a leader; it is not clear what lines are which.

This plan is not legible due to the scale

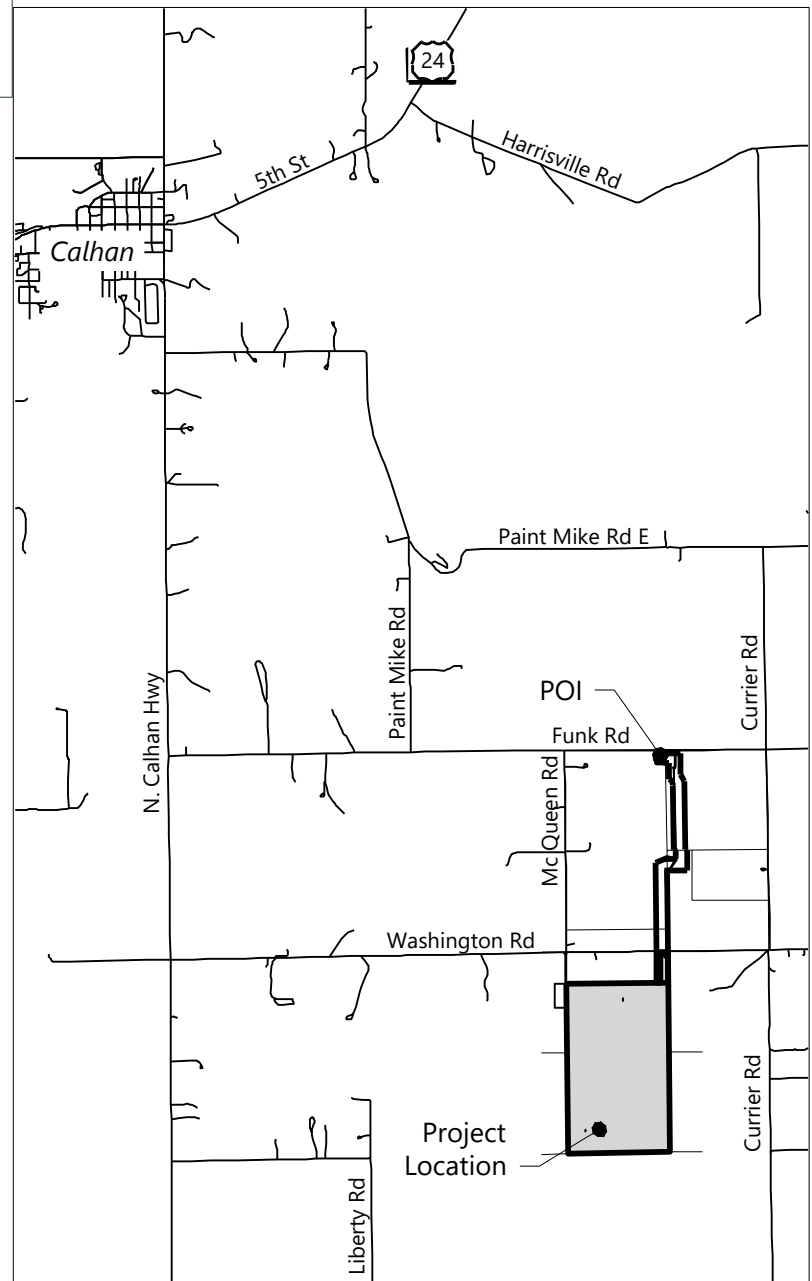


VICINITY MAP
Scale: 1" = 5000'

See Plan View 1 (This Sheet)

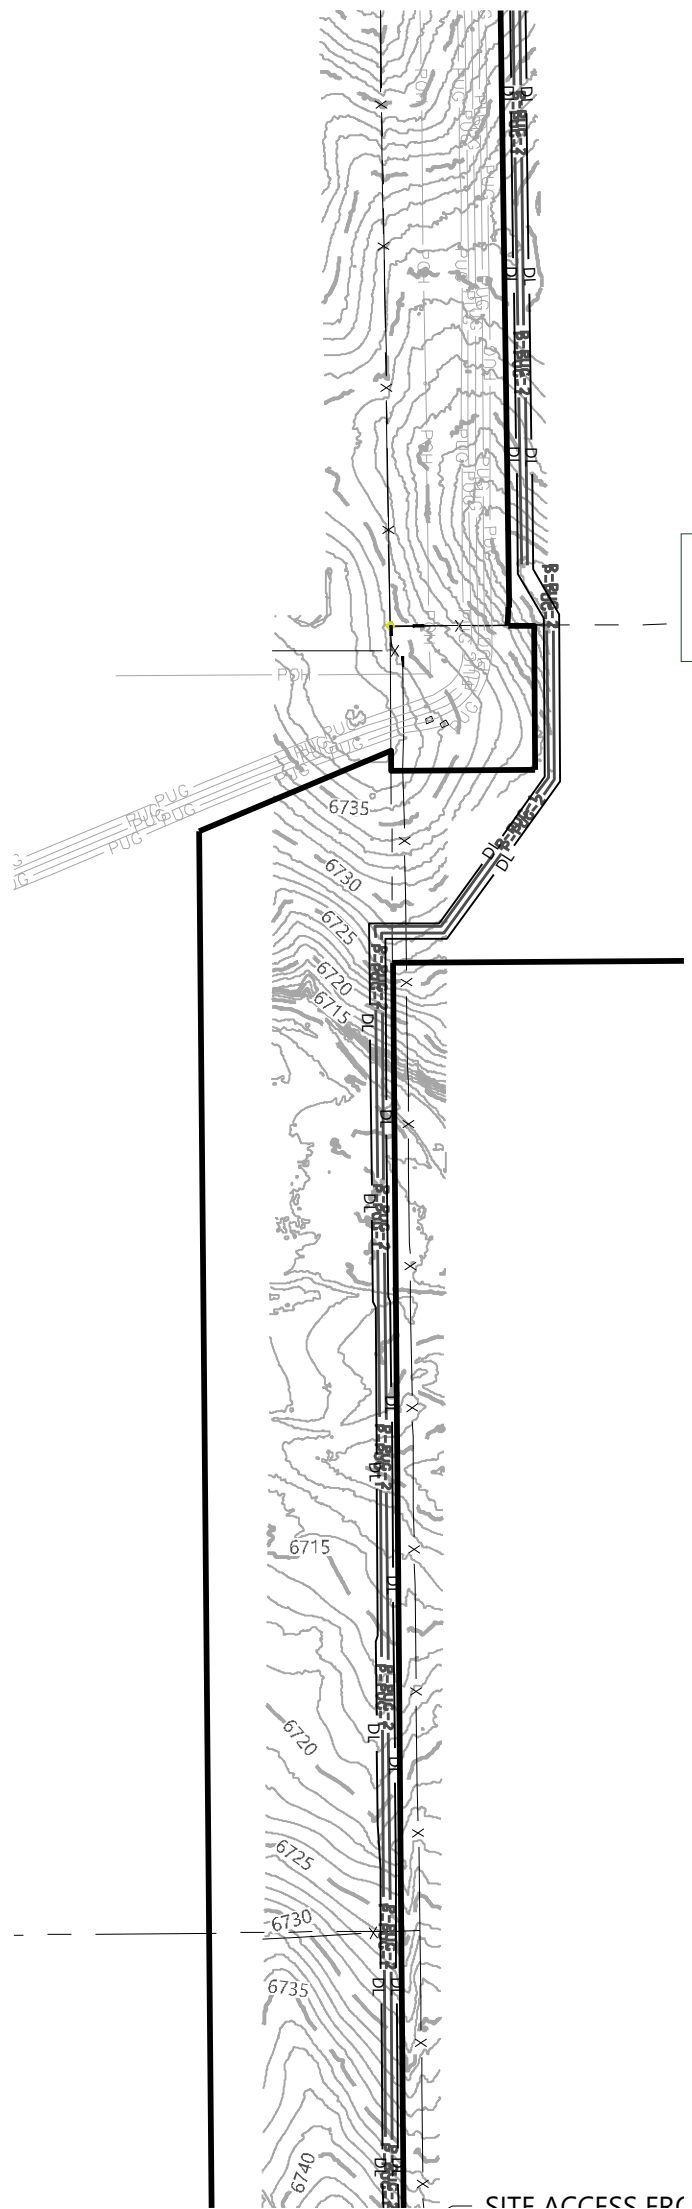

See Plan View 3 (This Sheet)

2 Plan View 2
1" = 300'

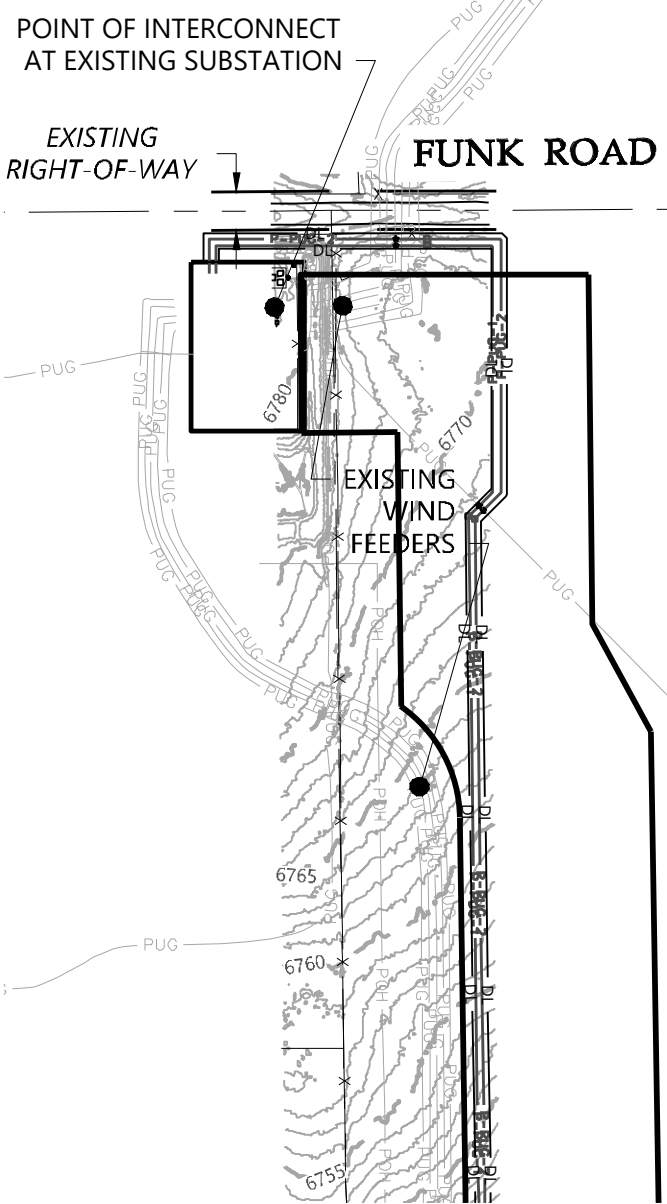

See Plan View 2 (This Sheet)

1 Plan View 1
1" = 300'

3 Plan View 3
1" = 300'

Markup Summary

dsdparsons (7)

SITE ACCESS GATE

Specify mix(s) and methods include, blanket, watering plan etc... The details must be provided.




Subject: Callout
Page Label: 1
Author: dsdparsons
Date: 5/20/2019 11:14:11 AM
Color: ■

Specify mix(s) and methods include, blanket, watering plan etc... The details must be provided.


Include in the FAE

Subject: Callout
Page Label: 1
Author: dsdparsons
Date: 5/20/2019 11:21:57 AM
Color: ■

Include in the FAE

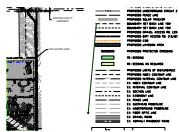

Subject: Arrow
Page Label: 1
Author: dsdparsons
Date: 5/20/2019 11:28:38 AM
Color: ■

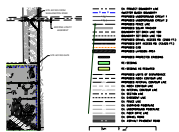


Subject: Arrow
Page Label: 1
Author: dsdparsons
Date: 5/20/2019 11:28:47 AM
Color: ■




Subject: Callout
Page Label: 1
Author: dsdparsons
Date: 5/20/2019 11:29:26 AM
Color: ■

Identify these setback, fence re-seeding , boundary lines with a leader; it is not clear what lines are which.

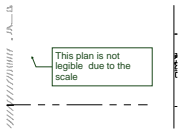

Subject: Callout
Page Label: 1
Author: dsdparsons
Date: 5/20/2019 11:30:12 AM
Color: ■

This plan is not legible due to the scale

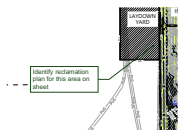

Subject: Callout
Page Label: 1
Author: dsdparsons
Date: 5/28/2019 12:13:26 PM
Color: ■

Identify reclamation plan for this area on sheet