



This needs more detail. Show all sign dimensions and building elevations.

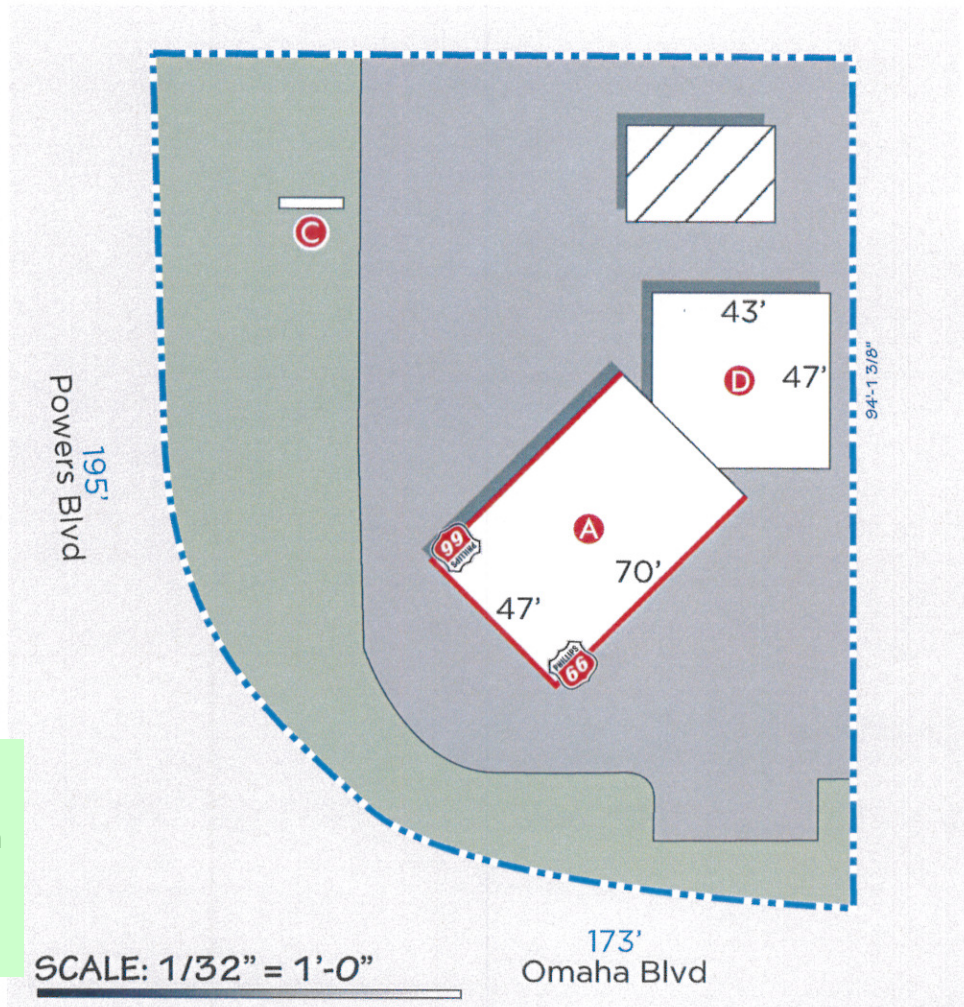

SCALE: 1/32" = 1'-0"

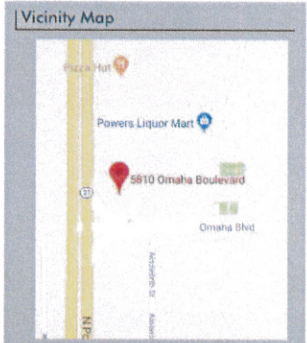

Additional Info

- Project Overview (Legend)
- Canopy
 - MID Sign
 - C Store

PROMOTION PLUS SIGN CO., INC.
"The Imaging Experts"
Now part of the FRAMINGTON PLUS SIGN CO., INC. Family
 21034 Osborne St. Canoga Park, CA 91304
 (P) 818.993.5406 (F) 818.993.3174
 State Licence 853228

Job Location
 880377
 5810 Omaha Blvd
 Colorado Springs, CO 80915

Owner Information
 Project: Initial - (see Image)
 Designed by: KM

Approval
 DocuSigned by:
Erin Parker for Doug Hedeker
 Date -
 I have reviewed all renderings and I am satisfied with the look and the scope of work listed within.
 This rendering is property of Promotion Plus Sign Co., Inc. and cannot be reproduced without written consent of owner.

PERMIT PLAN

Markup Summary

dsdKendall (1)

This needs more detail. Show all sign dimensions and building elevations.

SCALE

Subject: Text Box
Page Label: 1
Lock: Unlocked
Author: dsdKendall
Date: 10/26/2018 12:08:46 PM
Color: ■

This needs more detail. Show all sign dimensions and building elevations.