


**CLOVERLEAF FILING NO. 2  
LOT NO. 58**



Please add labels to drawing. Is this the landing? If so, it is shown within the side setback. Please correct so that the landing is outside the side setback and show the dimensions to the side property line.

*Handwritten in red:*  
Landing in red stairs

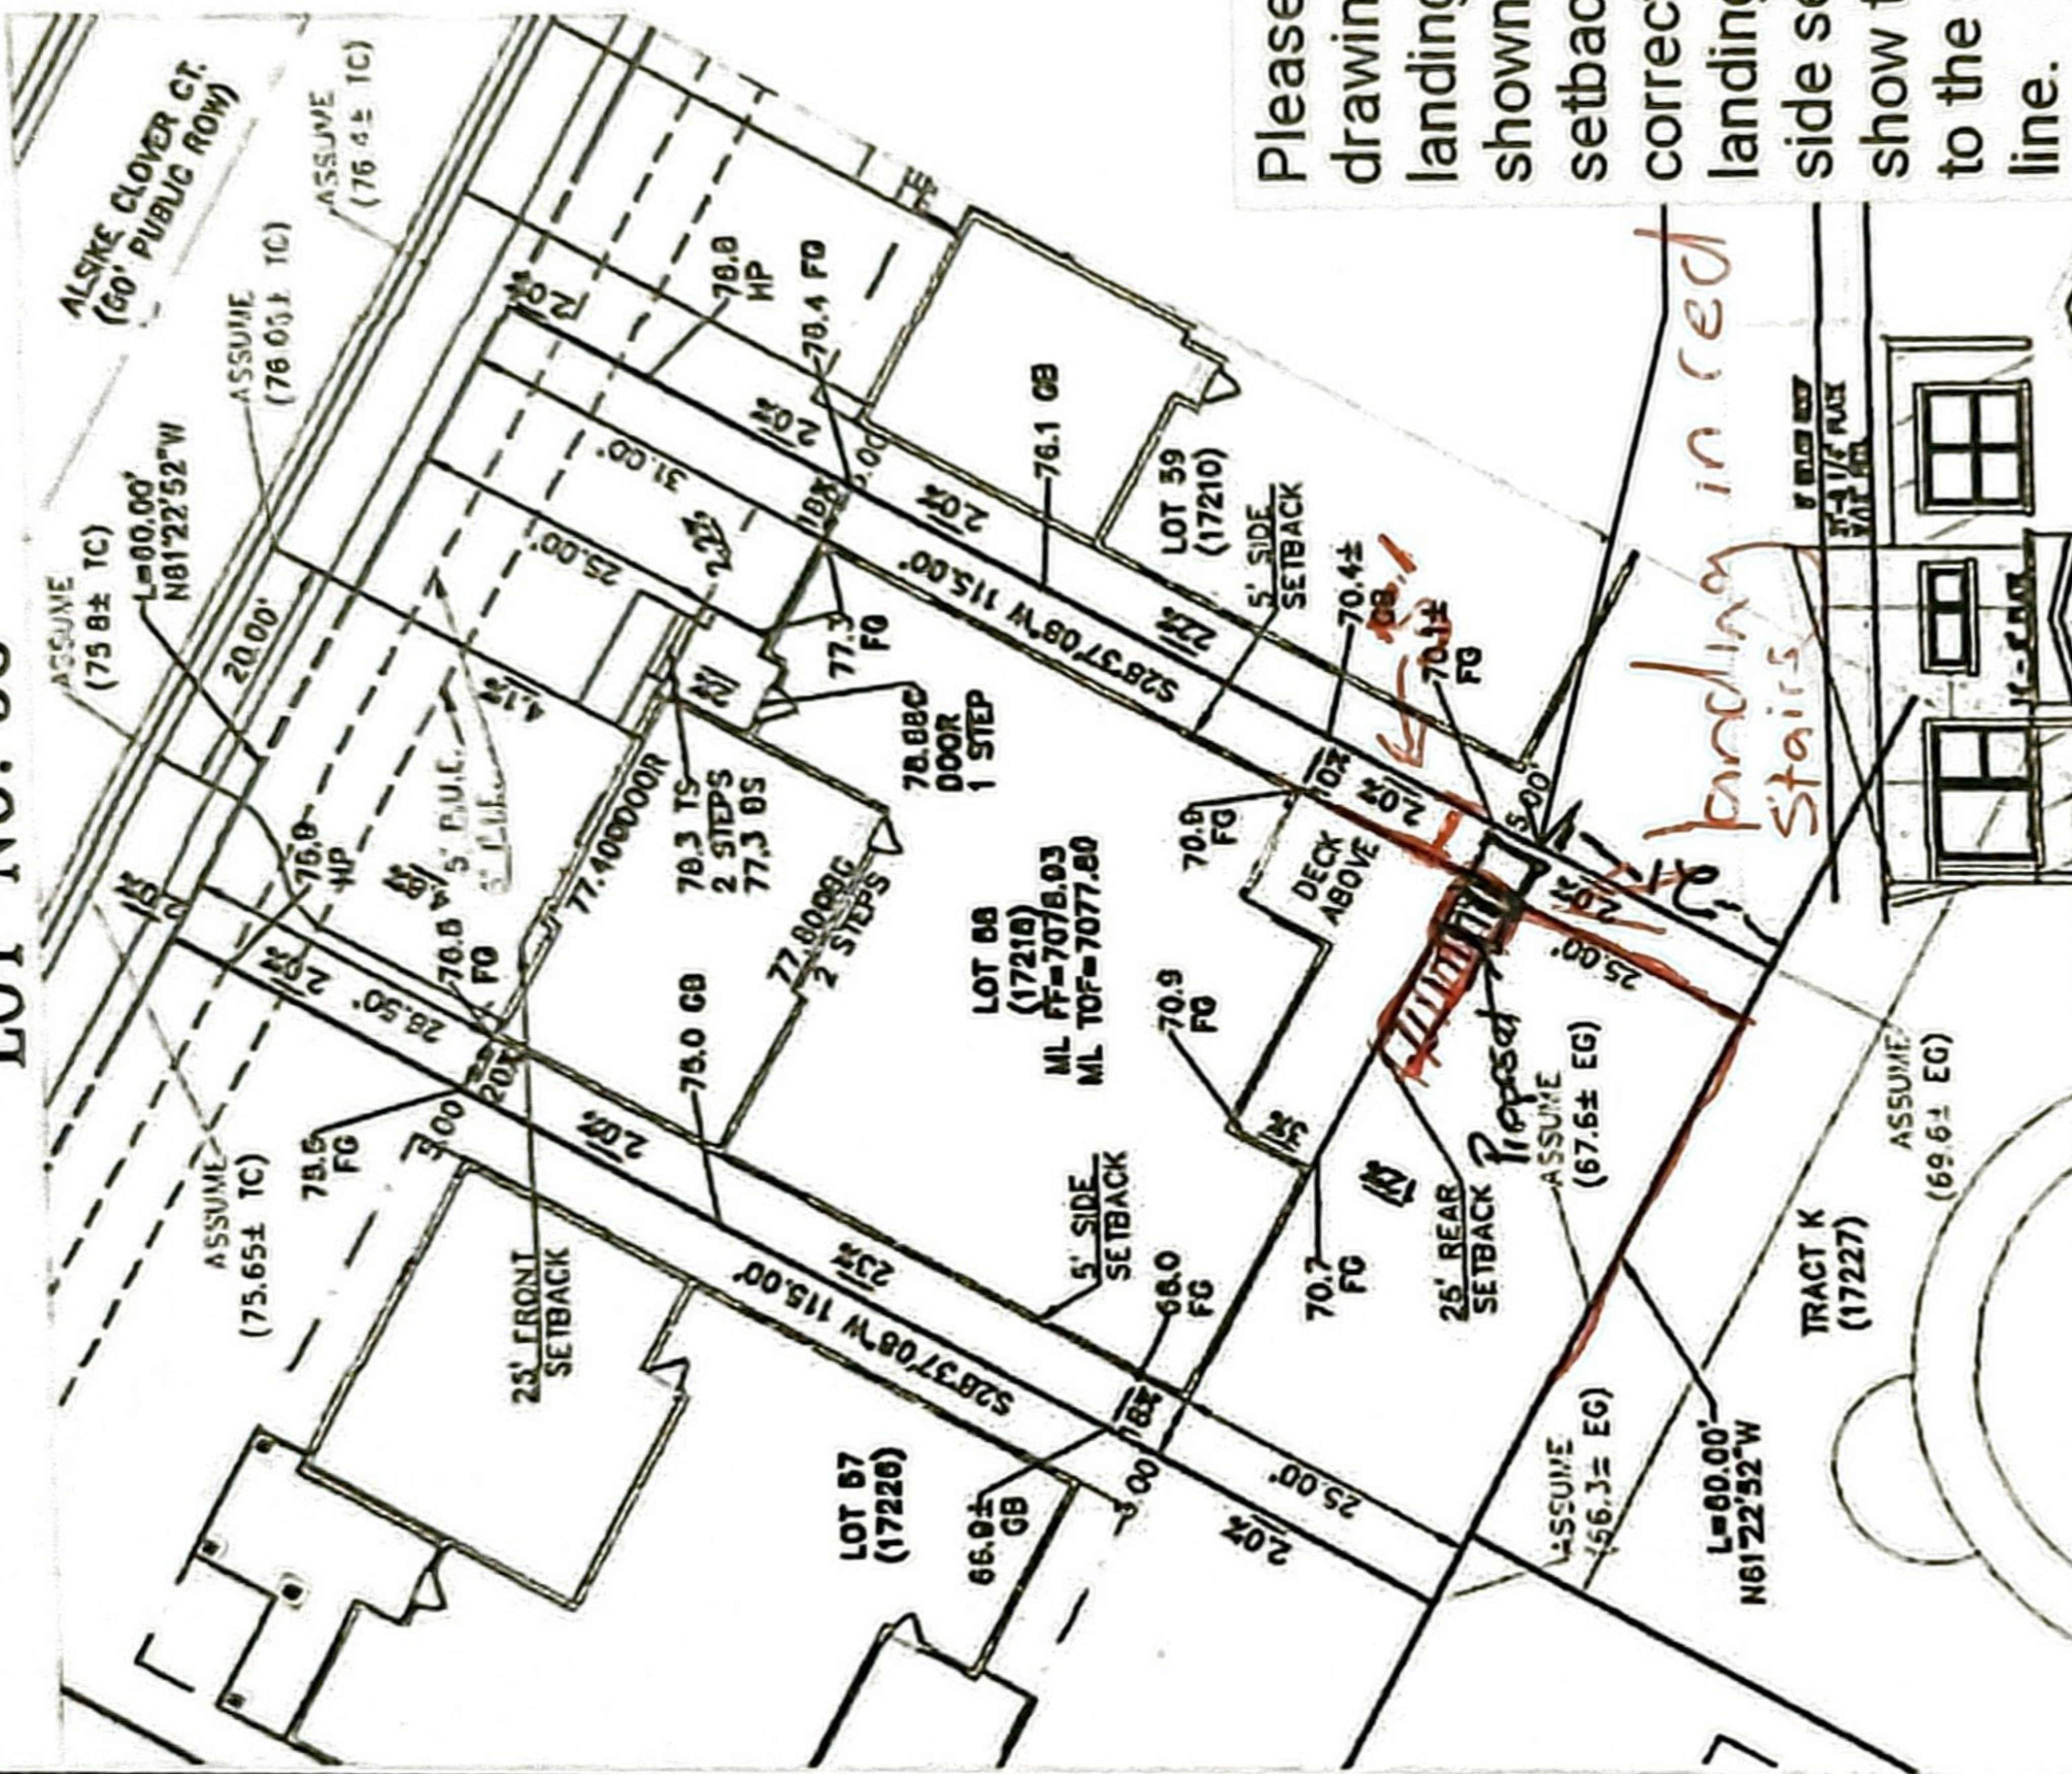

AVERAGE FINISHED GRADE: 7073.1B  
TAX SCHEDULE #: 7124206036  
DRIVEWAY: 42% OF FRONT SETBACK  
HOUSE: 3,168 SF (45.8% OF TOTAL LOT)  
ZONING: RS-5000  
MODEL #: 8885-B

N.A. 2,142 S.F. 962 S.F. 664 S.F.	3,442 S.F. 819 S.F.	8,900 S.F. 3,168 S.F. 45.9% 30.29
SUBMITTER: CLOVERLEAF FILING NO. 2 ADDRESS: 17218 ALSKE CLOVER COURT DATE DRAWN: 1/10/23 DRAWN BY: JF		LOT: 58 / COME COLO. SPGS. EL PASO SINGLE FAMILY
ENGINEER: DAVID WEEKLEY HOMES 7150 CAMPUS DRIVE, STE 320 COLORADO SPRINGS, COLORADO 80920		TERRA NOVA ENGINEERING, INC. 791 S. 2nd Street, Colorado Springs, CO 80904