
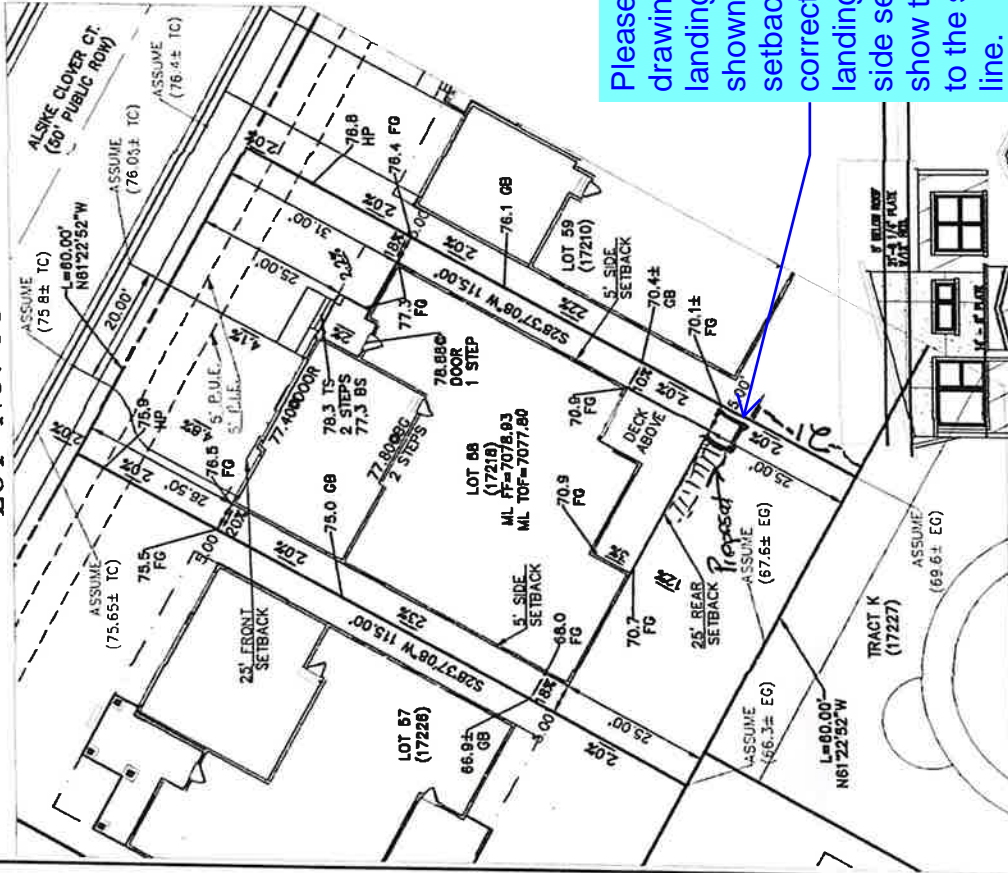


SCALE: 1" = 20'

CLOVERLEAF FILING NO. 2 LOT NO. 58

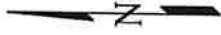

Please add labels to drawing. Is this the landing? If so, it is shown within the side setback. Please correct so that the landing is outside the side setback and show the dimensions to the side property line.

AVERAGE FINISHED GRADE: 7073.18
 TAX SCHEDULE #: 7124206036
 DRIVEWAY: 42% OF FRONT SETBACK
 HOUSE: 3,168 SF (45.9% OF TOTAL LOT)
 ZONING: RS-5000
 MODEL #: 8985-B



BUILDING SQUARE FOOTAGES FLOOR: 3,442 S.F. DRIVEWAY: 819 S.F. GARAGE: 664 S.F.		LOT SIZE INFORMATION LOT AREA: 6,900 S.F. HOUSE: 3,168 S.F. DRIVEWAY: 45.9% GARAGE: 30.2%	
SUBMITTER: CLOVERLEAF FILING NO. 2 ADDRESS: 1718 ALSIKE CLOVER COURT DATE DRAWN: 1/10/23		CITY/COUNTY: COLO. SPGS. EL PASO ZONING: RS-5000 TYPE OF UNIT: SINGLE FAMILY	
DESIGNER: DAVID WEEKLEY HOMES 7150 CAMPUS DRIVE STE 320 COLORADO SPRINGS, COLORADO 80920		ENGINEER: TERRA NOVA ENGINEERING, INC. 721 S. 23rd Street, Colorado Springs, CO 80904	