

GENERAL ELECTRICAL NOTES:

PART 1 - GENERAL

1.1 GENERAL CONDITIONS:

A. CONTRACTOR SHALL INSPECT THE EXISTING SITE CONDITIONS PRIOR TO SUBMITTING BID. ANY QUESTIONS ARISING DURING THE BID PERIOD IN REGARDS TO THE CONTRACTORS FUNCTIONS, THE SCOPE OF WORK, OR ANY OTHER ISSUE RELATED TO THIS PROJECT SHALL BE BROUGHT UP DURING THE BID PERIOD WITH THE PROJECT MANAGER FOR CLARIFICATION. NOT AFTER THE CONTRACT HAS BEEN AWARDED.

B. THE CONTRACTOR SHALL OBTAIN PERMITS, LICENSES, MAKE ALL DEPOSITS, AND PAY ALL FEES REQUIRED FOR THE CONSTRUCTION PERFORMANCE FOR THE WORK UNDER THIS SECTION.

C. DRAWINGS SHOW THE GENERAL ARRANGEMENT OF ALL SYSTEMS AND COMPONENTS COVERED UNDER THIS SECTION. THE CONTRACTOR SHALL VERIFY ALL DIMENSIONS. DRAWING SHALL NOT BE SCALED TO DETERMINE DIMENSIONS.

1.2 LAWS, REGULATIONS, ORDINANCES, STATUTES AND CODES.

A. ALL WORK SHALL BE INSTALLED IN ACCORDANCE WITH THE LATEST EDITION OF THE NATIONAL ELECTRICAL CODE, AND ALL APPLICABLE LOCAL LAWS, REGULATIONS, ORDINANCES, STATUTES AND CODES. CONDUIT BENDS SHALL BE THE RADIUS BEND FOR THE TRADE SIZE OF CONDUIT IN COMPLIANCE WITH THE LATEST EDITIONS OF NEC.

1.3 REFERENCES:

A. THE PUBLICATIONS LISTED BELOW ARE PART OF THIS SPECIFICATION. EACH PUBLICATION SHALL BE THE LATEST REVISION AND ADDENDUM IN EFFECT ON THE DATE. THIS SPECIFICATION IS ISSUED FOR CONSTRUCTION UNLESS OTHERWISE NOTED. EXCEPT AS MODIFIED BY THE REQUIREMENT SPECIFIED HEREIN OR THE DETAILS OF THE DRAWINGS, WORK INCLUDED IN THIS SPECIFICATION SHALL CONFORM TO THE APPLICABLE PROVISION OF THESE PUBLICATIONS.

- 1. ANSII/IEEE (AMERICAN NATIONAL STANDARDS INSTITUTE)
2. ASTM (AMERICAN SOCIETY FOR TESTING AND MATERIALS)
3. ICE (INSULATED CABLE ENGINEERS ASSOCIATION)
4. NEMA (NATIONAL ELECTRICAL MANUFACTURER'S ASSOCIATION)
5. NFPA (NATIONAL FIRE PROTECTION ASSOCIATION)
6. OSHA (OCCUPATIONAL SAFETY AND HEALTH ADMINISTRATION)
7. UL (UNDERWRITERS LABORATORIES, INC.)
8. AT&T GROUNDING AND BONDING STANDARDS TP-76416

1.4 SCOPE OF WORK:

A. WORK UNDER THIS SECTION SHALL CONSIST OF FURNISHING ALL LABOR, MATERIAL, AND ASSOCIATED SERVICES REQUIRED TO COMPLETE REQUIRED CONSTRUCTION AND BE OPERATIONAL.

B. ALL ELECTRICAL EQUIPMENT UNDER THIS CONTRACT SHALL BE PROPERLY TESTED, ADJUSTED, AND ALIGNED BY THE CONTRACTOR.

C. THE CONTRACTOR SHALL BE RESPONSIBLE FOR ALL EXCAVATING, DRAINING, TRENCHES, BACKFILLING, AND REMOVAL OF EXCESS DIRT.

D. THE CONTRACTOR SHALL FURNISH TO THE OWNER WITH CERTIFICATES OF A FINAL INSPECTION AND APPROVAL FROM THE INSPECTION AUTHORITIES HAVING JURISDICTION.

E. THE CONTRACTOR SHALL PREPARE A COMPLETE SET OF AS-BUILT DRAWINGS, DOCUMENT ALL WIRING EQUIPMENT CONDITIONS, AND CHANGES WHILE COMPLETING THIS CONTRACT. THE AS-BUILT DRAWINGS SHALL BE SUBMITTED AT COMPLETION OF THE PROJECT.

PART 2 - PRODUCTS

2.1 GENERAL:

A. ALL MATERIALS AND EQUIPMENT SHALL BE UL LISTED, NEW, AND FREE FROM DEFECTS.

B. ALL ITEMS OF MATERIALS AND EQUIPMENT SHALL BE ACCEPTABLE TO THE AUTHORITY HAVING JURISDICTION AS SUITABLE FOR THE USE INTENDED.

C. ALL EQUIPMENT SHALL BEAR THE UNDERWRITERS LABORATORIES LABEL OF APPROVAL, AND SHALL CONFORM TO REQUIREMENT OF THE NATIONAL ELECTRICAL CODE.

D. ALL OVERCURRENT DEVICES SHALL HAVE AN INTERRUPTING CURRENT RATING THAT SHALL BE GREATER THAN THE SHORT CIRCUIT CURRENT TO WHICH THEY ARE SUBJECTED, 10,000 AIC MINIMUM. VERIFY AVAILABLE SHORT CIRCUIT CURRENT DOES NOT EXCEED THE RATING OF ELECTRICAL EQUIPMENT IN ACCORDANCE WITH ARTICLE 110.24 NEC OR THE MOST CURRENT ADOPTED CODE PER THE GOVERNING JURISDICTION.

2.2 MATERIALS AND EQUIPMENT:

A. CONDUIT:

1. RIGID METAL CONDUIT (RMC) SHALL BE HOT-DIPPED GALVANIZED INSIDE AND OUTSIDE INCLUDING ENDS AND THREADS AND ENAMELED OR LACQUERED INSIDE IN ADDITION TO GALVANIZING.

2. LIQUIDTIGHT FLEXIBLE METAL CONDUIT SHALL BE UL LISTED.

3. CONDUIT CLAMPS, STRAPS AND SUPPORTS SHALL BE STEEL OR MALLEABLE IRON. ALL FITTINGS SHALL BE COMPRESSION AND CONCRETE TIGHT TYPE. GROUNDING BUSHINGS WITH INSULATED THROATS SHALL BE INSTALLED ON ALL CONDUIT TERMINATIONS.

4. NONMETALLIC CONDUIT AND FITTINGS SHALL BE SCHEDULE 40 PVC. INSTALL USING SOLVENT-CEMENT-TYPE JOINTS AS RECOMMENDED BY THE MANUFACTURER.

B. CONDUCTORS AND CABLE:

1. CONDUCTORS AND CABLE SHALL BE FLAME-RETARDANT, MOISTURE AND HEAT RESISTANT THERMOPLASTIC, SINGLE CONDUCTOR, COPPER, TYPE THHN/THWN-2, 600 VOLT, SIZE AS INDICATED, #12 AWG SHALL BE THE MINIMUM SIZE CONDUCTOR USED.

2. #10 AWG AND SMALLER CONDUCTOR SHALL BE SOLID OR STRANDED AND #8 AWG AND LARGER CONDUCTORS SHALL BE STRANDED.

3. SOLDERLESS, COMPRESSION-TYPE CONNECTORS SHALL BE USED FOR TERMINATION OF ALL STRANDED CONDUCTORS.

4. STRAIN-RELIEF SUPPORTS GRIPS SHALL BE HUBBELL KELLEMS OR APPROVED EQUAL. CABLES SHALL BE SUPPORTED IN ACCORDANCE WITH THE NEC AND CABLE MANUFACTURER'S RECOMMENDATIONS. ALL CONDUCTORS SHALL BE TAGGED AT BOTH ENDS OF THE CONDUCTOR, AT ALL PULL.

5. BOXES, J-BOXES, EQUIPMENT AND CABINETS AND SHALL BE IDENTIFIED WITH APPROVED PLASTIC TAGS (ACTION CRAFT, BRADY, OR APPROVED EQUAL).

C. DISCONNECT SWITCHES:

1. DISCONNECT SWITCHES SHALL BE HEAVY DUTY, DEAD-FRONT, QUICK-MAKE, QUICK-BREAK, EXTERNALLY OPERABLE, HANDLE LOCKABLE AND INTERLOCK WITH COVER IN CLOSED POSITION, RATING AS INDICATED, UL LABELED FURNISHED IN NEMA 3R ENCLOSURE, SQUARE-D OR ENGINEERED APPROVED EQUAL.

D. CHEMICAL ELECTROLYTIC GROUNDING SYSTEM:

1. INSTALL CHEMICAL GROUNDING AS REQUIRED. THE SYSTEM SHALL BE ELECTROLYTIC MAINTENANCE FREE ELECTRODE CONSISTING OF RODS WITH A MINIMUM #2 AWG CU EXOTHERMALLY WELDED PIGTAIL, PROTECTIVE BOXES, AND BACKFILL MATERIAL. MANUFACTURER SHALL BE LYNCOLE XIT GROUNDING ROD TYPES K2-(*)CS OR K2L-(*)CS (*) LENGTH AS REQUIRED.

2. GROUND ACCESS BOX SHALL BE A POLYPLASTIC BOX FOR NON-TRAFFIC APPLICATIONS, INCLUDING BOLT DOWN FLUSH COVER WITH "BREATHER" HOLES, XIT MODEL #XB-22. ALL DISCONNECT SWITCHES AND CONTROLLING DEVICES SHALL BE PROVIDED WITH ENGRAVED LAMICOID NAMEPLATES INDICATING EQUIPMENT CONTROLLED, BRANCH CIRCUITS ID NUMBERING, AND THE ELECTRICAL POWER SOURCE.

3. BACKFILL MATERIAL SHALL BE LYNCONITE AND LYNCOLE GROUNDING GRAVEL.

E. SYSTEM GROUNDING:

1. ALL GROUNDING COMPONENTS SHALL BE TINNED AND GROUNDING CONDUCTOR SHALL BE #2 AWG BARE, SOLID, TINNED, COPPER. ABOVE GRADE GROUNDING CONDUCTORS SHALL BE INSULATED WHERE NOTED.

2. GROUNDING BUSES SHALL BE BARE, TINNED, ANNEALED COPPER BARS OF RECTANGULAR CROSS SECTION. STANDARD BUS BARS MGB, SHALL BE FURNISHED AND INSTALLED BY THE CONTRACTOR. THEY SHALL NOT BE FABRICATED OR MODIFIED IN THE FIELD. ALL GROUNDING BUSES SHALL BE IDENTIFIED WITH MINIMUM 3/4" LETTERS BY WAY OF STENCILING OR DESIGNATION PLATE.

3. CONNECTORS SHALL BE HIGH-CONDUCTIVITY, HEAVY DUTY, LISTED AND LABELED AS GROUNDING CONNECTORS FOR THE MATERIALS USED. USE TWO-HOLE COMPRESSION LUGS WITH CLEAR HEAT SHRINK FOR MECHANICAL CONNECTIONS. USE TWO-HOLE COMPRESSION LUGS WITH INSPECTION WINDOW AND CLEAR HEAT SHRINK.

4. EXOTHERMIC WELDED CONNECTIONS SHALL BE PROVIDED IN KIT FORM AND SELECTED FOR THE SPECIFIC TYPES, SIZES, AND COMBINATIONS OF CONDUCTORS AND OTHER ITEMS TO BE CONNECTED.

5. GROUND RODS SHALL BE ERICO #615800, COPPER-CLAD STEEL WITH HIGH-STRENGTH STEEL CORE AND ELECTROLYTIC-GRADE COPPER OUTER SHEATH, MOLTEN WELDED TO CORE, 5/8"x10'-0". ALL GROUNDING RODS SHALL BE INSTALLED WITH INSPECTION SLEEVES.

6. INSTALL AN EQUIPMENT GROUNDING CONDUCTOR IN ALL CONDUITS IN COMPLIANCE WITH THE AT&T SPECIFICATIONS AND NEC. THE EQUIPMENT GROUNDING CONDUCTORS SHALL BE BONDED AT ALL JUNCTION BOXES, PULLBOXES, DISCONNECT SWITCHES, STARTERS, AND EQUIPMENT CABINETS.

F. OTHER MATERIALS:

1. THE CONTRACTOR SHALL PROVIDE OTHER MATERIALS, THOUGH NOT SPECIFICALLY DESCRIBED, WHICH ARE REQUIRED FOR A COMPLETELY OPERATIONAL SYSTEM AND PROPER INSTALLATION OF THE WORK.

2. PROVIDE PULL BOXES AND JUNCTION BOXES WHERE SHOWN OR REQUIRED BY NEC.

G. PANELS AND LOAD CENTERS:

1. ALL PANEL DIRECTORIES SHALL BE TYPEWRITTEN.

PART 3 - EXECUTION

3.1 GENERAL:

A. ALL MATERIAL AND EQUIPMENT SHALL BE INSTALLED IN STRICT ACCORDANCE WITH THE MANUFACTURER'S RECOMMENDATIONS.

B. B. EQUIPMENT SHALL BE TIGHTLY COVERED AND PROTECTED AGAINST DIRT OR WATER, AND AGAINST CHEMICAL OR MECHANICAL INJURY DURING INSTALLATION AND CONSTRUCTION PERIODS.

3.2 LABOR AND WORKMANSHIP:

A. ALL LABOR FOR THE INSTALLATION OF MATERIALS AND EQUIPMENT FURNISHED FOR THE ELECTRICAL SYSTEM SHALL BE INSTALLED BY EXPERIENCED WIREMEN, IN A NEAT AND WORKMAN-LIKE MANNER.

B. ALL ELECTRICAL EQUIPMENT SHALL BE ADJUSTED, ALIGNED AND TESTED BY THE CONTRACTOR AS REQUIRED TO PRODUCE THE INTENDED PERFORMANCE.

C. UPON COMPLETION OF WORK, THE CONTRACTOR SHALL THOROUGHLY CLEAN ALL EXPOSED EQUIPMENT, REMOVE ALL LABELS AND ANY DEBRIS, CRATING OR CARTONS AND LEAVE THE INSTALLATION FINISHED AND READY FOR OPERATION.

3.3 COORDINATION:

A. THE CONTRACTOR SHALL COORDINATE THE INSTALLATION OF ELECTRICAL ITEMS WITH THE OWNER-FURNISHED EQUIPMENT DELIVERY SCHEDULE TO PREVENT UNNECESSARY DELAYS IN THE TOTAL WORK.

3.4 INSTALLATION:

A. CONDUIT:

1. ALL ELECTRICAL WIRING SHALL BE INSTALLED IN CONDUIT AS SPECIFIED. NO CONDUIT OR TUBING OF LESS THAN 3/4 INCH TRADE SIZE.

2. PROVIDE RIGID PVC SCHEDULE 80 CONDUITS FOR ALL RISERS, RMC OTHERWISE NOTED. EMT MAY BE INSTALLED FOR EXTERIOR CONDUITS WHERE NOT SUBJECT TO PHYSICAL DAMAGE.

3. INSTALL SCH. 40 PVC CONDUIT WITH A MINIMUM COVER OF 24" UNDER ROADWAYS, PARKING LOTS, STREETS, AND ALLEYS. CONDUIT SHALL HAVE A MINIMUM COVER OF 18" IN ALL OTHER NON-TRAFFIC APPLICATIONS (REFER TO 2011 NEC, TABLE 300.5).

4. USE GALVANIZED FLEXIBLE STEEL CONDUIT WHERE DIRECT CONNECTION TO EQUIPMENT WITH MOVEMENT, VIBRATION, OR FOR EASE OF MAINTENANCE. USE LIQUID TIGHT, FLEXIBLE METAL CONDUIT FOR OUTDOOR APPLICATIONS. INSTALL GALVANIZED FLEXIBLE STEEL CONDUIT AT ALL POINTS OF CONNECTION TO EQUIPMENT MOUNTED ON SUPPORT TO ALLOW FOR EXPANSION AND CONTRACTION.

5. A RUN OF CONDUIT BETWEEN BOXES OR EQUIPMENT SHALL NOT CONTAIN MORE THAN THE EQUIVALENT OF THREE QUARTER-BENDS. CONDUIT BEND SHALL BE MADE WITH THE UL LISTED BENDER OR FACTORY 90 DEGREE ELBOWS MAY BE USED.

6. FIELD FABRICATED CONDUITS SHALL BE CUT SQUARE WITH A CONDUIT CUTTING TOOL AND REAMED TO PROVIDE A SMOOTH INSIDE SURFACE.

7. PROVIDE INSULATED GROUNDING BUSHING FOR ALL CONDUITS.

8. CONTRACTOR IS RESPONSIBLE FOR PROTECTING ALL CONDUITS DURING CONSTRUCTION. TEMPORARY OPENINGS IN THE CONDUIT SYSTEM SHALL BE PLUGGED OR CAPPED TO PREVENT ENTRANCE OF MOISTURE OR FOREIGN MATTER. CONTRACTOR SHALL REPLACE ANY CONDUITS CONTAINING FOREIGN MATERIALS THAT CANNOT BE REMOVED.

9. ALL CONDUITS SHALL BE SWABBED CLEAN BY PULLING AN APPROPRIATE SIZE MANDREL THROUGH THE CONDUIT BEFORE INSTALLATION OF CONDUCTORS OR CABLES. CONDUIT SHALL BE FREE OF DIRT AND DEBRIS.

10. INSTALL PULL STRINGS IN ALL CLEAN EMPTY CONDUITS. IDENTIFY PULL STRINGS AT EACH END.

11. INSTALL 2" HIGHLY VISIBLE AND DETECTABLE TAPE 12" ABOVE ALL UNDERGROUND CONDUITS AND CONDUCTORS.

12. CONDUITS SHALL BE INSTALLED IN SUCH A MANNER AS TO INSURE AGAINST COLLECTION OF TRAPPED CONDENSATION.

13. PROVIDE CORE DRILLING AS NECESSARY FOR PENETRATIONS TO ALLOW FOR RACEWAYS AND CABLES TO BE ROUTED THROUGH THE BUILDING. DO NOT PENETRATE STRUCTURAL MEMBERS. SLEEVES AND/OR PENETRATIONS IN FIRE RATED CONSTRUCTION SHALL BE EFFECTIVELY SEALED WITH FIRE RATED MATERIAL WHICH SHALL MAINTAIN THE FIRE RATING OF THE WALL OR STRUCTURE. FIRE STOPS AT FLOOR PENETRATIONS SHALL PREVENT PASSAGE OF WATER, SMOKE, FIRE, AND FUMES. ALL MATERIAL SHALL BE UL APPROVED FOR THIS PURPOSE.

B. CONDUCTORS AND CABLE:

1. ALL POWER WIRING SHALL BE COLOR CODED AS FOLLOWS:

Table with 2 columns: DESCRIPTION and 208/240/120 VOLT SYSTEMS. Rows include PHASE A (BLACK), PHASE B (RED), PHASE C (BLUE), NEUTRAL (WHITE), and GROUNDING (GREEN).

2. SPLICES SHALL BE MADE ONLY AT OUTLETS, JUNCTION BOXES, OR ACCESSIBLE RACEWAY CONDUITS APPROVED FOR THIS PURPOSE.

3. PULLING LUBRICANTS SHALL BE UL APPROVED. CONTRACTOR SHALL USE NYLON OR HEMP ROPE FOR PULLING CONDUCTOR OR CABLES INTO THE CONDUIT.

4. CABLES SHALL BE NEATLY TRAINED, WITHOUT INTERLACING, AND BE OF SUFFICIENT LENGTH IN ALL BOXES & EQUIPMENT TO PERMIT MAKING A NEAT ARRANGEMENT. CABLES SHALL BE SECURED IN A MANNER TO AVOID TENSION ON CONDUCTORS OR TERMINALS. CONDUCTORS SHALL BE PROTECTED FROM MECHANICAL INJURY AND MOISTURE. SHARP BENDS OVER CONDUIT BUSHINGS IS PROHIBITED. DAMAGED CABLES SHALL BE REMOVED AND REPLACED AT THE CONTRACTOR'S EXPENSE.

C. DISCONNECT SWITCHES:

1. INSTALL DISCONNECT SWITCHES LEVEL AND PLUMB. CONNECT TO WIRING SYSTEM AND GROUNDING SYSTEM AS INDICATED.

D. GROUNDING:

1. ALL METALLIC PARTS OF ELECTRICAL EQUIPMENT WHICH DO NOT CARRY CURRENT SHALL BE GROUNDED IN ACCORDANCE WITH THE REQUIREMENTS OF THE BUILDING MANUFACTURER, AT&T GROUNDING AND BONDING STANDARDS TP-76416, ND-00135, AND THE NATIONAL ELECTRICAL CODE.

2. PROVIDE ELECTRICAL GROUNDING AND BONDING SYSTEM INDICATED WITH ASSEMBLY OF MATERIALS, INCLUDING GROUNDING ELECTRODES, BONDING JUMPERS AND ADDITIONAL ACCESSORIES AS REQUIRED FOR A COMPLETE INSTALLATION.

3. ALL GROUNDING CONDUCTORS SHALL PROVIDE A STRAIGHT DOWNWARD PATH TO GROUND WITH GRADUAL BEND AS REQUIRED. GROUNDING CONDUCTORS SHALL NOT BE LOOPED OR SHARPLY BENT. ROUTE GROUNDING CONNECTIONS AND CONDUCTORS TO GROUND IN THE SHORTEST AND STRAIGHTEST PATHS POSSIBLE TO MINIMIZE TRANSIENT VOLTAGE RISES. BUILDINGS AND/OR NEW TOWERS GREATER THAN 75 FEET IN HEIGHT AND WHERE THE MAIN

4. GROUNDING CONDUCTORS ARE REQUIRED TO BE ROUTED TO GRADE. THE CONTRACTOR SHALL ROUTE TWO GROUNDING CONDUCTORS FROM THE ROOFTOP, TOWERS, AND WATER TOWERS GROUND RING, TO THE EXISTING GROUNDING SYSTEM. THE GROUNDING CONDUCTORS SHALL NOT BE SMALLER THAN #2 AWG COPPER. ROOFTOP GROUND RING SHALL BE BONDED TO THE EXISTING GROUNDING SYSTEM, THE BUILDING STEEL COLUMNS, LIGHTNING PROTECTION SYSTEM, AND BUILDING MAIN WATER LINE (FERROUS OR NONFERROUS METAL PIPING ONLY). SEE STANDARD 6.3.2.2.

5. TIGHTEN GROUNDING AND BONDING CONNECTORS, INCLUDING SCREWS AND BOLTS, IN ACCORDANCE WITH MANUFACTURER'S PUBLISHED TORQUE TIGHTENING VALUES FOR CONNECTORS AND BOLTS. WHERE MANUFACTURER'S TORQUING REQUIREMENTS ARE NOT AVAILABLE, TIGHTEN CONNECTIONS TO COMPLY WITH TIGHTENING TORQUE VALUES SPECIFIED IN UL TO ASSURE PERMANENT AND EFFECTIVE GROUNDING. CONTRACTOR SHALL VERIFY THE LOCATIONS OF GROUNDING TIE-IN-POINTS TO THE EXISTING

6. ALL UNDERGROUND GROUNDING CONNECTIONS SHALL BE MADE BY THE GROUNDING SYSTEM. EXOTHERMIC WELD PROCESS AND INSTALLED IN ACCORDANCE WITH THE MANUFACTURER'S INSTRUCTIONS.

7. ALL GROUNDING CONNECTIONS SHALL BE INSPECTED FOR TIGHTNESS. EXOTHERMIC WELDED CONNECTIONS SHALL BE APPROVED BY THE INSPECTOR HAVING JURISDICTION BEFORE BEING PERMANENTLY CONCEALED.

8. APPLY CORROSION-RESISTANCE FINISH TO FIELD CONNECTIONS AND PLACES WHERE FACTORY APPLIED PROTECTIVE COATINGS HAVE BEEN DESTROYED.

9. A SEPARATE, CONTINUOUS, INSULATED EQUIPMENT GROUNDING CONDUCTOR SHALL BE INSTALLED IN ALL FEEDER AND BRANCH CIRCUITS.

10. BOND ALL INSULATED GROUNDING BUSHINGS WITH A BARE 6 AWG GROUNDING CONDUCTOR TO A GROUND BUS.

11. DIRECT BURIED GROUNDING CONDUCTORS SHALL BE INSTALLED AT A NOMINAL DEPTH OF 36" MINIMUM BELOW GRADE, OR 6" BELOW THE FROST LINE, USE THE GREATER OF THE TWO DISTANCES.

12. ALL GROUNDING CONDUCTORS EMBEDDED IN OR PENETRATING CONCRETE SHALL BE INSTALLED IN SCHEDULE 40 PVC CONDUIT.

13. THE INSTALLATION OF CHEMICAL ELECTROLYTIC GROUNDING SYSTEM IN STRICT ACCORDANCE WITH MANUFACTURER'S INSTRUCTIONS. REMOVE SEALING TAPE FROM LEACHING AND BREATHER HOLES. INSTALL PROTECTIVE BOX FLUSH WITH GRADE.

14. DRIVE GROUND RODS UNTIL TOPS ARE A MINIMUM DISTANCE OF 36" DEPTH OR 6" BELOW FROST LINE, USING THE GREATER OF THE TWO DISTANCES.

15. IF COAX ON THE ICE BRIDGE IS MORE THAN 6 FT. FROM THE GROUND BAR AT THE BASE OF THE TOWER, A SECOND GROUND BAR WILL BE NEEDED AT THE END OF THE ICE BRIDGE, TO GROUND THE COAX CABLE GROUNDING KITS AND IN-LINE ARRESTORS

16. CONTRACTOR SHALL REPAIR, AND/OR REPLACE, EXISTING GROUNDING SYSTEM COMPONENTS DAMAGED DURING CONSTRUCTION AT THE CONTRACTORS EXPENSE.

3.5 ACCEPTANCE TESTING

A. CERTIFIED PERSONNEL USING CERTIFIED EQUIPMENT SHALL PERFORM REQUIRED TESTS AND SUBMIT WRITTEN TEST REPORTS UPON COMPLETION.

B. WHEN MATERIAL AND/OR WORKMANSHIP IS FOUND NOT TO COMPLY WITH THE SPECIFIED REQUIREMENTS, THE NON-COMPLYING ITEMS SHALL BE REMOVED FROM THE PROJECT SITE AND REPLACED WITH ITEMS COMPLYING WITH THE SPECIFIED REQUIREMENTS PROMPTLY AFTER RECEIPT OF NOTICE FOR NON-COMPLIANCE.

C. TEST PROCEDURES:


1. ALL FEEDERS SHALL HAVE INSULATION TESTED AFTER INSTALLATION, BEFORE CONNECTION TO DEVICES. THE CONDUCTORS SHALL TEST FREE FROM SHORT CIRCUITS AND GROUNDS. TESTING SHALL BE FOR ONE MINUTE USING 1000V DC. PROVIDE WRITTEN DOCUMENTATION FOR ALL TEST RESULTS.

2. PRIOR TO ENERGIZING CIRCUITRY, TEST WIRING DEVICES FOR ELECTRICAL CONTINUITY AND PROPER POLARITY CONNECTIONS.

3. MEASURE AND RECORD VOLTAGES BETWEEN PHASES AND BETWEEN PHASE CONDUCTORS AND NEUTRALS. SUBMIT A REPORT OF MAXIMUM AND MINIMUM VOLTAGES


4. PERFORM GROUNDING TEST TO MEASURE GROUNDING RESISTANCE OF GROUNDING SYSTEM USING THE IEEE STANDARD 3-POINT "FALL-OF-POTENTIAL" METHOD. PROVIDE PLOTTED TEST VALUES AND LOCATION SKETCH. NOTIFY THE ENGINEER IMMEDIATELY IF MEASURED VALUE IS OVER 5 OHMS.

AT&T Site ID: COL02568
6915 SPACE VILLAGE AVENUE
COLORADO SPRINGS, CO 80915

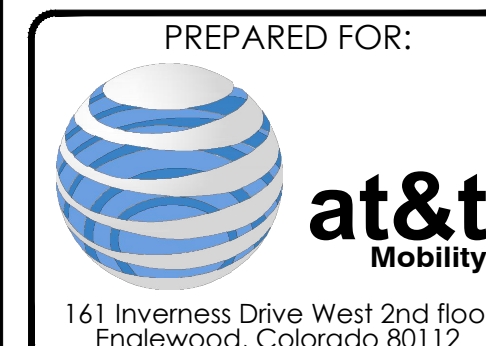

AT&T SITE NO: COL02568
BU NO: 823722
DRAWN BY: AK
CHECKED BY: CM

Table with 3 columns: REV, DATE, DESCRIPTION. Rows A, B, C with revision details.

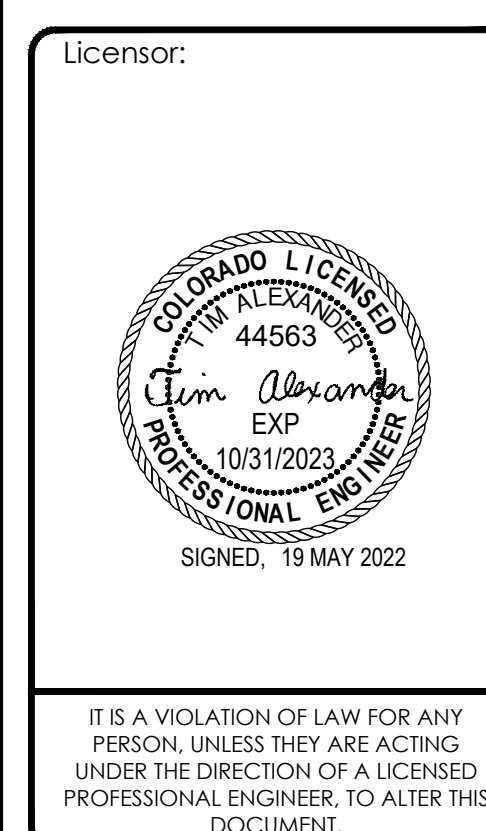

Issued For: 5/19/22
PRELIMINARY CD'S

SHEET TITLE: GENERAL NOTES


SHEET NUMBER: GN-6

AT&T Site ID:
COL02568
6915 SPACE VILLAGE
AVENUE
COLORADO SPRINGS,
CO 80915

Tower Owner:



PREPARED FOR:

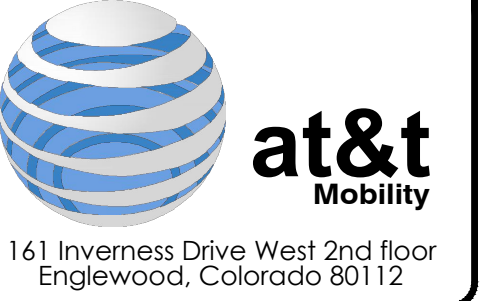

A&E:



AT&T SITE NO: COL02568

BU NO: 823722

DRAWN BY: AK

CHECKED BY: CM

REV	DATE	DESCRIPTION
A	2/25/22	PRELIMINARY CD'S
B	03/21/22	CLIENT REVISIONS
C	5/19/22	CLIENT REVISIONS

Licensor:



IT IS A VIOLATION OF LAW FOR ANY PERSON, UNLESS THEY ARE ACTING UNDER THE DIRECTION OF A LICENSED PROFESSIONAL ENGINEER, TO ALTER THIS DOCUMENT.

Issued For:

5/19/22


PRELIMINARY CD'S

SHEET TITLE:

DETAILS


SHEET NUMBER:

A-5

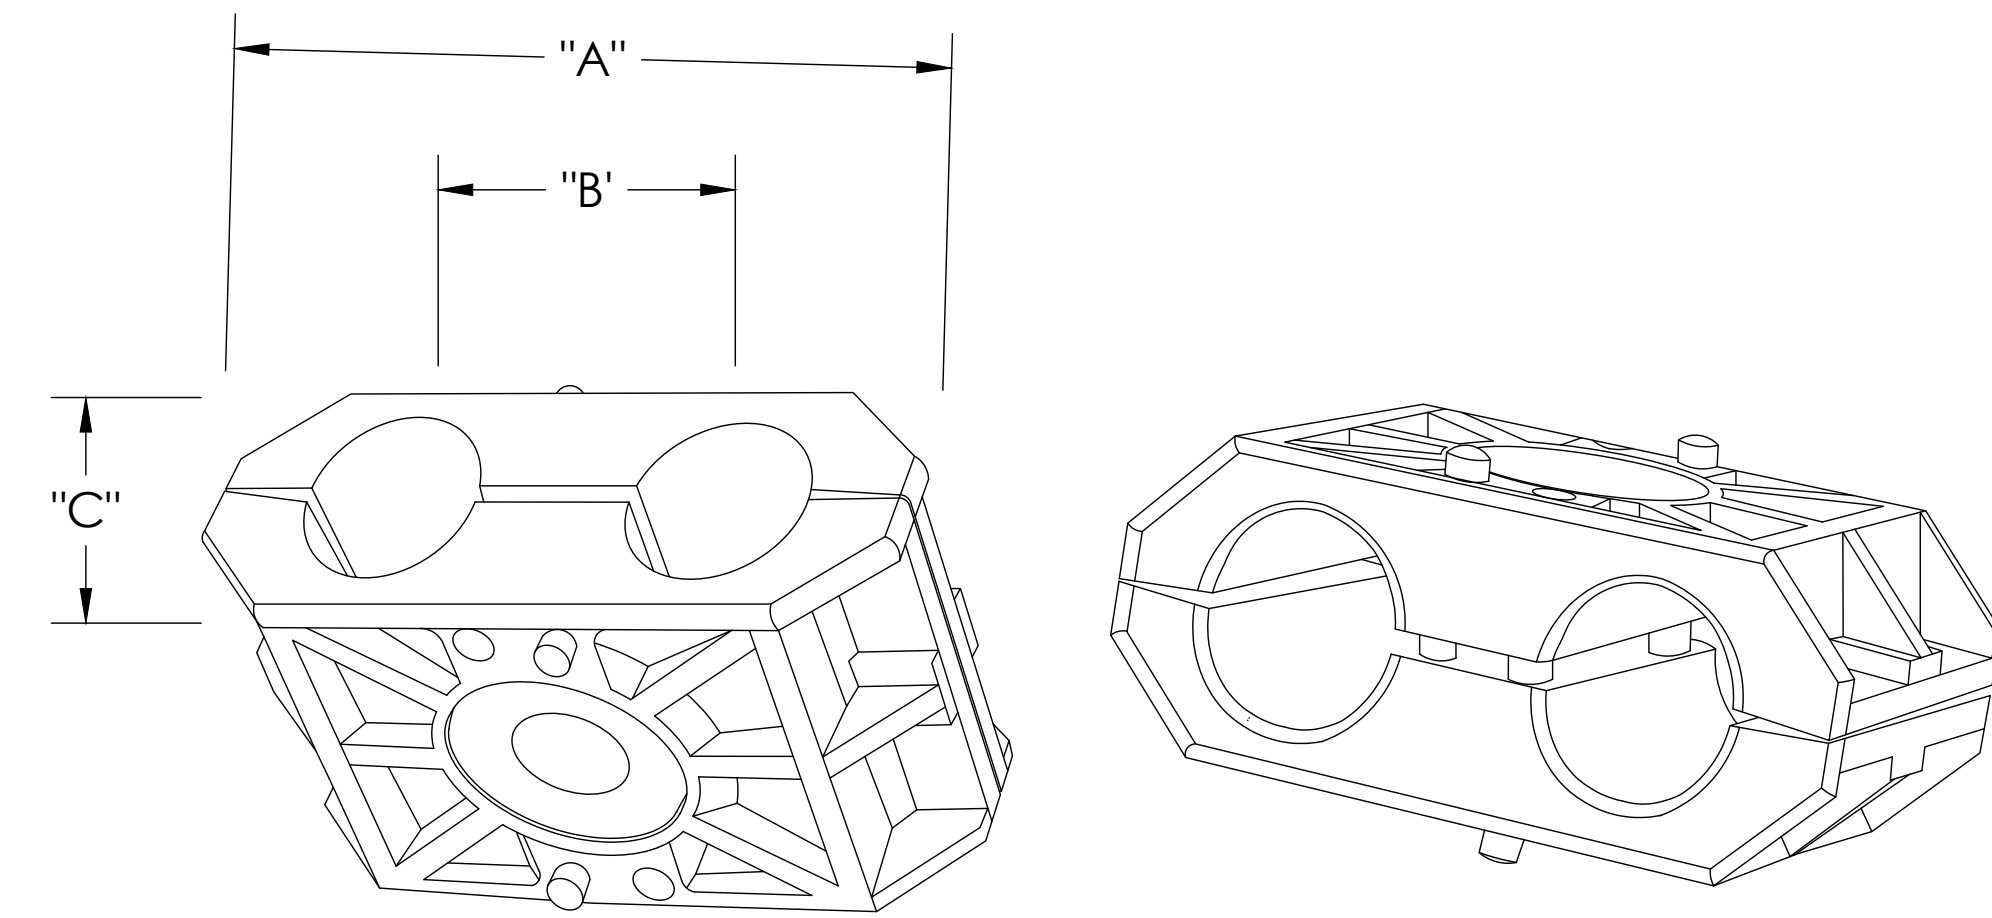

PART #	CABLE SIZE & TYPE	U of M	Weight/ 10 pk	A	B	C
CXB4	Fiber Kit (4-6mm)	10 PACK	1.3 lb	2-1/2"	1-1/4"	1"
CXB14-2	1/4" Cable (6-8mm)	10 PACK	0.20 lb	1-1/4"	3/4"	5/8"
CXB38	3/8" Cables & LMR400 (10-12 mm)	10 PACK	0.30 lb	1-5/8"	1"	7/8"
CXB12	1/2" Corrugated (15.5-17.5 mm)	10 PACK	0.60 lb	2-1/4"	1-1/4"	1"
CXB78	7/8" Corrugated (27-29 mm)	10 PACK	1.0 lb	3"	2"	1-1/4"
CXB114	1-1/4" Corrugated (39-42 mm)	10 PACK	1.6 lb	4-1/8"	2-1/2"	1-7/8"
CXB158	1-5/8" Corrugated (50-54 mm)	10 PACK	2.5 lb	5"	2-3/4"	2-1/2"
CXB214	2-1/4" Corrugated (60-65 mm)	10 PACK	3.0 lb	6"	3-1/8"	2-3/4"

6 JUMPER ATTACHMENT/CABLE BLOCK DETAIL
NOT TO SCALE

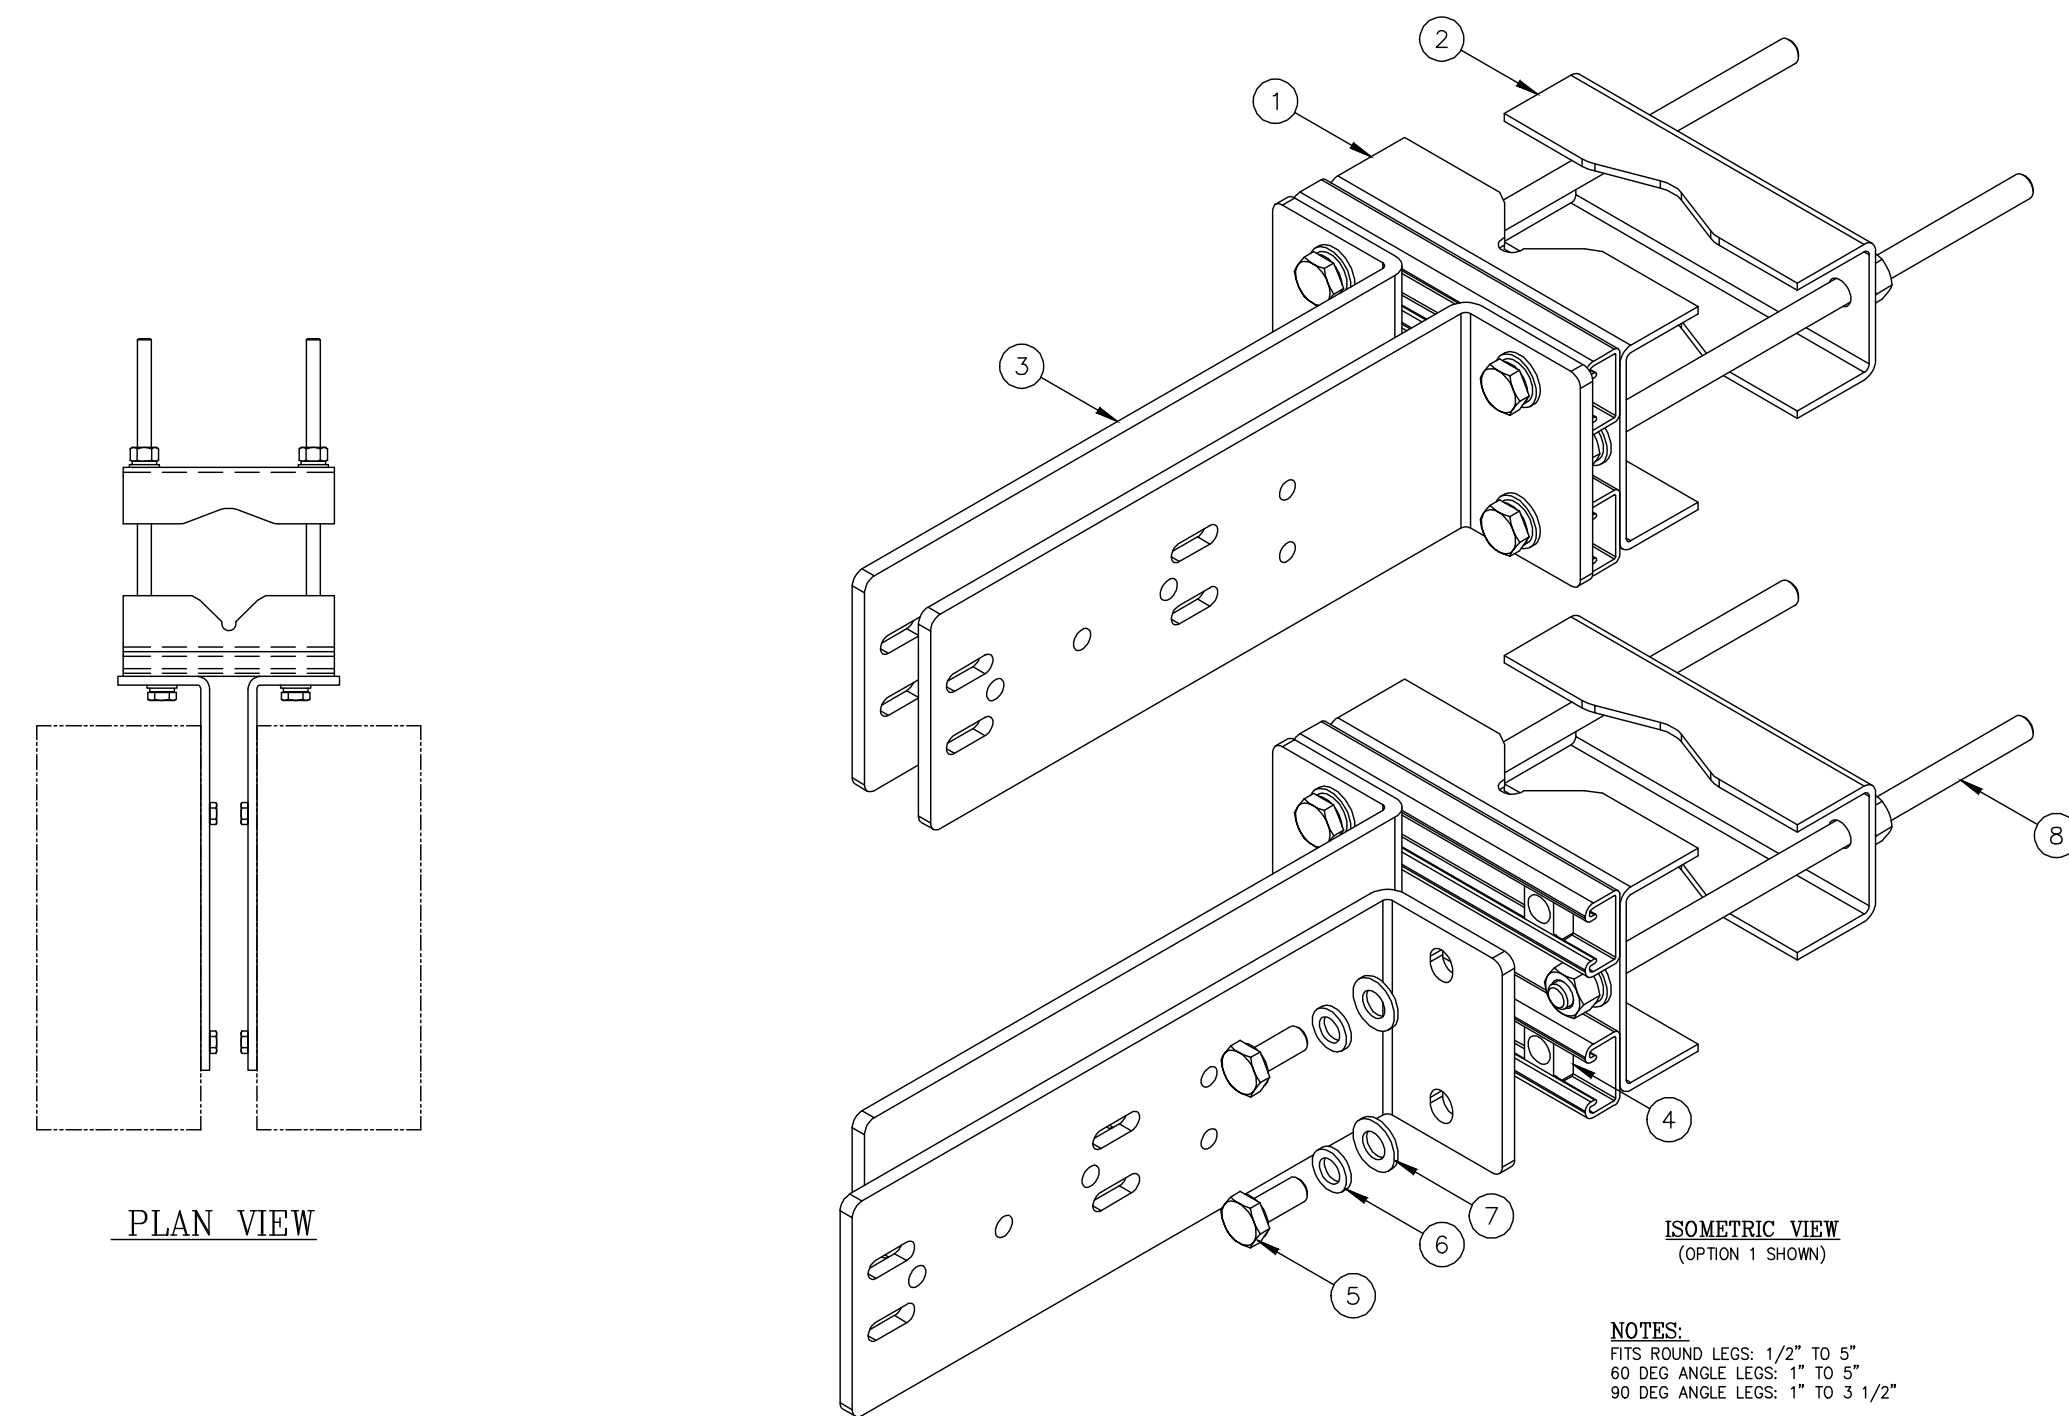


ITEM	QTY	PART NO.	DESCRIPTION	WEIGHT
1	2	CW01192	WELDMENT, FRONT CLAMP	9
2	2	CS03080	BACK CLAMP	5
3	4	CS03079	ANGLE, RRU MOUNT	29
4	8	C4098382	G-STRUT SPRING NUT GN-812 1/2"-13 OR EQUAL	1
5	8	C40112028	BOLT, 1/2" X 1 1/4" S.S.	1
6	8	C40018003	1/2" LOCK WASHER, S.S.	1
7	8	C40020012	1/2" FLAT WASHER, S.S.	1
8	4	C40032007	THREADED ROD ASSEMBLY, 1/2" X 12 HDG	5
TOTAL WEIGHT				52

NOTES:
FITS ROUND LEGS: 1/2" TO 5"
60 DEG ANGLE LEGS: 1" TO 5"
90 DEG ANGLE LEGS: 1" TO 3 1/2"


7 DUAL MOUNTING BRACKET
NOT TO SCALE

MANUFACTURER: NOKIA
MODEL: AIRSCALE RRH 4T4R B30 100W
HEIGHT: 16.83" (427mm)
WIDTH: 12.76" (326mm)
DEPTH: 7.22" (173mm)
WEIGHT: 39.02 LBS (17.7KG)

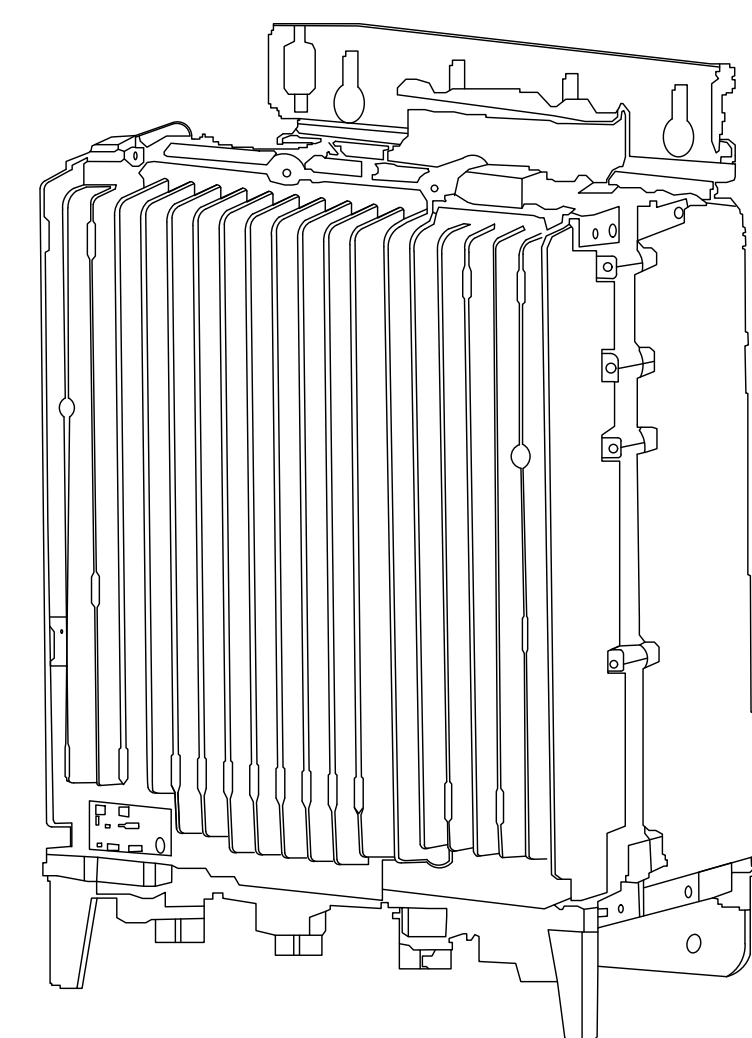


5 RRH DETAIL
NOT TO SCALE

MANUFACTURER: NOKIA
MODEL: AIRSCALE RRH 4T4R B25/B66 320W
HEIGHT: 22.0" (560mm)
WIDTH: 12.1" (308mm)
DEPTH: 5.9" (149mm)
WEIGHT: 66.1 LBS (30.0KG)

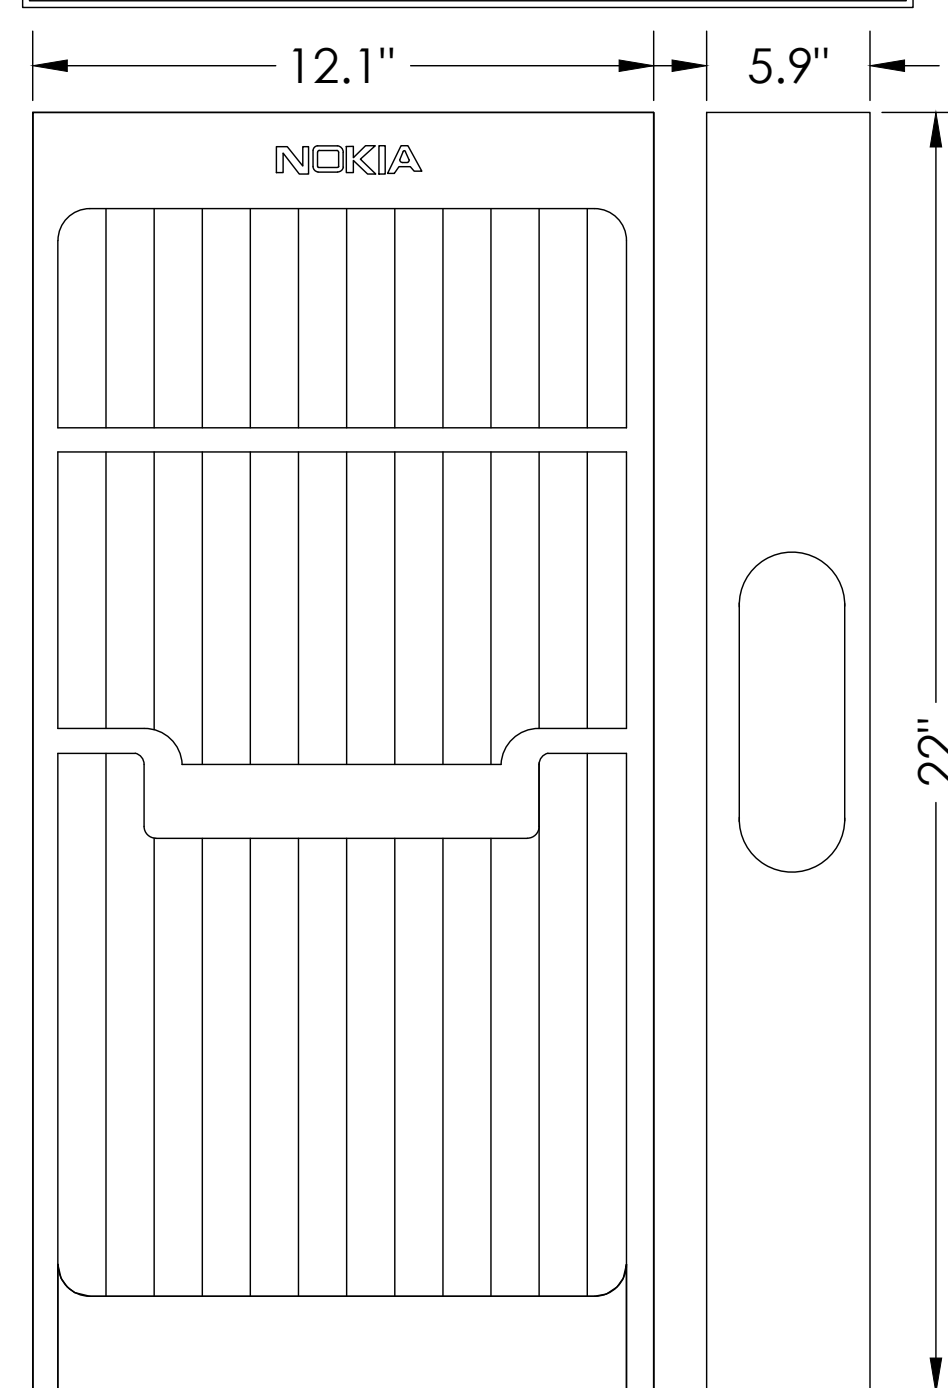


4 RRH DETAIL
NOT TO SCALE

MANUFACTURER: NOKIA
MODEL: AIRSCALE RRH 4T4R B5 160W
HEIGHT: 13.3" (337mm)
WIDTH: 11.6" (295mm)
DEPTH: 6.5" (165mm)
WEIGHT: 36.8 LBS (16.7KG)

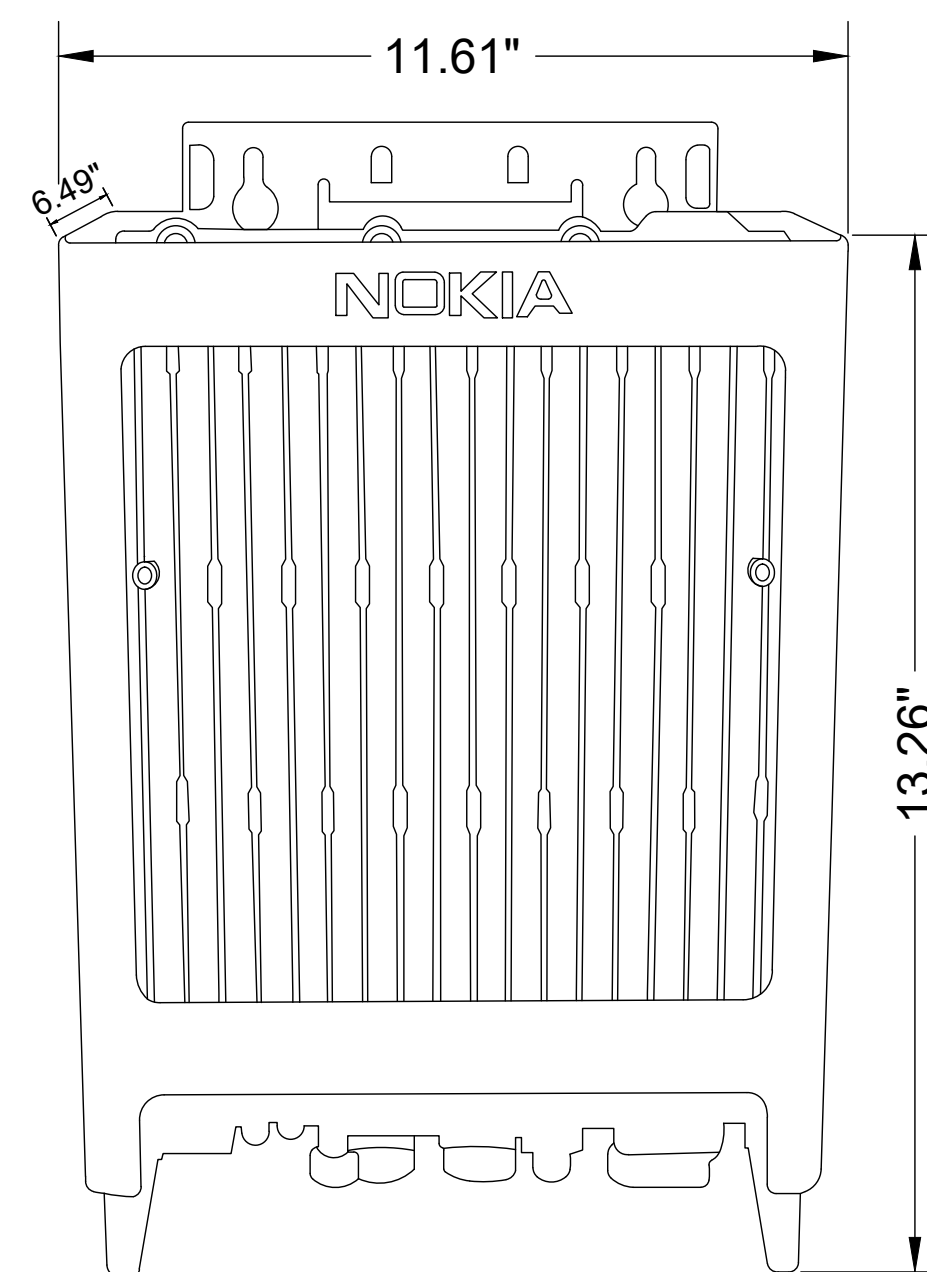


3 RRH DETAIL
NOT TO SCALE

MANUFACTURER: NOKIA
MODEL: AIRSCALE RRH 4T4R B12/14/29
370W AHLBBA
HEIGHT: 24.7" (609mm)
WIDTH: 14.8" (357mm)
DEPTH: 8.3" (198mm)
WEIGHT: 101.4 LBS (46KG) W/MOUNTING

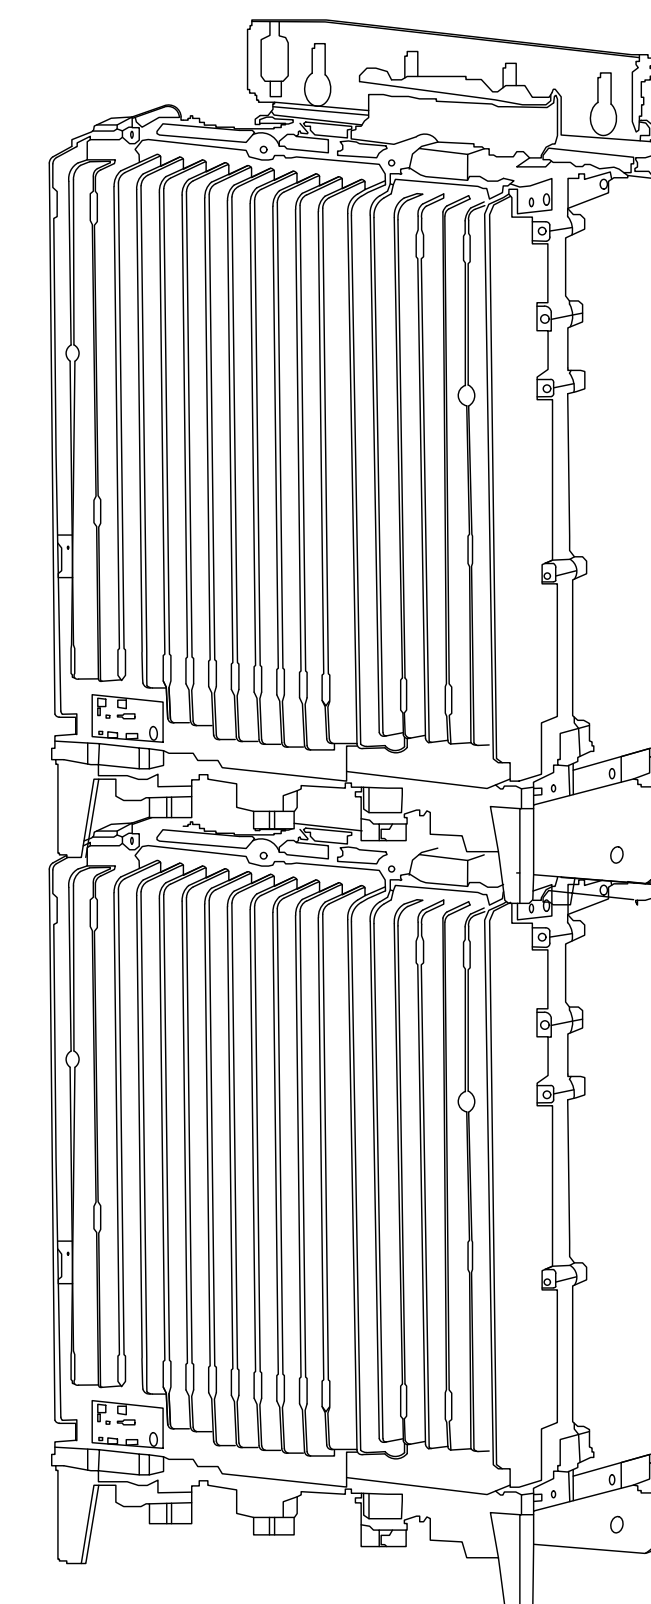

2 RRH DETAIL
NOT TO SCALE




MANUF: RAYCAP
DESC: SURGE PROTECTOR "SQUID" (OR SIMILAR)
MODEL: DC9-48-60-24-8C-EV
WEIGHT: 26.2 LBS

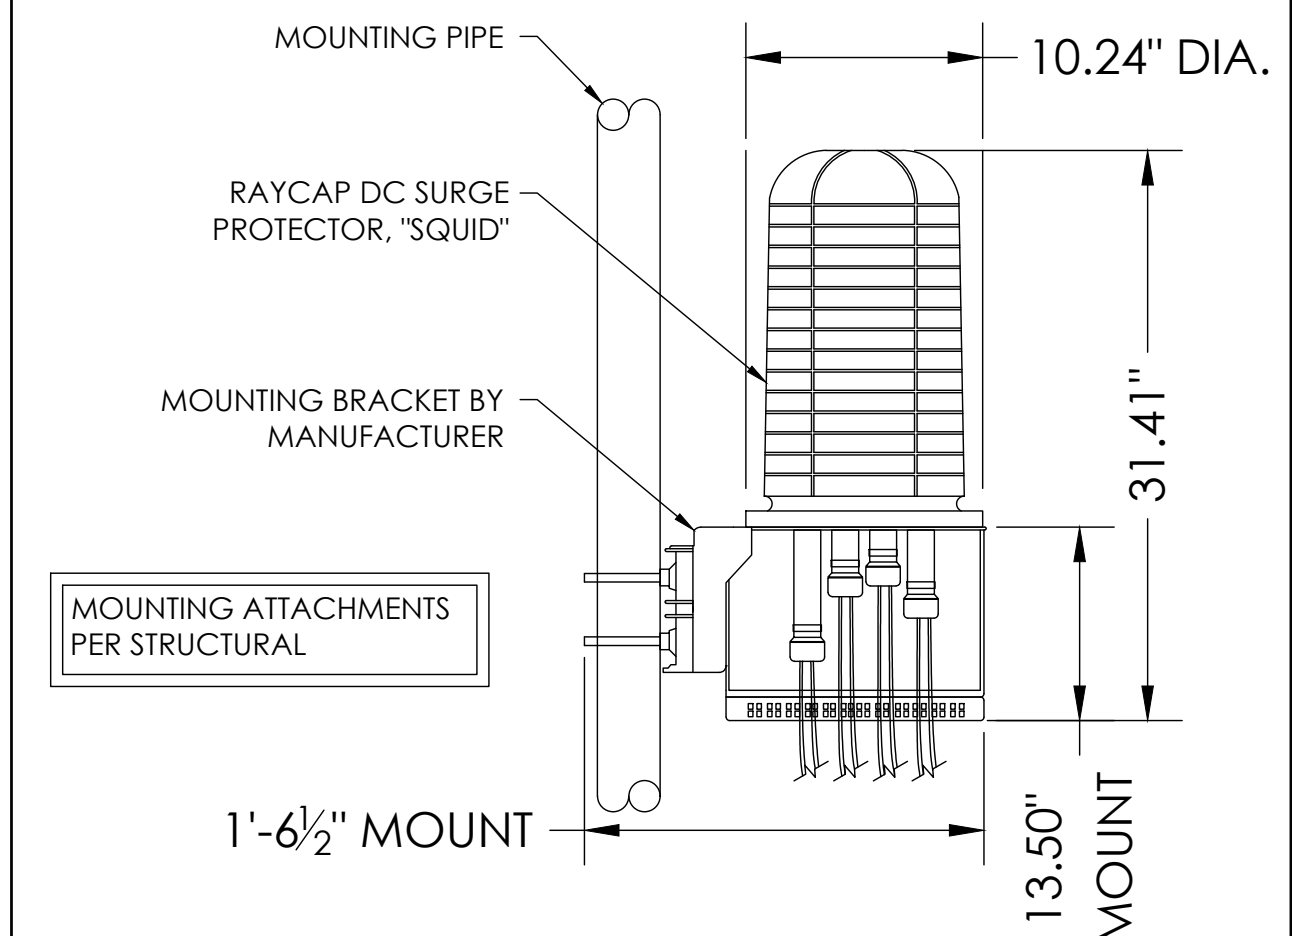

1 SURGE SUPPRESSOR DETAIL
NOT TO SCALE

SITE TYPE: MONOPOLE/WIC


PARTS LIST						
ITEM	QTY	PART NO.	PART DESCRIPTION	LENGTH	UNIT WT.	NET WT.
1	2	P3160	3-1/2" X 160' SCH 40 GALVANIZED PIPE	160 in	101.25	202.50
2	2	PC312	3-1/2" FENCE POST CAP		0.59	1.17
3	10	UN10	UNISTRUT		20.38	203.79
4	20	X-UB3312	3/8" X 3-1/2" X 4-3/4" X 2" U-BOLT (HDG.)		0.73	14.63
5	40	G38FW	3/8" HDG USS FLATWASHER		0.01	0.47
6	40	G38LW	3/8" HDG LOCKWASHER		0.01	0.27
7	40	G38NUT	3/8" HDG HEAVY 2H HEX NUT		0.03	1.35
8	20	UNICAP	UNISTRUT END CAP		0.03	0.64
					TOTAL WT. #	417.77

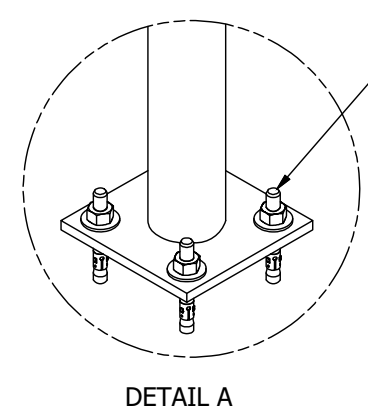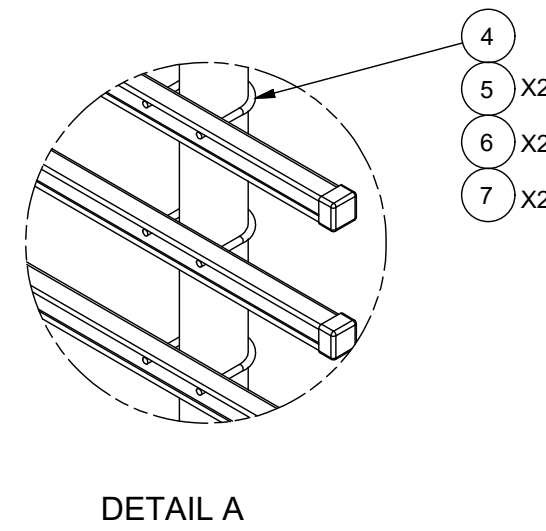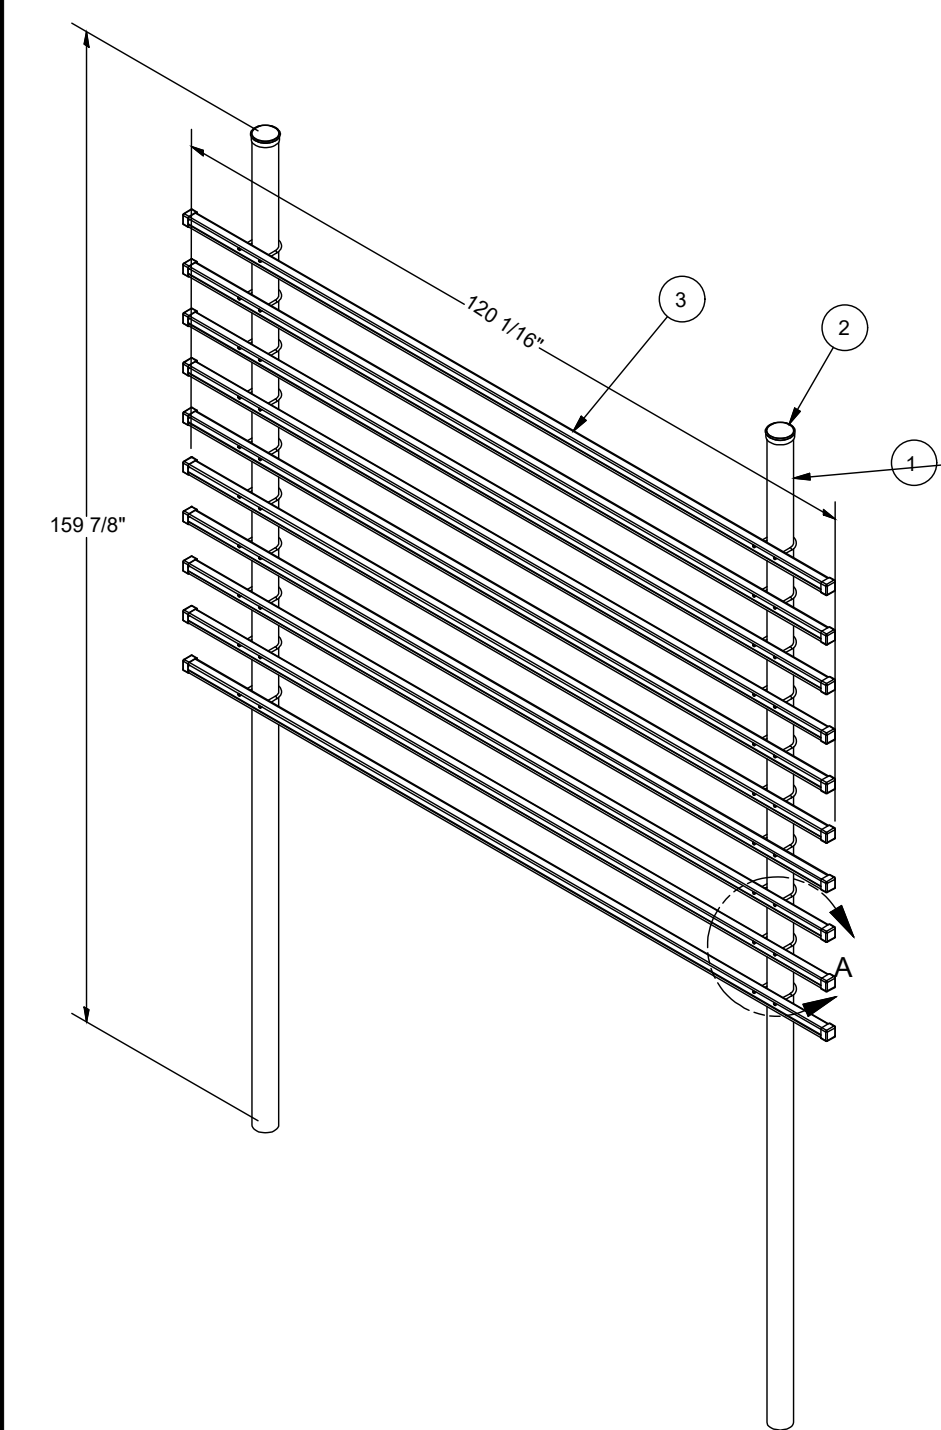


PARTS LIST						
ITEM	QTY	PART NO.	PART DESCRIPTION	UNIT WT.	NET WT.	
1	1	X-SP126	BASE SHOE PLATE PIPE COLUMN	89.00	89.00	
2	4	SWA585	5/8" X 5" STAINLESS WEDGE ANCHOR	0.64	2.55	
					TOTAL WT. #	91.55

BASE SHOE

5 SITEPRO1 - ER105D H-FRAME DETAIL
NOT TO SCALE

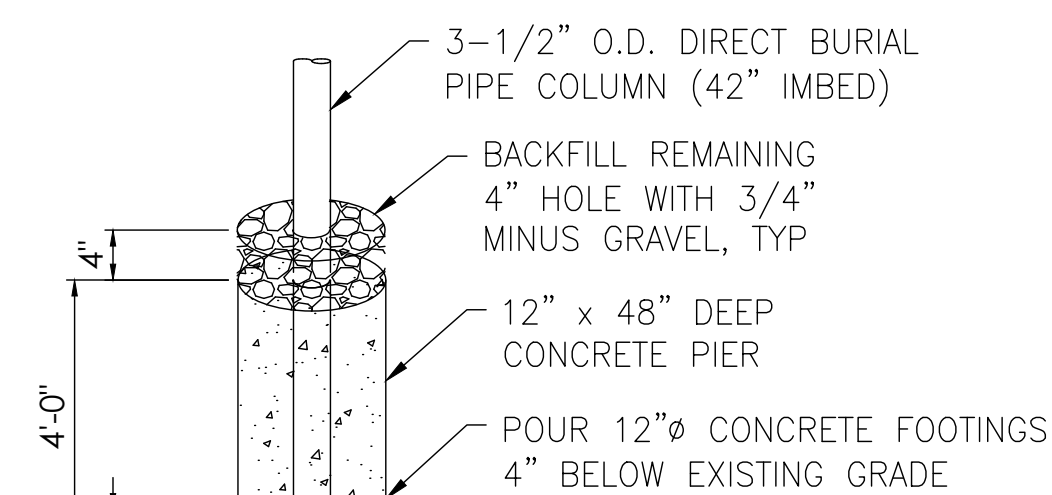


DIRECT BURIAL

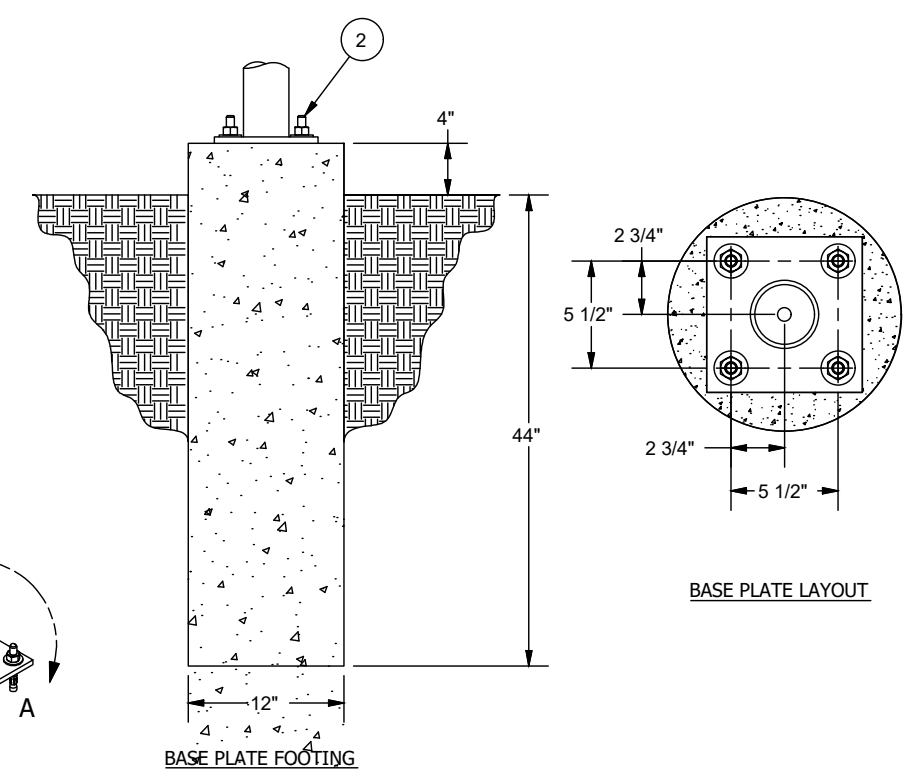


PARTS LIST						
ITEM	QTY	PART NO.	PART DESCRIPTION	UNIT WT.	NET WT.	
1	1	X-SP126	BASE SHOE PLATE PIPE COLUMN	89.00	89.00	
2	4	SWA585	5/8" X 5" STAINLESS WEDGE ANCHOR	0.64	2.55	
					TOTAL WT. #	91.55

BASE SHOE

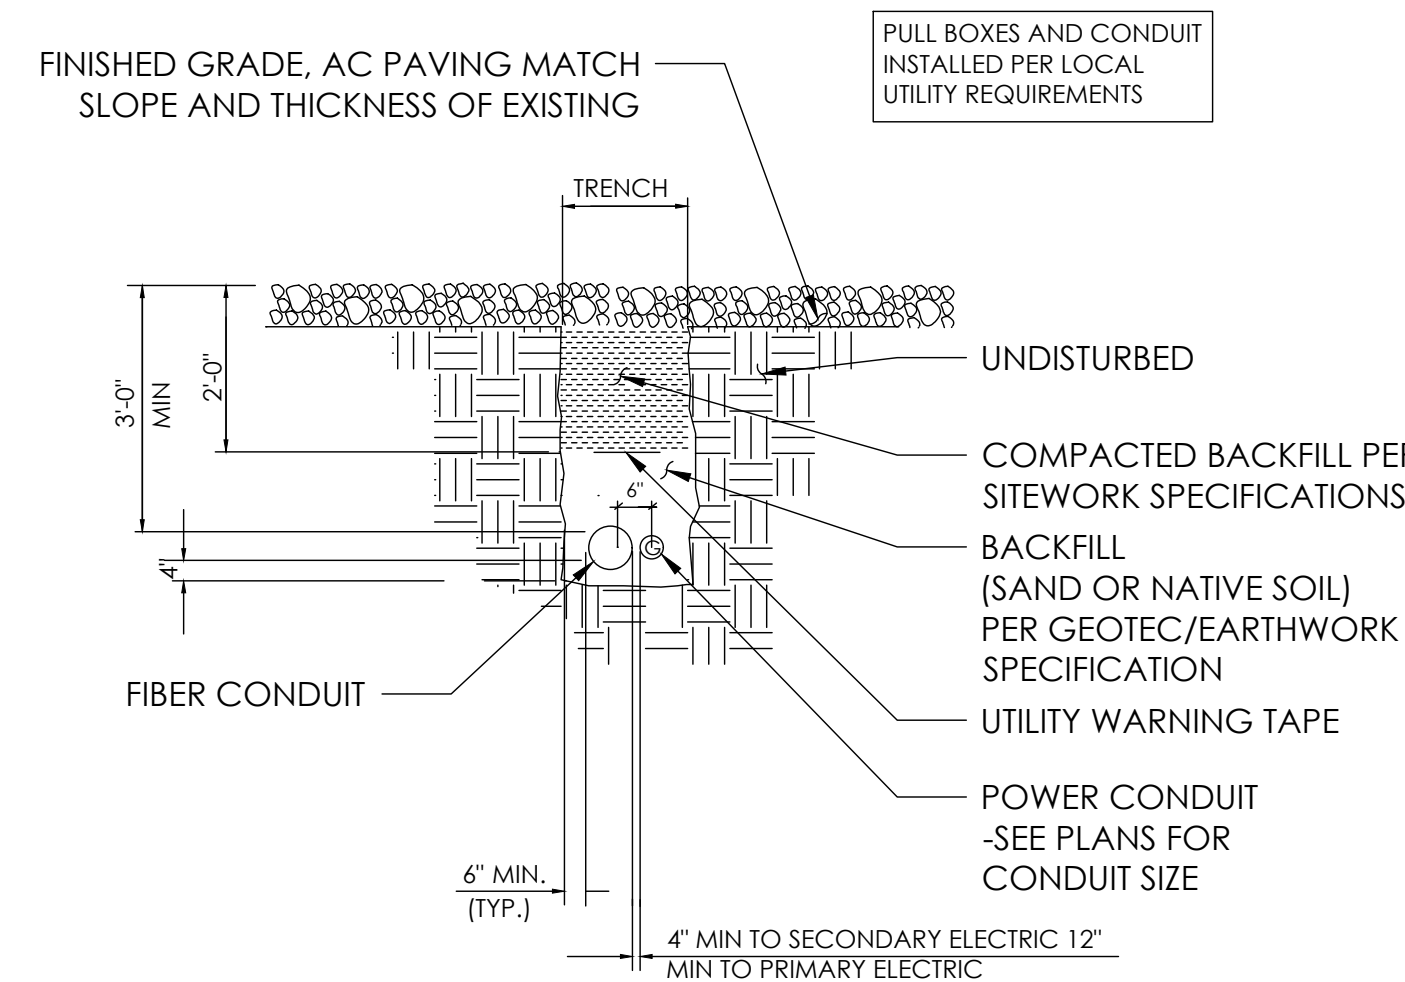


4 CONDUIT TRENCHING DETAIL
NOT TO SCALE

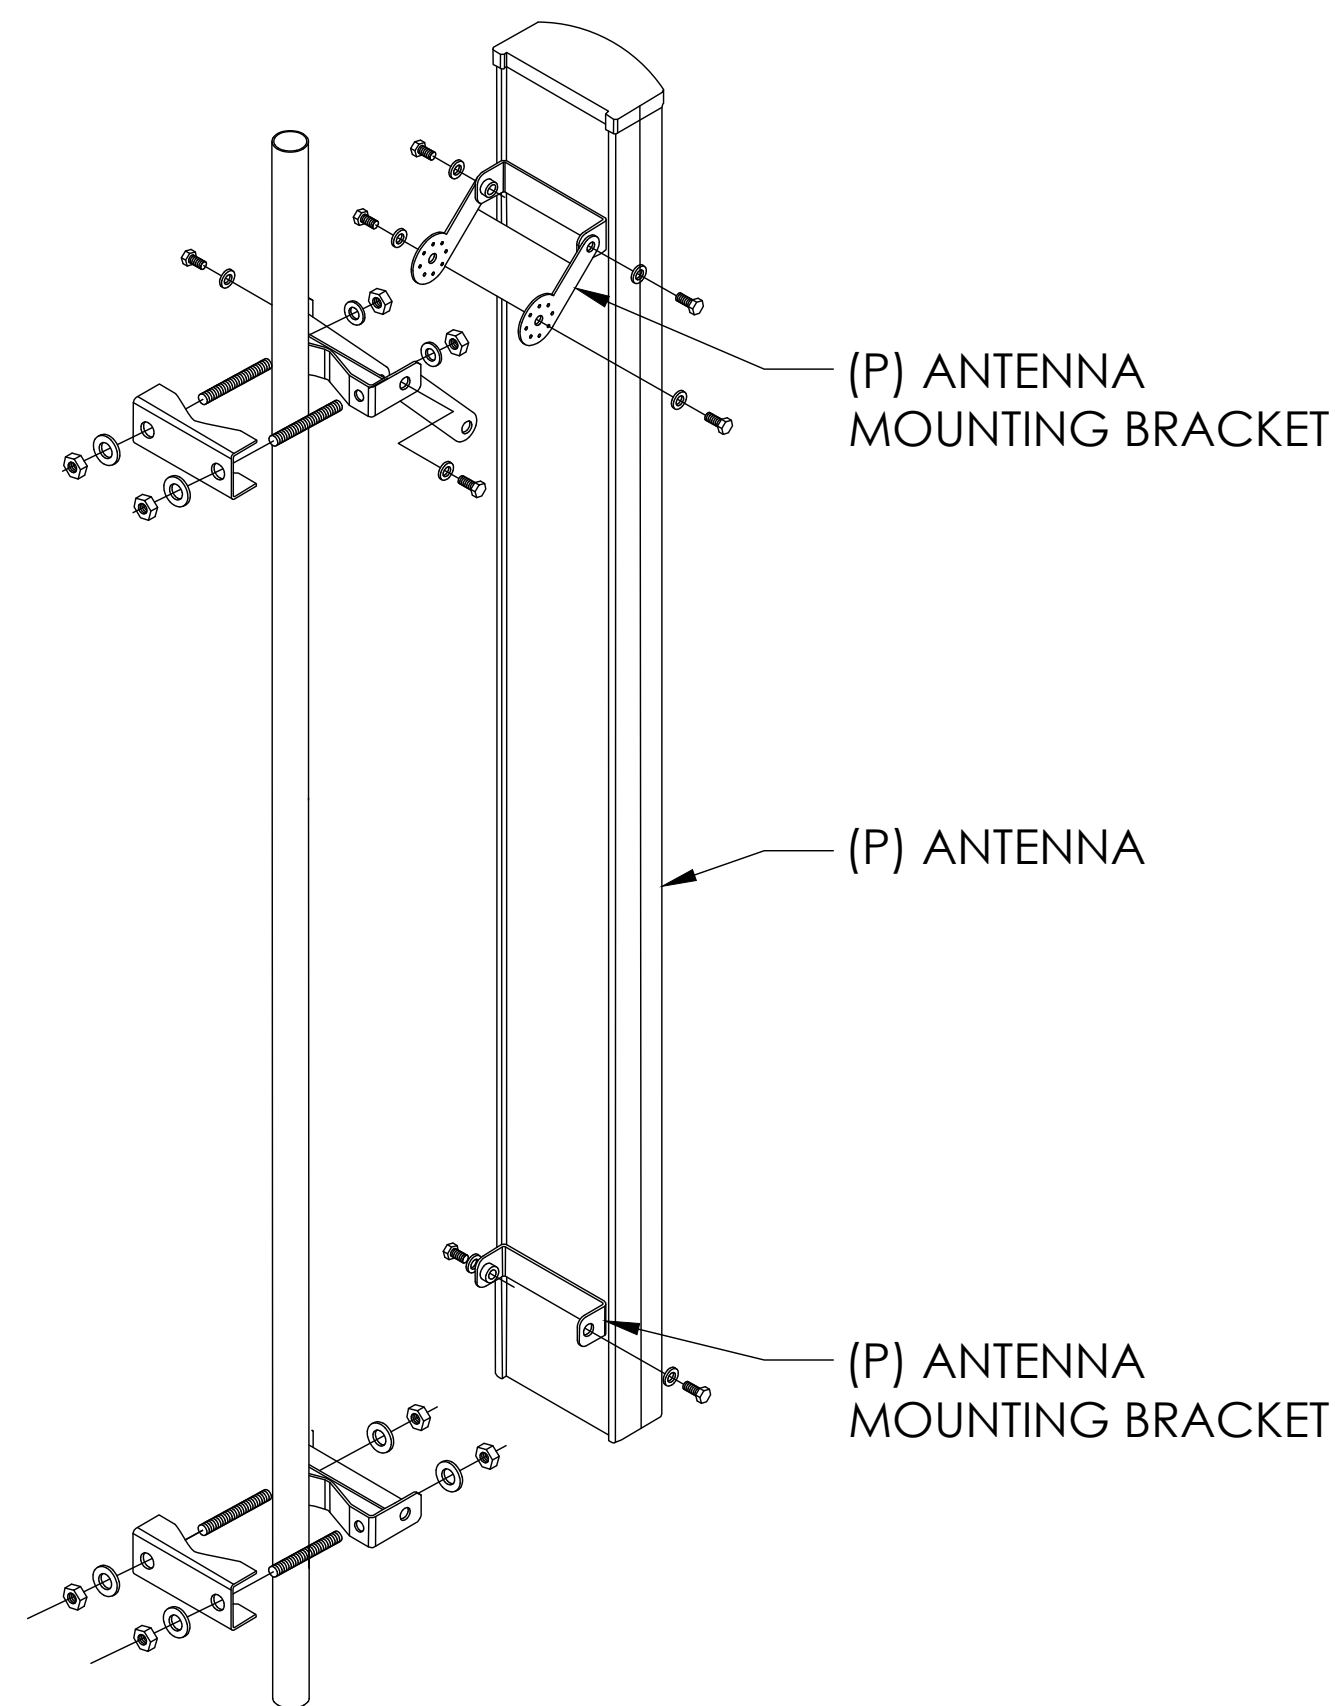



3 ANTENNA MOUNTING DETAILS
NOT TO SCALE

Parts List			
ITEM	QTY	PART NUMBER	DESCRIPTION
16	4	80-4941-00	LIFTING EYE
21	100	55-8002-06	Washer Flat SS 3/8
94	4	55-9044-00	ANCHOR SHACKLE
113	4	55-2008-06	7/8-14 ZN NYLOCK
114	4	55-5001-14	7/8-14 X 5.00 HHCS
296	4	80-7072-00	GPS MOUNT
297	4	55-6025-06	3/8-16 X 4.5 SS HHCS
315	4	80-7070-00	PAINTED UNISTRUT
316	32	55-5061-00	HHCS ZN 3/8-16 X 1 1/4
318	2	80-6845-00	GPS PIPE MOUNT
319	4	U-BOLT	

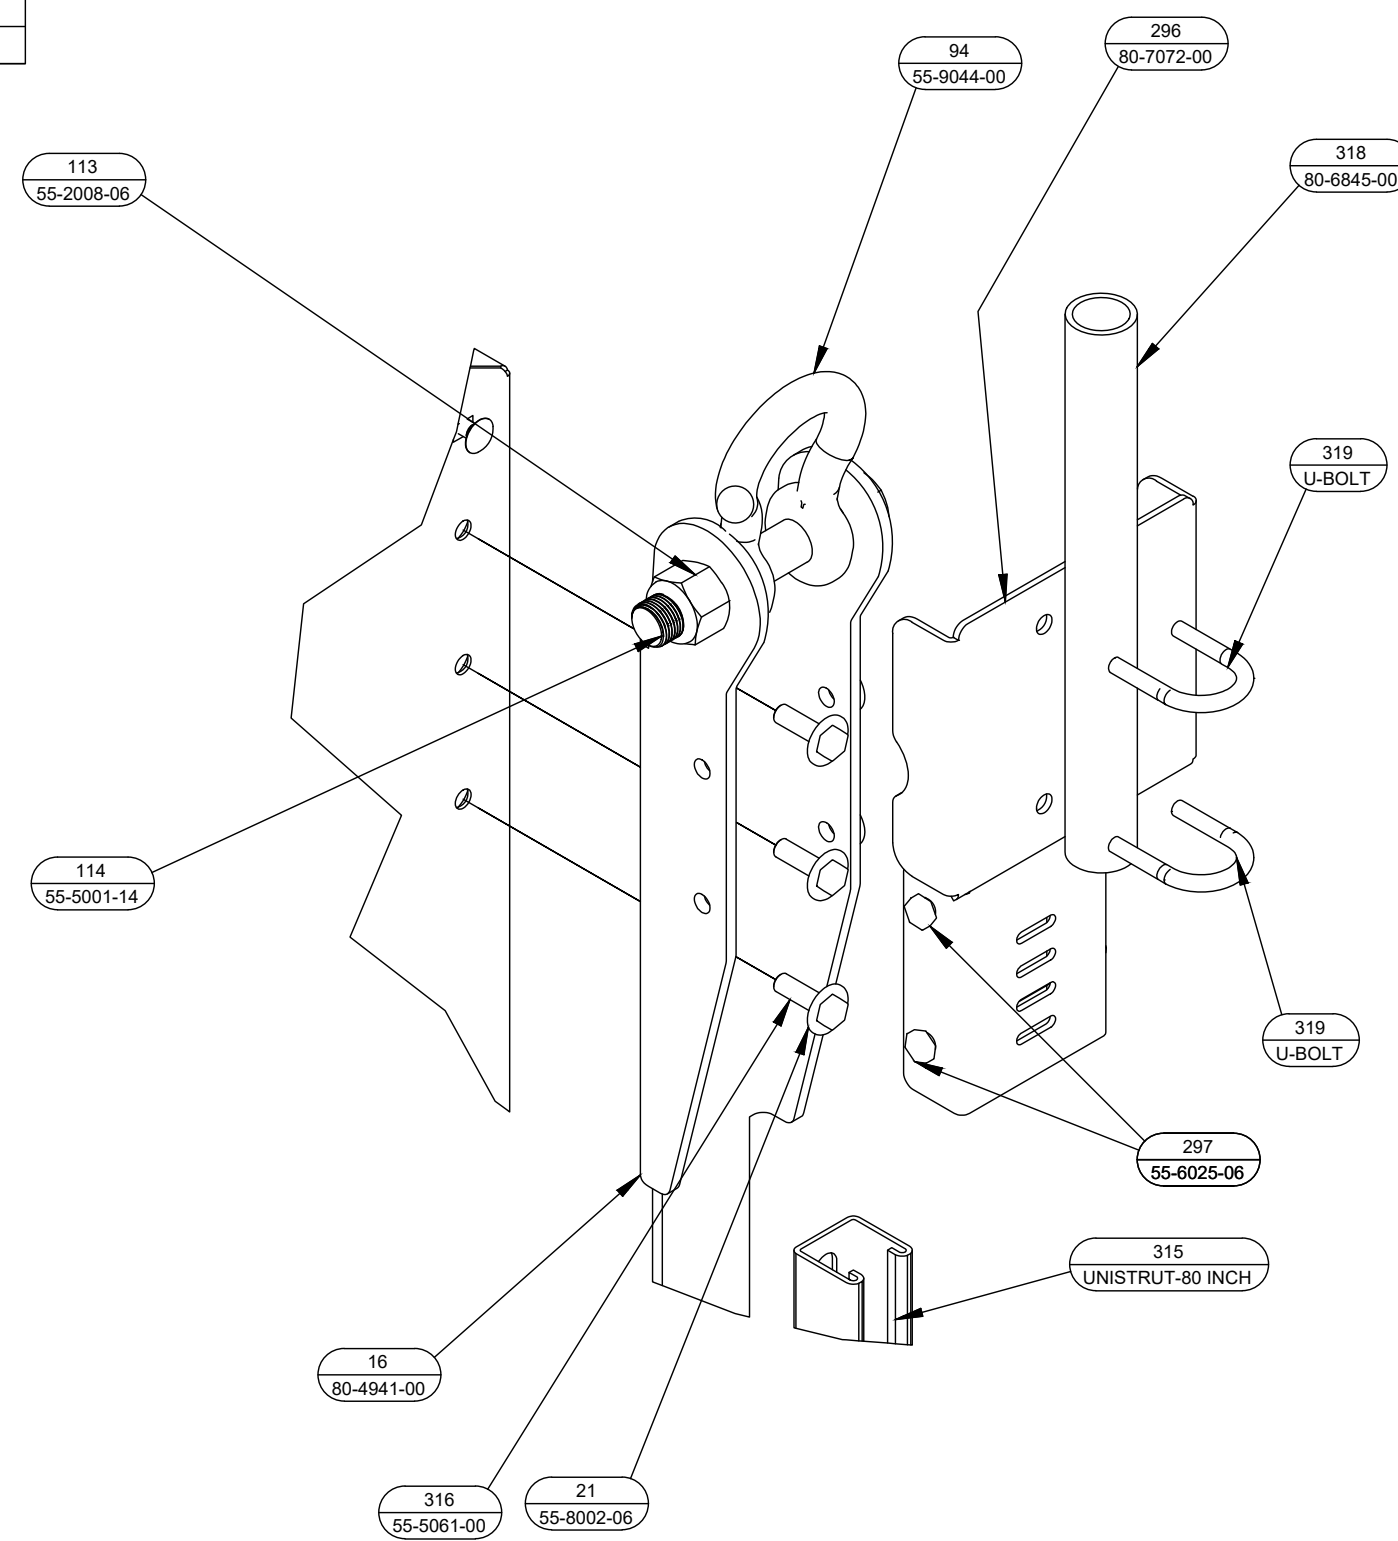



2 GPS MOUNTING DETAIL
NOT TO SCALE

ITEM	PART NO.	DESCRIPTION	QTY.	WEIGHT
1	MF-130	Ø3.5" O.D. X 13'-4" DIRECT BURIAL PIPE COLUMN	2	101.38 LBS
2	WB-CY210	SAFETY GRATING 24" X 10"	1	111.00 LBS
3	WBK210BHK	HARDWARE KIT (ITEMS 4-16)	1	
4	WBLB243.08	24" WAVEGUIDE BRIDGE SUPPORT BRACKET	2	7.14 LBS
5	GUB-4356	1/2" X 3-5/8" X 6" GALV U-BOLT KIT	4	0.83 LBS
6	WBJB6	1/2" J-BOLT	4	0.41 LBS
7	GW-F-04	1/2" GALV FLAT WASHER	4	0.01 LBS
8	GW-L-04	1/2" GALV LOCK WASHER	4	0.01 LBS
9	GN-04	1/2" GALV HEX NUT	4	0.04 LBS
10	WBT243.01	VERTICAL TRAPEZE SECTION	3	2.53 LBS
11	WBT243.02	HORIZONTAL TRAPEZE SECTION	9	2.81 LBS
12	MT-387	SQUARE WASHER, 1-1/2" X 1-5/8" W/ 7/16" HOLE	18	0.12 LBS
13	GB-03105	3/8" X 1" GALV BOLT KIT	18	0.04 LBS
14	GB-03205	3/8" X 2" GALV BOLT KIT	9	0.04 LBS
15	GW-F-03	3/8" GALV FLAT WASHER	9	0.01 LBS
16	PC-034	Ø3 1/2" PIPE CAP	2	0.28 LBS

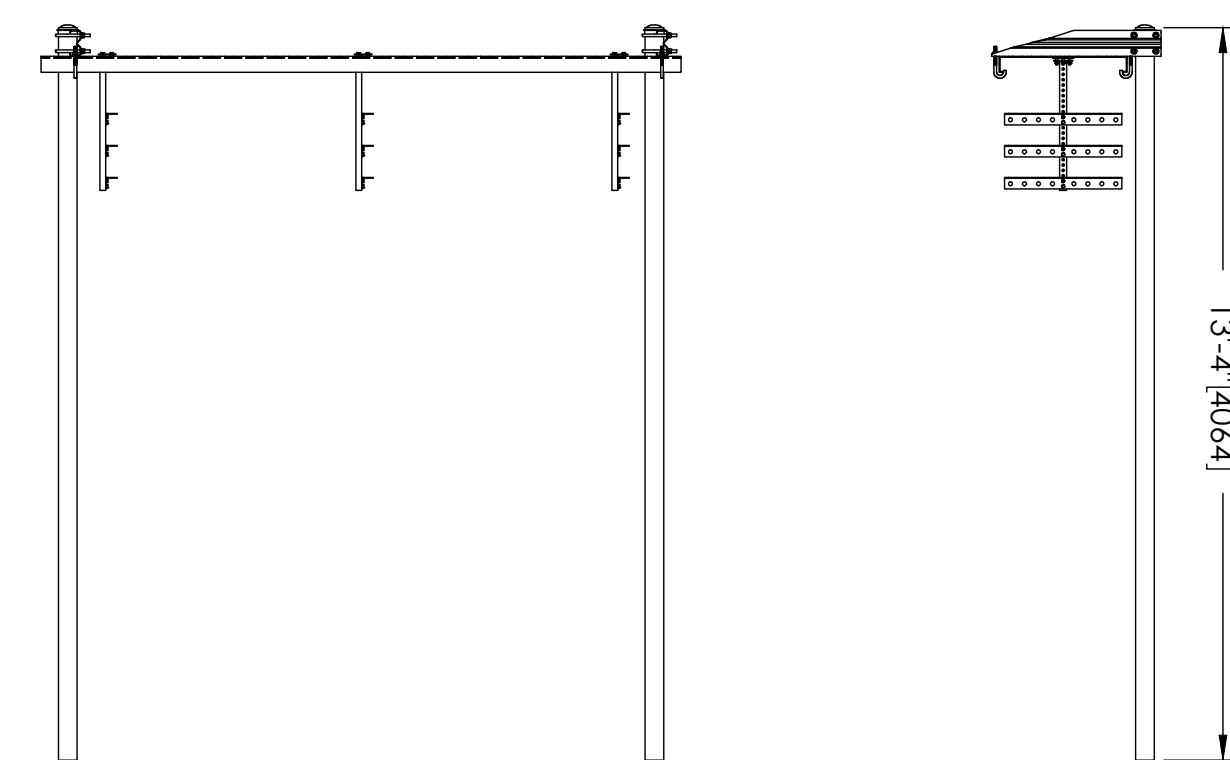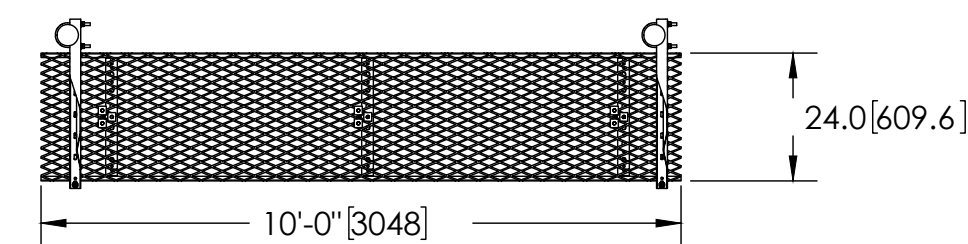

NOTES:
1. ALL METRIC DIMENSIONS ARE IN BRACKETS.

1 ICE BRIDGE DETAIL
NOT TO SCALE

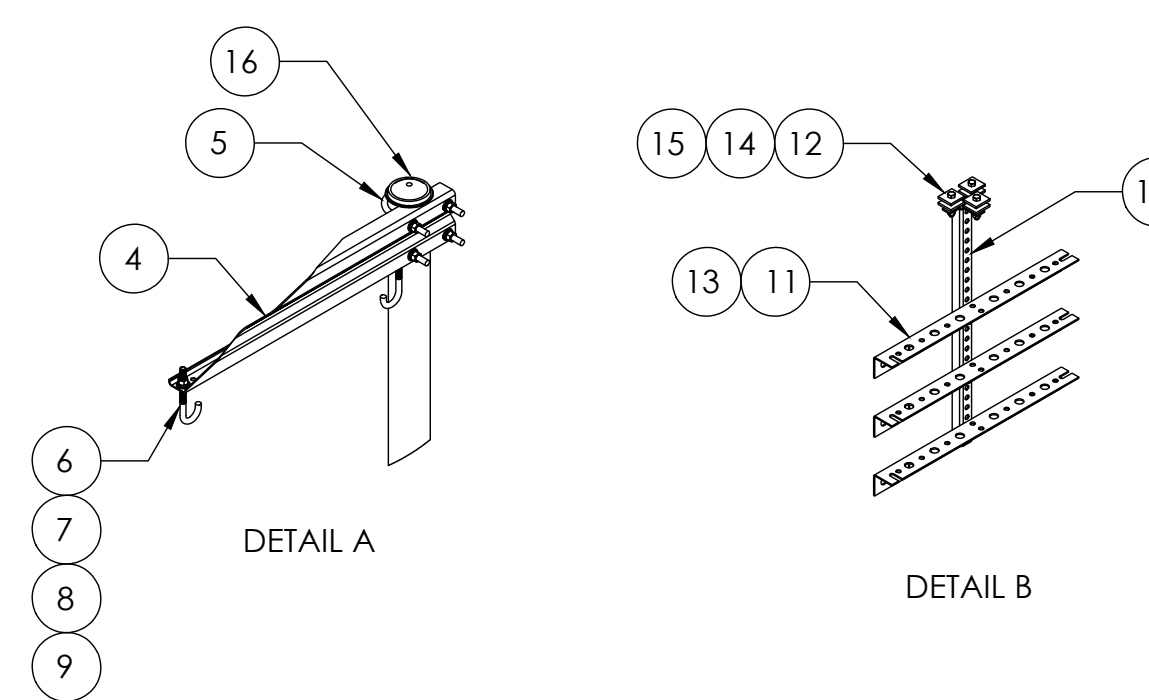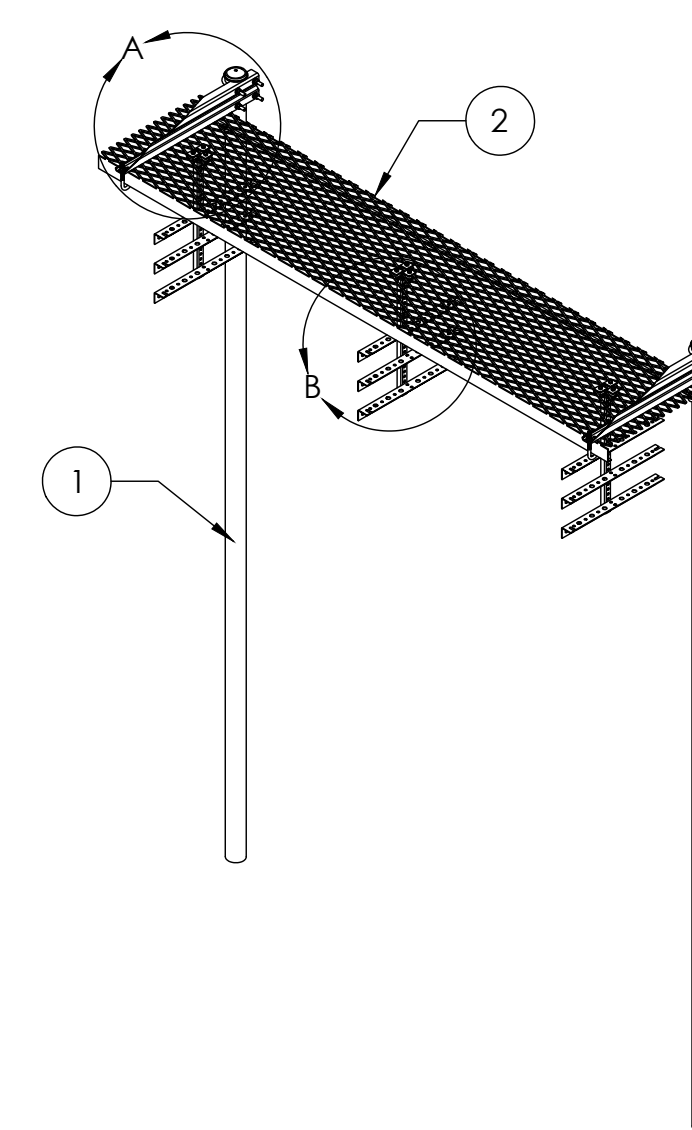

SITE TYPE: MONOPOLE/WIC

AT&T Site ID:
COL02568
6915 SPACE VILLAGE
AVENUE
COLORADO SPRINGS,
CO 80915

Owner:
CROWN CASTLE
2055 SOUTH STEARMAN DRIVE
CHANDLER, AZ 85286

PREPARED FOR:
at&t Mobility
161 Inverness Drive West 2nd floor
Englewood, Colorado 80112

A&E:
TELCYTE
INFRASTRUCTURE SERVICES
3450 N HIGLEY RD - SUITE 102,
MESA, AZ 85215

AT&T SITE NO: COL02568

BU NO: 823722

DRAWN BY: AK

CHECKED BY: CM

REV	DATE	DESCRIPTION
A	2/25/22	PRELIMINARY CD'S
B	03/21/22	CLIENT REVISIONS
C	5/19/22	CLIENT REVISIONS

Licenser:
COLORADO LICENSED
THE ALEXANDER
44563
Jim Alexander
EXP
10/31/2023
PROFESSIONAL ENGINEER
SIGNED: 19 MAY 2022






IT IS A VIOLATION OF LAW FOR ANY
PERSON, UNLESS THEY ARE ACTING
UNDER THE DIRECTION OF A LICENSED
PROFESSIONAL ENGINEER, TO ALTER THIS
DOCUMENT.

Issued For:
5/19/22
PRELIMINARY CD'S

SHEET TITLE:
DETAILS

SHEET NUMBER:
A-5.1

OJ7500D-ATT

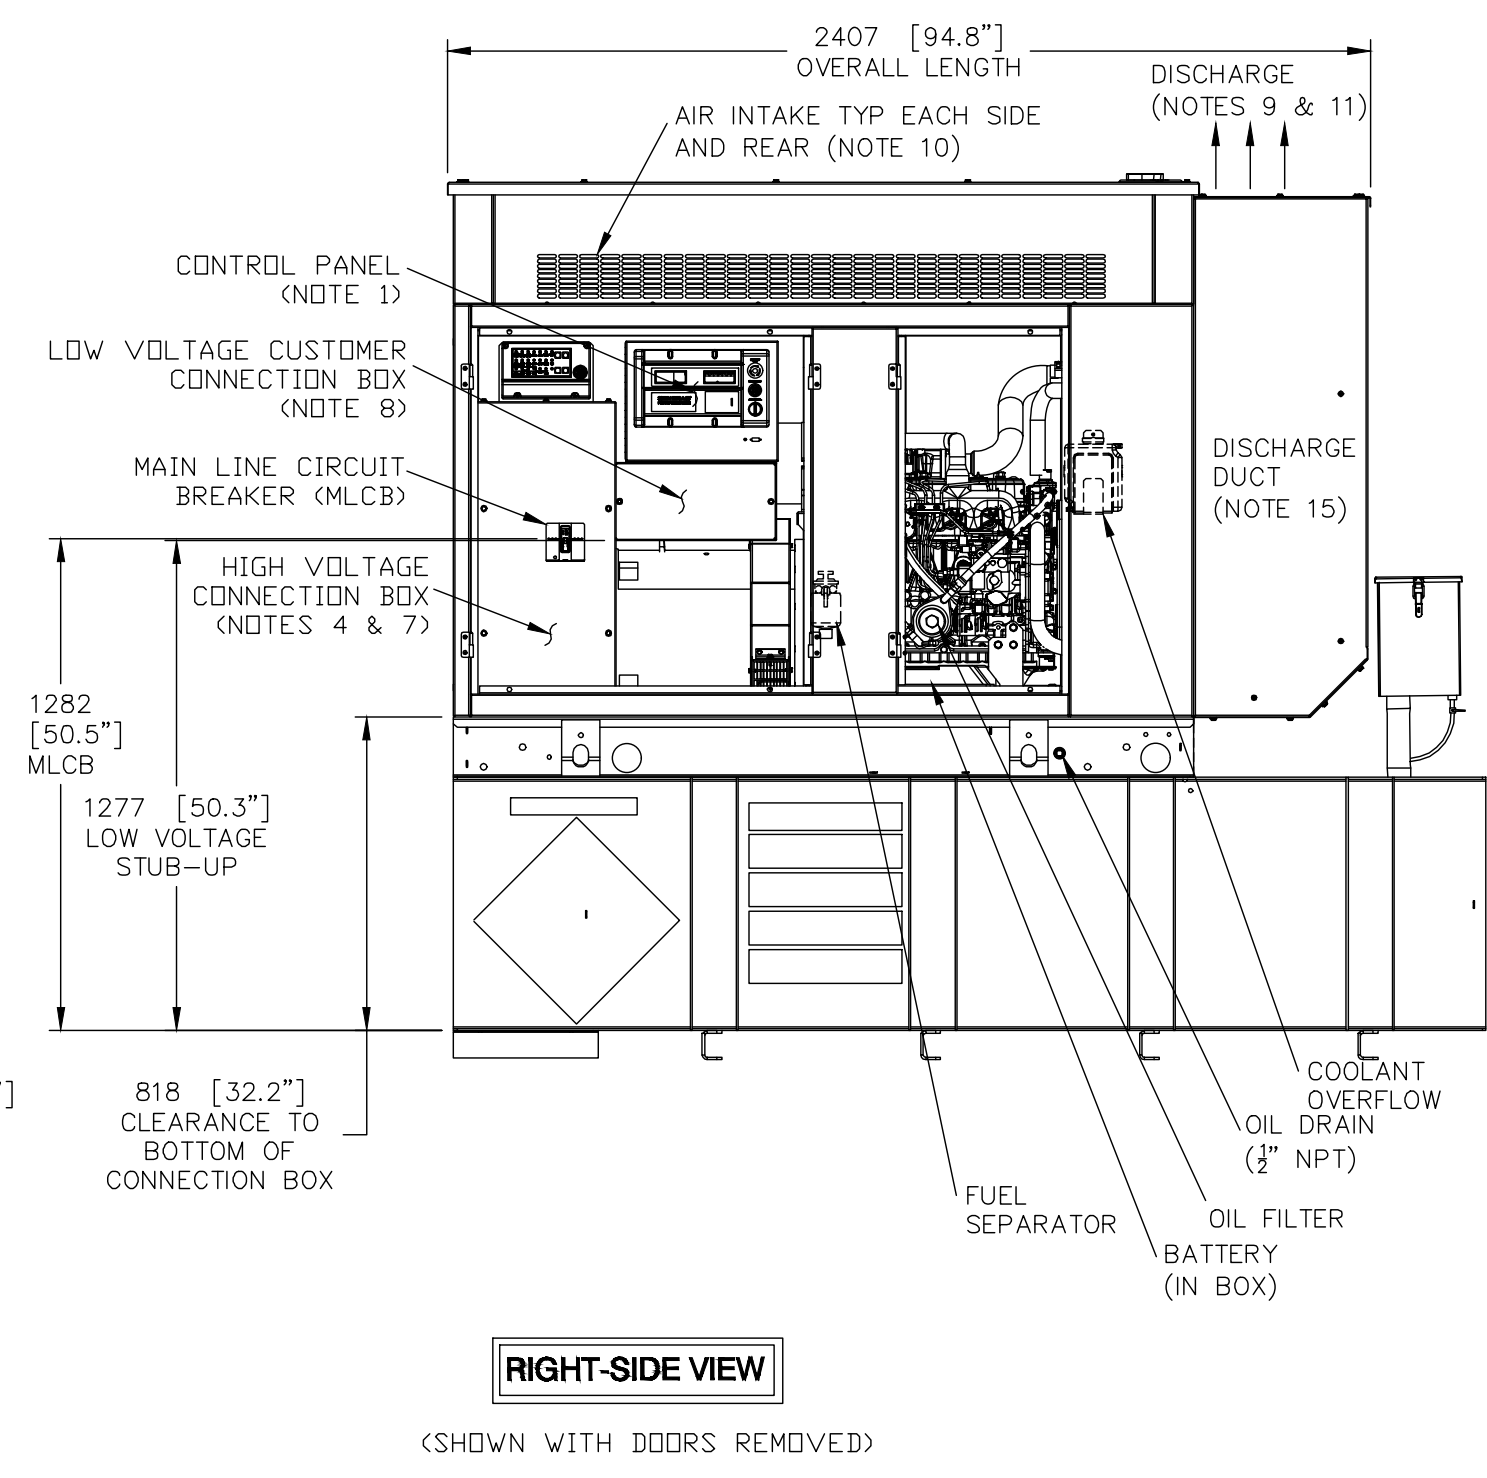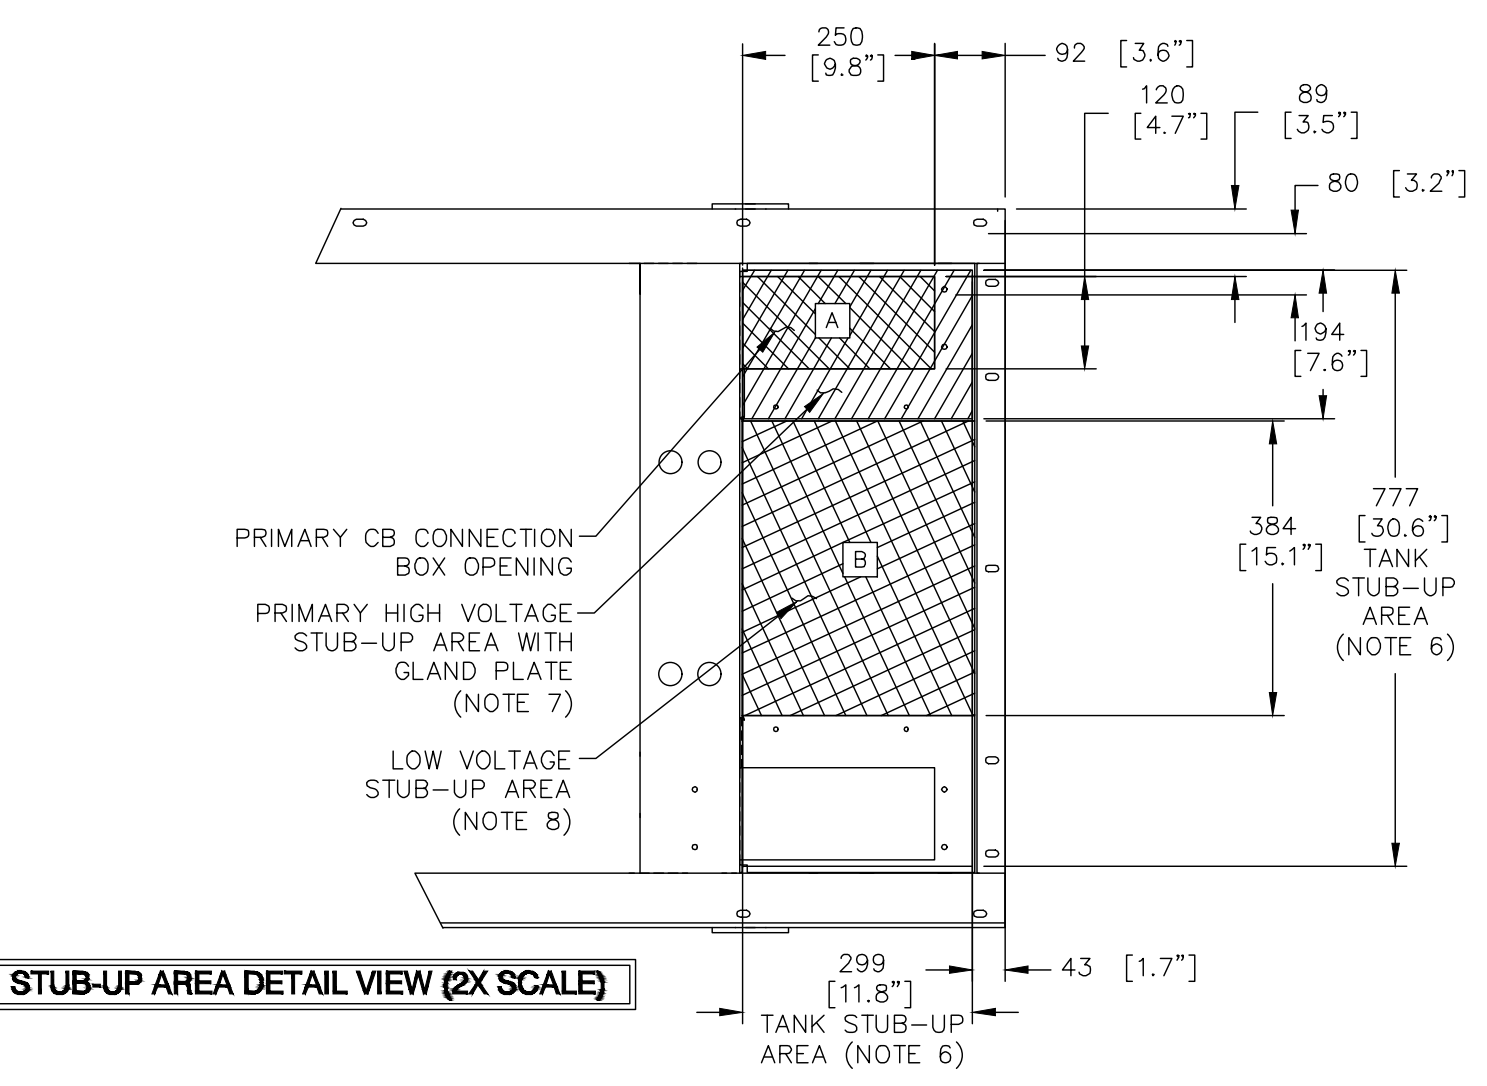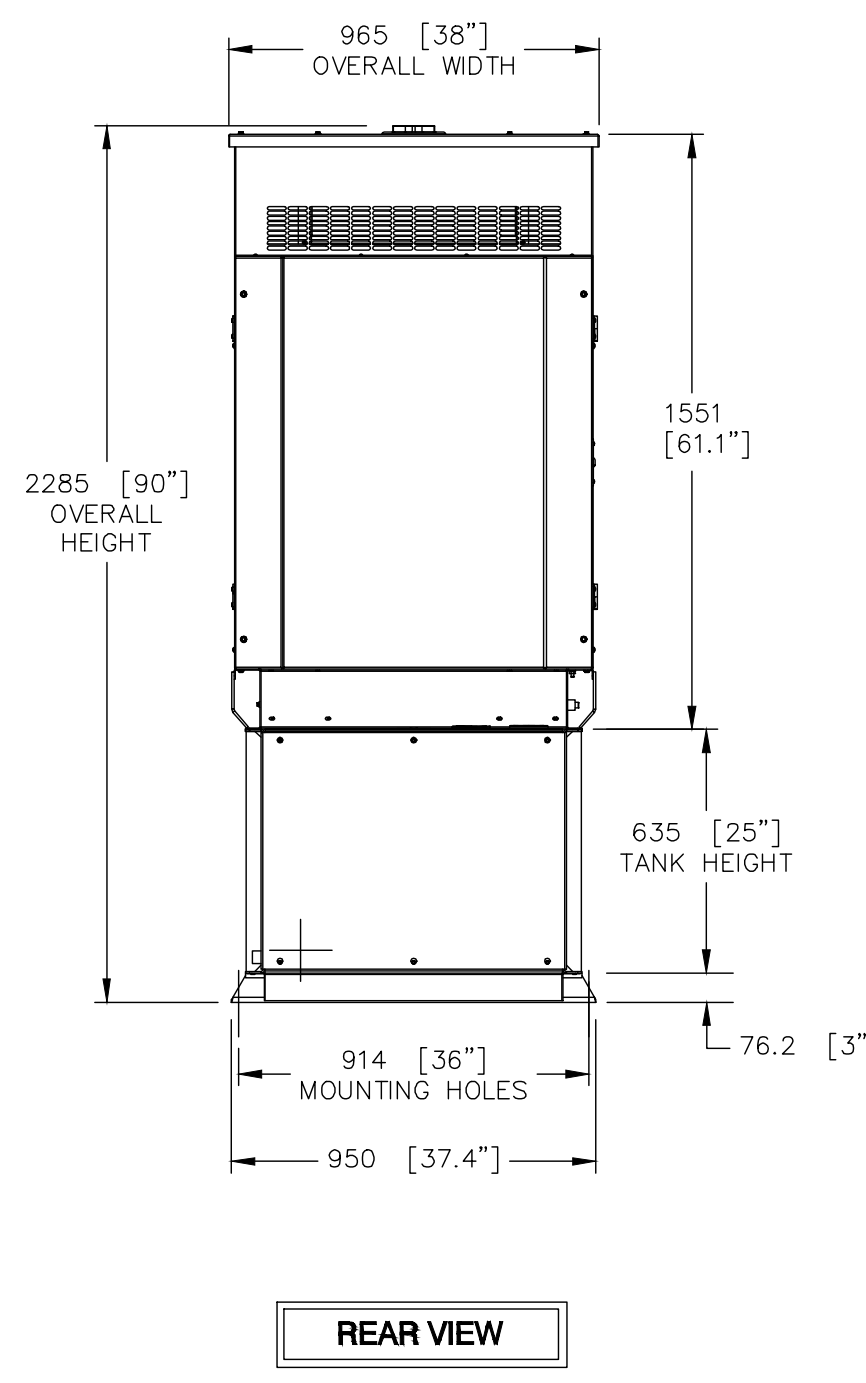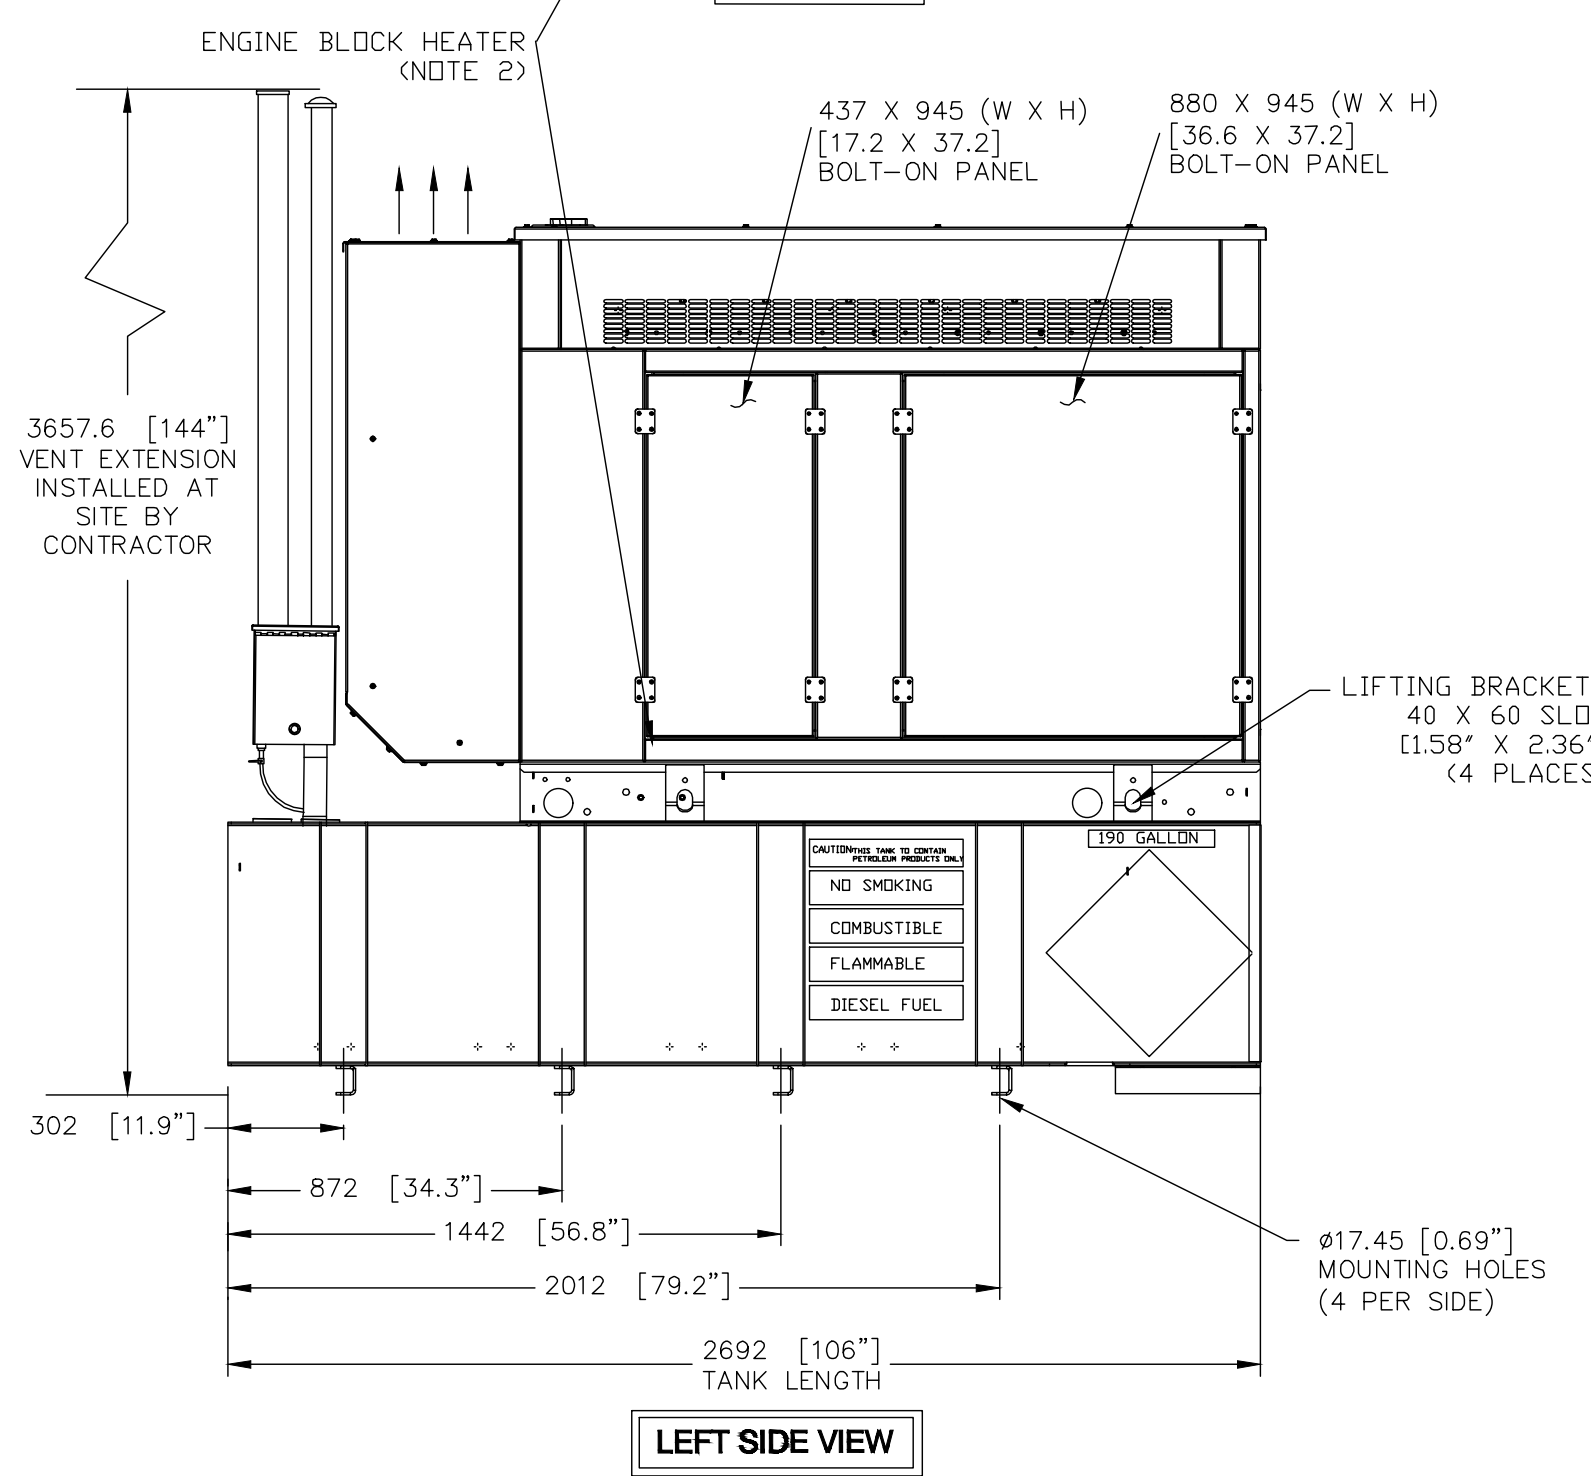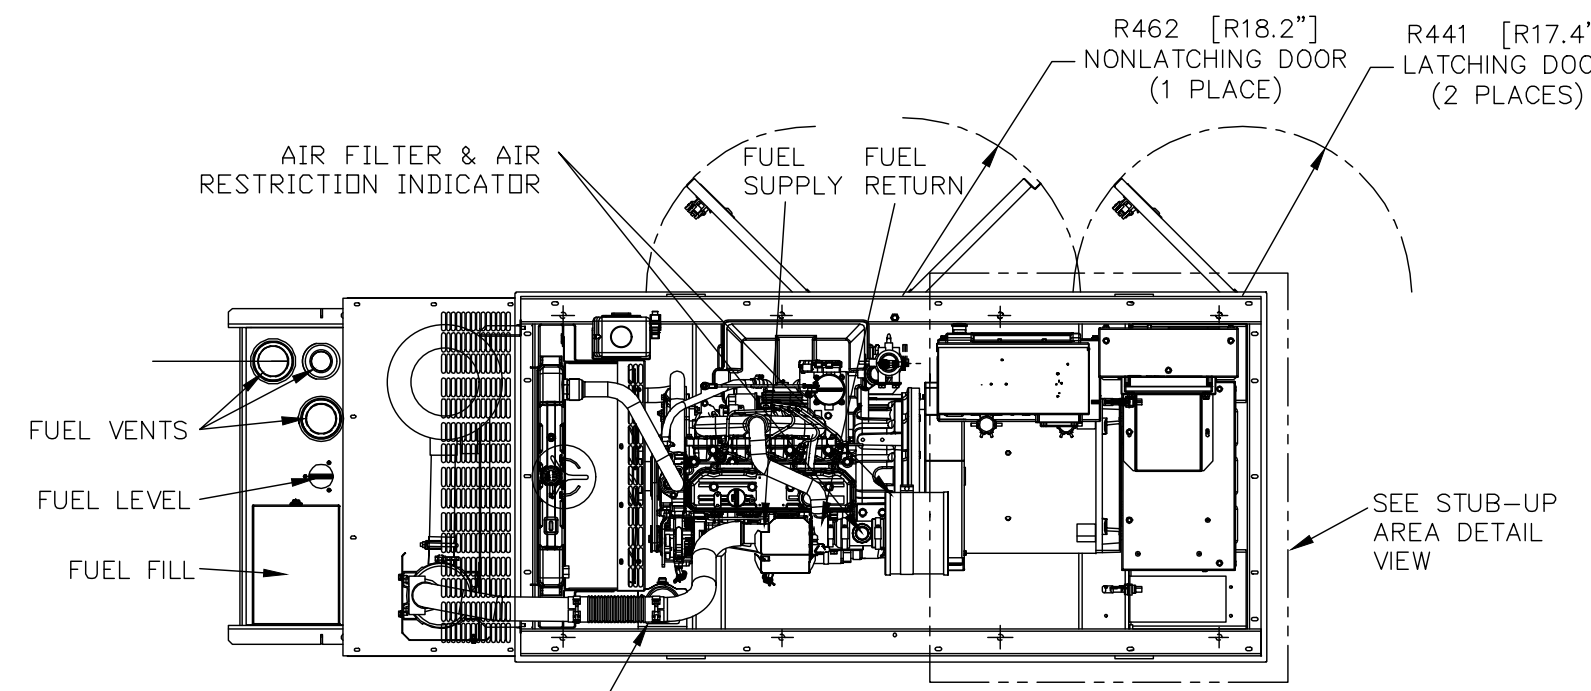

RECOMMENDED ELECTRICAL STUB-UPS
(SEE DETAILED VIEW & TOP VIEW)

DESCRIPTION	INSIDE BASE
HIGH VOLTAGE STUB-UP AREA 1) AC LOAD LEAD CONDUIT AREA. 2) 120/240 VAC FROM UTILITY (BY OTHERS) (GLAND PLATE INCLUDED)	A
LOW VOLTAGE STUB-UP AREA 1) TRANSFER SWITCH/ COMMUNICATION CONDUITS, COMMUNICATIONS AND 2-WIRE START MUST NOT BE RUN IN CONDUIT WITH AC WIRING. (SEE NOTE 8)	B

- NOTES:**
- CONTROL PANEL INCLUDES BATTERY CHARGER WITH THREE PRONG CORD.
 - 1500W 120VAC ENGINE BLOCK HEATER WITH THREE PRONG CORD.
 - 12 VOLT NEGATIVE GROUND SYSTEM.
 - GENERATOR MUST BE GROUNDED.
 - CENTER OF GRAVITY & WEIGHT MAY SHIFT SLIGHTLY DUE TO UNIT OPTIONS.
 - STUB-UPS: BASE TANK REQUIRES ALL STUB-UPS TO BE IN THE REAR TANK STUB-UP AREA.
 - HIGH VOLTAGE STUB-UP AREA INCLUDES THE AC LOAD LEAD CONNECTION TO THE MAIN LINE CIRCUIT BREAKER, THE NEUTRAL CONNECTION, AND AUXILIARY 120/240V CONNECTION.
 - CONNECTION POINTS FOR CONTROL WIRES. BOTTOM OF LOW VOLTAGE CUSTOMER CONNECTION BOX HAS KNOCKOUTS FOR 1/2" AND 3/4" CONDUIT FITTINGS.
 - MUST ALLOW FREE FLOW OF DISCHARGE AIR AND EXHAUST. SEE SPEC SHEET FOR MINIMUM AIR FLOW AND MAXIMUM RESTRICTION REQUIREMENTS.
 - MUST ALLOW FREE FLOW OF INTAKE AIR. SEE SPEC SHEET FOR MINIMUM AIR FLOW AND MAXIMUM RESTRICTION REQUIREMENTS.
 - GENERATOR MUST BE INSTALLED SUCH THAT FRESH COOLING AIR IS AVAILABLE AND THAT DISCHARGE AIR FROM THE RADIATOR IS NOT RECIRCULATED.
 - IT IS THE RESPONSIBILITY OF THE INSTALLATION TECHNICIAN TO ENSURE THAT THE GENERATOR INSTALLATION COMPLIES WITH ALL APPLICABLE CODES, STANDARDS, AND REGULATIONS.
 - 190 GALLON USEABLE CAPACITY BASETANK IS INCLUDED WITH GENERATOR.
 - UNIT IS SHIPPED WITH FUEL SUPPLY AND RETURN LINES DISCONNECTED AND PLUGGED BETWEEN ENGINE AND FUEL TANK. THIS HAS BEEN DONE TO FACILITATE PRESSURE TESTING OF THE TANK IN THE FIELD. FOR INFORMATION REGARDING CONNECTING THE FUEL SUPPLY AND RETURN LINES PRIOR TO START UP, SEE THE FUEL TANK FIELD TESTING PROCEDURE (0E5082) SUPPLIED IN THE TANK LOOSE VENTS KIT, WHICH IS SHIPPED WITH THIS GENERATOR.
 - SEE DRAWING 0C3850 FOR DISCHARGE DUCT REMOVAL. REMOVAL OF DUCT WILL PROVIDE ACCESS TO MUFFLER FOR SERVICING.

WEIGHT DATA: (INCLUDES EMPTY FUEL TANK)
GENERATOR: 1409 KG (3106 LBS)
GENERATOR WITH WOODEN SHIPPING SKID: 1474 KG (3250 LBS)

UNITS: mm [INCHES]

GENERAC POWER SYSTEMS OWNS THE COPYRIGHT OF THIS DRAWING WHICH IS SUPPLIED IN CONFIDENCE AND MUST NOT BE USED FOR ANY PURPOSE OTHER THAN FOR WHICH IT IS SUPPLIED WITHOUT THE EXPRESS WRITTEN CONSENT OF GENERAC POWER SYSTEMS.
© GENERAC POWER SYSTEMS 2001

INSTALL SD030
DIESEL 2.4L G16

GENERAC POWER SYSTEMS
Waukesha
P.O. BOX 8
WAUKESHA, WIS. 53187

INSTALLATION DRAWING

L2A Y02 SSM
190 GAL EXT VNT/FILL BASETANK

FILE NAME	SIZE B
SCALE	FIRST USE CALIFORNIA
DWG NO.	REV
OJ7500D	A

AT&T Site ID:
COL02568
6915 SPACE VILLAGE AVENUE
COLORADO SPRINGS, CO 80915

Tower Owner:
CROWN CASTLE
2055 SOUTH STEARMAN DRIVE
CHANDLER, AZ 85286

PREPARED FOR:
at&t Mobility
161 Inverness Drive West 2nd floor
Englewood, Colorado 80112

A&E:
TELCYTE
INFRASTRUCTURE SERVICES
3450 N HIGLEY RD - SUITE 102,
MESA, AZ 85215

AT&T SITE NO: COL02568
BU NO: 823722
DRAWN BY: AK
CHECKED BY: CM

REV	DATE	DESCRIPTION
A	2/25/22	PRELIMINARY CDS
B	03/21/22	CLIENT REVISIONS
C	5/19/22	CLIENT REVISIONS

Licensors:


SIGNED: 19 MAY 2022

IT IS A VIOLATION OF LAW FOR ANY PERSON, UNLESS THEY ARE ACTING UNDER THE DIRECTION OF A LICENSED PROFESSIONAL ENGINEER, TO ALTER THIS DOCUMENT.

Issued For:
5/19/22
PRELIMINARY CD'S

SHEET TITLE:
GENERATOR DETAILS

SHEET NUMBER:
S-3

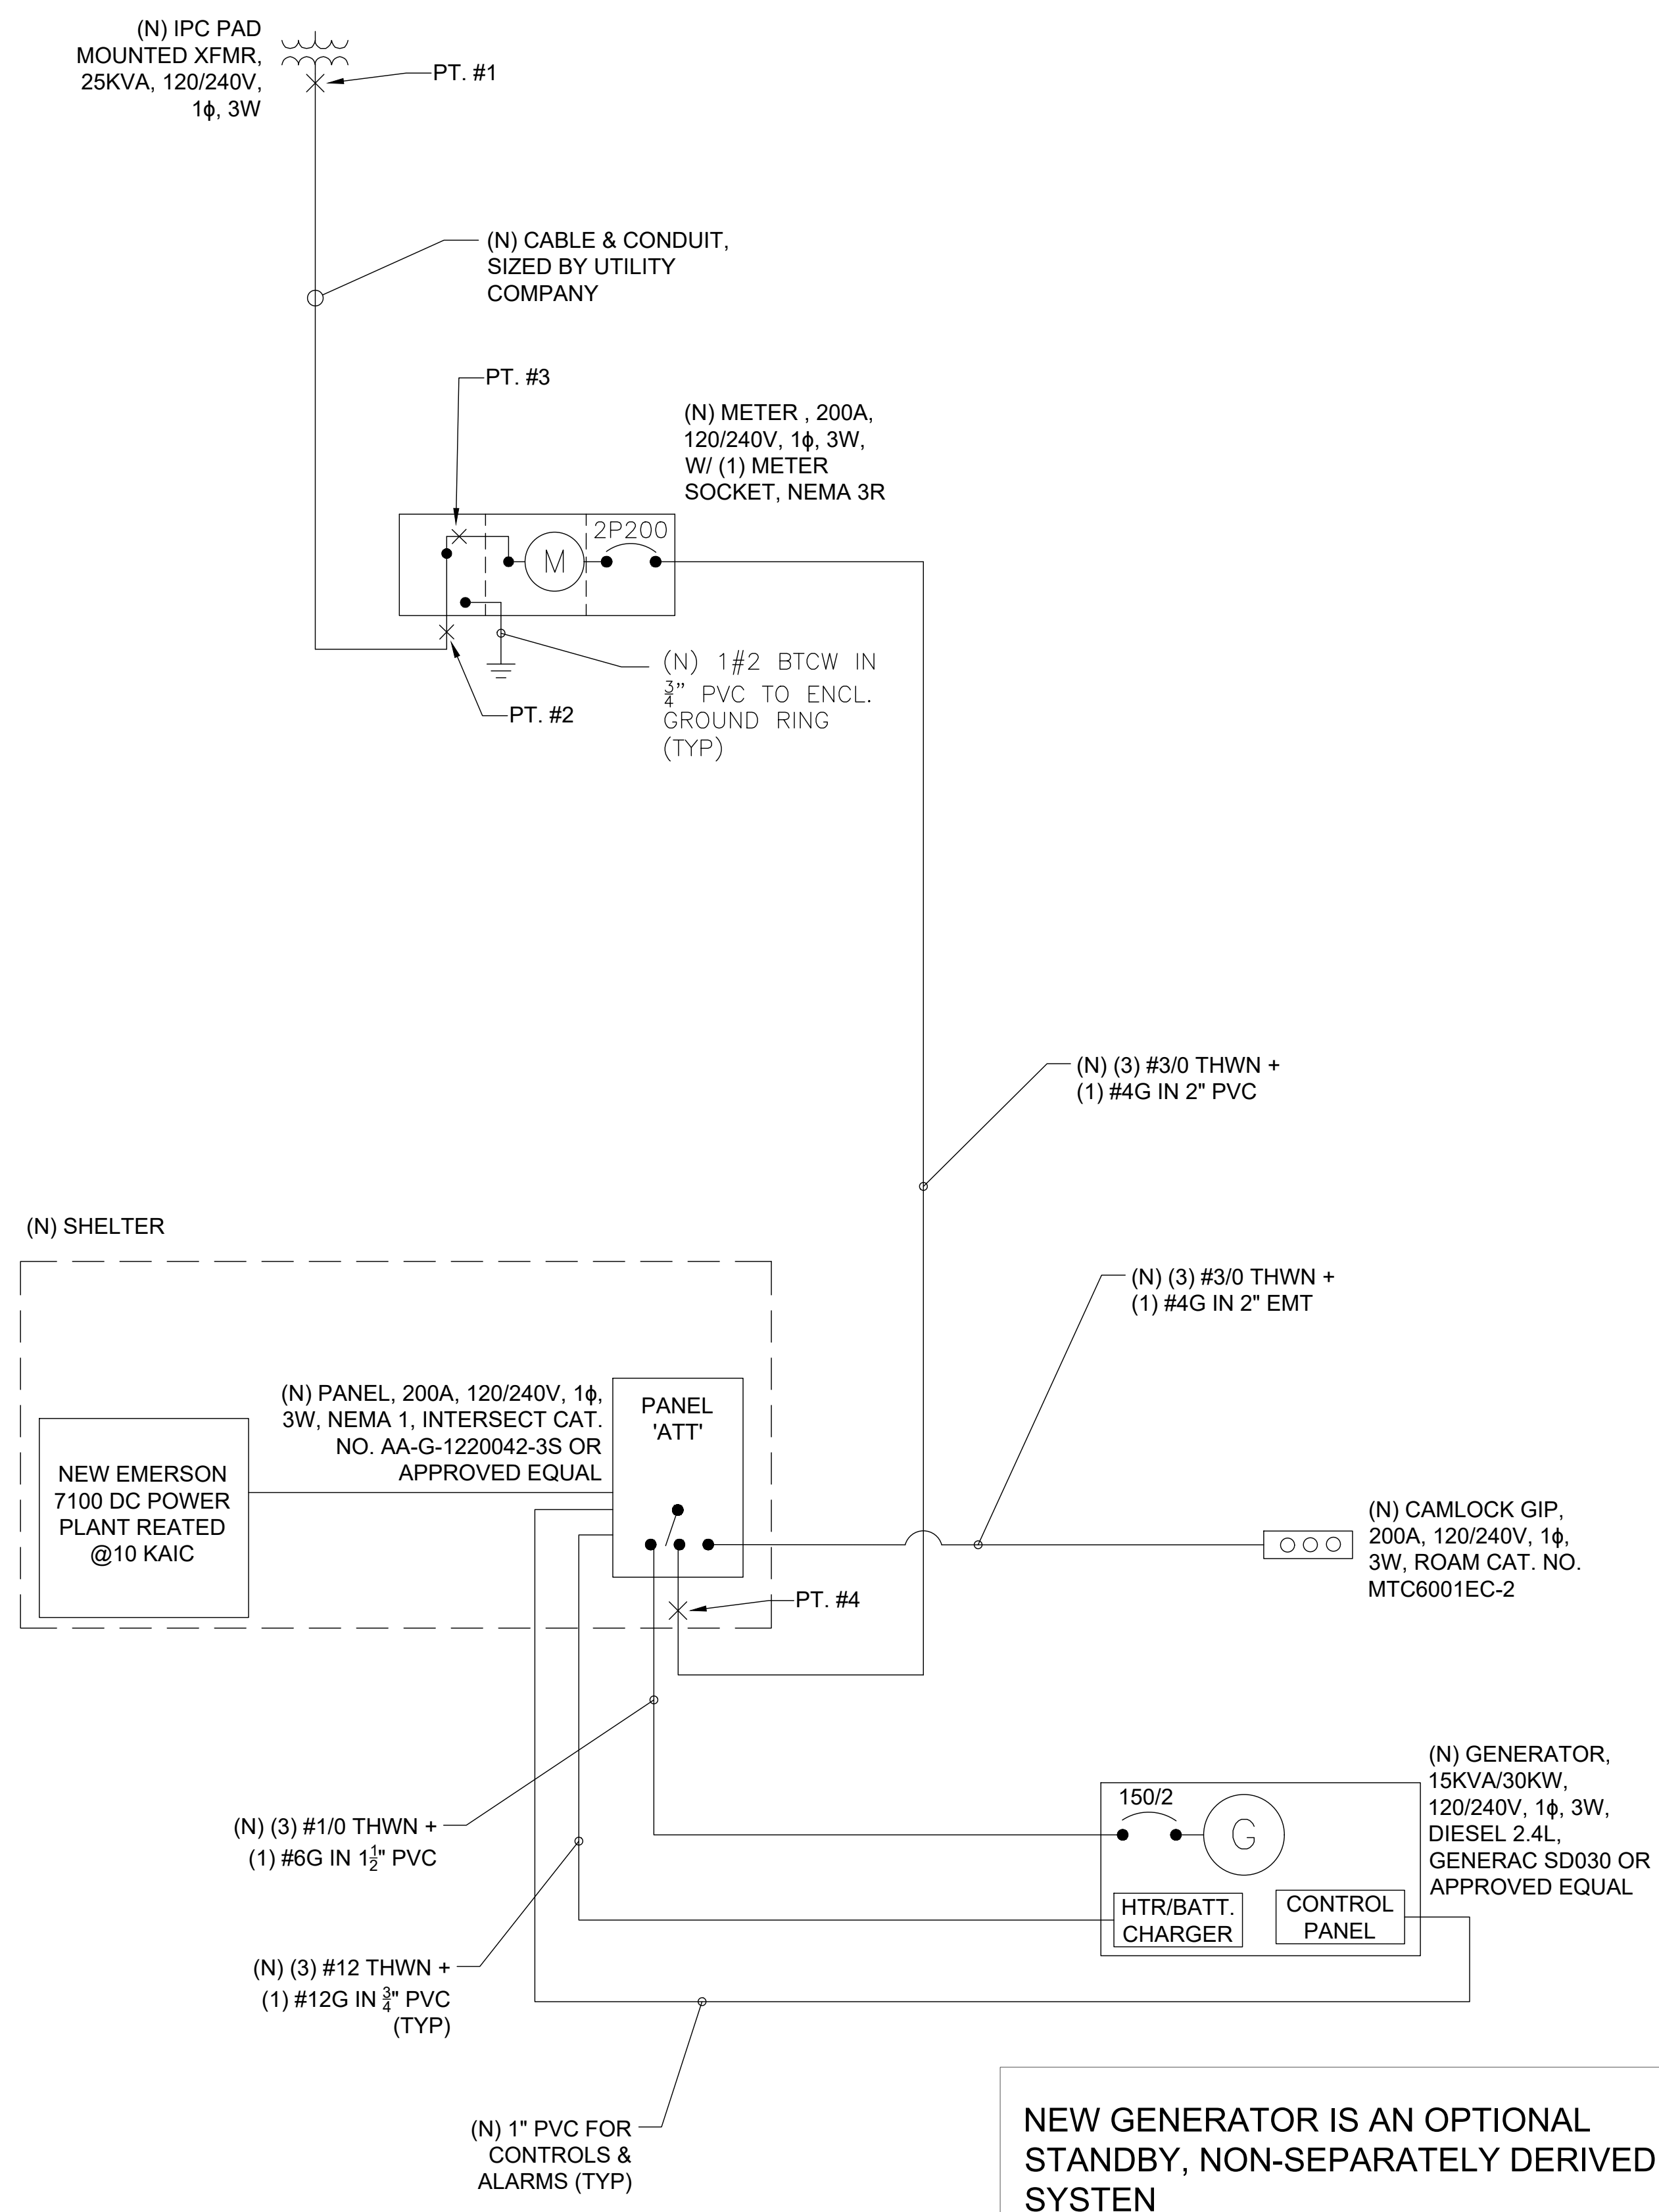

NOTES:
1. ACTUAL VALUES FOR FAULT CURRENT SHOWN IN DETAIL 1.

AC POWER PANEL No. 1
120/240 VOLTS, 1-PHASE, 3-WIRE, 200

DESCRIPTION	MAIN BREAKER RATING (A) :		200		SYSTEM VOLTAGE (V) :		240		DESCRIPTION	
	VA	c/nc	BKR	POSN	L1	L2	POSN	BKR		c/nc
RECTIFIER # 1	1725	c	30	3	3450		2	30	c	1725
	1725	c			3450	4	1725			
RECTIFIER # 2	1725	c	30	5	3450		6	30	c	1725
	1725	c			3450	8	1725			
RECTIFIER # 3	1725	c	30	7	3450		10	30	c	1725
	1725	c			3450	12	1725			
RECTIFIER # 7	1725	c	30	11	1725		14	30		
	1725	c			1725	16				
RECTIFIER # 8 / SPARE			30	17	0		18	30		
					0	20				
RECTIFIER # 9 / SPARE			30	21	0		22	30		
					0	24				
HVAC	2122	c	25	25	2482		26	20	nc	360
	2122	c			2482	28	360			
GFCI	180	nc	20	29	360		30	20	c	180
PHASE TOTALS (VA):					14917	14557				
CURRENT PER PHASE (A):					154	151	Amperes/phase cannot exceed main breaker rating			
PANEL TOTAL (VA):					29474	Legend: c = continuous, nc = non-continuous				
PANEL CAPACITY (kVA):					48.0	CONNECTED LOAD (kVA): 29.5				
PANEL LOADING (100% non-cont. load) (kVA):					0.9					
PANEL LOADING (125% continuous load) (kVA):					35.7					
PANEL LOADING (TOTAL) (kVA):					36.6					
SPARE CAPACITY (kVA):					11.4					

3 PANEL SCHEDULE
N.T.S.

SHORT CIRCUIT CALCULATIONS BASED UPON POINT METHOD AS ILLUSTRATED IN BUSSMAN PUBLICATION SPD-90. FAULT VALUES SHOWN ARE FOR LINE-TO-LINE FAULT @ 240 VAC

FAULT CURRENT AT TRANSFORMER SECONDARY PER LOCAL POWER COMPANY

$$I_{sc1} = \frac{V_{out}/V_{s-out} \times M_{tr} \times I_{scp-out}}{2 \times L \times I_{sc(L-L)}} = \frac{2 \times 10 \times 12175}{22737 \times 1 \times 240} = 12175 \text{ A}$$

$$f_1 = \frac{1}{1 + f_1} = \frac{1}{1 + 0.0446} = 0.9573$$

FAULT CURRENT AT METER BANK

$$I_{sc2} = M_1 \times I_{sc1} = 0.957 \times 12175 = 11652 \text{ A}$$

$$f_2 = \frac{2 \times L \times I_{sc(L-L)}}{C_2 \times n \times V_{L-L}} = \frac{2 \times 3 \times 11652}{36500 \times 240} = 0.0080$$

$$M_2 = \frac{1}{1 + f_2} = \frac{1}{1 + 0.0080} = 0.9921$$

FAULT CURRENT AT METER BANK BUSBAR

$$I_{sc3} = M_2 \times I_{sc2} = 0.9921 \times 11652 = 11560 \text{ A}$$

$$f_3 = \frac{2 \times L \times I_{sc(L-L)}}{C_3 \times n \times V_{L-L}} = \frac{2 \times 50 \times 11560}{13923 \times 1 \times 240} = 0.3460$$

$$M_3 = \frac{1}{1 + f_3} = \frac{1}{1 + 0.3460} = 0.7429$$

FAULT CURRENT AT PANEL 'ATT'

$$I_{sc4} = M_3 \times I_{sc3} = 0.7429 \times 11560 = 8588 \text{ A}$$

1 FAULT CALCULATIONS
N.T.S.

SITE TYPE: MONOPOLE/WIC

AT&T Site ID:
COL02568
6915 SPACE VILLAGE AVENUE
COLORADO SPRINGS, CO 80915

Tower Owner:
CROWN CASTLE
2055 SOUTH STEARMAN DRIVE
CHANDLER, AZ 85286

PREPARED FOR:
at&t Mobility
161 Inverness Drive West 2nd floor
Englewood, Colorado 80112

A&E:
TELCYTE
INFRASTRUCTURE SERVICES
3450 N HIGLEY RD - SUITE 102,
MESA, AZ 85215

AT&T SITE NO: COL02568
BU NO: 823722
DRAWN BY: AK
CHECKED BY: CM

REV	DATE	DESCRIPTION
A	2/25/22	PRELIMINARY CD'S
B	03/21/22	CLIENT REVISIONS
C	5/19/22	CLIENT REVISIONS

Licenser:

SIGNED: 19 MAY 2022

IT IS A VIOLATION OF LAW FOR ANY PERSON, UNLESS THEY ARE ACTING UNDER THE DIRECTION OF A LICENSED PROFESSIONAL ENGINEER, TO ALTER THIS DOCUMENT.

Issued For:
5/19/22
PRELIMINARY CD'S


SHEET TITLE:
POWER ONE-LINE DIAGRAM

SHEET NUMBER:
E-3

2 ONE-LINE DIAGRAM
N.T.S.

Site Plan Drawing_v1.pdf Markup Summary

[1] 823722_PETERSON AFB NORTH_RELO_COL02568_REV C_PCD_04.06.22 (Approved, TA, 19 May 2022)-T-1 (2)

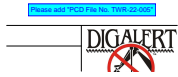

Page Label: [1] 823722_PETERSON AFB
NORTH_RELO_COL02568_REV C_PCD_04.06.22
(Approved, TA, 19 May 2022)-T-1
Author: Carlos


Please add "PCD File No. TWR-22-005"




Page Label: [1] 823722_PETERSON AFB
NORTH_RELO_COL02568_REV C_PCD_04.06.22
(Approved, TA, 19 May 2022)-T-1
Author: ashmathy

Please include:
-signature block for PCD department, 1-2 inches

[9] 823722_PETERSON AFB NORTH_RELO_COL02568_REV C_PCD_04.06.22 (Approved, TA, 19 May 2022)-A-1 (2)

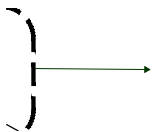

Page Label: [9] 823722_PETERSON AFB
NORTH_RELO_COL02568_REV C_PCD_04.06.22
(Approved, TA, 19 May 2022)-A-1
Author: ashmathy

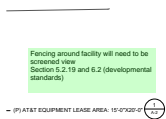

Page Label: [9] 823722_PETERSON AFB
NORTH_RELO_COL02568_REV C_PCD_04.06.22
(Approved, TA, 19 May 2022)-A-1
Author: ashmathy

Fencing around facility will need to be screened
view
Section 5.2.19 and 6.2 (developmental standards)

[10] 823722_PETERSON AFB NORTH_RELO_COL02568_REV C_PCD_04.06.22 (Approved, TA, 19 May 2022)-A-2 (1)



Page Label: [10] 823722_PETERSON AFB
NORTH_RELO_COL02568_REV C_PCD_04.06.22
(Approved, TA, 19 May 2022)-A-2
Author: ashmathy

Please include:
-location and dimension of rights of way and
existing and proposed easements
-setback distances from each existing and
proposed structure to the property lines