

*Please show and label all the existing utility easements, and provide reception number or book, and page numbers.

*Please show the proposed gas and electric meter locations.

*Please show the proposed transformer location.

1919 MAIN STREET, LLC
1919 MAIN STREET
PARCEL NO: 65020-00-028
ZONE: CC CAD-O
USE: SERVICE GARAGE

GREAT DANE VENTURES, LLC
MAIN STREET
PARCEL NO: 65020-00-061
ZONE: CC CAD-O
USE: OFFICE/WAREHOUSE

RONALD D. BLAIR
1845 MAIN STREET
PARCEL NO: 65020-00-059
ZONE: CC CAD-O
USE: MERCHANDISING

1831 MAIN PROPERTIES, LLC
1831 MAIN STREET
PARCEL NO: 65020-00-065
ZONE: CC CAD-O
USE: MERCHANDISING

ELM GROVE TOWNHOME OWNERS
ELM GROVE DRIVE
PARCEL NO: 65013-12-055
ZONE: RM-30 CAD-O
USE: RESIDENTIAL

ELM GROVE TOWNHOME OWNERS
ELM GROVE DRIVE
PARCEL NO: 65013-12-045
ZONE: RM-30 CAD-O
USE: RESIDENTIAL

PIKES PEAK CHRISTIAN CHURCH
4455 BRADLEY ROAD
PARCEL NO: 65013-18-001
ZONE: A-5 CAD-O
USE: RELIGIOUS WORSHIP

GALLOWAY - Basin limits
revised to remain outside
of the easement

It appears that the proposed water
quality basin is shown in the existing
utilities easement. Water quality
basins (including any retaining walls)
are not allowed in any public utilities
easements.


ADA NOTES

THE PARTIES RESPONSIBLE FOR THIS PLAN HAVE FAMILIARIZED THEMSELVES WITH ALL CURRENT ACCESSIBILITY CRITERIA AND SPECIFICATIONS AND THE PROPOSED PLAN REFLECTS ALL SITE ELEMENTS REQUIRED BY THE APPLICABLE ADA DESIGN STANDARDS AND GUIDELINES AS PUBLISHED BY THE UNITED STATES DEPARTMENT OF JUSTICE. APPROVAL OF THIS PLAN BY EL PASO COUNTY DOES NOT ASSURE COMPLIANCE WITH THE ADA OR ANY REGULATIONS OR GUIDELINES ENACTED OR PROMULGATED UNDER OR WITH RESPECT TO SUCH LAWS.

DRAWING INDEX

CO-0	1 OF 27 - SITE PLAN & PROJECT INFORMATION, DRAWING INDEX
CO-1	2 OF 27 - SITE DETAILS
CO-2	3 OF 27 - COVER SHEET
CO-3	4 OF 27 - NOTES
CO-4	5 OF 27 - DEMOLITION PLAN
CO-5	6 OF 27 - SITE PLAN
CO-6	7 OF 27 - HORIZONTAL CONTROL PLAN
CO-7	8 OF 27 - PAVING & STRIPING PLAN
CO-8	9 OF 27 - SITE DETAILS
CO-9	10 OF 27 - EROSION CONTROL
CO-10	11 OF 27 - EROSION CONTROL INTERIM PLAN
CO-11	12 OF 27 - GRADING & EROSION CONTROL FINAL PLAN
CO-12	13 OF 27 - GEC DETAILS
CO-13	14 OF 27 - GEC DETAILS
CO-14	15 OF 27 - GEC DETAILS
CO-15	16 OF 27 - GEC DETAILS
CO-16	17 OF 27 - WATER QUALITY DETENTION POND
CO-17	18 OF 27 - POND DETAILS
CO-18	19 OF 27 - UTILITY SERVICE PLAN
CO-19	20 OF 27 - UTILITY DETAILS
CO-20	21 OF 27 - LANDSCAPE PLAN - AREA A
CO-21	22 OF 27 - LANDSCAPE PLAN - AREA B
CO-22	23 OF 27 - LANDSCAPE DETAILS & NOTES
CO-23	24 OF 27 - SITE PHOTOMETRIC PLAN
CO-24	25 OF 27 - LIGHTING CUT SHEET 1 OF 2
CO-25	26 OF 27 - LIGHTING CUT SHEET 2 OF 2
CO-26	27 OF 27 - DP BUILDING ELEVATIONS

VICINITY MAP

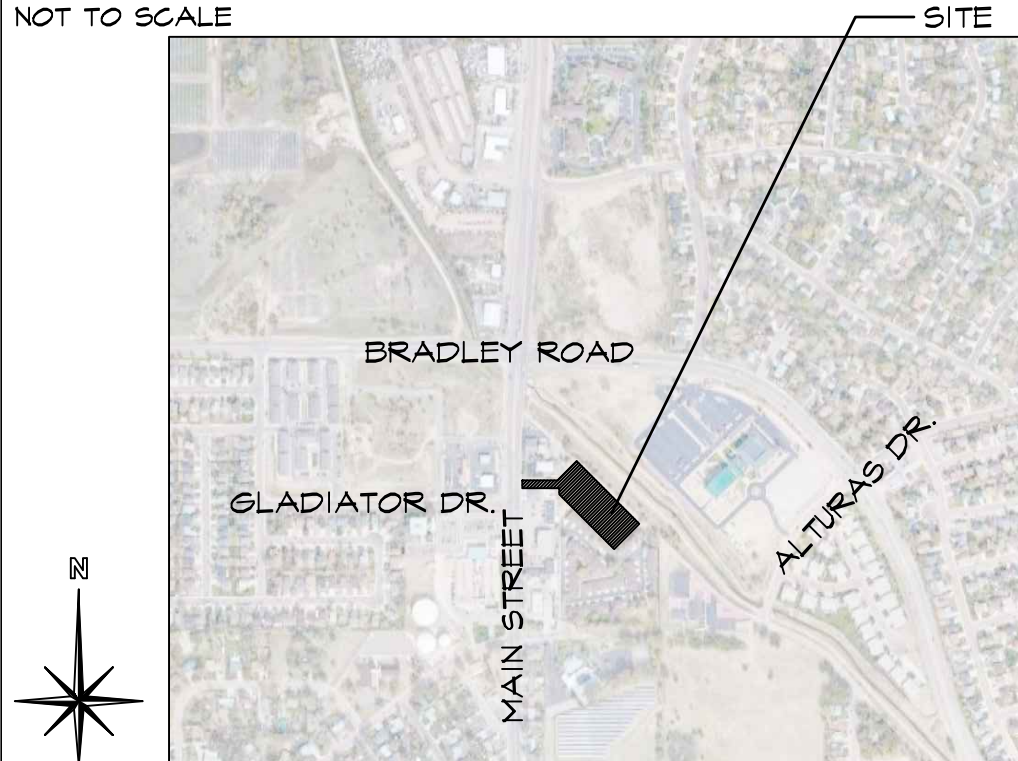

PROJECT INFORMATION

PROPERTY INFORMATION	
OWNER NAME:	GREAT DANE VENTURES, LLC
LOT:	5403 HIGH NOON AVE
ADDRESS:	COLORADO SPRINGS, CO 80923
LEGAL DESCRIPTION:	LOT 2, ELM GROVE VILLA SUBDIVISION
PARCEL NUMBER:	65013-12-002
ZONING:	CC CAD-O
LOT SIZE:	10,567 SF (1.62 ACRES)
CURRENT USE:	VACANT
FLOODPLAIN STATEMENT:	ZONE X (MAP NO. 0804107635, DATED DEC 7, 2018)
ZONING CODE STUDY	
PROPOSED PRINCIPAL USE:	OFFICE, WAREHOUSE, WASH BAY & AUTO REPAIR, CONT. EQUIP. YARD
STRUCTURAL COVERAGE:	17%
PAVEMENT COVERAGE:	26%
STREET COVERAGE:	0%
LANDSCAPE COVERAGE:	6%
BUILDING STRUCTURAL HEIGHT:	21'-4 3/4" (45'-0" MAX)
FRONT YARD SETBACK:	50'-0"
SIDE YARD SETBACK:	25'-0"
REAR YARD SETBACK:	25'-0"
BUILDING INFORMATION	
GROSS BUILDING AREA:	14,500 SF
BUILDING FOOTPRINT:	12,000 SF
BUILDING OCCUPANCY:	B/S-1
TYPE OF CONSTRUCTION:	II-B
FIRE SYSTEMS:	NONE
AREA SEPARATION WALLS:	NONE
REQUIRED PARKING SPACES	
OFFICE-(1 SPACE/200 S.F.)	18
(3,500 S.F. / 200 S.F.)	
STORAGE/MEZZ-(1 SPACE/1,000 S.F.)	3
(2,500 S.F. / 1,000 S.F.)	
WAREHOUSE-(1 SPACE/1,000 S.F.)	4
(8,500 S.F. / 1,000 S.F.)	
H.C.-(1 SPACE/25 REQ'D)	30
TOTAL PARKING SPACES REQUIRED:	30
TOTAL PARKING PROVIDED:	31
STANDARD SPACES PROVIDED:	2
H.C. SPACES PROVIDED:	5
PARALLEL SPACES PROVIDED:	1 (14'x18')
LOADING SPACE PROVIDED:	(SEE DETAIL 1/2 FOR DIMENSIONS)
DEVELOPMENT SCHEDULE	
CONSTRUCTION:	FALL 2021
LANDSCAPING:	SPRING 2022
DEVELOPMENT APPLICANT	
COMPANY:	HAMMERS CONSTRUCTION, INC.
	1411 WOOLSEY HEIGHTS
	COLORADO SPRINGS, CO 80915
PHONE NUMBER:	(719)-570-1549
FAX NUMBER:	(719)-570-1008
APPLICANT NAME:	LISA PETERSON
APPLICANT E-MAIL:	lpeterson@hammersconstruction.com


SITE LEGEND

---	PROPERTY LINE
---	RIGHT OF WAY
---	BUILDING SETBACK
---	LANDSCAPE SETBACK
---	UTILITY/DRAINAGE EASEMENT
---	ELECTRICAL EASEMENT
---	ACCESS EASEMENT
---	OPAQUE CHAINLINK FENCE
---	6" HIGH WROUGHT IRON FENCE
---	GAS LINE
---	WATER LINE
---	ELECTRICAL LINE
---	SANITARY SEWER LINE
---	STORM SEWER LINE
---	RETAINING WALL
---	NEW SIDEWALK LOCATIONS
---	W CONTROL JOINTS @ 5'-0" O.C.
●	PROPERTY CORNER
→	TRAFFIC FLOW
□	WALL PACK LIGHTING
+	SIGN
○	MANHOLE
⊞	ELECTRICAL TRANSFORMER
○	EXISTING FIRE HYDRANT
●	PROPOSED FIRE HYDRANT
⌈	WALK DOOR OR OVERHEAD DOOR LOCATIONS

① SITE PLAN (CONCEPT)

SCALE: 1"=30'-0"

NEW RETAINING WALL
SEE DTL. 5/2 (REFER
TO CIVIL PLANS FOR
WALL HEIGHTS)

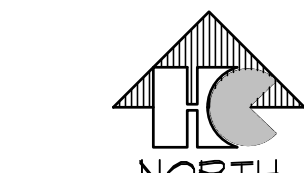

NORTH
GRAPHIC SCALE

(IN FEET)
1 inch = 30' ft.


HAMMERS
CONSTRUCTION INC.
COMMERCIAL GENERAL CONTRACTORS SPECIALIZING IN DESIGN/BUILD
PRESIDENT: STEVE R. HAMMERS
VICE PRES: DAVID J. HAMMERS
1411 WOOLSEY HEIGHTS
COLORADO SPRINGS, CO 80915
(719) 570-1549 FAX (719) 570-1008
www.hammersconstruction.com

THIS DRAWING CONTAINS MATERIAL & INFORMATION WHICH MAY NOT BE REPRODUCED WITHOUT WRITTEN CONSENT OF HAMMERS CONSTRUCTION, INC. THESE DRAWINGS ARE INTENDED TO BE USED ONLY BY HAMMERS CONSTRUCTION & ITS REPRESENTATIVES. THESE DRAWINGS HAVE NOT BEEN PREPARED FOR ANY OTHER PURPOSE THAN TO INDICATE THE GENERAL FEATURES AND PLACEMENT OF THE PROPOSED PROJECT. COPYRIGHT © 2021 HAMMERS CONSTRUCTION


SMITH PLUMBING & HTG
1875 MAIN STREET
COLORADO SPRINGS, CO 80911
EL PASO COUNTY, COLORADO

DATE: SEP 1, 2021
DRAWN BY: J. LATHAM
PROJ. MGR: R. GREEN
SCALE: SEE PLAN
APPROVED BY:
JOB NO: 1244


RESUBMITTALS:
▲
▲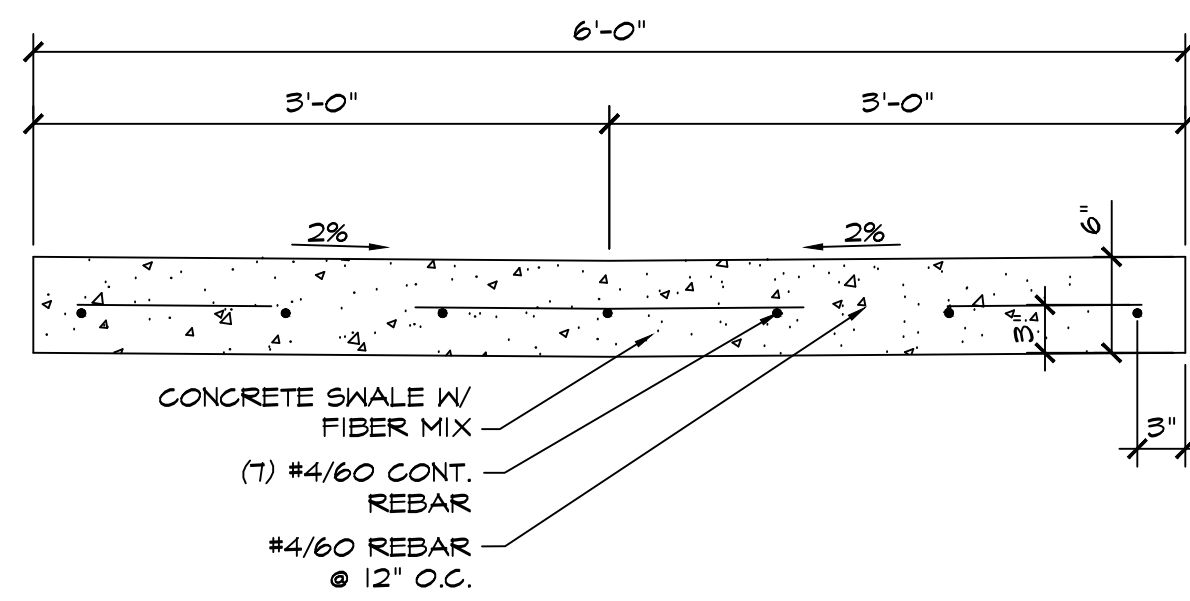

11 6'-0" CROSSSPAN DETAIL
SCALE: 1"=1'-0"

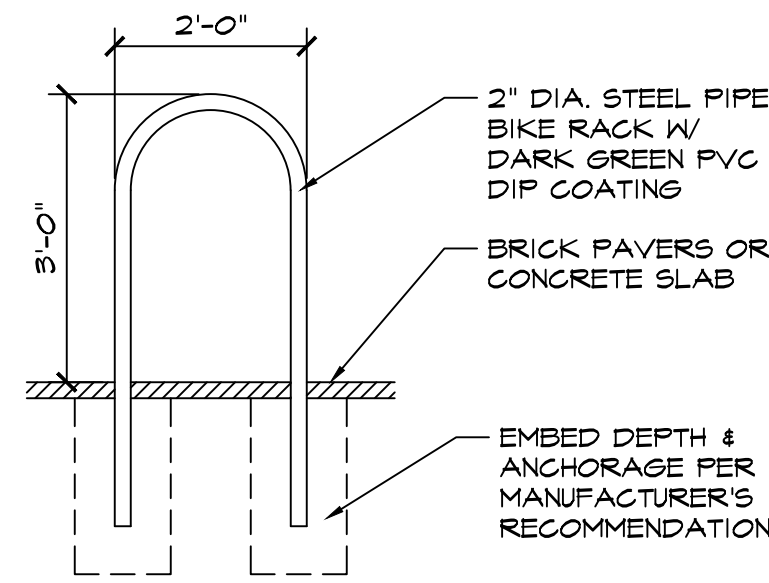


8 BIKE RACK DETAIL
SCALE: 1/2"=1'-0"

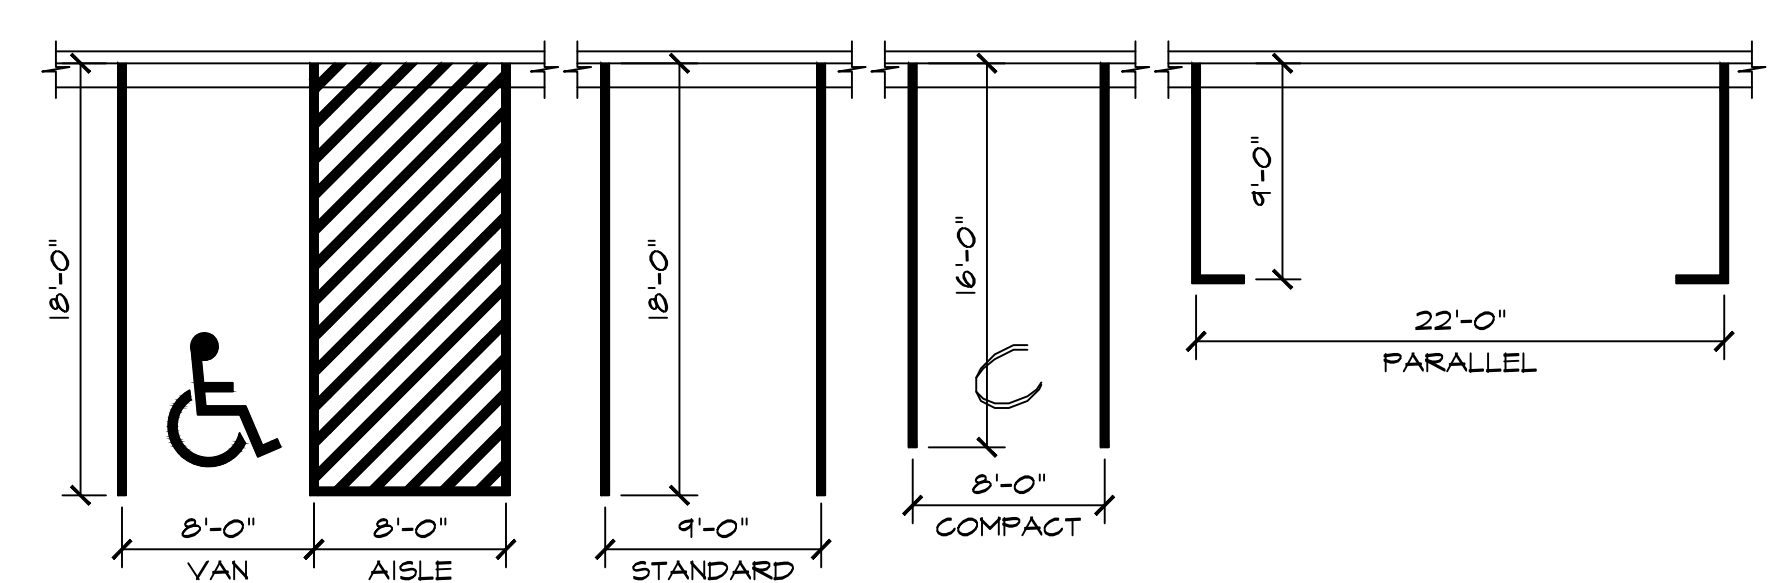


1 ADA / STANDARD PARKING
SCALE: 1/8"=1'-0"

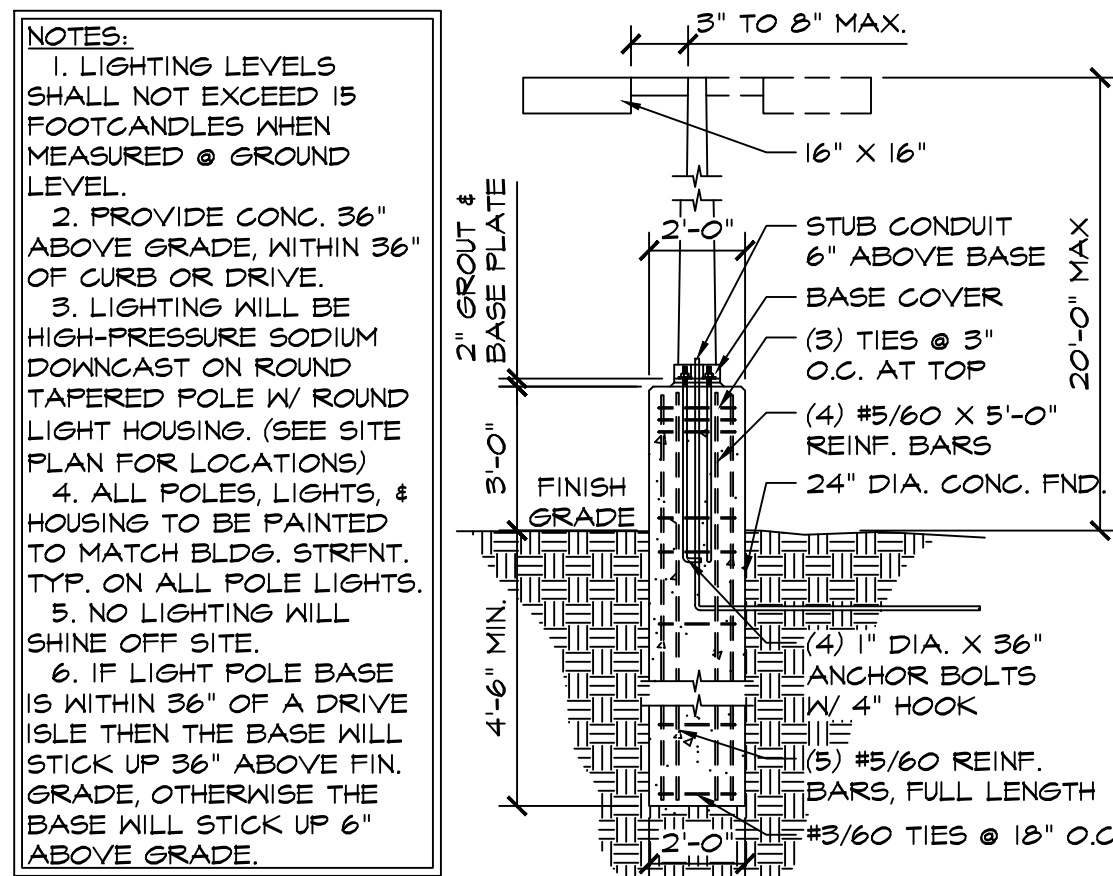




9 LIGHT POLE BASE DETAIL
SCALE: 1/4"=1'-0"

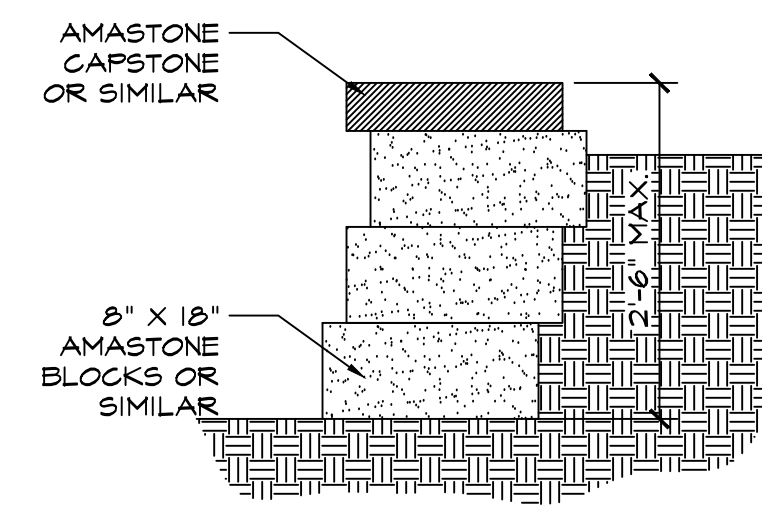

5 RETAINING WALL DETAIL
SCALE: 3/4"=1'-0"

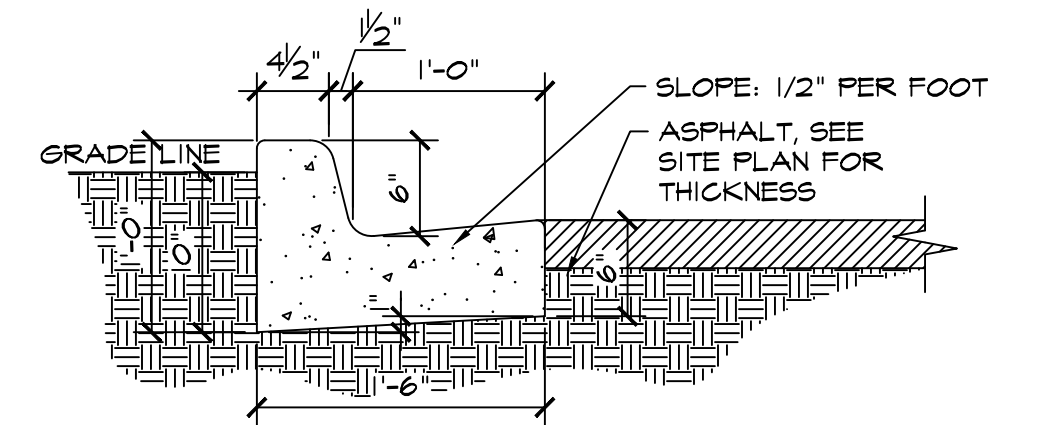


2 EPC TYPE B CURB
SCALE: 1"=1'-0"

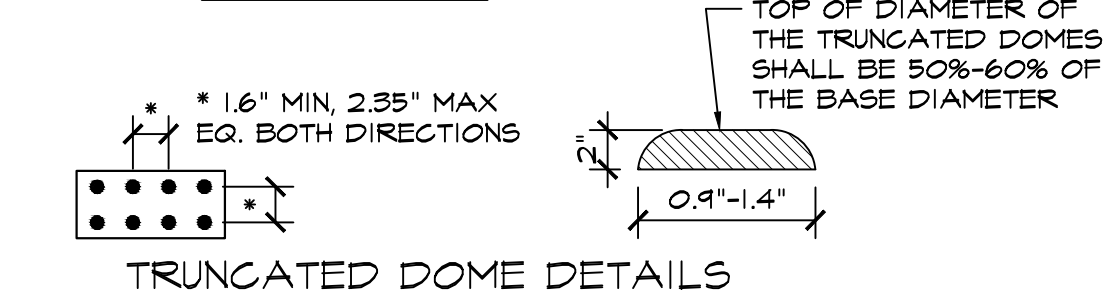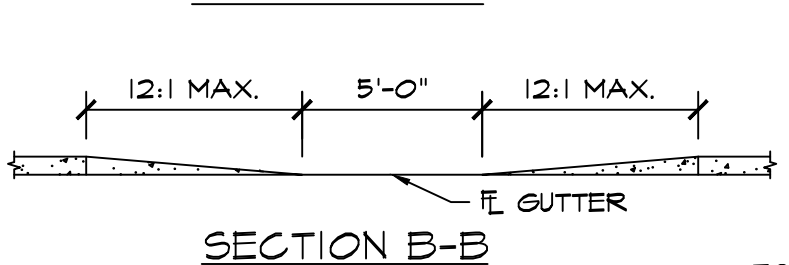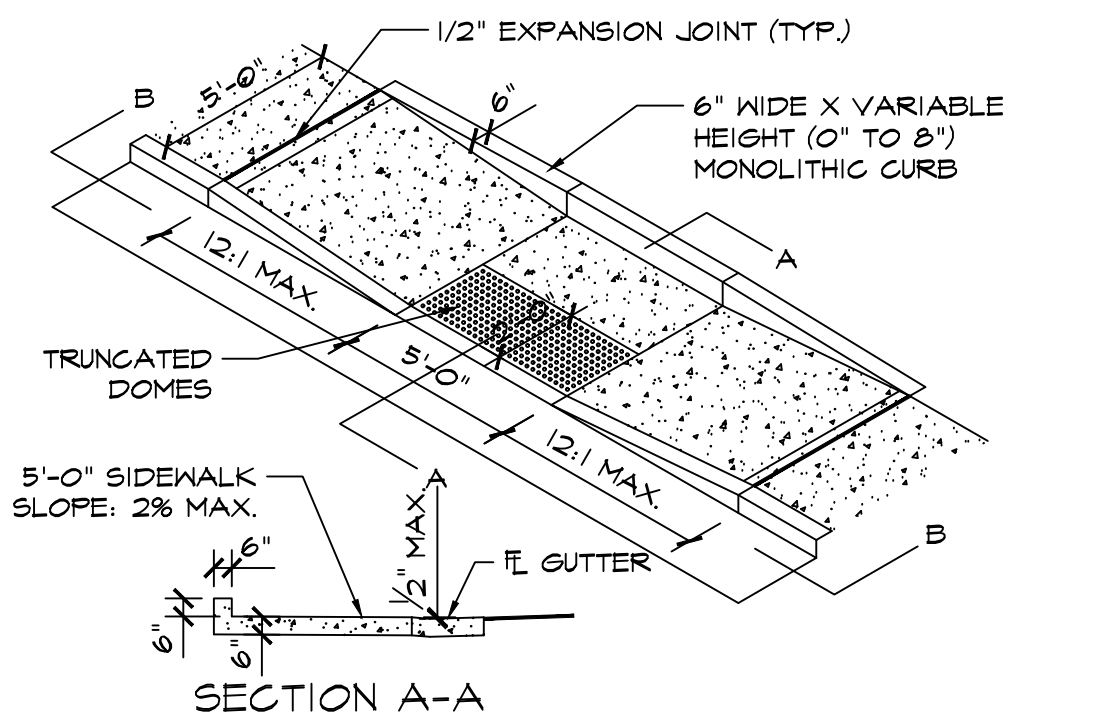


GENERAL NOTES:
1. ALL WORK TO BE DONE IN ACCORDANCE WITH CURRENT EL PASO COUNTY ENGINEERING DIVISION STANDARD SPECIFICATIONS.
2. SIDEWALK CROSS-SLOPE: 1/4"/FT.
3. CONTRACTOR TO OBTAIN REQUIRED CONCRETE PERMIT AND RAMP PERMIT AT ENGINEERING DIVISION INSPECTION OFFICE PRIOR TO CONSTRUCTION.
4. CONTRACTOR TO NOTIFY ENGINEERING DIVISION INSPECTION OFFICE AT LEAST 24 HOURS PRIOR TO PLACEMENT OF ANY CONCRETE.
5. THE RAMP SURFACES SHALL BE FINISHED WITH A COARSE BROOM FINISH, PARALLEL WITH THE SCORING IN ACCORDANCE WITH SECTION 504.05 OF THE STANDARD SPECIFICATIONS.
6. CONTRACTOR SHALL STAMP THE COMPANY NAME AND CONSTRUCTION DATE WITHIN THE PEDESTRIAN RAMP AREA.
7. PEDESTRIAN TRAVELWAY AND/OR LOCATION OF EXISTING OR FUTURE PEDESTRIAN RAMPS ON OPPOSITE CORNERS SHALL BE REVIEWED BEFORE CONSTRUCTING NEW RAMPS. NEW RAMPS SHALL ALIGN WITH EXISTING RAMPS AND PEDESTRIAN TRAVELWAY.
8. SHADED AREA: 6" THICK CONCRETE


10 PEDESTRIAN RAMP DETAIL D-BJ
SCALE: 3/16"=1'-0"

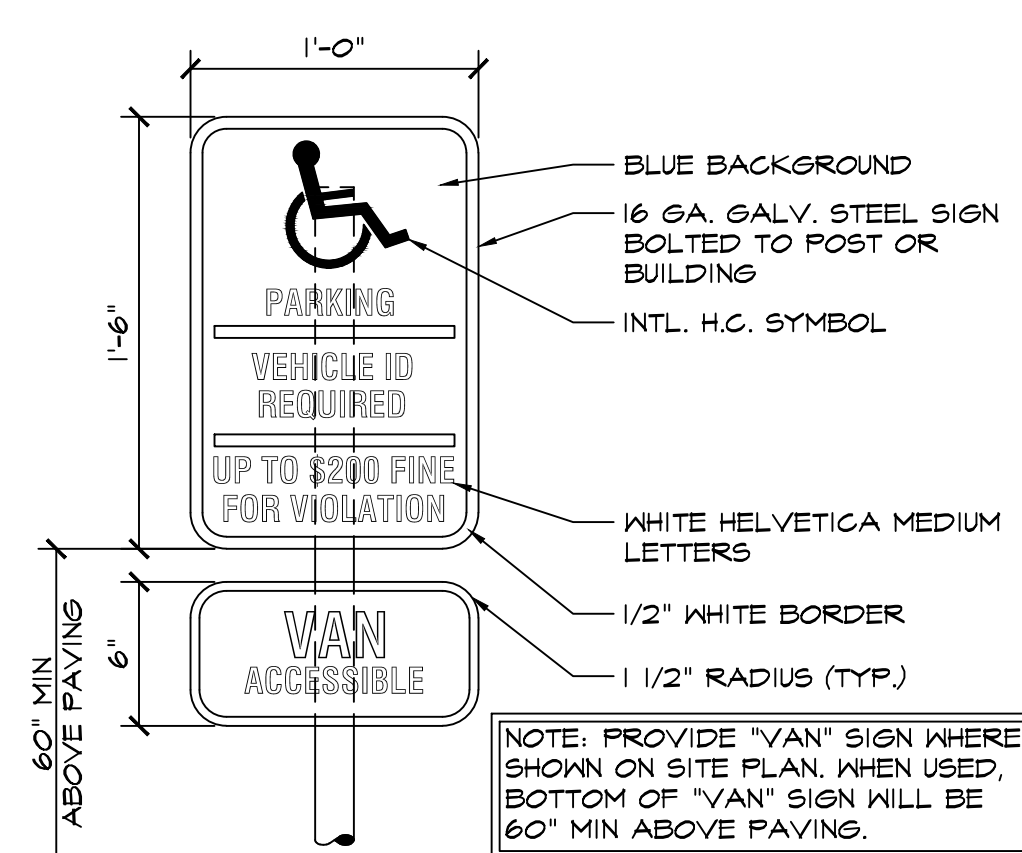


6 HANDICAPPED PARKING SIGN
SCALE: 1 1/2"=1'-0"

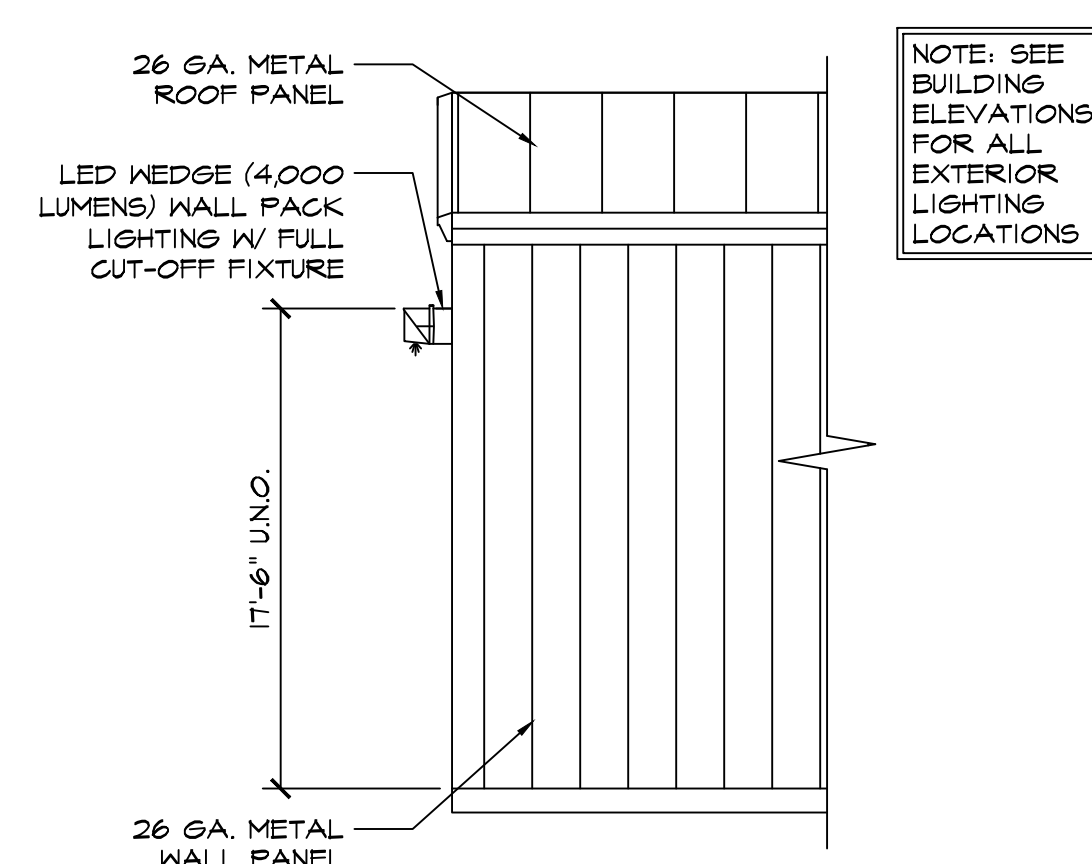

7 WALL PACK LIGHT DETAIL
SCALE: 1/4"=1'-0"

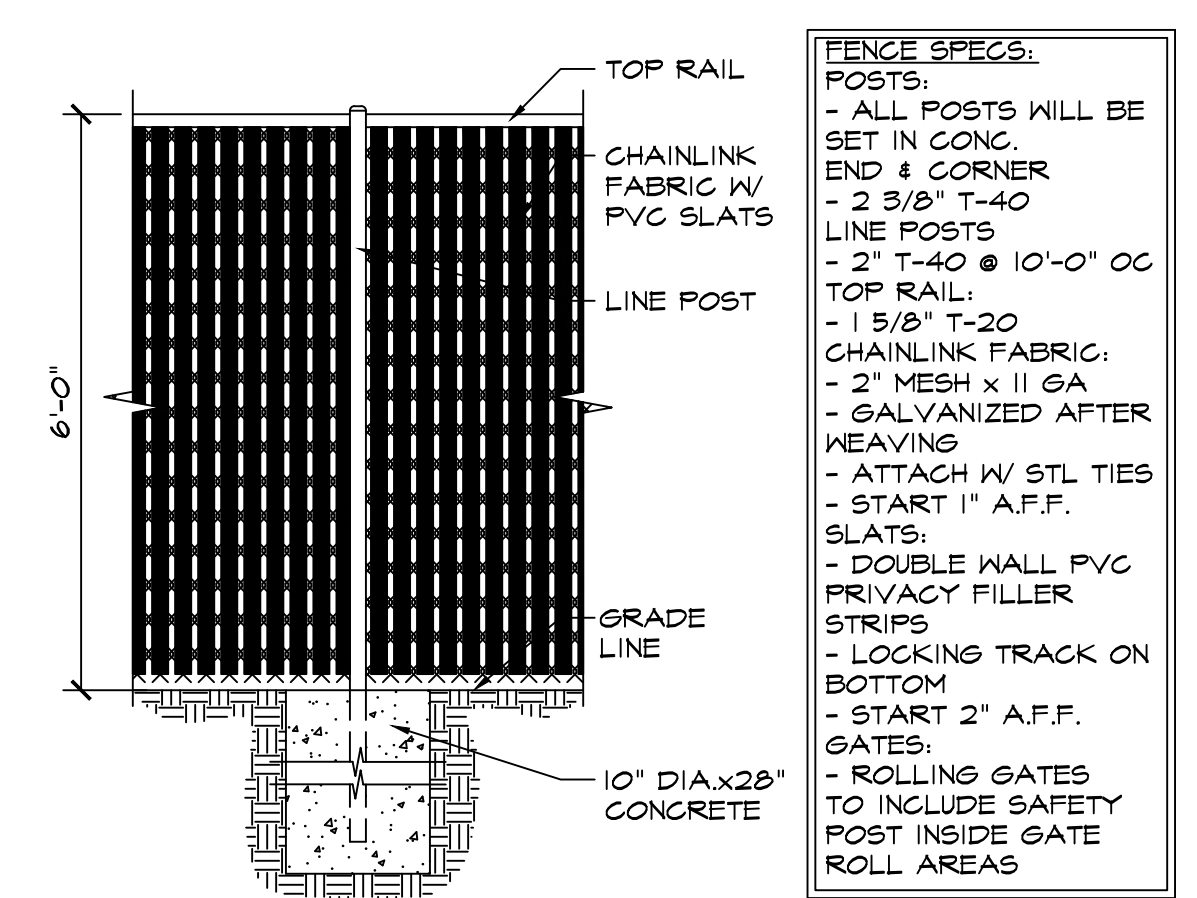

3 CHAINLINK FENCE DETAIL
SCALE: 1/2"=1'-0"

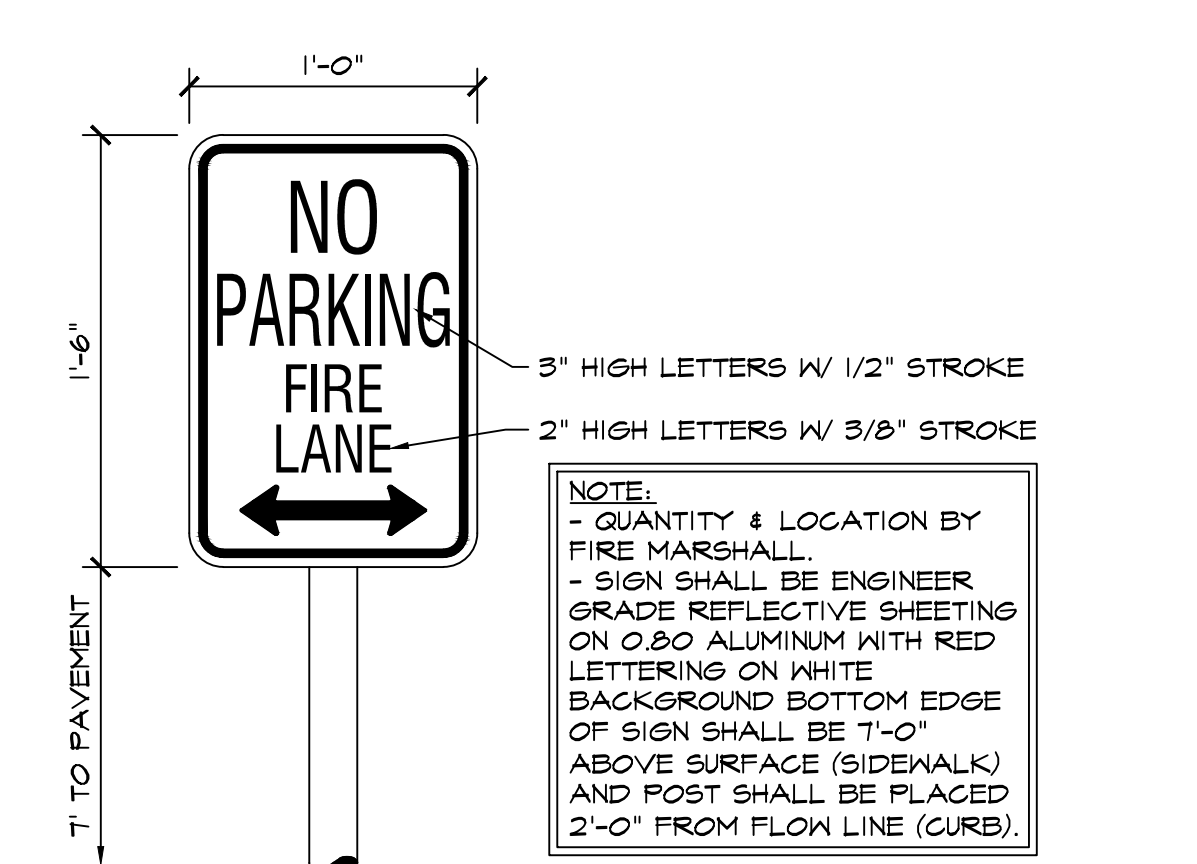

4 FIRE LANE SIGN
SCALE: 1 1/2"=1'-0"

THIS DRAWING CONTAINS MATERIAL & INFORMATION WHICH MAY NOT BE REPRODUCED WITHOUT WRITTEN CONSENT OF HAMMERS CONSTRUCTION INC. THESE DRAWINGS ARE INTENDED TO BE USED ONLY BY HAMMERS CONSTRUCTION & ITS REPRESENTATIVES. THESE DRAWINGS HAVE NOT BEEN PREPARED FOR ANY OTHER PURPOSE THAN TO INDICATE THE GENERAL FEATURES AND PLACEMENT OF THE PROPOSED PROJECT. COPYRIGHT © 2021 HAMMERS CONSTRUCTION

DATE: SEP 1, 2021
DRAWN BY: J. LATHAM
PROJ. MGR: R. GREEN
SCALE: SEE PLAN
APPROVED BY:
JOB NO: 1244

RESUBMITTALS:
▲
▲
DATE: SEP 1, 2021
DRAWN BY: J. LATHAM
PROJ. MGR: R. GREEN
SCALE: SEE PLAN
APPROVED BY:
JOB NO: 1244

RESUBMITTALS:
▲
▲
