SITE DEVELOPMENT PLAN AND WSEO COMPLIANCE PLAN PALMER SOLAR PROJECT AND WILLIAMS CREEK SUBSTATION EL PASO COUNTY, CO


A TRACT LOCATED IN SECTIONS 21, 22, 26, 27, 28, 35, TOWNSHIP 16 SOUTH, ALL IN RANGE 65 WEST OF THE 6TH PRINCIPAL

STANDARD NOTES:

- 1. ALL DRAINAGE AND ROADWAY CONSTRUCTION SHALL MEET THE STANDARDS AND SPECIFICATIONS OF THE CITY OF COLORADO SPRINGS. EL PASO COUNTY DRAINAGE CRITERIA MANUAL, VOLUMES 1 AND 2 AND THE EL PASO ENGINEERING MANUAL
- 2.CONTRACTOR SHALL BE RESPONSIBLE FOR THE NOTIFICATION AND FIELD NOTIFICATION OF ALL EXISTING UTILITIES, WHETHER SHOWN ON THE PLANS OR NOT, BEFORE BEGINNING CONSTRUCTION. LOCATION OF EXISTING UTILITIES SHALL BE VERIFIED BY THE CONTRACTOR PRIOR TO CONSTRUCTION. CALL 811 TO CONTACT THE UTILITY NOTIFICATION.
- 3.CONTRACTOR SHALL KEEP A COPY OF THESE APPROVED PLANS, THE GRADING AND EROSION CONTROL PLAN. THE STORMWATER MANAGEMENT (SWMP). THE SOILS AND GEOTECHNICAL REPORT. AND THE APPROPRIATE DESIGN AND CONTRUCTION STANDARDS AND SPECIFICATIONS AT THE JOB SITE AT ALL TIMES. INCLUDING THE FOLLOWING:
- a.EL PASO COUNTY ENGINEERING CRITERIA MANUAL (ECM).
- b.CITY OF COLORADO SPRINGS/ EL PASO COUNTY DRAINAGE CRITERIA MANUAL, VOLUMES 1 AND 2
- c. COLORADO DEPARTMENT OF TRANSPORTATION (CDOT) STANDARD SPECIFICATIONS FOR ROAD AND BRIDGE CONSTRUCTION.
- d.COOT M& S STANDARDS

APPROVED BY DSD.

- 4.NOTWITHSTANDING ANYTHING DEPICTED IN THESE PLANS IN WORDS OR GRAPHIC REPRESENTATION, ALL DESIGN AND CONSTRUCTION RELATED TO ROAD, STORM DRAINAGE, AND EROSION CONTROL SHALL CONFORM TO THE STANDARDS AND REQUIREMENTS OF THE MOST RECENT VERSION OF THE RELEVANT ADOPTED EL PASO COUNTY STANDARDS, INCLUDING THE LAND DEVELOPMENT CODE, THE ENGINEERING CRITERIA MANUAL, THE DRAINAGE CRITERIA MANUAL AND THE DRAINAGE CRITERIA MANUAL VOLUME 2. ANY DEVIATIONS FROM REGUALTIONS AND STANDARDS MSUT BE REQUESTED AND APPROVED IN WRITING. ANY MODIFICATIONS NECESSARY TO MEET CRITERIA AFTER-THE-FACT WILL BE ENTIRELY THE DEVELOPERS RESPONSIBILITY TO RECTIFY.
- 5.IT IS THE DESIGN ENGINEER'S RESPONSIBILITY TO ACCURATELY SHOW EXISTING CONDITIONS, BOTH ONSITE AND OFFSITE ON THE CONSTRUCTION PLANS. ANY MODIFICATIONS NECESSARY DUE TO CONFLICTS, OMISSIONS, OR CHANGED CONDITIONS WILL BE ENTIRELY THE DEVELOPERS RESPONSIBILITY TO RECTIFY.
- 6.CONTRACTOR SHALL SCHEDULE A PRE-CONSTRUCTION MEET WITH EL PASO COUNTY DEVELOPMENT SERVICES DEPARTMENT (DSO)— INSPECTIONS PRIOR TO STARTING
- 7.IT IS THE CONTRACTOR'S RESPONSIBILITY TO UNDERSTAND THE REQUIREMENTS OF ALL JURISDICTIONAL AGENCIES AND TO OBTAIN ALL REQUIRED PERMITS, INCLUDING BUT NOT LIMITED TO EL PASO COUNTY EROSION AND STORMWATER QUALITY CONTROL PERMIT (ESQCP). REGINAL BUILDING FLOORPLAN DEVELOPMENT PERMIT, U.S. ARMY CORPS OF ENGINEERS- ISSUED 401 AND/ OR 404 PERMITS, AND COUNTY AND STATE FUGITIVE DUST PERMITS
- 8.CONTRACTOR SHALL NOT DEVIATE FROM THE PLANS WITHOUT FIRST OBTAINING WRITTEN APPROVAL FROM THE DESIGN ENGINEER AND DSD. CONTRACTOR SHALL NOTIFY THE DESIGN ENGINEER IMMEDIATELY UPON DISCOVERY OF ANY ERRORS OR INCONSISTENCIES. 9.ALL STORM DRAIN PIPE SHALL BE CLASS III RECP UNLESS OTHERWISE NOTED AND
- 10. CONTRACTOR SHALL COORDINATE GEOTECHNICAL TESTING PER ECM STANDARDS. PAYMENT DESIGN SHALL BE APPROVED BY EL PASO COUNTY DSD PRIOR TO PLACEMENT OF CURB AND GUTTER AND PAVEMENT.
- 11. ALL CONSTRUCTION TRAFFIC MUST ENTER/EXIT THE SITE AT APPROVED CONSTRUCTION
- 12. SIGHT VISIBILITY TRIANGLES AS IDENTIFIED IN THE PLANS SHALL BE PROVIDED AT ALL INTERSECTIONS. OBSTRUCTIONS GREATER THAN 18 INCHES ABOVE FLOWLINE ARE NOT ALLOWED WITHIN SIGHT TRIANGLES.
- 13. SIGNING AND STRIPING SHALL COMPLY WITH EL PASO COUNTY DET AND MUTCO CRITERIA (IF APPLICABLE, ADDITIONAL SIGNING AND STRIPING NOTED WILL BE PROVIDED).
- 14. CONTRACTOR SHALL OBTAIN ANY PERMITS REQUIRED BY EL PASO COUNTY DOT, INCLUDING WORK WITH THE RIGHT-OF-WAY AND SPECIAL TRANSPORT PERMITS.
- 15. THE LIMITS OF CONSTRUCTION SHALL REMAIN WITHIN THE PROPERTY LINE UNLESS OTHERWISE NOTED. THE OWNER/DEVELOPER SHALL OBTAIN WRITTEN PERMISSION AND EASEMENTS, WHERE REQUIRED FROM ADJOINING PROPERTY OWNER(S) PRIOR TO ANY OFF-SITE DISTURBANCE, GRADING, OR CONSTRUCTION.

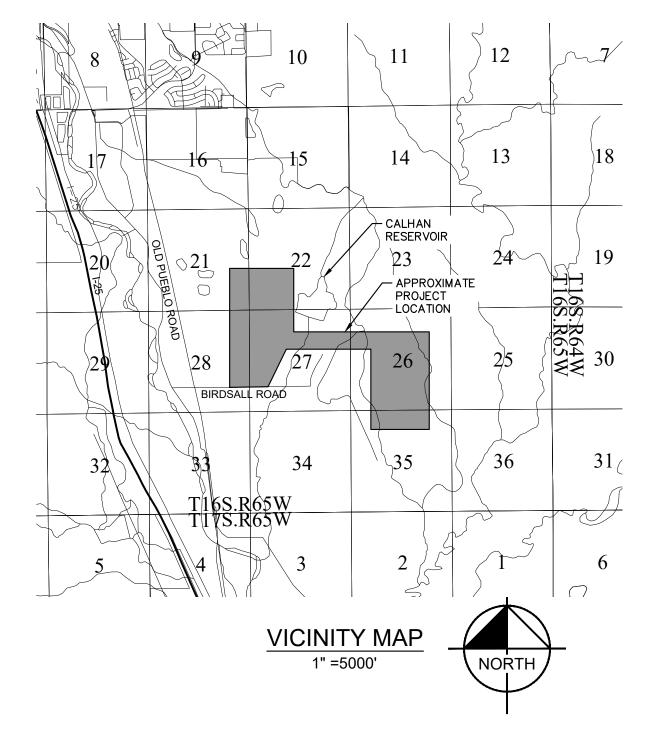

CONTACTS

PALMER SOLAR LLC 1710 29th STREET, SUITE 1068 BOULDER, CO 80301 TEL: (720) 245-2922 CONTACT: STUART COLES

COLORADO SPRINGS UTILITIES 121 SOUTH TEJON STREET, THIRD FLOOR P.O. BOX 1103, MAIL CODE 930 COLORADO SPRINGS, CO 80910 TEL: (719) 520-3600

EL PASO COUNTY: EL PASO COUNTY
DEVELOPMENT SERVICES DEPARTMENT 2880 INTERNATIONAL CIRCLE, SUITE 110 COLORADO SPRINGS, CO 80910 PHONE: (719) 520-3600

KIMLEY-HORN AND ASSOCIATES, INC. 2 NEVADA NORTH AVE., SUITE 300 COLORADO SPRINGS, CO 80903 TEL: (719) 453-0182 CONTACT: ERIC GUNDERSON, P.E.

CLARK LAND SURVEYING, INC. 177 S. TIFFANY DRIVE, UNIT 1 PUEBLO WEST, CO 81007 TEL: (719) 582-1270 CONTACT: NATHANIEL MAESTAS, PLS

INDEX OF SHEETS SHEET NO. COVER SHEET SITE LAYOUT EAST SITE LAYOUT WEST 4 - 21 DETAILED SITE PLAN 22 PUBLIC ROW IMPROVEMENTS 23 SITE DETAILS 24 - 27 PROJECT ELEVATIONS

ENGINEER'S SIGNATURE BLOCK

THESE DETAILED PLANS AND SPEFICATIONS WERE PREPARED UNDER MY DIRECTION AND SUPERVISION. SAID PLANS AND SPECIFICATIONS HAVE BEEN PREPARED ACCORDING TO THE CRITERIA ESTABLISHED BY THE COUNTY FOR DETAILED ROADWAY, DRAINAGE, GRADING AND EROSION CONTROL PLANS AND SPECIFICATIONS AND SAID PLANS AND SPECIFICATIONS ARE IN CONFORMITY WITH THE APPLICABLE MASTER DRAINAGE PLANS AND MASTER TRANSPORTATION PLANS. SAID PLANS AND SPECIFICATIONS MEET THE PURPOSES FOR WHICH THE PARTICULAR ROADWAY AND DRAINAGE FACILITIES ARE DESIGNED AND ARE CORRECT TO THE BEST OF MY KNOWLEDGE AND BELIEF. I ACCEPT RESPONSIBILITY FOR ANY LIABILITY CAUSED BY ANY NEGLIGENT ACTS, ERRORS OR OMISSIONS ON MY PART IN PREPARATION OF THE DETAILED PLANS AND SPECIFICATIONS.

ERIC GUNDERSON, PE - KIMLEY-HORN AND ASSOCIATES, INC. DATE

OWNER'S SIGNATURE BLOCK

I. THE OWNER/DEVELOPER HAVE READ AND WILL COMPLY WITH ALL OF THE REQUIREMENTS SPECIFIED IN THESE DETAILED PLANS AND SPECIFICATIONS.

DATE

EL PASO COUNTY REVIEW STATEMENT

COUNTY PLAN REVIEW IS PROVIDED ONLY FOR GENERAL CONFORMANCE WITH COUNTY DESIGN CRITERIA. THE COUNTY IS NOT RESPONSIBLE FOR THE ACCURACY AND ADEQUACY OF THE DESIGN DIMENSIONS AND/OR ELEVATIONS WHICH SHALL BE CONFIRMED AT THE JOB SITE. THE COUNTY THROUGH THE APPROVAL OF THIS DOCUMENT ASSUMES NO RESPONSIBILITY FOR COMPLETENESS AND/OR ACCURACY OF THIS DOCUMENT.

FILED IN ACCORDANCE WITH THE REQUIREMENTS OF THE EL PASO COUNTY LAND DEVELOPMENT CODE, DRAINAGE CRITERIA MANUAL, VOLUMES 1 AND 2, AND ENGINEERING CRITERIA MANUAL AS AMENDED.

DATE NAME

> PALMER SOLAR **COVER SHEET**

EL PASO COUNTY, CO

© 2019 KIMLEY-HORN AND ASSOCIATES, INC.

2 N. NEVADA AVENUE, SUITE 300 COLORADO SPRINGS, CO 80903 (719) 453-0180 DESIGNED DRAWN CHECKED EJG KRK

> SCALE (V): N/A SHEET NO. FEBRUARY 11, 2018 PROJECT NO. 096495003 DWG. NAME


SCALE (H): N/A


EJG


096495003 CV-SDP PCD EA NUMBER 17-46




each sheet

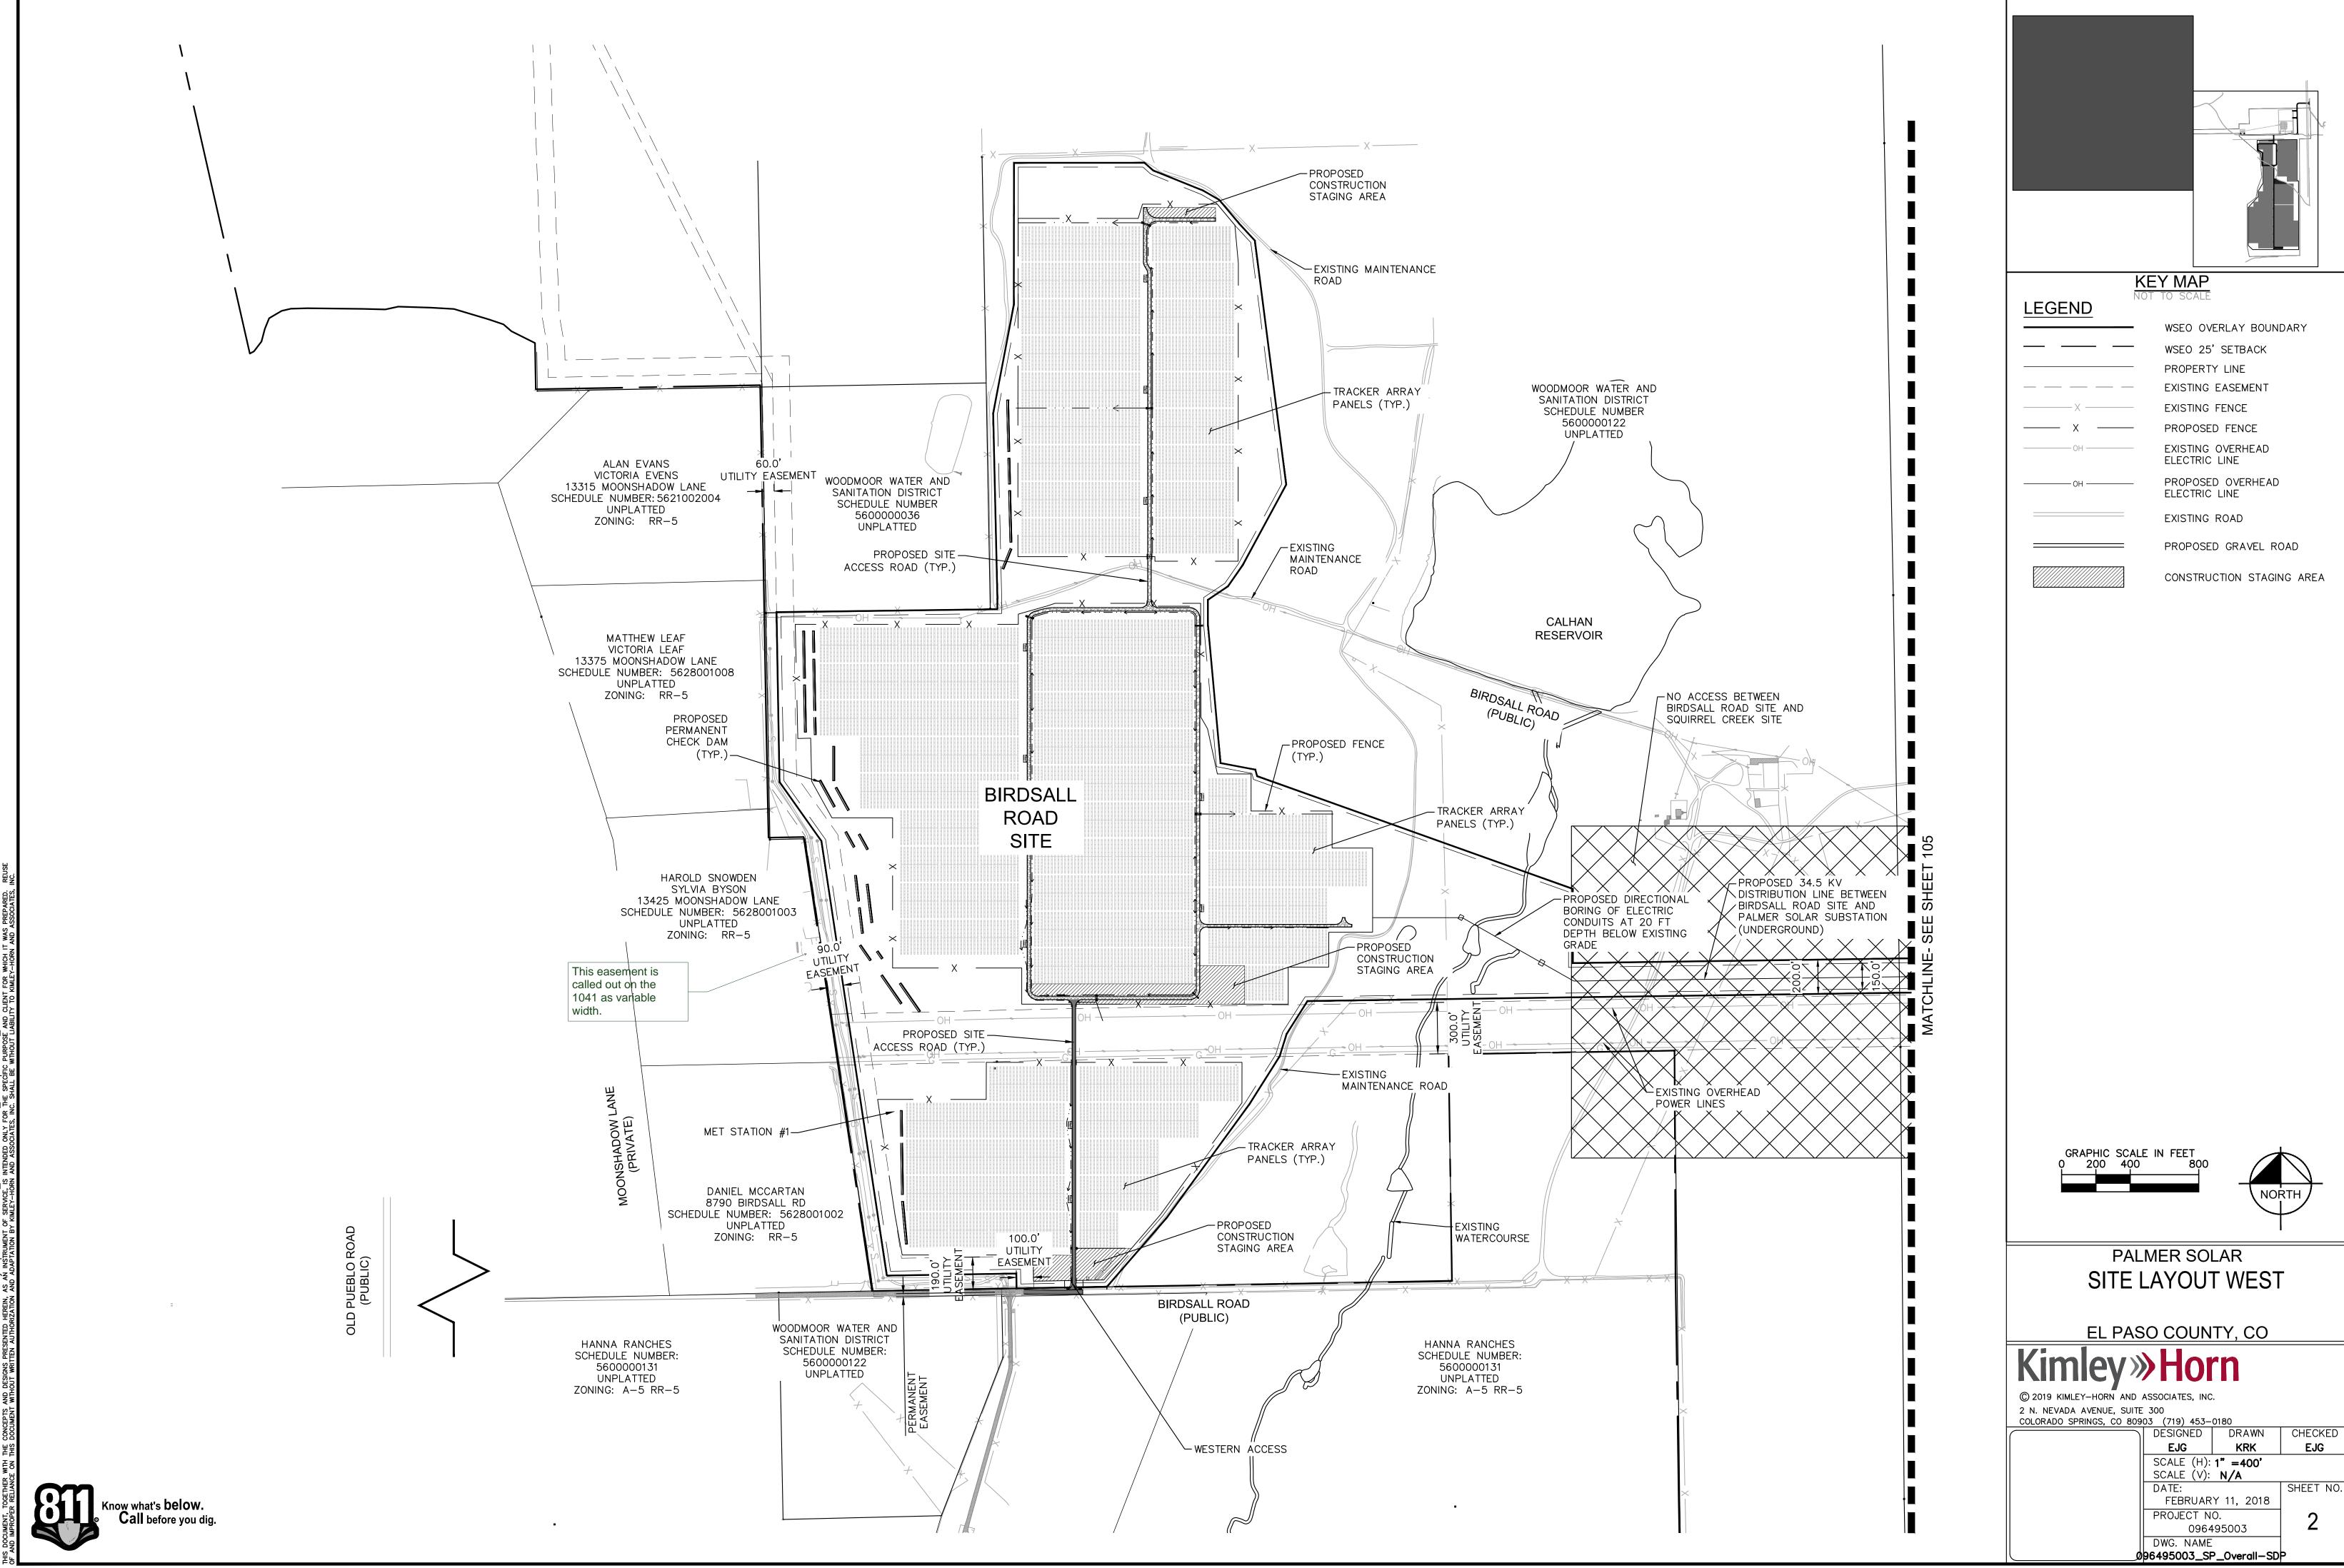

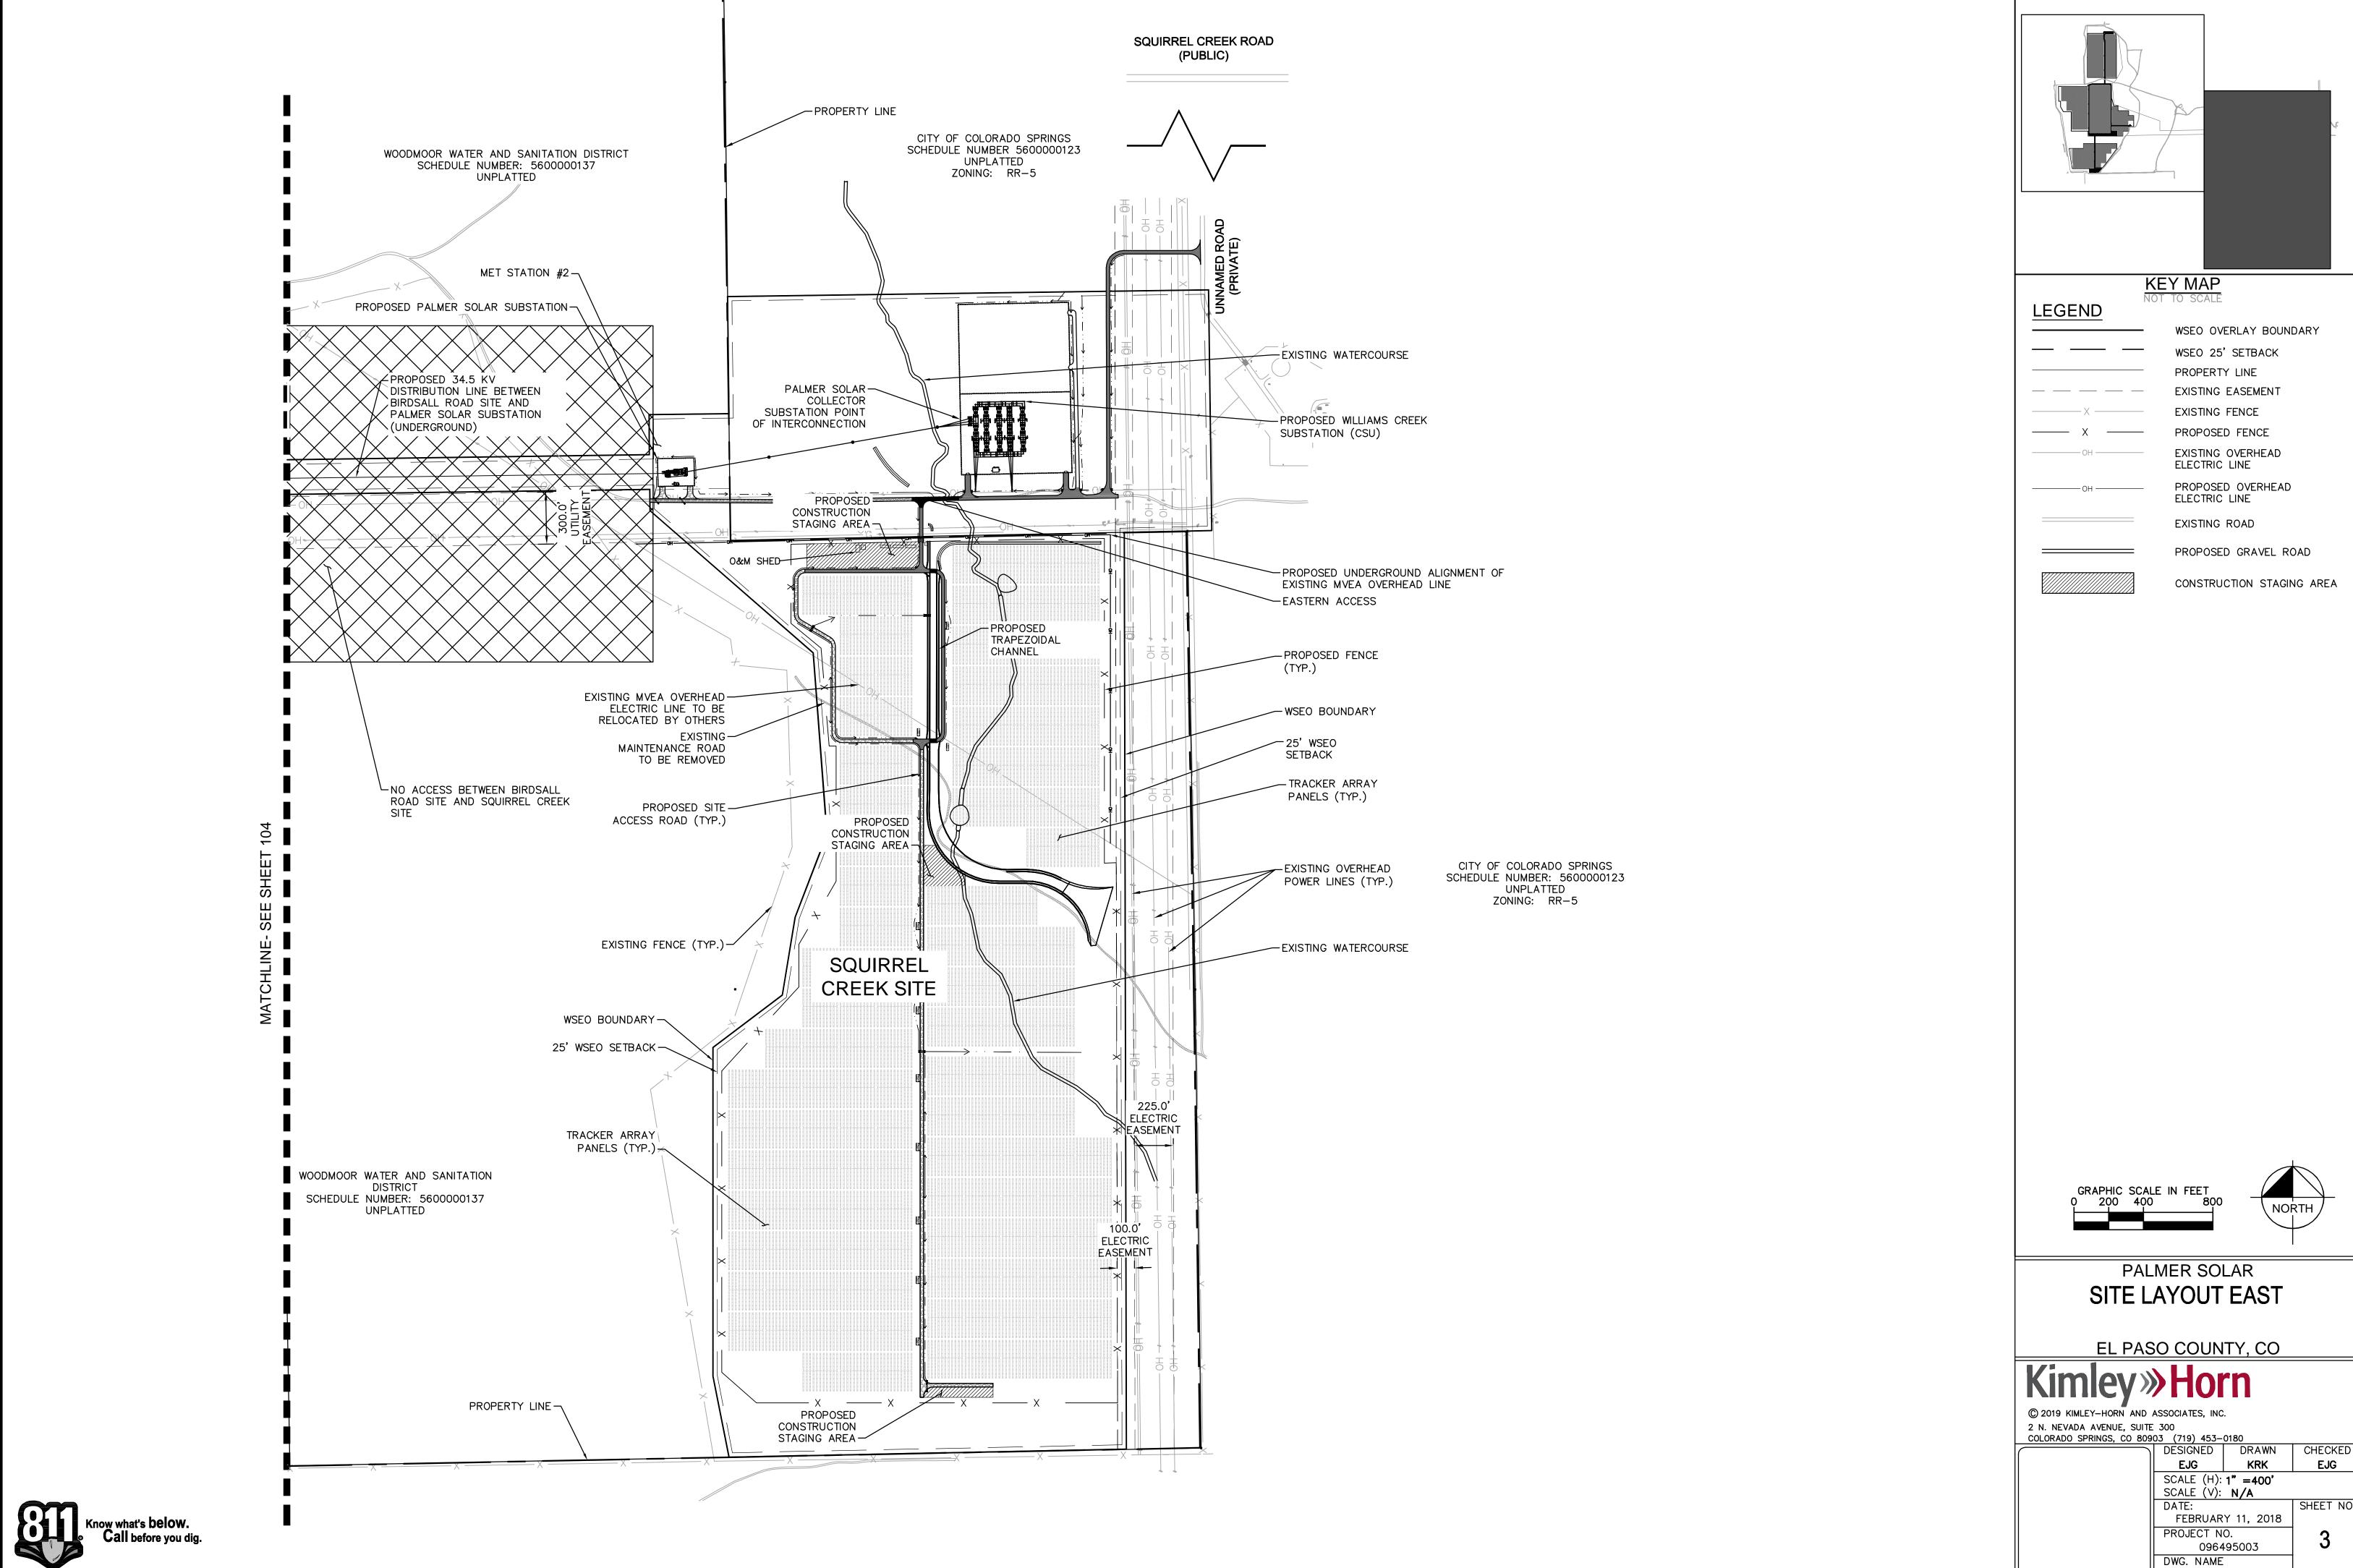

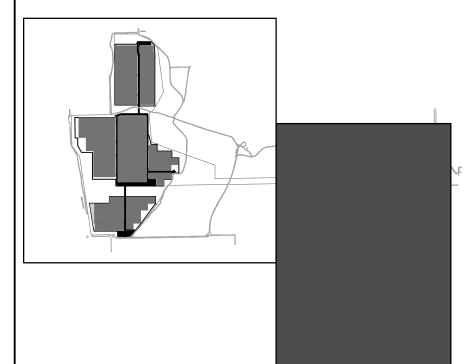

_Ø96495003_SP_Overall-SDP PCD EA NUMBER 17-46

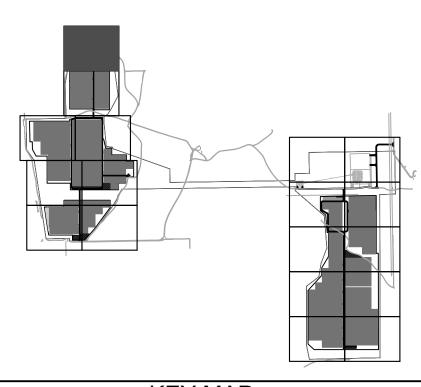

KEY MAP

CONSTRUCTION KEY NOTES:

- CONSTRUCT PRIVATE ACCESS ROAD PER TYPICAL 1 SECTION ON SHEET 124. (SECTION TYPE AND WIDTH PER PLAN)
- 2 INSTALL 8' PERIMETER CHAINLINK FENCE PER DETAIL ON SHEET 124.
- 3 INSTALL SWING GATE PER DETAIL ON SHEET 124.
- INSTALL POWER STATION PAD PER DETAIL ON SHEET 124.
- 5 CONSTRUCT STAGING AREA PER DETAIL ON SHEET 124.
- 6 CONVEYANCE DITCH PER DETAIL ON SHEET 147 (SEE SHEETS 127 TO 144 FOR DETAILED GRADING)
- 7 ROADSIDE SWALE PER DETAIL ON SHEET 147

NOTES:

ALL DIMENSIONS PROVIDED ON THE SITE PLAN ARE TO THE EDGE OF PROPERTY LINE, ACCESS ROAD, EDGE OF SOLAR STRUCTURE, EDGE OF POWER STATION PAD, OR PERIMETER FENCE LINE.

LEGEND:


WSEO BOUNDARY -----25' WSEO SETBACK EXISTING EASEMENT - EXISTING FENCE — X — PROPOSED FENCE

→··-·- PROPOSED ROADSIDE SWALE - PROPOSED CONVEYANCE DITCH - EXISTING OHE LINE

- PROPOSED OHE LINE STANDARD DUTY ROADWAY SECTION PER DETAIL ON SHEET

PER DETAIL ON SHEET 124 EXISTING MAINTENANCE ROAD TO BE REMOVED

CONSTRUCTION STAGING AREA CONCRETE LOWERING ROAD SECTION PER DETAIL ON SHEET 124

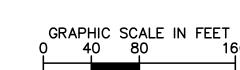



HEAVY DUTY ROADWAY SECTION

PALMER SOLAR DETAILED SITE PLAN


EL PASO COUNTY, CO


2 N. NEVADA AVENUE, SUITE 300
COLORADO SPRINGS, CO 80903 (719) 453-0180


DESIGNED DRAWN CHECKED

KRK EJG © 2019 KIMLEY-HORN AND ASSOCIATES, INC.

SCALE (H): 1"= 80' SCALE (V): N/A SHEET NO. FEBRUARY 11, 2018 PROJECT NO. 096495003 DWG. NAME

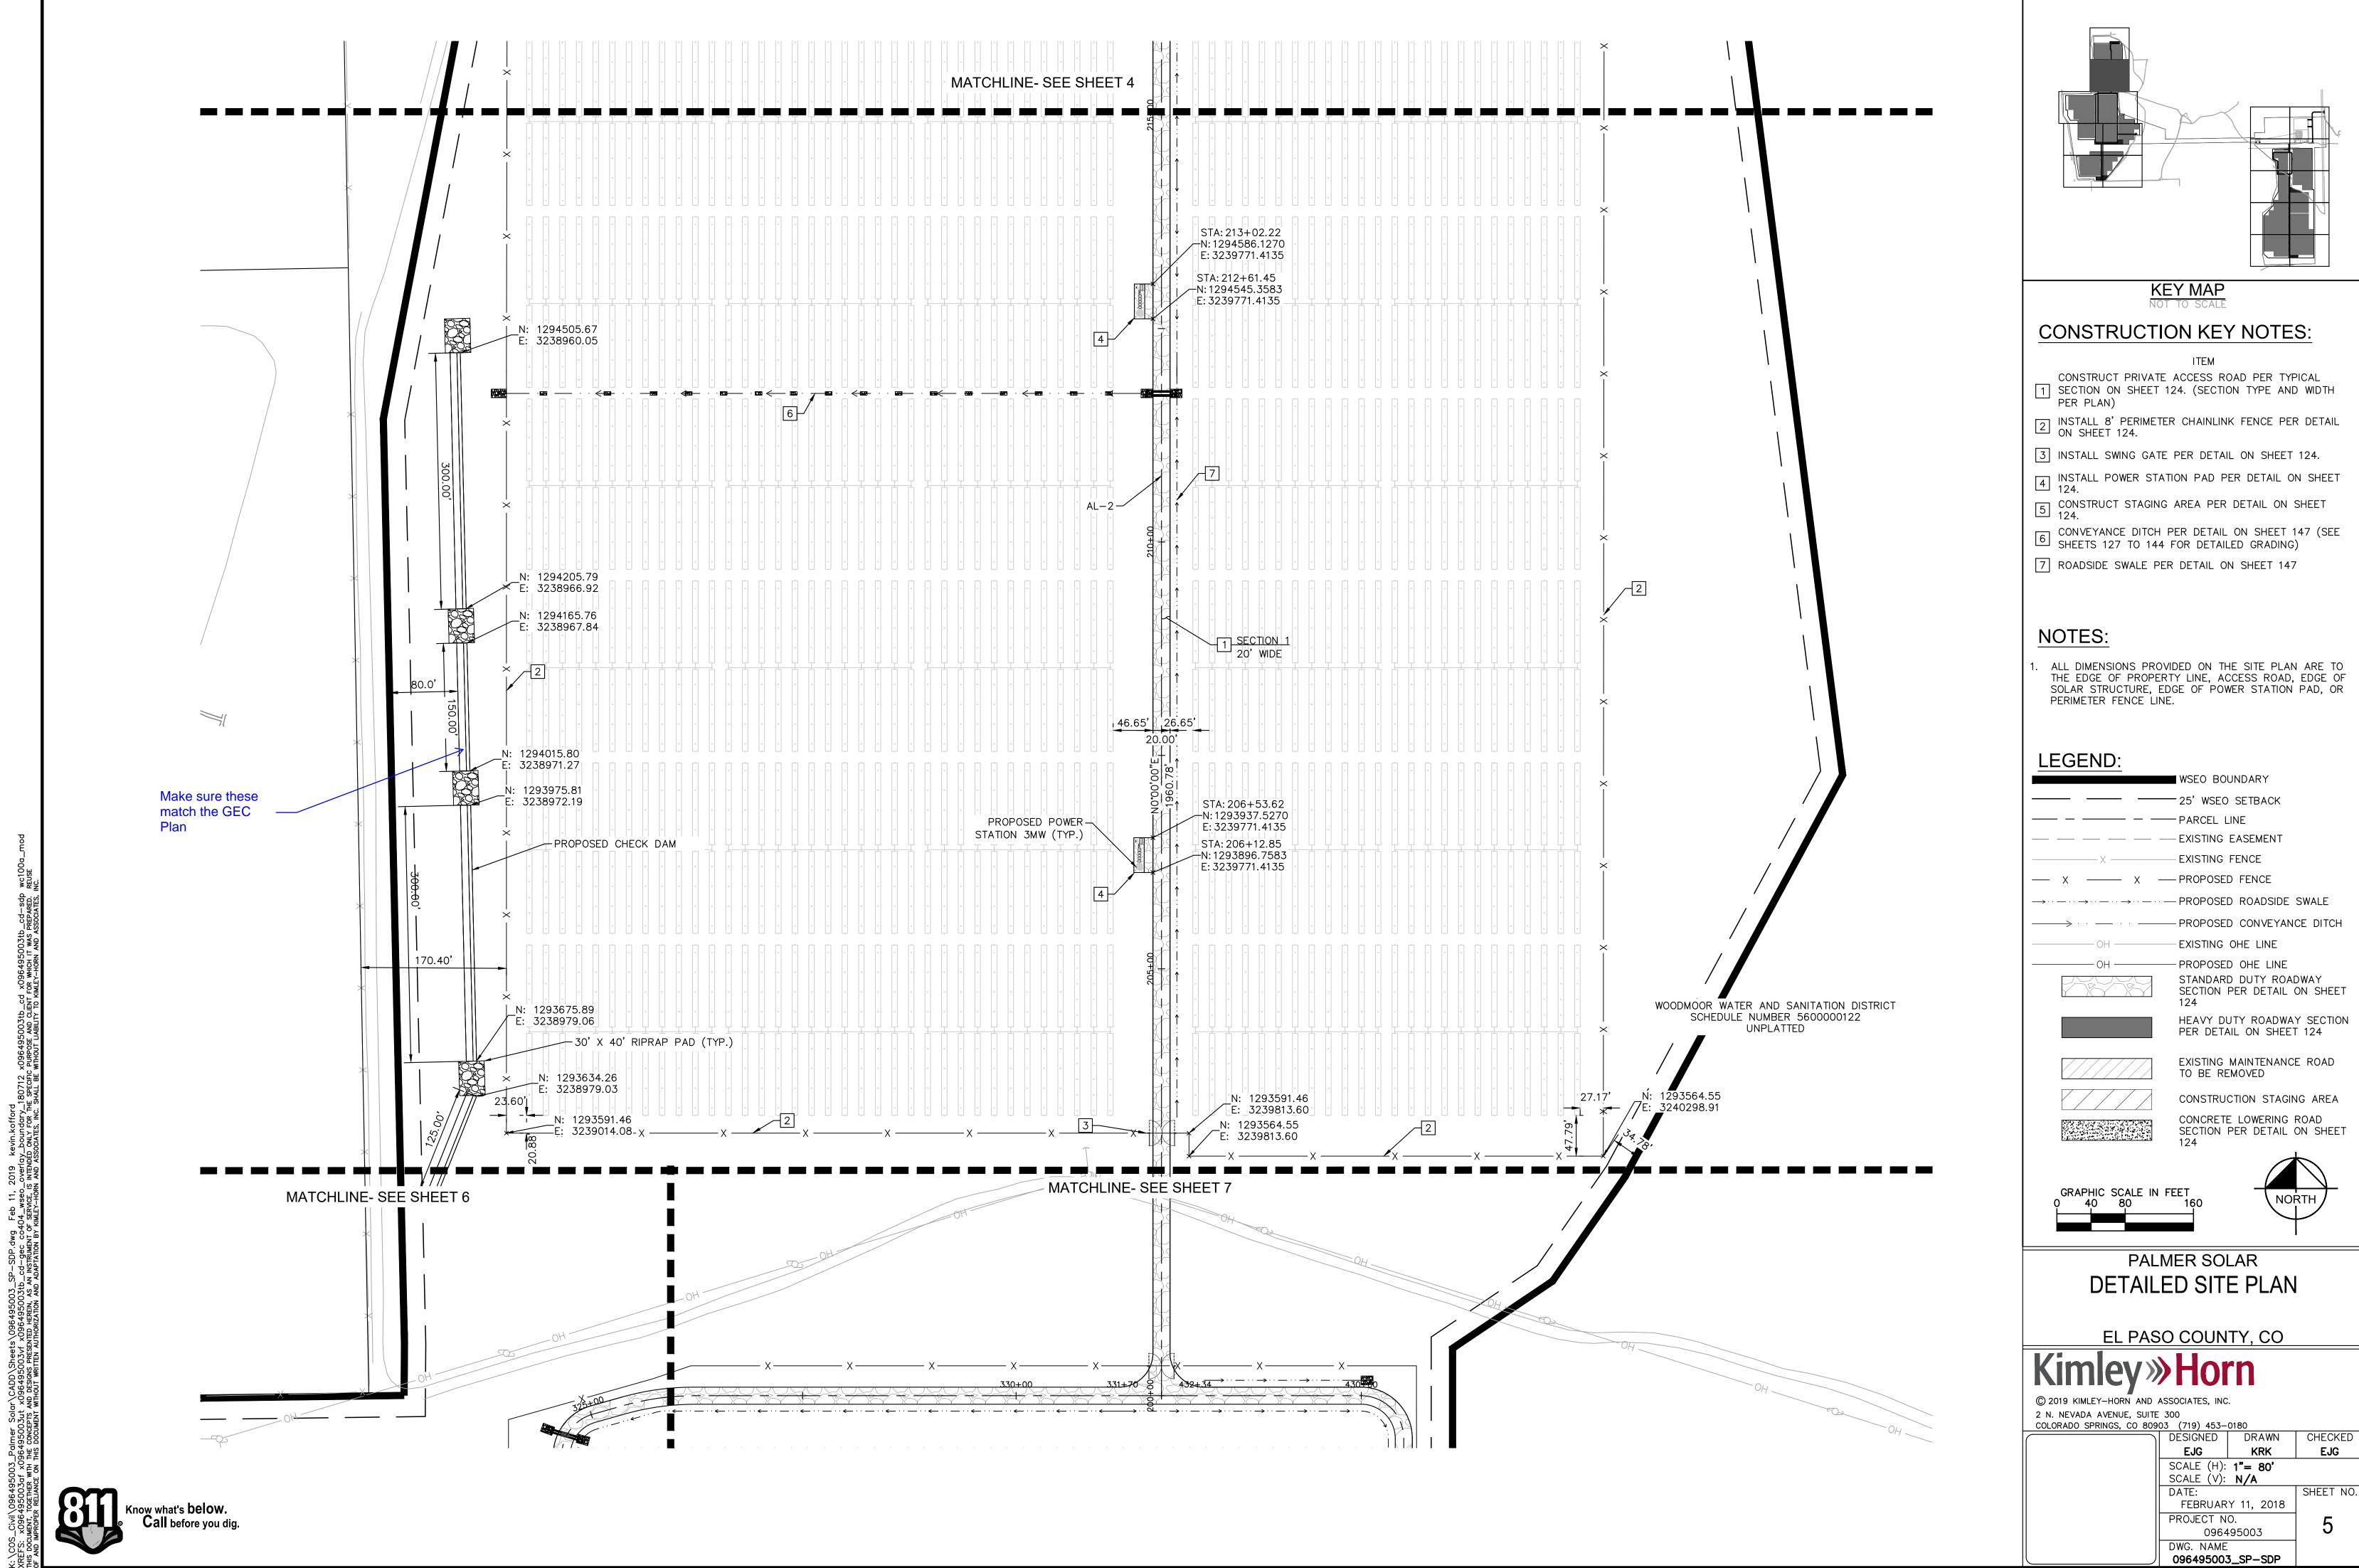

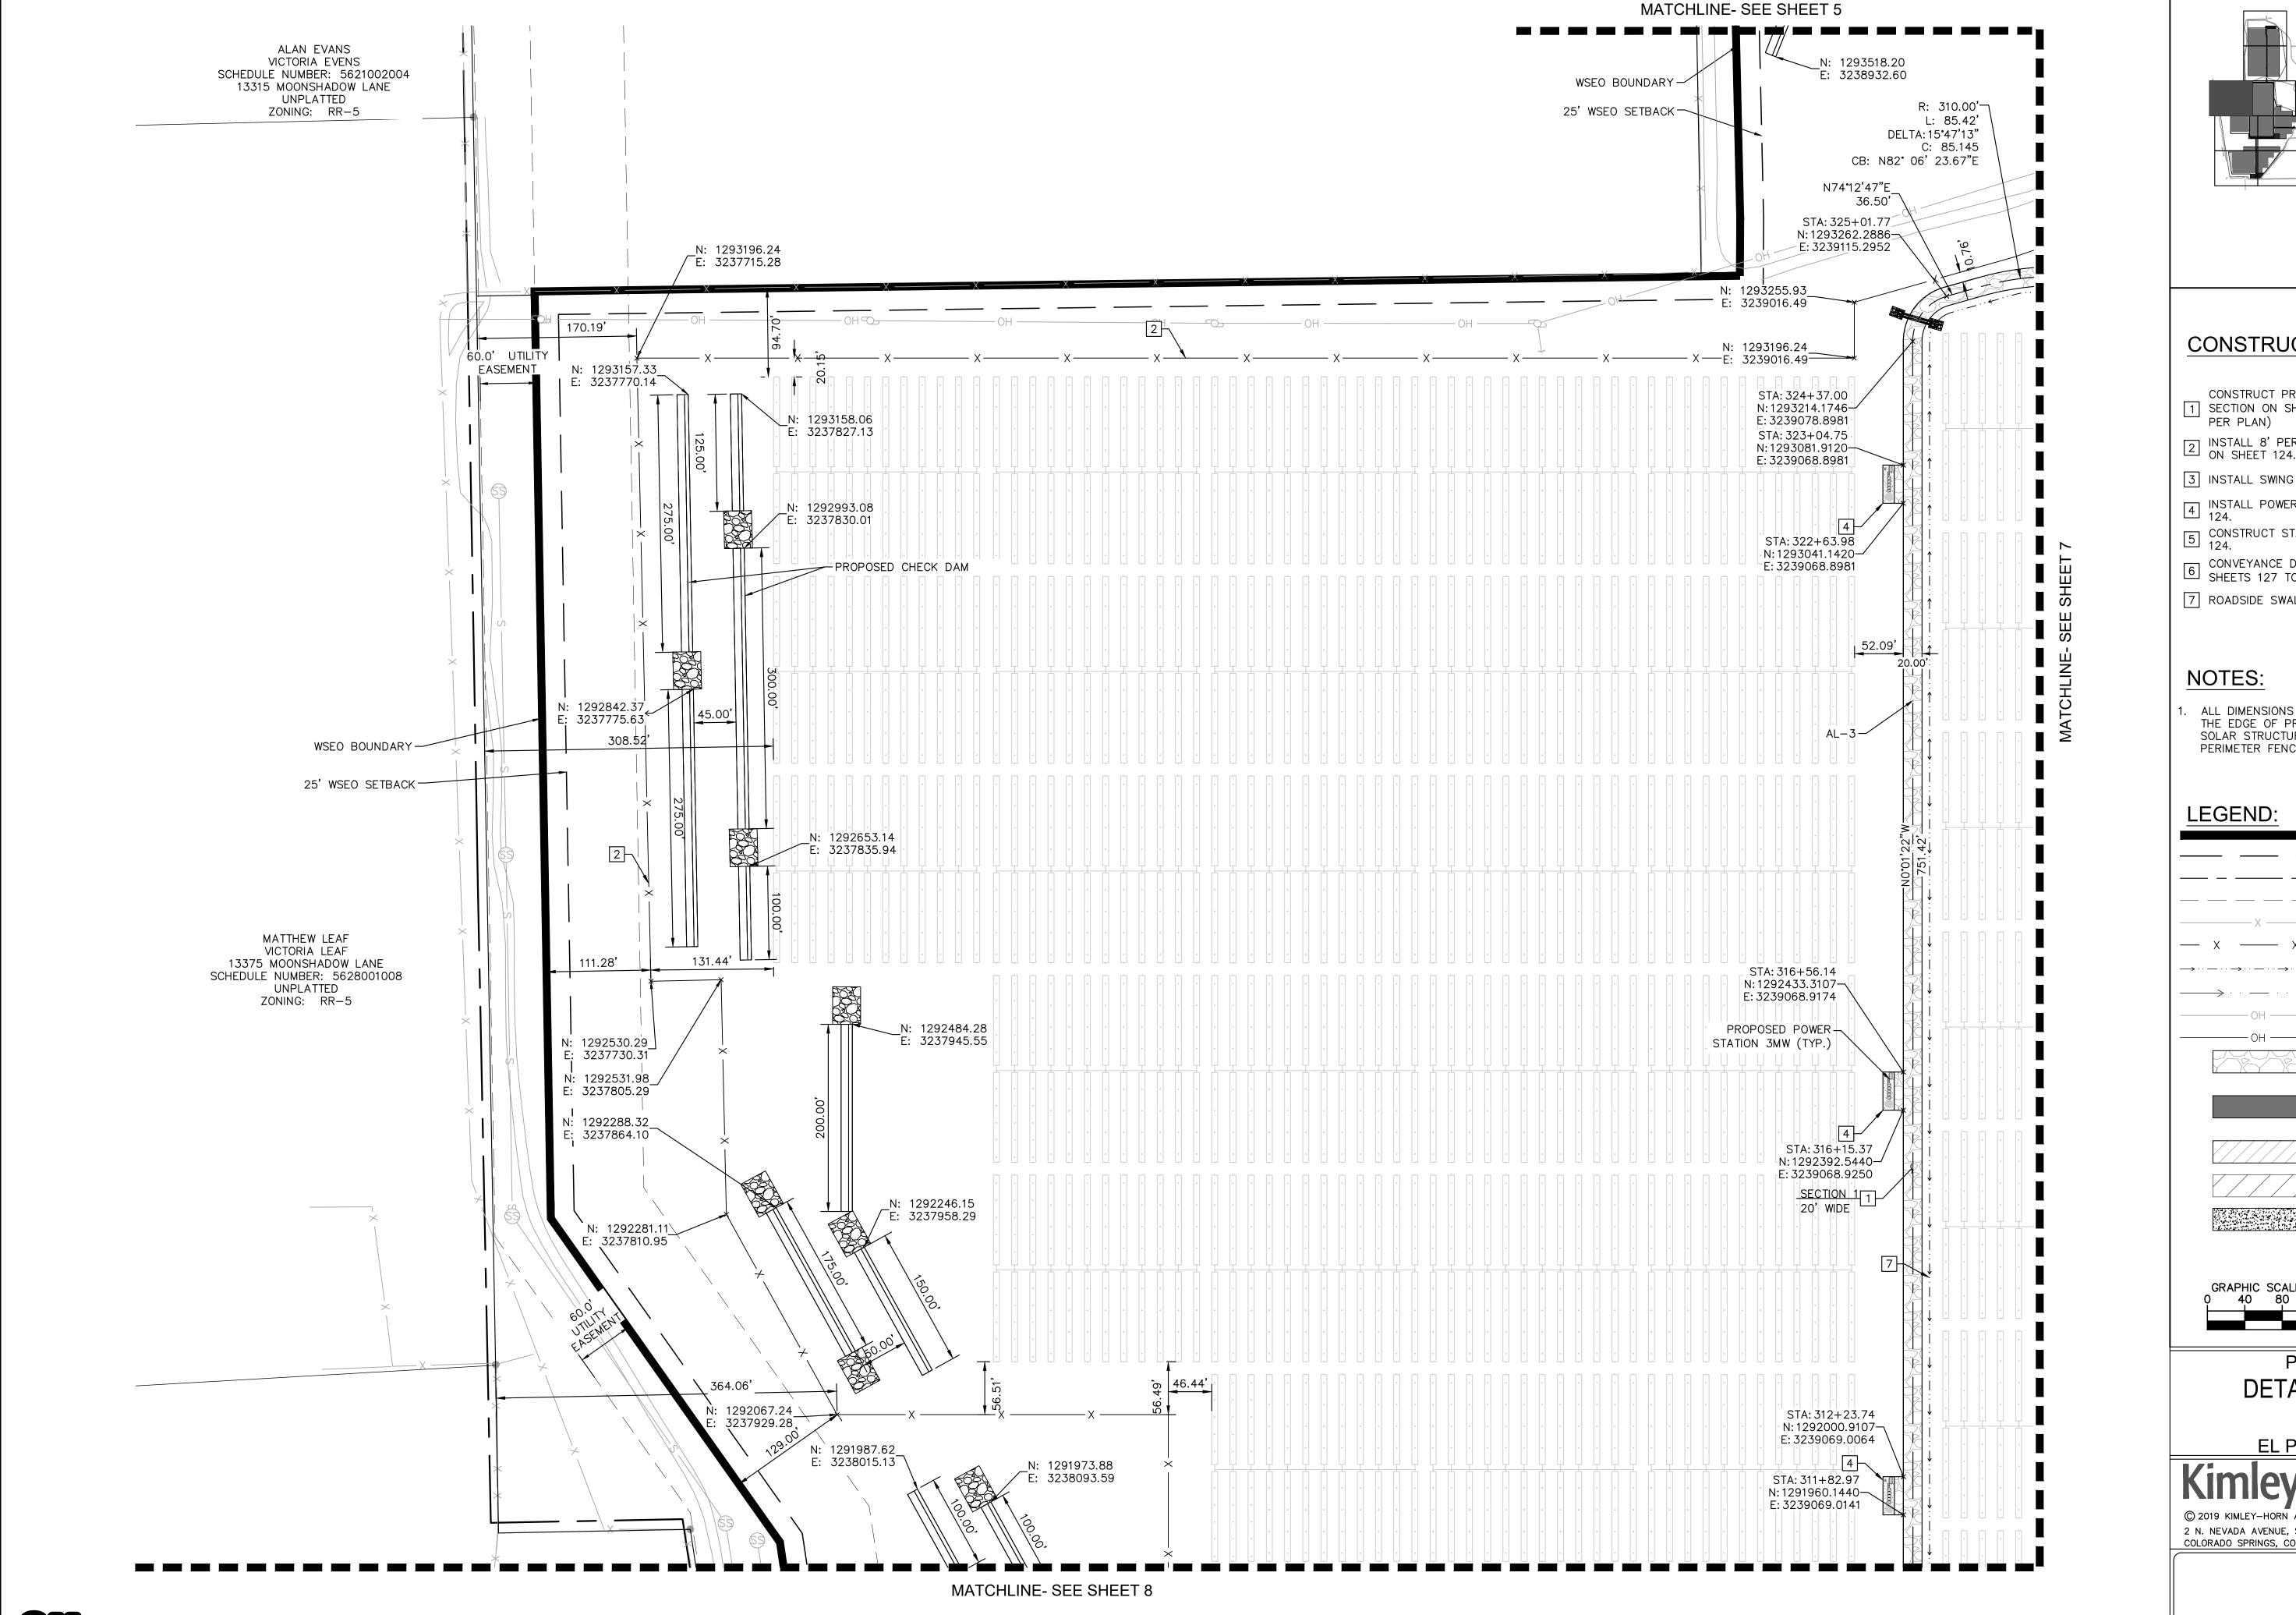

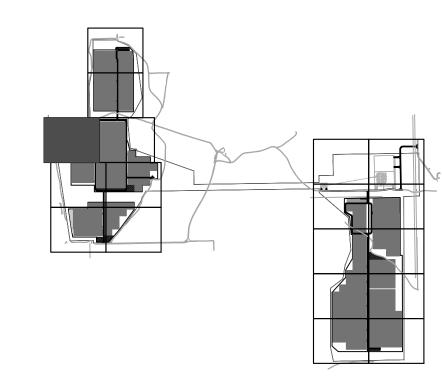

KEY MAP

CONSTRUCTION KEY NOTES:

- CONSTRUCT PRIVATE ACCESS ROAD PER TYPICAL 1 SECTION ON SHEET 124. (SECTION TYPE AND WIDTH
- 2 INSTALL 8' PERIMETER CHAINLINK FENCE PER DETAIL ON SHEET 124.
- 3 INSTALL SWING GATE PER DETAIL ON SHEET 124.
- INSTALL POWER STATION PAD PER DETAIL ON SHEET 124.
- 5 CONSTRUCT STAGING AREA PER DETAIL ON SHEET 124.
- 6 CONVEYANCE DITCH PER DETAIL ON SHEET 147 (SEE SHEETS 127 TO 144 FOR DETAILED GRADING)
- 7 ROADSIDE SWALE PER DETAIL ON SHEET 147

NOTES:

ALL DIMENSIONS PROVIDED ON THE SITE PLAN ARE TO THE EDGE OF PROPERTY LINE, ACCESS ROAD, EDGE OF SOLAR STRUCTURE, EDGE OF POWER STATION PAD, OR PERIMETER FENCE LINE.

WSEO BOUNDARY


LEGEND:


_____ 25' WSEO SETBACK EXISTING EASEMENT - EXISTING FENCE — X — X — PROPOSED FENCE $\rightarrow \cdots - \cdots$ PROPOSED ROADSIDE SWALE - PROPOSED CONVEYANCE DITCH EXISTING OHE LINE - PROPOSED OHE LINE STANDARD DUTY ROADWAY SECTION PER DETAIL ON SHEET HEAVY DUTY ROADWAY SECTION

PER DETAIL ON SHEET 124

EXISTING MAINTENANCE ROAD TO BE REMOVED CONSTRUCTION STAGING AREA

CONCRETE LOWERING ROAD SECTION PER DETAIL ON SHEET 124

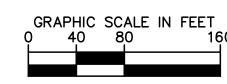

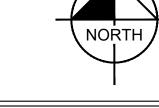

PALMER SOLAR DETAILED SITE PLAN


EL PASO COUNTY, CO

© 2019 KIMLEY-HORN AND ASSOCIATES, INC. 2 N. NEVADA AVENUE, SUITE 300


80903 (719) 453-0180				
		DESIGNED	DRAWN	CHECKE
		EJG	KRK	EJG
		SCALE (H):	1"= 80'	•
		SCALE (V):	N/A	
		DATE:	-	SHEET N
		FEBRUAR	Y 11, 2018	
			^	1 _


PROJECT NO. 096495003 DWG. NAME 096495003_SP-SDP


PCD EA NUMBER 17-46

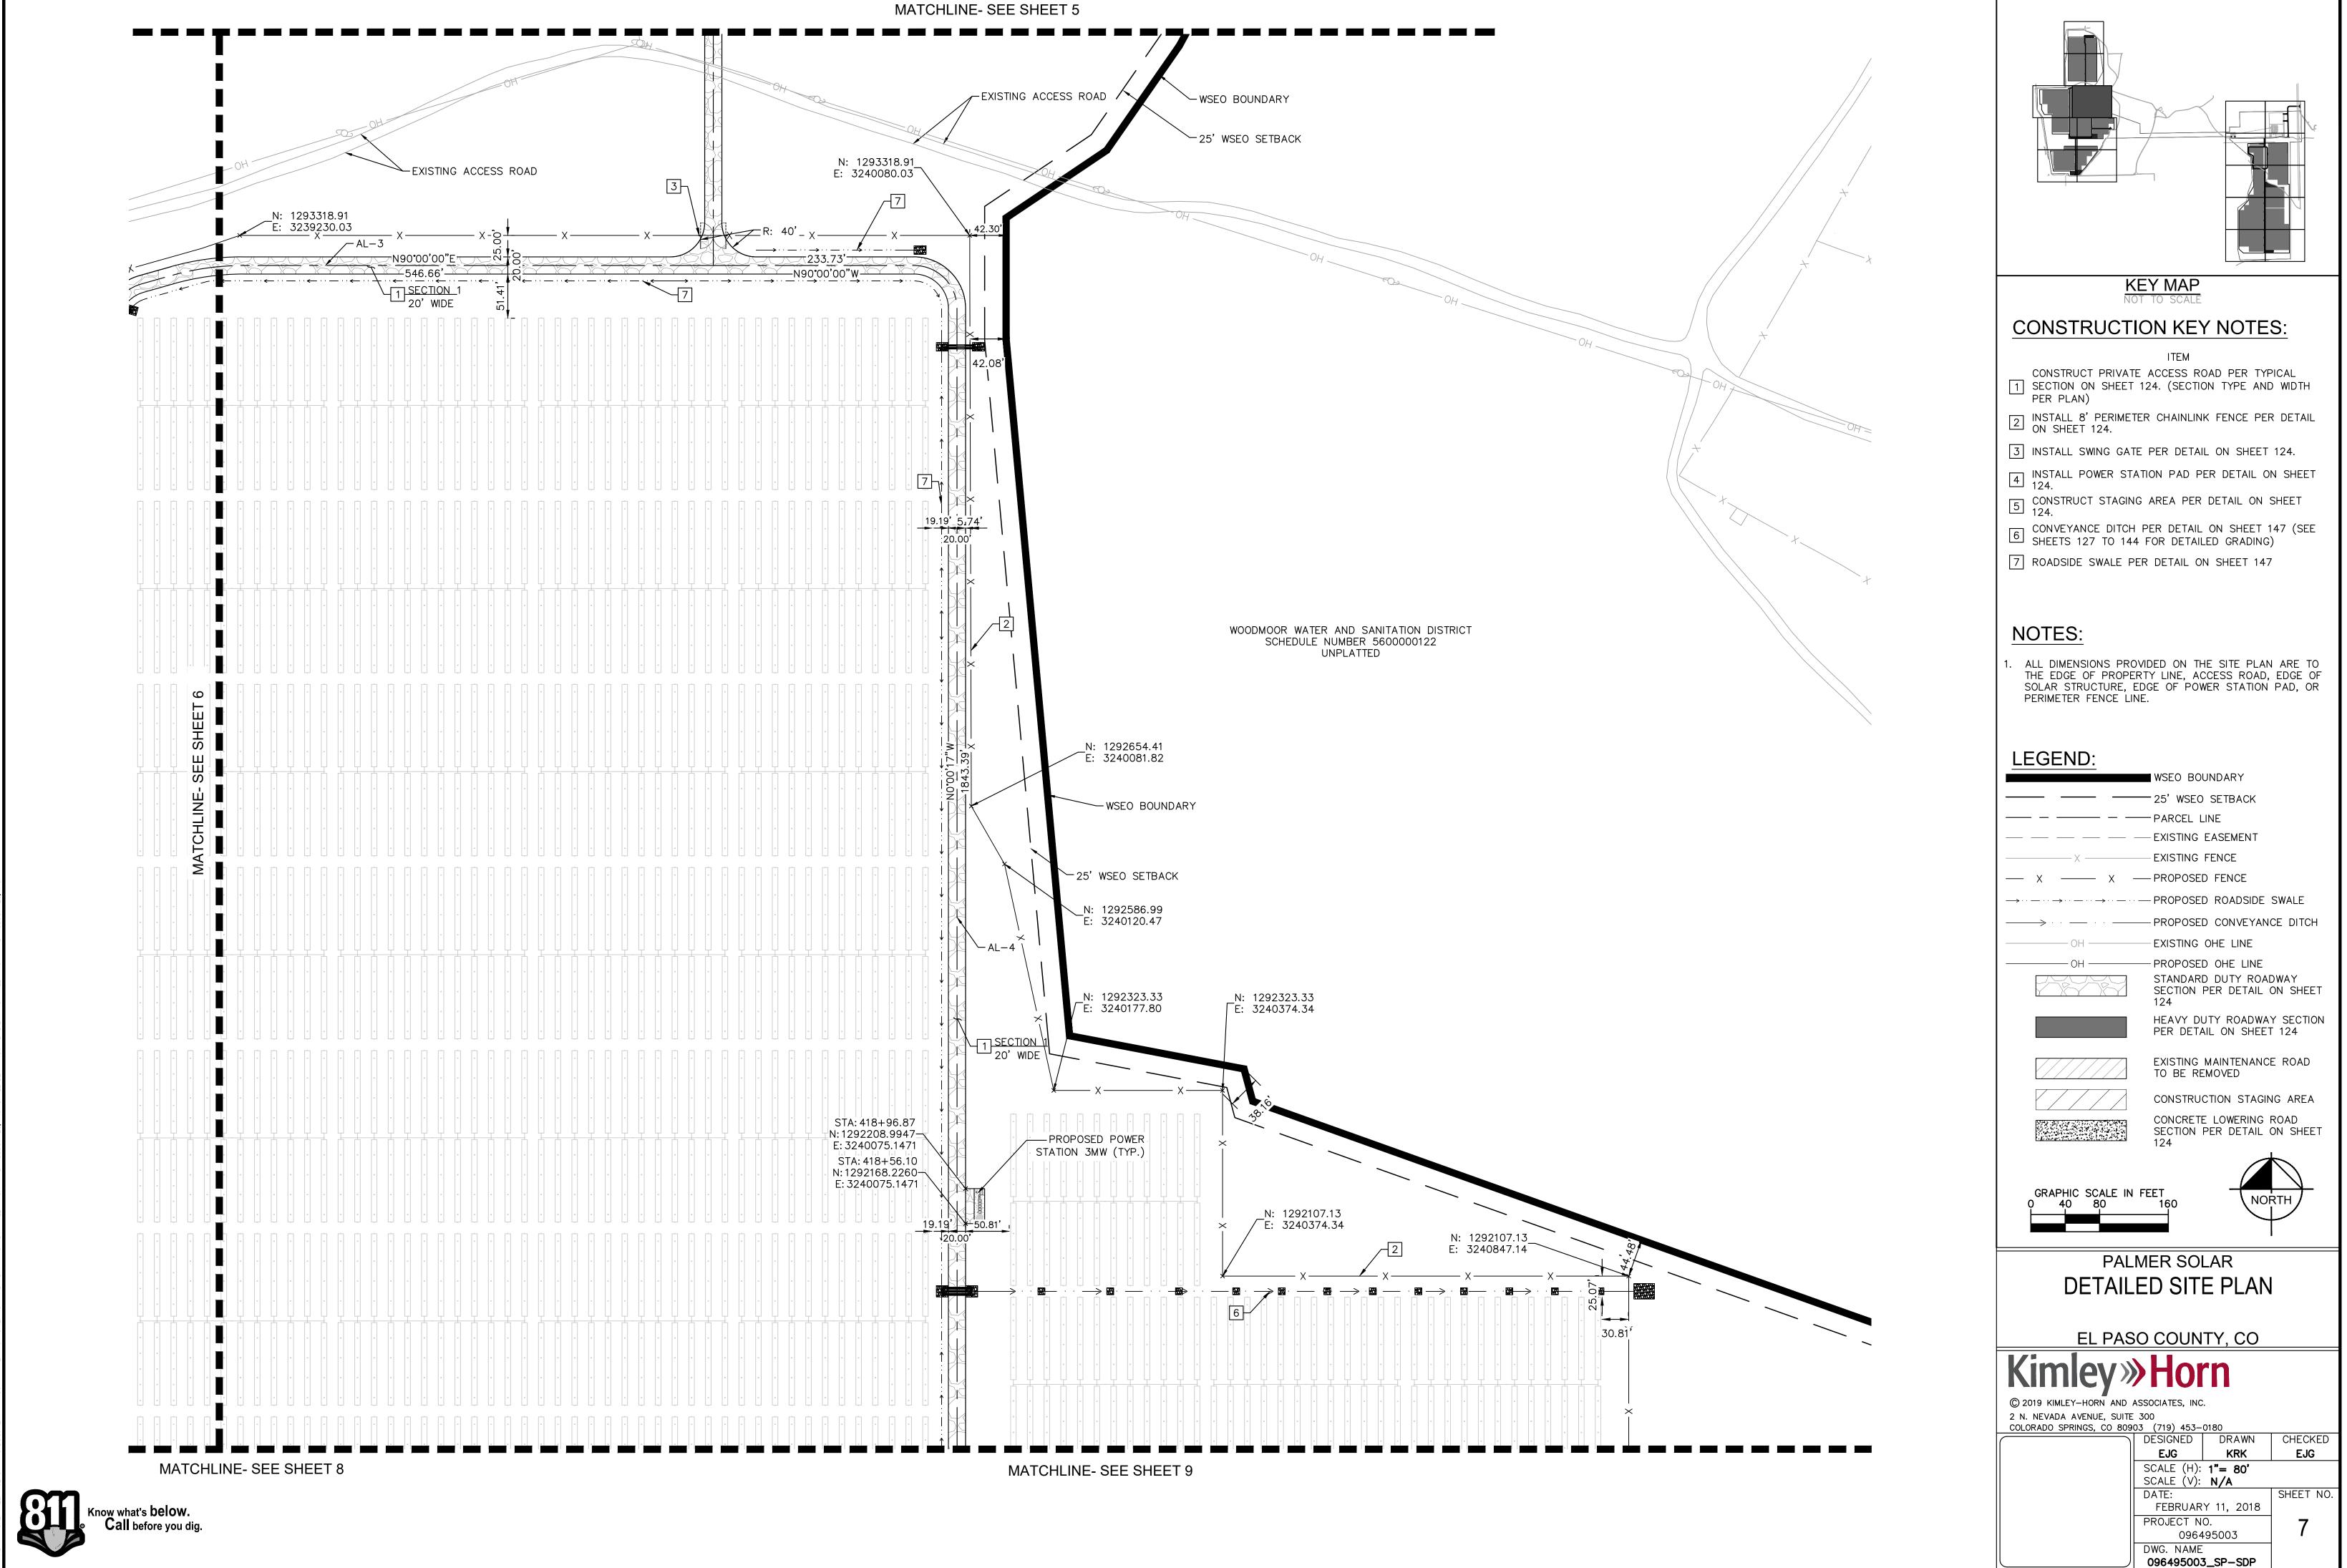

PCD EA NUMBER 17-46

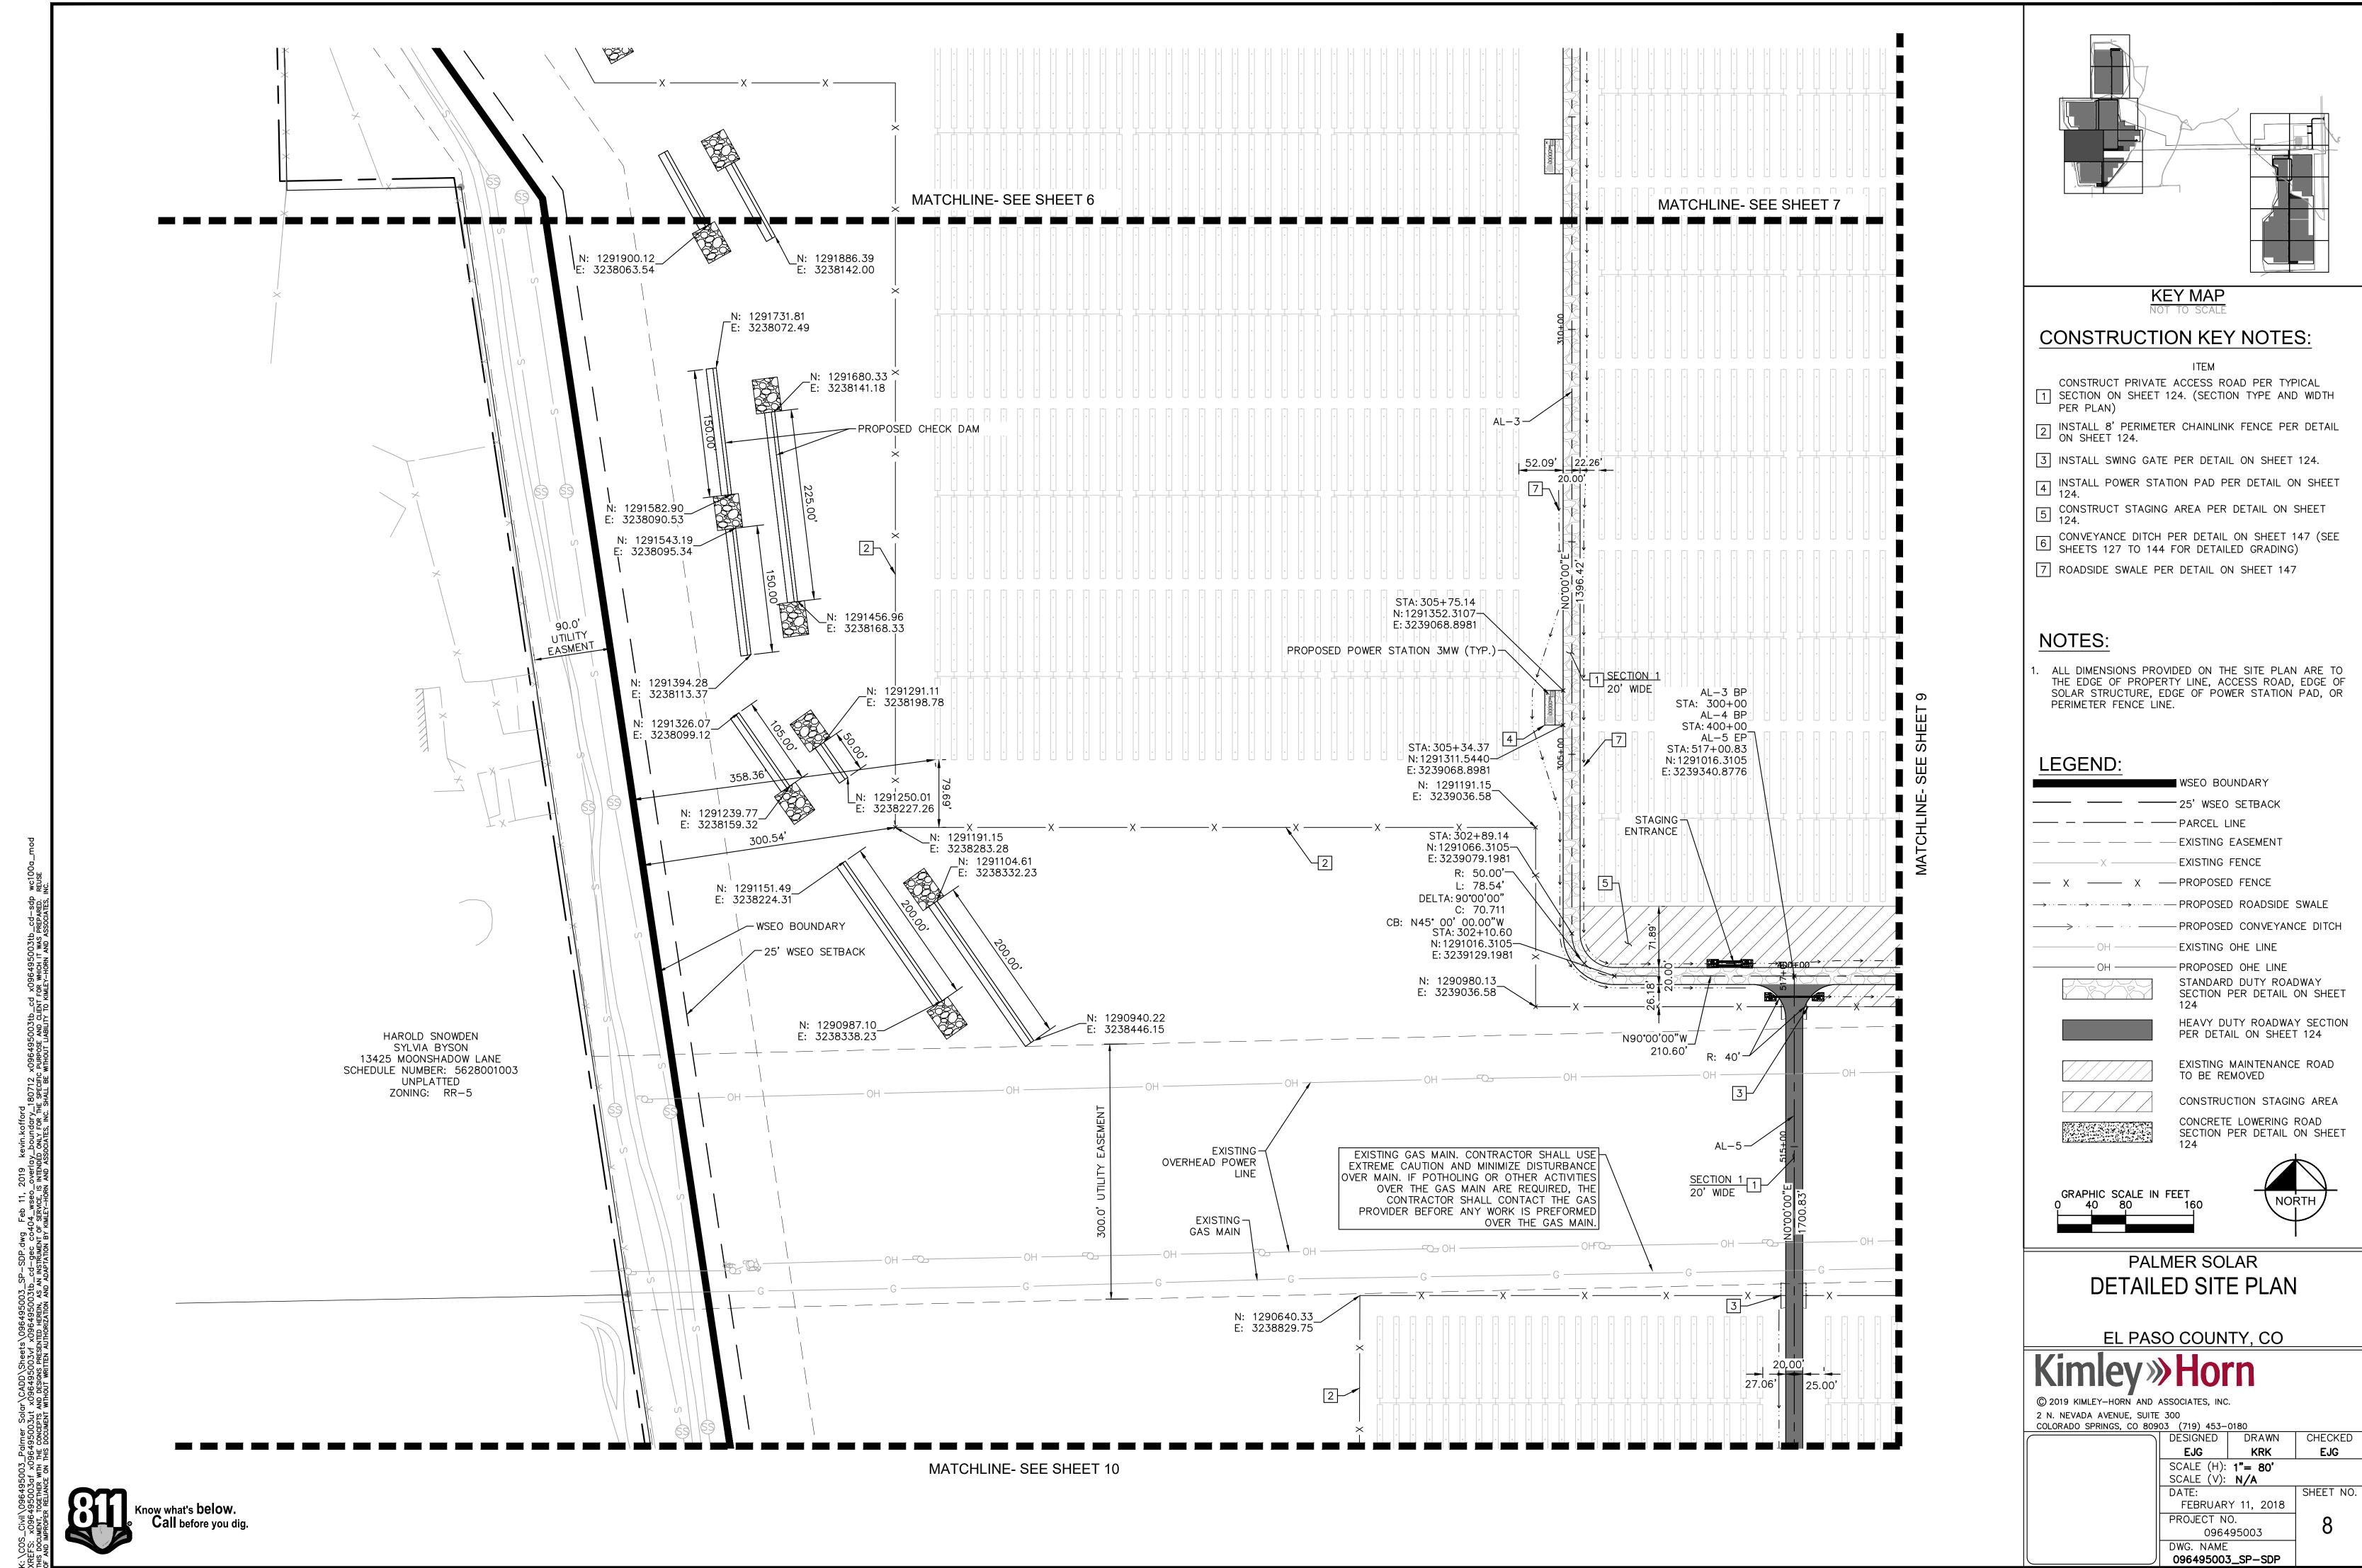

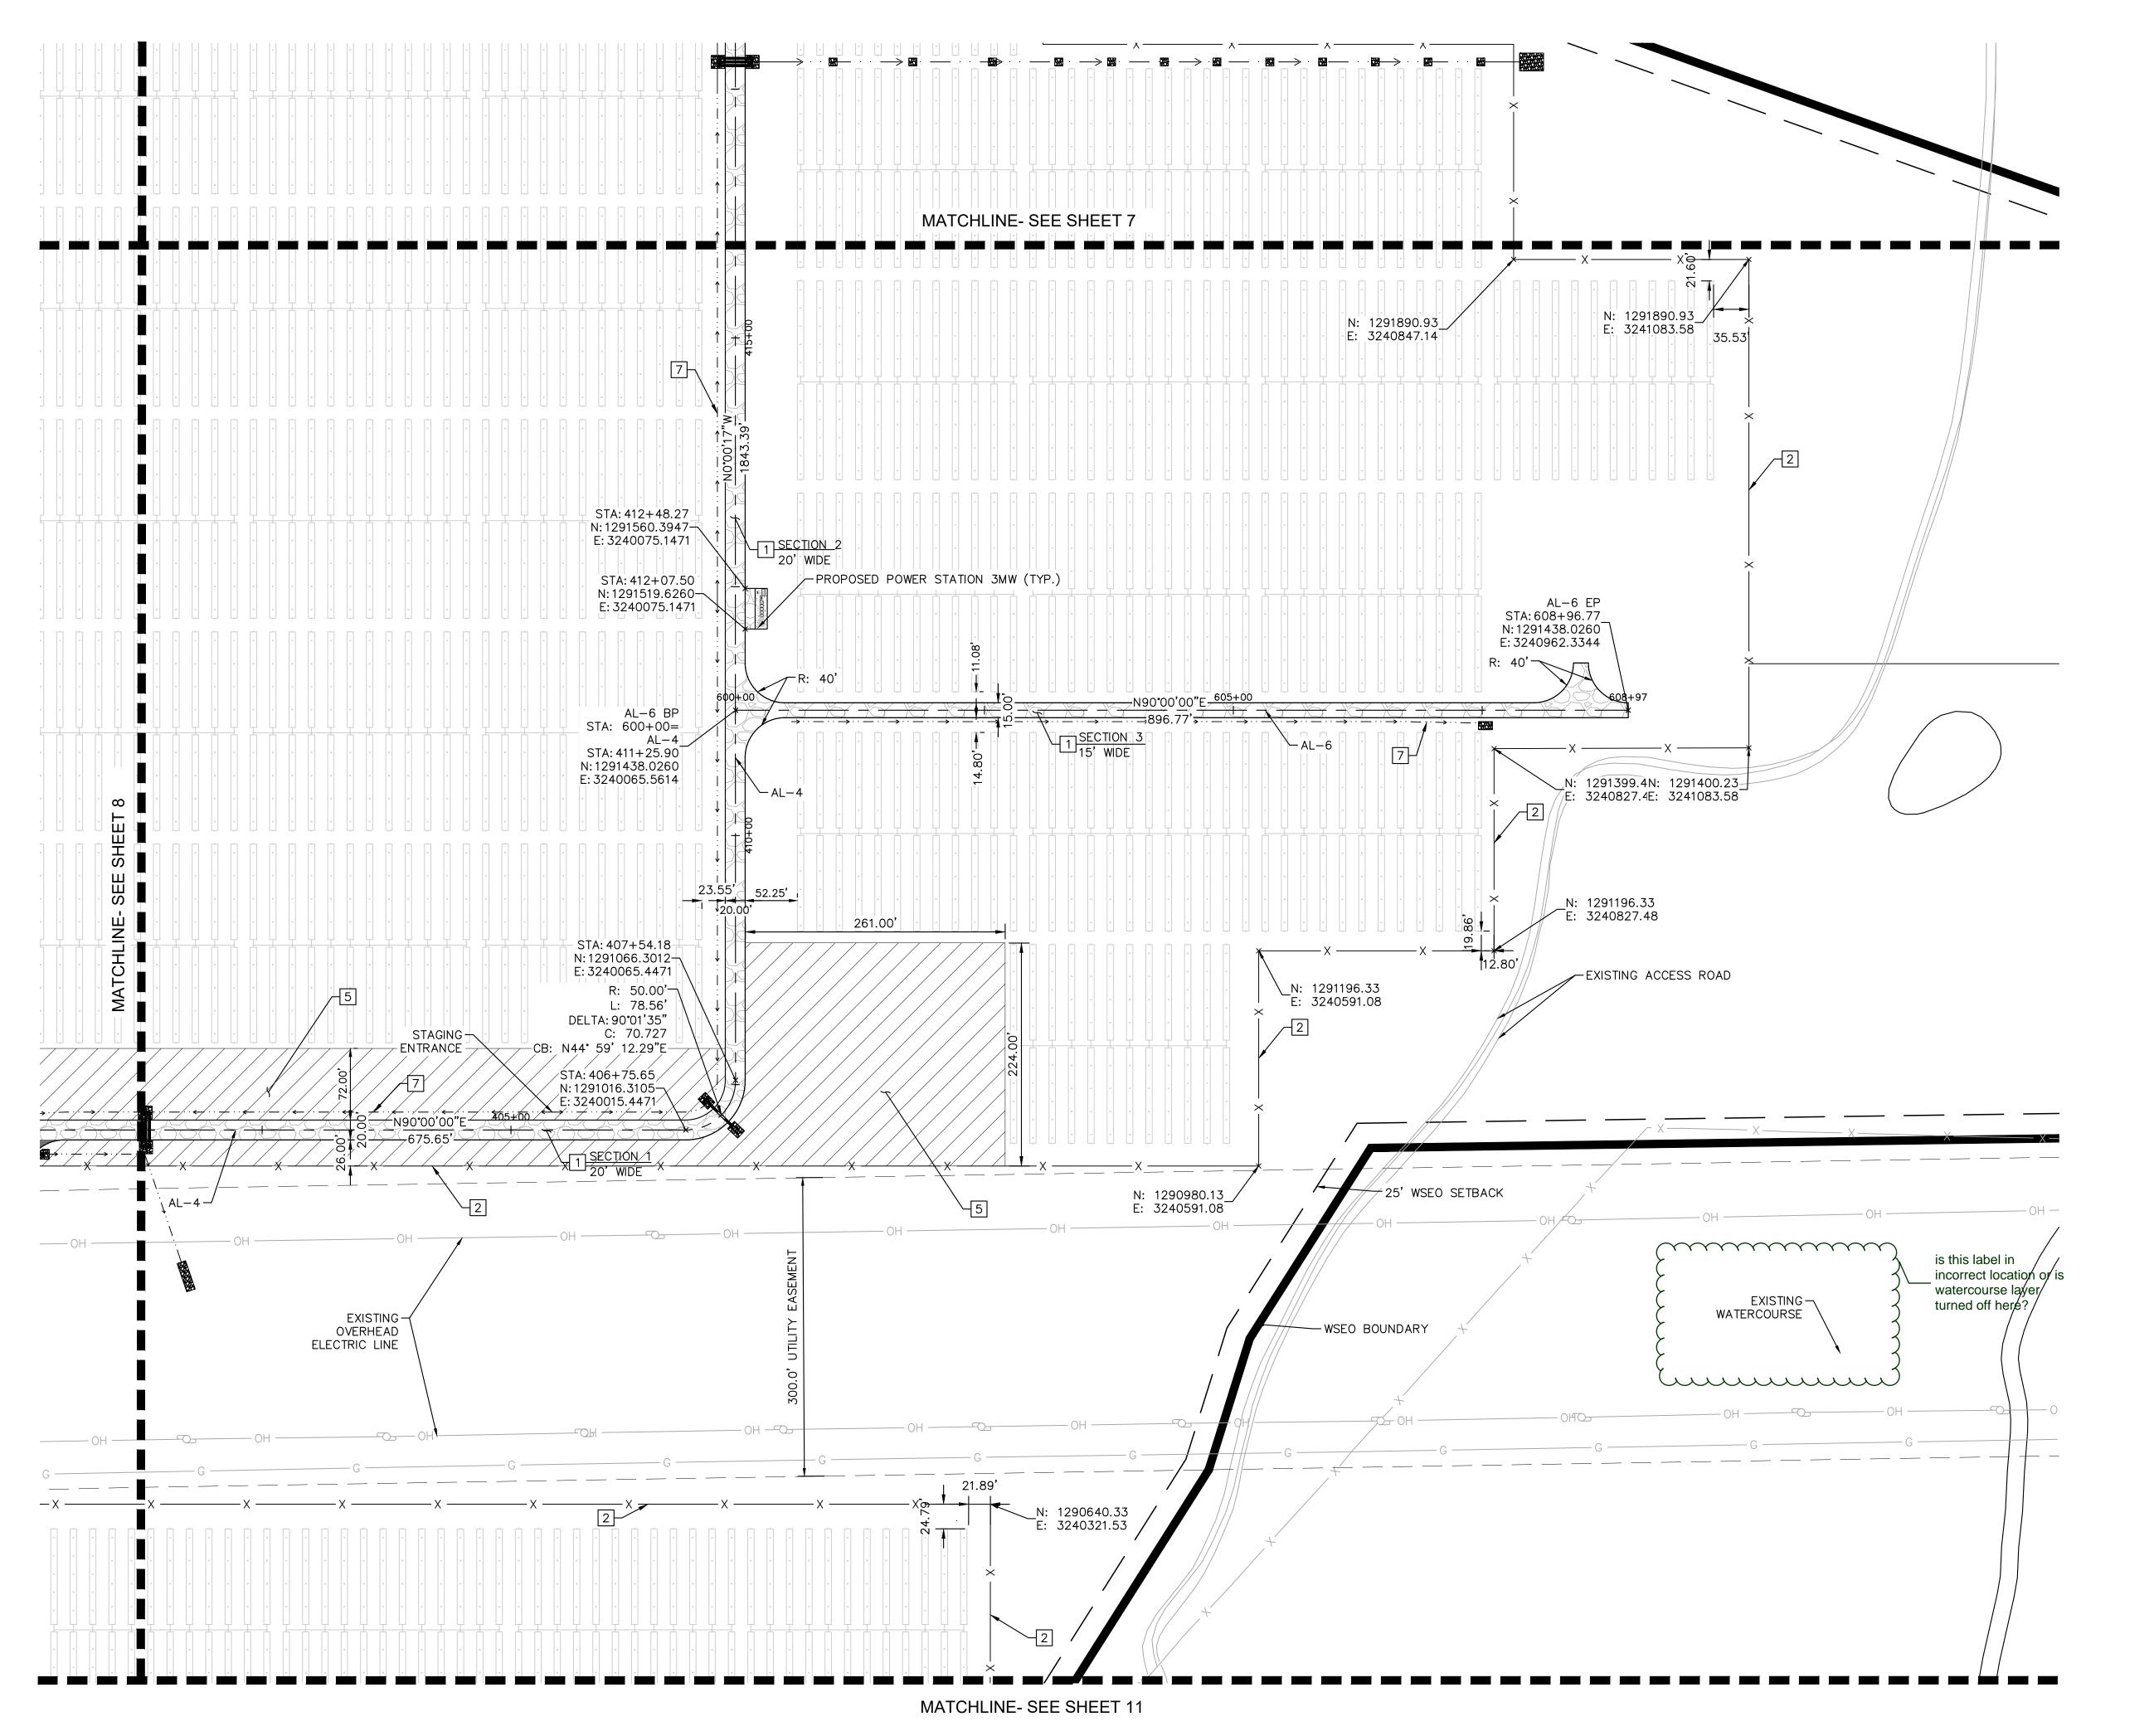

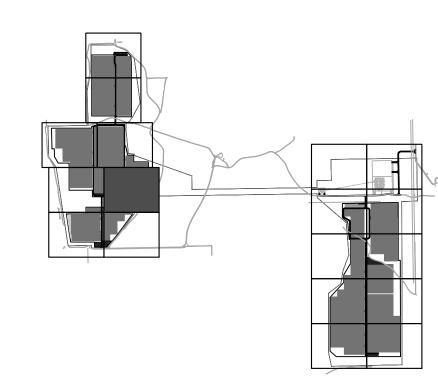

KEY MAP

CONSTRUCTION KEY NOTES:

ITFM

- CONSTRUCT PRIVATE ACCESS ROAD PER TYPICAL

 1 SECTION ON SHEET 124. (SECTION TYPE AND WIDTH PER PLAN)
- 2 INSTALL 8' PERIMETER CHAINLINK FENCE PER DETAIL ON SHEET 124.
- 3 INSTALL SWING GATE PER DETAIL ON SHEET 124.
- INSTALL POWER STATION PAD PER DETAIL ON SHEET 124.
- 5 CONSTRUCT STAGING AREA PER DETAIL ON SHEET 124.
- 6 CONVEYANCE DITCH PER DETAIL ON SHEET 147 (SEE SHEETS 127 TO 144 FOR DETAILED GRADING)
- 7 ROADSIDE SWALE PER DETAIL ON SHEET 147

NOTES:

1. ALL DIMENSIONS PROVIDED ON THE SITE PLAN ARE TO THE EDGE OF PROPERTY LINE, ACCESS ROAD, EDGE OF SOLAR STRUCTURE, EDGE OF POWER STATION PAD, OR PERIMETER FENCE LINE.

WSEO BOUNDARY

LEGEND:


E T

EXISTING MAINTENANCE ROAD TO BE REMOVED

CONSTRUCTION STAGING AREA

CONCRETE LOWERING ROAD
SECTION PER DETAIL ON SHEET
124

GRAPHIC SCALE IN FEET
0 40 80 160

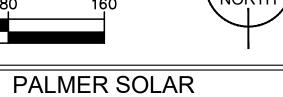

DETAILED SITE PLAN

EL PASO COUNTY, CO

Kimley» Hori

© 2019 KIMLEY-HORN AND ASSOCIATES, INC.

2 N. NEVADA AVENUE, SUITE 300
COLORADO SPRINGS, CO 80903 (719) 453-0180

DESIGNED DRAWN CHECKED

TO KRK EJG


EJG KRK EJG

SCALE (H): 1"= 80'
SCALE (V): N/A

DATE:
FEBRUARY 11, 2018

PROJECT NO.
096495003

DWG. NAME

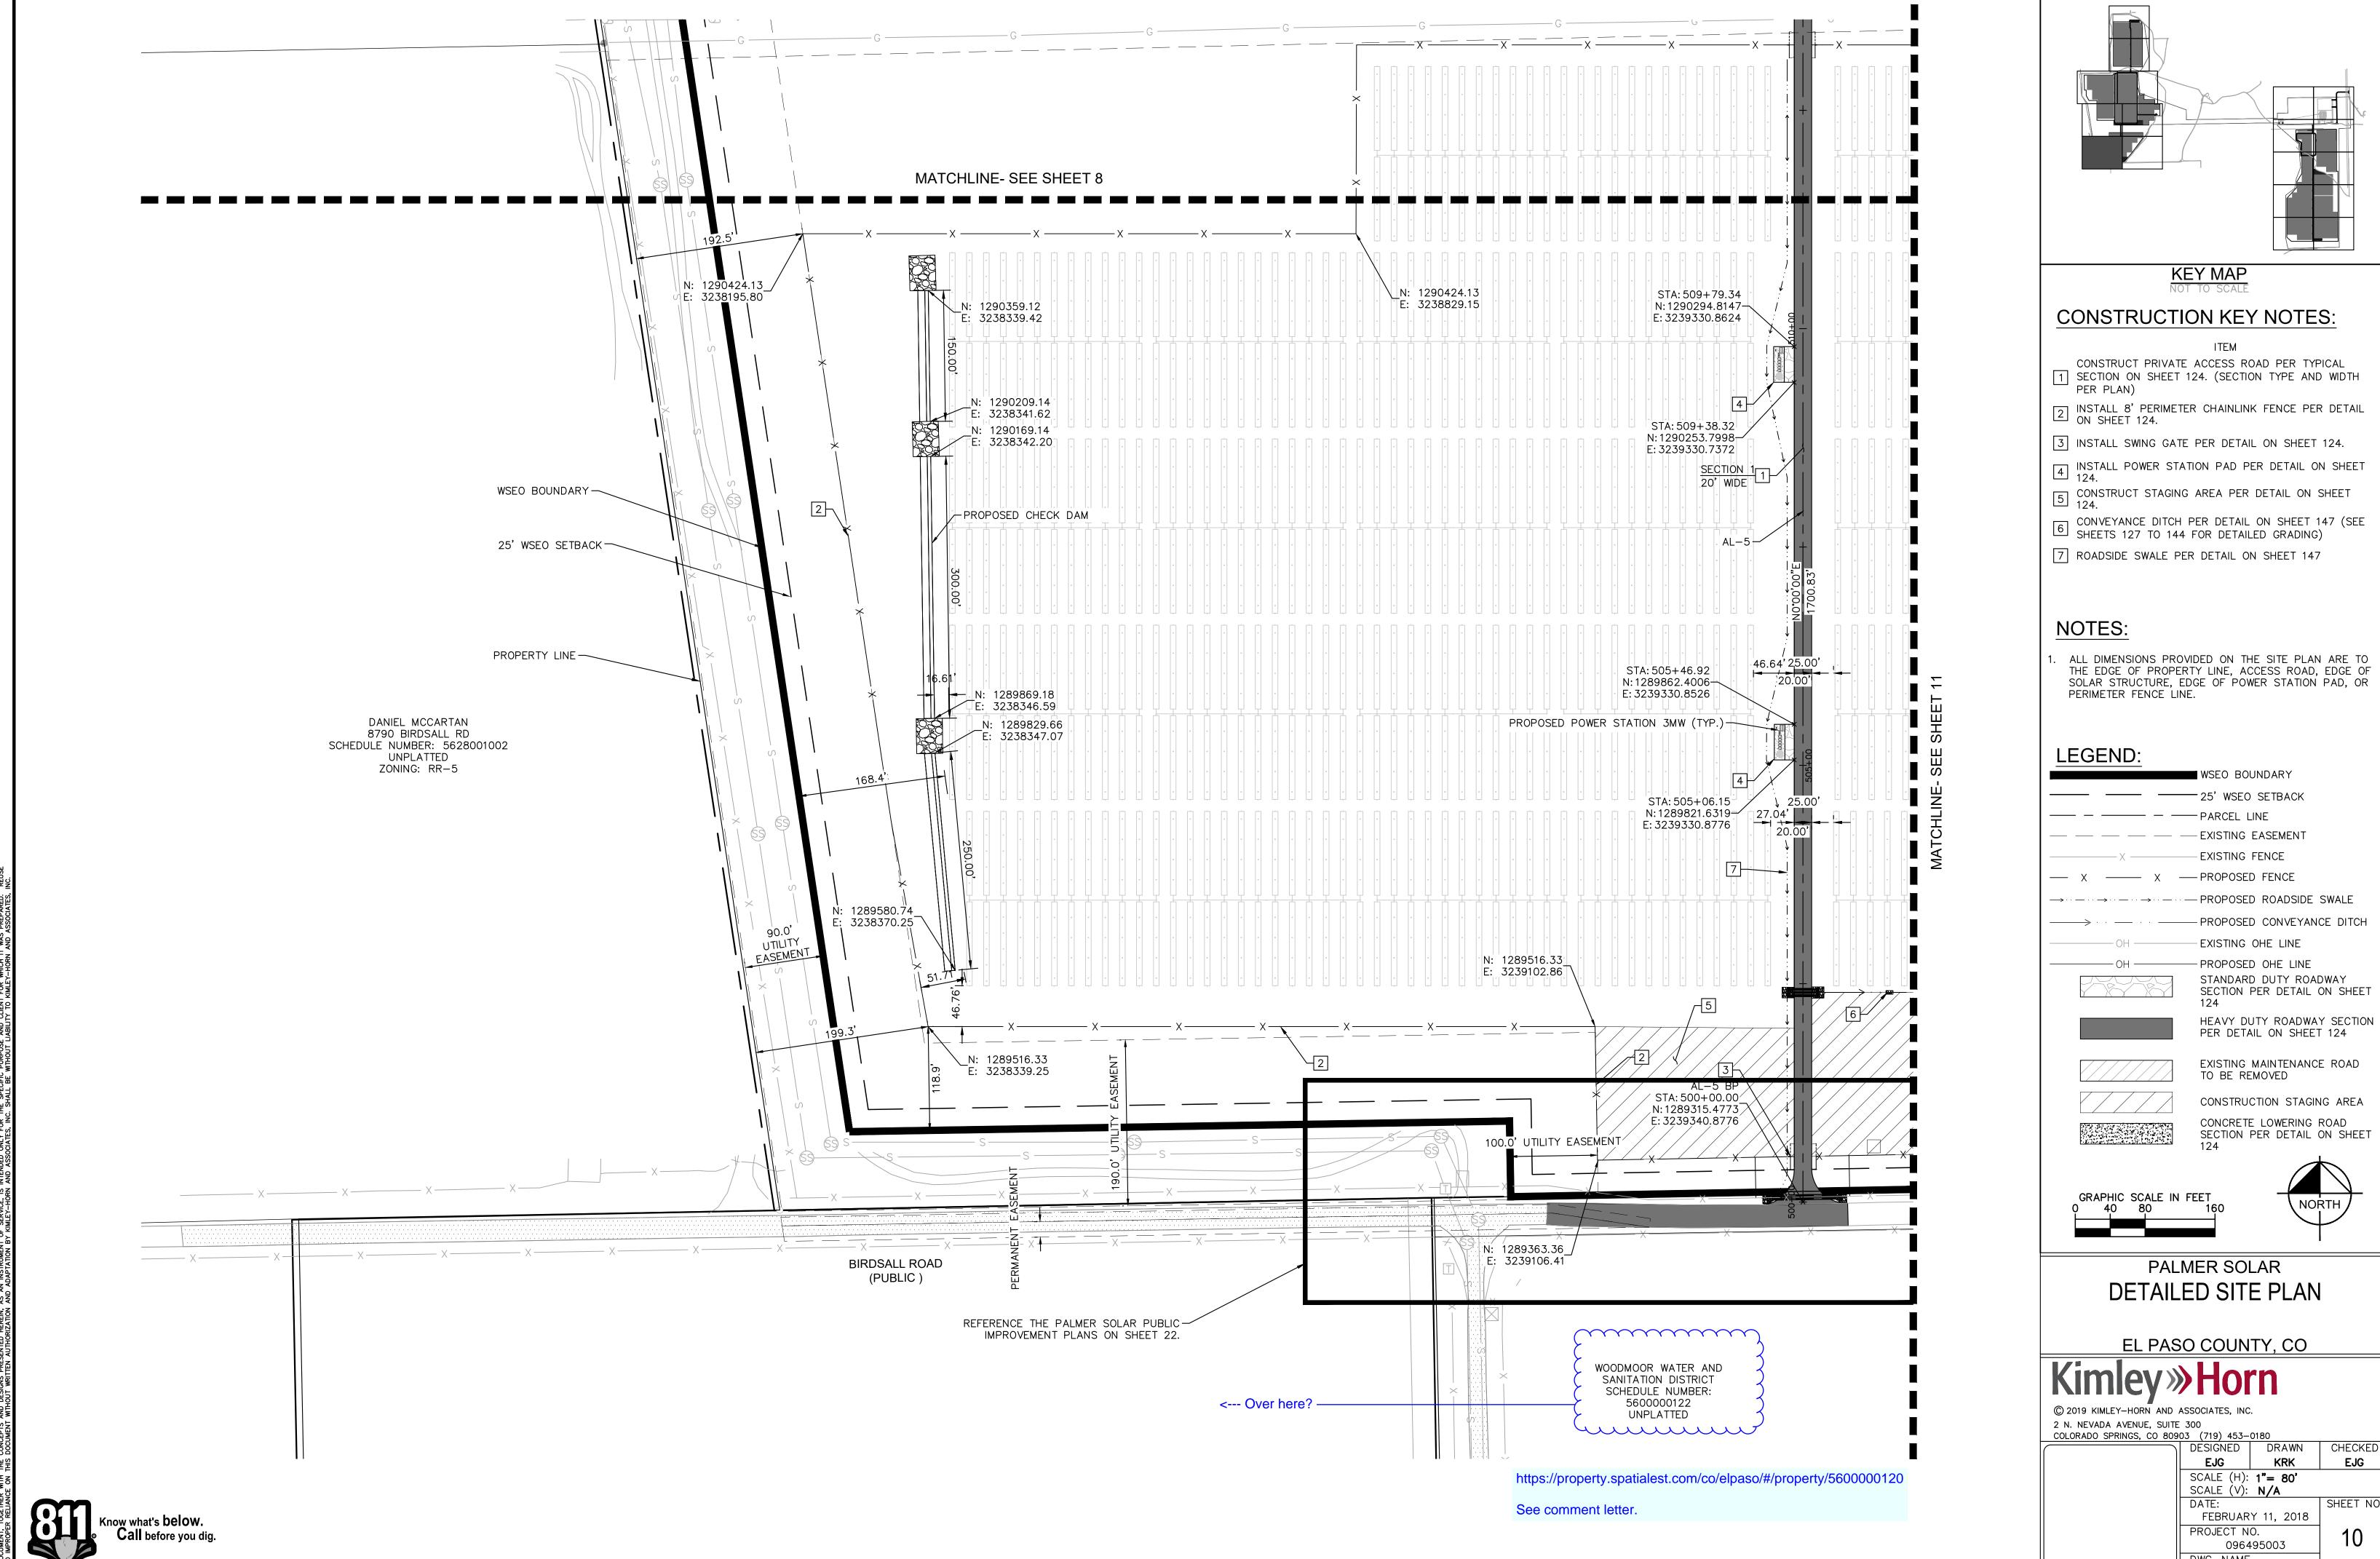

- 1 SECTION ON SHEET 124. (SECTION TYPE AND WIDTH


ALL DIMENSIONS PROVIDED ON THE SITE PLAN ARE TO THE EDGE OF PROPERTY LINE, ACCESS ROAD, EDGE OF SOLAR STRUCTURE, EDGE OF POWER STATION PAD, OR




EJG SHEET NO.

DWG. NAME 096495003_SP-SDP

PCD EA NUMBER 17-46

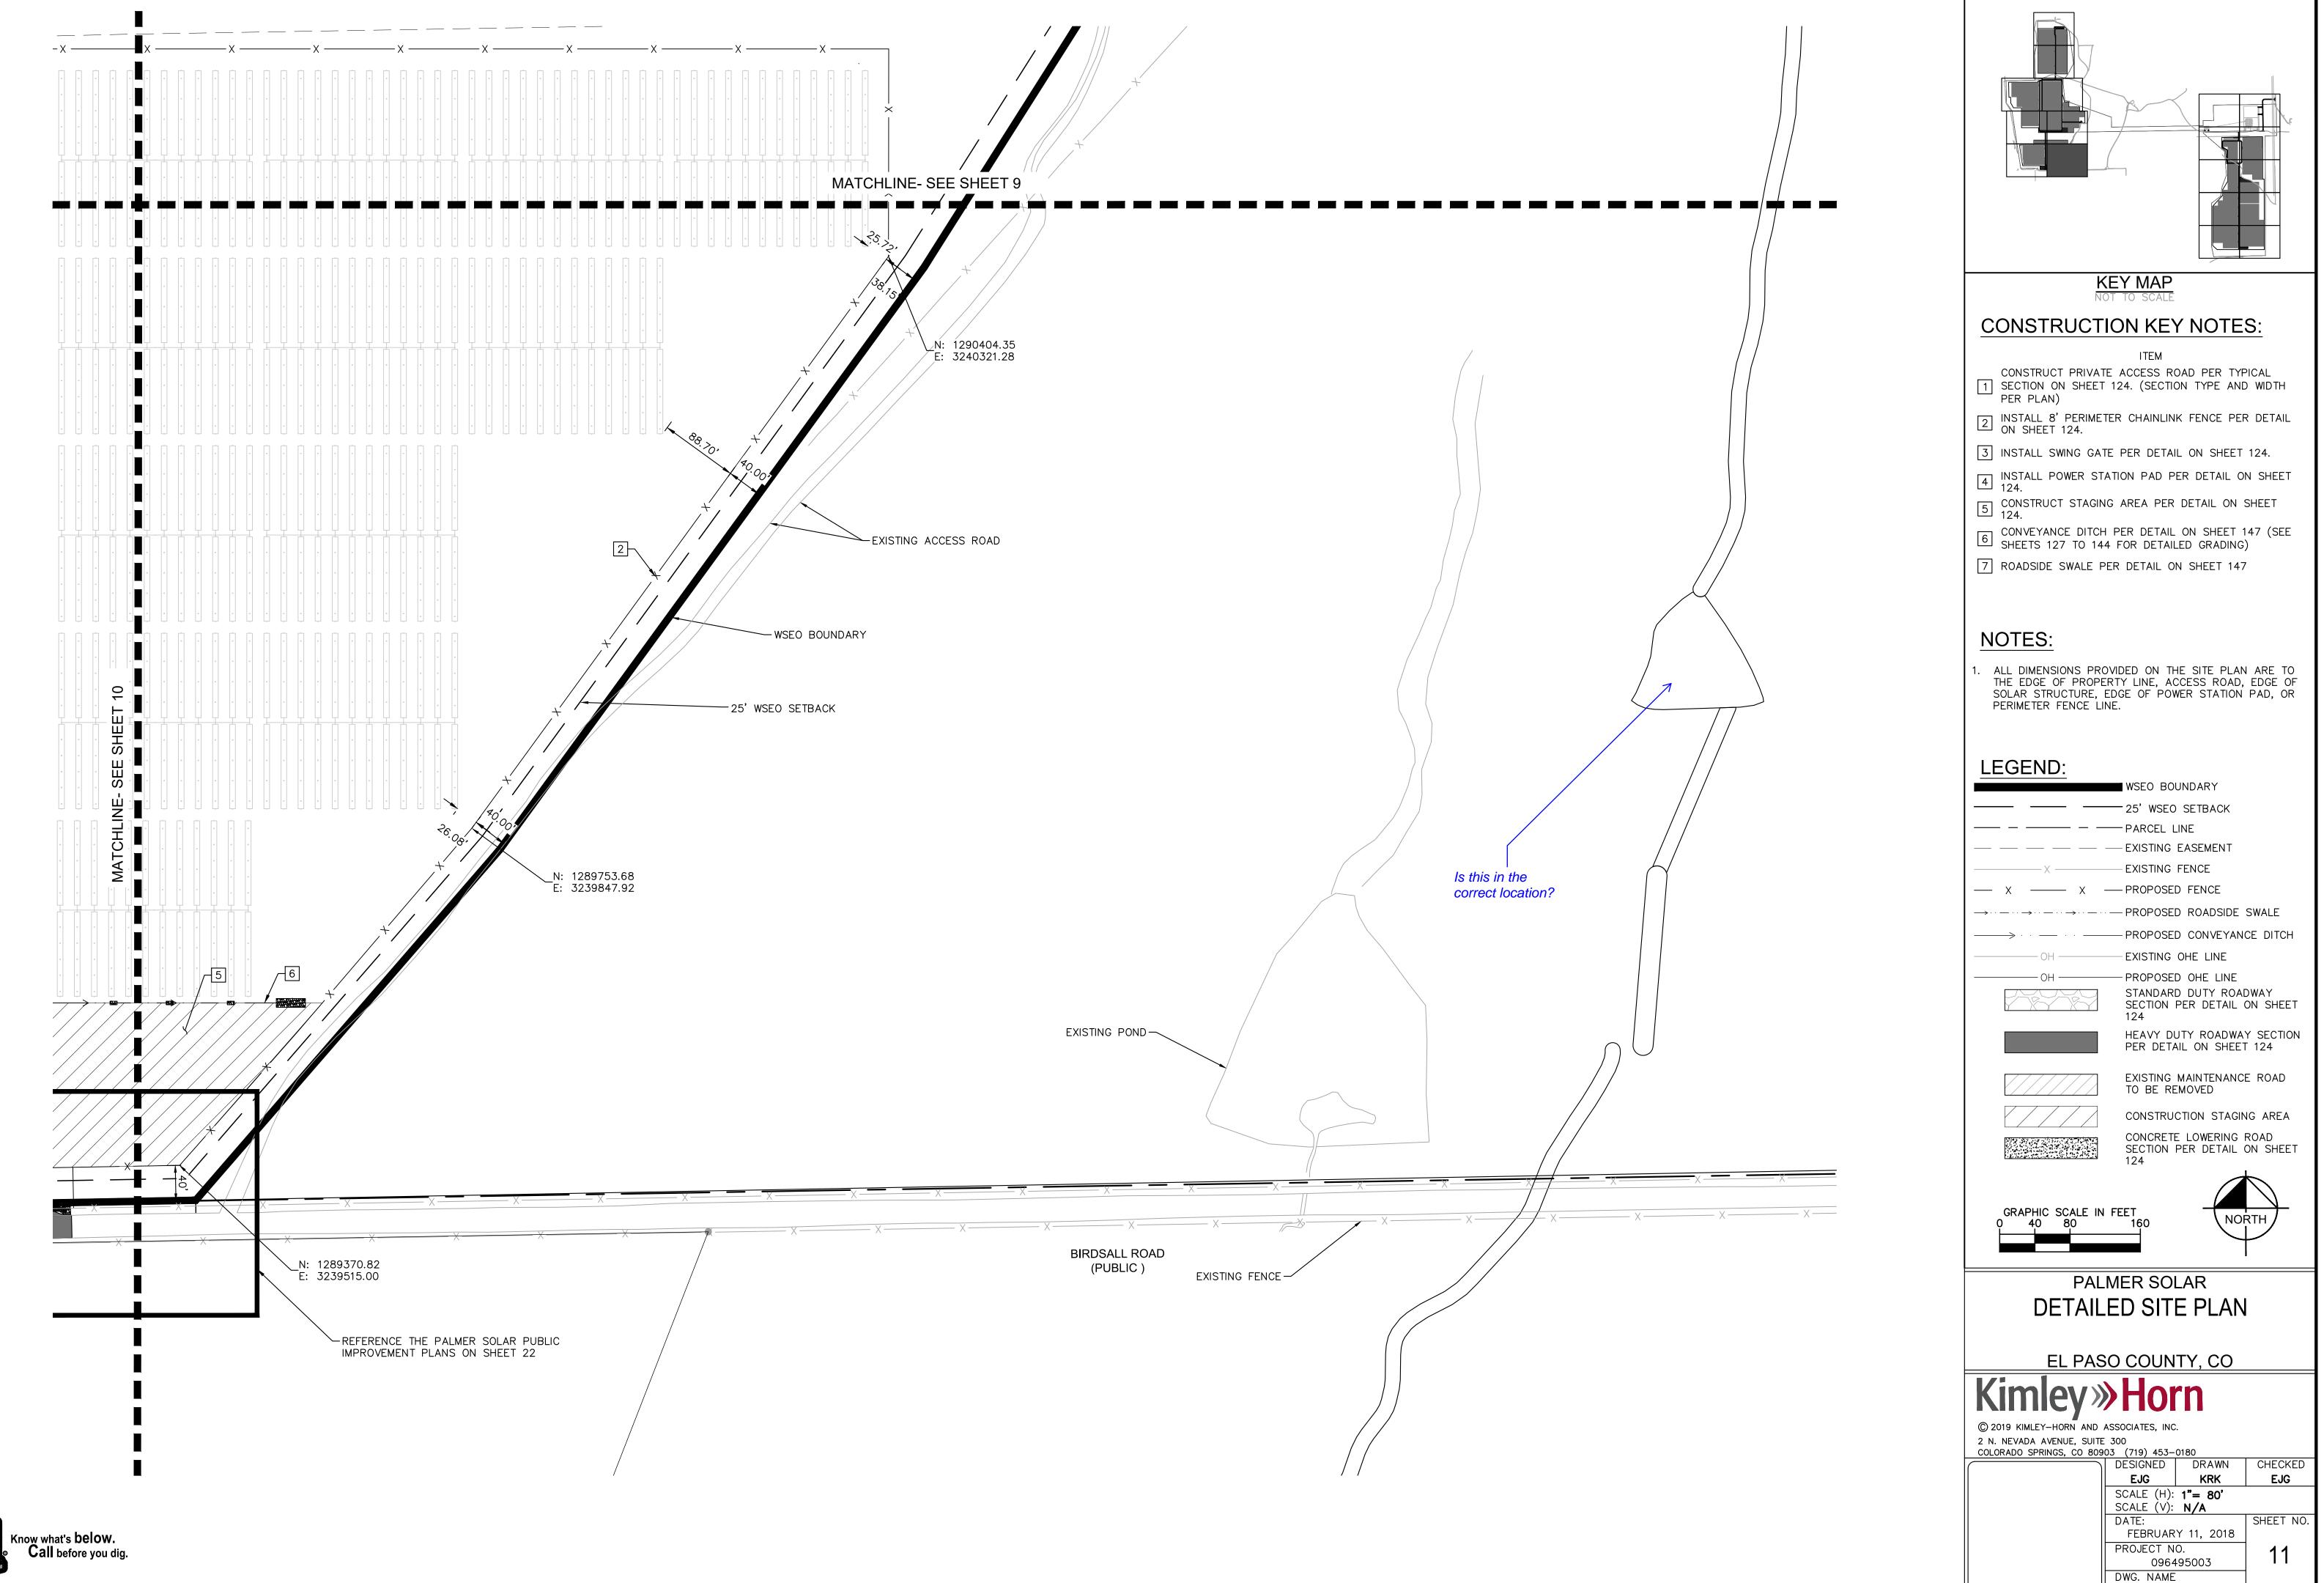

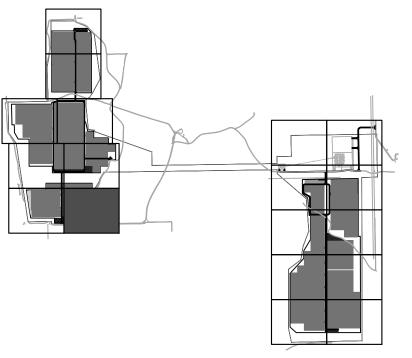



THE EDGE OF PROPERTY LINE, ACCESS ROAD, EDGE OF SOLAR STRUCTURE, EDGE OF POWER STATION PAD, OR


CONCRETE LOWERING ROAD SECTION PER DETAIL ON SHEET 124


SHEET NO.

096495003_SP-SDP

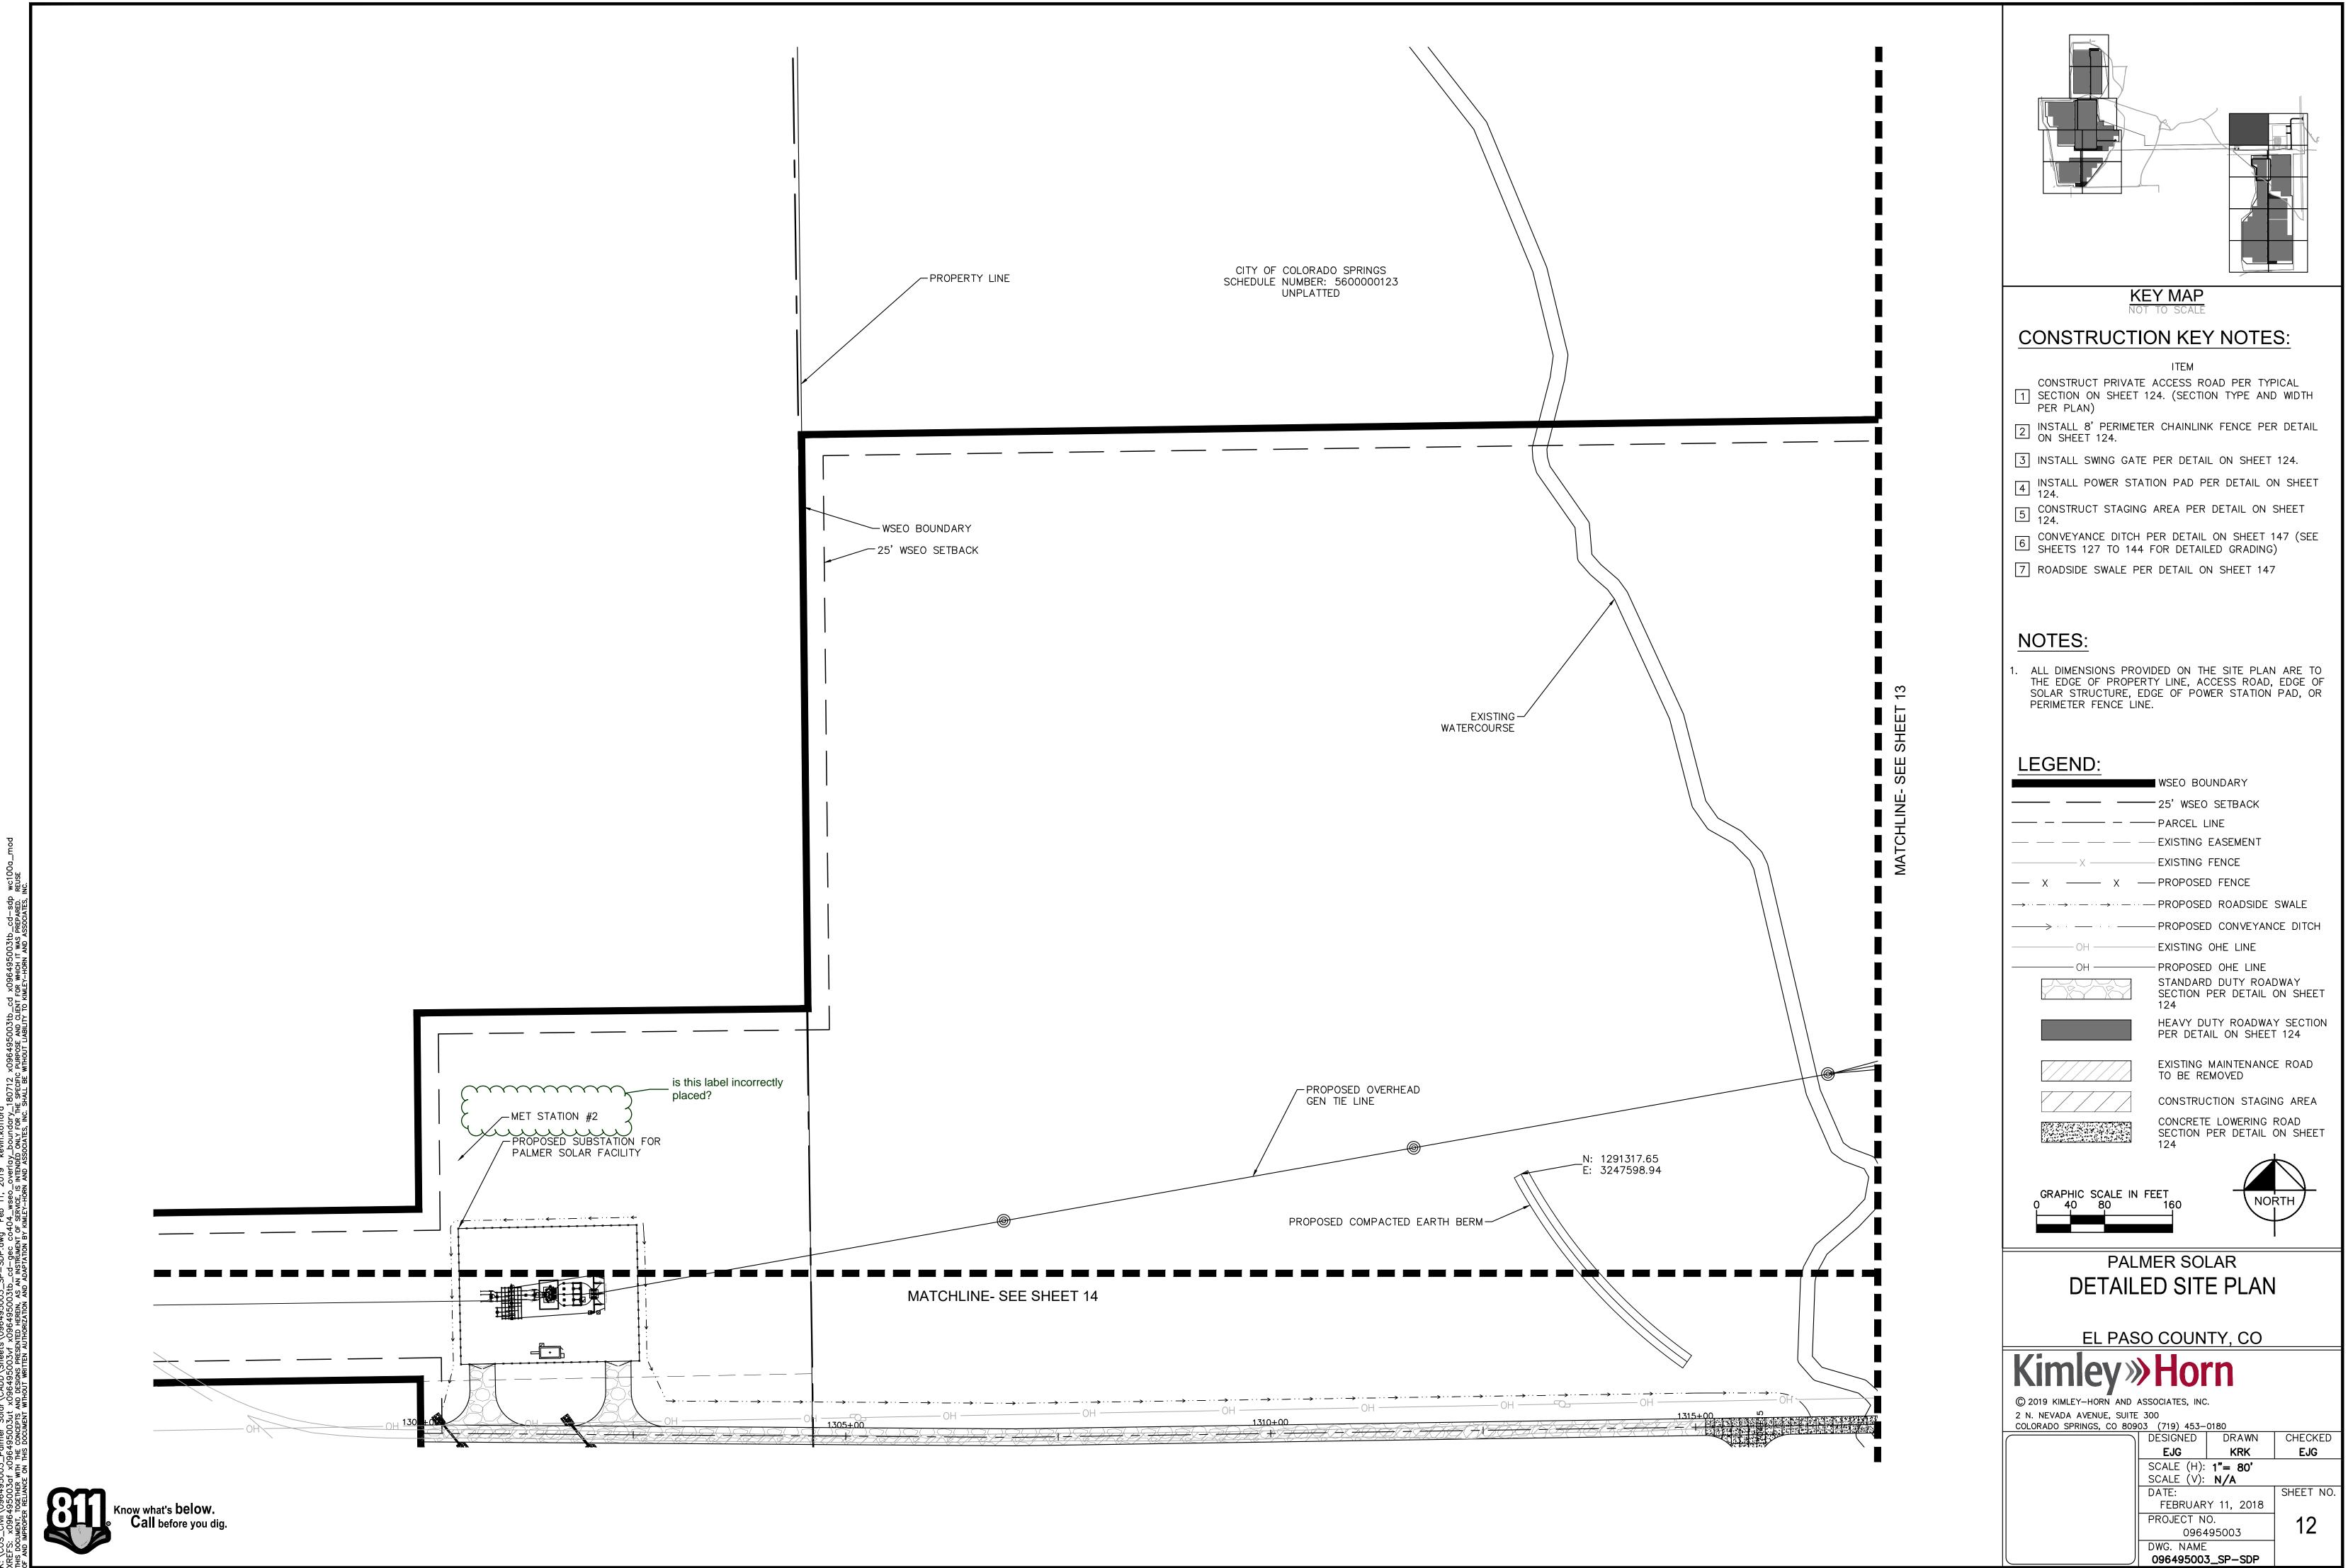


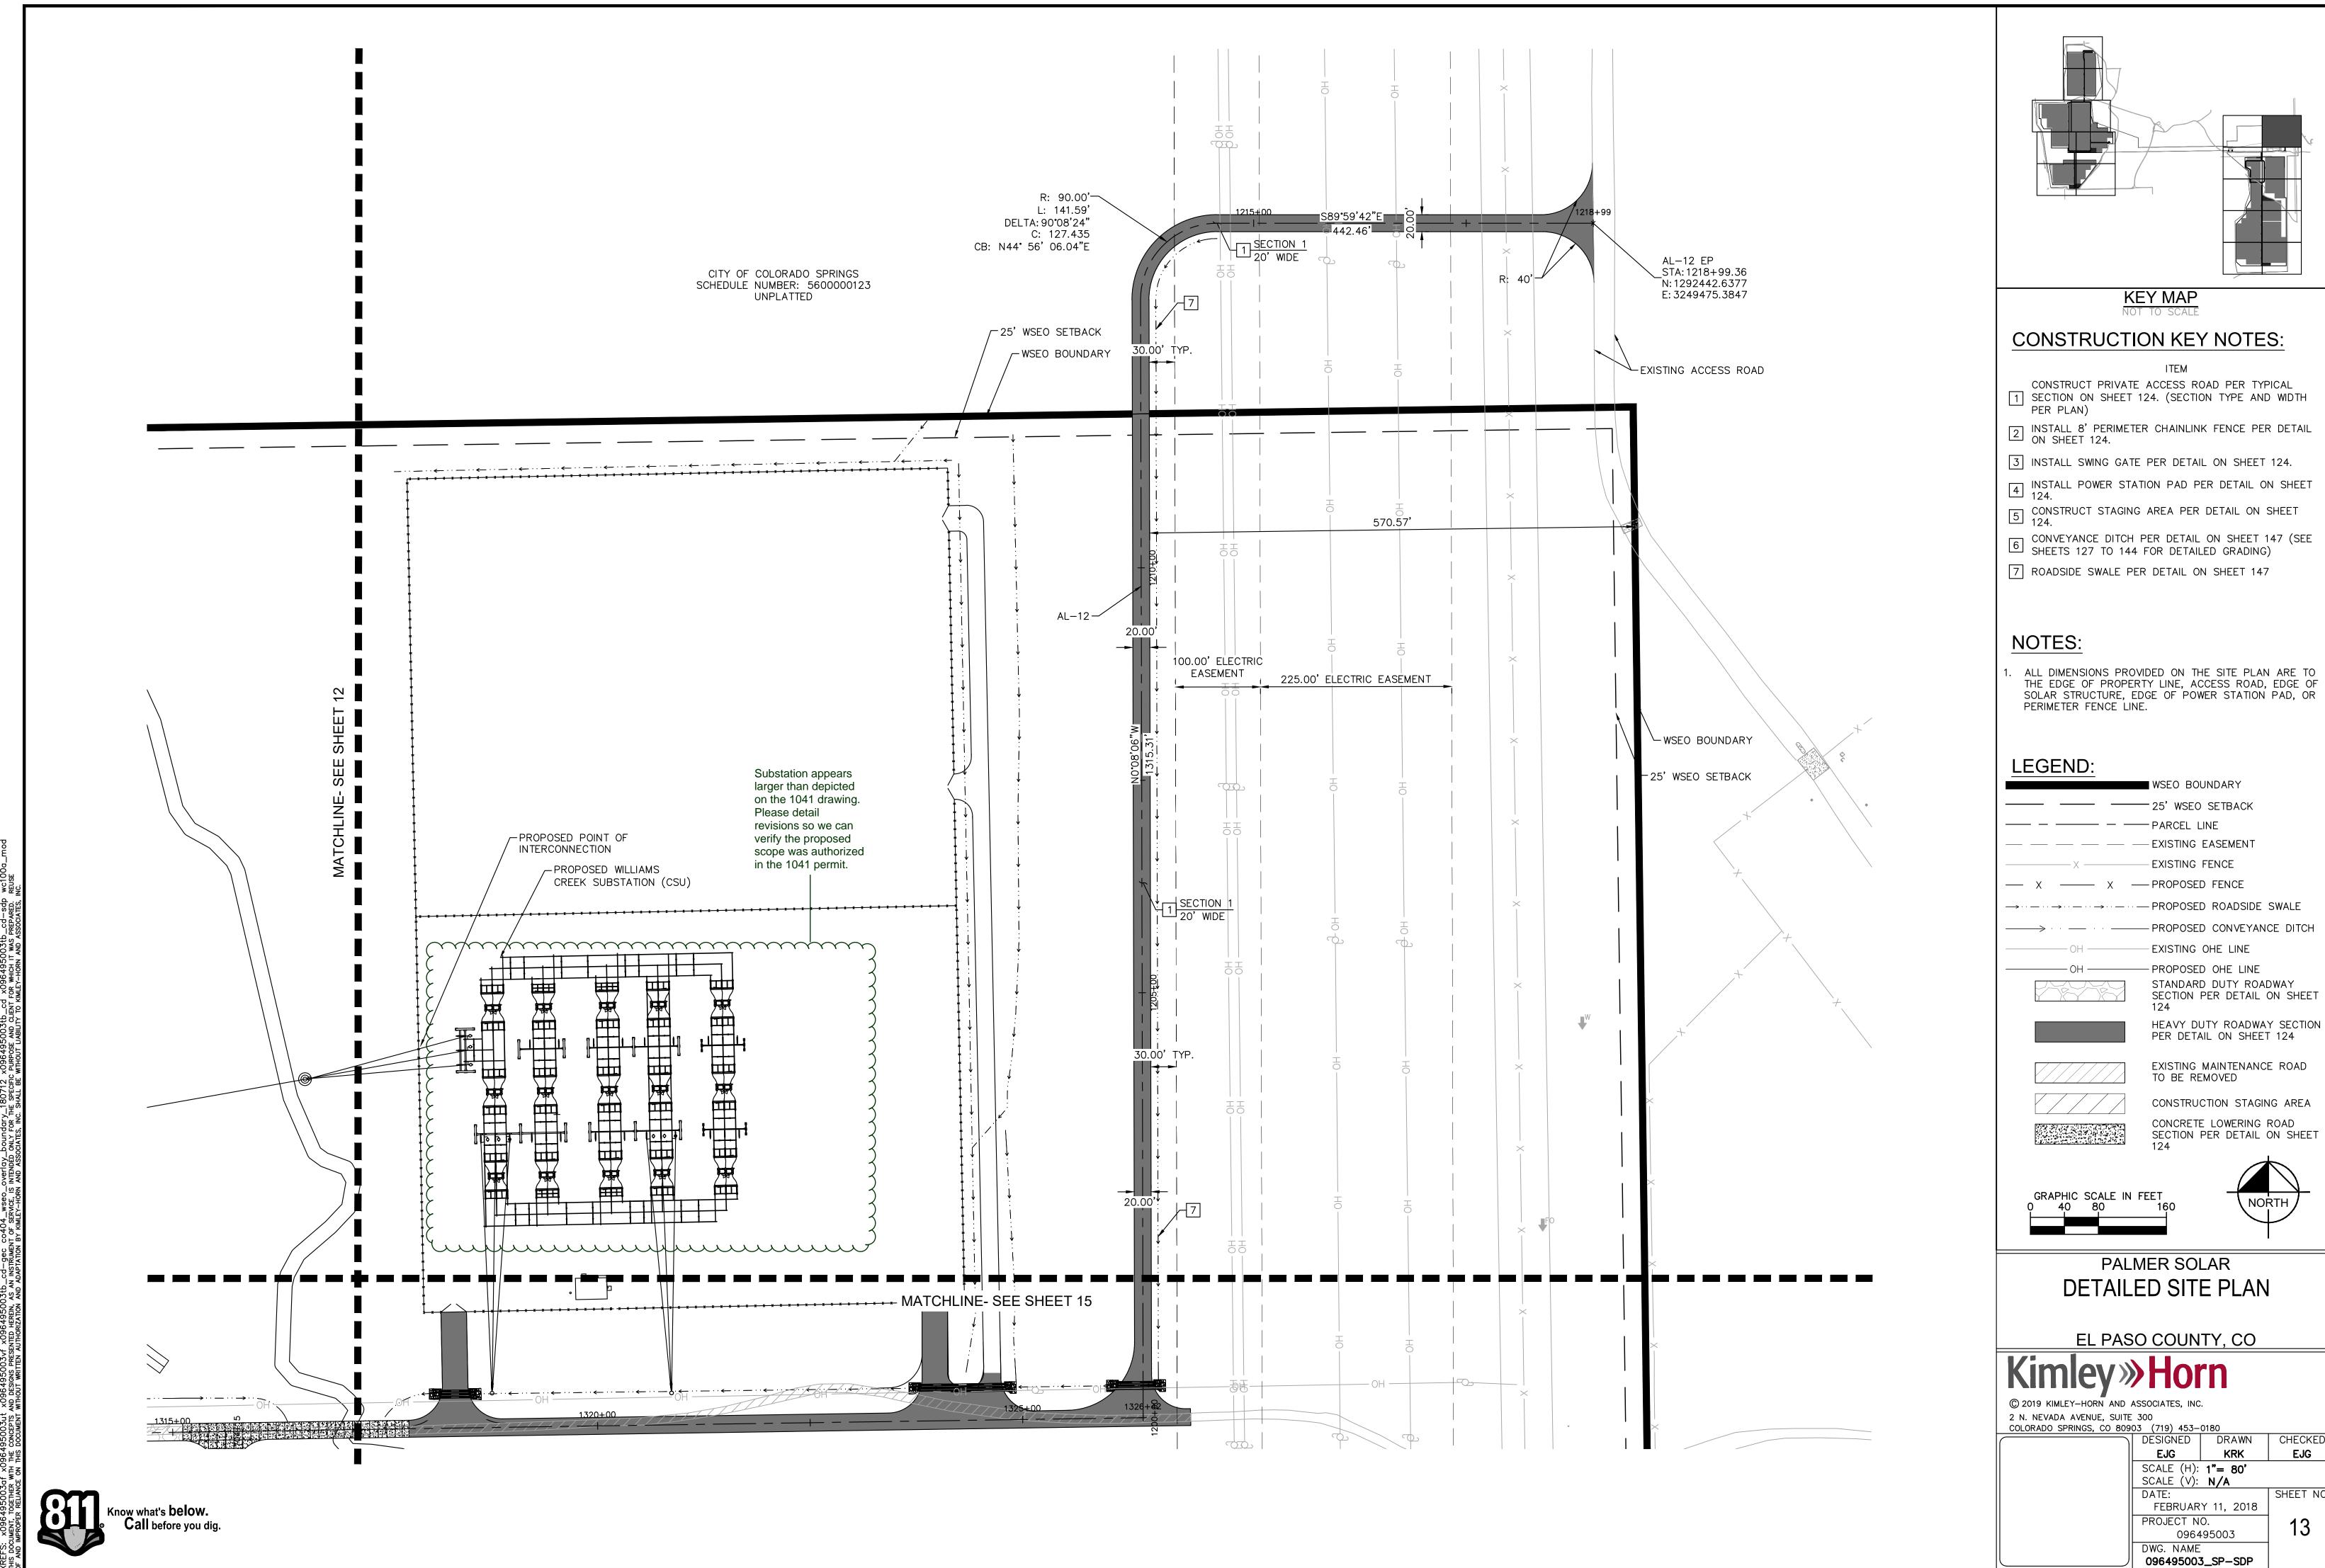


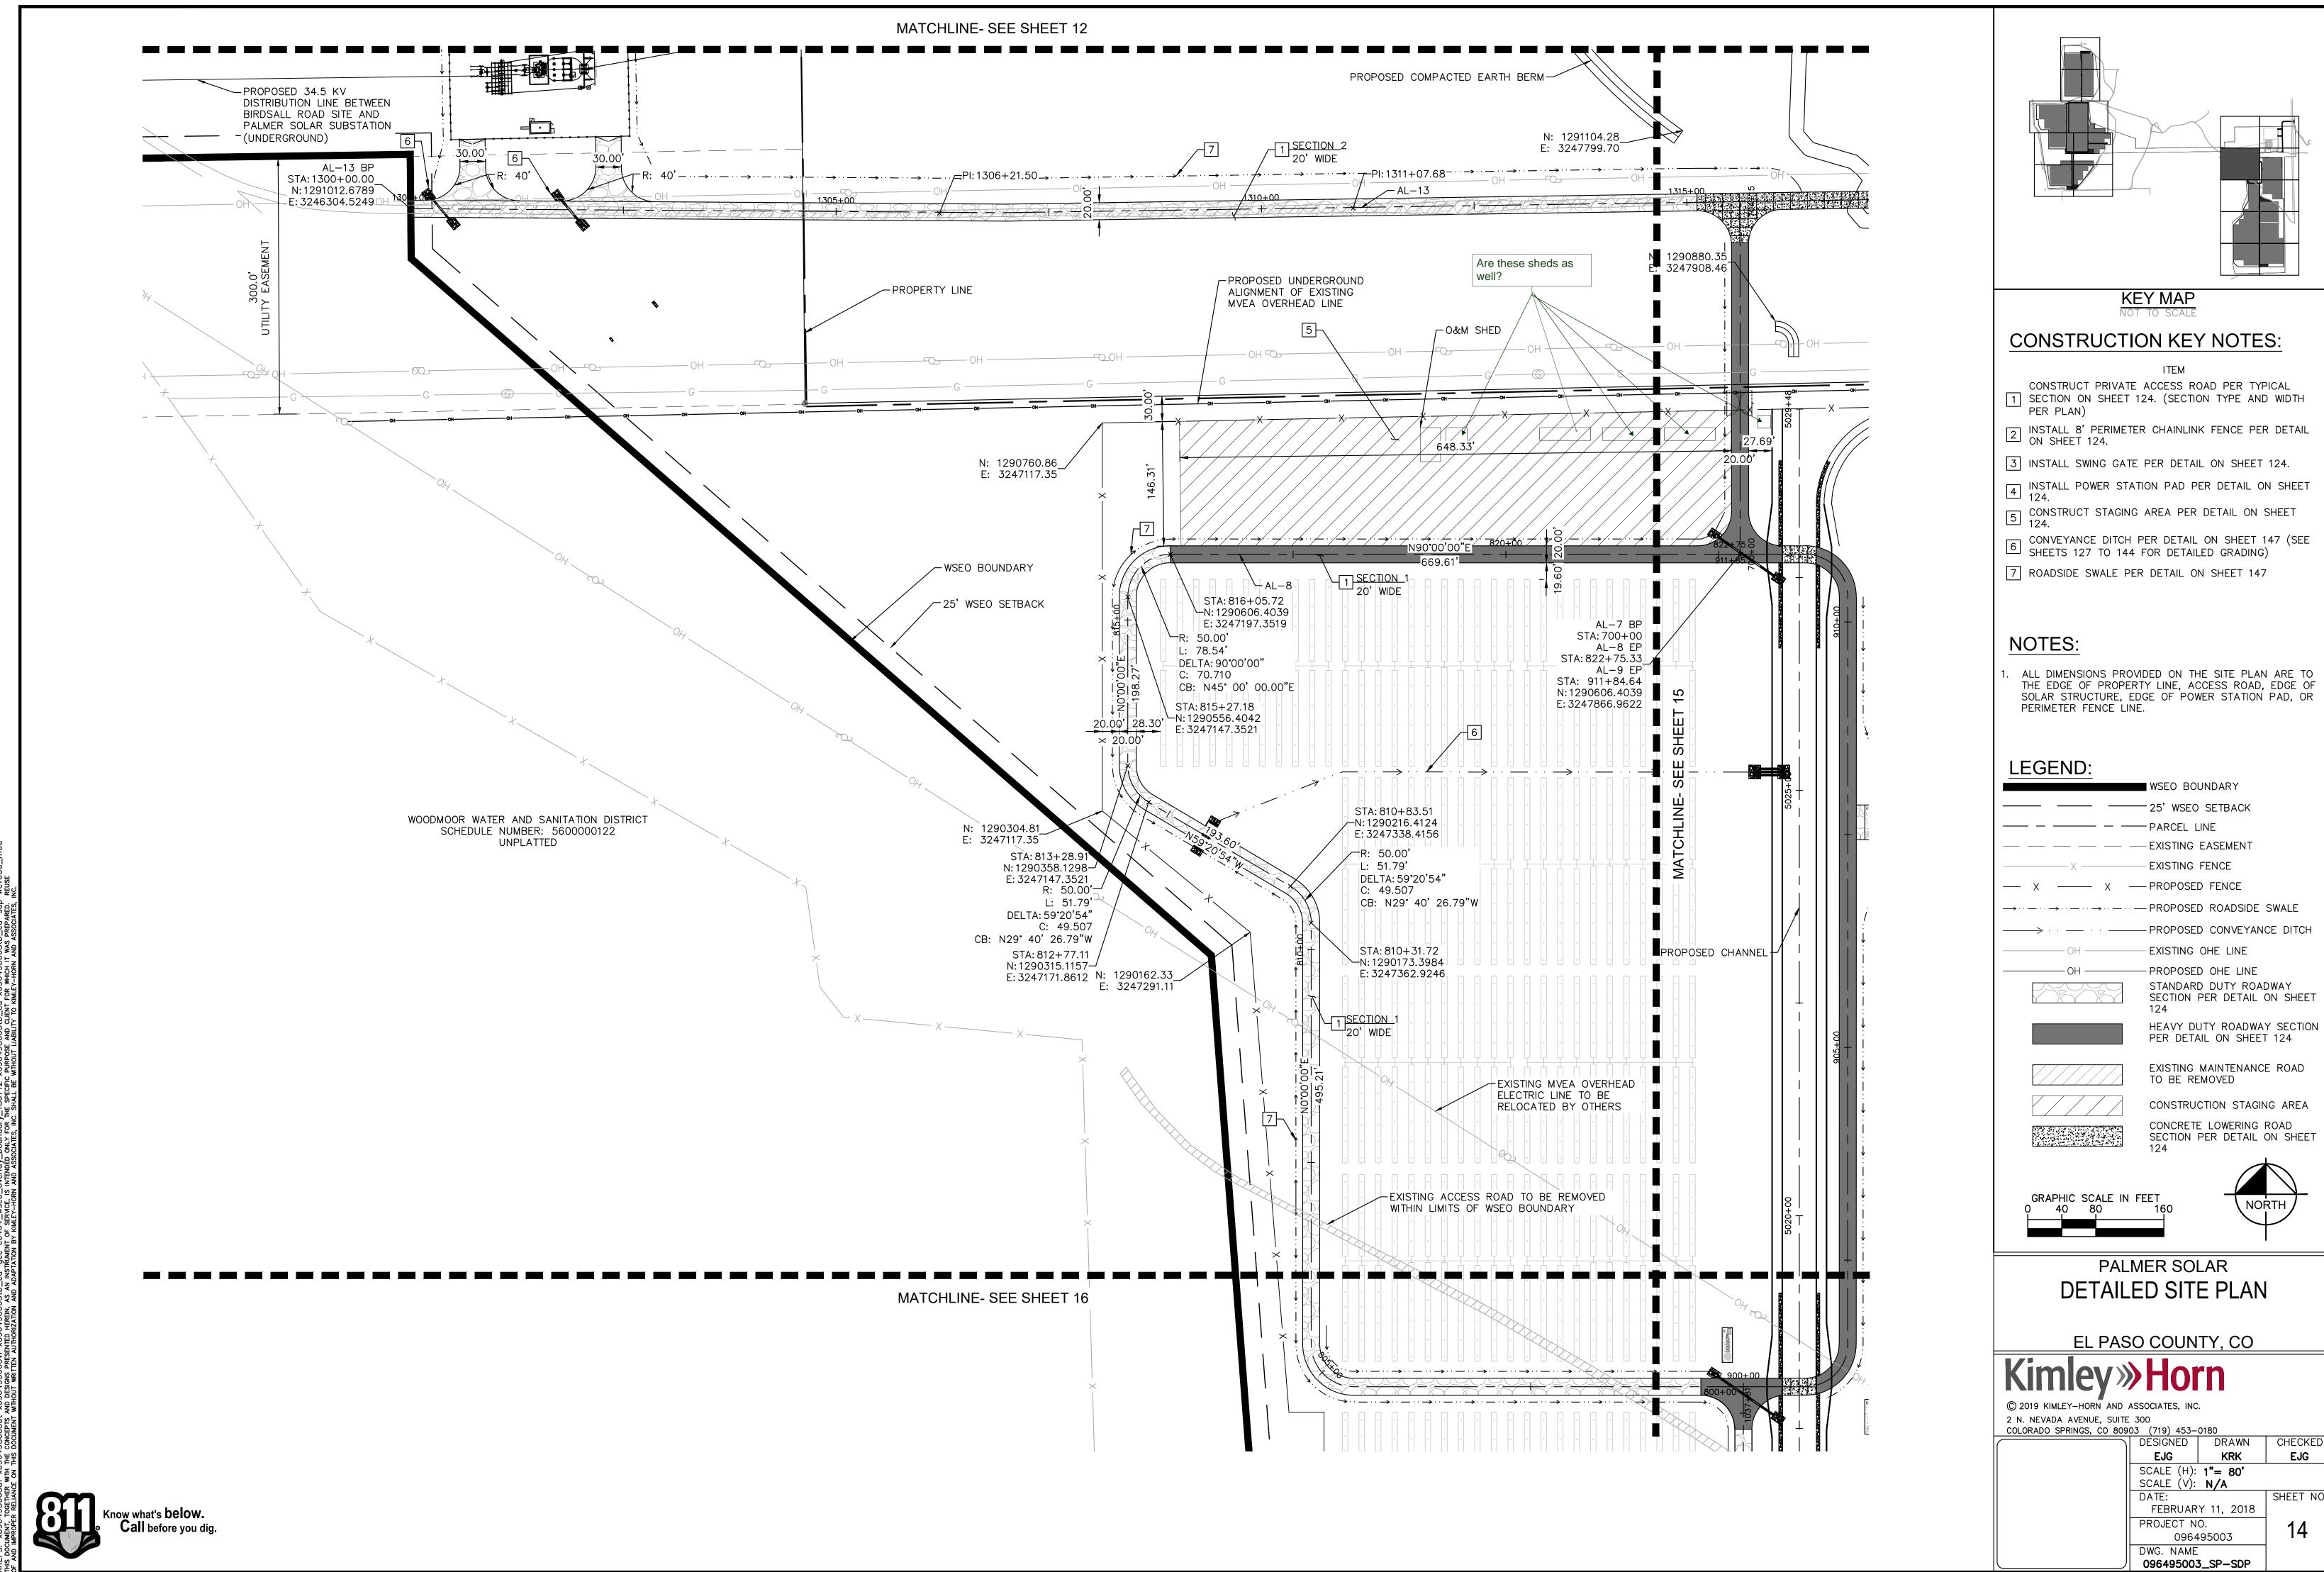

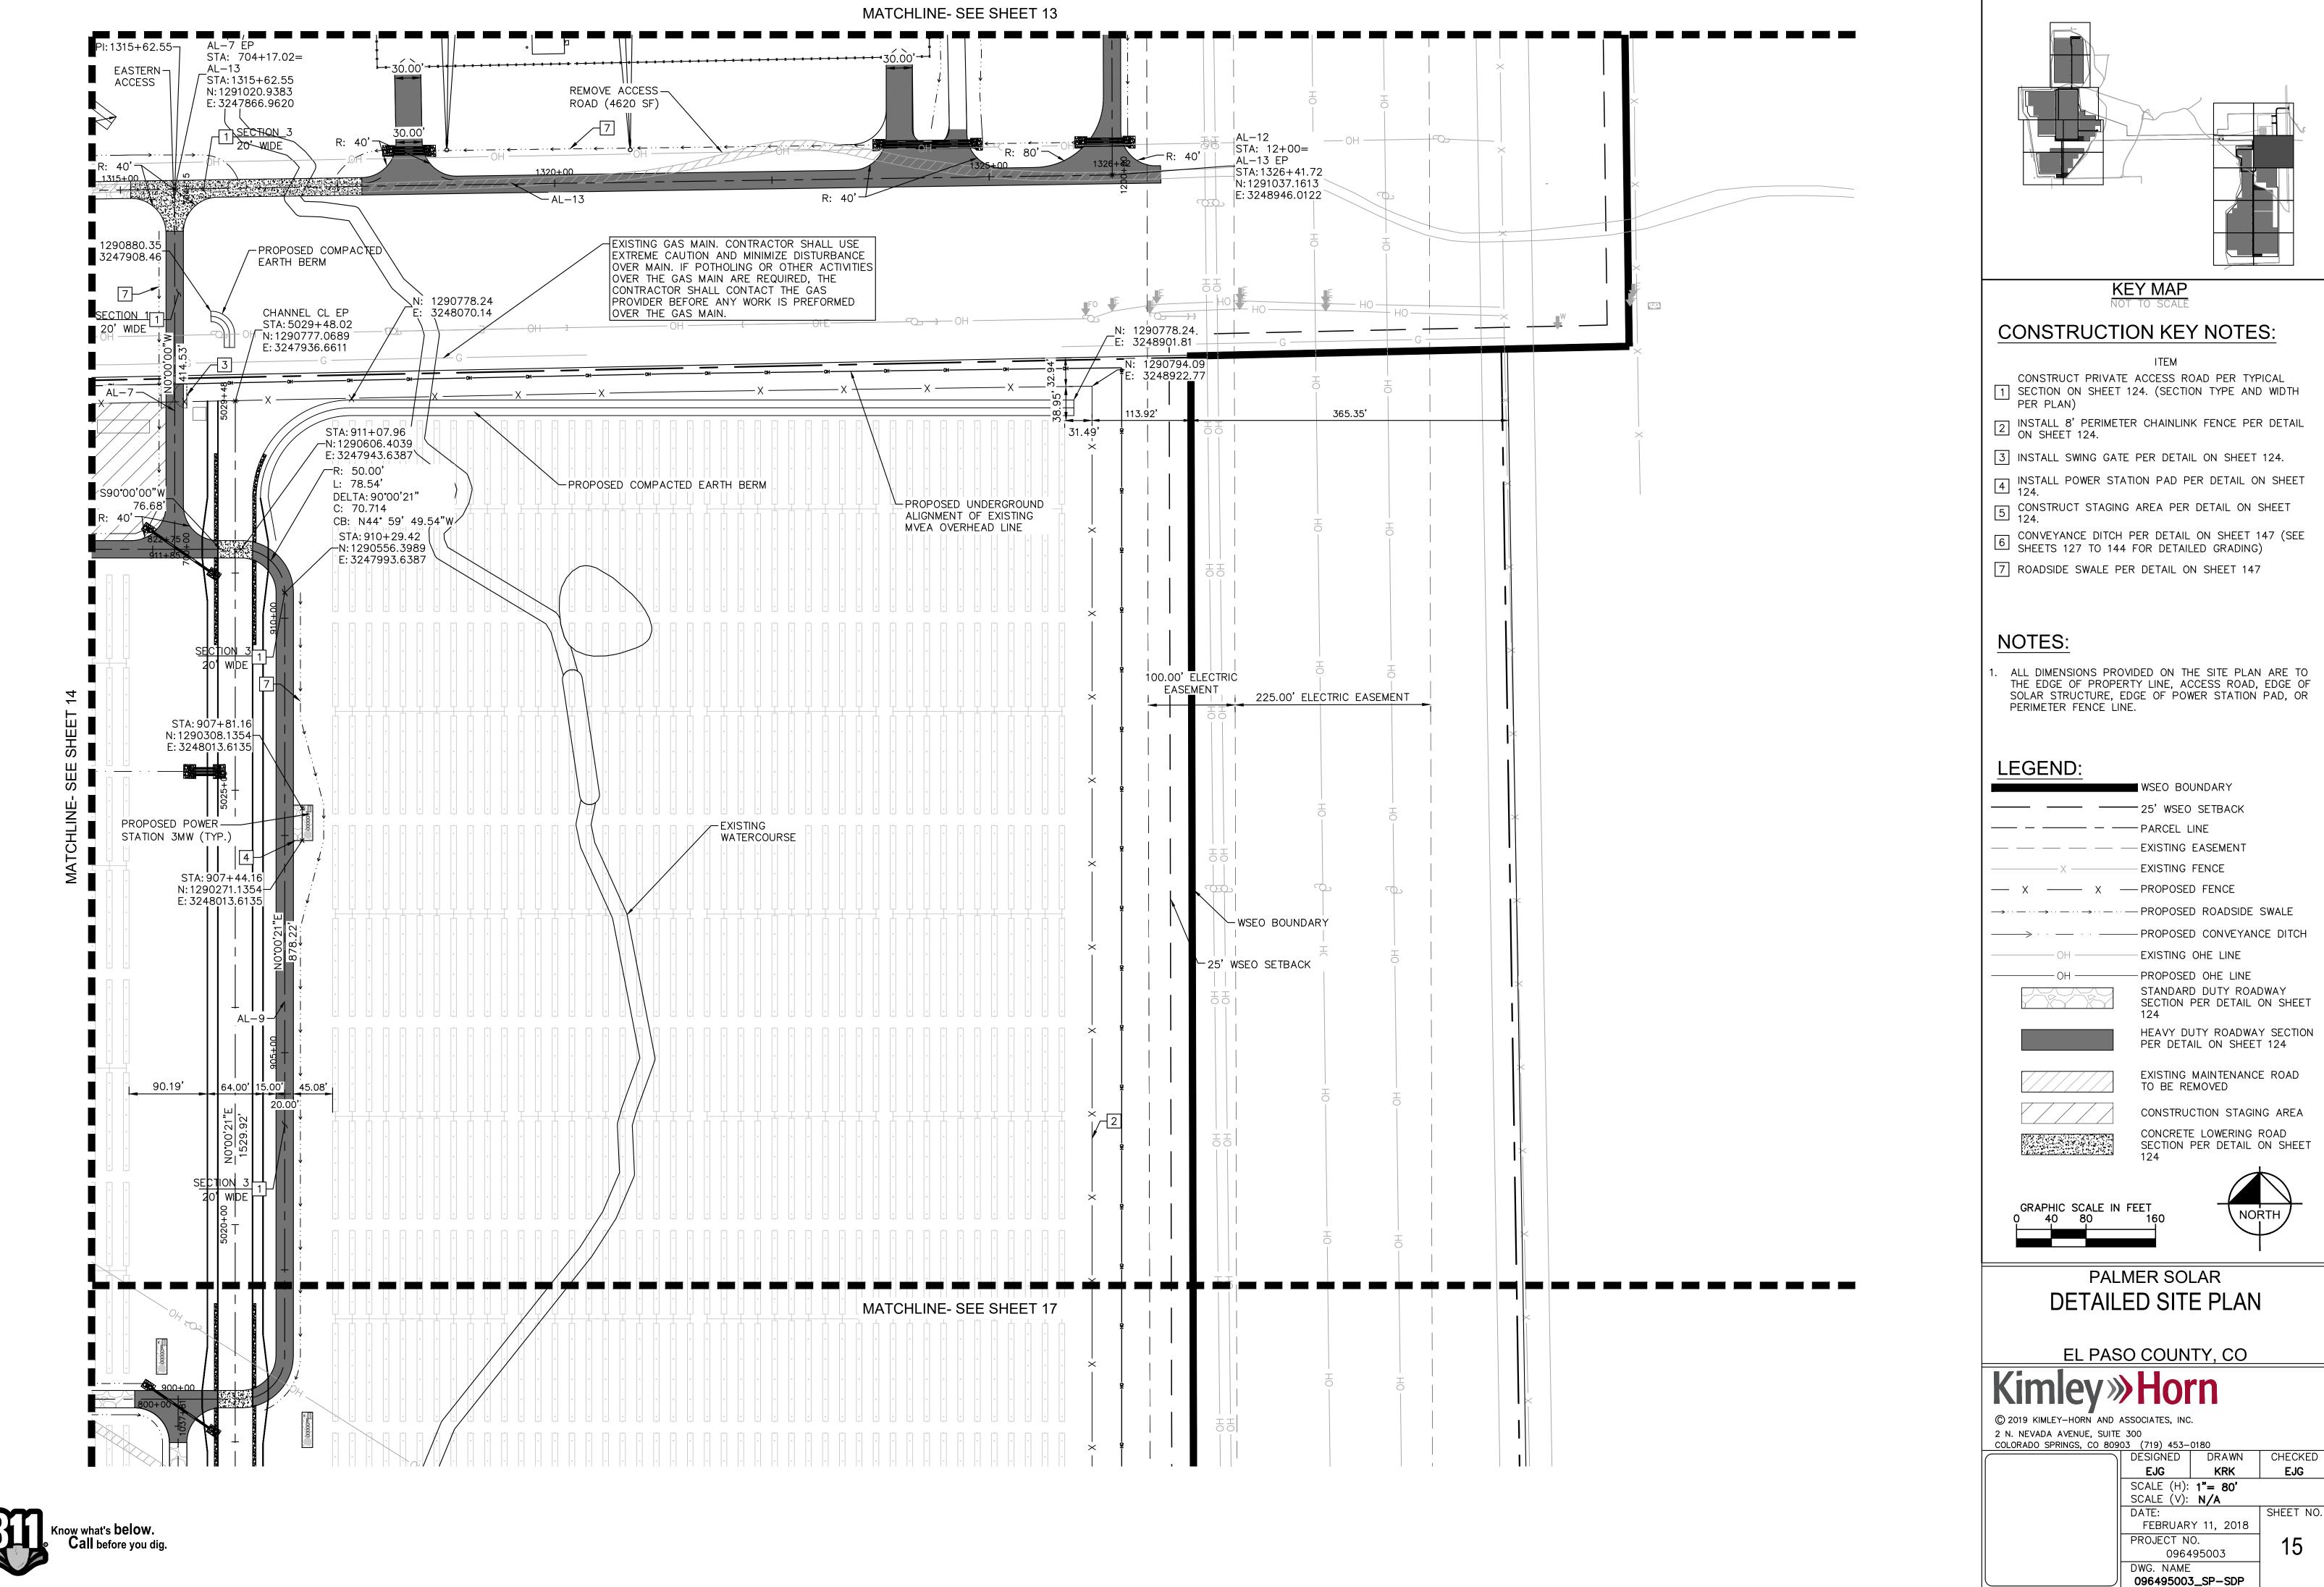

495003_Palmer Solar\CADD\Sheets\096495003_SP—SDP.dwg Feb 11, 2019 kevin.kofford 0.3 of x096495003ut x096495003vf x096495003tb_cd—gec co404_wseo_overlay_boundary_180712 HER WITH THE CONCEPTS AND DESIGNS PRESENTED HEREIN, AS AN INSTRUMENT OF SERVICE, IS INTENDED ONLY FOR THE SPECIFIANCE ON THIS DOCUMENT WITHOUT WRITTEN AUTHORIZATION AND ADAPTATION BY KIMLEY—HORN AND ASSOCIATES, INC. SHALL BE

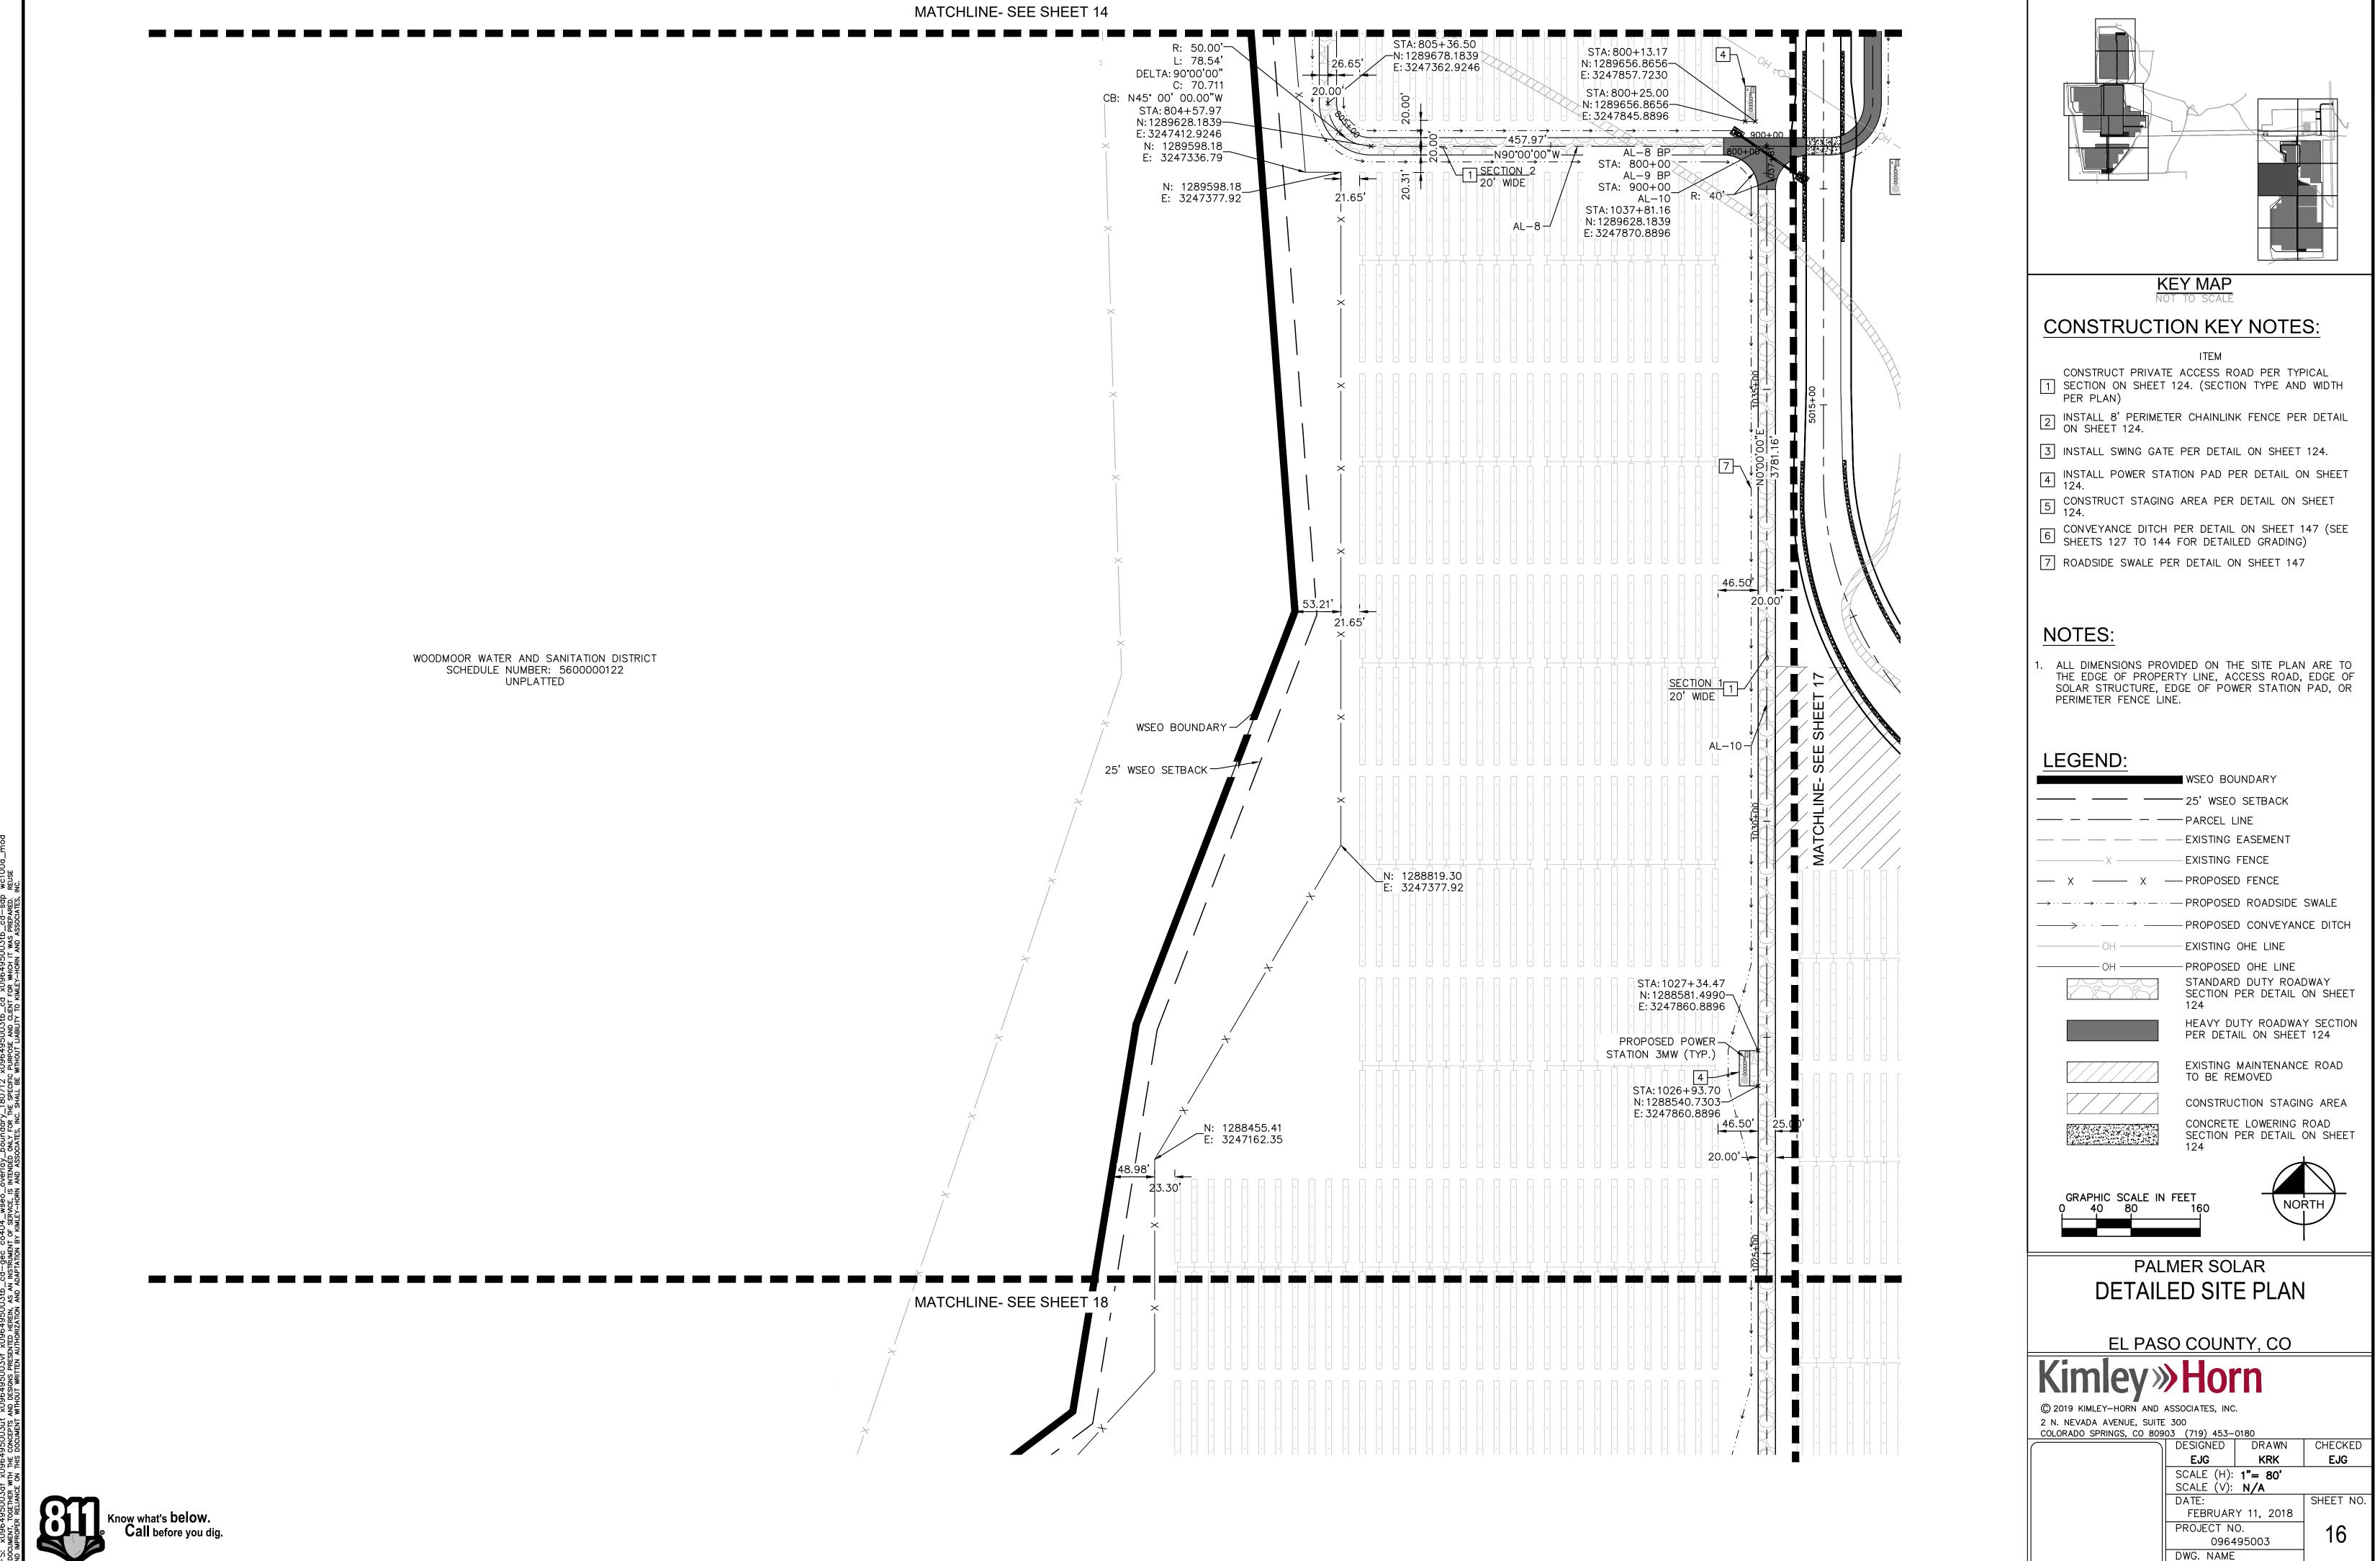


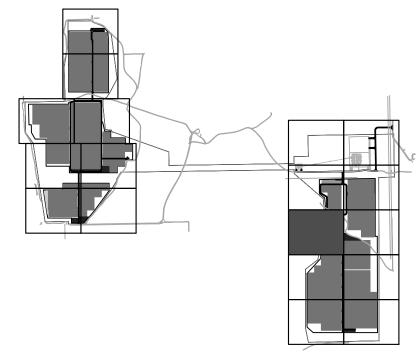



THE EDGE OF PROPERTY LINE, ACCESS ROAD, EDGE OF SOLAR STRUCTURE, EDGE OF POWER STATION PAD, OR


SHEET NO.


096495003_SP-SDP

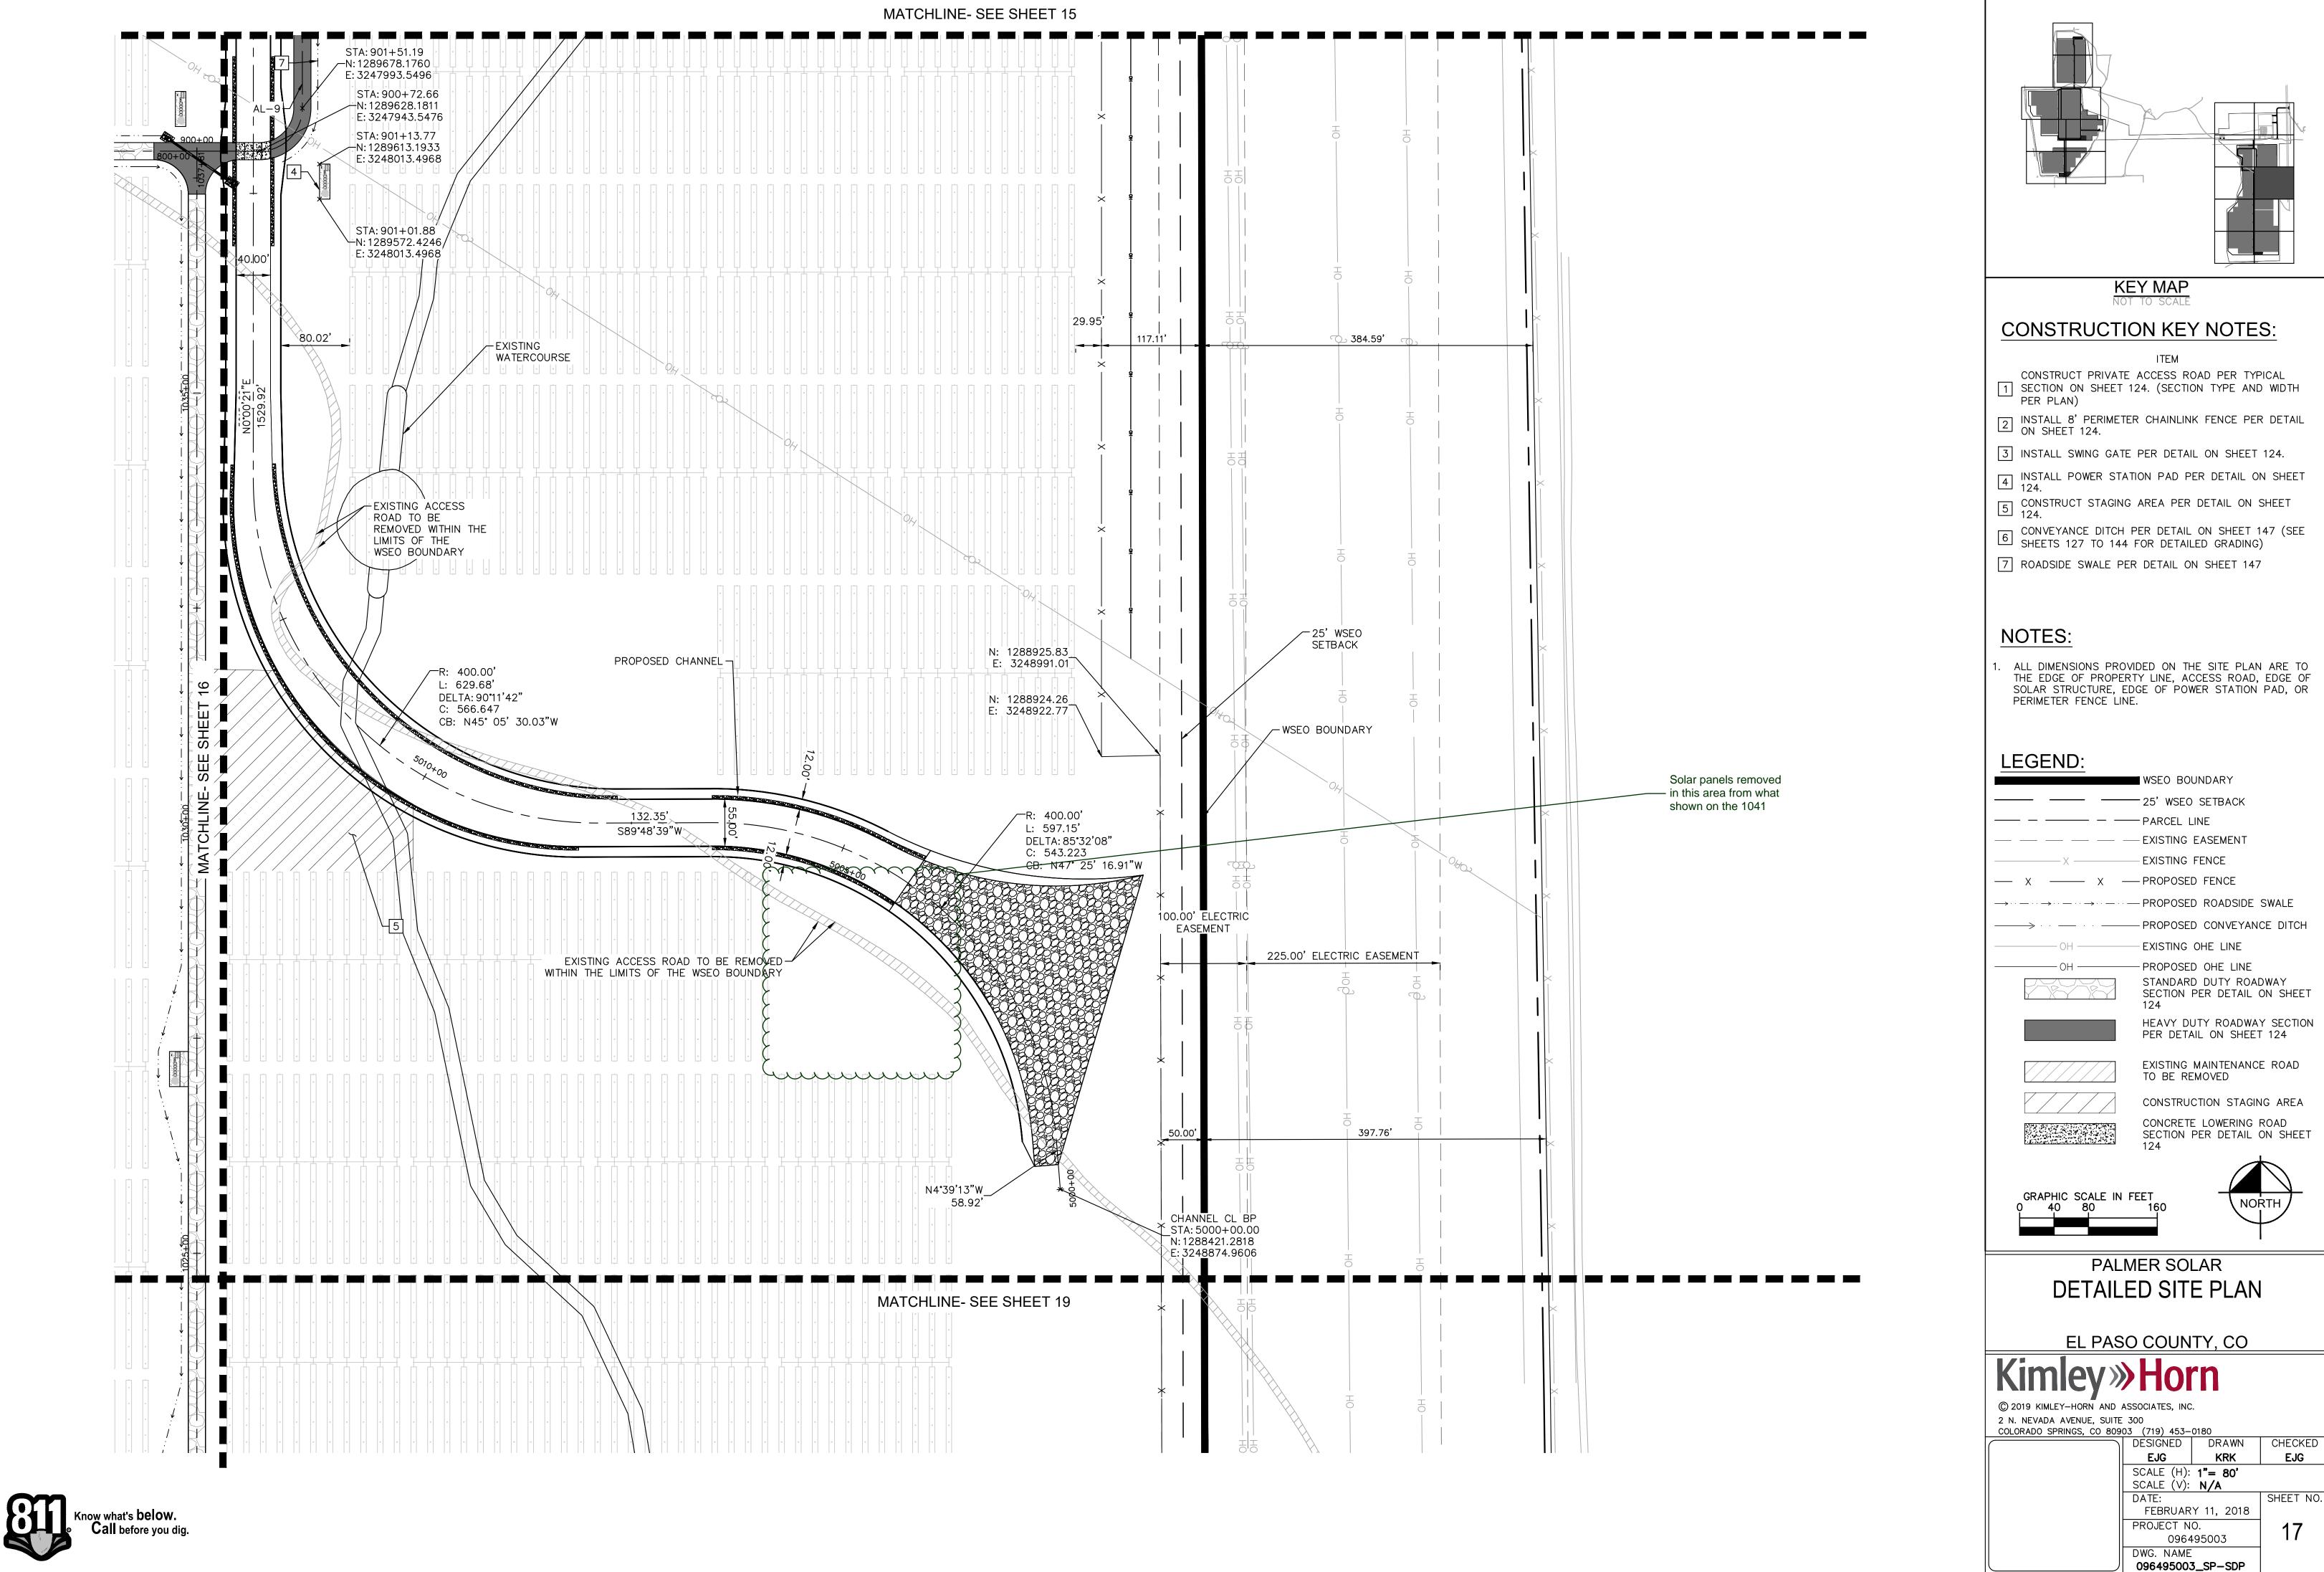


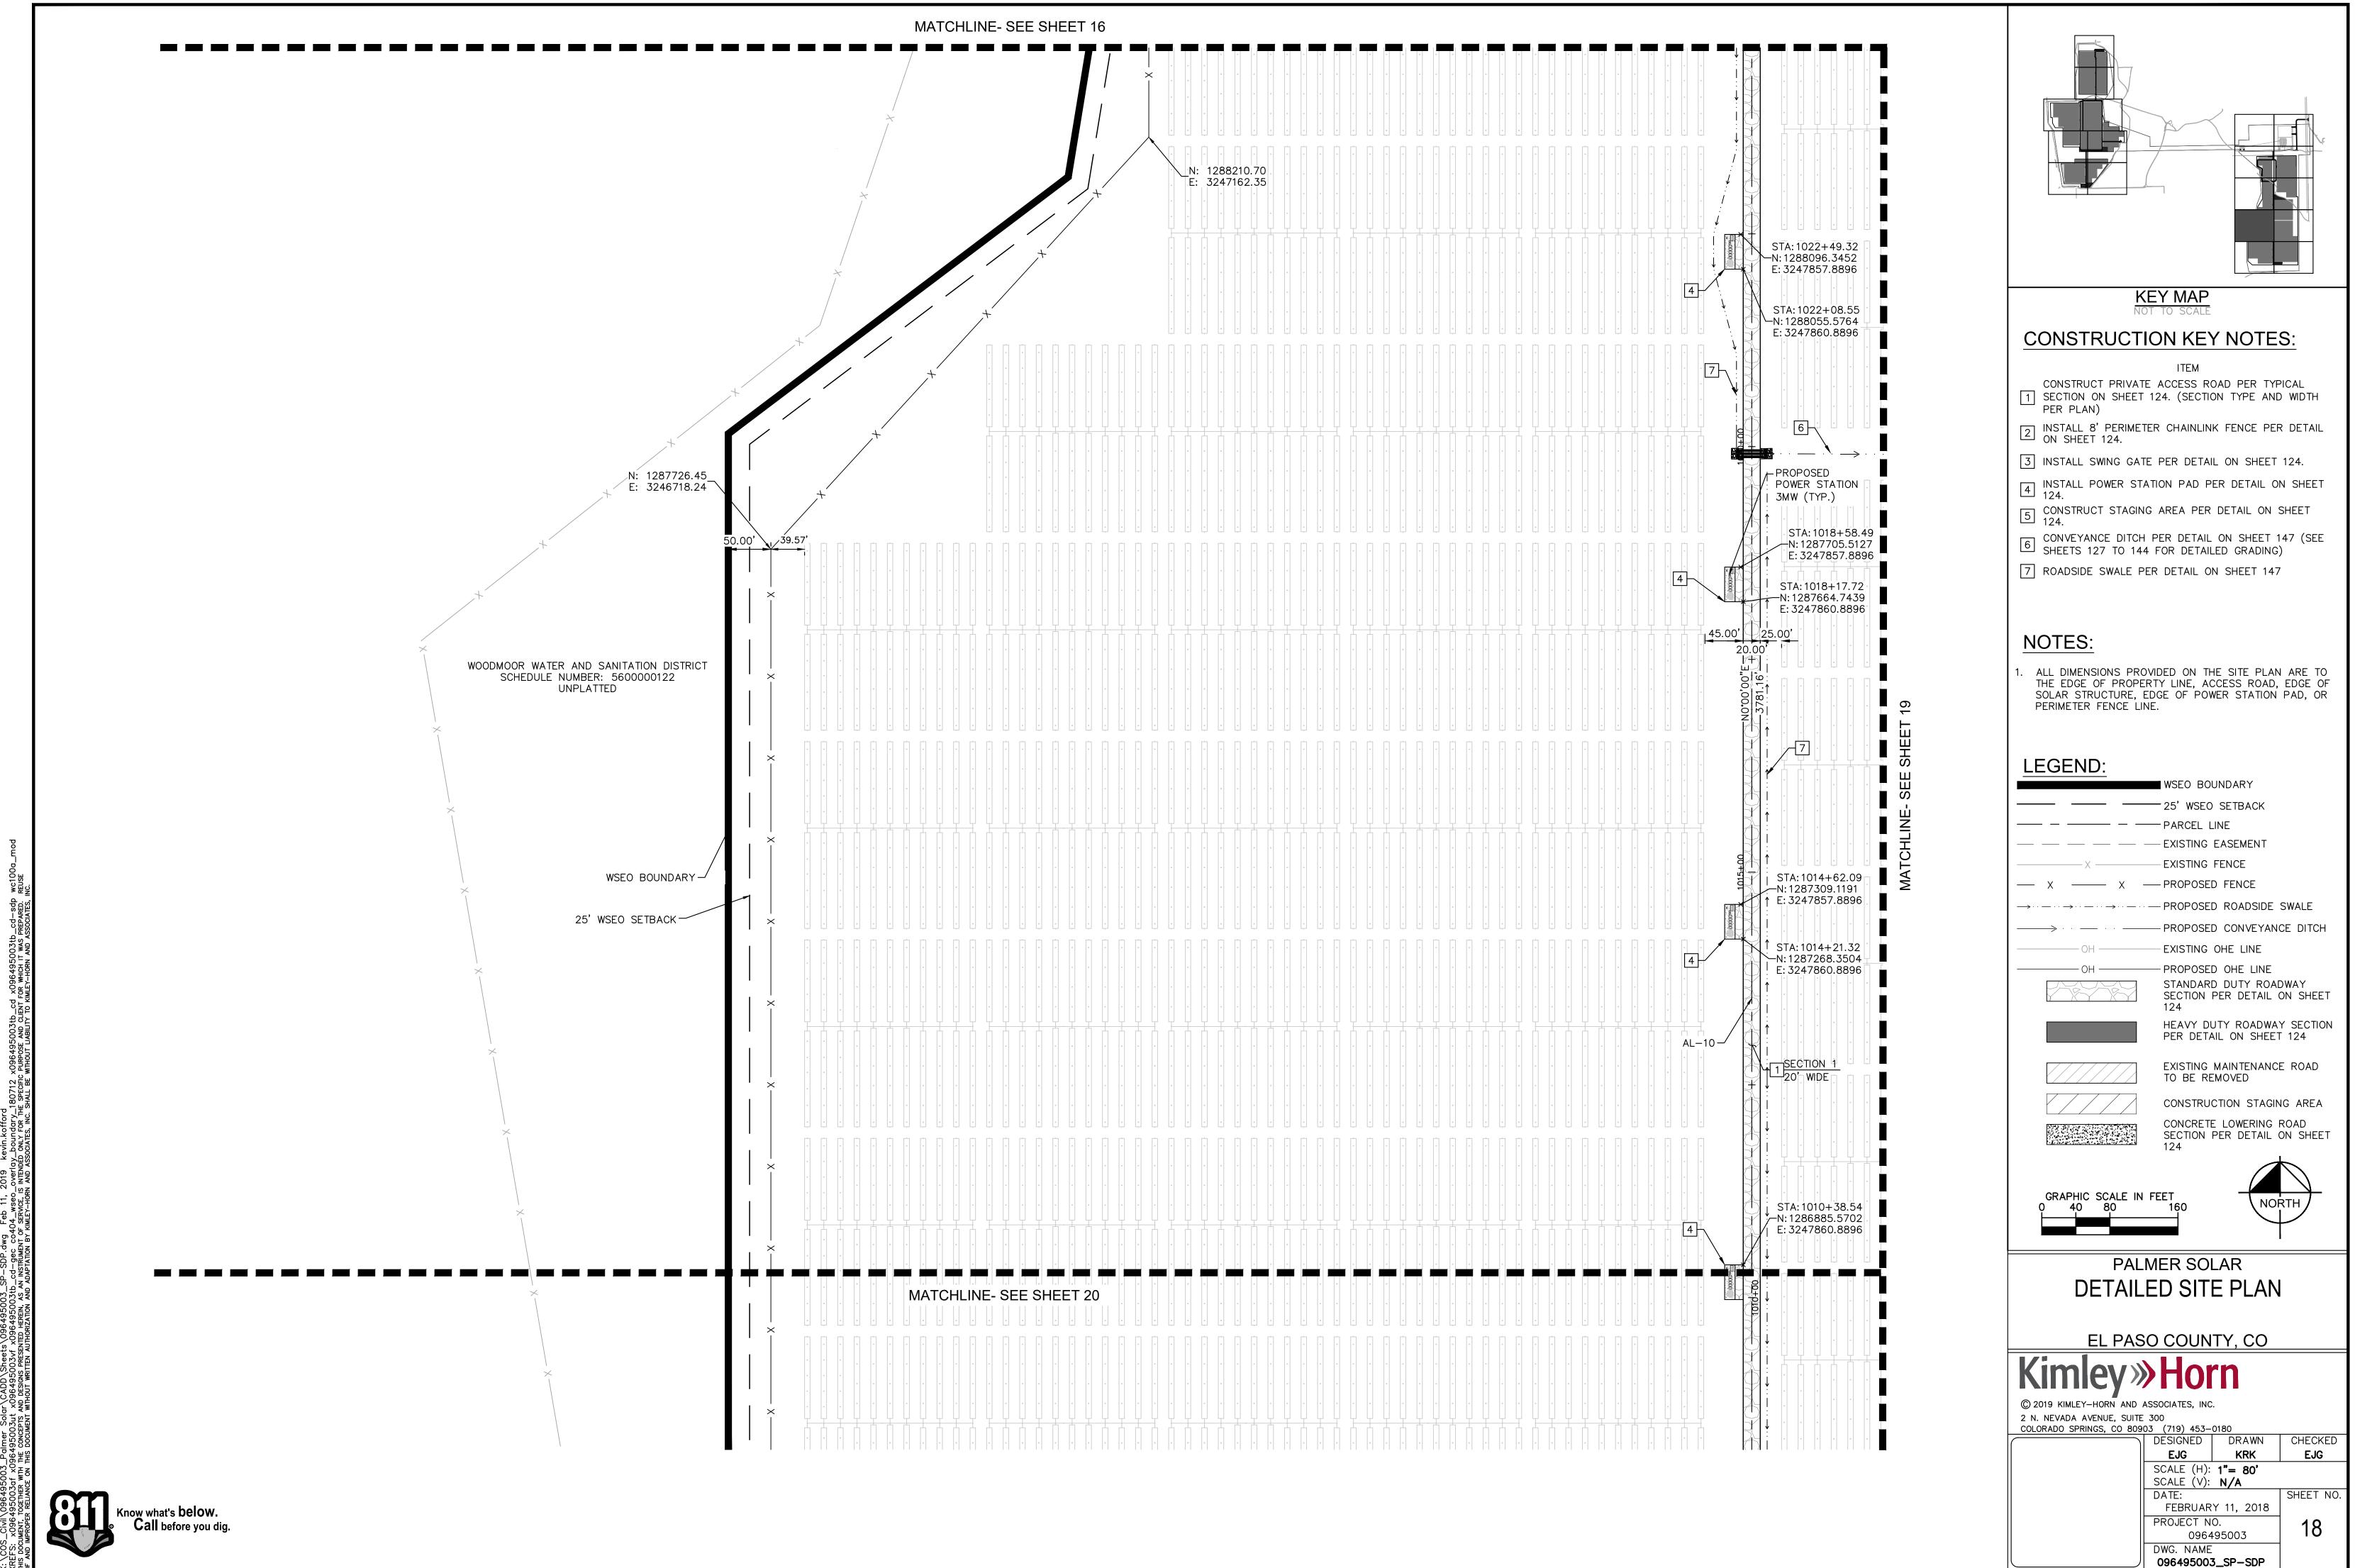


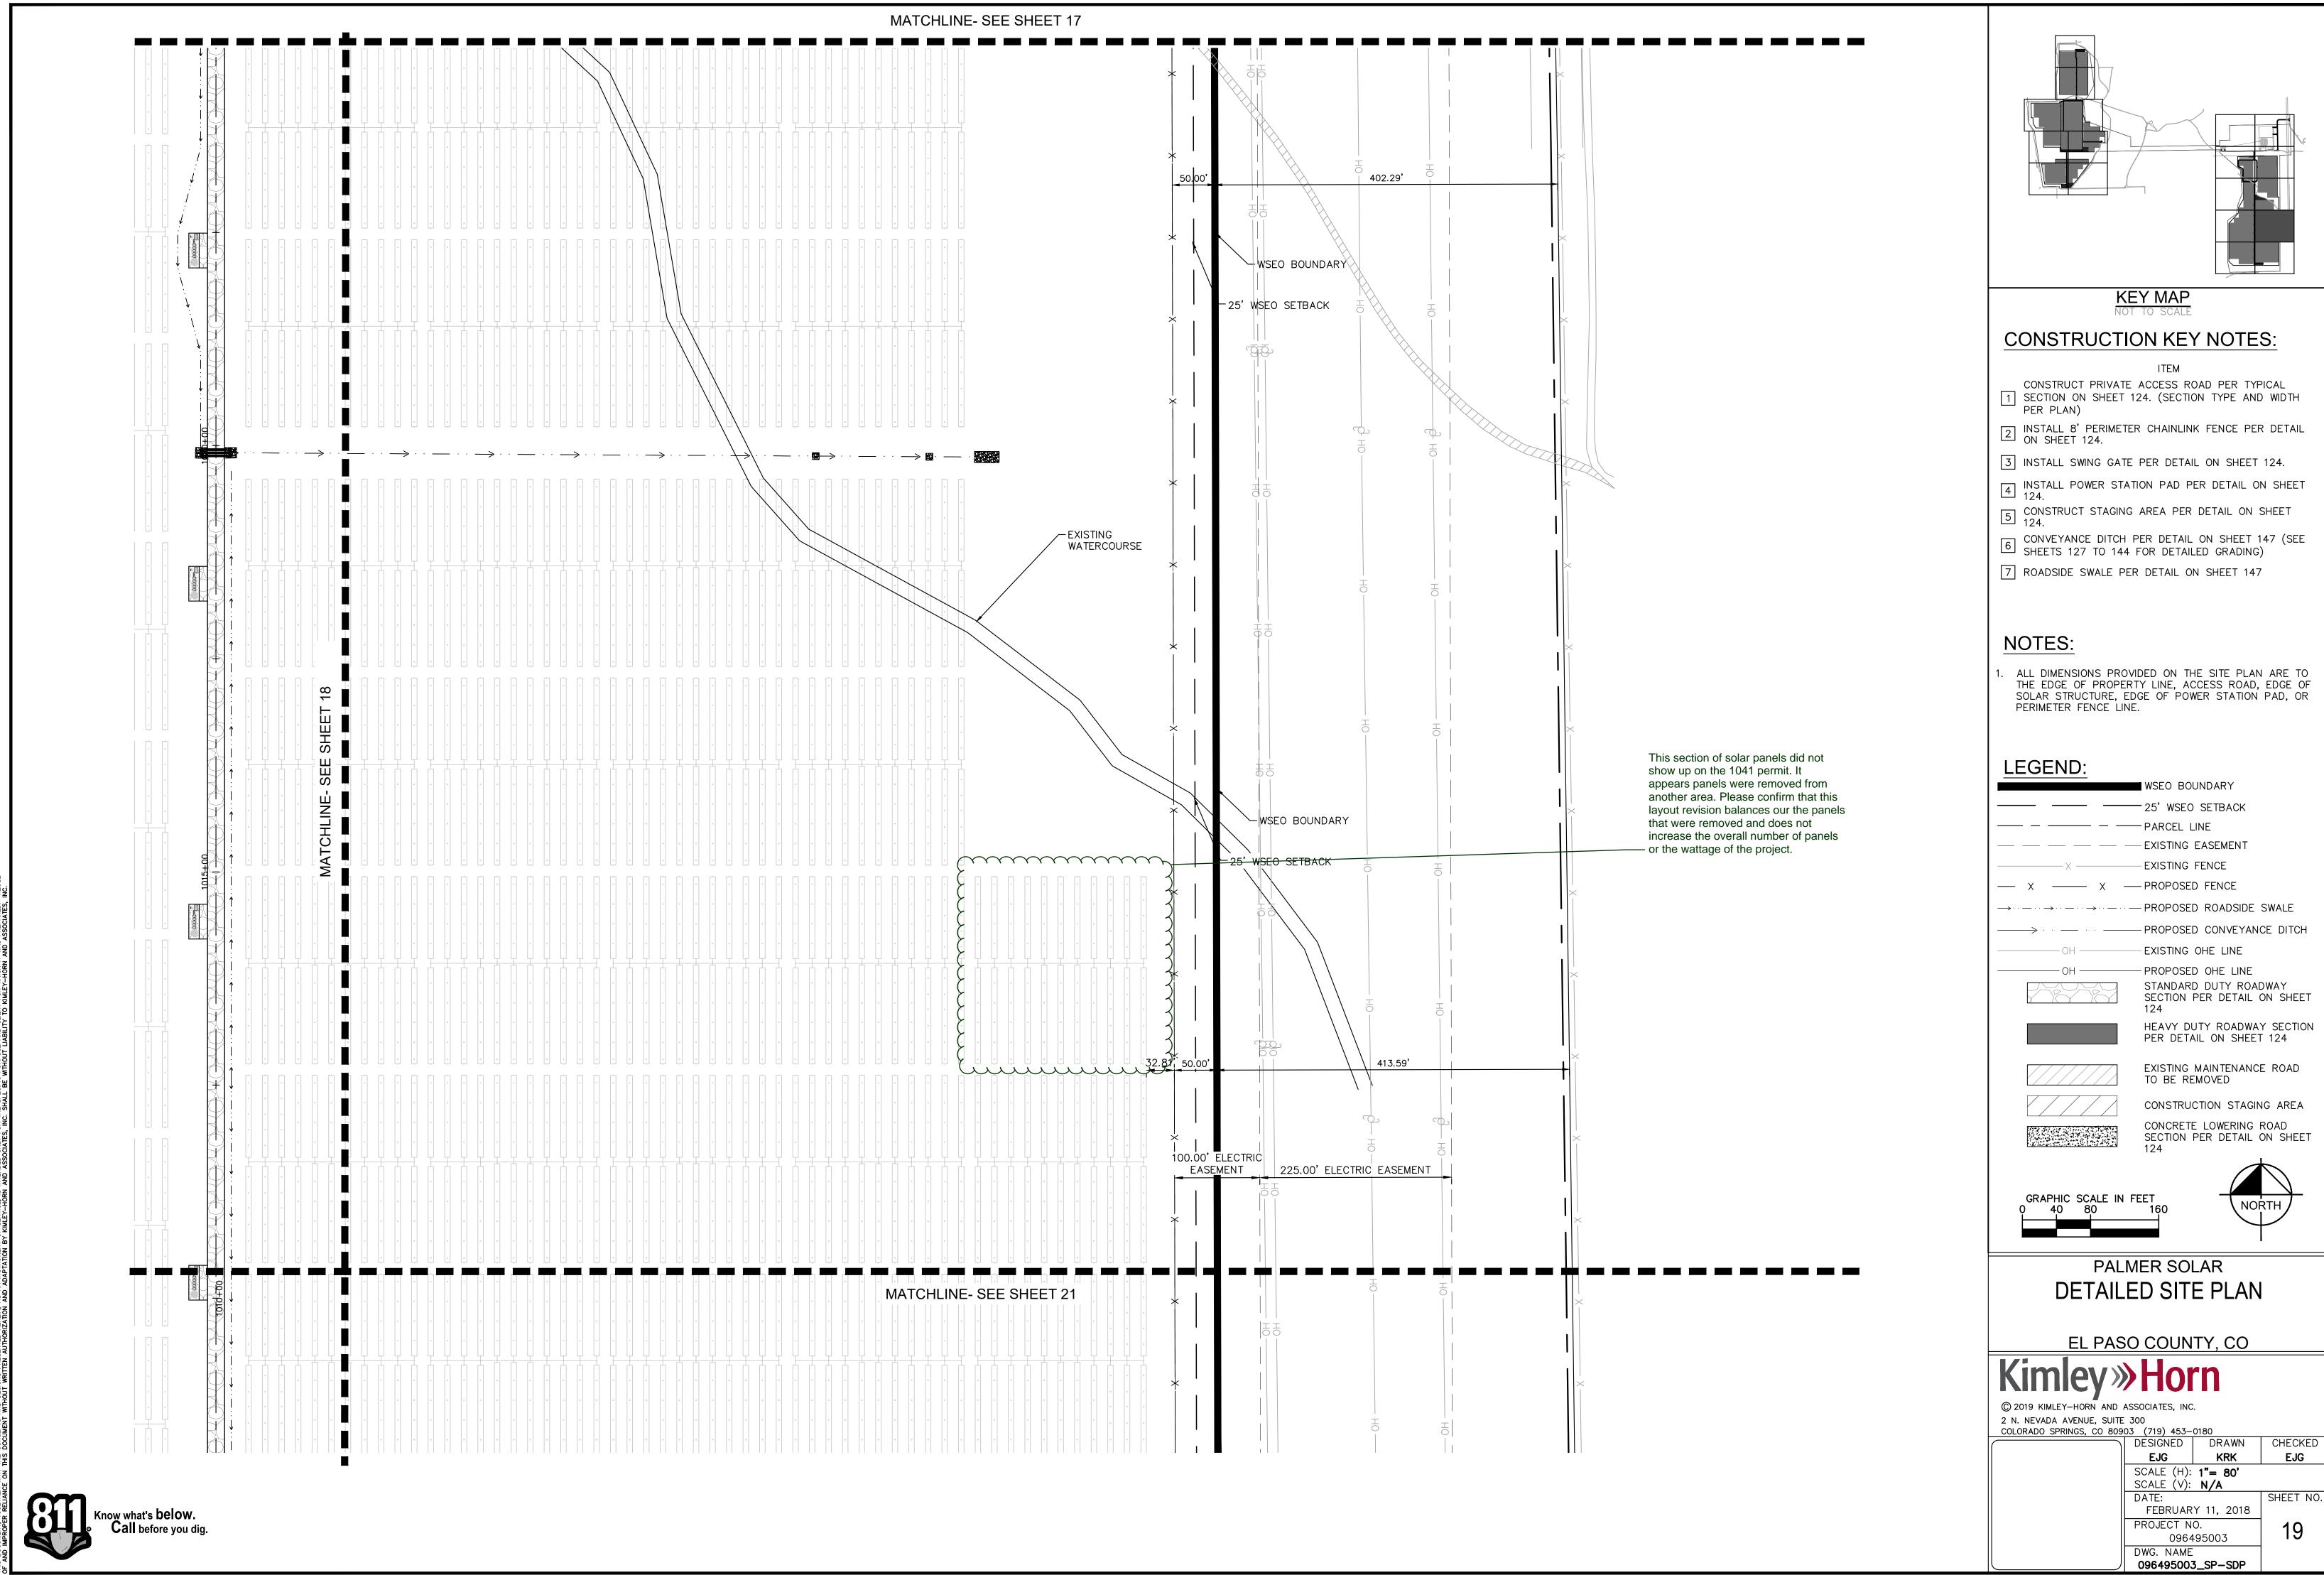

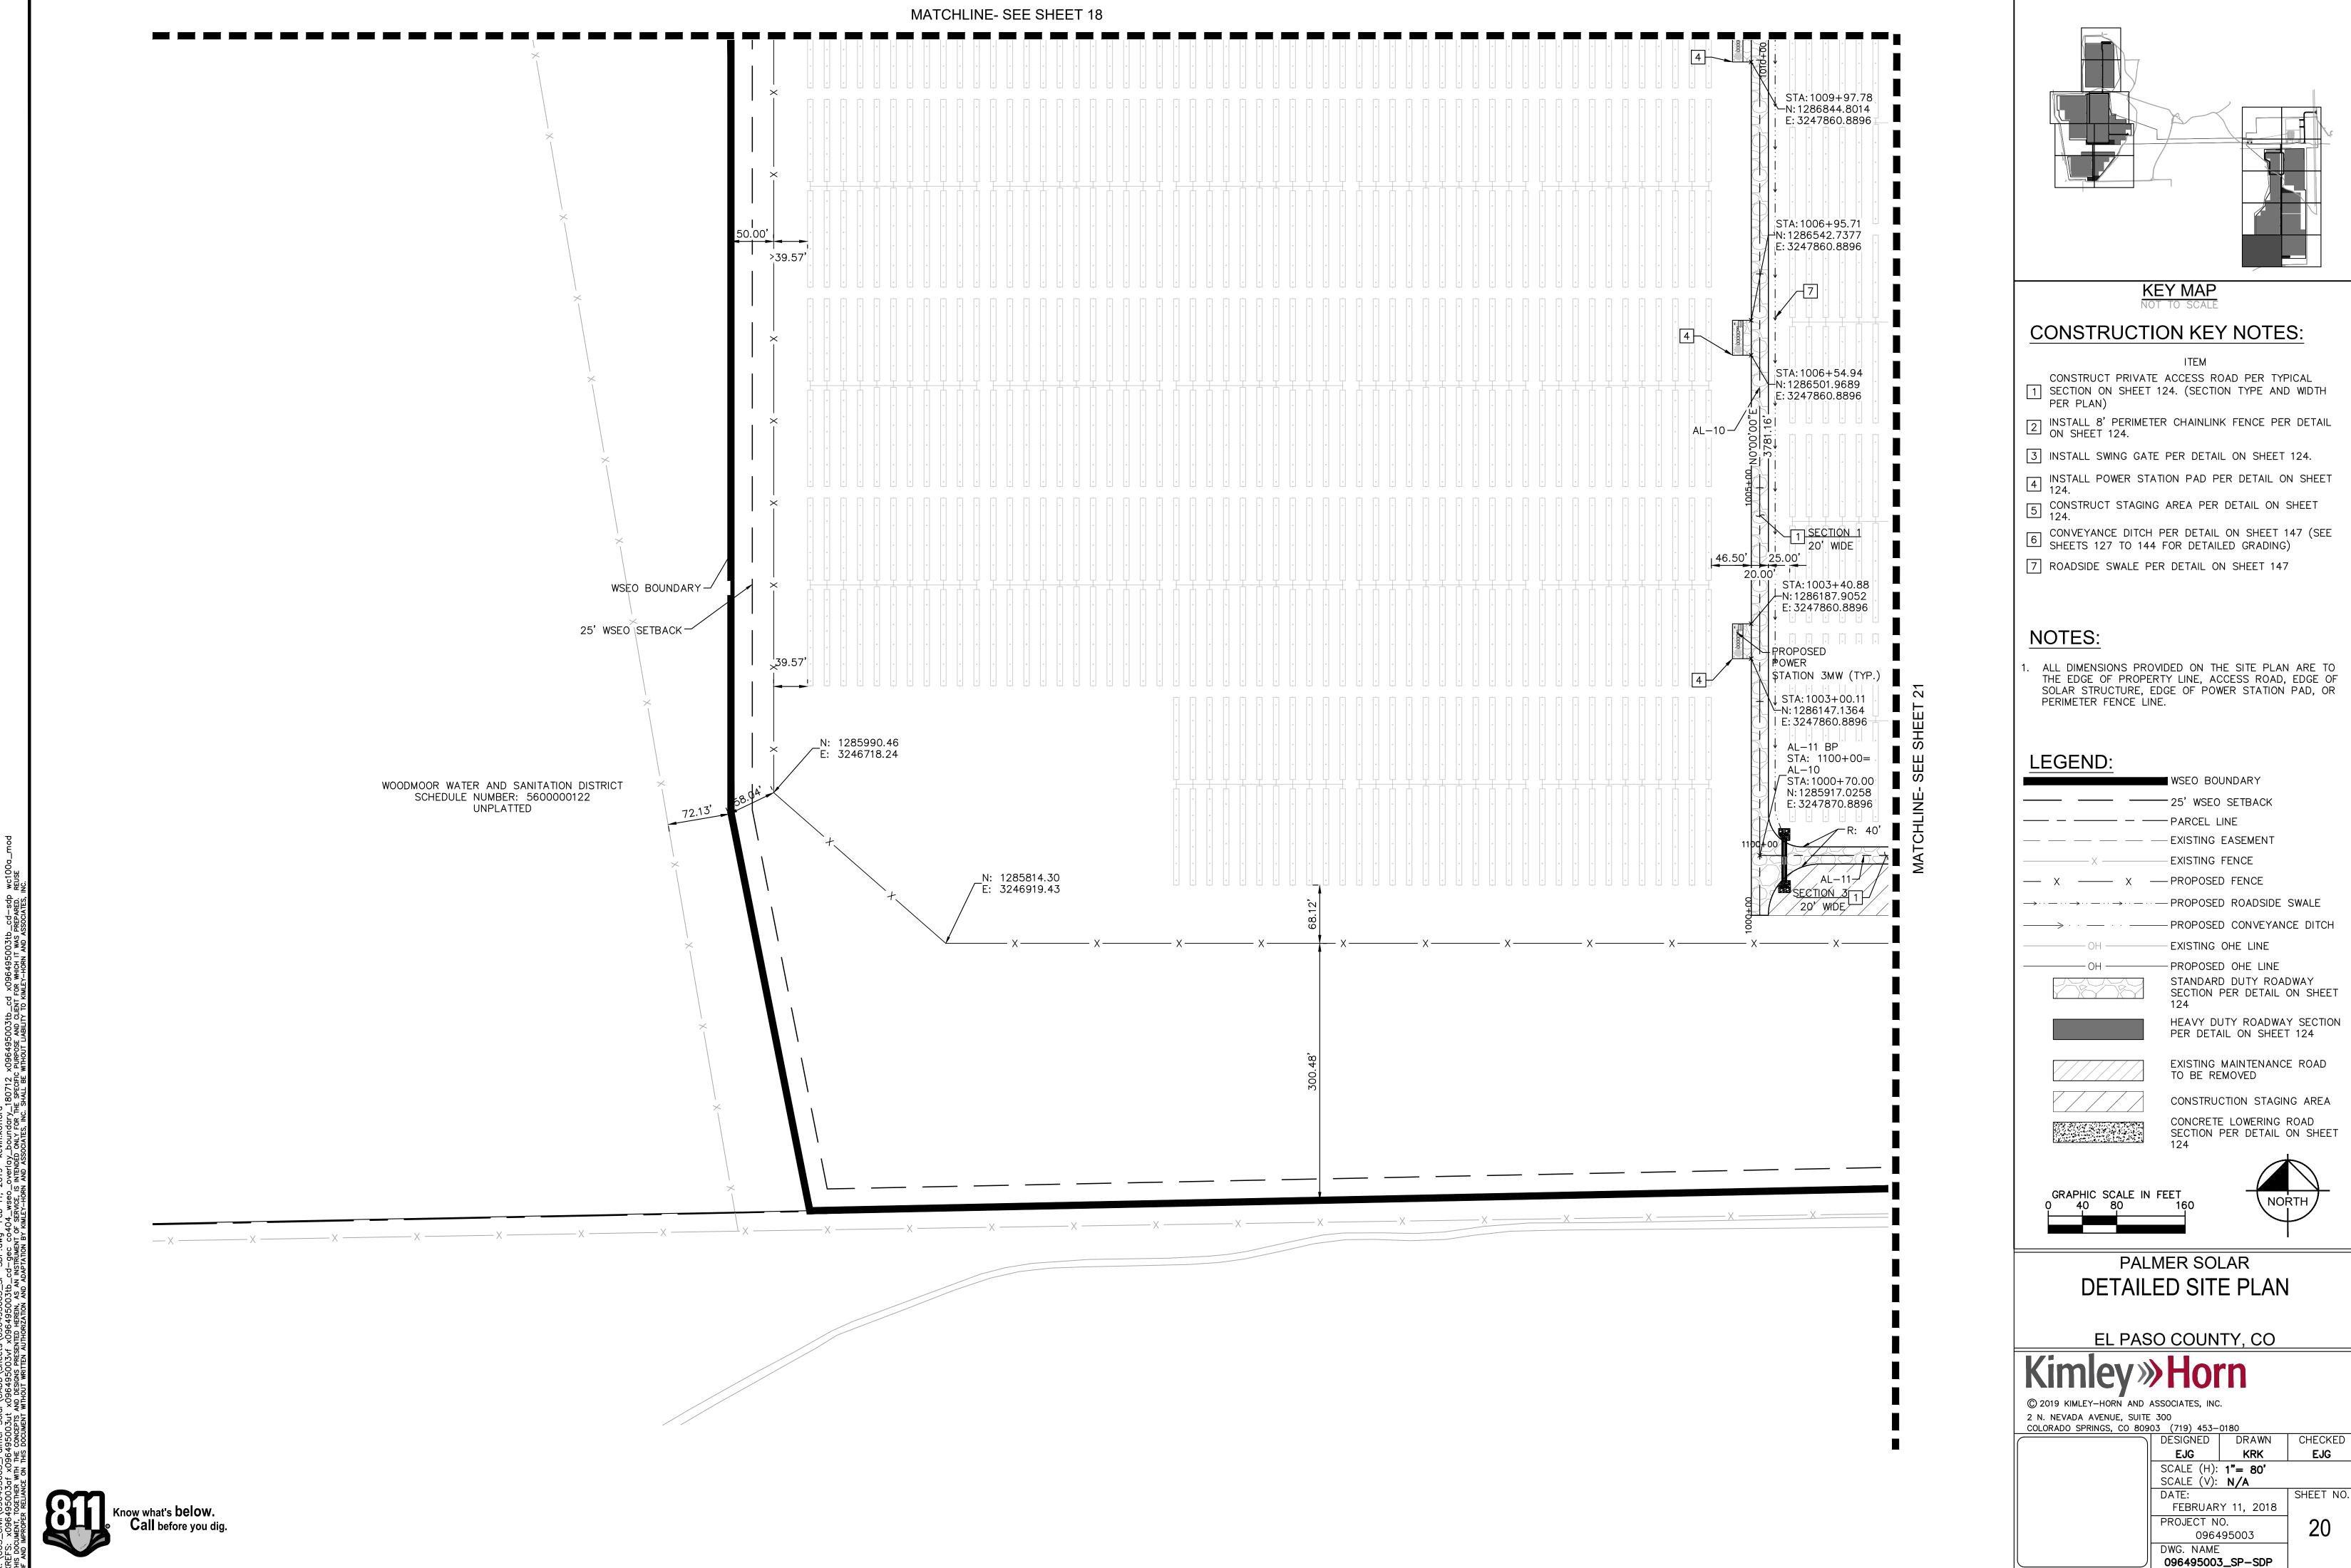

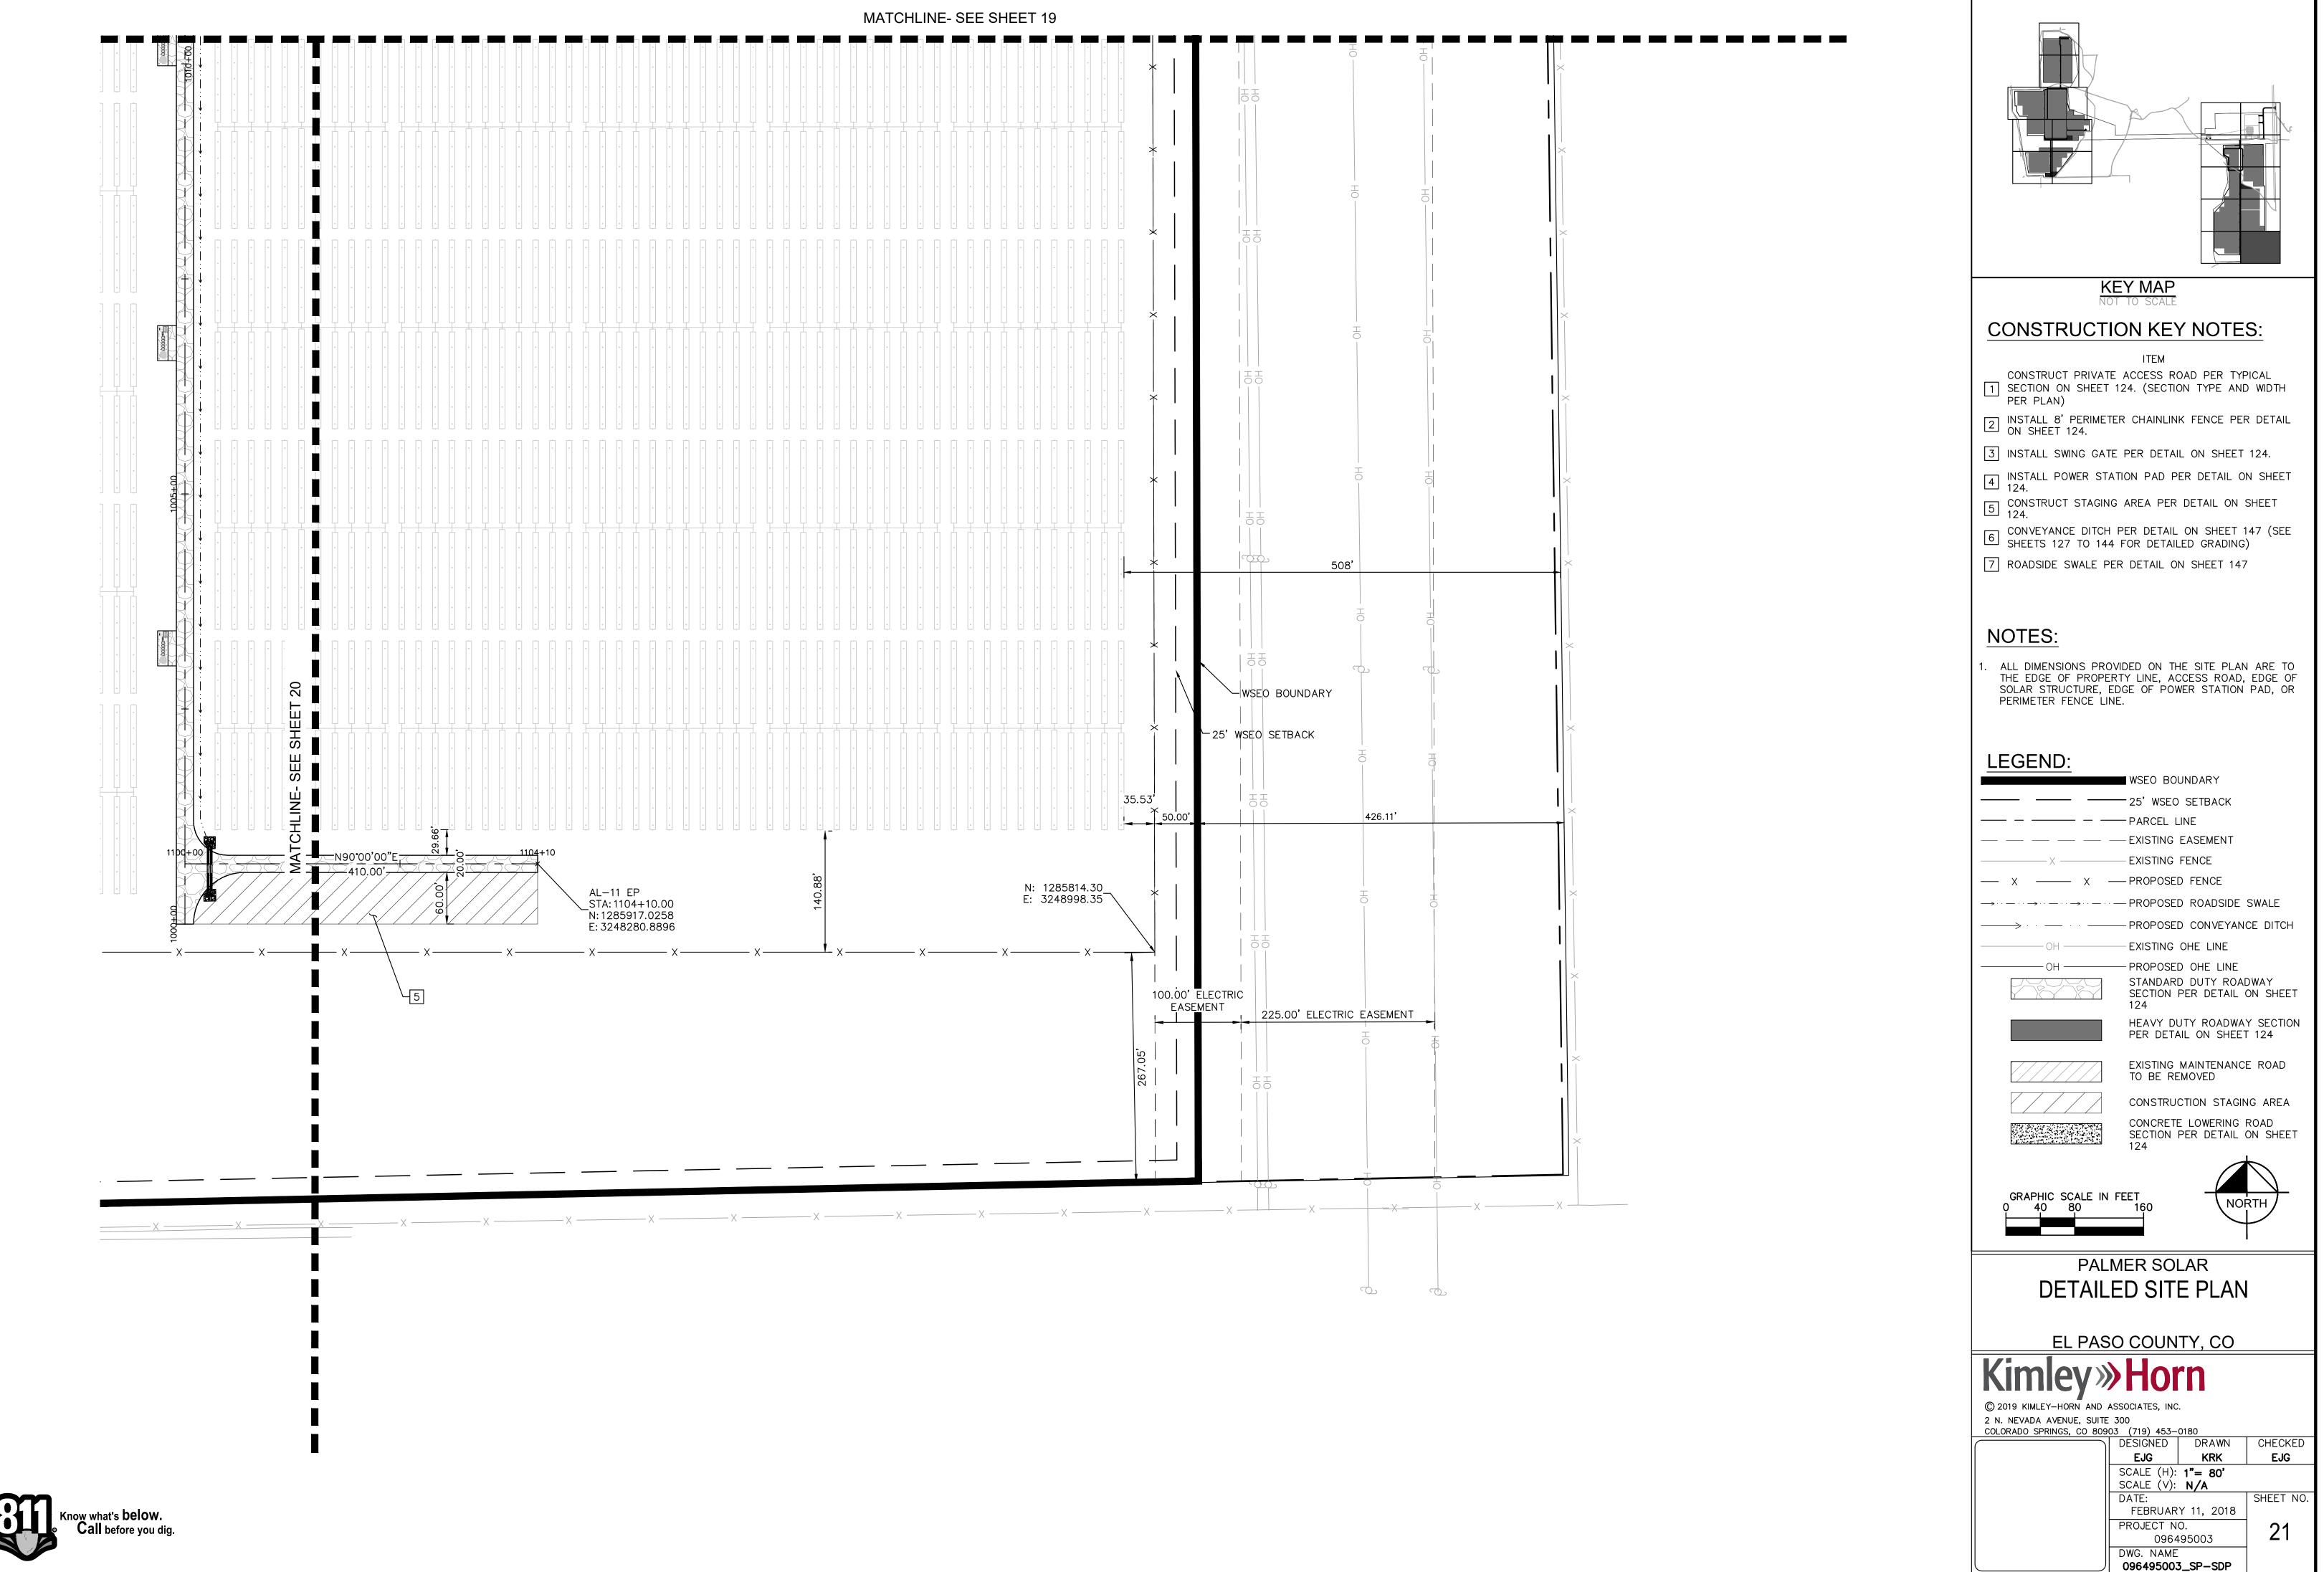

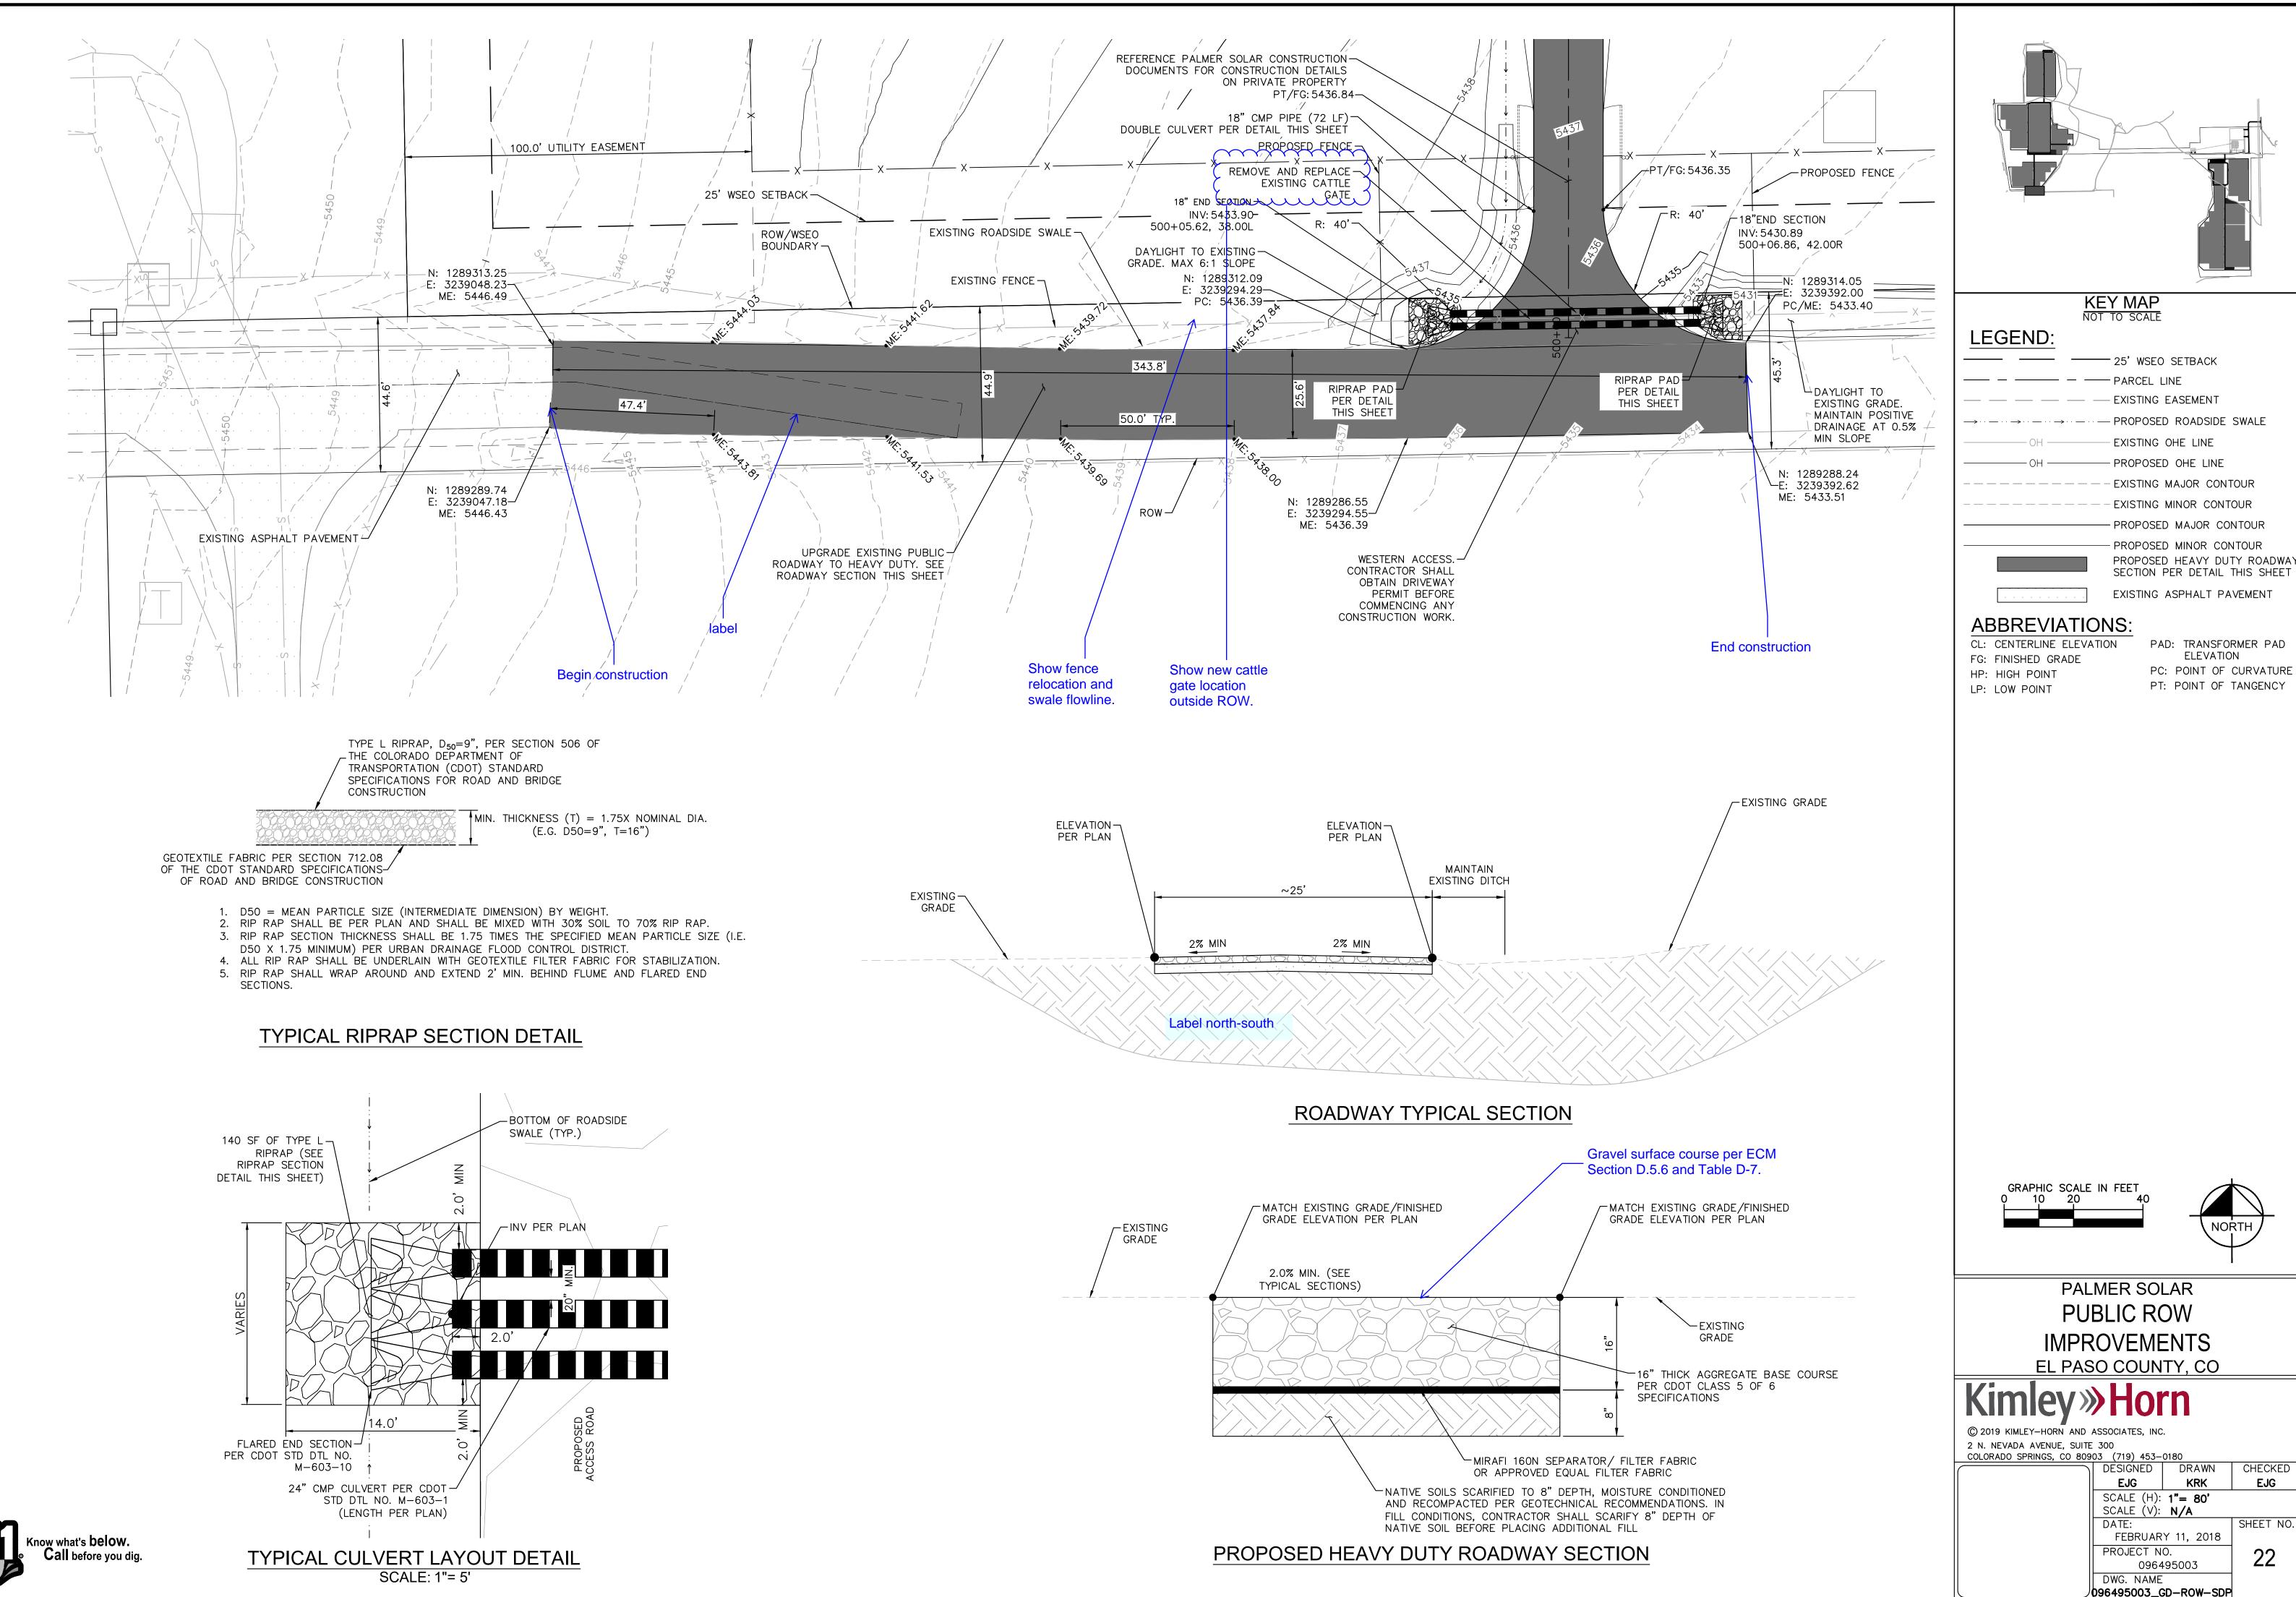

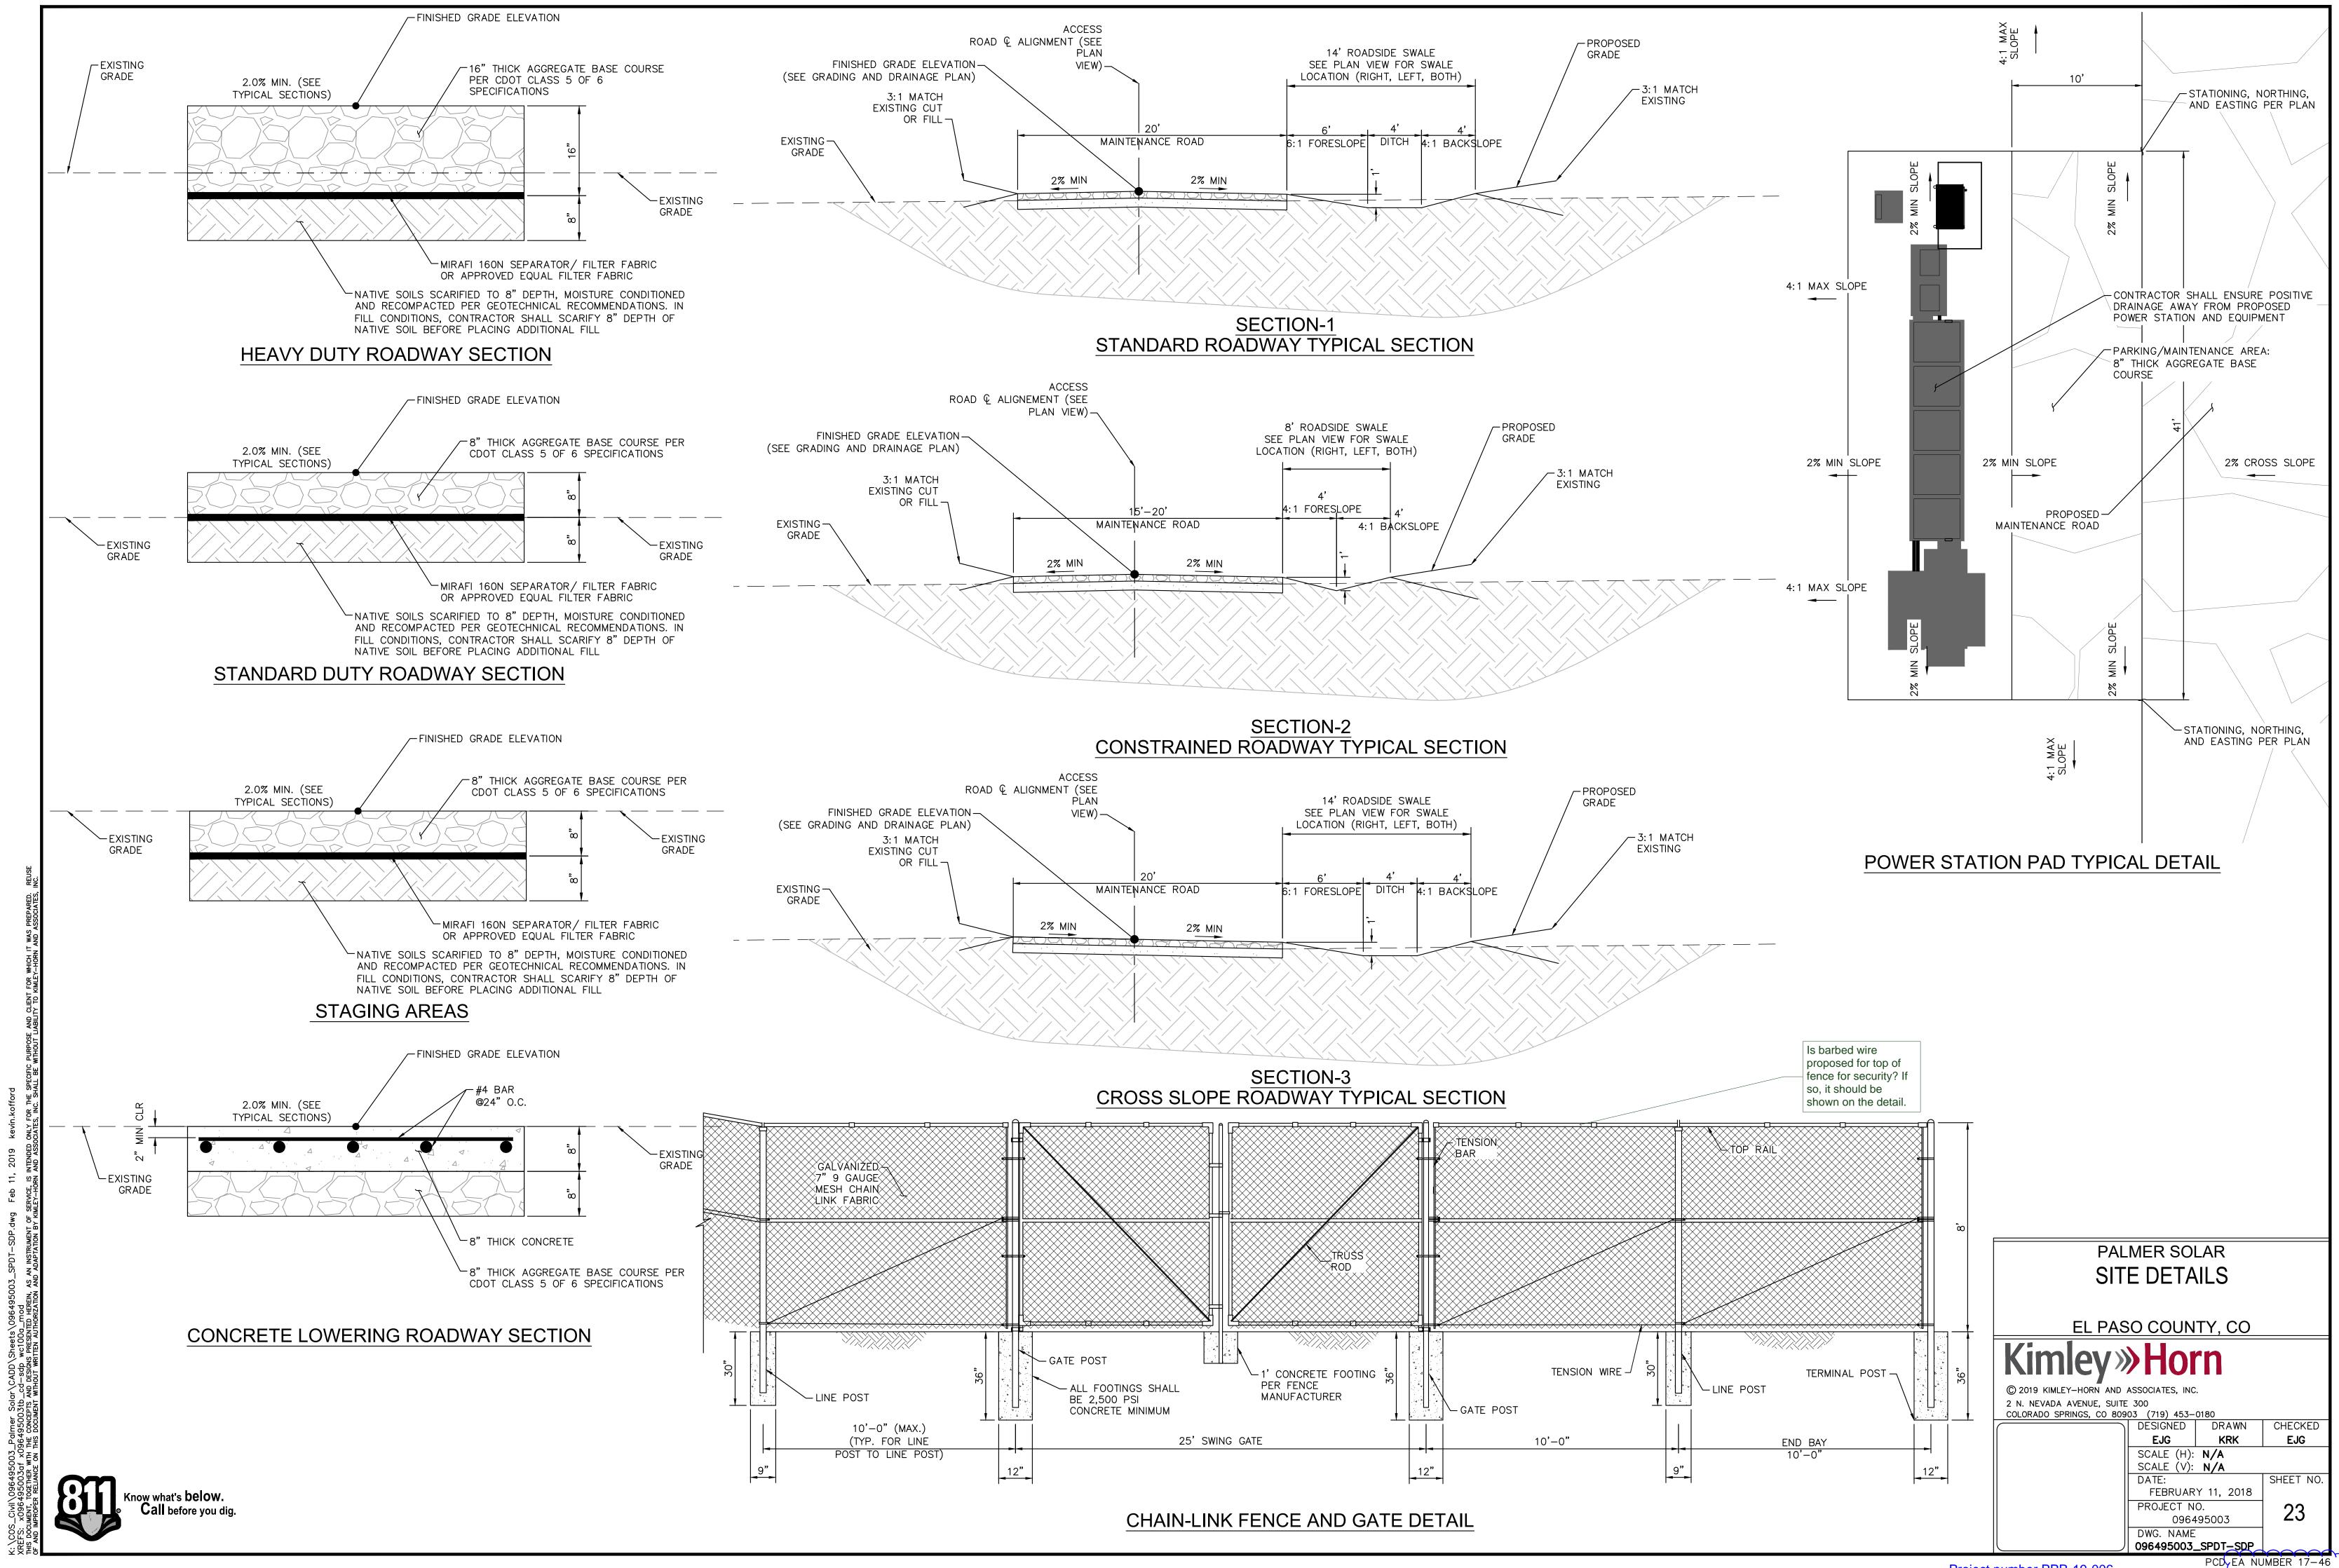

Markup Summary

Arrow (4)

Subject: Arrow

Page Label: [19] 19 DETAILED SITE PLAN

Author: Lindsay Darden Date: 3/4/2019 4:22:41 PM

Color:



Subject: Arrow

Page Label: [19] 19 DETAILED SITE PLAN

Author: Lindsay Darden Date: 3/4/2019 4:22:52 PM

Color:



Subject: Arrow

Page Label: [19] 19 DETAILED SITE PLAN

Author: Lindsay Darden Date: 3/4/2019 4:22:58 PM

Color: ■



Subject: Arrow

Page Label: [19] 19 DETAILED SITE PLAN

Author: Lindsay Darden Date: 3/4/2019 4:23:05 PM

Color:

Callout (11)



Subject: Callout

Page Label: [2] 2 SITE LAYOUT WEST

Author: Lindsay Darden Date: 2/28/2019 3:11:43 PM

Color:

This easement is called out on the 1041 as variable width.

TO PEN EUM STANDANUS.

Subject: Callout

Page Label: [1] 1 COVER SHEET

Author: dsdrice

Date: 3/1/2019 3:47:12 PM

Color:



Subject: Callout

Page Label: [7] 7 DETAILED SITE PLAN

Author: dsdrice

Date: 3/1/2019 3:49:59 PM

Color:

Make sure these match the GEC Plan



Subject: Callout

Page Label: [23] 23 SITE DETAILS


Author: dsdrice

Date: 3/1/2019 4:03:13 PM

Color:

label

DPW

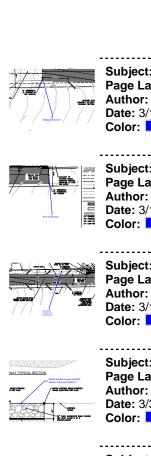

Subject: Callout Begin construction Page Label: [23] 23 SITE DETAILS Author: dsdrice Date: 3/1/2019 4:04:27 PM Color: Subject: Callout End construction Page Label: [23] 23 SITE DETAILS Author: dsdrice Date: 3/1/2019 4:05:02 PM Color: Subject: Callout Show fence relocation and swale flowline. Page Label: [23] 23 SITE DETAILS Author: dsdrice Date: 3/1/2019 4:09:32 PM Color: Subject: Callout Gravel surface course per ECM Section D.5.6 and Page Label: [23] 23 SITE DETAILS Table D-7. Author: dsdrice Date: 3/3/2019 5:36:26 PM Color: Subject: Callout Is this in the correct location? Page Label: [13] 13 DETAILED SITE PLAN Author: dsdrice Date: 3/3/2019 8:36:30 PM Color: Subject: Callout Are these sheds as well? Page Label: [19] 19 DETAILED SITE PLAN Author: Lindsay Darden Date: 3/4/2019 4:22:46 PM Color: Subject: Callout Is barbed wire proposed for top of fence for Page Label: [23] 23 SITE DETAILS security? If so, it should be shown on the detail. Author: Lindsay Darden Date: 3/6/2019 7:16:45 AM



Color:





Subject: Cloud+

Page Label: [1] 1 COVER SHEET

Author: dsdrice

Date: 3/1/2019 3:46:19 PM

Color:

Subject: Cloud+

Page Label: [1] 1 COVER SHEET

Author: dsdrice

Date: 3/1/2019 3:47:55 PM

Color:

PCD

PCD



Subject: Cloud+

Page Label: [12] 12 DETAILED SITE PLAN

Author: dsdrice

Date: 3/1/2019 3:59:02 PM

Color:



Subject: Cloud+

Page Label: [23] 23 SITE DETAILS

Author: dsdrice

Date: 3/1/2019 4:02:00 PM

Color:



Subject: Cloud+

Page Label: [23] 23 SITE DETAILS

Author: dsdrice

Date: 3/1/2019 4:06:26 PM

Color:



Subject: Cloud+

Page Label: [15] 15 DETAILED SITE PLAN

Author: Lindsay Darden Date: 3/5/2019 10:54:20 AM

Color:

Substation appears larger than depicted on the 1041 drawing. Please detail revisions so we can verify the proposed scope was authorized in the

Show new cattle gate location outside ROW.

1041 permit.

<--- Over here?

Project number PPR-19-006



Subject: Cloud+

Page Label: [22] 22 PUBLIC ROW IMPROVEMENTS

Author: Lindsay Darden Date: 3/5/2019 7:25:16 AM

Color:

Solar panels removed in this area from what

shown on the 1041



Subject: Cloud+

Page Label: [23] 23 SITE DETAILS

Author: Lindsay Darden Date: 3/5/2019 7:45:51 AM

Color:

This section of solar panels did not show up on the 1041 permit. It appears panels were removed from another area. Please confirm that this layout revision balances our the panels that were

removed and does not increase the overall number _____

of panels or the wattage of the project.



Subject: Cloud+

Page Label: [11] 11 DETAILED SITE PLAN

Author: Lindsay Darden Date: 3/5/2019 8:36:12 AM

Color:

is this label in incorrect location or is watercourse

layer turned off here?



Subject: Cloud+

Page Label: [14] 14 DETAILED SITE PLAN

Author: Lindsay Darden Date: 3/5/2019 8:47:23 AM

Color:

is this label incorrectly placed?

Highlight (1)



Subject: Highlight

Page Label: [12] 12 DETAILED SITE PLAN

Author: dsdrice

Date: 3/1/2019 4:00:43 PM

Color:

PCD File # (1)



Subject: PCD File #

Page Label: [1] 1 COVER SHEET

Author: Lindsay Darden Date: 3/4/2019 2:57:58 PM

Color:

Add PCD File # PPR-19-006 to each sheet

Text Box (2)



Subject: Text Box

Page Label: [12] 12 DETAILED SITE PLAN

Author: dsdrice

Date: 3/1/2019 3:59:20 PM **Color:**

https://property.spatialest.com/co/elpaso/#/propert

y/5600000120

See comment letter.

Label north-south

Subject: Text Box

Page Label: [23] 23 SITE DETAILS

Author: dsdrice

Date: 3/1/2019 4:10:32 PM

Color:

Label north-south