

Correct Name and add RS-6000 so these 3 Rezoning Maps can be distinguished when in packets

PRAIRIERIDGE FILING NO. 1


A PORTION OF THE SOUTHWEST QUARTER OF SECTION 28 AND THE NORTHWEST QUARTER OF SECTION 33, TOWNSHIP 12 SOUTH, RANGE 65 WEST OF THE SIXTH PRINCIPAL MERIDIAN, EL PASO COUNTY, STATE OF COLORADO

REZONE EXHIBIT

Month 2024
NOVEMBER 2023


- Existing land uses and zoning on the property and within five hundred (500) feet of the boundary Add
- Adjoining property ownership
- Existing private roads
- Existing structures
- Existing easements

Double check existing easements/roads

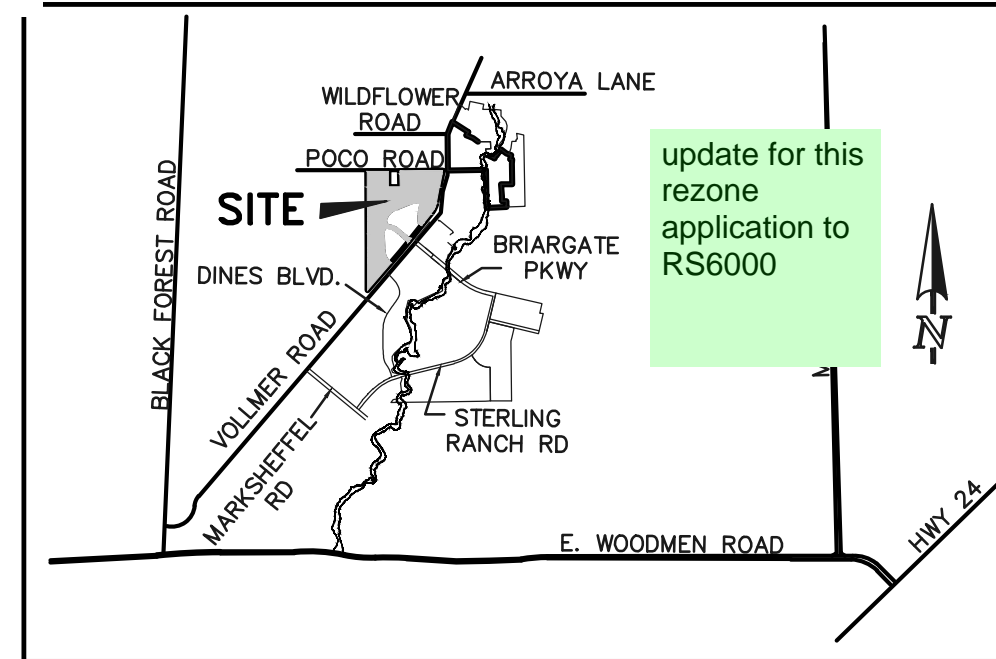

update for this rezone application to RS6000

please include this in RR0.5 so if road has to be shifted we dont have a sliver that needs to be rezoned to RR 0.5 in lieu if RS6000 as depicted which is not consistent with SKP

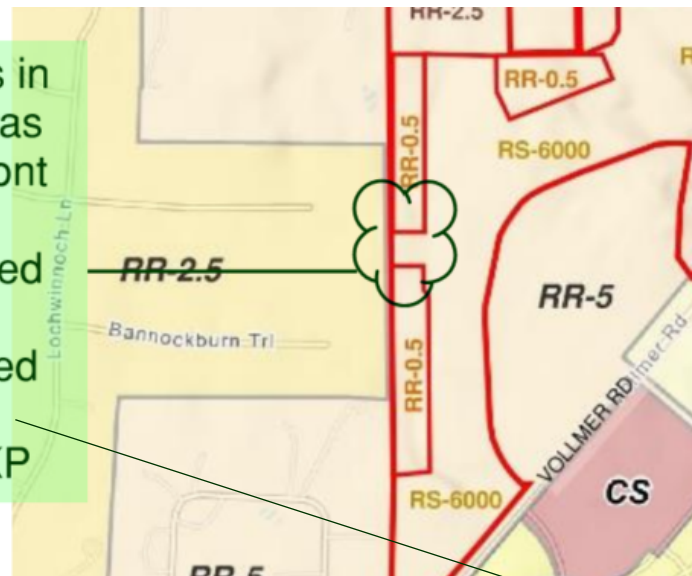

SITE DATA

TAX ID NUMBERS: PORTION OF 52280-00-024 & 52280-00-025

SKETCH PLAN: SKP 22-225 **SKP-22-005**

CURRENT ZONING: RR-5

PROPOSED ZONING: RS-6000

TOTAL AREA: 108.89 ACRES

REZONE AREA (RS-6000) 72.35 ACRES

Parcel A LEGAL DESCRIPTION

A PARCEL OF LAND BEING LOCATED IN A PORTION OF THE SOUTH HALF OF SECTION 28 AND THE NORTHWEST QUARTER OF SECTION 33, TOWNSHIP 12 SOUTH, RANGE 65 WEST OF THE SIXTH PRINCIPAL MERIDIAN, EL PASO COUNTY, COLORADO, BEING ALSO A PORTION OF LAND SURVEY PLAT RECORDED UNDER RECEPTION NO. 211900027, BEING MORE PARTICULARLY DESCRIBED AS FOLLOWS:

BASIS OF BEARINGS: THE SOUTH LINE OF THE SOUTHEAST QUARTER OF THE NORTHEAST QUARTER OF SECTION 28, TOWNSHIP 12 SOUTH, RANGE 65 WEST OF THE SIXTH PRINCIPAL MERIDIAN, BEING MONUMENTED AT THE WEST END WHICH IS THE SOUTHWEST CORNER OF THE SOUTHEAST QUARTER OF THE NORTHEAST QUARTER OF SAID SECTION 28, BY A 3-1/4" ALUMINUM SURVEYORS CAP STAMPED "ESI PLS 10376, 2006" AND AT THE EAST END, WHICH IS A 30" WITNESS CORNER TO THE EAST OF THE EAST QUARTER CORNER OF SAID SECTION 28, BY A 3-1/4" ALUMINUM SURVEYORS CAP STAMPED "ESI 10376, 2006", IS ASSUMED TO BEAR N89°08'28"E, A DISTANCE OF 1326.68 FEET.

COMMENCING AT THE CENTER-EAST 1/16 CORNER OF SAID SECTION 28, TOWNSHIP 12 SOUTH, RANGE 65 WEST OF THE SIXTH PRINCIPAL MERIDIAN, EL PASO COUNTY, COLORADO;

THENCE S83°37'56"W, A DISTANCE OF 62.10 FEET TO A POINT ON THE NORTH LINE OF THE SOUTH HALF OF SECTION 28 SAID POINT BEING THE NORTHEASTERLY CORNER OF LAND SURVEY PLAT RECORDED UNDER RECEPTION NO. 211900027 SAID POINT BEING ALSO IN THE WESTERLY RIGHT OF WAY LINE OF VOLLMER ROAD;

THENCE ON SAID WESTERLY RIGHT OF WAY LINE THE FOLLOWING TWO (2) COURSES:

1. THENCE S09°36'29"W, A DISTANCE OF 114.58 FEET;
2. THENCE S11°14'07"W, A DISTANCE OF 89.25 FEET TO THE POINT OF BEGINNING;

THENCE CONTINUING ON SAID WESTERLY RIGHT OF WAY LINE THE FOLLOWING THREE (3) COURSES:

1. THENCE S11°14'07"W, A DISTANCE OF 963.49 FEET;
2. THENCE ON THE ARC OF A CURVE TO THE RIGHT WHOSE CENTER BEARS N78°41'41"W, HAVING A DELTA OF 27°06'29", A RADIUS OF 603.83 FEET AND A DISTANCE OF 285.69 FEET;
3. THENCE S38°19'09"W, A DISTANCE OF 612.03 FEET;

THENCE N51°40'51"W, A DISTANCE OF 164.68 FEET;

THENCE N02°32'52"E, A DISTANCE OF 287.73 FEET;

THENCE N09°57'35"E, A DISTANCE OF 417.95 FEET;

THENCE ON THE ARC OF A CURVE TO THE LEFT WHOSE CENTER BEARS S09°57'35"W, HAVING A DELTA OF 31°02'16", A RADIUS OF 565.00 FEET, AND A DISTANCE OF 306.07 FEET;

THENCE S68°55'19"W, A DISTANCE OF 583.95 FEET;

THENCE ON A CURVE TO THE LEFT, HAVING A DELTA OF 57°09'17", A RADIUS OF 565.00 FEET, AND A DISTANCE OF 563.61 FEET;

THENCE S11°46'01"W, A DISTANCE OF 244.11 FEET;

THENCE ON A CURVE TO THE LEFT, HAVING A DELTA OF 14°47'24", A RADIUS OF 800.00 FEET, AND A DISTANCE OF 206.51 FEET;

THENCE S03°01'22"E, A DISTANCE OF 571.21 FEET;

THENCE ON A CURVE TO THE LEFT, HAVING A DELTA OF 46°22'30", A RADIUS OF 565.00 FEET, AND A DISTANCE OF 457.31 FEET;

THENCE S49°23'52"E, A DISTANCE OF 36.63 FEET TO A POINT ON THE WESTERLY RIGHT OF WAY LINE OF SAID VOLLMER ROAD;

THENCE S40°36'08"W, ON SAID WESTERLY RIGHT OF WAY LINE, A DISTANCE OF 1,236.97 FEET TO A POINT ON THE WEST LINE OF THE EAST HALF OF THE NORTHWEST QUARTER OF SAID SECTION 33;

THENCE N00°07'28"W, ON SAID WEST LINE, A DISTANCE OF 957.68 FEET;

THENCE N89°43'27"E, A DISTANCE OF 211.28 FEET;

THENCE N00°16'33"W, A DISTANCE OF 1,041.57 FEET;

THENCE N36°29'38"W, A DISTANCE OF 42.31 FEET;

THENCE N00°16'33"W, A DISTANCE OF 140.09 FEET;

THENCE S89°28'40"W, A DISTANCE OF 185.00 FEET TO A POINT ON THE WEST LINE OF THE EAST HALF OF THE SOUTHWEST QUARTER OF SAID SECTION 28;

THENCE N00°16'33"W, ON SAID WEST LINE, A DISTANCE OF 130.00 FEET;

THENCE N89°28'40"E, A DISTANCE OF 210.00 FEET;

THENCE N00°16'33"W, A DISTANCE OF 1,210.39 FEET;

THENCE N89°43'27"E, A DISTANCE OF 470.14 FEET;

THENCE S00°16'33"E, A DISTANCE OF 158.78 FEET;

THENCE S21°04'41"E, A DISTANCE OF 137.93 FEET;

THENCE N68°55'19"E, A DISTANCE OF 505.00 FEET;

THENCE N21°04'41"W, A DISTANCE OF 120.00 FEET;



THENCE N68°55'19"E, A DISTANCE OF 180.00 FEET;

THENCE N32°23'37"E, A DISTANCE OF 63.56 FEET;

THENCE N00°46'54"W, A DISTANCE OF 228.70 FEET;

THENCE N89°13'54"E, A DISTANCE OF 1,178.37 FEET TO THE POINT OF BEGINNING.

THE DESCRIPTION ABOVE PRODUCES A CALCULATED AREA OF 3,151,748 SQUARE FEET, (72.35417 ACRES) OF LAND MORE OR LESS AND IS DEPICTED ON THE ATTACHED GRAPHICAL EXHIBIT FOR REFERENCE.

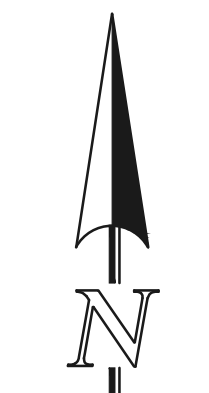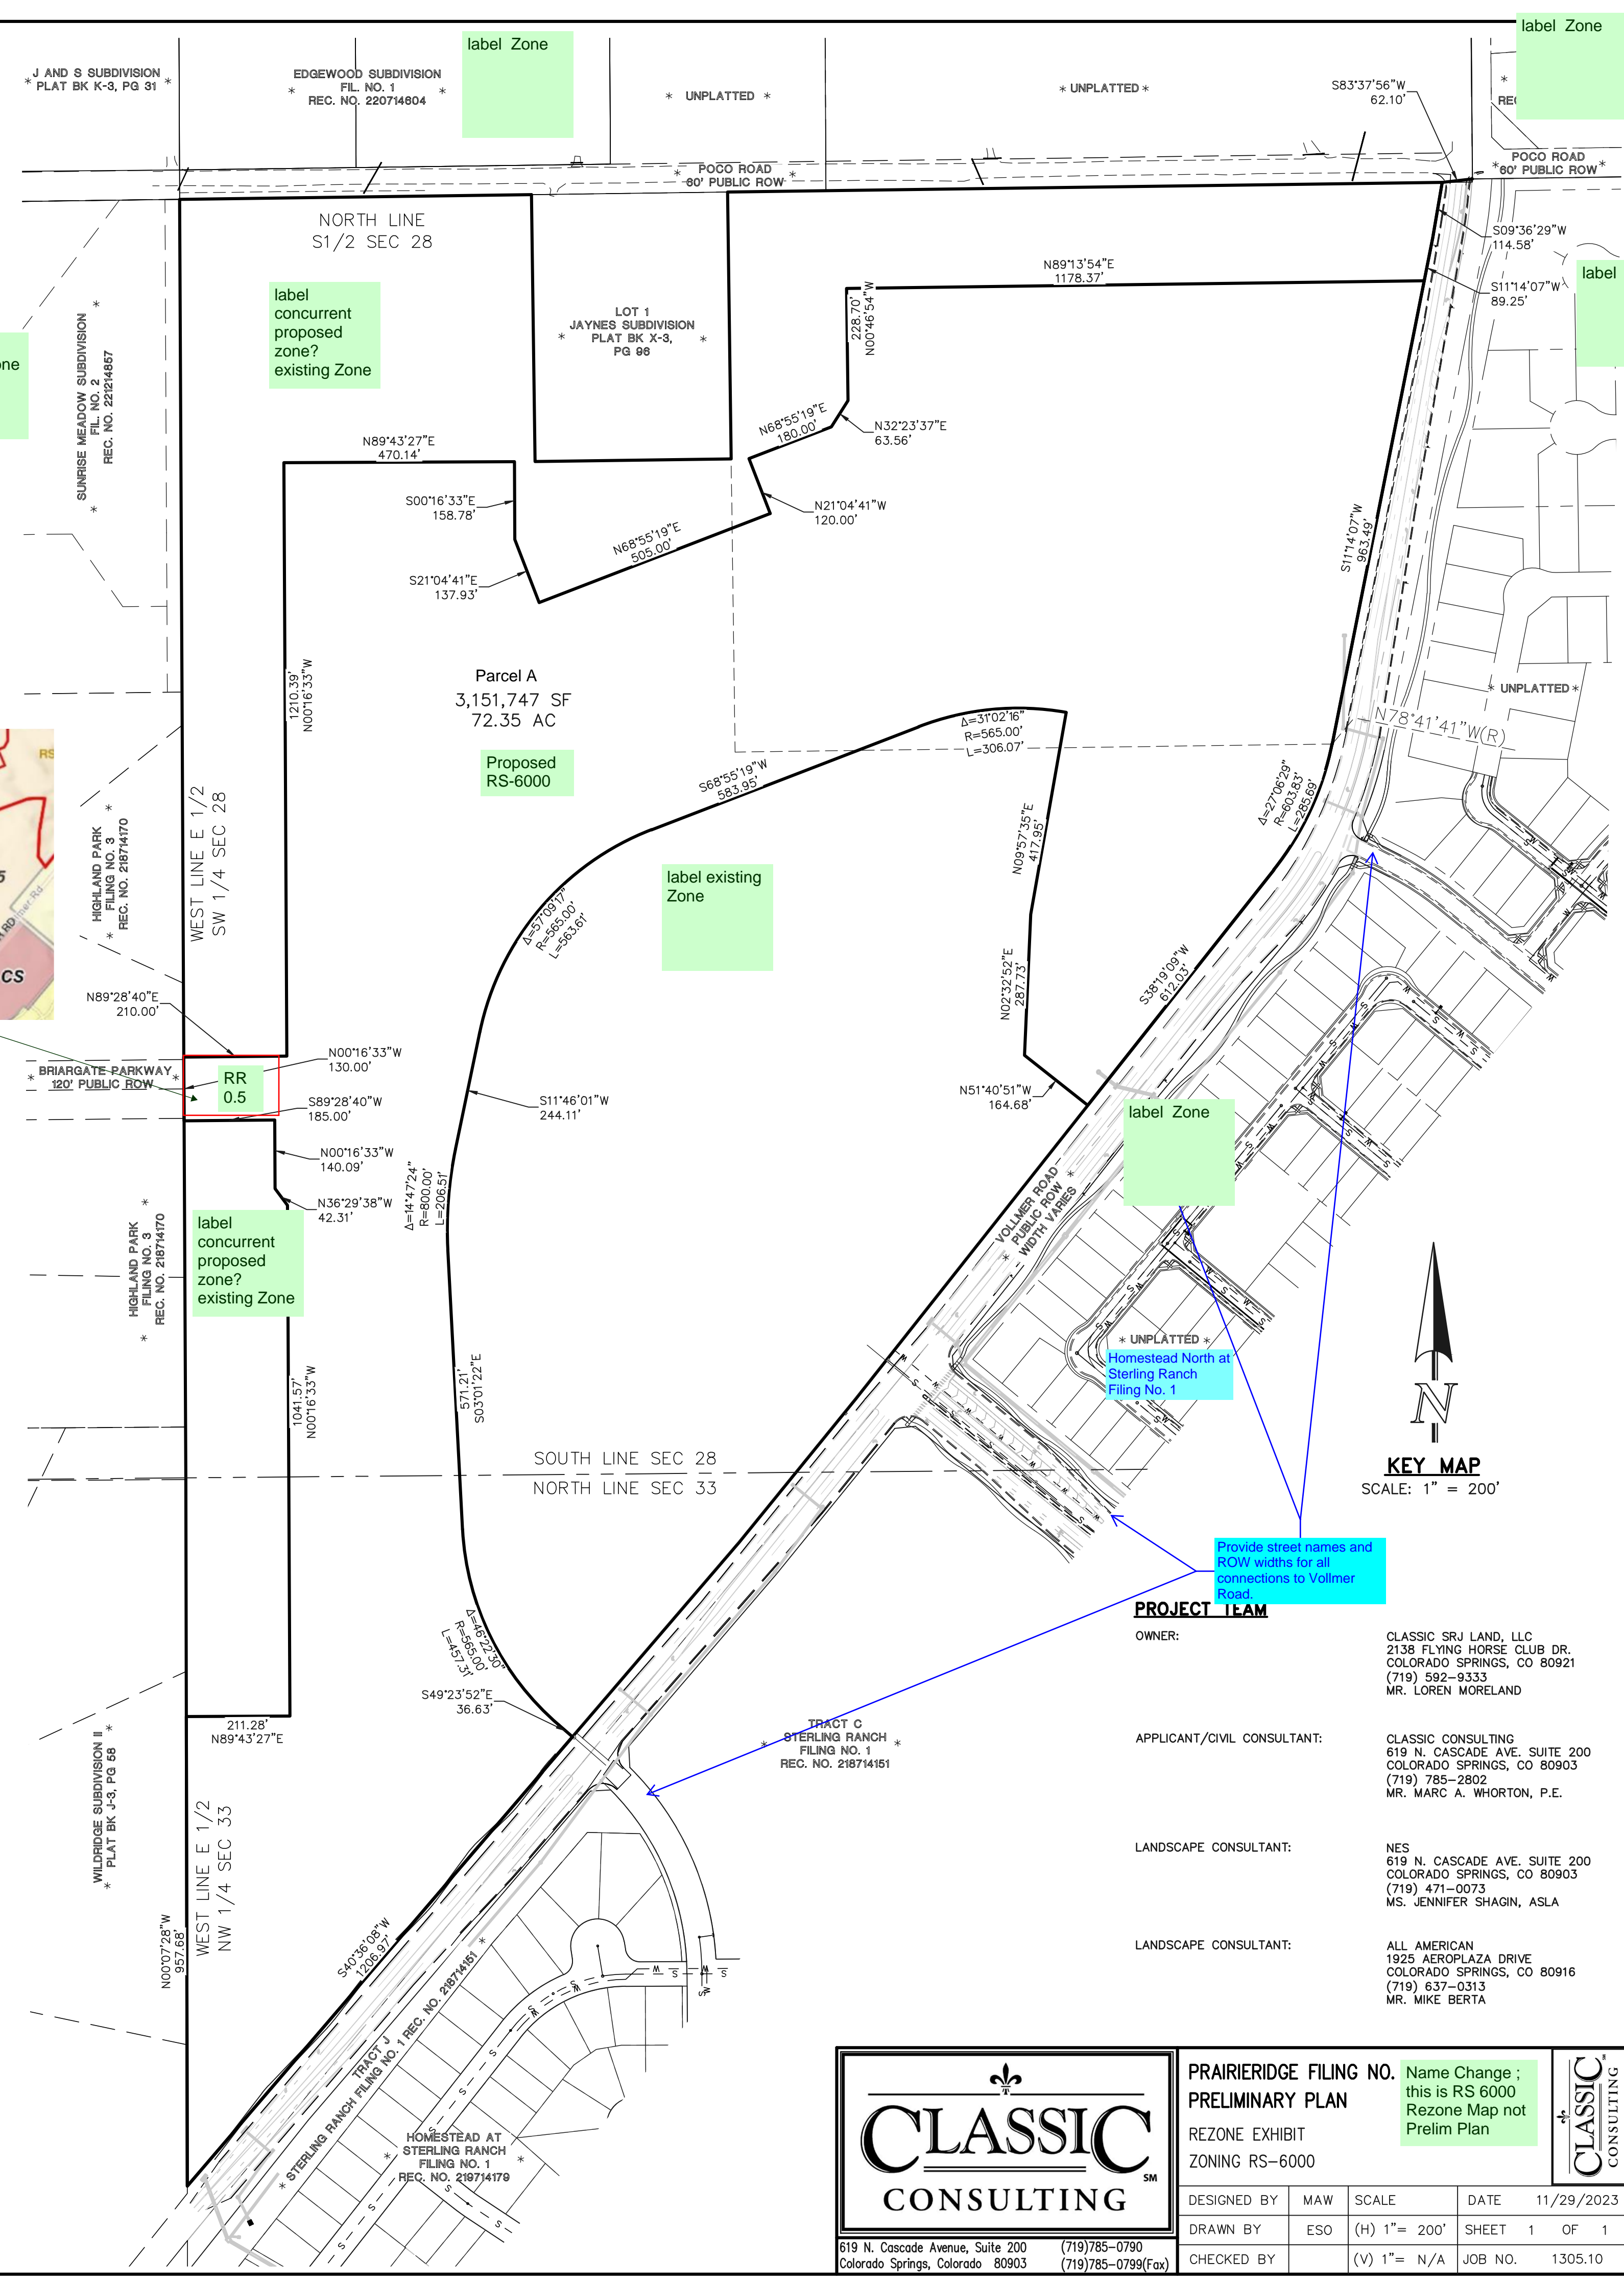

KEY MAP
SCALE: 1" = 200'

PROJECT TEAM

OWNER: CLASSIC SRJ LAND, LLC
2138 FLYING HORSE CLUB DR.
COLORADO SPRINGS, CO 80921
(719) 592-9333
MR. LOREN MORELAND

APPLICANT/CIVIL CONSULTANT: CLASSIC CONSULTING
619 N. CASCADE AVE, SUITE 200
COLORADO SPRINGS, CO 80903
(719) 785-2802
MR. MARC A. WHORTON, P.E.

LANDSCAPE CONSULTANT: NES
619 N. CASCADE AVE, SUITE 200
COLORADO SPRINGS, CO 80903
(719) 471-0073
MS. JENNIFER SHAGIN, ASLA

LANDSCAPE CONSULTANT: ALL AMERICAN
1925 AEROPAZA DRIVE
COLORADO SPRINGS, CO 80916
(719) 637-0313
MR. MIKE BERTA



PRAIRIERIDGE FILING NO. 1
PRELIMINARY PLAN
REZONE EXHIBIT
ZONING RS-6000

Name Change ; this is RS 6000
Rezoning Map not Prelim Plan


DESIGNED BY	MAW	SCALE	DATE	11/29/2023
DRAWN BY	ESO	(H) 1" = 200'	SHEET	1 OF 1
CHECKED BY	(V) 1" = N/A	JOB NO.	1305.10	

619 N. Cascade Avenue, Suite 200
Colorado Springs, Colorado 80903
(719) 785-0790
(719) 785-0799(Fax)

N:\10510\DRAWINGS\DEVELOPMENT\RS-6000_ZONING_EXHIBIT.dwg, 11/29/2023, 3:47:03 PM, 1:1

V1_Zoning Map R1 RS6000.pdf Markup Summary

CDurham (3)

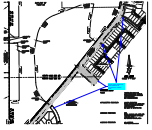

Subject: Callout
Page Label: [1] Layout1
Author: CDurham
Date: 1/22/2024 9:12:40 AM
Status:
Color: ■
Layer:
Space:

Provide street names and ROW widths for all connections to Vollmer Road.



Subject: Text Box
Page Label: [1] Layout1
Author: CDurham
Date: 1/22/2024 9:15:01 AM
Status:
Color: ■
Layer:
Space:

Homestead North at Sterling Ranch Filing No. 1

52280-00-024 &
5 SKP-22-005

Subject: Text Box
Page Label: [1] Layout1
Author: CDurham
Date: 1/22/2024 9:23:37 AM
Status:
Color: ■
Layer:
Space:

SKP-22-005

dsdparsons (20)




Subject: Image
Page Label: [1] Layout1
Author: dsdparsons
Date: 1/24/2024 11:42:25 AM
Status:
Color: ■
Layer:
Space:

Add

Subject: Planner
Page Label: [1] Layout1
Author: dsdparsons
Date: 1/24/2024 11:43:02 AM
Status:
Color: ■
Layer:
Space:

Add

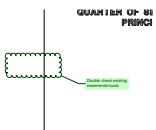

Subject: Planner
Page Label: [1] Layout1
Author: dsdparsons
Date: 1/24/2024 11:42:58 AM
Status:
Color: ■
Layer:
Space:

Double check existing easements/roads




Subject: Planner
Page Label: [1] Layout1
Author: dsdparsons
Date: 1/24/2024 11:43:28 AM
Status:
Color: ■
Layer:
Space:

Correct Name and add RS-6000 so these 3 Rezoning Maps can be distinguished when in packets



Subject: Planner
Page Label: [1] Layout1
Author: dsdparsons
Date: 1/24/2024 11:43:45 AM
Status:
Color: ■
Layer:
Space:

Month 2024

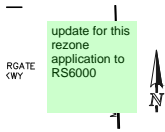

Subject: Planner
Page Label: [1] Layout1
Author: dsdparsons
Date: 1/24/2024 11:44:00 AM
Status:
Color: ■
Layer:
Space:

update for this rezone application to RS6000



Subject: Planner
Page Label: [1] Layout1
Author: dsdparsons
Date: 1/24/2024 11:44:46 AM
Status:
Color: ■
Layer:
Space:

label concurrent proposed zone? existing Zone



Subject: Planner
Page Label: [1] Layout1
Author: dsdparsons
Date: 1/24/2024 11:45:48 AM
Status:
Color: ■
Layer:
Space:

label existing Zone




Subject: Planner
Page Label: [1] Layout1
Author: dsdparsons
Date: 1/24/2024 11:45:33 AM
Status:
Color: ■
Layer:
Space:

label Zone

label existing
Zone


Subject: Planner
Page Label: [1] Layout1
Author: dsdparsons
Date: 1/24/2024 11:45:22 AM
Status:
Color: ■
Layer:
Space:

label existing Zone

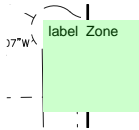

Subject: Planner
Page Label: [1] Layout1
Author: dsdparsons
Date: 1/24/2024 11:45:58 AM
Status:
Color: ■
Layer:
Space:

label Zone

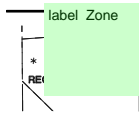


Subject: Planner
Page Label: [1] Layout1
Author: dsdparsons
Date: 1/24/2024 11:46:00 AM
Status:
Color: ■
Layer:
Space:

label Zone



Subject: Planner
Page Label: [1] Layout1
Author: dsdparsons
Date: 1/24/2024 11:46:04 AM
Status:
Color: ■
Layer:
Space:

label Zone

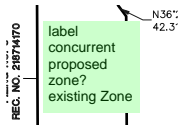

Subject: Planner
Page Label: [1] Layout1
Author: dsdparsons
Date: 1/24/2024 11:46:27 AM
Status:
Color: ■
Layer:
Space:

label concurrent proposed zone? existing Zone



Subject: Image
Page Label: [1] Layout1
Author: dsdparsons
Date: 1/24/2024 11:46:37 AM
Status:
Color: ■
Layer:
Space:




Subject: Arrow
Page Label: [1] Layout1
Author: dsdparsons
Date: 1/24/2024 11:46:42 AM
Status:
Color: ■
Layer:
Space:

0. Name Change ;
this is RS 6000
Rezone Map not
Prelim Plan

Subject: Planner
Page Label: [1] Layout1
Author: dsdparsons
Date: 1/24/2024 11:48:03 AM
Status:
Color: ■
Layer:
Space:

Name Change ; this is RS 6000 Rezone Map not Prelim Plan

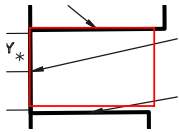

Subject: Rectangle
Page Label: [1] Layout1
Author: dsdparsons
Date: 1/24/2024 11:50:45 AM
Status:
Color: ■
Layer:
Space:

RR
0.5

Subject: Planner
Page Label: [1] Layout1
Author: dsdparsons
Date: 1/24/2024 11:50:36 AM
Status:
Color: ■
Layer:
Space:

RR 0.5

Proposed
RS-6000

Subject: Planner
Page Label: [1] Layout1
Author: dsdparsons
Date: 1/24/2024 11:51:10 AM
Status:
Color: ■
Layer:
Space:

Proposed RS-6000