


# FALCON SCHOOL DISTRICT 49 NEW FALCON HIGH SCHOOL BID PACKAGE A - SITE Development Plan

The LKA Partners, Inc.  
April 13, 2006

LKA PARTNERS  
INCORPORATED  
A Professional Corporation  
for Architecture and Planning  
430 North Tejon Street Suite 200  
Colorado Springs Colorado 80903  
tel: 719 473 8446 fax: 719 473 8448  
e-mail www.lkpartners.com

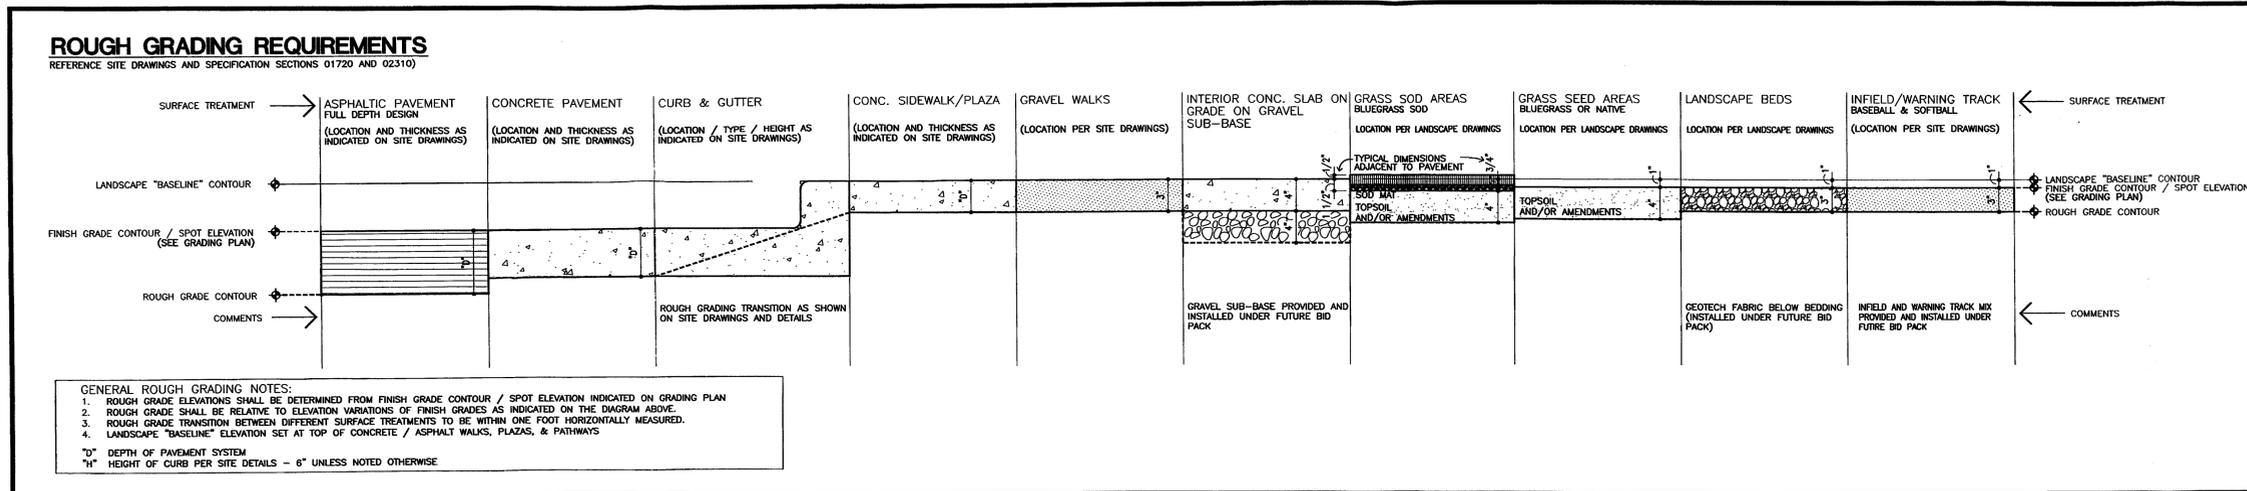






### CONTROL POINT TABLE

POINT#	DESCRIPTION	Position Y	Position X
100	CL @ PROP. LINE	14525.7107	15465.7523
101	AP	14624.7824	15532.5428
102	AP	14665.3497	15565.2620
103	CL @ PROP. LINE	14709.3077	15721.8546
104	AP	14831.1247	15755.4152
105	AP	14790.5872	15789.9663
106	AP	14834.3333	15910.3849
107	AP	14865.5275	15945.5162
108	CL @ PROP. LINE	15971.1008	14764.7753
109	CC	15877.5220	14830.1606
110	CC	15871.3544	14837.2592
111	CC	16266.8602	14955.5402
112	CL/MP	15834.9087	15215.8008
113	CL END DRIVE	15813.9387	15215.8008
114	CL/PT	15915.9687	15339.9539
115	CC	15850.9087	15339.9539
116	CL/PT	15860.9087	15613.9539
117	AP	15871.8929	15777.4348
118	AP	15871.8929	15897.4348
119	AP	15831.8929	15777.4348
120	AP	15831.8929	15897.4348
121	AP	15398.8553	15796.3057
122	AP	15492.2244	15978.0910
123	AP	15762.3674	16054.4259
124	AP	15656.2988	16326.3191
125	AP	15608.6563	16359.5318
126	AP	15502.5977	16536.4250
127	AP	15184.3129	16590.8407
128	AP	15200.3615	16158.9475
129	AP	15358.0140	16182.7448
130	AP	15444.0826	15848.8416
131	CC	14948.2129	16250.7465
132	CC	15162.7129	16230.7465
133	PC	15056.2129	16421.2721
134	CC	14913.5080	16237.6691
135	PC	14895.5192	16315.2768
136	AP	14937.3115	16351.8851
137	FOUL POLE	14609.4842	16313.2561
138	FOUL POLE	14278.4842	16042.5061
139	CC	14530.2624	16121.6879
<b>Net Used</b>			
141	FOUL POLE	14385.7885	15625.3595
142	FOUL POLE	14576.9807	15646.2885
143	CL @ PROP. LINE	15307.4091	14865.6188
144	CC	15307.4091	14927.8955
145	PT	15279.4091	14914.9153
146	PT	15249.4091	14953.5319
147	CC	15288.3926	15021.0283
148	CC	15161.3195	15075.2071
149	CC	15184.1986	15251.6315
150	CC	15218.9485	15297.8422
151	CC	15240.7854	15299.3348
152	WP	15258.3926	15990.3103
153	WP	15278.3926	16006.3103
154	PC	15322.8378	15151.0283
155	PT	15322.5569	15083.7722
156	CC	15323.7686	15127.0283
157	CC	15353.1140	15137.1745
158	PC	15312.6893	15075.2288
159	PC	15370.4673	15057.4949
160	AP/CORNER	15378.8929	15078.8929
161	AP/CORNER	15421.8396	15075.3539
162	PC	15381.2599	15026.7928
163	PC	15341.6989	14977.8337
164	CC	15381.4091	14977.8337
165	AP/CORNER	15361.4091	14987.8897
166	PC/CORNER	15361.4091	14886.8516
167	PC/CORNER	15427.3923	15006.1354
168	WP/CL	15403.9769	15006.6948
169	WP/CL	15625.9087	15050.0286
170	WP/CL	15638.2430	15025.2148
171	PC/CORNER	15607.5042	14992.8615
172	PC/CORNER	15646.9485	14984.6710
173	AP/CORNER	15673.3000	14984.1695
174	CC	15673.3459	14984.7342
175	CL @ PROP. LINE	15680.8396	14840.6020
176	CC	15708.0383	14857.4539
177	CC	15795.0383	15687.4539
178	WP/CL	15537.5778	15448.9539
179	PC	15380.3474	15580.6254
180	PC	15380.3474	15580.6254
181	WP/CL	15312.4091	15613.9539
182	WP	15139.9832	15687.4539
183	WP	15139.9832	15687.4539
184	WP/CL DRIVE	15103.9832	15687.4539
185	PT	14891.5725	15487.4539
186	PT	14971.4091	15486.2117
187	WP/CL	14805.1675	15682.3495
188	CC	14891.5725	15487.4539
189	PT	15006.3621	15559.8975
190	PT	15009.5310	15627.4539
191	PT/MP	14944.5090	15551.9152
192	WP	14983.1796	15515.6118
193	PT/MP	14971.4091	15486.2117
194	CC	14900.4091	15486.2117
195	BLDG. LAYOUT POINT	15092.8254	15478.6351
196	WP	14885.4091	15346.7693
197	WP/CL	14871.4091	15323.5986
198	PT	15010.4801	15321.8177
199	CC	15020.4091	15285.0290
200	PT	15083.5673	15248.7506
201	AP/CORNER	14957.2151	15263.4897
202	AP/CORNER	14939.2155	15223.0186
203	AP/CORNER	14995.4744	15125.5753
204	CL/CL FIELD	15035.9832	15998.5262
205	CC/MEASURE LINE	14880.8977	15855.5262
206	CC WALK	14878.5262	15858.5262
207	AP/CORNER	14855.9832	16038.5262
208	AP/CORNER	14855.9832	15878.5262
209	AP/CORNER	15215.9832	15878.5262
210	CC/MEASURE LINE	15191.2187	15888.5262
211	AP/CORNER	15215.9832	16038.5262
212	WP	14813.7131	15692.4658
213	PT	14881.5377	15771.2146
214	WP	14780.8929	15799.2661
215	WP	14718.2317	15883.2699
216	WP	14681.6491	15888.2174
217	AP/FIRST BASE	14611.8907	15633.3034
218	AP/SECOND BASE	14552.1574	15634.1195
219	AP/THIRD BASE	14562.8935	15893.1512
220	CC/INFIELD	14584.1030	15856.2333
221	AP	14621.3257	15862.4151
222	AP	14642.4948	15922.1374
223	AP	14652.0823	15946.8428
224	AP	14652.0823	15970.2095
225	AP	14632.6557	15985.8961
226	AP/HOME PLATE	14699.4842	16042.5061
227	AP/FIRST BASE	14519.4642	16042.5061
228	AP/SECOND BASE	14519.4642	16112.5061
229	AP/THIRD BASE	14619.4642	16112.5061
230	CC INFIELD	14566.6942	16085.2980
231	CC	14567.1448	16082.2254
232	WP	14674.3331	16007.3357
233	PC/MP	14718.2317	16033.7859
234	BLDG LAYOUT POINT	14718.2050	15958.5262
235	WP	14804.2024	15882.0408
236	WP	14837.6888	15915.5272
237	WP	14837.6888	16031.5251
238	WP	14804.2024	16025.0115
239	CC	14780.4866	15941.5283
240	CC	14787.3939	15956.2999
241	CC	14787.3939	15961.1250
242	CC	14780.4866	15975.5282
243	PT	14881.5377	16145.8377
244	SW PROF. CORNER	14624.9895	14782.9589

© Copyright 2006 The LKA Partners, Inc. This document and the information contained herein may not be reproduced or excerpted from without the express written permission of The LKA Partners, Inc. Unauthorised copying, disclosure or construction use are prohibited by copyright law.

## New Falcon High School

El Paso County, Colorado 80831

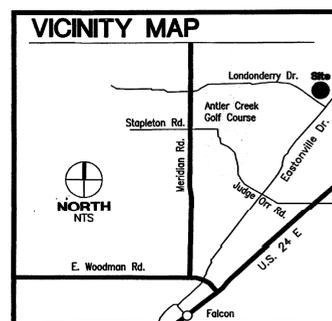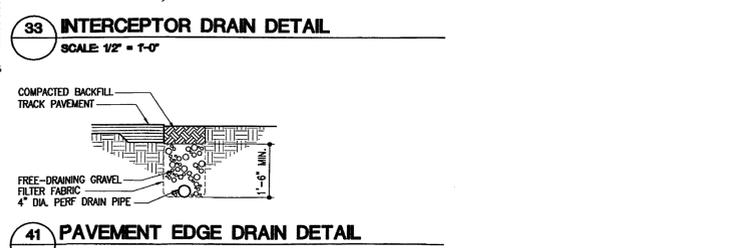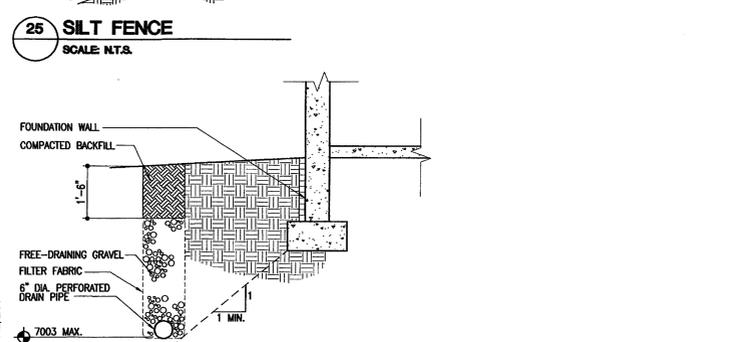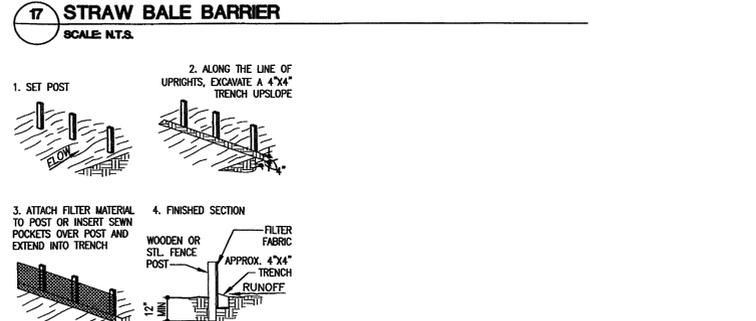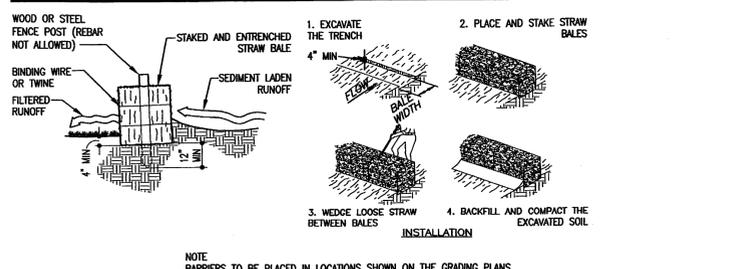

### DRAWING INDEX

T-1 TITLE SHEET

**SITE DEVELOPMENT**

- SD-1.1 SITE GRADING & EROSION CONTROL PLAN
- SD-1.2 ENLARGED SITE GRADING PLAN
- SD-2.1 SITE DEVELOPMENT PLAN
- SD-2.2 ENLARGED SITE DEVELOPMENT PLAN
- SD-3.1 DETAIL SHEET SITE DEVELOPMENT
- SD-3.2 DETAIL SHEET SITE DEVELOPMENT
- SD-3.3 CONCESSION-RESTROOM & FIELD BLDG DETAILS

**LANDSCAPE**

- LS-1.1 PRELIMINARY LANDSCAPE PLAN

**STRUCTURAL**

- S-2.0 OVERALL DIMENSION PLAN
- S-2.1 FOUNDATION PLAN - AREA "A"
- S-2.2 FOUNDATION PLAN - AREA "B" SOUTH / "C" EAST
- S-2.3 FOUNDATION PLAN - AREA "D" NORTH
- S-2.4 FOUNDATION PLAN - AREA "E"
- S-2.5 FOUNDATION PLAN - AREA "C" WEST / "E"
- S-2.6 FOUNDATION PLAN - AREA "F"
- S-2.7 FOUNDATION PLAN - AREA "G"

### CONSULTANTS

**Civil**

TERRA NOVA ENGINEERING, INC.  
125 N. WEBER STREET  
COLORADO SPRINGS, CO 80903-3406

**LANDSCAPE**

GUMAN & ASSOCIATES  
815 N. CASCADE AVE, SUITE 201  
COLORADO SPRINGS, CO 80903-2918

**STRUCTURAL**

HCOA, INC.  
619 N. CASCADE AVE, SUITE 201  
COLORADO SPRINGS, CO 80903

### SITE PLAN LEGEND

- PROPERTY BOUNDARY (REFER TO SURVEY)
- EXISTING CONTOURS (REFER TO SURVEY)
- PROPOSED NEW CONTOURS
- SPOT ELEVATION POINT & TYPE (SEE TYPE DESIGNATIONS THIS LEGEND)
- SITE PLAN SPECIFIC NOTE REFERENCE (SEE SPECIFIC NOTE LIST THIS SHEET)
- PAVEMENT TYPE/SURFACE TREATMENT (SEE LEGEND LIST THIS SHEET)
- NOTE/DETAIL REFERENCE BETWEEN ARROWS
- CURB RAMP FOR DISABLED ACCESSIBILITY (SEE DETAIL 1/73)
- CURB TRANSITION AT CURB RAMP (SEE DETAIL 1/73)
- TRENCH DRAIN (SEE DETAIL 1/74)

**RO** MAINLINE  
**MI** MANHOLE  
**INLET** AREA DRAIN  
**EJ** EXPANSION JOINT W/ CAULK (SEE DETAIL 2/72)  
**SJ** SCORE JOINT - AS INDICATED (SEE DETAIL 1/72)  
**IE** INVERT ELEVATION  
**FL** FLOW LINE  
**HPT** HIGH POINT  
**LPT** LOW POINT  
**PC** POINT OF CURVATURE  
**PT** POINT OF TANGENCY  
**CC** CENTER OF CURVATURE  
**PCR** POINT OF CURB RADIUS (RETURN)  
**AP** ANGLE POINT  
**TC** TOP OF CURB  
**TP** TOP OF PAVING (CONC / ASPHALT)  
**TG** TOP OF GRATE (DRAIN / INLET)  
**WP** WORKING POINT  
**C** CENTER LINE  
**TO** TOP OF " " "  
**TOW** TOP OF WALL  
**ML** MEASURE LINE (TRACK LAYOUT)  
**UNO** UNLESS NOTED OTHERWISE

### PAVEMENT SURFACE TREATMENT LEGEND

**ASPHALT PAVEMENT TYPE/DESCRIPTION:**

- 3" FULL DEPTH ASPHALT
- 4" FULL DEPTH ASPHALT
- 5" FULL DEPTH ASPHALT
- 6" FULL DEPTH ASPHALT
- 6.5" FULL DEPTH ASPHALT
- 6" FULL DEPTH ASPHALT MILLINGS

**CONCRETE AREAS TYPE/DESCRIPTION:**


- NOT USED
- 6" DEPTH CONCRETE PAVEMENT

### SITE PLAN GENERAL NOTES

- Site Dimensions / Layout are to Control Point, face of curb/flow line, edge of sidewalk and pavement, or face of building foundation (unless otherwise noted).
- Topsoil and backfill shall be stockpiled on the site as shown and approved by the Architect.
- Reference Topographic Survey prepared by Clark Land Surveying, Inc., dated January 20, 2006 for property boundary dimensions and bearings, benchmarks, site utilities, easements, legal descriptions and other existing site characteristics and information. (Under separate Contract)
- Coordinate work with Bid Package B for Storm Drainage and Utility construction. (Under separate Contract)
- Reference Site Development Plans for Grading, Horizontal Control, and Site Improvements.
- Contours indicate top of finished surface, asphalt, concrete, etc. Finish Grades, Rough Grades, and Subgrade Preparation shall be in accordance with specifications, details, and the Rough Grading Requirements indicated on this sheet.
- Finish Grading and transitions shall flow smoothly and evenly from contour/spot elevation to contour/spot elevation (unless otherwise indicated by spot elevations). There shall be no ridges at contour lines.
- Reference Geotechnical Engineering Report prepared by Kumar & Associates, Inc., dated February 21, 2006, for soils information and recommendations.
- Coordinate rough grading for driveways, sidewalks, and curb ramps with construction of improvements to Londonderry Drive and Lambert Road. Confirm layout and elevations of site improvements with proposed streets. Contact Architect immediately if layout, elevations, or extent varies from requirements under this Contract.
- Remove all existing improvements, including man-made/demolition debris, broken concrete and asphalt, rubble, etc. from site. Remove existing trees, shrubs, groundcover, and other plant materials, etc. Dispose of materials at an approved off-site location.
- Soccer Fields and Baseball/Softball Fields may be raised or lowered as required to achieve a cut/fill balance. The transition slopes between fields shall not exceed 3:1. Grade modifications to be reviewed and approved by the Architect.

### SITE PLAN SPECIFIC NOTES

- CONCRETE CURB AND GUTTER, (1+2)/SD3.1 TYP UNO
- CONCRETE RAMPED/MOUNTABLE CURB & GUTTER 5/SD3.1
- TAPERED CONCRETE RETAINING WALL.
- CONCRETE WALK WITH ISOLATION, EXPANSION & CONTRACTION JOINTS AS SHOWN (1/4" PER FOOT MAX. CROSS SLOPE), 8'-0" WIDE (8-12)/SD3.1 UNO.
- PASSENGER LOADING ZONE: 20'-0"x10'-0" (MIN), 2% MAX. CROSS SLOPE. (21)/SD3.1
- UTILITY ENCLOSURE SCREEN WALL (8)/SD3.2
- CHAIN LINK FENCE, ENCLOSURE, & GATES 6'-0" HIGH UNO (28)/SD3.1 & 20/SD3.1
- CHAINLINK FIELD FENCE AND GATES, 6'-0" HIGH UNO 20/SD3.1 & 28/SD3.1
- TRAFFIC CONTROL AND PARKING STRIPING:
  - A - CENTER LINES: 4" WIDE SOLID DOUBLE YELLOW, 3' APART, NOT USED
  - B - LANE LINES: 4" WIDE DASHED WHITE, 10' LONG, 10' GAPS, NOT USED
  - C - CHANNELING LINES: 8" WIDE SOLID WHITE, 10' LONG
  - D - STOP BARS: 24" WIDE SOLID WHITE
  - E - AUTO PARKING STALL LINES: 4" WIDE SOLID WHITE
  - F - HANDICAP / DISABLED PARKING STALL STRIPING & LOADING AREA LINES: 4" WIDE SOLID WHITE PERIMETER & 24" APART AT CROSSHATCH
- TRAFFIC ARROW GRAPHICS. (25 AND 26)/SD3.1
- PEDESTRIAN CROSSWALK STRIPING, 12" WIDE SOLID WHITE, 24" APART, 8'-0" LONG UNO
- 11 BICYCLES PER BIKE RACK TYPE OF 2 (19)/SD3.1
- 3" THICK GRAVEL WALK, 8'-0" WIDE UNO.
- 3 RAIL PEELLED POLE WOOD FENCE.
- SITE SIGN (22)/SD3.1
- ASPHALT CURB (4)/SD3.2
- FLAGPOLE (17)/SD3.1
- PAINTED HANDICAPPED SYMBOL SEE 27/SD3.1.
- CONCRETE SPLASH BLOCK.
- NOT USED.
- LIGHT POLE. NIC
- FLUSH CONCRETE EDGE. (7)/SD3.1.
- BASEBALL BACKSTOP. SEE DETAIL 35/SD3.1.
- CONCRETE BENCH SEE 43/SD3.1.
- SOFTBALL BACKSTOP. SEE DETAIL 33/SD3.1.
- ACCESSIBLE RAMP (39)/SD3.1
- STEEL TRAFFIC GATE SEE DETAIL 9/SD-3.2.
- 4" THICK GRAVEL OVER WEED BARRIER FABRIC AROUND EQUIPMENT PADS.
- ASPHALT PATH, 8'-0" WIDE UNO.
- SIDEWALK TRENCH DRAIN.
- BOLLARD, SEE 18/SD3.1.
- NOT USED.
- CONC. SWALE SEE 13/SD3.1.
- 5'-0" HIGH CHAINLINK FENCE.
- CONCRETE MOW BAND CENTERED ON FENCE 4'x 12" WIDE
- REMOVABLE BOLLARD.
- NOT USED.
- NOT USED.

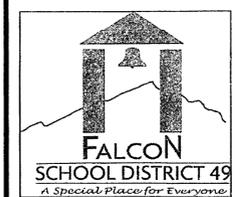

Falcon School District 49  
10850 E. Woodmen Road  
Falcon, Colorado 80831

Construction Documents  
Bid Package A  
Site Grading

Drawn: FK  
Checked: JC  
Issued: April 13, 2006  
Revised:

PPR-17-048

## TITLE SHEET

Scale: AS INDICATED

# T-1

New Falcon High School Project No. 03-021  
The LKA Partners Incorporated

# FALCON SCHOOL DISTRICT 49 - NEW FALCON HIGH SCHOOL - BID PAK D - VOLUME I OF II

## KEYNOTE LIST

2.1 DRILLED CONC. PIERS	8.1 HM FRAME	2.13 CONC. CURB & GUTTER	9.1 PORTLAND CEMENT
2.2 BACKFILL	8.2 HM DOOR	2.14 ASPHALT CURB	9.11 CERAMIC TILE
2.3 REINFORCING GRANULAR BACKFILL	8.3 HM WINDOW	2.15 LANDSCAPE TIMBER	9.12 ACACIA PLASTER
2.4 COMPACTED SUBGRADE	8.4 HM STAIR	2.16 CHAIN LINK FENCE	9.13 GYPSUM BOARD CEILING
2.5 AGGREGATE BASE COURSE	8.5 HM DEFLECTION CHANNEL	2.17 CHAIN LINK GATE	9.14 SUSPENDED CEILING
2.6 ASPHALTIC CONC. PAVING	8.6 HM FRAME ANCHOR	2.18 MASONRY RETAINING WALL	9.15 QUARRY TILE
2.7 CONCRETE PAVING	8.7 HM SUB-SILL	2.19 ALUMINUM WINDOW	9.16 QUARRY TILE BASE
2.8 CONC. WALK	8.8 HM WOOD DOOR	2.20 CONC. WALK	9.17 CERAMIC TILE BASE
2.9 BRICK PAVEMENT	8.9 HM WOOD WINDOW	2.21 CONC. WALK	9.18 CERAMIC TILE PARTITION
2.10 TEMS COURT SURFACING	8.10 HM WOOD PANEL	2.22 PERFORATED DRAIN PIPE	9.19 URMAL SCREEN
2.11 TRACK SURFACING	8.11 HM WOOD TRIM	2.23 IMPERFORATED DRAIN	9.20 STAIR PARTITION
2.12 BASEBALL FIELD SURFACING	8.12 HM WINDOW	2.24 CONC. CURB & GUTTER	9.21 WIRE MESH PARTITION
2.13 CONC. CURB & GUTTER	8.13 HM WINDOW	2.25 ASPHALT CURB	9.22 WIRE MESH PARTITION
2.14 ASPHALT CURB	8.14 HM WINDOW	2.26 ASPHALT CURB	9.23 WIRE MESH PARTITION
2.15 LANDSCAPE TIMBER	8.15 HM WINDOW	2.27 ASPHALT CURB	9.24 WIRE MESH PARTITION
2.16 CHAIN LINK FENCE	8.16 HM WINDOW	2.28 ASPHALT CURB	9.25 WIRE MESH PARTITION
2.17 CHAIN LINK GATE	8.17 HM WINDOW	2.29 ASPHALT CURB	9.26 WIRE MESH PARTITION
2.18 MASONRY RETAINING WALL	8.18 HM WINDOW	2.30 CONC. PILE RIGID END SECTION	9.27 WIRE MESH PARTITION
2.19 ALUMINUM WINDOW	8.19 HM WINDOW	2.31 CONC. PILE RIGID END SECTION	9.28 WIRE MESH PARTITION
2.20 CONC. WALK	8.20 HM WINDOW	2.32 CONC. PILE RIGID END SECTION	9.29 WIRE MESH PARTITION
2.21 CONC. WALK	8.21 HM WINDOW	2.33 CONC. PILE RIGID END SECTION	9.30 WIRE MESH PARTITION
2.22 PERFORATED DRAIN PIPE	8.22 HM WINDOW	2.34 CONC. PILE RIGID END SECTION	9.31 WIRE MESH PARTITION
2.23 IMPERFORATED DRAIN	8.23 HM WINDOW	2.35 CONC. PILE RIGID END SECTION	9.32 WIRE MESH PARTITION
2.24 CONC. CURB & GUTTER	8.24 HM WINDOW	2.36 CONC. PILE RIGID END SECTION	9.33 WIRE MESH PARTITION
2.25 ASPHALT CURB	8.25 HM WINDOW	2.37 CONC. PILE RIGID END SECTION	9.34 WIRE MESH PARTITION
2.26 ASPHALT CURB	8.26 HM WINDOW	2.38 CONC. PILE RIGID END SECTION	9.35 WIRE MESH PARTITION
2.27 ASPHALT CURB	8.27 HM WINDOW	2.39 CONC. PILE RIGID END SECTION	9.36 WIRE MESH PARTITION
2.28 ASPHALT CURB	8.28 HM WINDOW	2.40 CONC. PILE RIGID END SECTION	9.37 WIRE MESH PARTITION
2.29 ASPHALT CURB	8.29 HM WINDOW	2.41 CONC. PILE RIGID END SECTION	9.38 WIRE MESH PARTITION
2.30 CONC. PILE RIGID END SECTION	8.30 HM WINDOW	2.42 CONC. PILE RIGID END SECTION	9.39 WIRE MESH PARTITION
2.31 CONC. PILE RIGID END SECTION	8.31 HM WINDOW	2.43 CONC. PILE RIGID END SECTION	9.40 WIRE MESH PARTITION
2.32 CONC. PILE RIGID END SECTION	8.32 HM WINDOW	2.44 CONC. PILE RIGID END SECTION	9.41 WIRE MESH PARTITION
2.99 CONC. PILE RIGID END SECTION	8.99 HM WINDOW	3.11 CONC. PILE RIGID END SECTION	10.08 WIRE MESH PARTITION
3.00 CONC. PILE RIGID END SECTION	8.100 HM WINDOW	3.12 CONC. PILE RIGID END SECTION	10.09 WIRE MESH PARTITION

### SYMBOL LEGEND

**ASSEMBLY NOTE**

1 → SPECIFIC NOTE (APPLIES ONLY TO THE DRAWING ON WHICH THE NOTE APPEARS UON)

HM → HOLLOW METAL FRAME ELEVATION, SEE SHEET A-12.1

AS → ALUMINUM STOREFRONT ELEVATION, SEE SHEET A-13.1

CS → CASEWORK ELEVATION, SEE SHEET A-14.1

EQ → EQUIPMENT SCHEDULE, SEE SHEET A-14.1

TD → TOILET ACCESSORY SCHEDULE, SEE SHEET A-8.1

AS.1 → BUILDING ELEVATION

A AB.1 → BUILDING OR WALL SECTION

AI.1 → INTERIOR ELEVATION

4.81 → DETAIL REFERENCE

--- MATCHLINE

**DOOR LABEL (FLOORPLANS):**

DOOR TYPE, SEE SHEET A2.3

ROOM NUMBER

DOOR NUMBER

**ROOM LABEL (FLOOR PLANS):**

ROOM NAME → CLASSROOM

ROOM NUMBER → 104

FINISH TYPE, SEE SHEET A-2.3

**ROOM LABEL (CEILING PLANS):**

ROOM NUMBER → 104

CEILING TYPE, SEE SHEET A-3.1

(4x12) → INDICATES QUANTITY (4) AND DEPTH (12") OF SHELVES, SEE DETAIL 9/A-14.1.

### GENERAL NOTES

- REFER TO SHEET A-2.3 FOR ROOM FINISH SCHEDULE AND DOOR SCHEDULE.
- ALL SITE PLAN SPOT ELEVATIONS OUTSIDE THE BUILDING RELATE TO USG OR SITE DATUM AT THE BENCHMARK. ALL SPOT ELEVATIONS INSIDE THE BUILDING REFER TO BUILDING REFERENCED ELEVATIONS.
- NOTIFY ARCHITECT IMMEDIATELY SHOULD CONDITIONS BE FOUND CONTRADICTORY TO THESE DRAWINGS.
- REFER TO INTERIOR AND/OR EXTERIOR ELEVATIONS FOR LOCATIONS OF CORRIDOR BORROWED-LIGHT WINDOWS AND EXTERIOR CLERESTORY WINDOWS NOT SHOWN ON CLERESTORY PLANS.
- PROVIDE ADEQUATE BACKING SUPPORT AT ALL LOCATIONS WHERE ACCESSORIES OCCUR, INCLUDING PAPER TOWEL DISPENSERS, GRAB BARS, TOILET PAPER DISPENSERS, SOAP DISPENSERS, AND OTHER ITEMS REQUIRING BACKING SUPPORT WHICH ARE TO BE FURNISHED AND/OR INSTALLED BY OWNER OR GENERAL CONTRACTOR.
- PROVIDE HORIZONTAL WOOD BLOCKING IN STUD WALLS FOR MOUNTING CASEWORK. PROVIDE AND ALIGN STUDS WITH SHELF STANDARDS AND/OR PROVIDE ADDITIONAL BLOCKING.
- IN ROOMS WITH FLOOR DRAINS, SLOPE CONCRETE FLOOR SLABS TOWARD FLOOR DRAINS AT 1/8" PER FOOT IN 18" RADIUS AROUND DRAIN.
- ALL INTERIOR DIMENSIONS ARE TAKEN TO FACE OF MASONRY WALLS, FACE OF STUD WALLS OR GRID LINES UNON.
- ALL EXTERIOR DIMENSIONS ARE TO FACE OF STUD, MASONRY OR FOUNDATION.
- ALL ANGLES ARE 90 OR 45 DEGREES IN PLAN UNON.
- ALL CMU IS 6" NOMINAL UNON.
- PROVIDE BULLNOSE BLOCK AT OUTSIDE CORNERS IN CORRIDORS, LOBBIES AND PASSAGEWAYS, AND OTHER LOCATIONS IDENTIFIED ON THE DRAWINGS. BULLNOSE CORNERS SHALL EXTEND FROM FLOOR TO CEILING. USE STANDARD CORNERS ABOVE CEILING.
- ALL STRUCTURAL STEEL STUDS ARE 6" WIDE UNON.
- ALL DRYWALL STUDS ARE 3-5/8" WIDE UNON.
- SEE SHEET A8.1 FOR ENLARGED TOILET FLOOR PLANS, TOILET ACCESSORY SCHEDULE AND FIXTURE MOUNTING HEIGHTS.
- PROVIDE CORNER GUARDS AT OUTSIDE CORNERS OF ALL GYPSUM BOARD AND ABUSE RESISTANT GYPSUM BOARD WALLS. CORNER GUARDS ARE NOT SHOWN ON THE DRAWINGS.
- APPLY SEALANT AT JOINTS BETWEEN ALL INTERIOR CONCRETE SLABS-ON-GRADE AND CONCRETE OR MASONRY WALLS. USE AN EXTERIOR SEALANT FOR THE SLAB. APPLY SEALANT AT ALL CONCRETE SLAB-ON-GRADE CONTROL JOINTS AND AROUND ALL PLUMBING PENETRATIONS.
- AT COMPLETION OF CONSTRUCTION, PATCH ALL NEW AND EXISTING ASPHALT OR CONCRETE PAVING DAMAGED AS A RESULT OF OPERATIONS UNDER THIS CONTRACT.
- GENERAL CONTRACTOR SHALL COORDINATE ALL MECHANICAL, ELECTRICAL AND GENERAL CONSTRUCTION WORK (INCLUDING WALL, FLOOR AND ROOF OPENINGS) SHOWN AT VARIOUS LOCATIONS THROUGHOUT THE DRAWINGS WHETHER OR NOT CROSS-REFERENCED. MECHANICAL AND ELECTRICAL ITEMS MAY OCCUR WHICH ARE NOT SHOWN ON REFLECTED CEILING PLANS OR OTHER ARCHITECTURAL DRAWINGS.
- BLOCK COURSING BEGINS AT ELEVATION 99'-4" WITH AN 8" HIGH STARTER COURSE.
- WHERE DIAGONAL BRACES OCCUR IN STUD WALL PARTITIONS, PROVIDE STEEL STUD TRACK AT TOP AND BOTTOM.
- SEE SHEETS A-7.4 & A-7.5 FOR ENLARGED STAIR PLANS.

### ASSEMBLY NOTES

**FLOORS**

(1) 4" CONCRETE SLAB ON METAL DECK OVER STRUCTURAL STEEL FRAMING

(2) 4" CONCRETE SLAB ON VAPOR BARRIER ON GRAVEL BED ON COMPACTED SUBGRADE

**WALLS**

(W) EXTERIOR CMU WITH LOOSE FILL INSULATION IN ALL UNROUTED CELLS. SOLID GROUT ALL CELLS BELOW FINISHED FLOOR SLAB. SEE SHEETS SD-3.3, A-5.1 AND A-5.2 FOR MASONRY TYPES AND COURSING PATTERNS.

(W2) NOT USED

(W3) 4"x8"x 5/8" GROOVED HARDBOARD SIDING ON FELT UNDERLAYMENT ON 1/2" FIBERBOARD SHEATHING ON 2X4 WOOD STUDS @ 16" O.C. WITH 1/2" OSB INTERIOR PANELS.

(W4) 8" THICK STRUCTURAL PRECAST PANEL, TYPE "A" (NON-INSULATED)

(W5) 8" THICK STRUCTURAL PRECAST PANEL, TYPE "B" (INSULATED)

(W6) 9" THICK STRUCTURAL PRECAST PANEL, TYPE "5" (COMPOSITE/INSULATED)

(W7) SAND-FILLED CMU

(W8) THIN COAT STUCCO SYSTEM OVER FELT UNDERLAYMENT OVER GYPSUM SHEATHING ON 6" STRUCTURAL STUDS WITH BATT INSULATION BETWEEN, AND GB ON INTERIOR FACE.

(W9) LAMINATE GYPSUM BOARD TO WALL

(W10) FURR WALL W/ GYPSUM BOARD ON 2 1/2" METAL STUDS

(W11) GYPSUM BOARD ON EA SIDE OF DOUBLE STUD WALL (6" & 2 1/2" STUDS)

(W12) GYPSUM BOARD ON EACH SIDE OF DOUBLE STUD WALL (3 5/8" EACH)

**ROOFS**

(R1) BALLASTED EPDM ROOFING MEMBRANE OVER R20 RIGID INSULATION OVER METAL ROOF DECK.

(R2) PREFINISHED CORRUGATED METAL ROOFING ON STRUCTURAL STEEL FRAMING. PAINT UNDERSIDE OF PANELS.

(R3) ASPHALT FIBERGLASS SHINGLES ON FELT ON 1/2" OSB ON PREMANUFACTURED TRUSSES.

(R4) STANDING SEAM METAL ROOFING ON FELT ON 3/4" PLYWOOD ON R20 RIGID INSUL. OVER METAL DECK.

(R5) FULLY ADHERED EPDM OVER COVERBOARD ON R20 RIGID INSULATION ON METAL ROOF DECK

(R6) FULLY ADHERED EPDM OVER COVERBOARD ON TAPERED INSULATION ON METAL ROOF DECK

**CEILING**

(C1) REFLECTED CEILING PLAN - AREA "A"

(C2) REFLECTED CEILING PLAN - AREA "B"

(C3) REFLECTED CEILING PLAN - AREA "C"

(C4) REFLECTED CEILING PLAN - AREA "D"

(C5) REFLECTED CEILING PLAN - AREA "E"

(C6) REFLECTED CEILING PLAN - AREA "F"

(C7) REFLECTED CEILING PLAN - AREA "G"

(C8) REFLECTED CEILING PLAN - AREA "H"

(C9) REFLECTED CEILING PLAN - AREA "I"

(C10) REFLECTED CEILING PLAN - AREA "J"

(C11) REFLECTED CEILING PLAN - AREA "K"

(C12) REFLECTED CEILING PLAN - AREA "L"

(C13) REFLECTED CEILING PLAN - AREA "M"

(C14) REFLECTED CEILING PLAN - AREA "N"

(C15) REFLECTED CEILING PLAN - AREA "O"

(C16) REFLECTED CEILING PLAN - AREA "P"

(C17) REFLECTED CEILING PLAN - AREA "Q"

(C18) REFLECTED CEILING PLAN - AREA "R"

(C19) REFLECTED CEILING PLAN - AREA "S"

(C20) REFLECTED CEILING PLAN - AREA "T"

(C21) REFLECTED CEILING PLAN - AREA "U"

(C22) REFLECTED CEILING PLAN - AREA "V"

(C23) REFLECTED CEILING PLAN - AREA "W"

(C24) REFLECTED CEILING PLAN - AREA "X"

(C25) REFLECTED CEILING PLAN - AREA "Y"

(C26) REFLECTED CEILING PLAN - AREA "Z"

(C27) REFLECTED CEILING PLAN - AREA "AA"

(C28) REFLECTED CEILING PLAN - AREA "AB"

(C29) REFLECTED CEILING PLAN - AREA "AC"

(C30) REFLECTED CEILING PLAN - AREA "AD"

(C31) REFLECTED CEILING PLAN - AREA "AE"

(C32) REFLECTED CEILING PLAN - AREA "AF"

(C33) REFLECTED CEILING PLAN - AREA "AG"

(C34) REFLECTED CEILING PLAN - AREA "AH"

### SITE PLAN LEGEND

	PROPERTY BOUNDARY (REFER TO SURVEY)	RO	CONCRETE RUN-OUT 9SEE DETAIL 2/14)
	EXISTING CONTOURS (REFER TO SURVEY)	MH	MANHOLE
	PROPOSED NEW CONTOURS	AD	AREA DRAIN
	SPOT ELEVATION POINT & TYPE (SEE TYPE DESIGNATIONS THIS LEGEND)	EJ	EXPANSION JOINT W/ CAULK (SEE DETAIL 2/12)
	SITE PLAN SPECIFIC NOTE REFERENCE (SEE SPECIFIC NOTE LIST THIS SHEET)	SJ	SCORE JOINT- AS INDICATED (SEE DETAIL 1/12)
	PAVEMENT TYPE/SURFACE TREATMENT (SEE LEGEND LIST THIS SHEET)	IE	INVERT ELEVATION
	NOTE/DETAIL REFERENCE BETWEEN ARROWS	FL	FLOW LINE
	CURB RAMP FOR DISABLED ACCESSIBILITY (SEE DETAIL 1/13)	HPT	HIGH POINT
	CURB TRANSITION AT CURB RAMP (SEE DETAIL 1/13)	LPT	LOW POINT
	TRENCH DRAIN (SEE DETAIL 1/14)	PC	POINT OF CURVATURE
		PT	POINT OF TANGENCY
		CC	CENTER OF CURVATURE
		PCR	POINT OF CURB RADIUS (RETURN)
		AP	ANGLE POINT
		TC	TOP OF CURB
		TP	TOP OF PAVING (CONC / ASPHALT)
		TO	TOP OF GRATE (DRAIN / INLET)
		WP	WORKING POINT
		Q	CENTER LINE
		TOW	TOP OF WALL
		TO	TOP OF "
		ML	MEASURE LINE (TRACK LAYOUT)
		UNO	UNLESS NOTED OTHERWISE

### PAVEMENT SURFACE TREATMENT LEGEND

#### ASPHALT PAVEMENT TYPE/DESCRIPTION:

- 1 3" FULL DEPTH ASPHALT
- 2 4" FULL DEPTH ASPHALT
- 3 5" FULL DEPTH ASPHALT
- 4 6" FULL DEPTH ASPHALT
- 5 6.5" FULL DEPTH ASPHALT

#### CONCRETE PAVEMENT TYPE/DESCRIPTION:

- 1 NOT USED
- 2 6" DEPTH CONCRETE PAVEMENT

### SITE PLAN GENERAL NOTES

1. SITE DIMENSIONS / LAYOUT ARE TO CONTROL POINT, FACE OF CURB/FLOW LINE, EDGE OF SIDEWALKS AND PAVEMENT, OR FACE OF BUILDING FOUNDATION (UNLESS OTHERWISE NOTED).
2. REFERENCE TOPOGRAPHIC SURVEY PREPARED BY CLARK LAND SURVEYING, INC., DATED JANUARY 20, 2006 FOR PROPERTY BOUNDARY DIMENSIONS AND BEARINGS, BENCHMARKS, SITE UTILITIES, EASEMENTS, LEGAL DESCRIPTIONS AND OTHER EXISTING SITE CHARACTERISTICS AND INFORMATION.
3. REFERENCE GEOTECHNICAL ENGINEERING REPORT PREPARED BY KUMAR & ASSOCIATES, INC., DATED FEBRUARY 21, 2006, FOR SOILS INFORMATION AND RECOMMENDATIONS.

### SITE PLAN SPECIFIC NOTES ①

1. CONCRETE CURB AND GUTTER, (1+2/SD-3.1) TYP UNO
2. CONCRETE RAMPED/MOUNTABLE CURB & GUTTER (3/SD-3.1)
3. TAPERED CONCRETE RETAINING WALL.
4. CONCRETE WALK WITH ISOLATION, EXPANSION & CONTRACTION JOINTS AS SHOWN (1/4" PER FOOT MAX. CROSS SLOPE), 8'-0" WIDE (9-12/SD-3.1) UNO.
5. PASSENGER LOADING ZONE: 20'-0"x10'-0" (MIN), 2% MAX. CROSS SLOPE. (21/SD-3.1)
6. CMU SCREEN WALL. (41/SD-3.2 & 3A/A-5.1)
7. CHAIN LINK FENCE, ENCLOSURE, & GATES 10'-0" HIGH UNO (28/SD-3.1 & 20/SD-3.1)
8. CHAIN LINK FIELD FENCE AND GATES, 6'-0" HIGH UNO (20/SD-3.1 & 28/SD-3.1)
9. TRAFFIC CONTROL AND PARKING STRIPING:
  - A - CENTER LINES: 4" WIDE SOLID DOUBLE YELLOW, 3" APART, NOT USED
  - B - LANE LINES: 4" WIDE DASHED WHITE, 10' LONG, 10' GAPS, NOT USED
  - C - CHANNELIZING LINES: 8" WIDE SOLID WHITE
  - D - STOP BARS: 24" WIDE SOLID WHITE
  - E - AUTO PARKING STALL LINES: 4" WIDE SOLID WHITE
  - F - HANDICAP / DISABLED PARKING STALL STRIPING & LOADING AREA LINES 4" WIDE SOLID WHITE PERIMETER & 24" APART AT CROSSHATCH
10. TRAFFIC ARROW GRAPHICS. (25 AND 26/SD-3.1)
11. PEDESTRIAN CROSSWALK STRIPING, 12" WIDE SOLID WHITE, 24" APART, 8'-0" LONG UNO
12. BIKE RACK. 11 BICYCLES PER RACK, TYP. OF 6 (18/SD-3.1)
13. 3" THICK GRAVEL WALK, 8'-0" WIDE UNO.
14. 3-RAIL PEELLED POLE WOOD FENCE (46/SD-3.2).
15. SITE SIGN (22/SD-3.1)
16. ASPHALT CURB (35/SD-3.2)
17. FLAGPOLE (17/SD-3.1)
18. PAINTED HANDICAPPED SYMBOL (27/SD-3.1).
19. PRECAST CONCRETE SPLASH BLOCK.
20. SCOREBOARD POLE (26/SD-3.2).
21. NOT USED.
22. FLUSH CONCRETE EDGE. (6/SD-3.1).
23. BASEBALL BACKSTOP (35/SD-3.1).
24. PRE-CAST CONCRETE BENCH, TYP. OF 4.
25. SOFTBALL BACKSTOP (33/SD-3.1).
26. ACCESSIBLE RAMP (39/SD-3.1)
27. STEEL TRAFFIC GATE (42/SD-3.2).
28. 4" THICK GRAVEL OVER WEED BARRIER FABRIC AROUND EQUIPMENT PADS.
29. ASPHALT PATH, 8'-0" WIDE UNO.
30. SIDEWALK CHASE (34/SD-3.2).
31. BOLLARD, TYP. OF 6, (18/SD-3.1).
32. DUGOUT (39/SD-3.2).
33. CONC. SWALE (13/SD-3.1).
34. NOT USED.
35. COMBINATION SOCCER/FOOTBALL GOAL (8/SD-3.1).
36. PAVEMENT EDGE @ BLEACHER RAMP (7/SD-3.1).
37. MONUMENT SIGN (1/SD-3.2).
38. DOCK STAIR (30/SD-3.2).
39. SITE STAIR (31/SD-3.2).
40. DOCK GUARDRAIL (22/SD-3.2).
41. CONC. STOOP, 72"x60"x4" THICK. ARCHITECT TO COORDINATE EXACT LOCATION.
42. CONC. STOOP, 84"x60"x4" THICK. ARCHITECT TO COORDINATE EXACT LOCATION.
43. CONC. CHASE THROUGH CURB (14/SD-3.2).
44. FIELD CORNER MARKER, TYP. OF FOUR PER SOCCER & SOCCER/FOOTBALL FIELD (17/SD-3.2).
45. 6" TH. REIN. CONC. MECH/ELEC EQUIPMENT PAD TO SUPPORT 100 PSF. CONTRACTOR TO VERIFY PAD SIZE REQUIREMENTS W/EQUIP. MANUFACTURER.
46. INTEGRALLY COLORED CONCRETE.
47. GRAVEL GROUNDCOVER. SEE LANDSCAPE DRAWINGS.
48. TENNIS COURT CONC. CURB (16/SD-3.2 AT TALL CURB CONDITION).
49. FLUSH CURB (4/SD-3.1).
50. RIPRAP SWALE (18/SD-3.2).
51. ROLLED CURB (3/SD-3.1).
52. SOCCER GOAL.
53. COMPACTED RECYCLED COLD BITUMINOUS PAVING, 6" FULL DEPTH, COMPLYING W/ SECTION 406 OF THE COLORADO DEPARTMENT OF TRANSPORTATION STANDARD SPECIFICATIONS FOR ROAD AND BRIDGE CONSTRUCTION, 2005 EDITION.
54. COMPACTED RECYCLED COLD BITUMINOUS PAVING, 3" FULL DEPTH.
55. BLEACHERS, N.I.C.
56. HOME BLEACHERS (9/SD-2.3).
57. VISITOR BLEACHERS (12/SD-2.3).
58. GROUTED COBBLE SWALE (25/SD-3.2).
59. CAST-IN-PLACE CONCRETE SPLASH BLOCK (19/SD-3.2).
60. SHOT PUT PIT SURFACING.
61. PAINTED CURB - RED.
62. PAINTED CURB - YELLOW.

### CONTROL POINT TABLE

POINT#	DESCRIPTION	Position Y	Position X
100	CL @ PROP. LINE	14525.7107	15495.7523
101	AP	14624.9624	15532.5428
102	AP	14685.3497	15585.2820
103	CL @ PROP. LINE	14708.9077	15121.8046
104	AP	14603.1247	15154.4162
105	AP	14790.9672	15189.5653
106	AP	14834.3333	15210.3849
107	AP	14843.5273	15184.5182
108	CL @ PROP. LINE	15971.1008	15164.7353
109	CC	15877.5320	14830.1606
110	CC	15871.5544	14837.2592
111	CC	16648.9087	14980.5402
112	CL/WP	15934.9087	15215.8006
113	CL END DRIVE	15813.9087	15215.8006
114	CL/PY	15934.9087	15939.9539
115	CC	15860.9087	15538.7439
116	CL/PY	15860.9087	15613.9539
117	AP	15871.8929	15777.4348
118	AP	15871.8929	15897.4348
119	AP	15831.8929	15897.4348
120	AP	15831.8929	15897.4348
121	AP	15398.8553	15798.3057
122	AP	15400.2254	15976.0110
123	AP	15762.5874	16094.4259
124	AP	15656.2988	16326.3191
125	AP	15608.6883	16304.2518
126	AP	15922.8971	16538.4295
127	AP	15184.3129	16300.8407
128	AP	15290.3815	16158.9475
129	AP	15352.5071	16180.1348
130	AP	15444.0826	15948.8416
131	CC	14946.2129	16230.7465
132	PC	15186.2129	16230.7465
133	PC	15292.8971	16421.2791
134	CC	14913.5080	16237.6091
135	PC	14986.5182	16315.7842
136	PC	14837.3175	16211.8831
137	FOUL POLE	14809.4842	16373.2261
138	FOUL POLE	14279.4642	16042.5061
139	CC	14530.2624	16121.6879
140	CC	14621.9251	15882.4151
141	FOUL POLE	14385.7885	15925.3595
142	FOUL POLE	14578.1807	15846.2880
143	PT @ PROP. LINE	15309.8442	14861.6929
144	PT	15309.4091	14868.3170
145	PT	15279.4011	14877.4364
146	PC	15231.7523	14861.3636
147	CC	15288.3926	15021.0283
148	CC	15160.8469	15074.2628
149	CC	15179.4091	14876.1769
150	CC	15218.5450	15247.8618
151	CC	15509.4091	14885.2149
152	WP	15228.3926	15090.3103
153	WP	15178.3926	15090.3103
154	PC	15323.1248	15150.9160
155	PT	15352.9536	15083.7766
156	CC	15352.5071	15123.1741
157	CC	15363.3140	15137.1745
158	PC	15312.6893	15075.2298
159	PC	15370.4673	15057.4849
160	AP/CORNER	15279.8802	15075.8952
161	AP/CORNER	15421.8368	15075.3539
162	PC	15381.1588	15024.7264
163	PC	15349.5351	15005.3827
164	CC	15391.2565	14972.8972
165	AP/CORNER	15361.4091	14987.8897
166	PC/CORNER	15361.4091	14888.8516
167	PC/CORNER	15427.2923	15006.1894
168	WP/CL	15403.8526	15041.8947
169	PC	15625.9087	15050.0280
170	WP/CL	15638.1028	15024.2246
171	PC/CORNER	15607.5042	14982.8615
172	PC/CORNER	15686.6287	14984.3763
173	AP/CORNER	15673.8300	14984.1065
174	CC	15673.3459	14984.7342
175	CL @ PROP. LINE	15680.8396	14940.6020
176	CC	15785.0383	15257.8339
177	CC	15785.0383	15667.4539
178	WP/CL	15531.5778	15448.3638
179	PC	15280.3474	15580.6254
180	PC	15240.3474	15588.6254
181	WP/CL	15312.4091	15613.3539
182	WP	15139.9832	15697.4539
183	WP	15107.9832	15697.4539
183A	CC	15098.5310	15677.4539
184	WP/CL DRIVE	15103.9832	15697.4539
185	PT	14881.5755	15697.4539
186	PT	14791.4008	15670.5759
187	WP/CL	14805.1675	15662.3495
188	CC	14881.5755	15497.4539
189	PT	15006.3021	15559.8973
190	PT	15099.5310	15527.4539
191	PT/WP	14944.5090	15551.9152
192	WP	14983.1798	15515.6118
193	PT/WP	14971.4091	15486.2717
194	CC	14600.4091	15498.7173
195	BLDG LAYOUT POINT	15092.8254	15478.6351
196	WP	14985.4091	15346.7683
197	WP/CL	14971.4091	15273.3588
198	PT	15010.4801	15327.8177
199	CC	15020.4091	15285.0290
200	PT	15083.5873	15248.7308
201	AP/CORNER	14951.2761	15257.8957
202	AP/CORNER	14939.2155	15223.0168
203	AP/CORNER	14995.4744	15125.5753
204	CL/CL FIELD	15035.9832	15658.5262
205	CC/MEASURE LINE	14879.5262	20938.5262
206	CC WALK	14879.5262	20938.5262
207	AP/CORNER	14855.9832	16038.5262
208	AP/CORNER	14855.9832	15878.5262
209	AP/CORNER	15215.9832	15878.5262
210	CC/MEASURE LINE	15191.2767	15858.5262
211	AP/CORNER	15215.9832	16038.5262
212	WP	14813.7131	15692.4858
213	PT	14881.5377	20771.2195
214	WP	14786.9214	15877.4539
215	WP	14718.2317	15883.3699
216	WP	14881.6491	15898.5174
217	AP/FIRST BASE	14811.1890	15823.3838
218	AP/SECOND BASE	14552.1574	15834.1195
219	AP/THIRD BASE	14562.8035	15893.1512
220	CC/INFIELD	14584.1030	15856.2333
221	AP/HOME PLATE	14621.9251	15882.4151
222	AP	14842.4048	15922.1354
223	AP	14852.0823	15946.8428
224	AP	14852.0823	15970.5095
225	AP	14832.7657	15899.5061
226	AP/HOME PLATE	14809.4842	16042.5061
227	AP/FIRST BASE	14519.4642	16042.5061
228	AP/SECOND BASE	14519.4642	16132.5061
229	AP/THIRD BASE	14609.4642	16132.5061
230	CC INFIELD	14566.8842	16085.2890
231	CC	14567.7449	16084.2254
232	WP	14674.3331	21007.3357
233	PC/WP	14718.2337	21003.7859
234	BLDG LAYOUT POINT	14722.2050	20958.5262
235	WP	14804.2024	15882.0408
236	WP	14837.8888	15915.5272
237	WP	14837.8888	16001.5271
238	WP	14804.2024	16035.0115
239	CC	14790.4866	20941.5283
240	CC	14787.3939	20950.3399
241	CC	14787.3939	20961.2125
242	CC	14790.4866	15975.5262
243	PT	14861.5377	21145.8377
244	SW PROP. CORNER	14824.8965	14782.5989
245	PT	15309.4091	14885.2149
246	PT	15274.5024	14884.0696
247	CC	15277.4331	15002.8338
248	CC	15318.8900	15027.8561

© Copyright 2006 The LKA Partners, Inc. This document and the information contained herein may not be reproduced or excerpted from without the express written permission of The LKA Partners, Inc. Unauthorised copying, disclosure or construction use are prohibited by copyright law.

**New Falcon High School**  
Falcon, Colorado 80831



**Falcon School District 49**  
10850 E. Woodmen Road  
Falcon, Colorado 80831


### Construction Documents Bid Package D

Drawn: FK  
Checked: JSC  
Issued: August 10, 2006  
Revised:

### SITE DEVELOPMENT NOTES & LEGENDS

Scale: AS INDICATED  
**SD-2.0**  
New Falcon High School Project No. 03-021  
The LKA Partners Incorporated

Limits of School Expansion

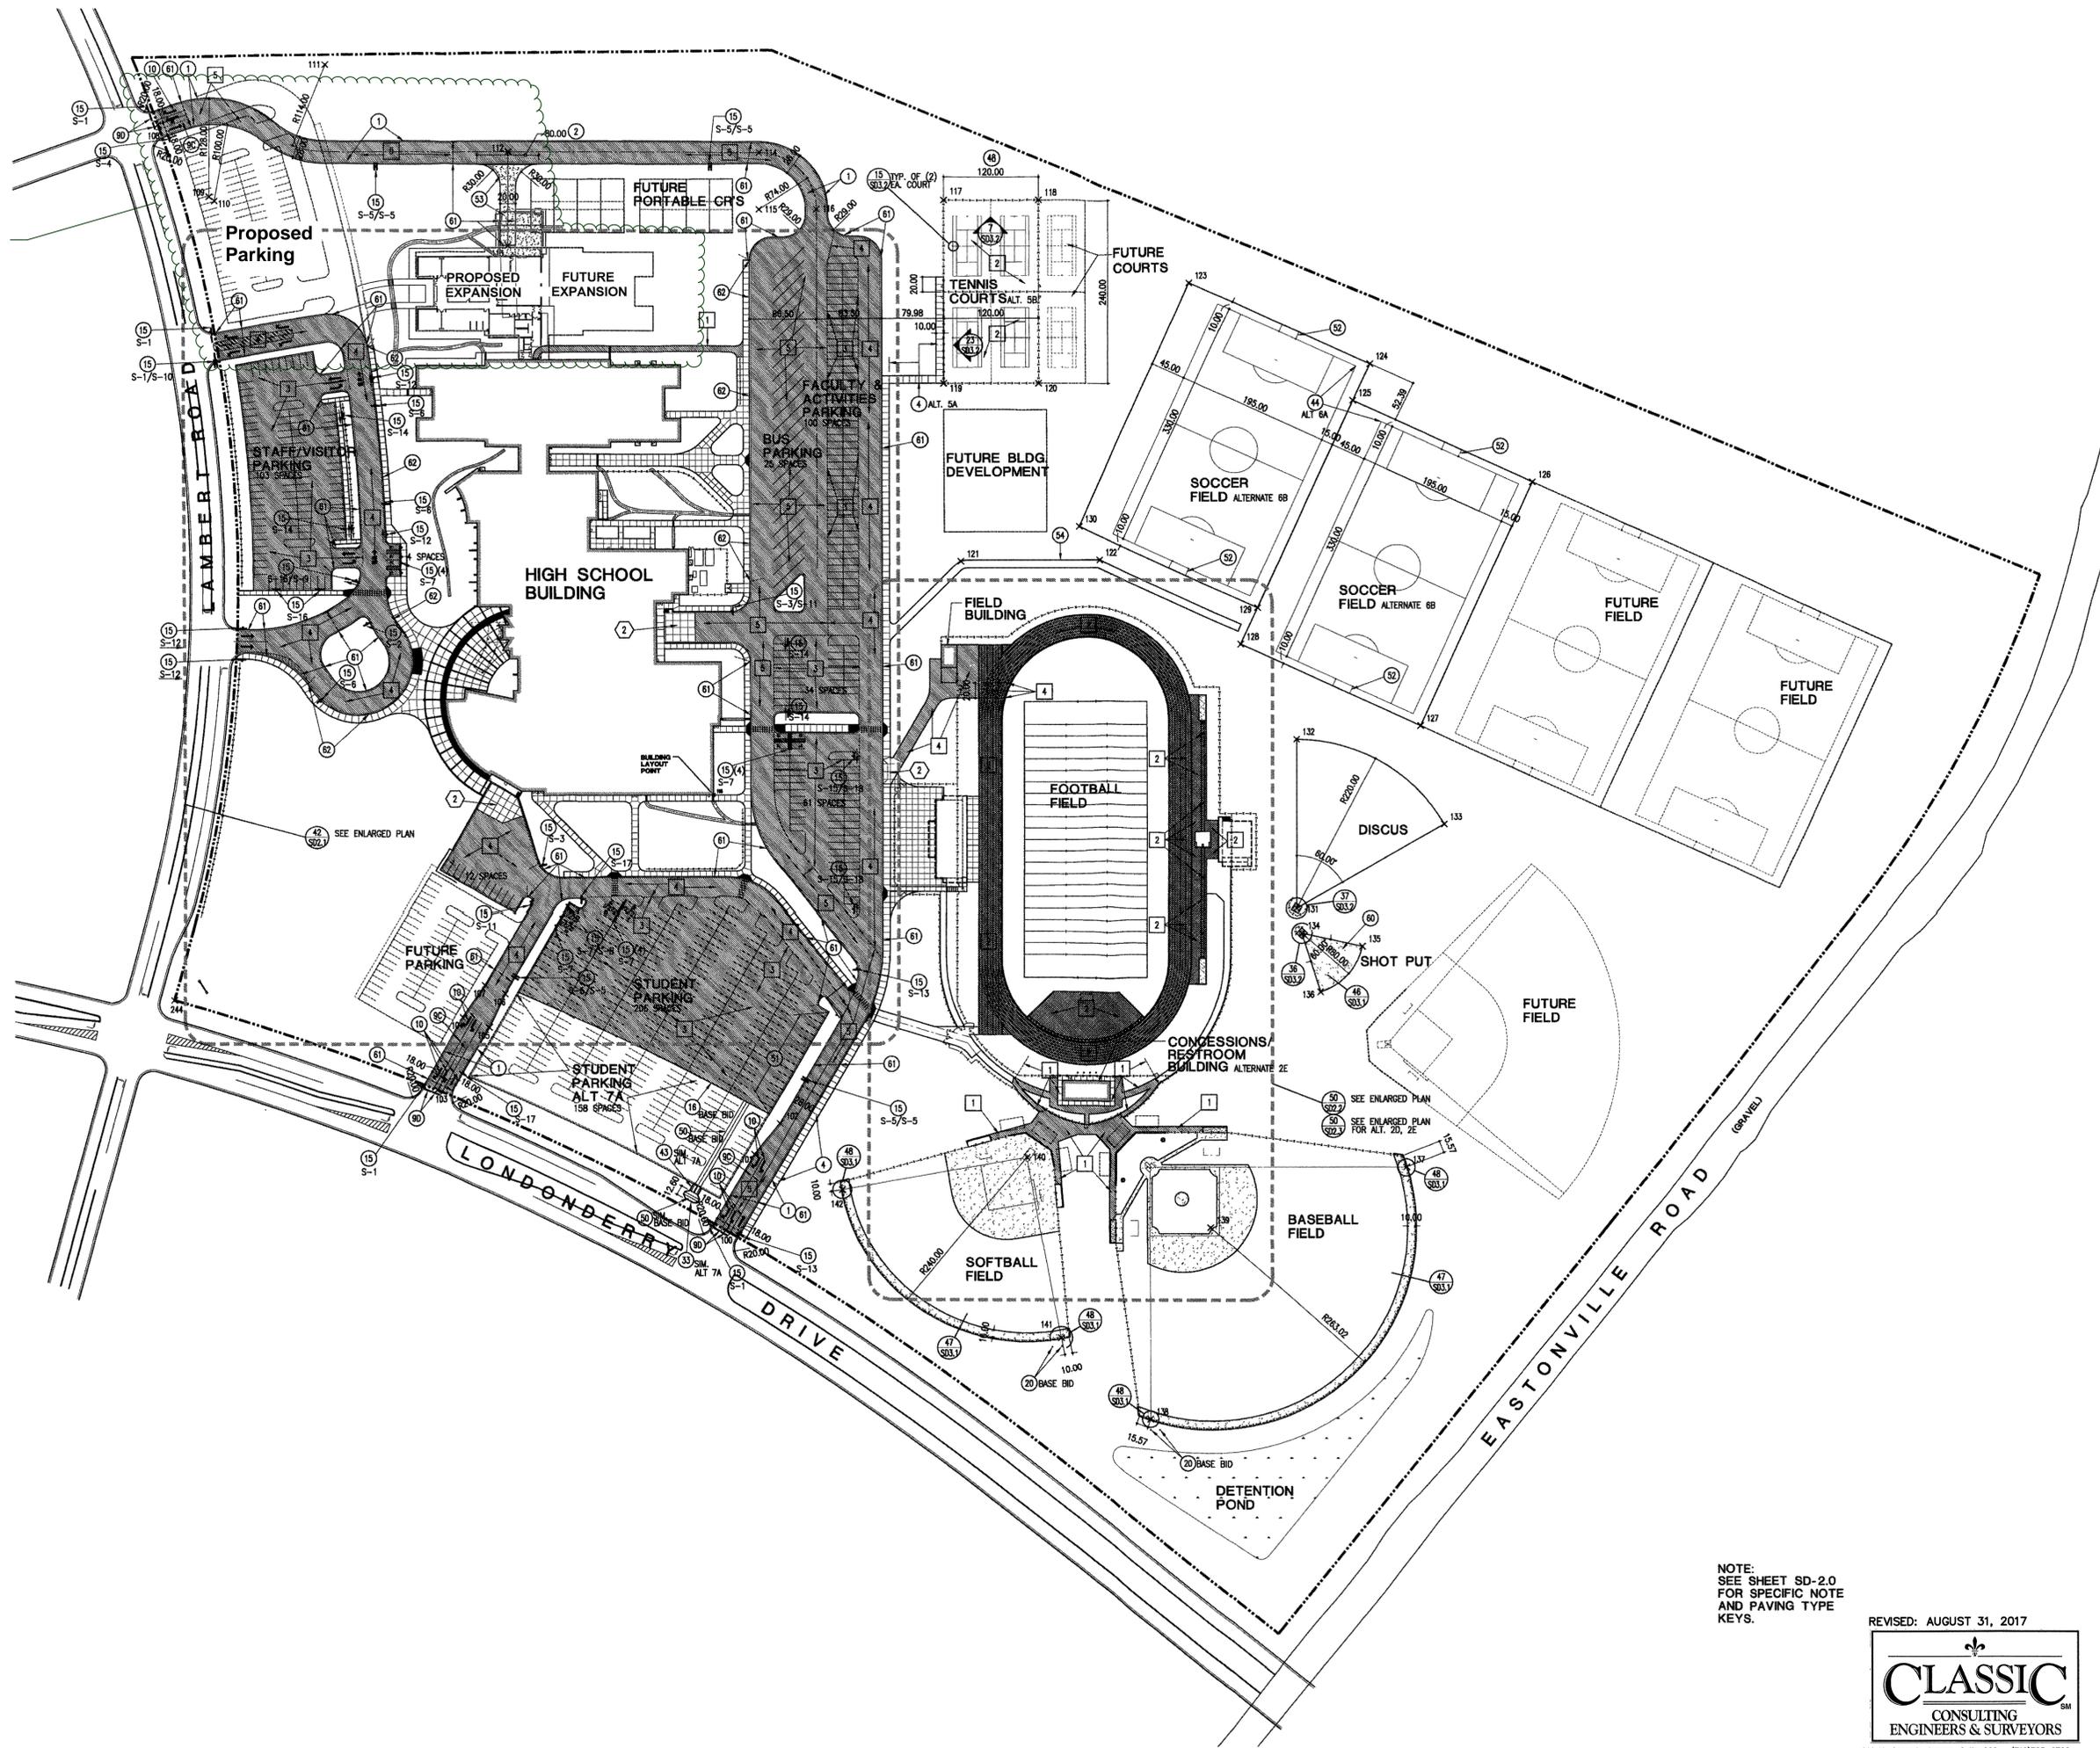

© Copyright 2006 The LKA Partners, Inc. This document and the information contained herein may not be reproduced or excerpted from without the express written permission of The LKA Partners, Inc. Unauthorised copying, disclosure or construction use are prohibited by copyright law.

**New Falcon High School**  
 Falcon, Colorado 80831



Falcon School District 49  
 10850 E. Woodmen Road  
 Falcon, Colorado 80831

**Construction Documents Bid Package D**

Drawn: LKA  
 Checked: JSC  
 Issued: August 10, 2006  
 Revised:

NOTE:  
 SEE SHEET SD-2.0  
 FOR SPECIFIC NOTE  
 AND PAVING TYPE  
 KEYS.

REVISED: AUGUST 31, 2017



619 N. Cascade Avenue, Suite 200 (719)785-0790  
 Colorado Springs, Colorado 80903 (719)785-0789(Fax)


**Site Development Plan**

Scale: AS NOTED

**SD-2.1**

New Falcon High School Project No. 03-021  
 The LKA Partners Incorporated



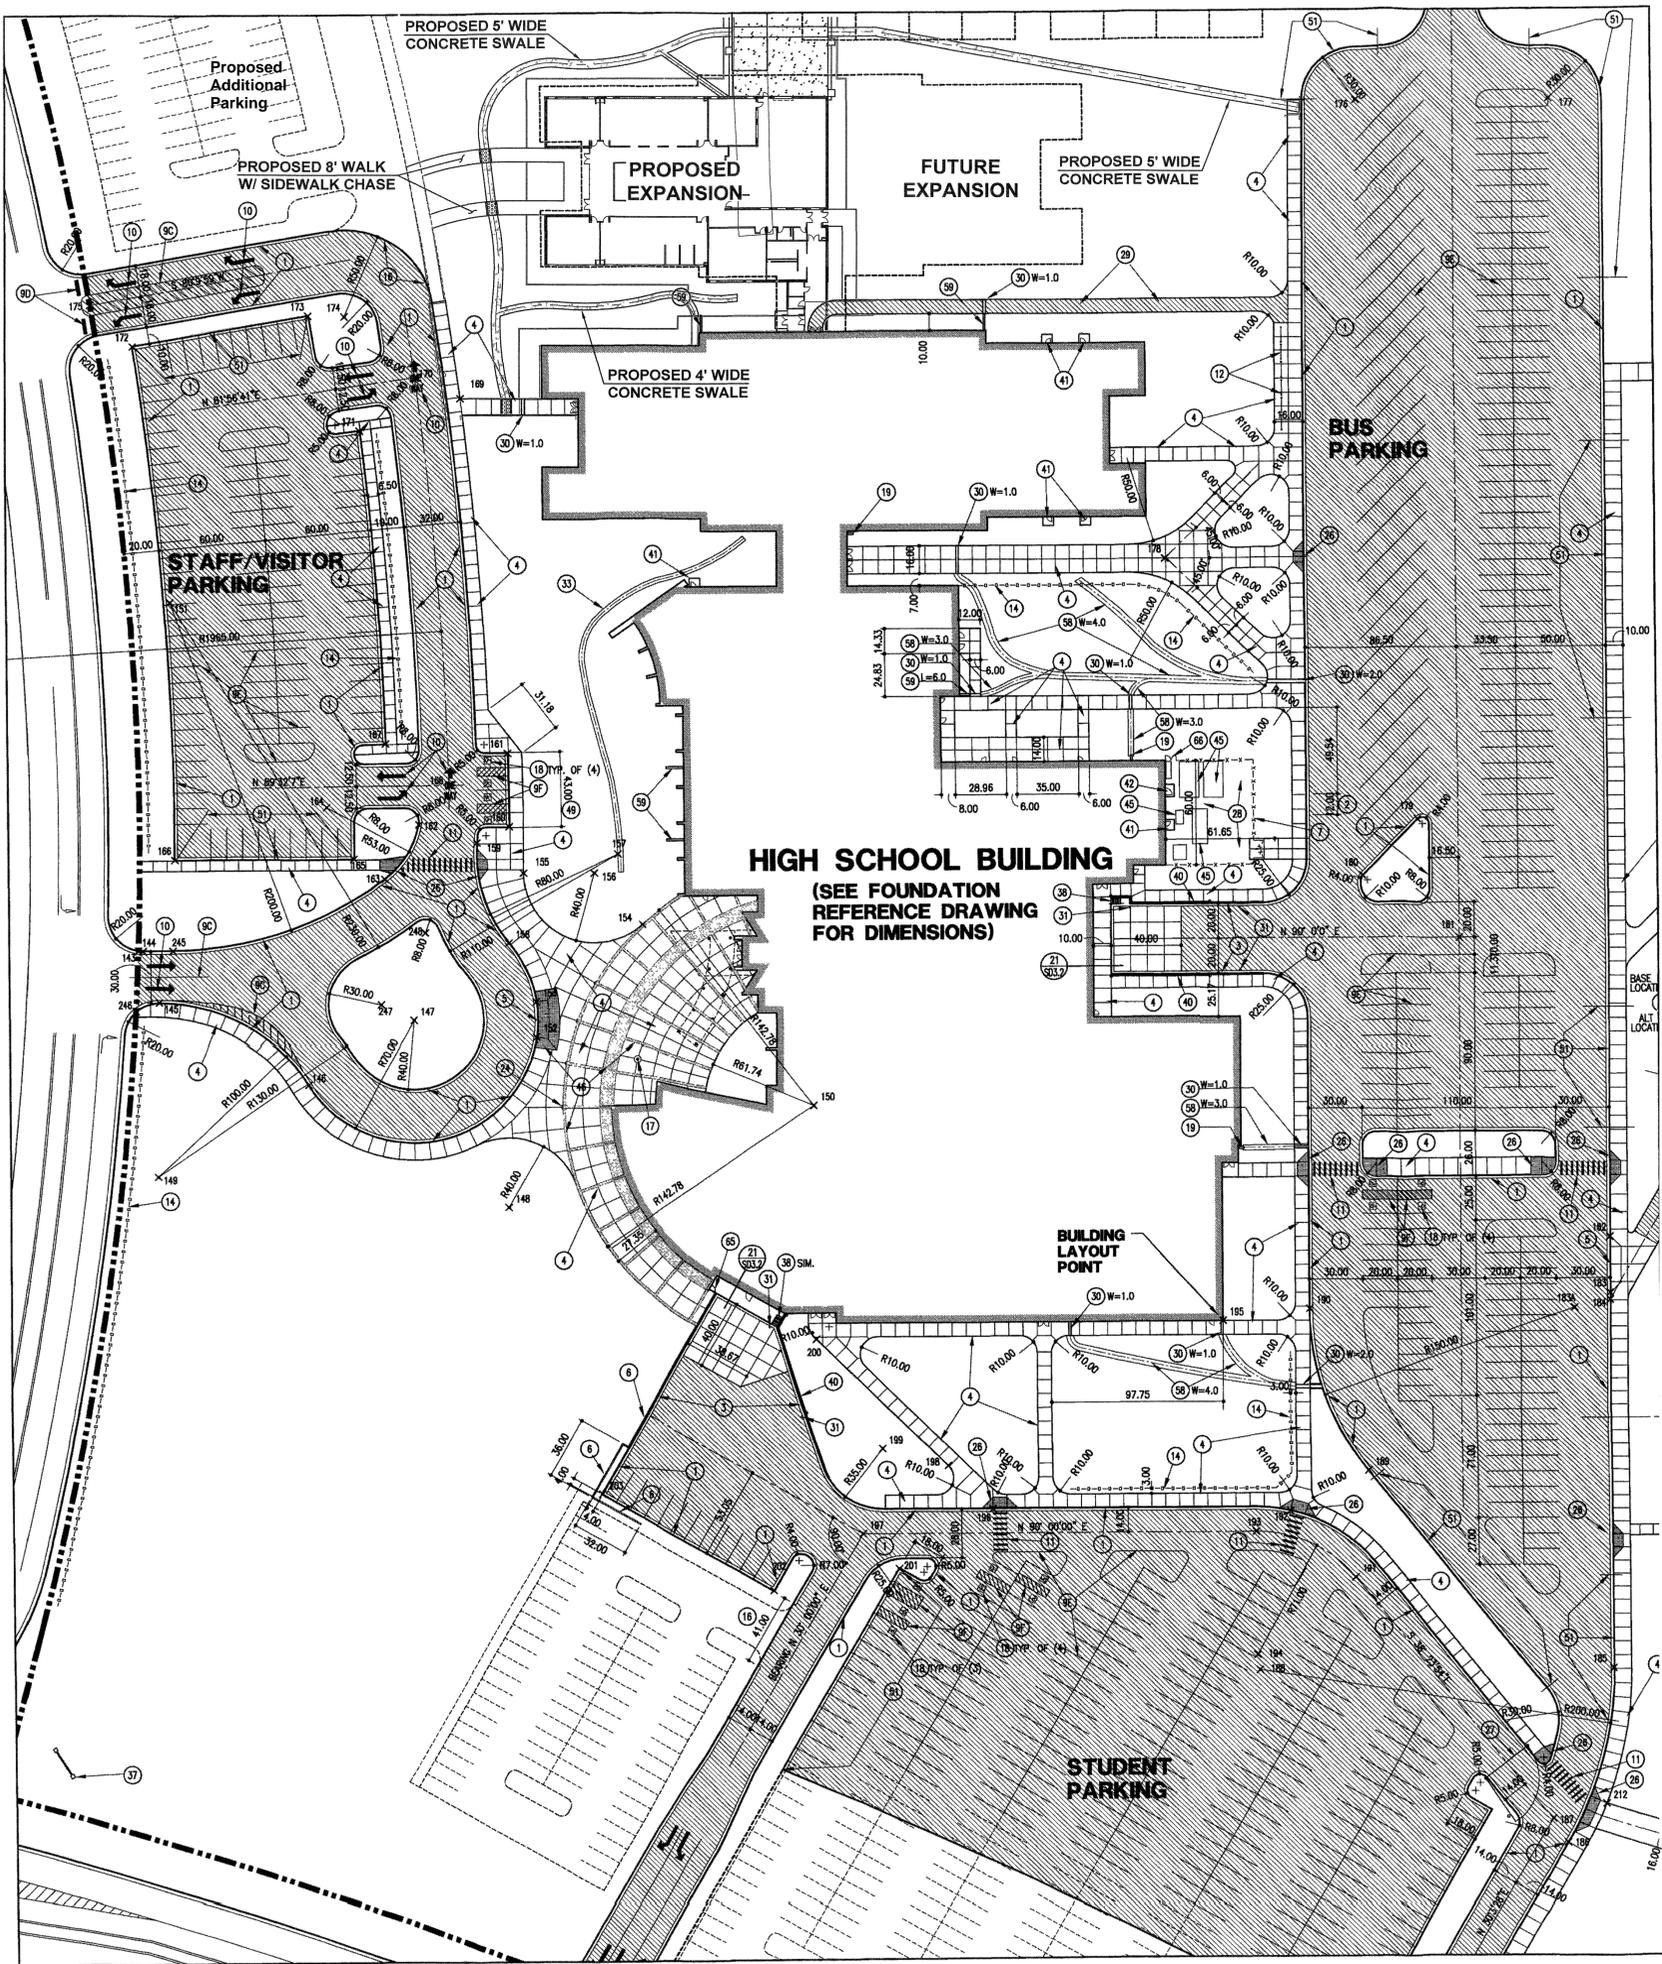

42 ENLARGED PLAN  
SCALE: 1" = 40'-0"

© Copyright 2006 The LKA Partners, Inc. This document and the information contained herein may not be reproduced or transmitted in any form or by any means, electronic, mechanical, photocopying, recording, or by any information storage and retrieval system, without the prior written permission of The LKA Partners, Inc. Unauthorized copying, disclosure or construction use are prohibited by copyright law.

**New Falcon High School**  
Falcon, Colorado 80831



Falcon School District 49  
10850 E. Woodmen Road  
Falcon, Colorado 80831  
**Construction Documents Bid Package D**

Drawn: JI  
Checked: JSC  
Issued: August 10, 2001  
Revised:

Enlarged Site Plan

REVISED: AUGUST 31, 2017



619 N. Cascade Avenue, Suite 200 (719)785-0790  
Colorado Springs, Colorado 80903 (719)785-0799(Fax)

Scale: As Noted

**SD-2.2**

New Falcon High School Project No. 03-02  
The LKA Partners Incorporate



NORTH

© Copyright 2006 The LKA Partners, Inc. This document and the information contained herein may not be reproduced or accepted from without the express written permission of The LKA Partners, Inc. Unauthorized copying, disclosure or construction use are prohibited by copyright law.

**New Falcon High School**  
 El Paso County, Colorado 80831



Falcon School District 49  
 10850 E. Woodmen Road  
 Falcon, Colorado 80831

**Construction Documents  
 Bid Package A  
 Site Grading**

Drawn: LKA

Checked: JC

Issued: April 13, 2006

Revised: 1 MO-1 May 25, 2006

2 FO-2 June 12, 2006

3 MO-2 June 30, 2006

4 FO1 Aug 23, 2006

REVISED: AUGUST 31, 2017



619 N. Cascade Avenue, Suite 200 (719) 785-0790  
 Colorado Springs, Colorado 80903 (719) 785-0799(Fax)

**EROSION CONTROL LEGEND**

SEDIMENT FENCING W/ STAKING (REFERENCE DETAIL 25/T-1)	SF	SF
STRAW BALE SEDIMENT CONTROL W/ STAKING (REFERENCE DETAIL 17/T-1)	SB	
VEHICLE TRACKING CONTROL (VTC) 6" DEPTH OF 1.5" TO 3" DIA. ROCK (TO BE INSTALLED ONLY IF OFFSITE ROAD IS PAVED)	VTC	
INLET PROTECTION	IP	
GRASS SWALE	GS	

**EROSION CONTROL NOTES**

- SEE LANDSCAPE PLAN FOR SLOPE PROTECTION.
- INLET PROTECTION TO BE PROVIDED AT ALL PROPOSED INLETS. MORE OR FEWER MAY BE REQUIRED DEPENDING ON FINAL NUMBER OF INLETS SHOWN ON FINAL UTILITY PLAN.
- TOPSOIL STOCKPILE MAY REQUIRE RELOCATION PER CONTRACTOR'S REQUIREMENTS.
- OWNER/CONTRACTOR SHALL BE RESPONSIBLE FOR OBTAINING ALL REQUIRED FEDERAL, STATE, COUNTY, AND DUST CONTROL PERMITS.


**NOTE:**

EROSION CONTROL DESIGN BY TERRA NOVA ENGINEERING, INC.

**Site Grading Plan**

Scale: 1" = 80'


**SD-11**  
 New Falcon High School Project No. 03-021  
 The LKA Partners Incorporated

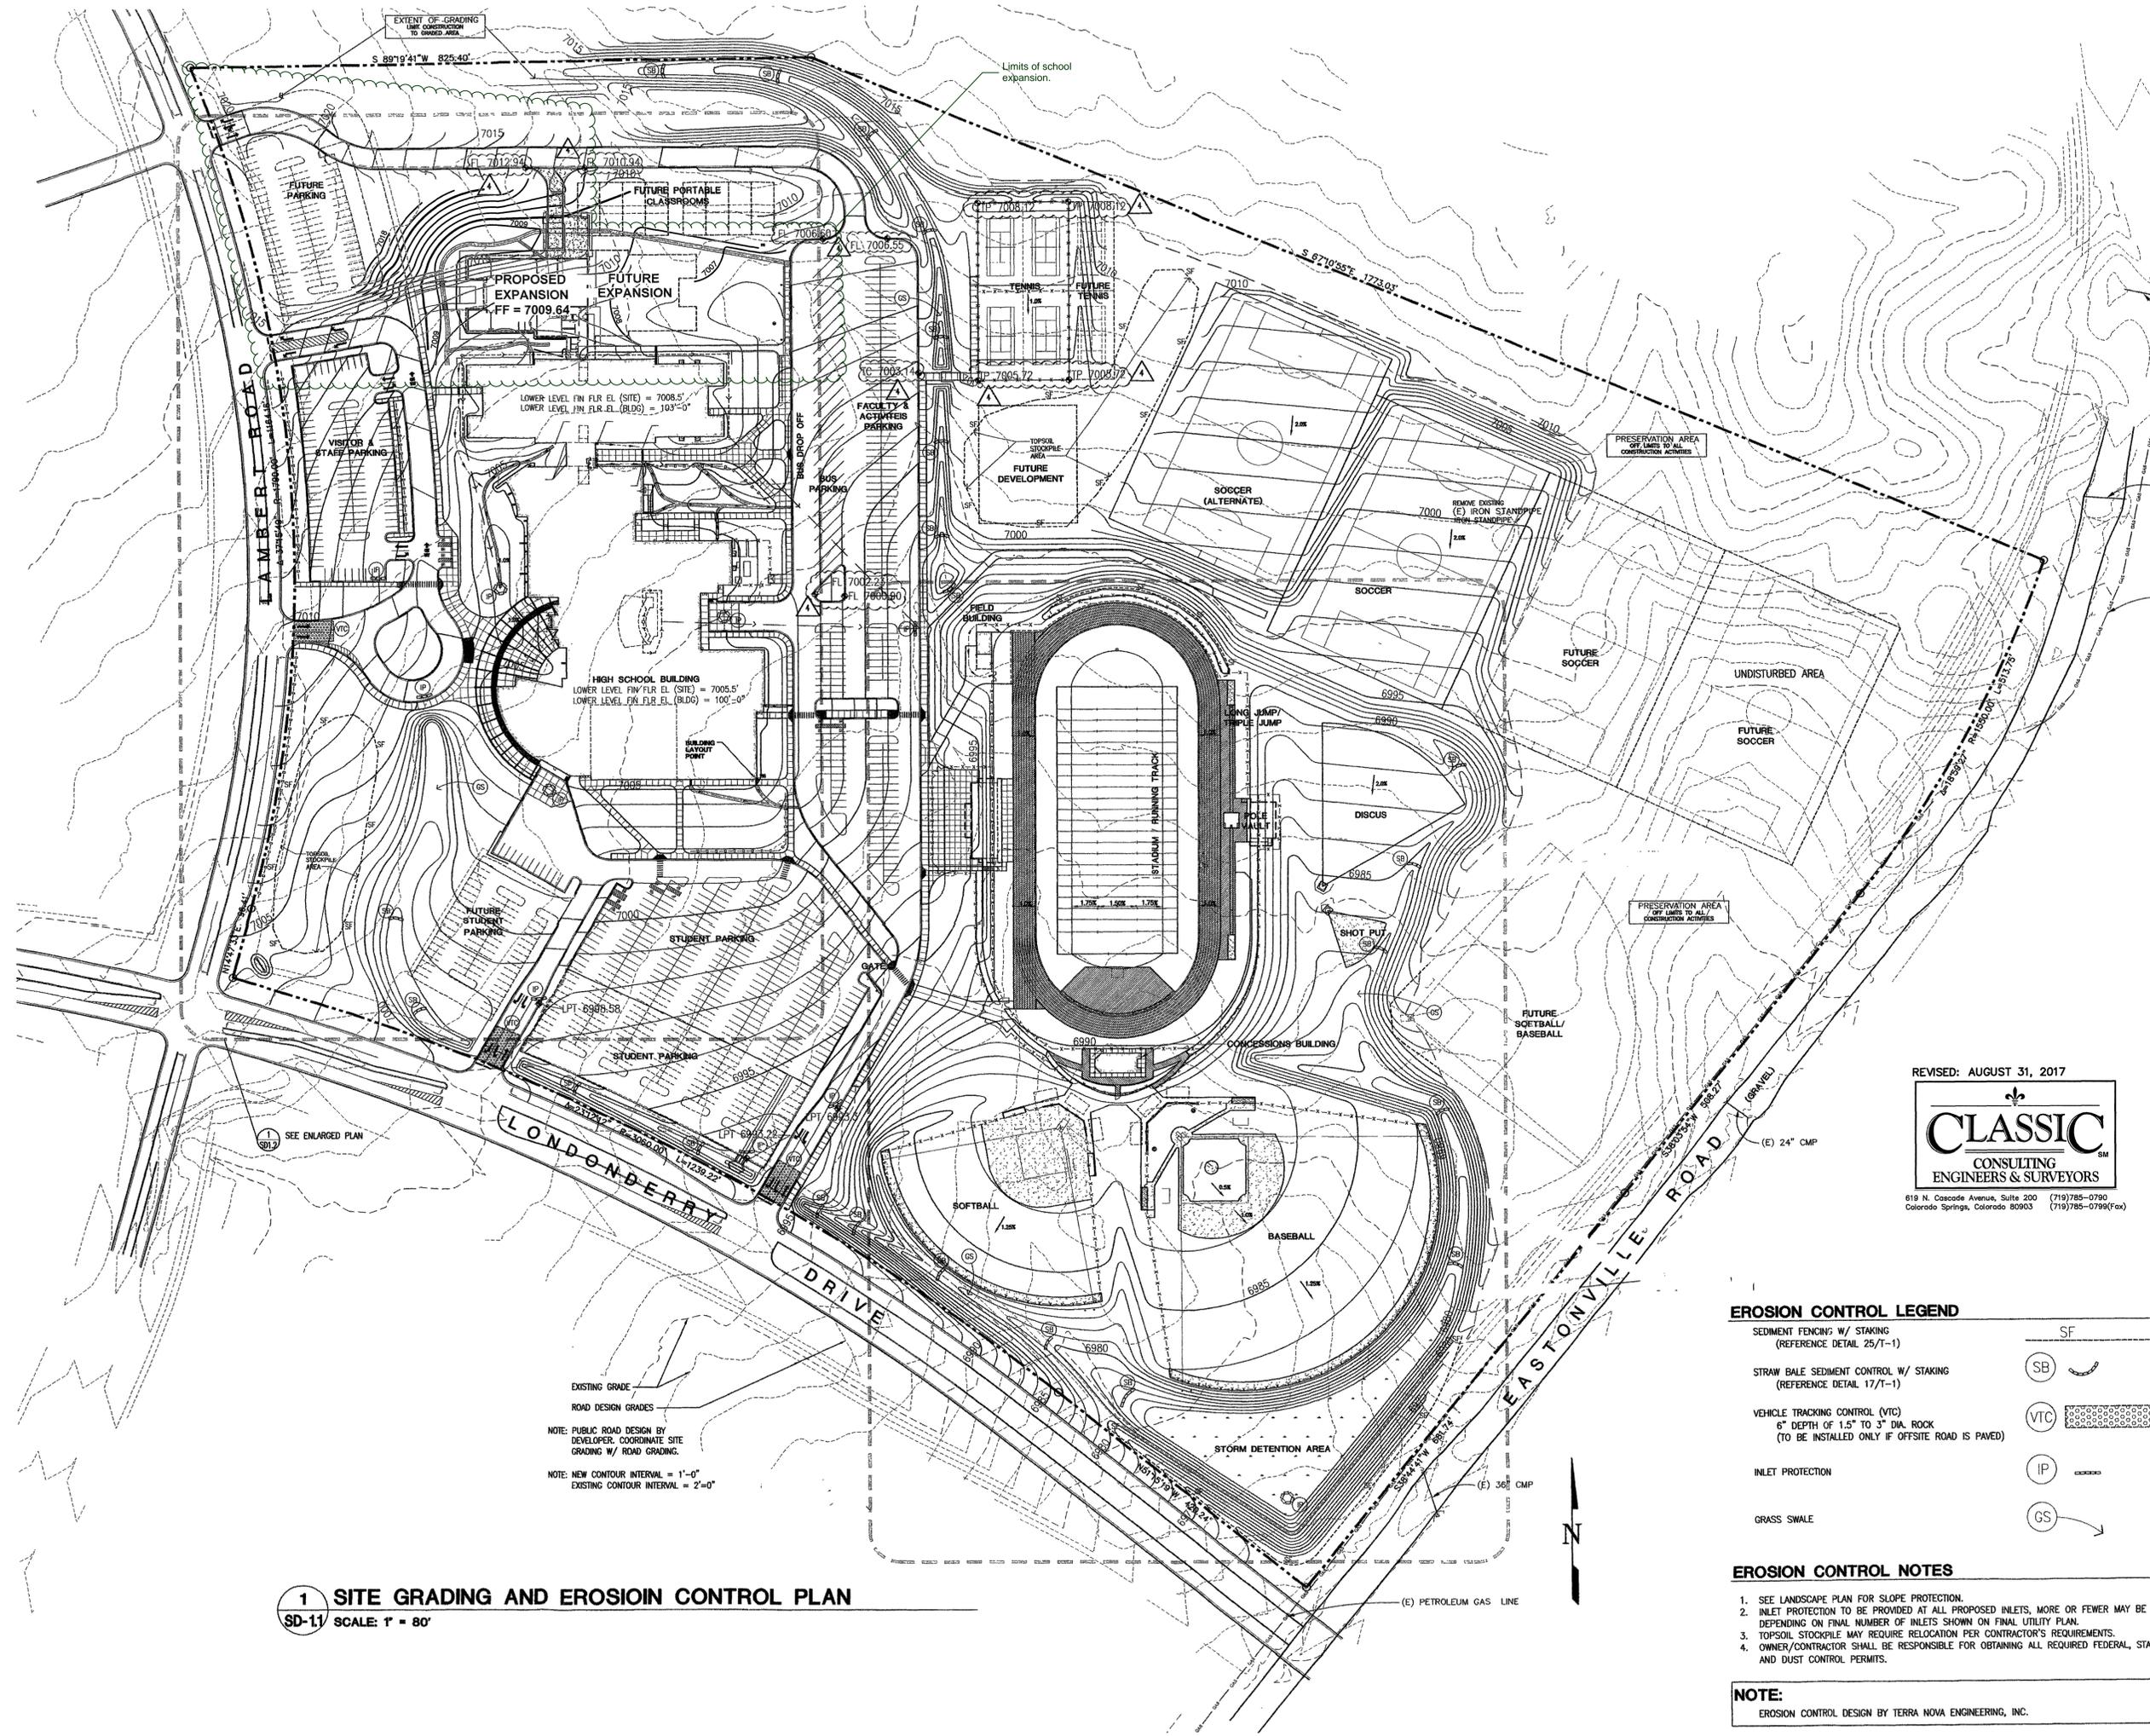

**1 SITE GRADING AND EROSION CONTROL PLAN**  
 SD-11 SCALE: 1" = 80'

EXISTING GRADE  
 ROAD DESIGN GRADES  
 NOTE: PUBLIC ROAD DESIGN BY DEVELOPER. COORDINATE SITE GRADING W/ ROAD GRADING.  
 NOTE: NEW CONTOUR INTERVAL = 1'-0"  
 EXISTING CONTOUR INTERVAL = 2'-0"



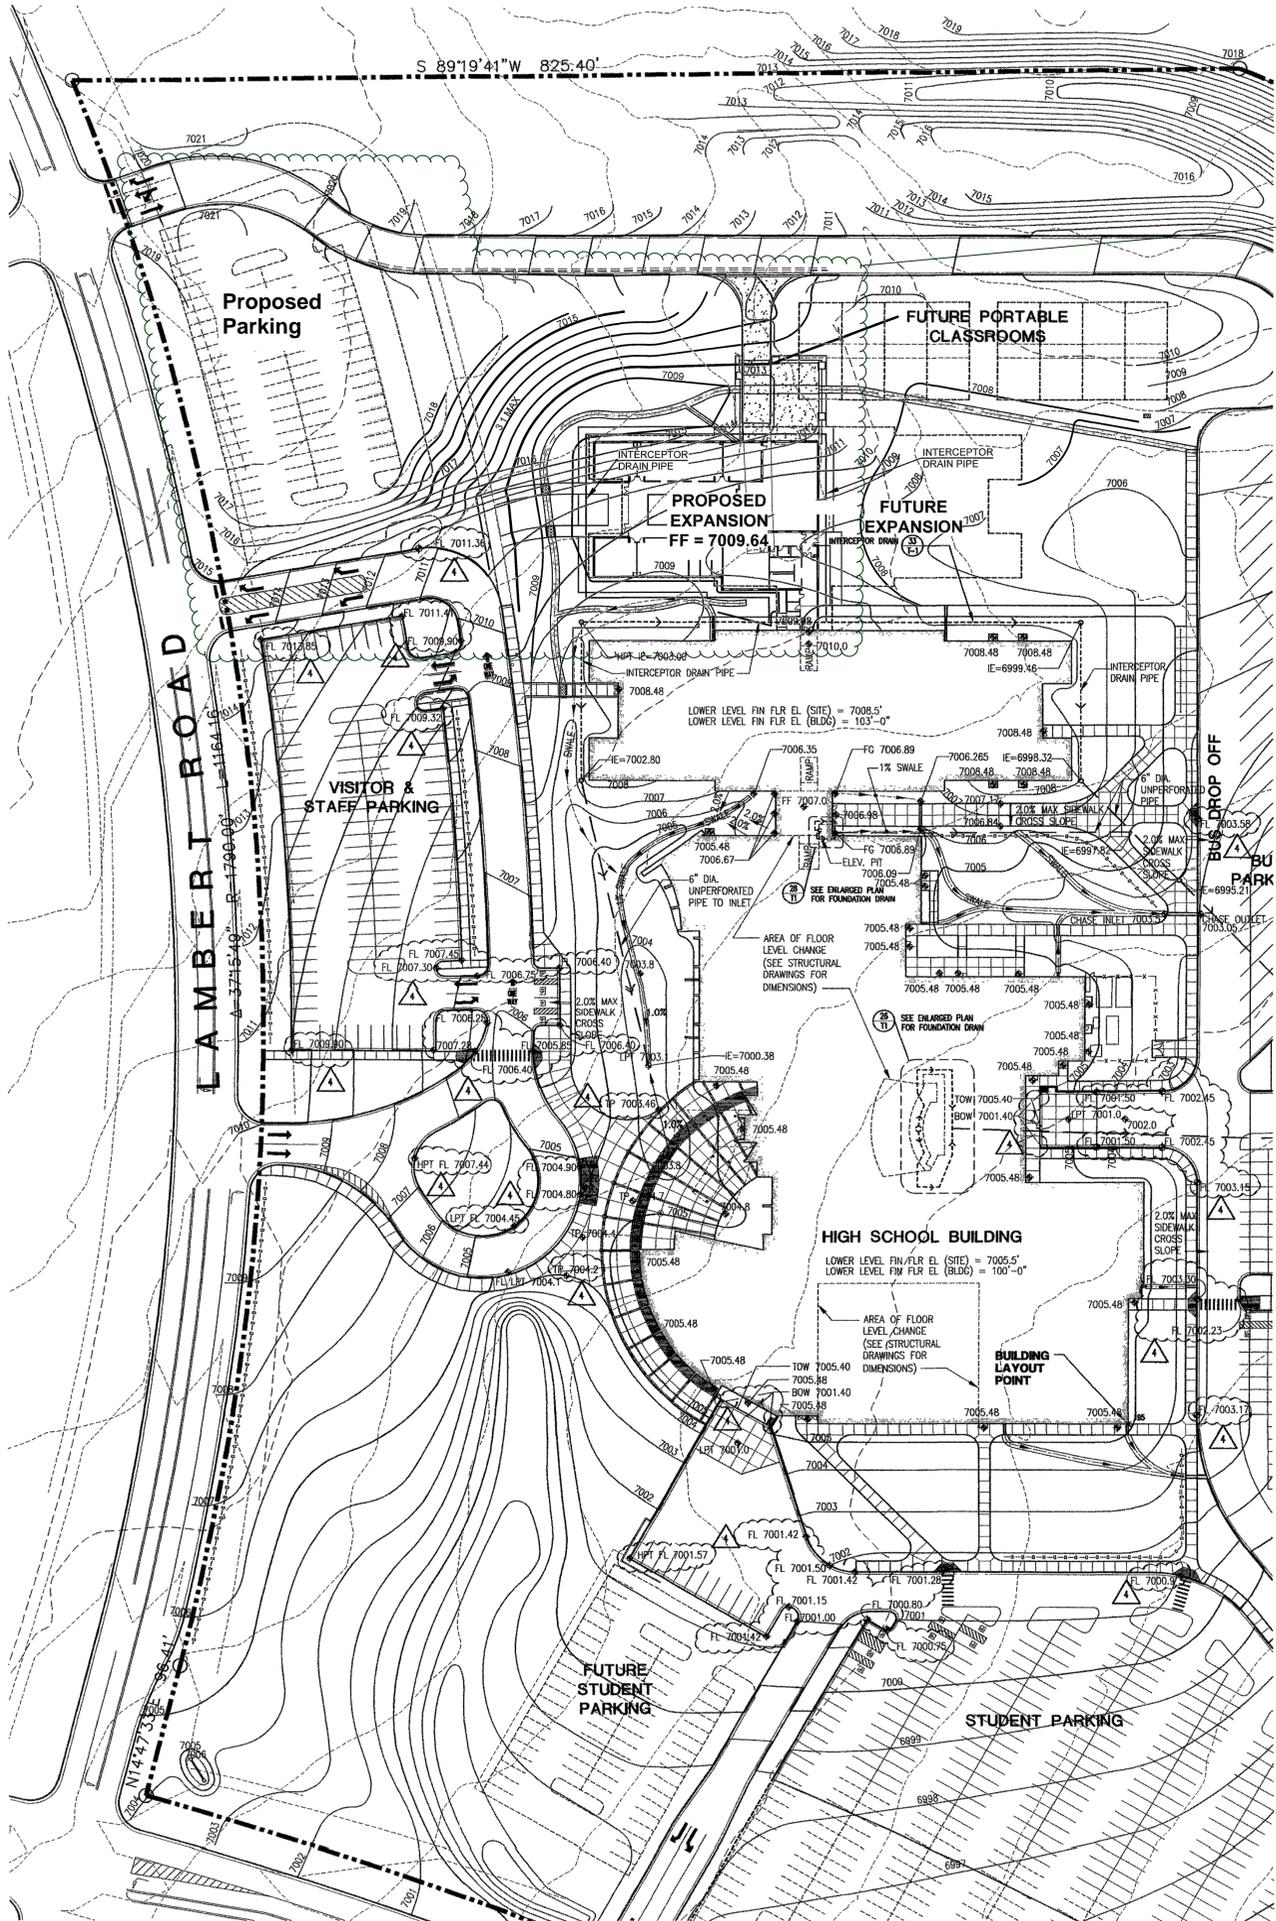

Limits of School Expansion

**1 ENLARGED SITE GRADING PLAN**  
 SD-12 SCALE: 1" = 50'

© Copyright 2006 The LKA Partners, Inc. This document and the information contained herein may not be reproduced or accepted from without the express written permission of The LKA Partners, Inc. Unauthorized copying, disclosure or construction use are prohibited by copyright law.

**New Falcon High School**  
 El Paso County, Colorado 80831



**Falcon School District 49**  
 10850 E. Woodmen Road  
 Falcon, Colorado 80831

**Construction Documents Bid Package A Site Grading**

Drawn: LKA  
 Checked: JC  
 Issued: April 13, 2006  
 Revised: MO-1 May 25, 2006  
 FO-2 June 12, 2006  
 MO-2 June 30, 2006  
 FO-11 Aug 23, 2006

CMP


**Enlarged Site Grading Plan**

Scale: 1" = 50'  
**SD-12**  
 New Falcon High School Project No. 03-021  
 The LKA Partners Incorporated

C:\Revit\37-17109-00\_LAR\_FalconsAddn\_2016.dwg  
3/23/2017 4:46:43 PM


LANDSCAPE PLAN  
SCALE: 1"=30'-0"

1  
LS-1.1 | L1.0

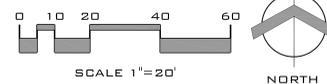

SCALE 1"=20'

NORTH

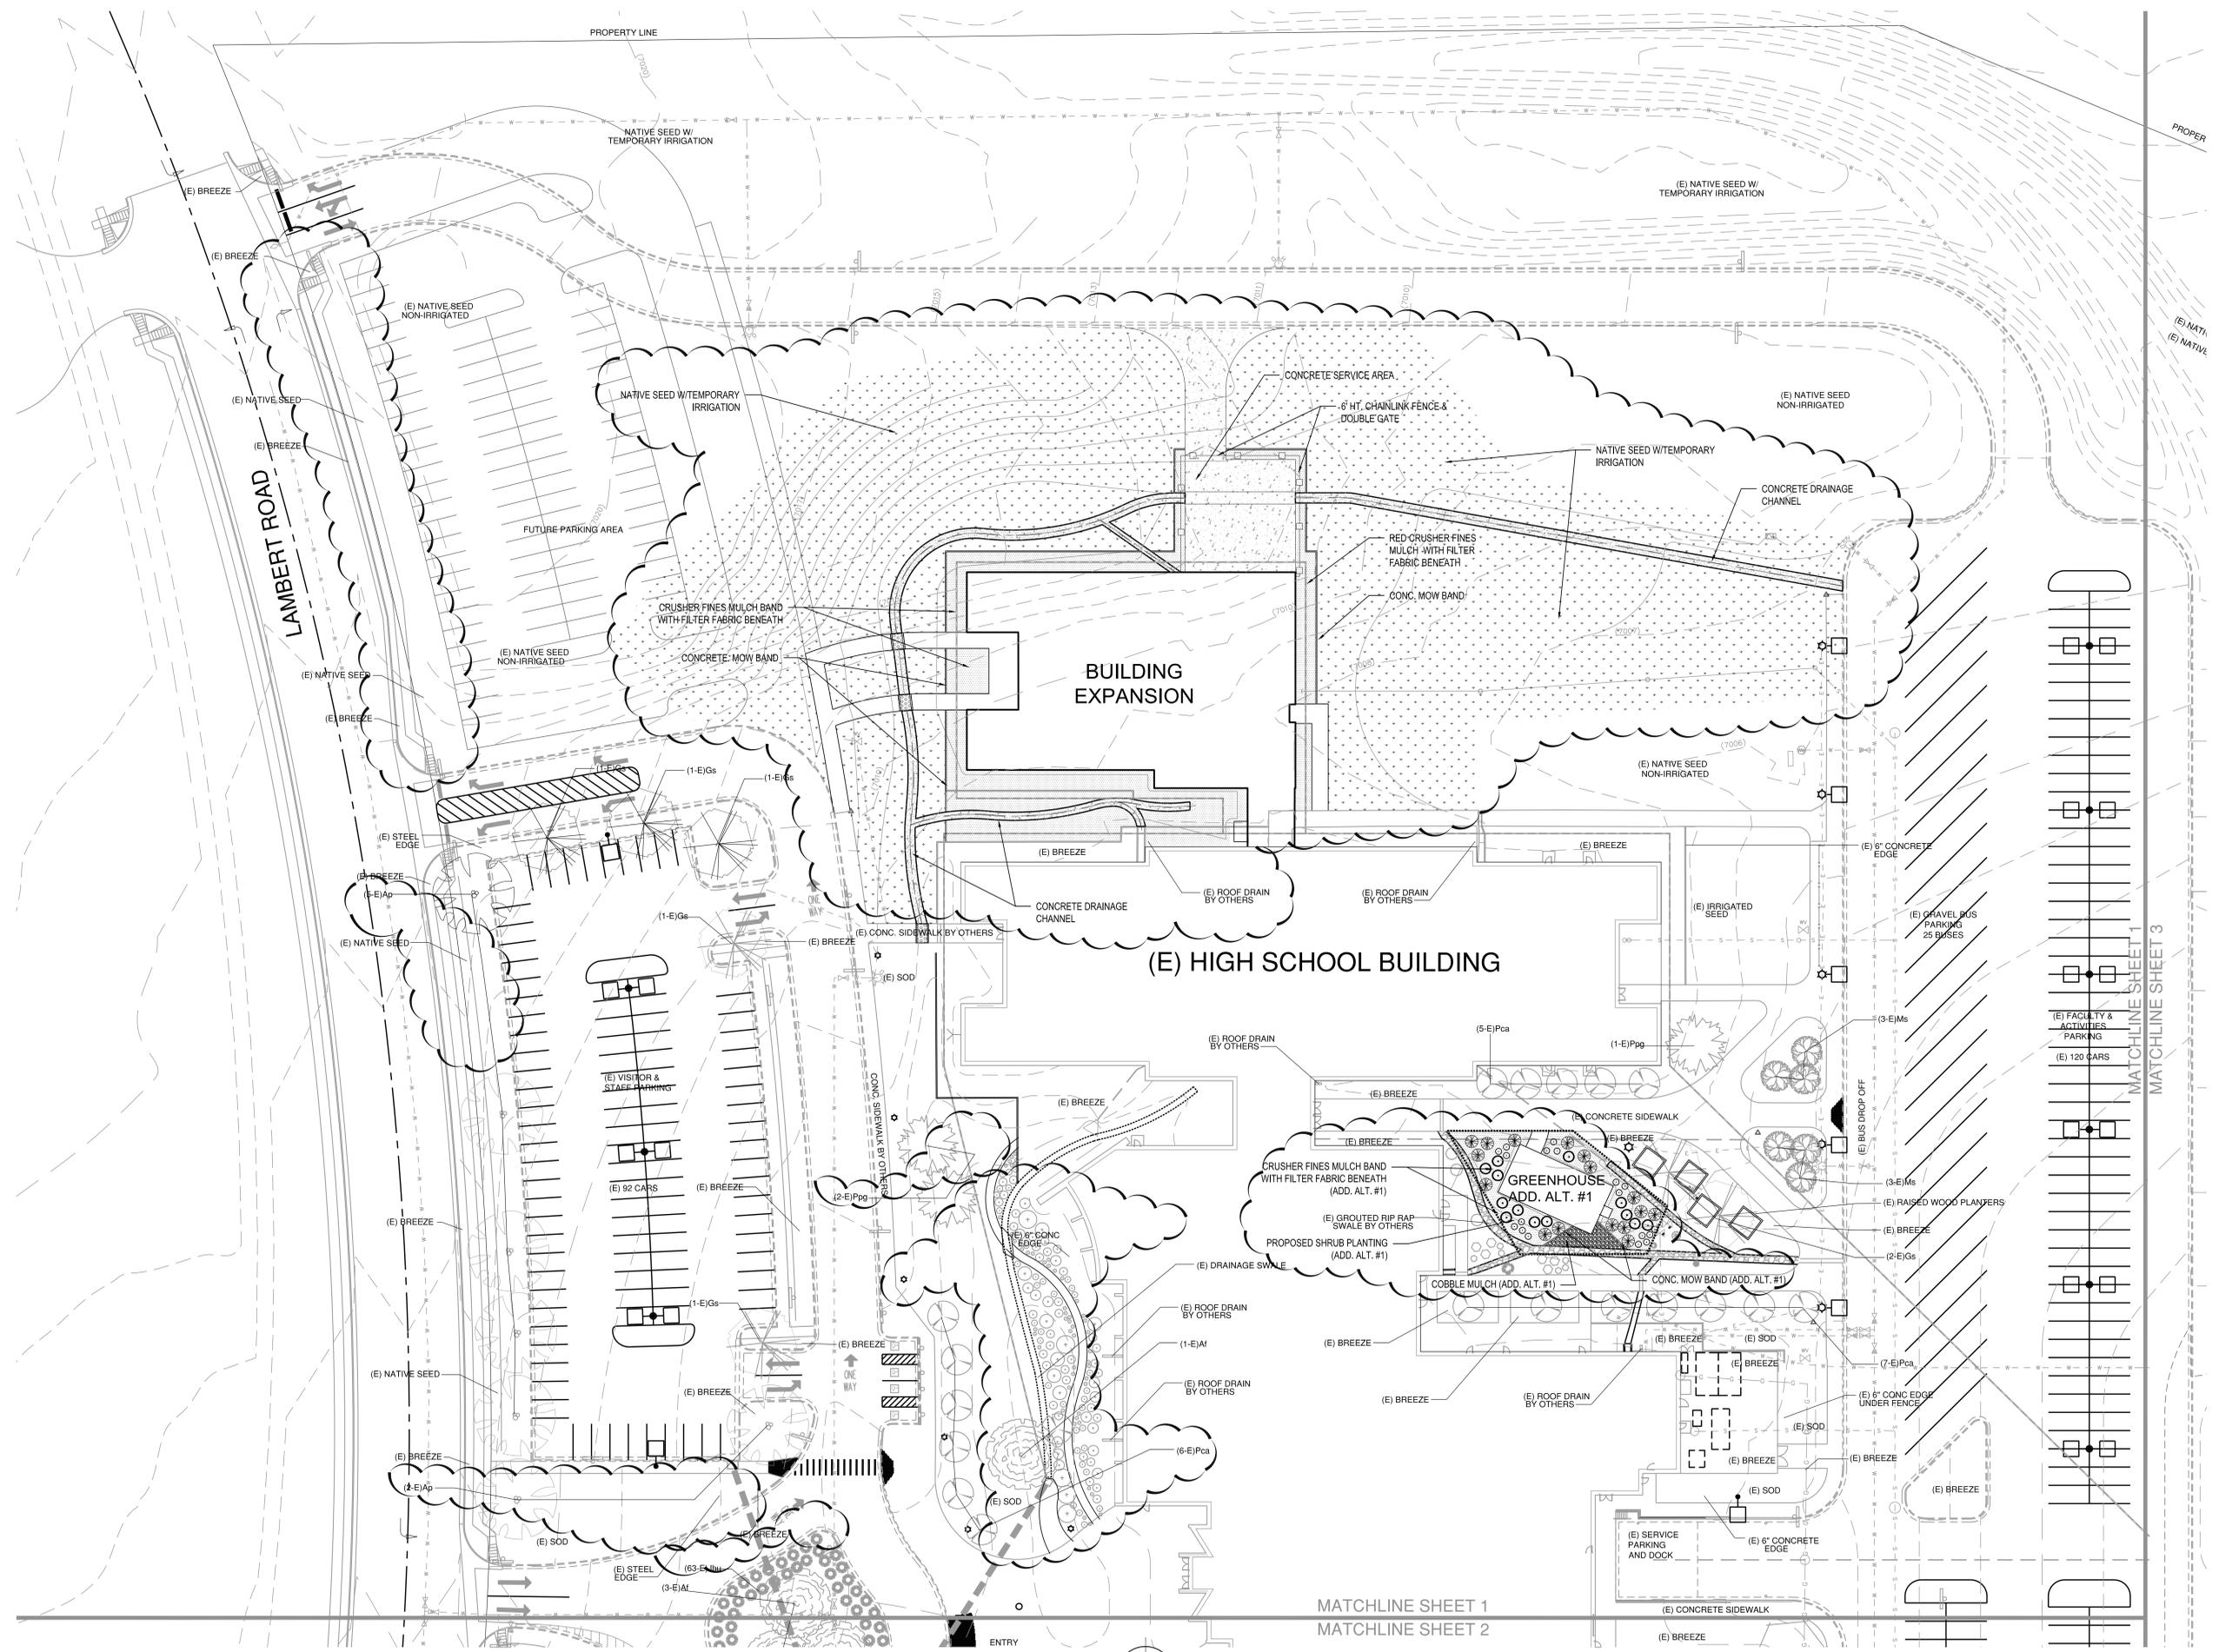

MATCHLINE SHEET 1  
MATCHLINE SHEET 2

MATCHLINE SHEET 1  
MATCHLINE SHEET 3

(E) EXISTING CONDITIONS AS OF 6/20/17;  
WORK DONE BY OTHERS

COUNTY SITE PLAN SUBMITTAL  
REVISIONS-08/21/17

design  
COLLABORATIVE  
landscape architecture... public participation  
1925 N. W. 10th St., Ste. 200  
Culver City, CA 90230  
714.222.9100  
714.222.9888

**DLR Group**  
Architecture Engineering Planning Interiors  
© DLR Group Inc. a Colorado corporation. ALL RIGHTS RESERVED.  
2017







**LS1.1**  
37-17109-00  
04.07.17


Landscape Plan  
**FALCON HIGH SCHOOL ADDITION**  
FALCON SCHOOL DISTRICT 49

DESIGN  
DEVELOPMENT  
10255 LAMBERT ROAD  
FAYTON, CO

Markup Summary

dsdruiz (17)

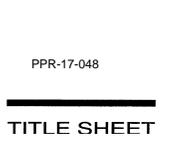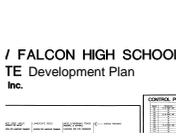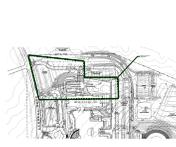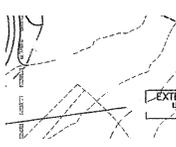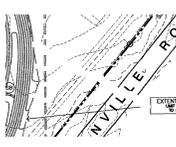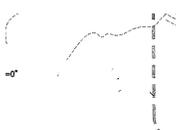 <p>PPR-17-048 TITLE SHEET</p>	<p><b>Subject:</b> Text Box <b>Page Label:</b> 1 <b>Lock:</b> Locked <b>Author:</b> dsdruiz</p>	<p>PPR-17-048</p>
 <p>/ FALCON HIGH SCHOOL TE Development Plan Inc.</p>	<p><b>Subject:</b> Text Box <b>Page Label:</b> 1 <b>Lock:</b> Locked <b>Author:</b> dsdruiz</p>	<p>Development Plan</p>
 <p>Diagram showing school expansion limits.</p>	<p><b>Subject:</b> Cloud+ <b>Page Label:</b> 4 <b>Lock:</b> Locked <b>Author:</b> dsdruiz</p>	<p>Limits of School Expansion</p>
 <p>Proposed Parking</p>	<p><b>Subject:</b> Text Box <b>Page Label:</b> 4 <b>Lock:</b> Locked <b>Author:</b> dsdruiz</p>	<p>Proposed Parking</p>
 <p>Diagram showing school expansion limits.</p>	<p><b>Subject:</b> Text Box <b>Page Label:</b> 5 <b>Lock:</b> Locked <b>Author:</b> dsdruiz</p>	
 <p>Proposed Additional Parking</p>	<p><b>Subject:</b> Text Box <b>Page Label:</b> 5 <b>Lock:</b> Locked <b>Author:</b> dsdruiz</p>	<p>Proposed Additional Parking</p>
 <p>Diagram showing school expansion limits.</p>	<p><b>Subject:</b> Cloud+ <b>Page Label:</b> 6 <b>Lock:</b> Locked <b>Author:</b> dsdruiz</p>	<p>Limits of school expansion.</p>
 <p>Site plan with highlighted area.</p>	<p><b>Subject:</b> Highlight <b>Page Label:</b> 6 <b>Lock:</b> Locked <b>Author:</b> dsdruiz</p>	<p>3</p>
 <p>Site plan with highlighted area.</p>	<p><b>Subject:</b> Highlight <b>Page Label:</b> 6 <b>Lock:</b> Locked <b>Author:</b> dsdruiz</p>	
 <p>Site plan with highlighted area.</p>	<p><b>Subject:</b> Highlight <b>Page Label:</b> 6 <b>Lock:</b> Locked <b>Author:</b> dsdruiz</p>	<p>.</p>

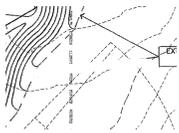

**Subject:** Highlight  
**Page Label:** 6  
**Lock:** Locked  
**Author:** dsdruiz

~




**Subject:** Highlight  
**Page Label:** 6  
**Lock:** Locked  
**Author:** dsdruiz

—



**Subject:** Highlight  
**Page Label:** 6  
**Lock:** Locked  
**Author:** dsdruiz

Drawn

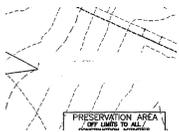

**Subject:** Highlight  
**Page Label:** 6  
**Lock:** Locked  
**Author:** dsdruiz

\*



**Subject:** Text Box  
**Page Label:** 7  
**Lock:** Locked  
**Author:** dsdruiz



**Subject:** Text Box  
**Page Label:** 7  
**Lock:** Locked  
**Author:** dsdruiz

Proposed Parking



**Subject:** Cloud+  
**Page Label:** 7  
**Lock:** Locked  
**Author:** dsdruiz

Limits of School Expansion