



Released for Permit
 05/08/2026 10:52:28 AM
 REGIONAL Building Department
 Becky A
 ENUMERATION




2782.4 A1 ELEVATION
 AVERAGE FINISH GRADE = (AFG)
 $AFG = \frac{84.9 + 84.4(2) + 83.9}{4} = 84.4$
 BUILDING HEIGHT = 22.5 + (TF - AFG) =
 BUILDING HEIGHT = 22.5 + (85.4 - 84.4) = 23.5

SFD26419
 PLAT-15653
 RS-6000
 ASQ261

APPROVED
 Plan Review


05/15/2026 3:54:33 PM
 dsdhill

EPC Planning & Community
 Development Department

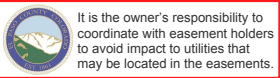

LOT 46

LOT 48

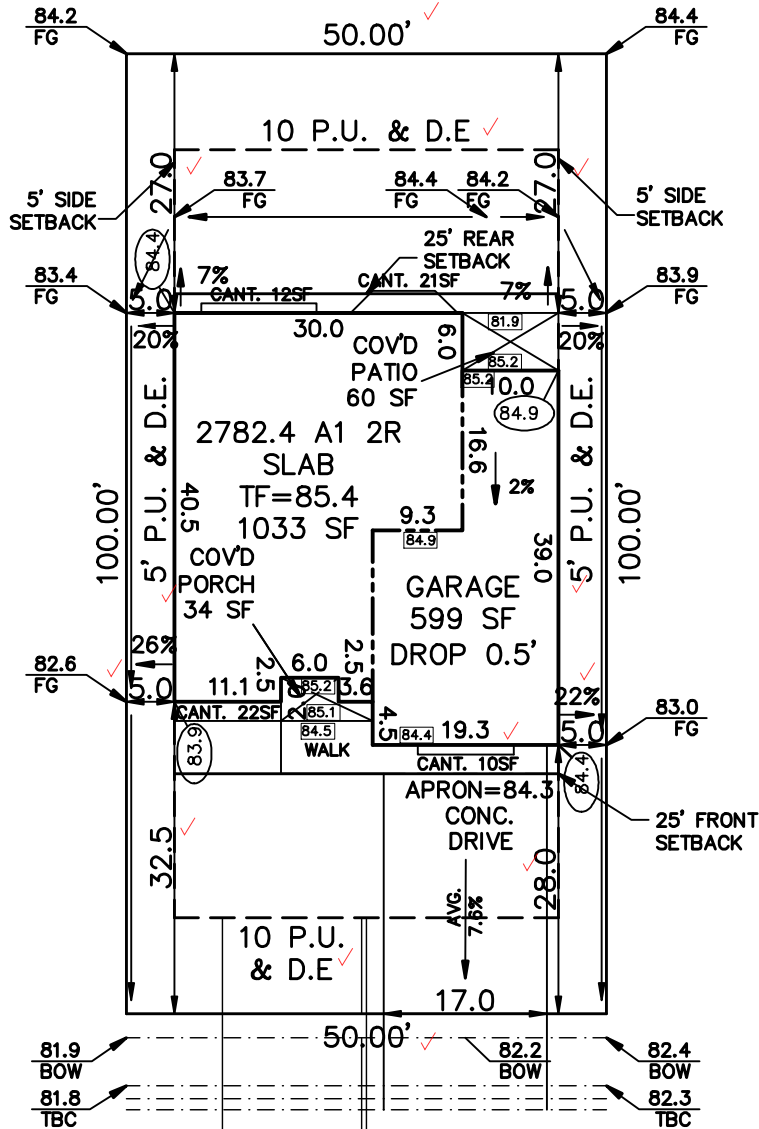

ANY APPROVAL GIVEN BY
 EL PASO COUNTY
 DOES NOT OBLIATE THE NEED
 TO COMPLY WITH APPLICABLE
 FEDERAL, STATE, OR LOCAL
 LAWS AND/OR REGULATION

Planning & Community Development Department
 approval is contingent upon compliance with all
 applicable notes on the recorded plat.

An access permit must be granted by the
 Planning & Community Development Department
 prior to the establishment of any driveway onto a
 County road.

Division of blockage of any drainage way
 is not permitted without approval of the
 Planning & Community Development Department

MASTER PARCEL
 5300000765

ZONING RS-5000
 SCHEDULE No. 5233300001

<p>WARNING!</p> <ol style="list-style-type: none"> LOCATE UNDERGROUND UTILITIES PRIOR TO EXCAVATION. THIS PLOT PLAN SHOWS IMPROVEMENTS AT GRADE ONLY. SEE FOUNDATION PLANS FOR STRUCTURAL INFORMATION 	<p>SITE DATA</p> <p>LOT SQ. FT. = 5000 ✓ HOUSE SQ. FT. = 1770 ✓ COVERAGE = 35.4% ✓ BLDG. HEIGHT = 23.5 ✓</p>	<p>LEGEND</p> <p>(00.0) FINISH GRADE (00.0) CONC. GRADE</p> <p>SCALE: ...1"=20' DRAWN BY: TAP</p>	<p>FLAT WORK:</p> <p>4" DRIVEWAY 519 SF 6" DRIVEWAY SF 4" SIDEWALK 165 SF 6" SIDEWALK 85 SF PATIO 60 SF, WALK 56 SF, PORCH 34 SF</p>
--------------------------------------------------------------------------------------------------------------------------------------------------------------------------------------------------------------------------------------	------------------------------------------------------------------------------------------------------------------------------------------------------------	------------------------------------------------------------------------------------------------------------------------------------	---------------------------------------------------------------------------------------------------------------------------------------------------------------------------------------------------------------------------

<p>CHALLENGER HOMES 8605 EMPLOYER DRIVE COLORADO SPRINGS, COLORADO 80920</p> <p>(IN FEET) 1 inch = 20 ft.</p>	<p>PLOT PLAN</p>					
	<p>LEGAL DESCRIPTION</p> <p>LOT 47 ✓ STERLING RANCH FILING No.4 ✓ COLORADO SPRINGS, EL PASO COUNTY, COLORADO</p>					
<p>ADDRESS</p> <p>7850 MOORE DRIVE ✓</p>			<table border="1"> <tr> <td data-bbox="706 2494 966 2607"> <p>PREPARED FOR CHALLENGER HOMES</p> </td> <td data-bbox="966 2494 1226 2607"> <p>TITLE CO. FILE NO. DRAWING NAME SR4-47</p> </td> <td data-bbox="1226 2494 1485 2607"> <p>DATE 05-07-26 PROJECT NO.</p> </td> </tr> </table>	<p>PREPARED FOR CHALLENGER HOMES</p>	<p>TITLE CO. FILE NO. DRAWING NAME SR4-47</p>	<p>DATE 05-07-26 PROJECT NO.</p>
<p>PREPARED FOR CHALLENGER HOMES</p>	<p>TITLE CO. FILE NO. DRAWING NAME SR4-47</p>	<p>DATE 05-07-26 PROJECT NO.</p>				



2880 International Circle, Suite 110
 Colorado Springs, CO 80910
 Phone: 719-520-6300
 Email: Stormwater@elpasoco.com
publicworks.elpasoco.com/stormwater/

EPC STORMWATER APPROVAL:

<p>APPROVED</p> <p>05/07/2026 4:20:17 PM</p> <p><i>Erica Rylander</i></p> <p>EPC Department of Public Works</p>

EL PASO COUNTY
STORMWATER PERMIT FORM
Associate Erosion and Stormwater Quality Control Permit (AESQCP)

Stormwater Permit Number: ASQ 261

This form initially acts as the permit application. Only once this form has been signed & approved, all other required documents have been submitted & approved, and the Notice to Proceed has been issued, does this form become an active permit. The AESQCP is for single-family residential home construction within a Larger Common Plan of Development (see ECM Appendix I.3).

Part I. Home Builder/Operator (Permit Holder)	
Company	Challenger Building, LLC
Name of Responsible Individual	Jason Trynoski
Title	Area Manager (COS/Northern CO)
Physical Address (not PO Box)	
Street Number and Street Name	8605 Explorer Drive, Suite 250
City, State, Zip Code	Colorado Springs, CO 80920
Mailing Address (if differs from above)	
Street Number and Street Name	
City, State, Zip Code	
Phone Number - Office	(719) 598-5192
Phone Number - Cell	(303) 210-0327
Email Address	Jason@challengerhomes.com

Part II. Property Owner
<i>Check the box next to the applicable Property Owner statement.</i>
<input checked="" type="checkbox"/> The Property Owner is the same entity as listed in Part I. Home Builder/Operator <input type="checkbox"/> The Property Owner is a different entity than listed in Part I. Home Builder/Operator <i>If the Home Builder/Operator is not the Property Owner of one or more lots, please provide the Property Owner's information in Table 1 on Page 5 of this application.</i>

Part III. Qualified Stormwater Manager (QSM)*	
Company/Organization	Challenger Building, LLC
Name	Jason Trynoski
Phone Number - Office	(719) 598-5192
Phone Number - Cell	(303) 210-0327
Email Address	Jason@challengerhomes.com

*This section can be left blank through Stormwater Permit Application review but must be filled in no later than at the Pre-Construction Meeting.



2880 International Circle, Suite 110
 Colorado Springs, CO 80910
 Phone: 719-520-6300
 Email: Stormwater@elpasoco.com
publicworks.elpasoco.com/stormwater/

EL PASO COUNTY
STORMWATER PERMIT FORM
Associate Erosion and Stormwater Quality Control Permit (AESQCP)

Stormwater Permit Number: ASQ 261_____

Part IV. Project Information	
Subdivision Name and Filing Number	Sterling Ranch Filing 4
Street Address and Lot Number*	East of Sterling Ranch Road and North of Marksheffel Road, Lots 1-96
Schedule <i>input estimated month (or season) and year</i>	Start of Construction: 5/11/2026 Completion of Construction: 3/31/2029

*Following issuance of this AESQCP, additional lots purchased by the Permit Holder, within the Subdivision and Filing identified above, may be added to this AESQCP by submitting an AESQCP Modification Request Form.



2880 International Circle, Suite 110
Colorado Springs, CO 80910
Phone: 719-520-6300
Email: Stormwater@elpasoco.com
publicworks.elpasoco.com/stormwater/

EL PASO COUNTY
STORMWATER PERMIT FORM
Associate Erosion and Stormwater Quality Control Permit (AESQCP)

Stormwater Permit Number: ASQ 261

REQUIRED SUBMISSIONS

See ECM Appendix I for the documentation required to be submitted, reviewed, and approved in conjunction with this Stormwater Permit Form.

RESPONSIBILITY FOR DAMAGE

The County and its officers and employees, including but not limited to the ECM Administrator, shall not be answerable or accountable in any manner for damage to property or for injury to or death of any person, including but not limited to the Permit Holder, persons employed by the Permit Holder, or persons acting on behalf of the Permit Holder, from any cause. The Permit Holder shall be responsible for any liability imposed by law and for damage to property or injuries to or death of any person, including but not limited to the Permit Holder, persons employed by the Permit Holder, and persons acting on behalf of the Permit Holder, arising out of work or other activity permitted and done under a permit, or arising out of the failure to perform the obligations under any permit with respect to maintenance or any other obligations, or resulting from defects or obstructions, or from any cause whatsoever during the progress of the work or other activity, or at any subsequent time work or other activity is being performed under the obligations provided by and contemplated by the permit.

The Permit Holder shall indemnify, save, and hold harmless the County and its officers and employees, including but not limited to the Board of County Commissioners (BoCC) and ECM Administrator, from all claims, suits or actions of every name, kind and description brought for or on account of damage to property or injuries to or death of any person, including but not limited to the Permit Holder, persons employed by the Permit Holder, persons acting in behalf of the Permit Holder and the public, resulting from the performance of work or other activity under the permit, or arising out of the failure to perform obligations under any permit with respect to maintenance or any other obligations, or resulting from defects or obstructions, or from any cause whatsoever during the progress of the work or other activity, or at any subsequent time work or other activity is being performed under the obligations provided by and contemplated by the permit, except as otherwise provided by state law. The Permit Holder waives any and all rights to any type of expressed or implied indemnity against the County, its officers or employees. It is the intent of the parties that the Permit Holder will indemnify, save, and hold harmless the County, its officers and employees from any and all claims, suits or actions as set forth above regardless of the existence or degree of fault of or negligence, whether active or passive, primary or secondary, on the part of the County, the Permit Holder, persons employed by the Permit Holder, or persons acting in behalf of the Permit Holder.



2880 International Circle, Suite 110
Colorado Springs, CO 80910
Phone: 719-520-6300
Email: Stormwater@elpasoco.com
publicworks.elpasoco.com/stormwater/

EL PASO COUNTY
STORMWATER PERMIT FORM
Associate Erosion and Stormwater Quality Control Permit (AESQCP)

Stormwater Permit Number: ASQ 261

APPLICATION AND PERMIT CERTIFICATION – PERMIT HOLDER

We, as the Permit Holder, hereby certify that this application is correct and complete as per the requirements presented in the El Paso County Engineering Criteria Manual (ECM) and Drainage Criteria Manual (DCM) Volume 2. We, as the Permit Holder, have read and will comply with all of the requirements of the submitted Stormwater Management Plan (SWMP), Grading & Erosion Control (GEC) Plan, and any other documents specifying construction control measures to be used on the site, including permit conditions that may be required by the ECM Administrator. We understand that the approved plans are an enforceable part of the Stormwater Permit. We further understand that we are to comply with all requirements set forth by the ECM and DCM Volume 2. We understand that the permitted area is that which is shown as the Limits of Disturbance on the approved GEC Plans and any subsequently approved AESQCP Modification Request Form. We further understand all necessary construction control measures are to be installed in accordance with the SWMP, GEC Plan, ECM, and DCM Volume 2 before land disturbance begins and that failure to comply will result in a Stop Work Order and may result in other penalties as allowed by law. We understand that the construction control measures are to be maintained on the site and be modified as necessary to protect stormwater quality as the project progresses. We understand that, prior to the sale or transfer of control of the lot to a private homeowner, we are responsible for installing adequate construction control measures and informing the private homeowner of their responsibility to maintain the construction control measures until Final Stabilization is achieved, in accordance with ECM Section I.4.7 and ECM Section I.4.8. We further understand and agree to indemnify, save, and hold harmless the County and its officers and employees, including but not limited to the BoCC and ECM Administrator, from all claims, suits or actions of every name, kind and description as outlined in Responsibility for Damage section above.

Signed by:
Jason Trynoski
39BFE9EED7EA480...
Signature of Home Builder/Operator (Permit Holder)

5/7/2026
Date

Jason Trynoski
Print Name of Home Builder/Operator (Permit Holder)



2880 International Circle, Suite 110
Colorado Springs, CO 80910
Phone: 719-520-6300
Email: Stormwater@elpasoco.com
publicworks.elpasoco.com/stormwater/

EL PASO COUNTY
STORMWATER PERMIT FORM
Associate Erosion and Stormwater Quality Control Permit (AESQCP)

Stormwater Permit Number: ASQ_____

For all lots to be covered by the AESQCP that are not owned by the Home Builder/Operator, provide the Property Owner's information in Table 1 below.

Table 1. Property Owner Information

Lot Number	Property Owner Name	Current Mailing Address	Phone Number	Email Address

SITE



2023 PPRBC
2021 IECC Amended

Address: 7850 MOORE DR, COLORADO SPRINGS

Parcel: 5300000765

Plan Track #: 212984 

Received: 08-May-2026 (BECKYA)

Description:

RESIDENCE

Type of Unit:

Garage	557	
Lower Level 2	1045	
Main Level	1041	
Upper Level 1	1741	
	4384	Total Square Feet

Required PPRBD Departments (3)

Enumeration

APPROVED

BECKYA

5/8/2026 10:52:40 AM

Floodplain

(N/A) RBD GIS

Construction

Released for Permit
05/08/2026 12:09:18 PM



CONSTRUCTION


Required Outside Departments (1)

County Zoning

APPROVED

Plan Review

05/15/2026 3:56:39 PM



**EPC Planning & Community
Development Department**

Release of this plan does not preclude compliance with all applicable codes, ordinances and other pertinent regulations. This plan set must be present on the job site for every inspection.