

SMOKE STACK AT STERLING RANCH


Rezone Map to include the following elements, as appropriate:	
1	Boundary description of the subject property, which shall illustrate the legal description
2	Existing land uses and zoning on the property and within five hundred (500) feet of the boundary
3	Adjoining property ownership
4	Existing private roads
5	Existing structures
6	Existing easements
7	Name and address of the petitioner, owners of all interests (including mineral interests), in the property, and preparer

GE 65 WEST OF
JNTY, COLORADO

JUD
NTIAL
ERRIDGE
GROUP LLC

Add existing easements, etc.
per checklist please

NES: Added.

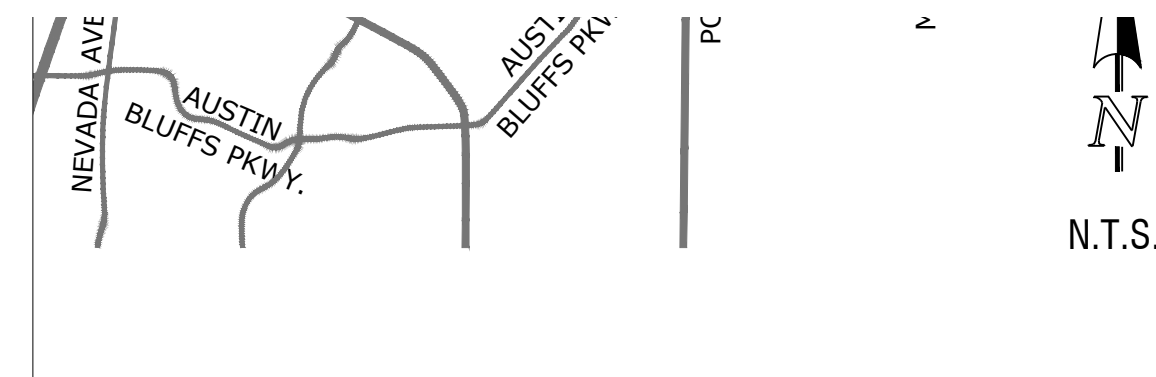

SITE DATA

OWNER:
Vantage Homes Corp.
9549 Federal Dr., Suite 100
Colorado Springs, CO 80921

PREPARED BY:
NES INC.
619 N. CASCADE AVE STE 200
COLORADO SPRINGS CO 80903
Tax ID Numbers:

5228000030, 5228000038

Sketch Plan:
Current Zoning:
Proposed Zoning:
Total Area:

SKP 18-003 (Approved 2018)
RR-5
RR-0.5
37.86798 ac

2023 file if approved

NES: This is reflecting the current approved Sketch Plan that we are amending. Label has been updated. Once this next amendment is approved then it will replace this current file number and approval date.

LEGAL DESCRIPTION

A PARCEL OF LAND BEING LOCATED IN A PORTION OF SECTION 27, TOWNSHIP 12 SOUTH, RANGE 65 WEST OF THE SIXTH PRINCIPAL MERIDIAN, EL PASO COUNTY, COLORADO, BEING MORE PARTICULARLY DESCRIBED AS FOLLOWS:

BASIS OF BEARINGS: THE EASTERLY BOUNDARY OF RETREAT AT TIMBERRIDGE FILING NO. 2 RECORDED UNDER RECEPTION NO. 222715015, RECORDS OF EL PASO COUNTY, COLORADO, BEING MONUMENTED AT THE SOUTH END WHICH IS THE SOUTHWEST 1/16 CORNER OF SAID SECTION 27, BY A 1/2" ALUMINUM SURVEYORS CAP STAMPED "CCES LLC PLS 30118", IS ASSUMED TO BEAR N00°54'30"W, A DISTANCE OF 2478.00 FEET.

COMMENCING AT THE NORTHEASTERLY CORNER OF SAID RETREAT AT TIMBERRIDGE FILING NO. 2:

THENCE N00°54'30"W, A DISTANCE OF 274.03 FEET TO THE POINT OF BEGINNING;
THENCE CONTINUING N00°54'30"W, A DISTANCE OF 963.57 FEET;
THENCE N88°38'53"E, A DISTANCE OF 479.88 FEET;
THENCE S74°18'11"E, A DISTANCE OF 157.76 FEET;
THENCE ON THE ARC OF A CURVE TO THE LEFT, HAVING A DELTA OF 10°51'04", A RADIUS OF 500.00 FEET, AND A DISTANCE OF 138.33 FEET;
THENCE N89°50'45"E, A DISTANCE OF 716.65 FEET;
THENCE S11°52'02"E, A DISTANCE OF 234.39 FEET;
THENCE S71°06'46"E, A DISTANCE OF 502.14 FEET TO THE WESTERLY BOUNDARY OF INDIAN WELLS SUBDIVISION, FILING NO. 1, RECORDED IN PLAT BOOK 23 AT PAGE 83;
THENCE S01°51'59"E, ON SAID WESTERLY BOUNDARY, A DISTANCE OF 1,249.69 FEET;
THENCE S89°05'30"W, A DISTANCE OF 756.72 FEET;
THENCE N00°54'30"W, A DISTANCE OF 1,249.69 FEET;
THENCE S89°50'45"W, A DISTANCE OF 860.00 FEET;
THENCE ON THE ARC OF A CURVE TO THE LEFT, HAVING A DELTA OF 61°09'02", A RADIUS OF 200.00 FEET, AND A DISTANCE OF 213.46 FEET;
THENCE S89°05'30"W, A DISTANCE OF 224.51 FEET TO THE POINT OF BEGINNING.

CONTAINING A CALCULATED AREA OF 37.86798 ACRES (1,649,829 SQUARE FEET).



please identify subdivision names for clarity

NES: This has been provided and additional labels have been added.

NES: Added.

provide acreage

EASEMENT
NES: Added. Please reference new linetype legend.

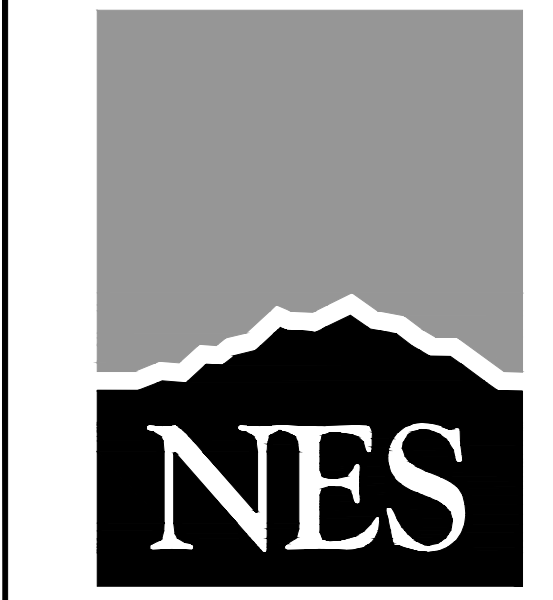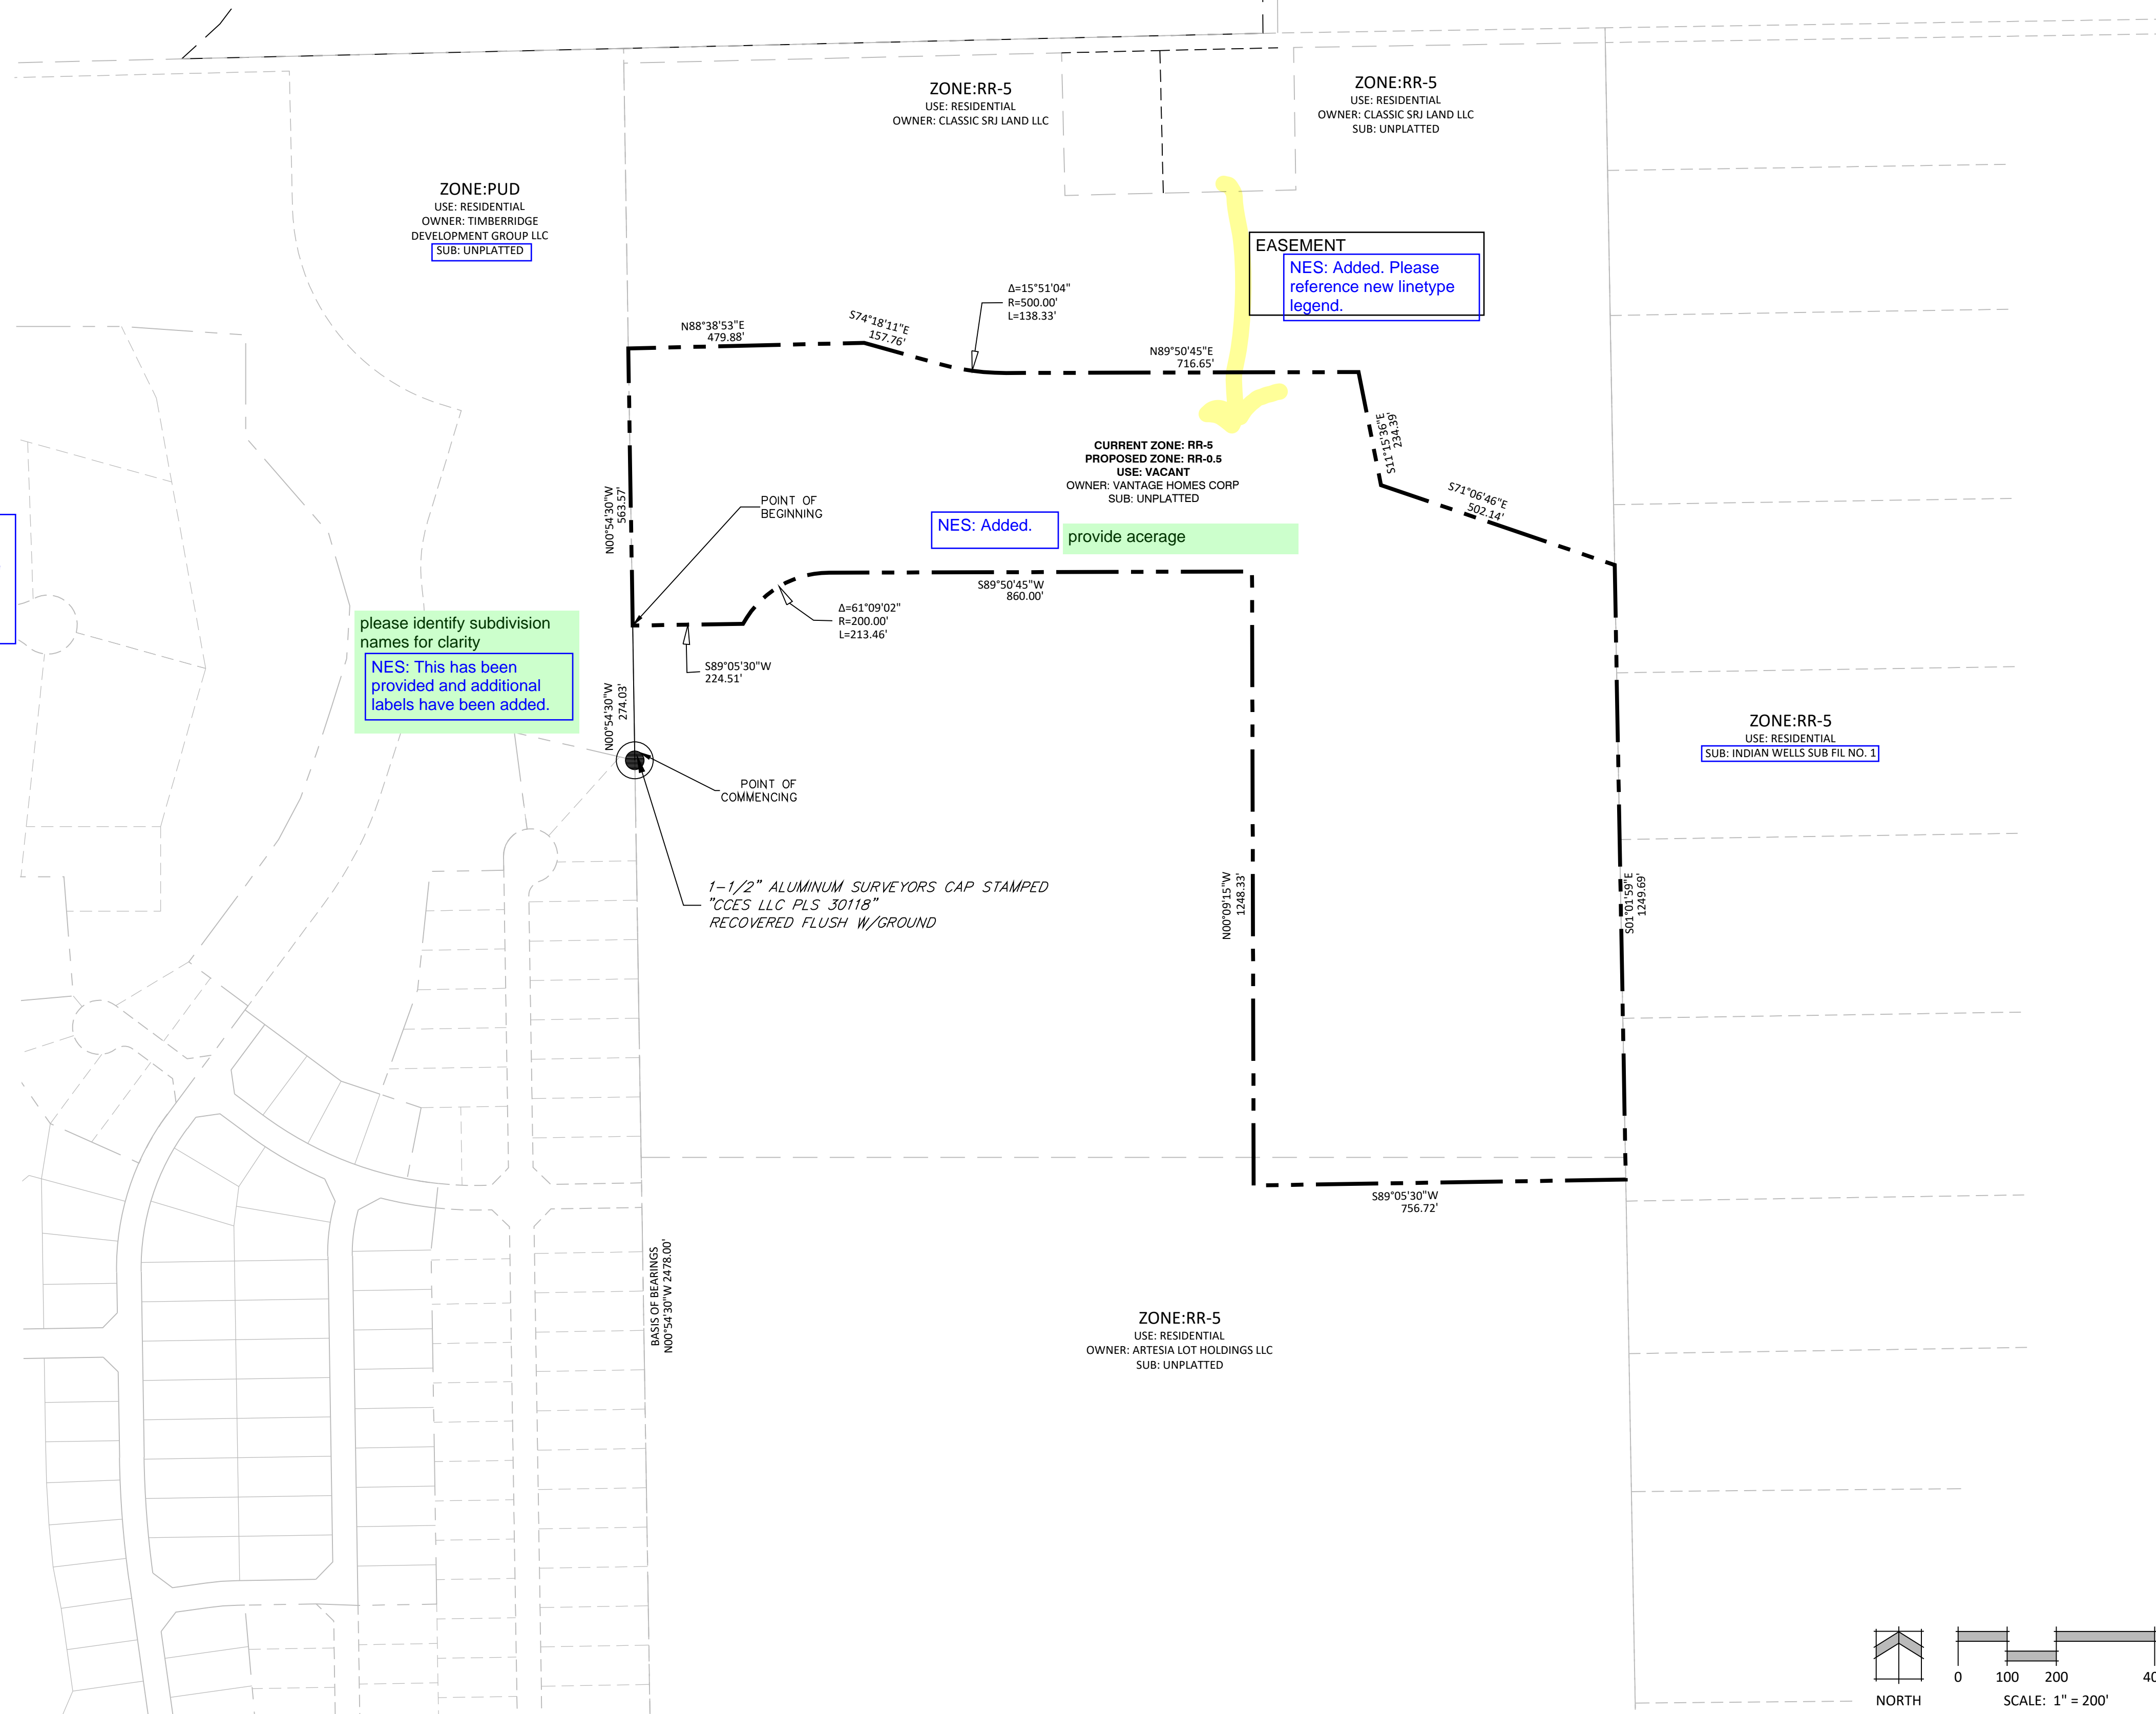

N.E.S. Inc.
619 N. Cascade Avenue, Suite 200
Colorado Springs, CO 80903

Tel. 719.471.0073
Fax 719.471.0267

www.nescolorado.com

© 2012. All Rights Reserved.

PLANNING / LANDSCAPE ARCHITECT
IN ASSOCIATION WITH

SMOKE STACK AT STERLING RANCH REZONE

DATE: 10/09/2023
PROJECT MGR: A. BARLOW
PREPARED BY: B. PERKINS

ENTITLEMENT


DATE:	BY:	DESCRIPTION:

REZONE EXHIBIT

1


1 OF 1

P2310

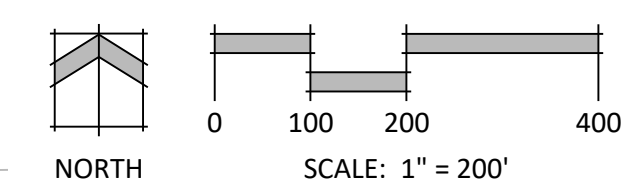


V1_ Zone map comments -2310.pdf Markup Summary

AutoCAD SHX Text (4)

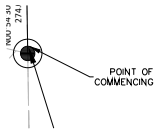

Subject:
Page Label: [1] Rezone -1
Author: AutoCAD SHX Text
Date:
Status:
Color:
Layer:
Space:

POINT OF COMMENCING

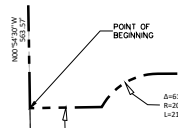

Subject:
Page Label: [1] Rezone -1
Author: AutoCAD SHX Text
Date:
Status:
Color:
Layer:
Space:

POINT OF BEGINNING



Subject:
Page Label: [1] Rezone -1
Author: AutoCAD SHX Text
Date:
Status:
Color:
Layer:
Space:


1-1/2" ALUMINUM SURVEYORS CAP STAMPED
"CCES LLC PLS 30118" RECOVERED FLUSH
W/GROUND



Subject:
Page Label: [1] Rezone -1
Author: AutoCAD SHX Text
Date:
Status:
Color:
Layer:
Space:


N

dsdparsons (8)

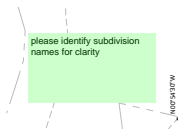

Subject: Planner
Page Label: [1] Rezone -1
Author: dsdparsons
Date: 11/2/2023 2:29:12 PM
Status:
Color:
Layer:
Space:

please identify subdivision names for clarity

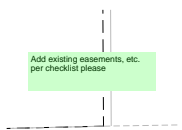


Subject: Planner
Page Label: [1] Rezone -1
Author: dsdparsons
Date: 11/2/2023 2:30:48 PM
Status:
Color:
Layer:
Space:

Add existing easements, etc. per checklist please




Subject: Image
Page Label: [1] Rezone -1
Author: dsdparsons
Date: 11/2/2023 2:31:03 PM
Status:
Color: ■
Layer:
Space:

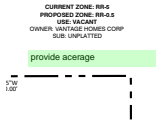


Subject: Planner
Page Label: [1] Rezone -1
Author: dsdparsons
Date: 11/2/2023 2:29:55 PM
Status:
Color: ■
Layer:
Space:

provide acreage

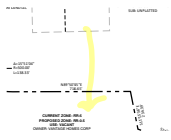

Subject: Highlight
Page Label: [1] Rezone -1
Author: dsdparsons
Date: 11/2/2023 2:31:59 PM
Status:
Color: ■
Layer:
Space:

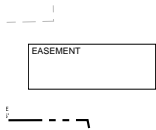

Subject: Text Box
Page Label: [1] Rezone -1
Author: dsdparsons
Date: 11/2/2023 2:32:08 PM
Status:
Color: ■
Layer:
Space:

EASEMENT



Subject: Cloud
Page Label: [1] Rezone -1
Author: dsdparsons
Date: 11/2/2023 2:59:12 PM
Status:
Color: ■
Layer:
Space:



Subject: Callout
Page Label: [1] Rezone -1
Author: dsdparsons
Date: 11/2/2023 2:59:16 PM
Status:
Color: ■
Layer:
Space:

2023 file if approved