




SOUTH ELEVATION
SCALE 1" = 20'

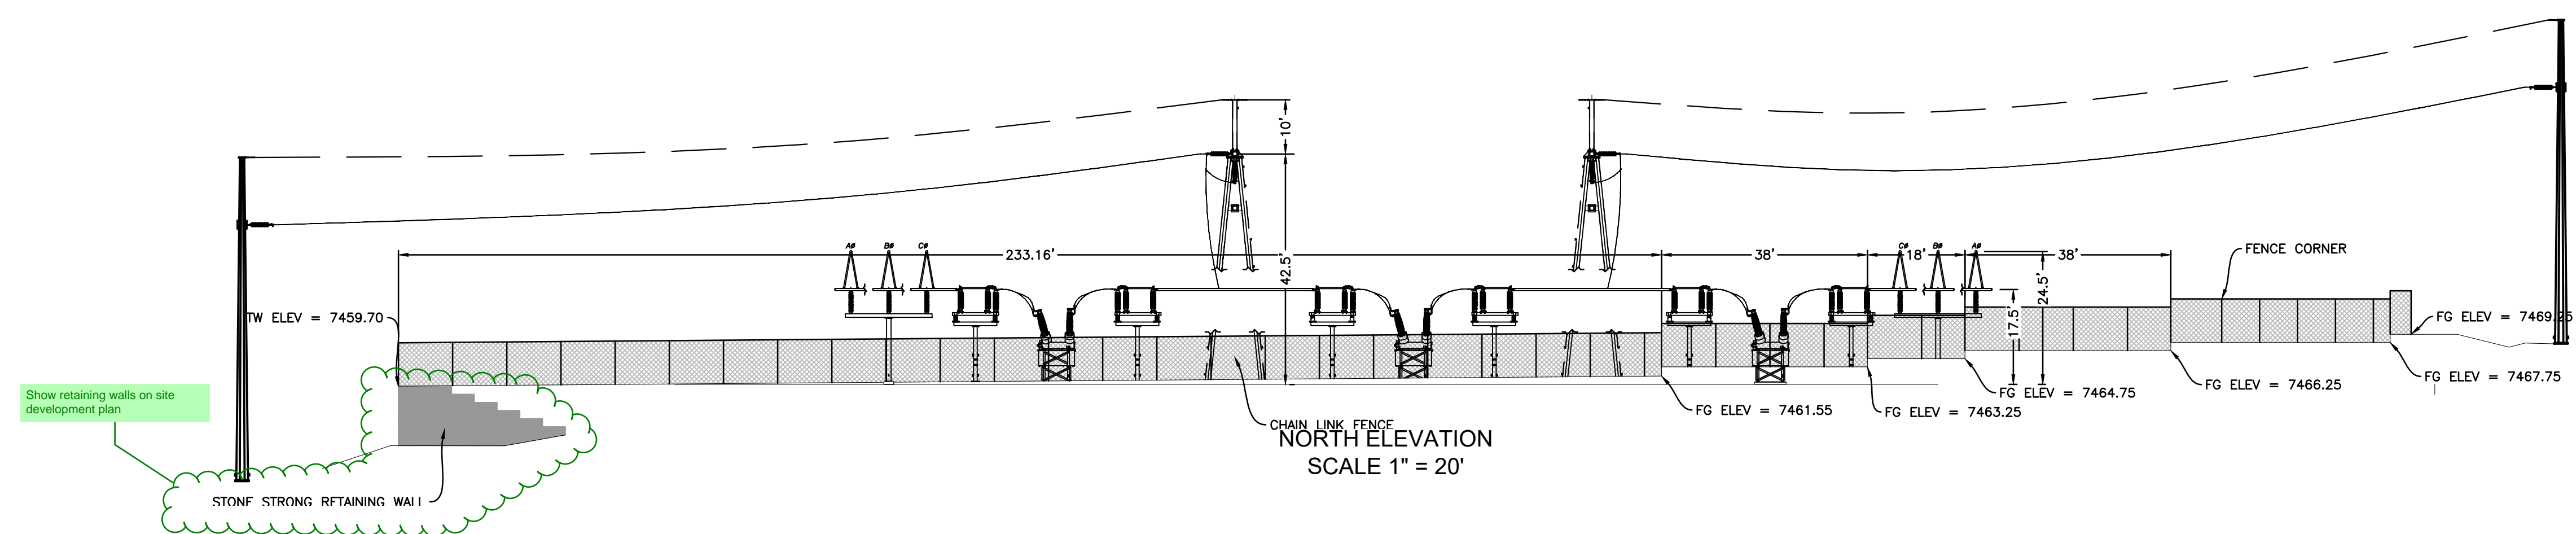

NORTH ELEVATION
SCALE 1" = 20'

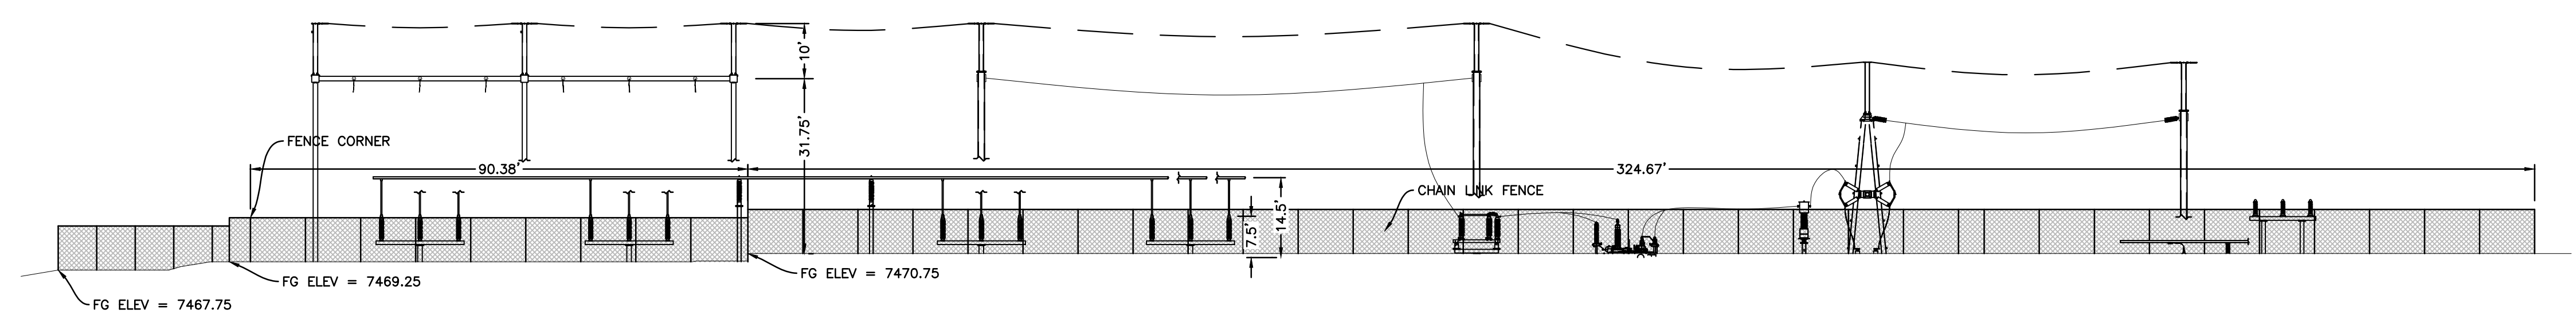

WEST ELEVATION
SCALE 1" = 20'

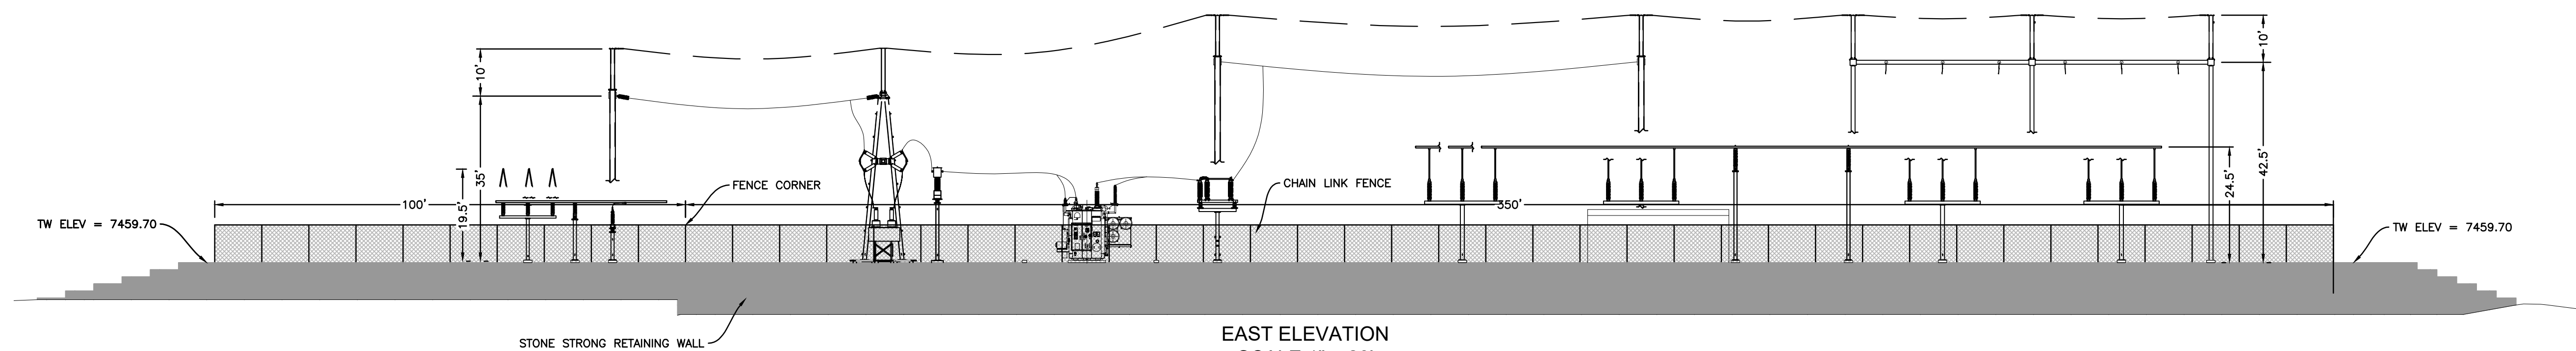


EAST ELEVATION
SCALE 1" = 20'

Reference Drawings		Drawing Title	
Dwg. No.	Mfr.	Dwg. No.	Mfr.
Revision		Revision	
No.	Date	Dwn.	Appd.
7			
6			
5			
4			
3			
2			
1			
<p>FOX RUN SUBSTATION</p> <p>ELEVATION VIEWS</p> <p>TRI-STATE GENERATION & TRANSMISSION ASSOCIATION, INCORPORATED</p> <p>1100 W. 116th Ave. P.O. Box 33695 Denver, Colorado 80233 303-452-6111</p> <p>UPDATED BY: KENUTL 5/17/2022 4:56 PM Contract: .</p> <p>PATH: T:\Projects\Fox Run Substation\EL_Paso County\Dea\21036C_Elevations.dwg</p>			
Dwn: TMC	Date: 04/27/22		
Appd: .	Date: .		
ELEVATIONS			

Elevation Plans_V1.pdf Markup Summary

8/30/2022 5:36:30 PM (1)

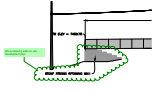

Subject: Cloud+
Page Label: 1
Author: Linda.Nguyen
Date: 8/30/2022 5:36:30 PM
Status:
Color: ■
Layer:
Space:

Show retaining walls on site development plan