


# Final Plat OWL RIDGE SUBDIVISION

PART OF THE WEST HALF OF THE SOUTHWEST QUARTER OF SECTION 7, TOWNSHIP 11  
SOUTH, RANGE 65 WEST OF THE SIXTH PRINCIPAL MERIDIAN  
COUNTY OF EL PASO, STATE OF COLORADO

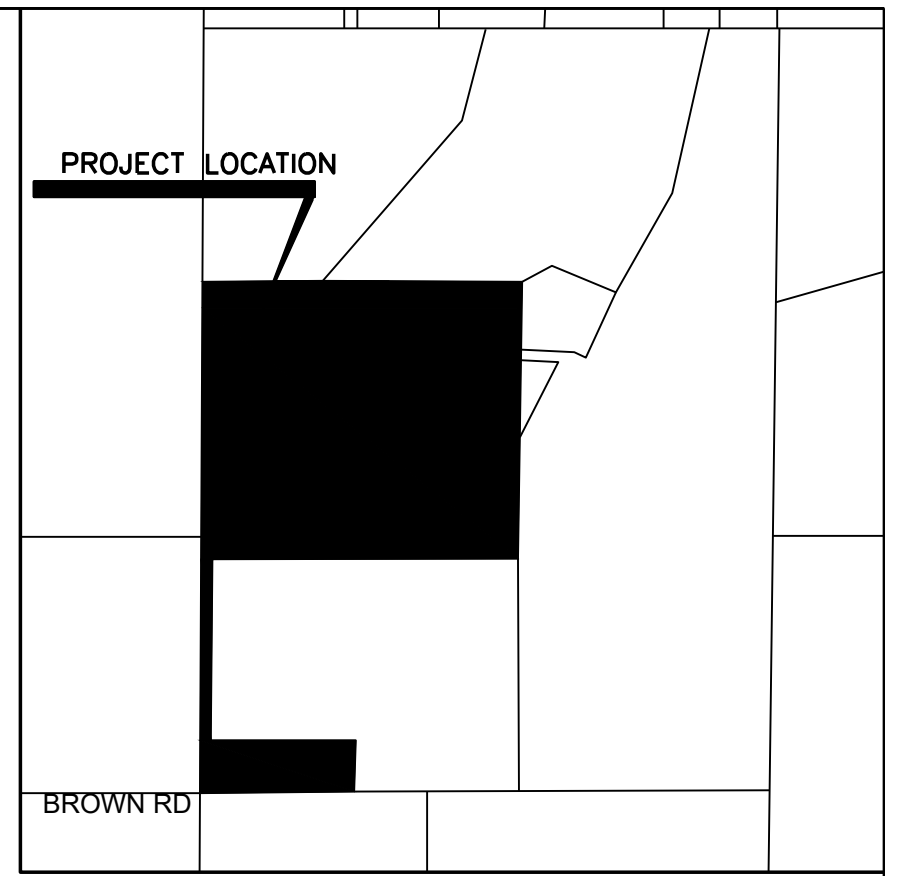

VICINITY MAP  
(NOT TO SCALE)

**ENVIRONMENTAL:**  
DEVELOPER SHALL COMPLY WITH FEDERAL AND STATE LAWS, REGULATIONS, ORDINANCES, REVIEW AND PERMIT REQUIREMENTS, AND OTHER AGENCY REQUIREMENTS, IF ANY, OF APPLICABLE AGENCIES, INCLUDING, BUT NOT LIMITED TO, THE COLORADO DEPARTMENT OF WILDLIFE, COLORADO DEPARTMENT OF TRANSPORTATION, U.S. ARMY CORPS OF ENGINEERS, THE U.S. FISH & WILDLIFE SERVICE REGARDING THE ENDANGERED SPECIES ACT, PARTICULARLY AS IT RELATES TO THE PREBLE'S MEADOW JUMPING MOUSE AS A LISTED THREATENED SPECIES.

**FLOODPLAIN NOTE:**  
FLOOD INSURANCE RATE MAP, MAP NUMBER 084041C0305G EFFECTIVE DATE DECEMBER 7, 2018, INDICATES THAT THE AREA WITHIN THE SURVEYED PROPERTY TO BE LOCATED IN ZONE X (AREAS DETERMINED TO BE OUTSIDE THE 500-YEAR FLOOD PLAIN).

**EASEMENTS:**  
UNLESS OTHERWISE INDICATED, ALL SIDE, FRONT, AND REAR LOT LINES ARE HEREBY PLATTED ON EITHER SIDE WITH A 10-FOOT PUBLIC UTILITY AND DRAINAGE EASEMENT. ALL EXTERIOR SUBDIVISION BOUNDARIES ARE HEREBY PLATTED WITH A 20-FOOT PUBLIC UTILITY AND DRAINAGE EASEMENT. THE SOLE RESPONSIBILITY FOR THE MAINTENANCE OF THESE EASEMENTS IS HEREBY VESTED WITH THE INDIVIDUAL PROPERTY OWNERS.

**UTILITY NOTES:**  
ANY UTILITY COMPANY THAT LOCATES FACILITIES IN ANY EASEMENT SHALL HAVE THE RIGHT TO PRUNE, REMOVE, ERADICATE, CUT AND CLEAR AWAY ANY TREES, LIMBS, VINES, AND BRUSH ON THE UTILITY EASEMENT NOW OR AT ANY FUTURE TIME AND PRUNE AND CLEAR AWAY ANY TREE LIMBS, VINES, AND BRUSH ON LANDS ADJACENT TO THE UTILITY EASEMENT WHENEVER, IN THE UTILITY COMPANIES JUDGMENT, SUCH MAY INTERFERE WITH OR ENDANGER THE CONSTRUCTION, OPERATION, OR MAINTENANCE OF ITS FACILITIES. TOGETHER WITH THE RIGHT OF INGRESS TO AND EGRESS FROM THE UTILITY EASEMENT AND CONTIGUOUS LAND SUBJECT TO THIS PLAT FOR THE PURPOSE OF SURVEYING, ERECTING, REBUILDING, REPLACING, AND WITH OR ENDANGERING THE CONSTRUCTION, OPERATION OR MAINTENANCE OF SAID FACILITIES.

**NOTICE:**  
ACCORDING TO COLORADO LAW YOU MUST COMMENCE ANY LEGAL ACTION BASED UPON ANY DEFECT IN THIS SURVEY WITHIN THREE YEARS AFTER YOU FIRST DISCOVER SUCH DEFECT. IN NO EVENT MAY ANY ACTION BASED UPON ANY DEFECT IN THIS SURVEY BE COMMENCED MORE THAN TEN YEARS FROM THE DATE OF CERTIFICATION SHOWN HEREON.

**ACCESS:**  
NO DRIVEWAY SHALL BE ESTABLISHED UNLESS AN ACCESS PERMIT HAS BEEN GRANTED BY EL PASO COUNTY.

All this data needs to be updated to include the 35 acre lot as well

DENSITY AND DIMENSIONAL STANDARDS FOR RESIDENTIAL DISTRICT RR-5						
ZONING DISTRICT	AREA	WIDTH (AT FRONT SETBACK LINE)	FRONT	REAR	SIDE	MAXIMUM LOT COVERAGE
RR-5	5 ACRES (1.2)	200 Ft	25 Ft	25 Ft	25 Ft	25%

**OWNER:**  
COLT & KATHRYN HAUGEN  
LIVING TRUST  
18855 BROWN ROAD  
COLORADO SPRINGS, CO 80906  
719-440-8808

**TOTAL ACREAGE:**  
LOT 1 = 20.33 ACRES  
LOT 2 = 5.00 ACRES  
FLAG STEM = 1.67 ACRES  
TOTAL = 27.00 ACRES

**LOT & DENSITY DATA:**  
GROSS ACREAGE: 27.00 ACRES  
TOTAL LOTS: 2  
GROSS DENSITY: 0.074 LOTS/ACRE  
NET DENSITY: 0.079 LOTS/ACRE  
NET ACREAGE: 25.33 ACRES

**SURVEYOR:**  
TIM SLOAN, VICE-PRESIDENT  
SMH CONSULTANTS, P.A.  
411 SOUTH TEJON STREET, SUITE 1  
COLORADO SPRINGS, CO 80903  
719-465-2145

**SERVICE PROVIDERS:**  
TRI-LAKES MONUMENT FIRE DEPARTMENT  
MOUNTAIN VIEW ELECTRIC ASSOC.  
CENTURYLINK  
INDIVIDUAL SEWAGE DISPOSAL SYSTEMS  
DOMESTIC WELLS  
PROPANE SERVICE

**DATE SUBMITTED:** 11/28/2022  
**REVISIONS:**

**FEES:**  
Park Fee: \$1,380.00  
School Fee:  
Brown Road Cost Share: \$14,866.81

**SMH CONSULTANTS**  
Civil Engineering • Land Surveying • Landscape Architecture  
www.smhconsultants.com

Manhattan, KS - HQ P: (785) 776-0541 • Dodge City, KS P: (620) 255-1952  
Kansas City, KS P: (913) 444-9615 • Colorado Springs, CO P: (719) 465-2145

Drawn By: JTH Project 2010CS4031 DD TDS87 PCD File # MS-22-005

NOVEMBER 2022

**NOTES:**


- NO GAPS OR OVERLAPS EXIST.
- THERE ARE NO LINES OF POSSESSION THAT AFFECT THIS SURVEY.
- PARENT TRACT IS RECORDED IN BOOK INSTRUMENT #219120728, REGISTER OF DEEDS OFFICE, EL PASO COUNTY, COLORADO.
- ALL BUILDING SETBACK REQUIREMENTS SHALL BE DETERMINED BY THE ZONING DISTRICT, UNLESS OTHERWISE NOTED.
- THIS SURVEY DOES NOT CONSTITUTE A TITLE SEARCH BY SMH CONSULTANTS, TO DETERMINE OWNERSHIP OR EASEMENTS OF RECORD. FOR INFORMATION REGARDING EASEMENTS AND RIGHT OF WAY, SMH CONSULTANTS RELIED UPON THE TITLE POLICY PREPARED BY STEWART TITLE COMPANY dba LEGACY TITLE, 1641867, DATED APRIL 4, 2022.
- BASIS OF BEARINGS IS THE WEST PROPERTY LINE, MONUMENTED AS SHOWN AND BEARING NORTH 00 DEGREES 27 MINUTES 45 SECONDS WEST, 1326.92 FEET.
- SEWAGE TREATMENT IS THE RESPONSIBILITY OF EACH INDIVIDUAL PROPERTY OWNER. THE EL PASO COUNTY PUBLIC HEALTH DEPARTMENT MUST APPROVE EACH SYSTEM AND, IN SOME CASES, THE DEPARTMENT MAY REQUIRE AN ENGINEER-DESIGNED SYSTEM PRIOR TO PERMITTING APPROVAL.
- INDIVIDUAL WELLS ARE THE RESPONSIBILITY OF EACH PROPERTY OWNER. PERMITS FOR INDIVIDUAL WELLS MUST BE OBTAINED FROM THE STATE ENGINEER WHO BY LAW HAS THE AUTHORITY TO SET CONDITIONS FOR THE ISSUANCE OF THESE PERMITS.
- WATER IN THE DENVER WATER BASIN AQUIFERS IS ALLOCATED BASED ON A 100-YEAR AQUIFER LIFE; HOWEVER, FOR EL PASO COUNTY PLANNING PURPOSES, WATER IN THE DENVER BASIN AQUIFERS IS ELEVATED BASED ON A 300-YEAR AQUIFER LIFE. APPLICANTS, THE HOME OWNERS ASSOCIATION, AND ALL FUTURE OWNERS IN THE SUBDIVISION SHOULD BE AWARE THAT THE ECONOMIC LIFE OF A WATER SUPPLY BASED ON WELLS IN A GIVEN DENVER BASIN AQUIFER MAY BE LESS THAN EITHER THE 100 YEARS OR 300 YEARS INDICATED DUE TO ANTICIPATED WATER LEVEL DECLINES. FURTHERMORE, THE WATER SUPPLY PLAN SHOULD NOT RELY SOLELY UPON NON-RENEWABLE AQUIFERS. ALTERNATIVE RENEWABLE WATER RESOURCES SHOULD BE ACQUIRED AND INCORPORATED IN A PERMANENT WATER SUPPLY PLAN THAT PROVIDES FUTURE GENERATIONS WITH A WATER SUPPLY.
- THE PROPERTY OWNER, ITS SUCCESSORS AND ASSIGNS, AND ALL FUTURE LOT OWNERS IN THIS DEVELOPMENT ARE HEREBY ON NOTICE THAT THEY MAY BE REQUIRED TO COMPLY WITH APPLICABLE RULES, IF ANY, OF THE COLORADO GROUND WATER COMMISSION AND/OR THE UPPER BLACK SQUIRREL CREEK GROUND WATER MANAGEMENT DISTRICT, WHICH COMPLIANCE MAY RESULT IN A REDUCTION OF WELL WITHDRAWAL LIMITS, AND THUS A REDUCTION IN WATER AVAILABILITY.
- ALL PROPERTY OWNERS ARE RESPONSIBLE FOR MAINTAINING PROPER STORM WATER DRAINAGE IN AND THROUGH THEIR PROPERTY. PUBLIC DRAINAGE EASEMENTS AS SPECIFICALLY NOTED ON THE PLAT SHALL BE MAINTAINED BY THE INDIVIDUAL LOT OWNERS UNLESS OTHERWISE INDICATED. HOMEBUILDERS ARE RESPONSIBLE TO ENSURE PROPER DRAINAGE AROUND STRUCTURES INCLUDING ELEVATIONS OF FOUNDATIONS AND WINDOW WELLS IN RELATION TO SIDE-LOT DRAINAGE EASEMENTS AND SWALES. HOMEOWNERS SHALL NOT CHANGE THE GRADE OF THE LOT OR DRAINAGE SWALES WITHIN SAID EASEMENTS, AS CONSTRUCTED BY THE BUILDER, IN A MANNER THAT WOULD CAUSE ADVERSE DRAINAGE IMPACTS TO PROPERTIES. STRUCTURES, FENCES, MATERIALS OR LANDSCAPING THAT COULD IMPEDE THE FLOW OF RUNOFF SHALL NOT BE PLACED IN DRAINAGE EASEMENTS.
- ACCESS TO LOTS 1 & 2 SHALL BE THROUGH THE SHOWN ACCESS EASEMENT. THE RESPONSIBILITY AND MAINTENANCE OF SAID ACCESS IS SUBJECT TO THE MAINTENANCE AGREEMENT AND ALL RESTRICTIONS CONTAINED THEREIN, AS RECORDED AT RECEPTION NO. \_\_\_\_\_ OF THE RECORDS OF EL PASO COUNTY CLERK AND RECORDER.
- THE SUBDIVIDER(S) AGREES ON BEHALF OF HIM/HERSELF AND ANY DEVELOPER OR BUILDER SUCCESSORS AND ASSIGNEES THAT SUBDIVIDER AND/OR SAID SUCCESSORS AND ASSIGNS SHALL BE REQUIRED TO PAY TRAFFIC IMPACT FEES IN ACCORDANCE WITH EL PASO COUNTY ROAD IMPACT FEE PROGRAM RESOLUTION (RESOLUTION NO. 19-471) OR ANY AMENDMENTS THERETO, AT OR PRIOR TO THE TIME OF BUILDING PERMIT SUBMITTALS. THE FEE OBLIGATION IF NOT PAID AT FINAL PLAT RECORDING, SHALL BE DOCUMENTED ON ALL SALES DOCUMENTS AND PLAT NOTES TO ENSURE THAT A TITLE SEARCH WOULD FIND THE FEE OBLIGATION BEFORE SALE OF THE PROPERTY.
- DUE TO THEIR LENGTH, SOME OF THE DRIVEWAYS WILL NEED TO BE SPECIFICALLY APPROVED BY THE TRI-LAKES MONUMENT FIRE PROTECTION DISTRICT.
- MAILBOXES SHALL BE INSTALLED IN ACCORDANCE WITH ALL EL PASO COUNTY DEPARTMENT OF TRANSPORTATION AND THE UNITED STATES POSTAL SERVICE REGULATIONS.
- THE FOLLOWING REPORTS HAVE BEEN SUBMITTED IN ASSOCIATION WITH THE FINAL PLAT FOR THIS SUBDIVISION AND ARE ON FILE AT THE COUNTY DEVELOPMENT SERVICE DEPARTMENT: DRAINAGE REPORT, WATER RESOURCES REPORT, WASTEWATER DISPOSAL REPORT, GEOLOGY AND SOILS REPORT, FIRE PROTECTION REPORT, AND TRAFFIC MEMO.
- THE ADDRESSES EXHIBITED ON THIS PLAT ARE FOR INFORMATIONAL PURPOSES ONLY. THEY ARE NOT THE LEGAL DESCRIPTION AND ARE SUBJECT TO CHANGE.
- INDIVIDUAL LOTS SHALL CONTRIBUTE TO THE BROWN ROAD IMPROVEMENT ESCROW AGREEMENT, FOR FUTURE IMPROVEMENTS TO BROWN ROAD, AS RECORDED WITH EL PASO COUNTY CLERK AND RECORDER AT RECEPTION NO. \_\_\_\_\_.
- WATER RIGHTS MAY NOT BE CONVEYED, SOLD OR TRANSFERRED PER COURT DECREE 2021W3126 DATED FEBRUARY 8, 2022. USE OF WATER RIGHTS CAN NOT BE CHANGED FROM WHAT IS OUTLINED IN THE PRECEDING COURT DECREE.
- THE FOUNDATION SYSTEMS FOR THE PROPOSED SINGLE-FAMILY RESIDENTIAL STRUCTURES AND ANY RETENTION/DETENTION FACILITIES SHOULD BE DESIGNED AND CONSTRUCTED BASED UPON RECOMMENDATIONS DEVELOPED IN A SITE-SPECIFIC SUBSURFACE SOIL INVESTIGATION.
- INDIVIDUAL LOT PURCHASERS ARE RESPONSIBLE FOR CONSTRUCTING DRIVEWAYS INCLUDING NECESSARY DRAINAGE IN ACCORDANCE WITH LAND DEVELOPMENT CODE SECTION 6.3.3.C.2 AND 6.3.3.C. DUE TO ITS LENGTH, DRIVEWAY FOR LOT 1 WILL NEED TO BE APPROVED BY THE FIRE DISTRICT AUTHORITY.

Include the note Soil and Geology Conditions. There are conditions noted in the report for the 35 acre lot as well as the 22 acre lot.

Geologic Hazard Note-Final Plat: (to be customized based upon the individual circumstances)  
The following lots have been found to be impacted by geologic hazards. Mitigation measures and a map of the hazard area can be found in the report (Title of Report, generally from the Preliminary Plan file) by (author of the report) (date of report) in file (name of file and file number) available at the El Paso County Planning and Community Development Department:  
•Downslope Creep: (name lots or location of area)  
•Rockfall Source: (name lots or location of area)  
•Rockfall Runout Zone: (name lots or location of area)  
•Potentially Seasonally High Groundwater: (name lots or location of area)  
•Other Hazard:  
In Areas of High Groundwater:  
Due to high groundwater in the area, all foundations shall incorporate an underground drainage system.

This needs to be included in this subdivision as Lot 3. It is part of the parent parcel and is subject to this subdivision request

NOT PART OF THIS SUBDIVISION 35.0 ACRES

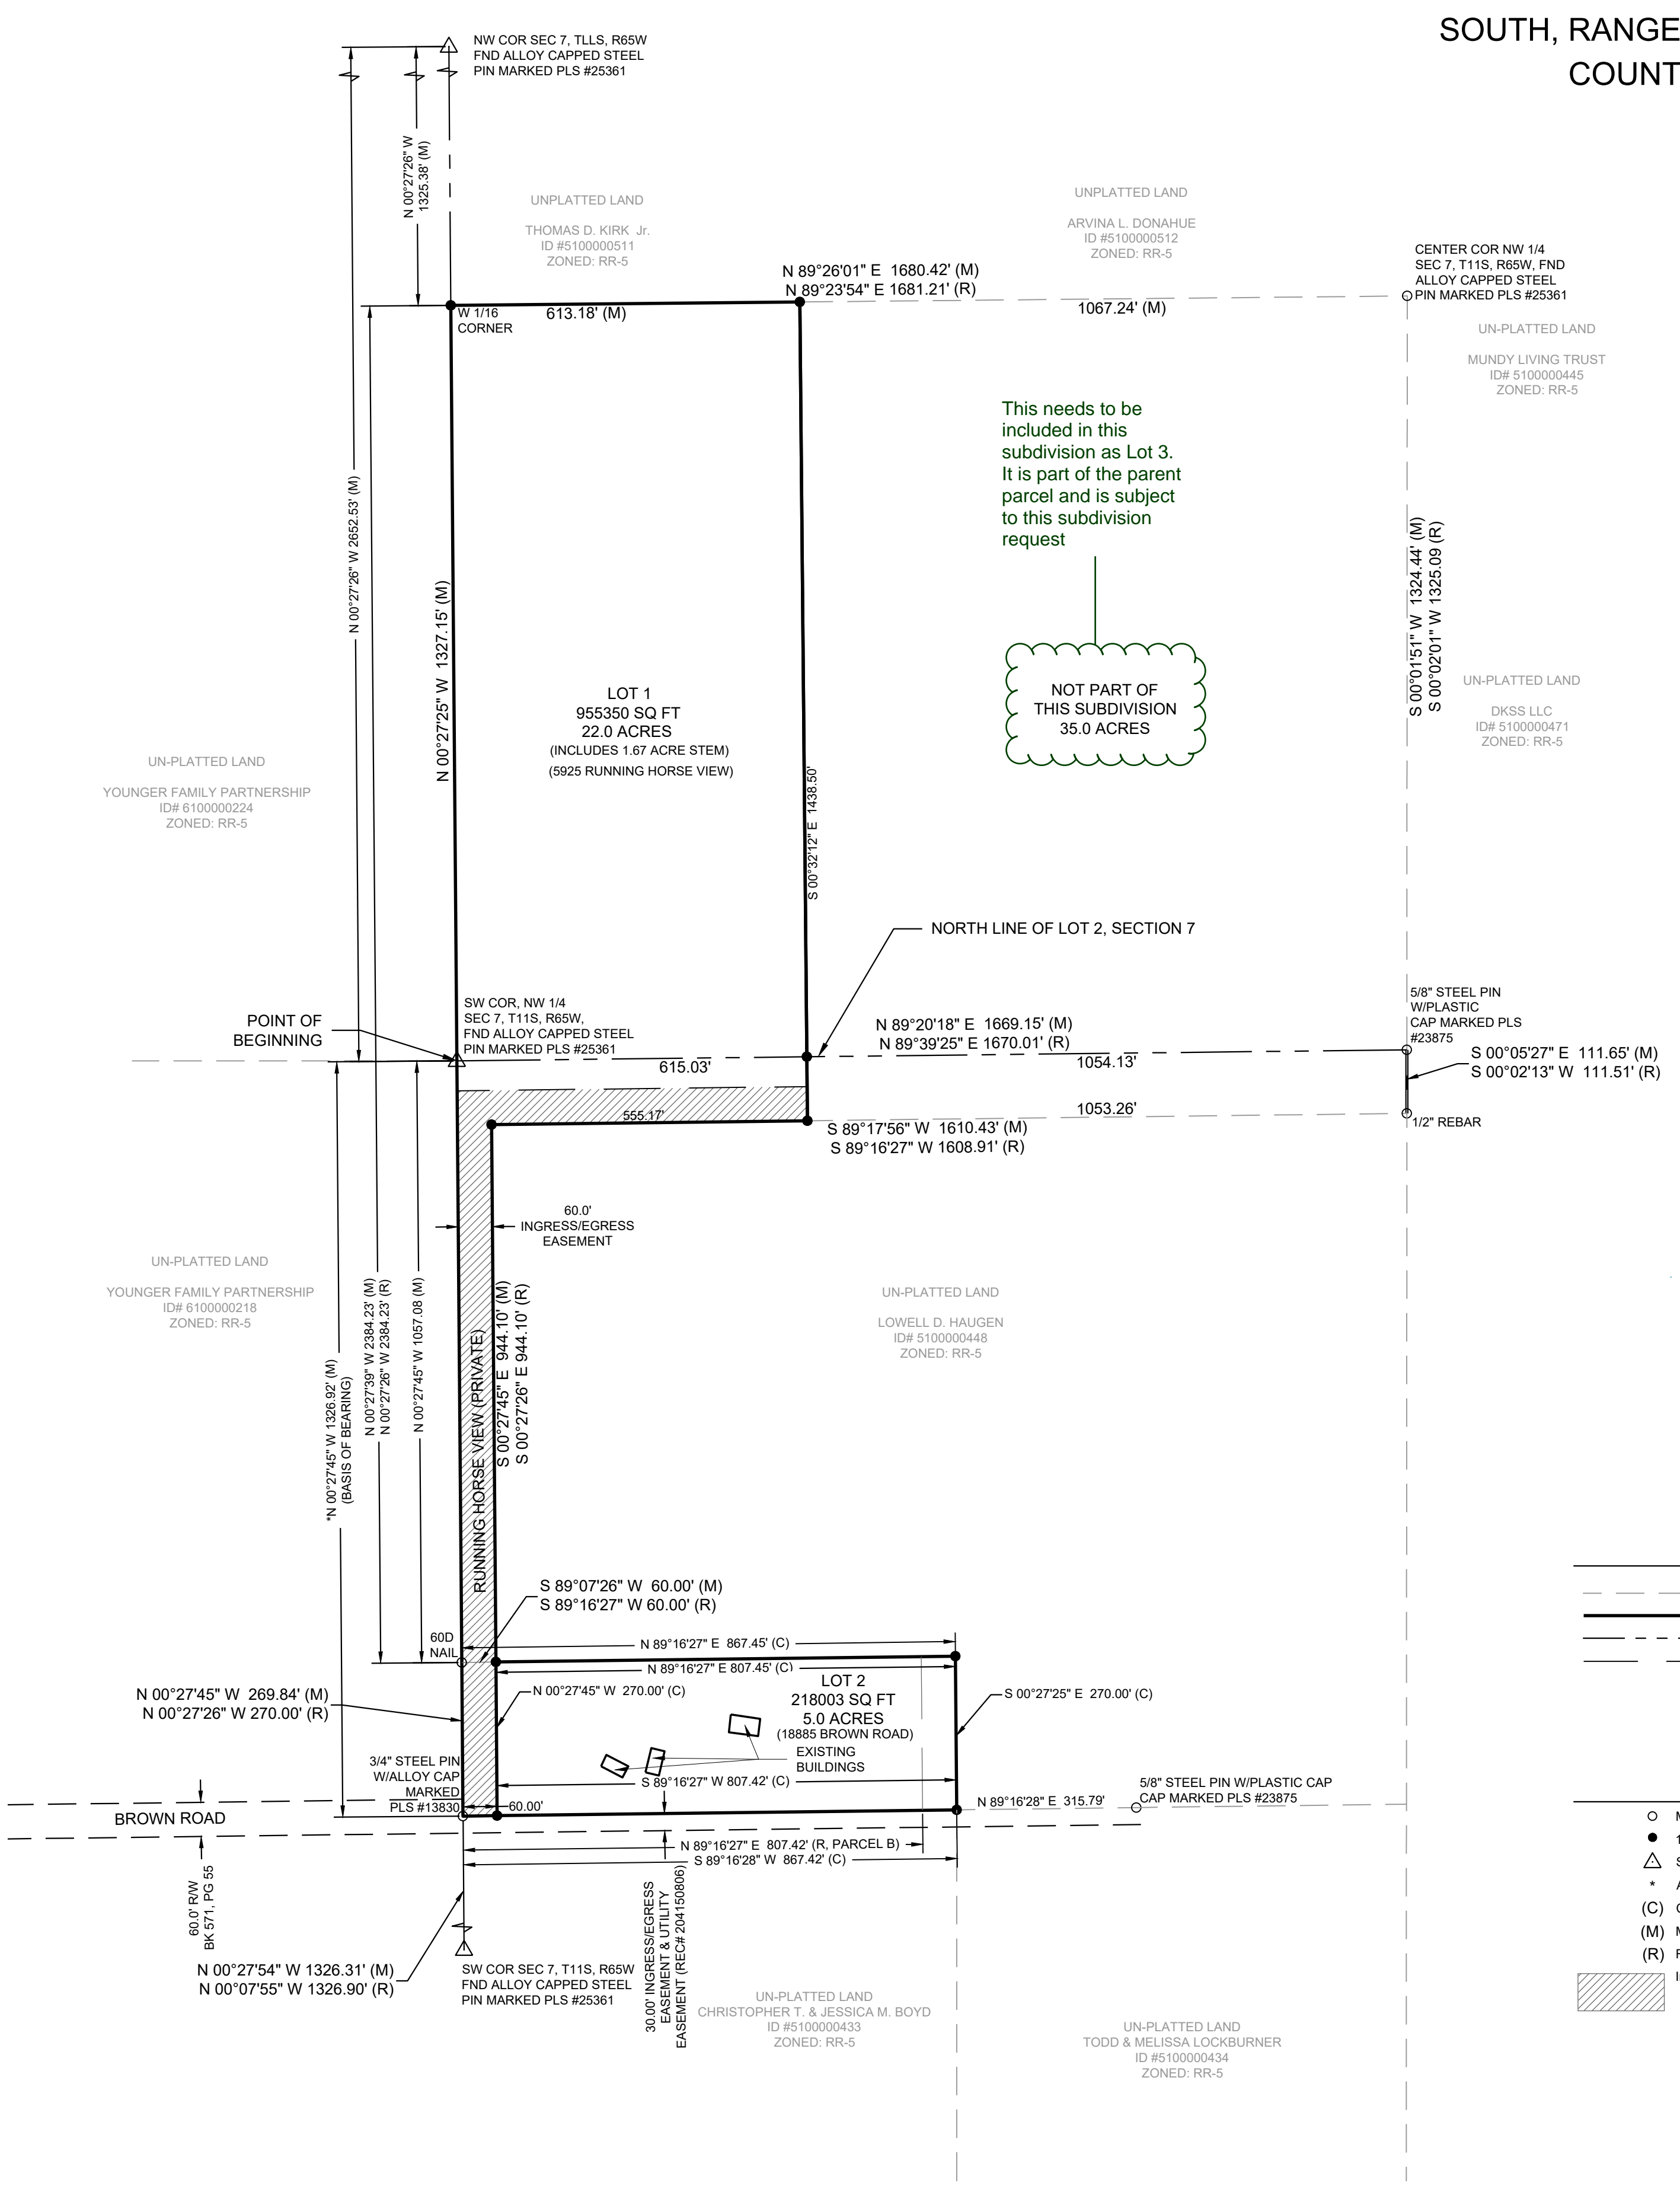


**LINETYPE LEGEND**

- Adjacent Property Line
- Property Line
- - - Section Line
- · - · - Easement Line


**SYMBOL LEGEND**

- Monument Found Origin: Unknown
- 1/2"x24" Rebar w/PL S38374 Cap Set
- △ Section Corner
- + Assumed Bearing
- (C) Calculated Dimension
- (M) Measured Dimension
- (R) Recorded Dimension
- ▨ Ingress/Egress

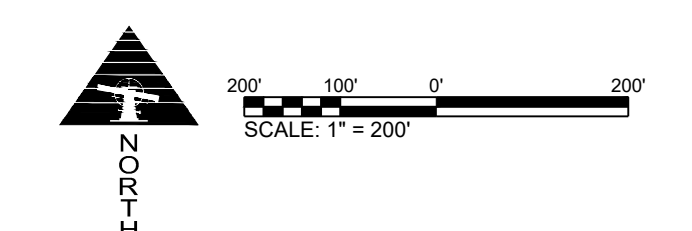

# Final Plat OWL RIDGE SUBDIVISION

PART OF THE WEST HALF OF THE SOUTHWEST QUARTER OF SECTION 7, TOWNSHIP 11  
SOUTH, RANGE 65 WEST OF THE SIXTH PRINCIPAL MERIDIAN  
COUNTY OF EL PASO, STATE OF COLORADO

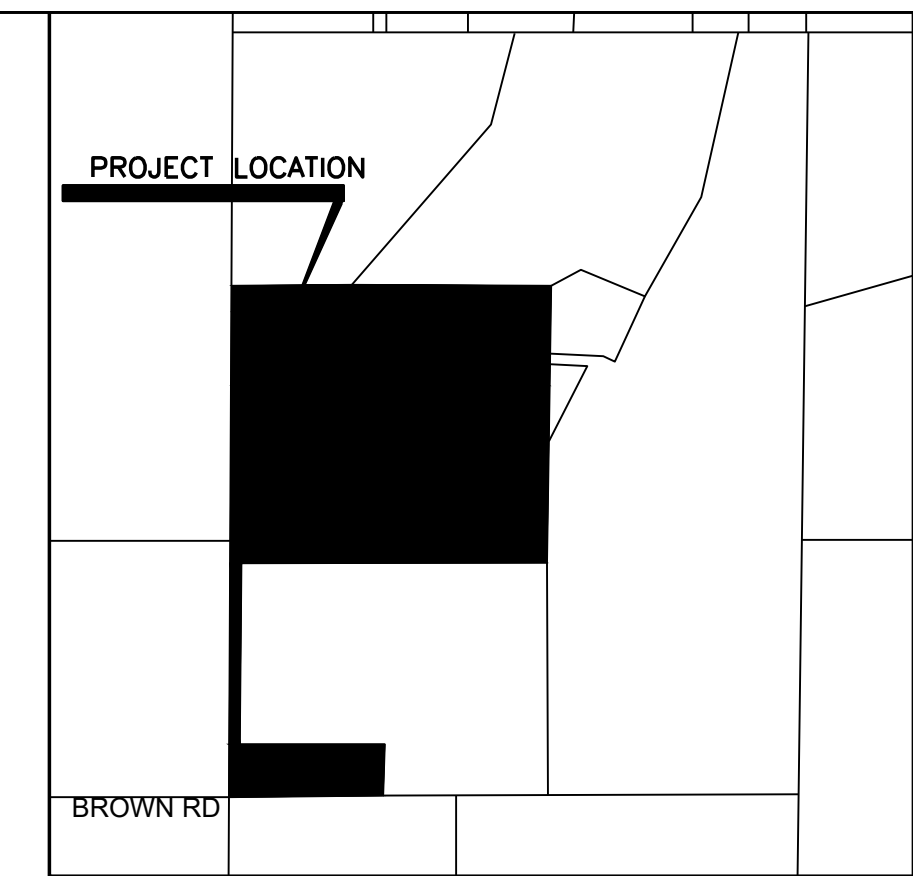

VICINITY MAP  
(NOT TO SCALE)

**BOARD OF COUNTY COMMISSIONERS CERTIFICATE:**

This Plat OWL RIDGE SUBDIVISION was approved for filing by the El Paso County, Colorado Board of County Commissioners on the \_\_\_\_\_ day of \_\_\_\_\_, 2022, subject to any notes specified hereon and any conditions included in the resolution of approval. The dedications of land to the public streets and easements are accepted, but public improvements thereon will not become the maintenance responsibility of El Paso County until preliminary acceptance of the public improvements in accordance with the requirements of the Land Development Code and Engineering Criteria Manual, and the Subdivision Improvements Agreement.

\_\_\_\_\_  
Chair, Board of County Commissioners Date

\_\_\_\_\_  
Director, Planning and Community Development Department Date

\_\_\_\_\_  
El Paso County Assessor Date

**RECORDINGS:**

STATE OF COLORADO )  
COUNTY OF EL PASO ) SS

I hereby certify that this instrument was filed for record in my office at \_\_\_\_\_ O'clock \_\_\_\_M. this \_\_\_\_\_ day of \_\_\_\_\_, 2022 A.D., and is duly recorded under Reception Number \_\_\_\_\_ of the records of El Paso County, State of Colorado.

Chuck Broerman, Recorder


By: \_\_\_\_\_ Deputy \_\_\_\_\_ Date

**SURVEYOR'S CERTIFICATION:**

I, Tim Sloan, a duly registered Professional Land Surveyor in the State of Colorado, do hereby certify that this plat truly and correctly represents the results of a survey made on November 19, 2020, by me or under my direct supervision and that all monuments exist as shown hereon; that mathematical closure errors are less than 1:10,000; and that said plat has been prepared in full compliance with all applicable laws of the State of Colorado dealing with monuments, subdivision, or surveying of land and all applicable provisions of the El Paso County Land Development Code.

I attest the above on this \_\_\_\_\_ day of \_\_\_\_\_, 20\_\_\_\_.

Tim Sloan, Professional Surveyor  
Colorado Registered PLS #38374

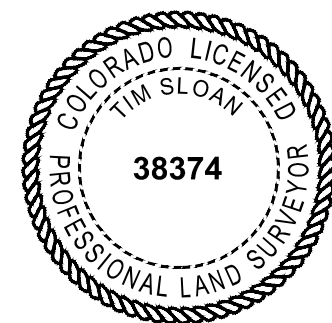

**KNOW ALL MEN BY THESE PRESENTS:**

That the undersigned, Colt H. Haugen and Kathryn E. Haugen, being the owners of the following described tract of land:

**TO WIT:**

**PROPERTY DESCRIPTION:**

A tract of land in the West Half of Section 7, Township 11 South, Range 65 West of the Sixth Principal Meridian, El Paso County, Colorado described as follows:

Beginning at Southwest Corner of the Northwest Quarter of said Section 7; thence N 00°27'25" W 1327.15 feet along the West Line of the Northwest Quarter of said Section 7; thence N 89°26'01" W 613.18 feet; thence S 00°32'12" W 1438.50 feet; thence S 89°17'56" W 555.17 feet; thence S 00°27'45" E 944.10 feet; thence N 89°16'27" W 807.45 feet; thence S 00°27'25" E 270.00 feet; thence S 89°16'28" W 867.42 feet; thence N 00°27'45" W 1326.92 feet to the point of beginning, containing 27.0 acres.

Subject to easements and restrictions of record.

**DEDICATION:**

The undersigned, being all the Owners, Mortgages, Beneficiaries of Deeds of Trust and holders of other interests in the land described herein, have laid out, subdivided, and platted said lands into lots and easements as shown hereon under the name and subdivision of "Owl Ridge Subdivision". All public improvements so platted are hereby dedicated to public use and said Owner does hereby covenant and agree that the public improvements will be constructed to El Paso County standards and that proper drainage and erosion control for same will be provided at said Owner's expense, all to the satisfaction of the Board of County Commissioners of El Paso County, Colorado. Upon acceptance by resolution, all public improvements so dedicated will become matters of maintenance by El Paso County, Colorado. The utility easements shown hereon are hereby dedicated for public utilities and communication systems and other purposes as shown hereon. The entities responsible for providing the services for which the easements are established are hereby granted the perpetual right of ingress and egress from and to adjacent properties for installation, maintenance, and replacement of utility lines and related facilities.

**IN WITNESS WHEREOF:**

The aforementioned Colt H. Haugen and Kathryn E. Haugen, has executed this instrument this \_\_\_\_\_ day of \_\_\_\_\_, 2022 A.D.

\_\_\_\_\_  
Colt H. Haugen Kathryn E. Haugen

**NOTARIAL:**

STATE OF COLORADO )  
COUNTY OF EL PASO ) SS

The foregoing instrument was acknowledged before me this \_\_\_\_\_ day of \_\_\_\_\_, 2022 A.D. by Colt H. Haugen and Kathryn E. Haugen

Witness my hand and seal \_\_\_\_\_

Address \_\_\_\_\_  
\_\_\_\_\_

My Commission expires \_\_\_\_\_

DATE SUBMITTED: 11/28/2022
REVISIONS:



Civil Engineering • Land Surveying • Landscape Architecture  
www.smhconsultants.com  
Manhattan, KS - HQ P: (785) 776-0541 • Dodge City, KS P: (620) 255-1952  
Kansas City, KS P: (913) 444-9615 • Colorado Springs, CO P: (719) 465-2145  
Drawn By: ATJ Project 2010CS4031 DD TDS87 PCD File #MS-22-005

NOVEMBER 2022