



EL PASO COUNTY PLANNING & COMMUNITY DEVELOPMENT
SIGN APPLICATION

Incorrect schedule
number

DATE:

Business

Name: Aspen View Homes
Address: 555 Middle Creek
Dkwy, Ste 380
Co Springs Co 80921
Zone: _____
Legal Description: _____

Type of Sign

Illuminated: _____
Non-Illuminated: X
Valuation: _____

Storefront Length &/or
Width: _____

Proposed Sign Sq. Ft. 8x6


Existing Sign Sq. Ft. _____

Total Sign Sq. Ft. _____

Contractor Information

Name: Fusion Sign & Design
Address: 4165 Sinton Rd
Co Springs Co 80907
Phone: 719-303-5144
Type of License: BIDG DSA
Contractor ID# 19271

Vicinity Map
Tax Schedule # 5906203001
Please show major intersections.

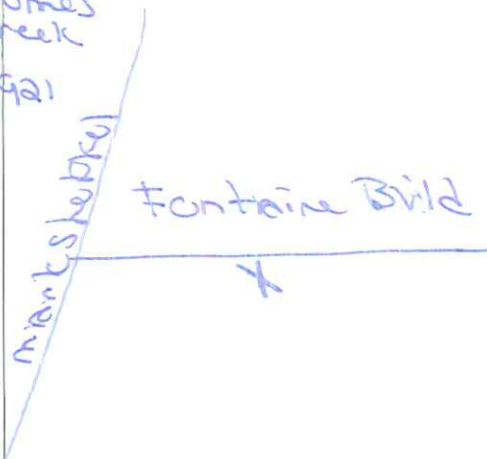

Elevation Drawing
Indicate storefront length & placement of
sign.

Sign Plan
(Please indicate dimensions and sign copy)

See Attachment

For Planning & Community Development Use Only

Approved Date: _____ Resubmittal? Yes _____ No _____
Denied Date: _____
Comments: _____

Fee of \$262.00 must accompany this Application. Additional signs at time of first Application are \$125.00. Make checks payable to El Paso County.

Markup Summary

dsdkendall (1)

COUNTY PLANNING & COMM
SIGN APPLICATION

Subject: Text Box
Page Label: 1
Author: dsdkendall
Date: 8/23/2018 2:42:03 PM
Color: ■

Incorrect schedule number

Incorrect schedule
number

