

Drainage Report

17115 GOSHAWK ROAD
COLORADO SPRINGS, CO 80908
EL PASO COUNTY

PREPARED FOR: MR. ARVIN LOUDERMILK
17115 GOSHAWK ROAD
COLORADO SPRINGS, CO 80908

April 5, 2019

Prepared by
Richard Lyon, P.E.
Rocky Mountain Group
2910 Austin Bluffs Parkway | Colorado Springs, CO 80918




PCD File No. MS192

Drainage Report Statements

1. Engineer's Statement:

This report and plan for the preliminary drainage design of the Loudermilk Minor Subdivision was prepared by me (or under my direct supervision) in accordance with the provisions of El Paso County Drainage Design and Technical Criteria for the owners thereof. I understand that El Paso County does not and will not assume liability for drainage facilities designed by other :


Richard D. Lyon 53921
Colorado P.E. No.



2. Developer's Statement:

I, the developer have read and will comply with all of the requirements specified in this drainage report and plan.


Loudermilk Living Trust
Business Name

By: Cheryl Loudermilk

Title: Trustee

Address: 17115 E. Goshawk Road

Colorado Springs, CO 80908

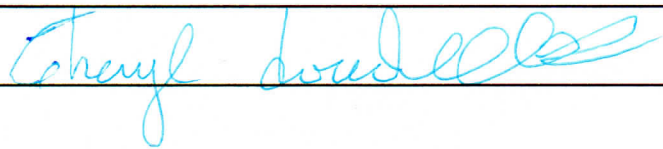

3. EL PASO COUNTY:

Filed in accordance with the requirements of the Drainage Criteria Manual, Volumes 1 and 2, El Paso County Engineering Criteria Manual and Land Development Code as amended.

Jennifer Irvine, P.E.
County Engineer / ECM Administrator

Date

Conditions:

Table of Contents

I.	General Location and Description.....	1
A.	Location.....	1
B.	Description of Property	1
II.	Existing and Proposed Drainage Basins and Subbasins	2
A.	Major Basin Description	2
B.	Existing Subbasin Descriptions.....	2
C.	Proposed Subbasin Descriptions	3
III.	Drainage Design Criteria	5
A.	Development Criteria Reference.....	5
B.	Hydrologic Criteria	5
IV.	Drainage Facility Design	7
A.	General Concept.....	7
B.	Specific Details	7
C.	Four-Step Process.....	8
V.	Drawings	9
A.	General Location Map.....	9
B.	Drainage Plan	9

Appendices

Appendix A – General Location Map, Assessor Maps, Survey/Plat Maps

Appendix B –FEMA Floodplain Map

Appendix C – USDA Soils Map

Appendix D – Hydrologic and Hydraulic Calculations

Appendix E – Drainage Plan Exhibits including Elevations Exhibit, Existing Subbasins, and
Proposed Subbasins

I. General Location and Description

A. Location

The project addresses of 17115 Goshawk Road East and 0 Goshawk Road East are located in Colorado Springs in El Paso County, Colorado. The township, range, and section code is S23 T11S R65W includes the two parcels owned by Loudermilk Living Trust and are schedule numbers 5123000014 and 5123000013, as shown in Appendix A. The parcels are approximately a half of a mile north of Hodgen Road, 1.25 miles west of North Meridian Road, and within 3.5 miles of the northern county border. The parcels are a quarter of a mile northwest of the West Kiowa Creek and are divided at an easement for overhead electric lines running north and south. Drainage and utilities easements are shown on the survey plat provided in the Appendix A. The property and the subdivisions in the vicinity flow to the Kiowa Creek watershed and are nearest the Kiowa Creek Watershed 1-N-10 Reservoir. The nearby platted developments include sections of Sec. 23-11-65 and Meridian Ranch to the east.

B. Description of Property

The properties are approximately 19.87 acres with 17115 Goshawk Road East accounting for 15.96 acres and 0 Goshawk Road East accounting for 4.04 acres. The vast majority of the parcels consist of vegetation, shrubbery, and fields. Existing development currently consists of a single family residence with various detached structures including a garage, two sheds, and a pool building currently under construction at 17115 Goshawk Road East. There is no existing or proposed development on the east parcel. A vicinity map, survey maps with the legal description of the parcel and topography is provided in Appendix A.

The developed property contains an existing 990 lineal foot gravel driveway from Goshawk Road East which terminates to the existing shed. The existing structures and their approximate roof areas are as follows: single family residence of 4,445 square feet; pool building additions of 2,612 square feet; detached garage of 1,632 square feet; shed 1 of 1,618 square feet; shed 2 of 584 square feet; and a barn of 2,024 square feet.

The Owners plan to build a single-family residence following the subdivision of the west parcel into a separate lot. As such, a minor subdivision is required by El Paso County prior to obtaining a building permit.

The general ground cover consists of tall grasses and weeds with landscaping around the existing single family residence. Deciduous trees and vegetation are denser near the western portion of the property. The general topography consists of natural flat areas nearing 1 percent slope to areas of drainage ways at 25 percent slopes from north to south. Field areas make up about two-thirds of the parcel and are generally within 10 percent slope. The other third of the parcel consists of sloped landscape to depressions that convey storm water to the West Kiowa Creek and are generally sloped from 10 to 25 percent. The overall elevation difference from the highest point in the northwest corner of the property to the lowest point about 400 feet east of the southwest property corner is about 36 feet.

The soil conditions are described in a Geology and Soils Report prepared by RMG-Rocky Mountain Group and are described as well-draining to high-draining sandy loam soils. Additionally, a USDA soil survey map is provided in Appendix C for reference.

The properties consists of some major drainage ways that ultimately drain to the West Kiowa Creek drainage way. The on-site major drainage ways consist of elevation depressions that flow from north to south. The existing development contains a gravel roadway that crosses through a drainage way and a stand pipe connected to a culvert pipe is currently installed for conveyance. A culvert pipe is proposed to replace the stand pipe for the proposed minor subdivision. There are no known irrigation facilities or utilities and other encumbrances in respect to drainage patterns on the site.

Further sections will refer to the two parcels as a combined 19.87 acre property as it was analyzed in engineering exhibits and calculations.

II. Existing and Proposed Drainage Basins and Subbasins

A. Major Basin Description

The parcel falls within the southeast region of FEMA Floodplain Map Number 08041C0310G dated December 7, 2018 showing a designation of Zone X, an area of minimal flood hazard. The map is provided in Appendix B. The major basin that the parcel falls within sheet flows from the north to the south to the West Kiowa Creek drainage way. There are no identified nearby irrigation facilities or other obstruction which could influence or be included by the local drainage.

B. Existing Subbasin Descriptions

The existing subbasins are delineated according to major drainage ways as determined by the natural topography of the land and any drainage infrastructure. The Loudermilk parcel plus the additional 4.04 acre parcel to the east (schedule no. 5123000013) was delineated into five subbasins and are described as follows:

Subbasin EX-1 is the 5.87 acre subbasin consisting of the area north of the gravel roadway to the existing single-family residence that flows into the existing stand pipe and culvert under the gravel roadway that is to be replaced with an 18" CMP culvert pipe. The subbasin contains impervious area due to existing gravel roadways, a single-family residence with addition, and various hardscape and detached buildings. The vast majority of the subbasin consists of tall grasses and weeds with dense deciduous trees and vegetation. This subbasin ultimately flows to the West Kiowa Creek and is added to Subbasin EX-2 for a final point of concentration at the southern property line.

Subbasin EX-2 is the 4.78 acre subbasin that consists of the west side of the parcel, the outlet of the standpipe and outlet drainage infrastructure, and the south side of the gravel roadway. As with most of the property, the vast majority of this subbasin consists of tall grasses and weeds. This sub-basin, in combination with Subbasin EX-1, provides a storm water volume within a drainage way to the south of the property which ultimately reaches the West Kiowa Creek. There is an existing 18" CMP culvert at the driveway entrance to the property off of Goshawk Road and Design Point #2 refers to the portion of Subbasin EX-2 that flows through this culvert.

Subbasin EX-3 is the 3.85 acre subbasin consisting of some detached structures and gravel roadway. The subbasin flows south through a drainage way in the form of an elevation depression that ultimately flows to the West Kiowa Creek. The survey limits do not show if this delineation meets with Subbasins EX-1 and EX-2 and so it was delineated as its own subbasin.

Subbasin EX-4 is the 3.47 acre subbasin that consists entirely of tall grasses and weeds that flows to the southeast property corner. This major drainage way includes part of the 4.04 acre parcel also owned by the Loudermilk Living Trust to the east. The subbasin ultimately flows to the West Kiowa Creek.

Subbasin EX-5 is the 1.83 acre subbasin to the northeast of the property which includes the 4.04 acre parcel also owned by the Loudermilk Living Trust. The drainage way flows south east to the West Kiowa Creek. The survey limits do not show if this delineation meets with Subbasin EX-4 and so it was delineated as its own subbasin.

Off-site Flow: The property address 17215 Goshawk Road E. to the north of the Loudermilk Living Trust parcel general flows through the property and consists of tall grasses, shrubs, and nearly full vegetative cover with approximately a third of the property consisting of trees. This off-site sheet flow has sufficient grass/vegetative buffer prior to entering the property. Areas to the north of 17215 Goshawk Road E. sheet flows to the east into the electrical easement and toward the creek. Properties to the west of Goshawk Road E. flow to the west roadside ditch and due south toward the creek. Offsite (OS) subbasins are depicted in the subbasin delineation exhibits.

C. Proposed Subbasin Descriptions

The proposed subbasins are within the proposed minor subdivision parcel as well as the existing property limits and are delineated according to major drainage ways as determined by the natural topography of the land and any drainage infrastructure. The post-development conditions are shown with the new minor subdivision parcel lines and the subbasins are delineated for proposed conditions. The rest of the parcel is delineated accordingly.

Development Subbasin 1 is the 3.75 acre subbasin consisting of the proposed house with a concrete driveway turnaround and a gravel driveway. The proposed single-family home will

Please see comments on drainage plan.

require an on-site wastewater treatment system and grading will be proposed via a grading and drainage plan to convey flow to the drainage way consistent with Subbasin EX-1 which flows to a new 18" CMP culvert pipe under the existing gravel driveway to the existing single-family residence. As with all drainage ways within the minor subdivision parcels, the flow ultimately goes to the West Kiowa Creek.

Development Subbasin 2 is the 1.36 acre subbasin consisting of the northwest corner of the new minor subdivision parcel that flows south to Subbasin EX-2. Sheet flow will go over the driveway and an 18" CMP culvert will be installed at Goshawk Road. The flow ultimately goes to the West Kiowa Creek.

Subbasin EX-1 is reduced to a 3.42 acre subbasin in order to delineate between the subdivided parcels. The flow patterns remain the same as historical conditions.

Subbasin EX-2 is reduced to a 2.17 acre subbasin in order to delineate between the subdivided parcels. The flow pattern remains the same as historical conditions.

Subbasin EX-3 is slightly reduced to a 3.81 acre subbasin in order to delineate between the subdivided parcels with some of the development basin delineated to include some of the northern portion. The flow pattern remains the same as historical conditions.

Subbasin EX-4 is the 3.47 acre subbasin that consists entirely of tall grasses and weeds that flows to the southeast property corner. This major drainage way includes part of the 4.04 acre parcel also owned by the Loudermilk Living Trust to the east. The subbasin ultimately flows to the West Kiowa Creek.

Subbasin EX-5 is the 1.83 acre subbasin to the northeast of the property which includes the 4.04 acre parcel also owned by the Loudermilk Living Trust. The drainage way flows south east to the West Kiowa Creek. The survey limits do not show if this delineation meets with Subbasin EX-4 and so it was delineated as its own subbasin.

Offsite drainage patterns upstream are not expected to adversely affect development on the new minor subdivision parcel. Engineered grading plans can properly convey the upstream flow away from the building structure and septic area to the historic point of concentration as needed. Downstream drainage patterns will be not changed due to development within the new minor subdivision parcel. Upstream off-site flow also includes no impervious area with the exception of Goshawk Road Subbasin OS-2.

III. Drainage Design Criteria

A. Development Criteria Reference

Colorado Urban Drainage and Flood Control District Drainage Criteria Manual, Volume I (January 2016)

Colorado Urban Drainage and Flood Control District Drainage Criteria Manual, Volume III (April 2018)

Urban Storm Drainage Criteria Manual, Volume III (November, 2015)

No previous PDR, DBPSs, or master plan drainage reports/studies have been developed for this area. As such, a drainage study in the format of a Preliminary and Final Drainage Report is presented for the application of a minor subdivision in order to demonstrate the hydrological and hydraulic conditions for the existing and post-development conditions within the subdivision.

B. Hydrologic Criteria

The design rainfall is according to NOAA Rainfall Data provided in Appendix E. The data for the one-hour rainfall depths were used for inputs in the UD-Rational Method calculator for storms 2 through 500. The rational method tabulations and any drainage infrastructure calculations are provided in Appendix E.

The flows in cubic feet per second (cfs) for a 5-year, 10-year, and 100-year storm event per subbasin and design points are summarized in the following table for the existing and post-development conditions:

Existing Conditions Flows

Subbasin Name	5-Year	10-Year	100-Year
EX-1	0.35	0.48	4.02
EX-2	0.31	0.43	3.35
DP1: OS-1 + EX-1	0.49	0.67	6.79
EX-3	0.30	0.41	2.90
EX-4	0.04	0.06	1.76
EX-5	0.02	0.03	0.97

OS-1	0.14	0.20	6.06
OS-2	0.35	0.46	2.19
OS-4	0.00	0.00	0.05
OS-5	0.08	0.12	3.60

The total storm water flow from the parcel plus offsite upstream sheet flow to the West Kiowa Creek watershed is 1.59 cfs for a 5-year storm event, 2.19 cfs for a 10-year storm event, and 24.90 cfs for a 100-year storm event. The Loudermilk Parcel accounts for 1.02 cfs for a 5-year storm event, 1.41 cfs for a 10-year storm event, and 13.00 cfs for a 100-year storm event.

Post-Developed Conditions Flows

Please include DP3 in the post-developed flows table.

Subbasin Name	5-Year	10-Year	100-Year
DV-1	0.25	0.35	2.75
DV-2	0.17	0.23	1.33
EX-1	0.43	0.57	2.47
DP1: DV-2 + EX-1 (culvert inlet)	0.33	0.63	3.42
EX-2	0.22	0.30	2.44
DP2: DV-1 (DW entry culvert)	0.83	1.13	8.23
EX-3	0.30	0.41	2.89
EX-4	0.04	0.06	1.76
EX-5	0.02	0.03	0.97
OS-1	0.14	0.20	6.06
OS-2	0.35	0.46	2.19
OS-4	0.00	0.00	0.05
OS-5	0.08	0.12	3.60

Design Point 2 doesn't match what is on the drainage plan/calculations. Per the drainage plan, DP2 consists of OS2, DV2, and EX2. Revise the text and flows accordingly.

Design point 1 doesn't match what is on the drainage plan/calculations. Per the drainage plan DP1 consists of OS1, DV1, and EX1. Revise the text and flows accordingly.

The total storm water flow from the parcel plus offsite sheet flow from the upstream property to the West Kiowa Creek watershed is 2.00 cfs for a 5-year storm event, 2.73 cfs for a 10-year storm event, and 26.51 cfs for a 100-year storm event.

The Loudermilk Minor Subdivision accounts for 1.43 cfs for a 5-year storm event, 1.95 cfs for a 10-year storm event, and 14.61 cfs for a 100-year storm event.

For the entire assessed area (including offsite drainage), these are increases of 0.41 cfs for a 5-year storm event, 0.54 cfs for a 10-year storm event, and 1.61 cfs for a 100-year storm event. These are very minimal increases in storm flow to the West Kiowa Creek watershed. The greatest point of interest is the inlet of the proposed culvert pipe that crosses the existing gravel road and ensuring that the culvert pipe is sized properly for the post-development conditions (DP1).

Please show and label on the drainage plan

IV. Drainage Facility Design

A. General Concept

The general concept of the drainage across this parcel and within the drainage basin as a whole is to convey storm water sheet flow to the south and southeast to the West Kiowa Creek. The proposed minor subdivision will remain consistent with historical drainage patterns by implementing 18" CMP culvert pipes and eliminating channelized storm water flow via level spreaders of 14' length and varied widths per the engineering calculations provided in Appendix D. The proposed development will also reduce erosion and sediment runoff by implementing energy dissipation at the outlet of channelized storm flow outlets via rip-rap of $D_{50} = 6"$ and improve infiltration via plantings and landscaping of the proposed development. Culvert, level spreader, and rip-rap sizing calculations are included in the Appendix.

B. Specific Details

The hydrologic and hydraulic details are provided in the previous section. The post-development flow increase is 1.41 cfs for a 100-year storm event which is a minimal increase to the downstream properties and watershed. As stated previously, the proposed culvert pipe to replace the stand pipe and daylighted pipe under the existing gravel driveway will be analyzed to prevent standing water at the point of concentration or inlet of the culvert pipe. Rip-rap for energy dissipation and a level spreader will be designed at the outlet to eliminate channelized flow.

The proposed single-family residence will require grading and drainage plan(s) to show sheet flow from upstream areas away from structure foundations, away from the septic field, and to continue the historical drainage pattern to the proposed culvert pipe.

The proposed plan will not require any regular maintenance. It is recommended that the owner(s) inspect their respective culvert pipes to clear debris once a year and after major rainfall events such as 100-year storms or greater. Observing any soil settling that may alter the flowline grade of culvert pipes is also recommended to prevent backflow conditions.

C. Four-Step Process

The selection of appropriate BMPs is based on the characteristics of the site and potential pollutants. The Four-Step Process provides a method of going through the selection process. The following applies the four-step process to the preliminary development plan for the Loudermilk Minor Subdivision:

Step 1: Employ Runoff Reduction Practices

The preliminary development plan calls for the use of compacted gravel for the driveway off of Goshawk Road E. with the minimal amount of concrete pavement for the driveway apron at the entrance drive. The use of gravel provides reduced impervious area compared to a rigid pavement. Grass buffers are sufficient for the location of the build and drainage pattern with greater than 1:1 impervious (roof) to pervious grass landscape area. Additionally, grass swales will be graded to convey storm water toward the West Kiowa Creek.

Step 2: Stabilize Drainageways

A stabilized/constructed natural drainageway is to be implemented to convey stormwater from the developed area to the south side of the property. Engineered rip-rap and level spreaders are to be implemented for energy dissipation and reduction of erosion to downstream landscape.

Step 3: Provide Water Quality Capture Volume

The development of the minor subdivision will not require more than one acre of disturbance. BMPs such as porous pavement detention, porous landscape detention, extended detention basins, sand filter extended detention basins, constructed wetland basins, or a retention pond are unnecessary for a development of this size with adequate pervious landscaping downstream of the proposed development. Implementing the aforementioned best management practices will maintain the historical drainage patterns and reduce erosion. The flow chart (Figure I-1. BMP Requirements Flowchart for New Development and Redevelopment Sites – For Selecting Post-Construction BMPs in Compliance with El Paso County’s Stormwater NPDES Permit) from the El Paso County Engineering Criteria Manual indicates that a rural area development with less than one acre of disturbance with site tributary waters not classified as high risk does not require additional BMPs and methods for permanent sediment control is the main focus.

Step 4: Consider the Need for Industrial and Commercial BMPs

As this is not an industrial or commercial site, the need for specialized BMPs is not required. There will be no storage/handling areas or a need for permanent spill containment and control.

V. Drawings

A. General Location Map

See Appendix A.

B. Drainage Plan


See Attached Exhibits in Appendix D.

**Appendix A – General Location Map, Assessor Maps,
and Survey & Plat Maps**



17115 Goshawk Rd

Vicinity Map

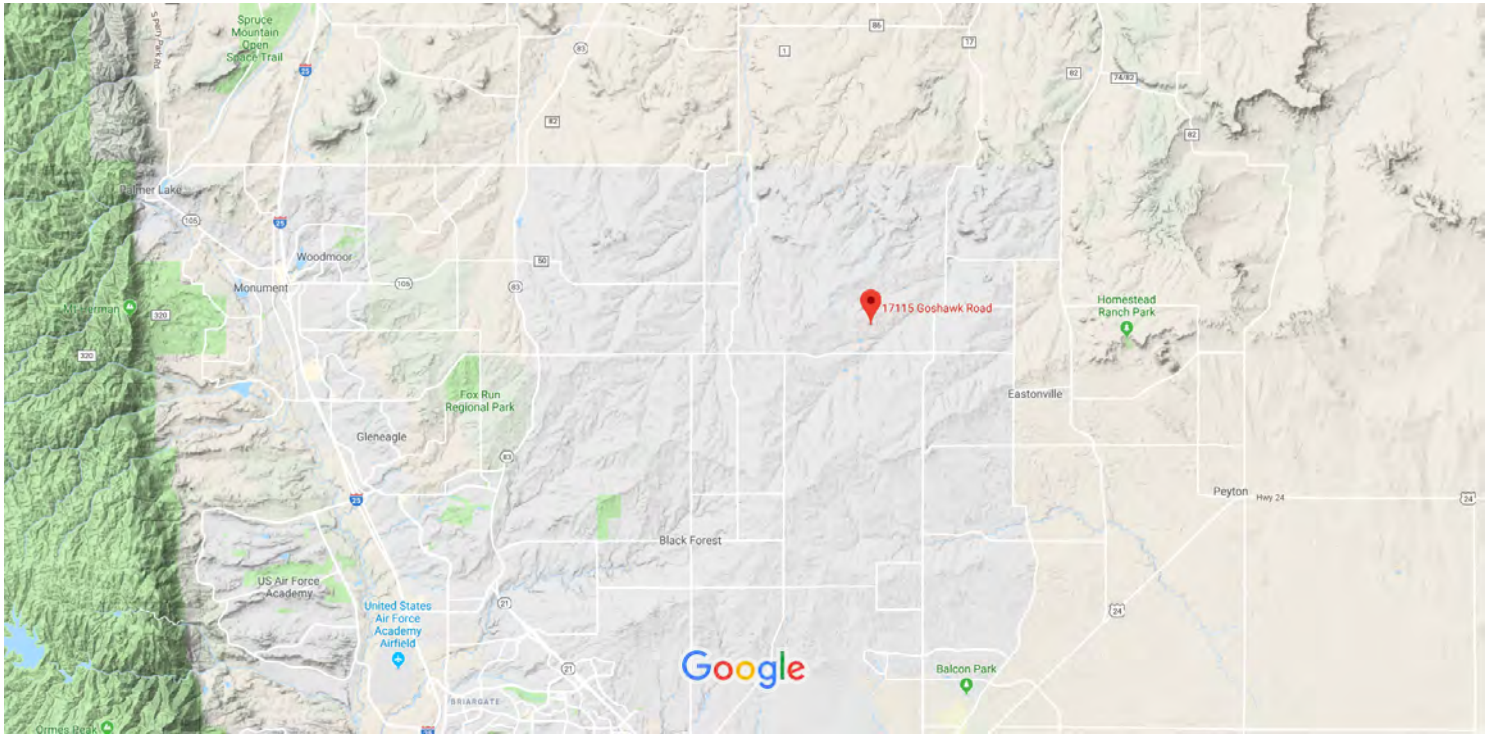

Map data ©2019 Google 2 mi



17115 Goshawk Rd

Colorado Springs, CO 80908



You visited 2 months ago



39HC+QH Black Forest, Colorado


El Paso County Assessor's Office

17115 GOSHAWK RD E

SCHEDULE: 5123000014

OWNER: LOUDERMILK LIVING TRUST

COPYRIGHT 2010 by the Board of County Commissioners, El Paso County, Colorado. All rights reserved. No part of this document or data contained hereon may be reproduced; used to prepare derivative products; or distributed without the specific written approval of the Board of County Commissioner, El Paso County, Colorado. This document was prepared from the best data available at the time of plotting and is for internal use only. El Paso County, Colorado, makes no claim as to the completeness or accuracy of the data contained hereon.

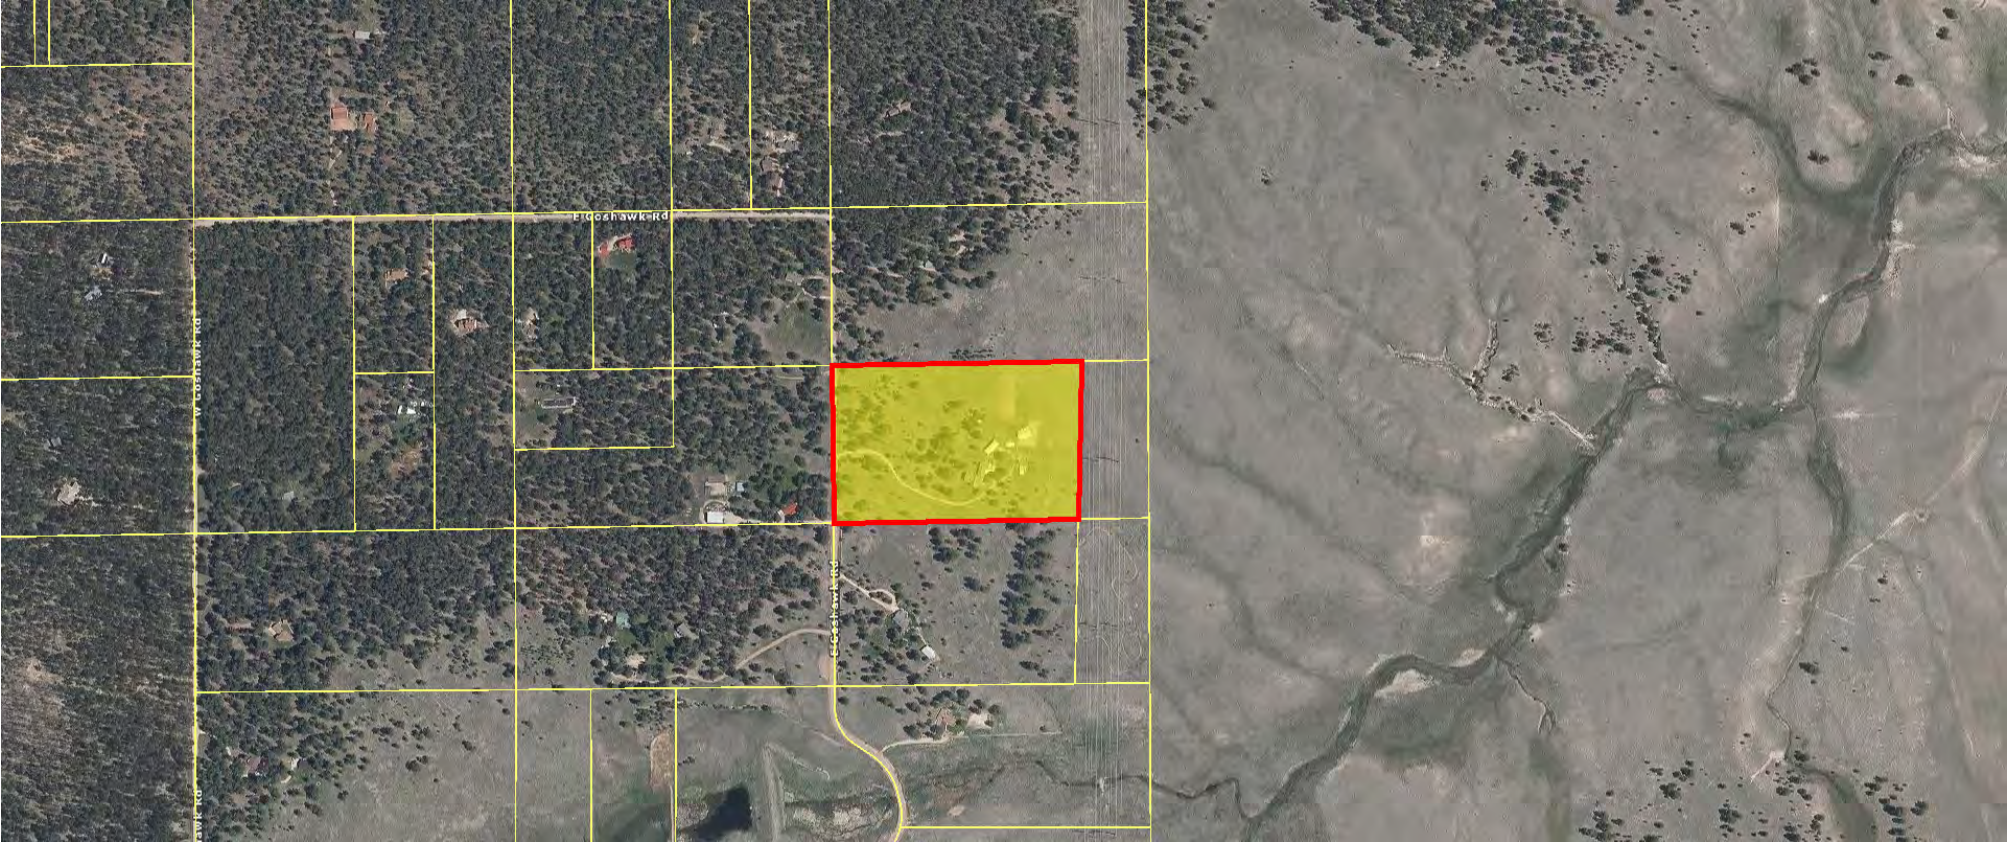

El Paso County Assessor's Office

0 GOSHAWK RD E

SCHEDULE: 5123000013


OWNER: LOUDERMILK LIVING TRUST

COPYRIGHT 2010 by the Board of County Commissioners, El Paso County, Colorado. All rights reserved. No part of this document or data contained hereon may be reproduced; used to prepare derivative products; or distributed without the specific written approval of the Board of County Commissioner, El Paso County, Colorado. This document was prepared from the best data available at the time of plotting and is for internal use only. El Paso County, Colorado, makes no claim as to the completeness or accuracy of the data contained hereon.



LOUDERMILK SUBDIVISION FILING NO. 1

IN THE NORTHEAST QUARTER OF SECTION 23, T11S, R65W, 6th P.M.
EL PASO COUNTY, COLORADO

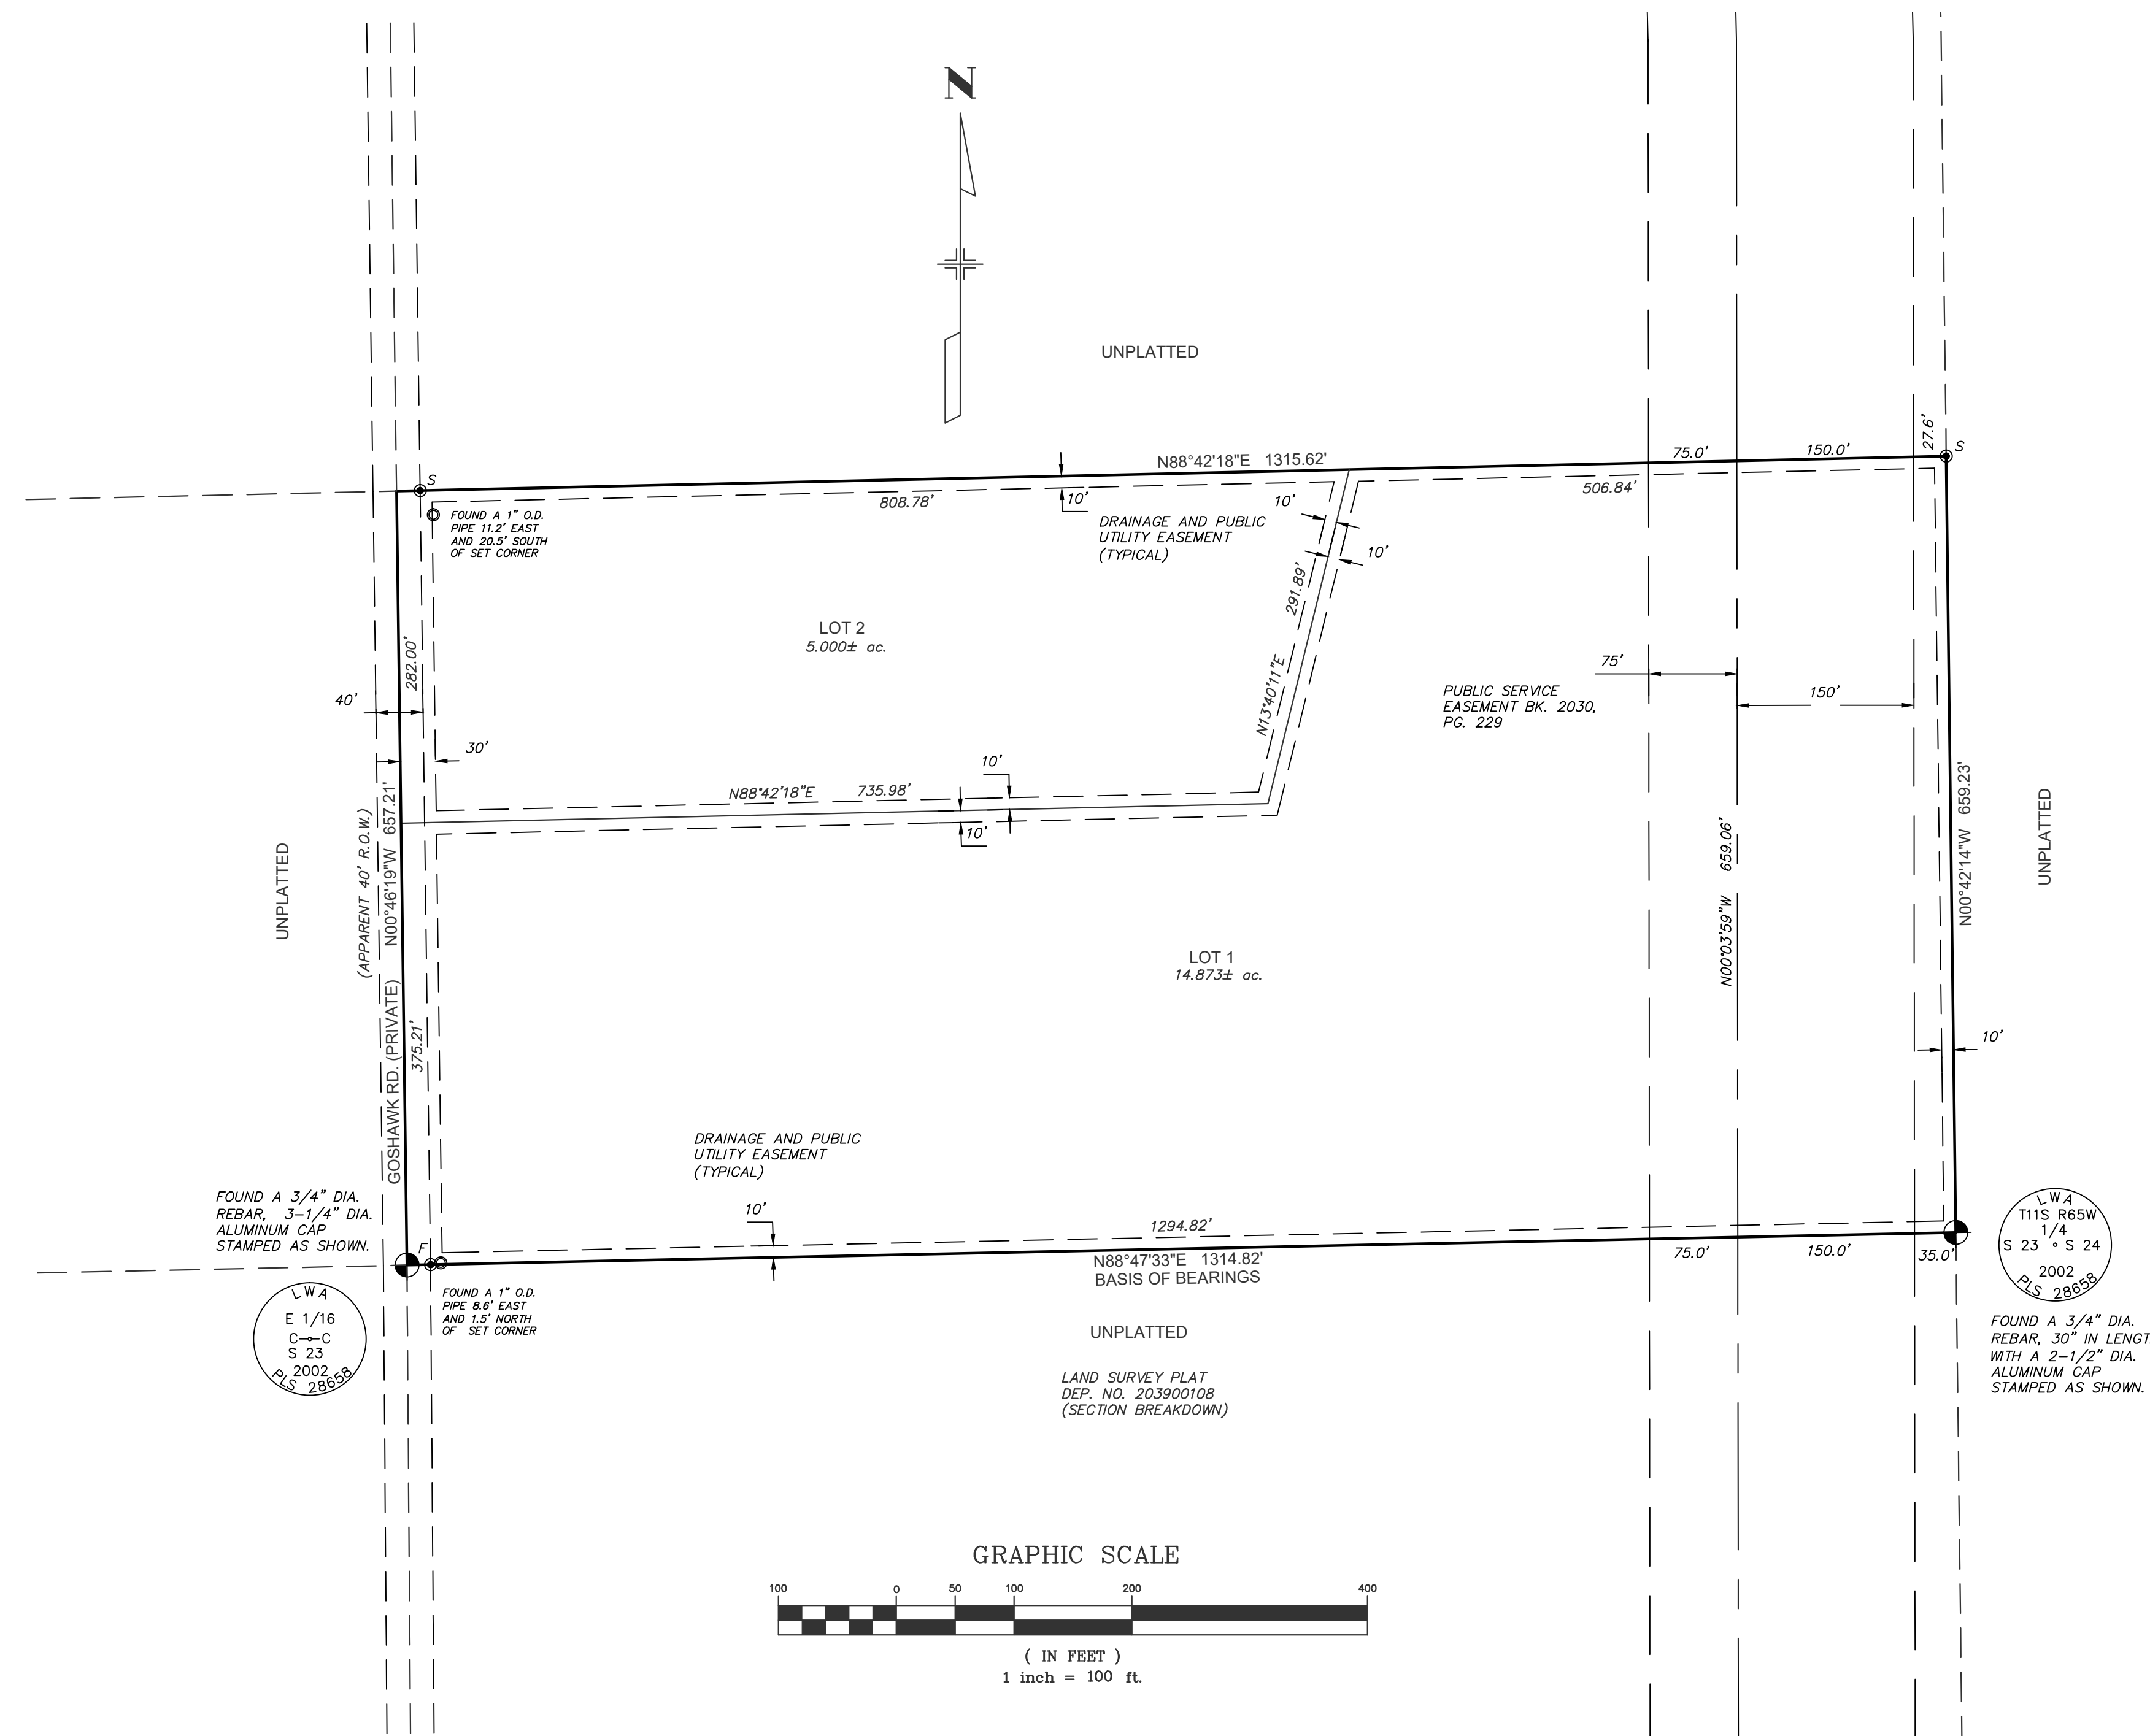

BE IT KNOWN BY THESE PRESENTS:

THE LOUDERMILK LIVING TRUST, _____, MANAGER, IS THE OWNER OF THE FOLLOWING DESCRIBED TRACT OF LAND, TO WIT:

THE SOUTH HALF OF THE SOUTHEAST QUARTER OF THE NORTHEAST QUARTER SECTION 23, TOWNSHIP 11 SOUTH, RANGE 65 WEST OF THE 6th PM., EL PASO COUNTY, COLORADO.

CONTAINING 19.873 ACRES, MORE OR LESS.

EASEMENTS:

SIDE AND REAR LOT LINES ARE HEREBY PLATTED WITH A TEN (10) FOOT EASEMENT FOR DRAINAGE AND PUBLIC UTILITIES ONLY; THE FRONT LOT LINES ARE HEREBY PLATTED WITH A THIRTY (30) FOOT EASEMENT FOR DRAINAGE AND PUBLIC UTILITIES ONLY, WITH THE SOLE RESPONSIBILITY FOR MAINTENANCE BEING VESTED WITH THE PROPERTY OWNERS.

OWNERS CERTIFICATE:

THE LOUDERMILK LIVING TRUST, _____, MANAGER, BEING THE OWNER, MORTGAGEES, BENEFICIARIES OF DEEDS OF TRUST AND HOLDERS OF OTHER INTERESTS IN THE LAND DESCRIBED HEREIN, HAVE LAID OUT, SUBDIVIDED AND PLATTED SAID LANDS INTO LOTS AND EASEMENTS AS SHOWN HEREON UNDER THE NAME AND SUBDIVISION OF LOUDERMILK SUBDIVISION FILING NO. 1. ALL PUBLIC IMPROVEMENTS SO PLATTED ARE HEREBY DEDICATED TO PUBLIC USE AND SAID OWNER DOES HEREBY COVENANT AND AGREE THAT THE PUBLIC IMPROVEMENTS WILL BE CONSTRUCTED TO EL PASO COUNTY STANDARDS AND THAT PROPER DRAINAGE AND EROSION CONTROL FOR THE SAME WILL BE PROVIDED AT SAID OWNER'S EXPENSE, ALL TO THE SATISFACTION OF THE BOARD OF COUNTY COMMISSIONERS OF EL PASO COUNTY, COLORADO. UPON ACCEPTANCE BY RESOLUTION, ALL PUBLIC IMPROVEMENTS SO DEDICATED WILL BECOME MATTERS OF MAINTENANCE BY EL PASO COUNTY, COLORADO. THE UTILITY EASEMENTS SHOWN HEREON ARE HEREBY DEDICATED FOR PUBLIC UTILITIES, COMMUNICATION SYSTEMS AND OTHER PURPOSES AS SHOWN HEREON. THE ENTITIES RESPONSIBLE FOR PROVIDING THE SERVICES FOR WHICH THE EASEMENTS ARE ESTABLISHED ARE HEREBY GRANTED THE PERPETUAL RIGHT OF INGRESS AND EGRESS FROM AND TO ADJACENT PROPERTIES FOR INSTALLATION, MAINTENANCE AND REPLACEMENT OF UTILITY LINES AND RELATED FACILITIES.

IN WITNESS WHEREOF:

THE AFOREMENTIONED THE LOUDERMILK LIVING TRUST, _____, MANAGER, HAS EXECUTED THIS INSTRUMENT THIS _____ DAY OF _____, 2019.

THE LOUDERMILK LIVING TRUST
_____, MANAGER

NOTARIAL:

STATE OF COLORADO)
COUNTY OF EL PASO) SS

THE FOREGOING INSTRUMENT WAS ACKNOWLEDGED BEFORE ME THIS _____ DAY OF _____, 2019 BY _____, MANAGER
THE LOUDERMILK LIVING TRUST

MY COMMISSION EXPIRES: _____ NOTARY PUBLIC

BOARD OF COUNTY COMMISSIONERS CERTIFICATE:

THIS PLAT FOR LOUDERMILK SUBDIVISION FILING NO. 1 WAS APPROVED FOR FILING BY THE EL PASO COUNTY, COLORADO BOARD OF COUNTY COMMISSIONERS ON THIS _____ DAY OF _____, 2019, SUBJECT TO ANY NOTES SPECIFIED HEREON AND ANY CONDITIONS INCLUDED IN THE RESOLUTION OF APPROVAL. THE DEDICATIONS OF LAND TO THE PUBLIC, STREETS, TRACTS AND EASEMENTS ARE ACCEPTED, BUT PUBLIC IMPROVEMENTS THEREON WILL NOT BECOME THE MAINTENANCE RESPONSIBILITY OF EL PASO COUNTY UNTIL PRELIMINARY ACCEPTANCE OF THE PUBLIC IMPROVEMENTS IN ACCORDANCE WITH THE REQUIREMENTS OF THE LAND DEVELOPMENT CODE AND ENGINEERING CRITERIA MANUAL, AND THE SUBDIVISION IMPROVEMENTS AGREEMENT.

PRESIDENT, BOARD OF COUNTY COMMISSIONERS DATE

DIRECTOR, COUNTY PLANNING AND COMMUNITY DEVELOPMENT DATE

COUNTY ASSESSOR DATE

NOTES:

THE PROPERTY IS SUBJECT TO AN APPARENT TWENTY (20) FOOT RIGHT OF WAY FOR GOSHAWK ROAD. THE ROAD IS POSTED AS PRIVATE AND MAINTENANCE IS THE RESPONSIBILITY OF THE HOMEOWNERS ASSOCIATION.

THE BASIS OF BEARINGS FOR THIS SURVEY IS THE SOUTH LINE OF THE SOUTHEAST QUARTER OF THE NORTHEAST QUARTER OF SECTION 23, N88°47'33"E - 1314.82'. THE DIRECTION IS BASED ON THE LAND SURVEY PLAT BY LEIGH WHITEHEAD AND ASSOCIATES, 7/2/2003, DEPOSIT NUMBER 203900108, AND THE LINE IS MONUMENTED AS SHOWN.

UNITS OF MEASURE ARE U.S. SURVEY FEET

● FOUND ALIQUOT CORNER AS NOTED

○ FOUND MONUMENT AS NOTED

⊙ FOUND / SET A 5/8" DIAMETER REBAR, 18" IN LENGTH, WITH A 1-1/2" DIAMETER ALUMINUM CAP "LWA PLS 28658"

RESEARCH FOR RECORDED RIGHTS OF WAY AND EASEMENTS WAS DONE BY _____

THIS SURVEY DOES NOT CONSTITUTE A TITLE SEARCH BY LWA LAND SURVEYING, INC. OR KEVIN M. O'LEARY.

SURVEYOR'S CERTIFICATION:

I, KEVIN M. O'LEARY, A DULY REGISTERED PROFESSIONAL LAND SURVEYOR IN THE STATE OF COLORADO, DO HEREBY CERTIFY THAT THIS PLAT TRULY AND CORRECTLY REPRESENTS THE RESULTS OF A SURVEY MADE ON THE DATE OF THE SURVEY BY ME OR UNDER MY DIRECT SUPERVISION AND THAT ALL MONUMENTS EXIST AS SHOWN HEREON; THAT MATHEMATICAL CLOSURE ERRORS ARE LESS THAN 1:10,000; AND THAT SAID PLAT HAS BEEN PREPARED IN FULL COMPLIANCE WITH ALL APPLICABLE LAWS OF THE STATE OF COLORADO DEALING WITH MONUMENTS, SUBDIVISION, OR SURVEYING OF LAND AND ALL APPLICABLE PROVISIONS OF THE EL PASO COUNTY LAND DEVELOPMENT CODE.

I ATTEST THE ABOVE ON THIS _____ DAY OF _____, 2019.

KEVIN M. O'LEARY
COLORADO REGISTERED PLS #28658
FOR AND ON BEHALF OF
LWA LAND SURVEYING, INC.

DATE

"NOTICE: ACCORDING TO COLORADO LAW YOU MUST COMMENCE ANY LEGAL ACTION BASED UPON ANY DEFECT IN THIS SURVEY WITHIN THREE YEARS AFTER YOU FIRST DISCOVER SUCH DEFECT. IN NO EVENT MAY ANY ACTION BASED UPON ANY DEFECT IN THIS SURVEY BE COMMENCED MORE THAN TEN YEARS FROM THE DATE OF THE CERTIFICATION SHOWN HEREON."

RECORDING:

STATE OF COLORADO) SS
COUNTY OF EL PASO)

I HEREBY CERTIFY THAT THIS INSTRUMENT WAS FILED FOR RECORD AT MY OFFICE AT _____ O'CLOCK _____ M., THIS _____ DAY OF _____, 2019, AND IS DULY RECORDED AT RECEPTION NO. _____ OF THE RECORDS OF EL PASO COUNTY, COLORADO.

CHUCK BROERMAN
BY: _____
COUNTY CLERK AND RECORDER

FEE: _____
SURCHARGE: _____

FEES:

DRAINAGE FEES: _____
BRIDGE FEES: _____
SCHOOL FEES: _____
PARK FEES: _____

PREPARED BY
LWA LAND SURVEYING, INC.
953 EAST FILLMORE STREET
COLORADO SPRINGS, COLORADO 80907
Phone (719) 636-5179

SILVERADO RANCH
DECEMBER 19, 2018
PROJECT 18072
SHEET 1 OF 1


BLACK FOREST

CONTOUR INTERVAL: 1'
DATE OF PHOTOGRAPHY: 11-21-2018



MAP AND AUTOCAD FILE MADE IN AMERICA
BY LANDMARK MAPPING, LTD.
1650 NORTH OLL DRIVE, PUEBLO WEST, COLORADO, 81007
PHONE: (303) 922-2417
LANDMARK MAPPING PROJECT NUMBER: LM1814

- FIRE
- ◆ LPOLE
- MANHOLE
- SIGN
- ◆ UPOLE
- FENCE
- MISC
- TOWER
- PILE
- > < CULVERT
- ROCK
- IRRIGATION
- MAILBOX
- TREE
- TRAFFIC
- RP-RAP
- 3 POLE-ANCHOR

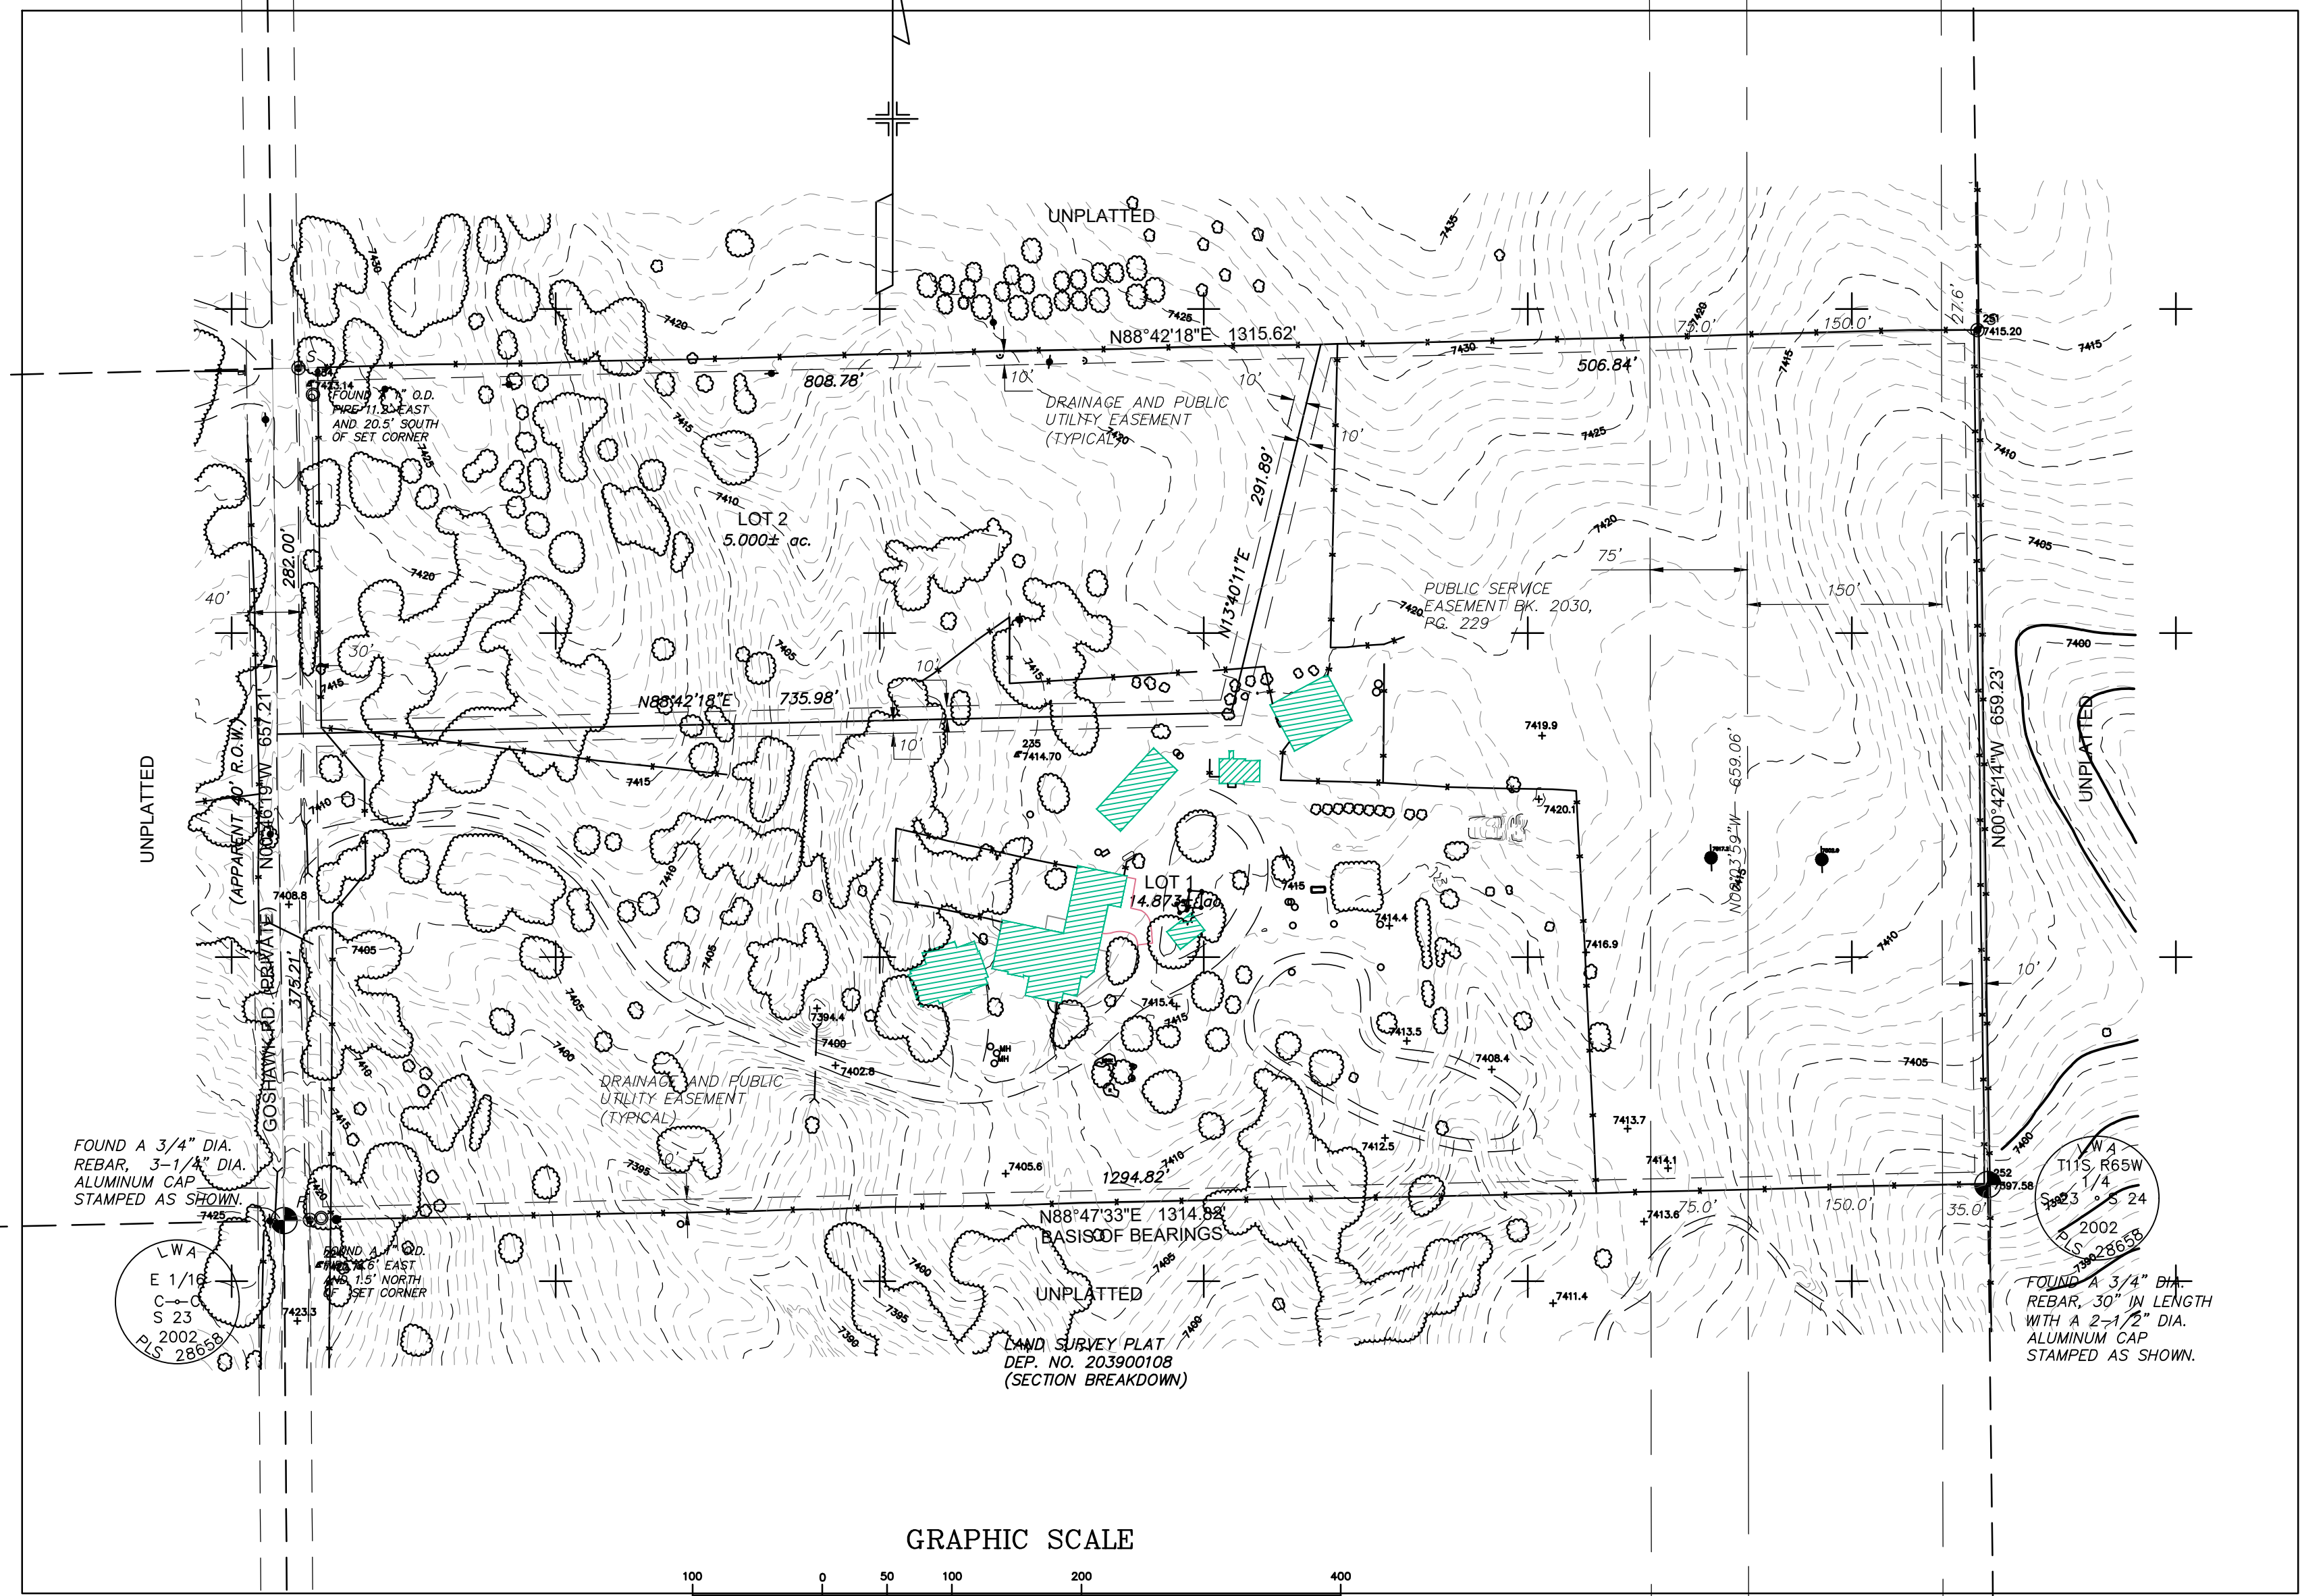

GRAPHIC SCALE



(IN FEET)
1 inch = 100 ft.

17115 GOSHAWK ROAD EAST
THE SOUTH HALF OF THE SOUTHEAST QUARTER OF THE
NORTHEAST QUARTER SECTION 23, TOWNSHIP 11 SOUTH, RANGE 65
WEST OF THE 6th PM.

THE PROPERTY IS SUBJECT TO AN APPARENT TWENTY (20) FOOT RIGHT OF WAY FOR GOSHAWK ROAD. THE ROAD IS POSTED AS PRIVATE AND MAINTENANCE IS THE RESPONSIBILITY OF THE HOMEOWNERS ASSOCIATION.

THE BASIS OF BEARINGS FOR THIS SURVEY IS THE SOUTH LINE OF THE SOUTHEAST QUARTER OF THE NORTHEAST QUARTER OF SECTION 23, N88°47'33"E - 1314.82'. THE DIRECTION IS BASED ON THE LAND SURVEY PLAT BY LEIGH WHITEHEAD AND ASSOCIATES, 7/2/2003, DEPOSIT NUMBER 203900108, AND THE LINE IS MONUMENTED AS SHOWN.

UNITS OF MEASURE ARE U.S. SURVEY FEET

- ◆ FOUND ALIQUOT CORNER AS NOTED
- FOUND MONUMENT AS NOTED
- FOUND / SET A 5/8" DIAMETER REBAR, 18" IN LENGTH, WITH A 1-1/2" DIAMETER ALUMINUM CAP "LWA PLS 28658"

RESEARCH FOR RECORDED RIGHTS OF WAY AND EASEMENTS WAS DONE BY _____
THIS SURVEY DOES NOT CONSTITUTE A TITLE SEARCH BY LWA LAND SURVEYING, INC. OR KEVIN M. O'LEARY.

Appendix B – FEMA Floodplain Map

NOTES TO USERS

This map is for use in administering the National Flood Insurance Program. It does not necessarily identify all areas subject to flooding, particularly from local drainage sources of small size. The community map repository should be consulted for possible updated or additional flood hazard information.

To obtain more detailed information in areas where **Base Flood Elevations (BFEs)** and/or **floodways** have been determined, users are encouraged to consult the Flood Profiles and Floodway Data and/or Summary of Stillwater Elevations tables contained within the Flood Insurance Study (FIS) report that accompanies this FIRM. Users should be aware that BFEs shown on the FIRM represent rounded whole-foot elevations. These BFEs are intended for flood insurance rating purposes only and should not be used as the sole source of flood elevation information. Accordingly, flood elevation data presented in the FIS report should be utilized in conjunction with the FIRM for purposes of construction and/or floodplain management.

Coastal Base Flood Elevations shown on this map apply only landward of 0.0' North American Vertical Datum of 1988 (NAVD88). Users of this FIRM should be aware that coastal flood elevations are also provided in the Summary of Stillwater Elevations table in the Flood Insurance Study report for this jurisdiction. Elevations shown in the Summary of Stillwater Elevations table should be used for construction and/or floodplain management purposes when they are higher than the elevations shown on this FIRM.

Boundaries of the **floodways** were computed at cross sections and interpolated between cross sections. The floodways were based on hydraulic considerations with regard to requirements of the National Flood Insurance Program. Floodway widths and other pertinent floodway data are provided in the Flood Insurance Study report for this jurisdiction.

Certain areas not in Special Flood Hazard Areas may be protected by **flood control structures**. Refer to section 2.4 "Flood Protection Measures" of the Flood Insurance Study report for information on flood control structures for this jurisdiction.

The **projection** used in the preparation of this map was Universal Transverse Mercator (UTM) zone 13. The **horizontal datum** was NAD83, GRS80 spheroid. Differences in datum, spheroid, projection or UTM zones zones used in the production of FIRMs for adjacent jurisdictions may result in slight positional differences in map features across jurisdiction boundaries. These differences do not affect the accuracy of this FIRM.

Flood elevations on this map are referenced to the **North American Vertical Datum of 1988 (NAVD88)**. These flood elevations must be compared to structure and ground elevations referenced to the same **vertical datum**. For information regarding conversion between the National Geodetic Vertical Datum of 1929 and the North American Vertical Datum of 1988, visit the National Geodetic Survey website at <http://www.ngs.noaa.gov/> or contact the National Geodetic Survey at the following address:

NGS Information Services
NOAA, NINCS12
National Geodetic Survey
SSMC-3, #9202
1315 East-West Highway
Silver Spring, MD 20910-3282

To obtain current elevation, description, and/or location information for **bench marks** shown on this map, please contact the Information Services Branch of the National Geodetic Survey at (301) 713-3242 or visit its website at <http://www.ngs.noaa.gov/>.

Base Map information shown on this FIRM was provided in digital format by El Paso County, Colorado Springs Utilities, City of Fountain, Bureau of Land Management, National Oceanic and Atmospheric Administration, United States Geological Survey, and Anderson Consulting Engineers, Inc. These data are current as of 2006.

This map reflects more detailed and up-to-date **stream channel configurations and floodplain delineations** than those shown on the previous FIRM for this jurisdiction. The floodplains and floodways that were transferred from the previous FIRM may have been adjusted to conform to these new stream channel configurations. As a result, the Flood Profiles and Floodway Data tables in the Flood Insurance Study Report (which contains authoritative hydraulic data) may reflect stream channel distances that differ from what is shown on this map. The profile baselines depicted on this map represent the hydraulic modeling baselines that match the flood profiles and Floodway Data Tables if applicable, in the FIS report. As a result, the profile baselines may deviate significantly from the new base map channel representation and may appear outside of the floodplain.

Corporate limits shown on this map are based on the best data available at the time of publication. Because changes due to annexations or de-annexations may have occurred after this map was published, map users should contact appropriate community officials to verify current corporate limit locations.

Please refer to the separately printed **Map Index** for an overview map of the county showing the layout of map panels; community map repository addresses; and a Listing of Communities table containing National Flood Insurance Program dates for each community as well as a listing of the panels on which each community is located.


Contact **FEMA Map Service Center (MSC)** via the FEMA Map Information eXchange (FMIX) 1-877-336-2627 for information on available products associated with this FIRM. Available products may include previously issued Letters of Map Change, a Flood Insurance Study Report, and/or digital versions of this map. The MSC may also be reached by Fax at 1-800-358-9620 and its website at <http://www.msc.fema.gov/>.

If you have **questions about this map** or questions concerning the National Flood Insurance Program in general, please call 1-877-FEMA MAP (1-877-336-2627) or visit the FEMA website at <http://www.fema.gov/business/nfp/>.

El Paso County Vertical Datum Offset Table

Flooding Source	Vertical Datum Offset (ft)
REFER TO SECTION 3.3 OF THE EL PASO COUNTY FLOOD INSURANCE STUDY FOR STREAM BY STREAM VERTICAL DATUM CONVERSION INFORMATION	


Panel Location Map

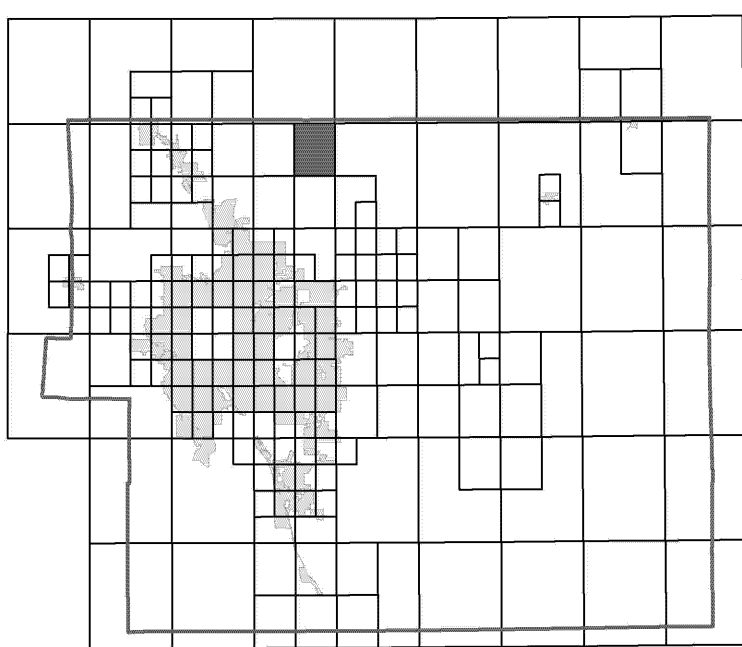

This Digital Flood Insurance Rate Map (DFIRM) was produced through a Cooperating Technical Partner (CTP) agreement between the State of Colorado Water Conservation Board (CWCB) and the Federal Emergency Management Agency (FEMA).



Additional Flood Hazard information and resources are available from local communities and the Colorado Water Conservation Board.

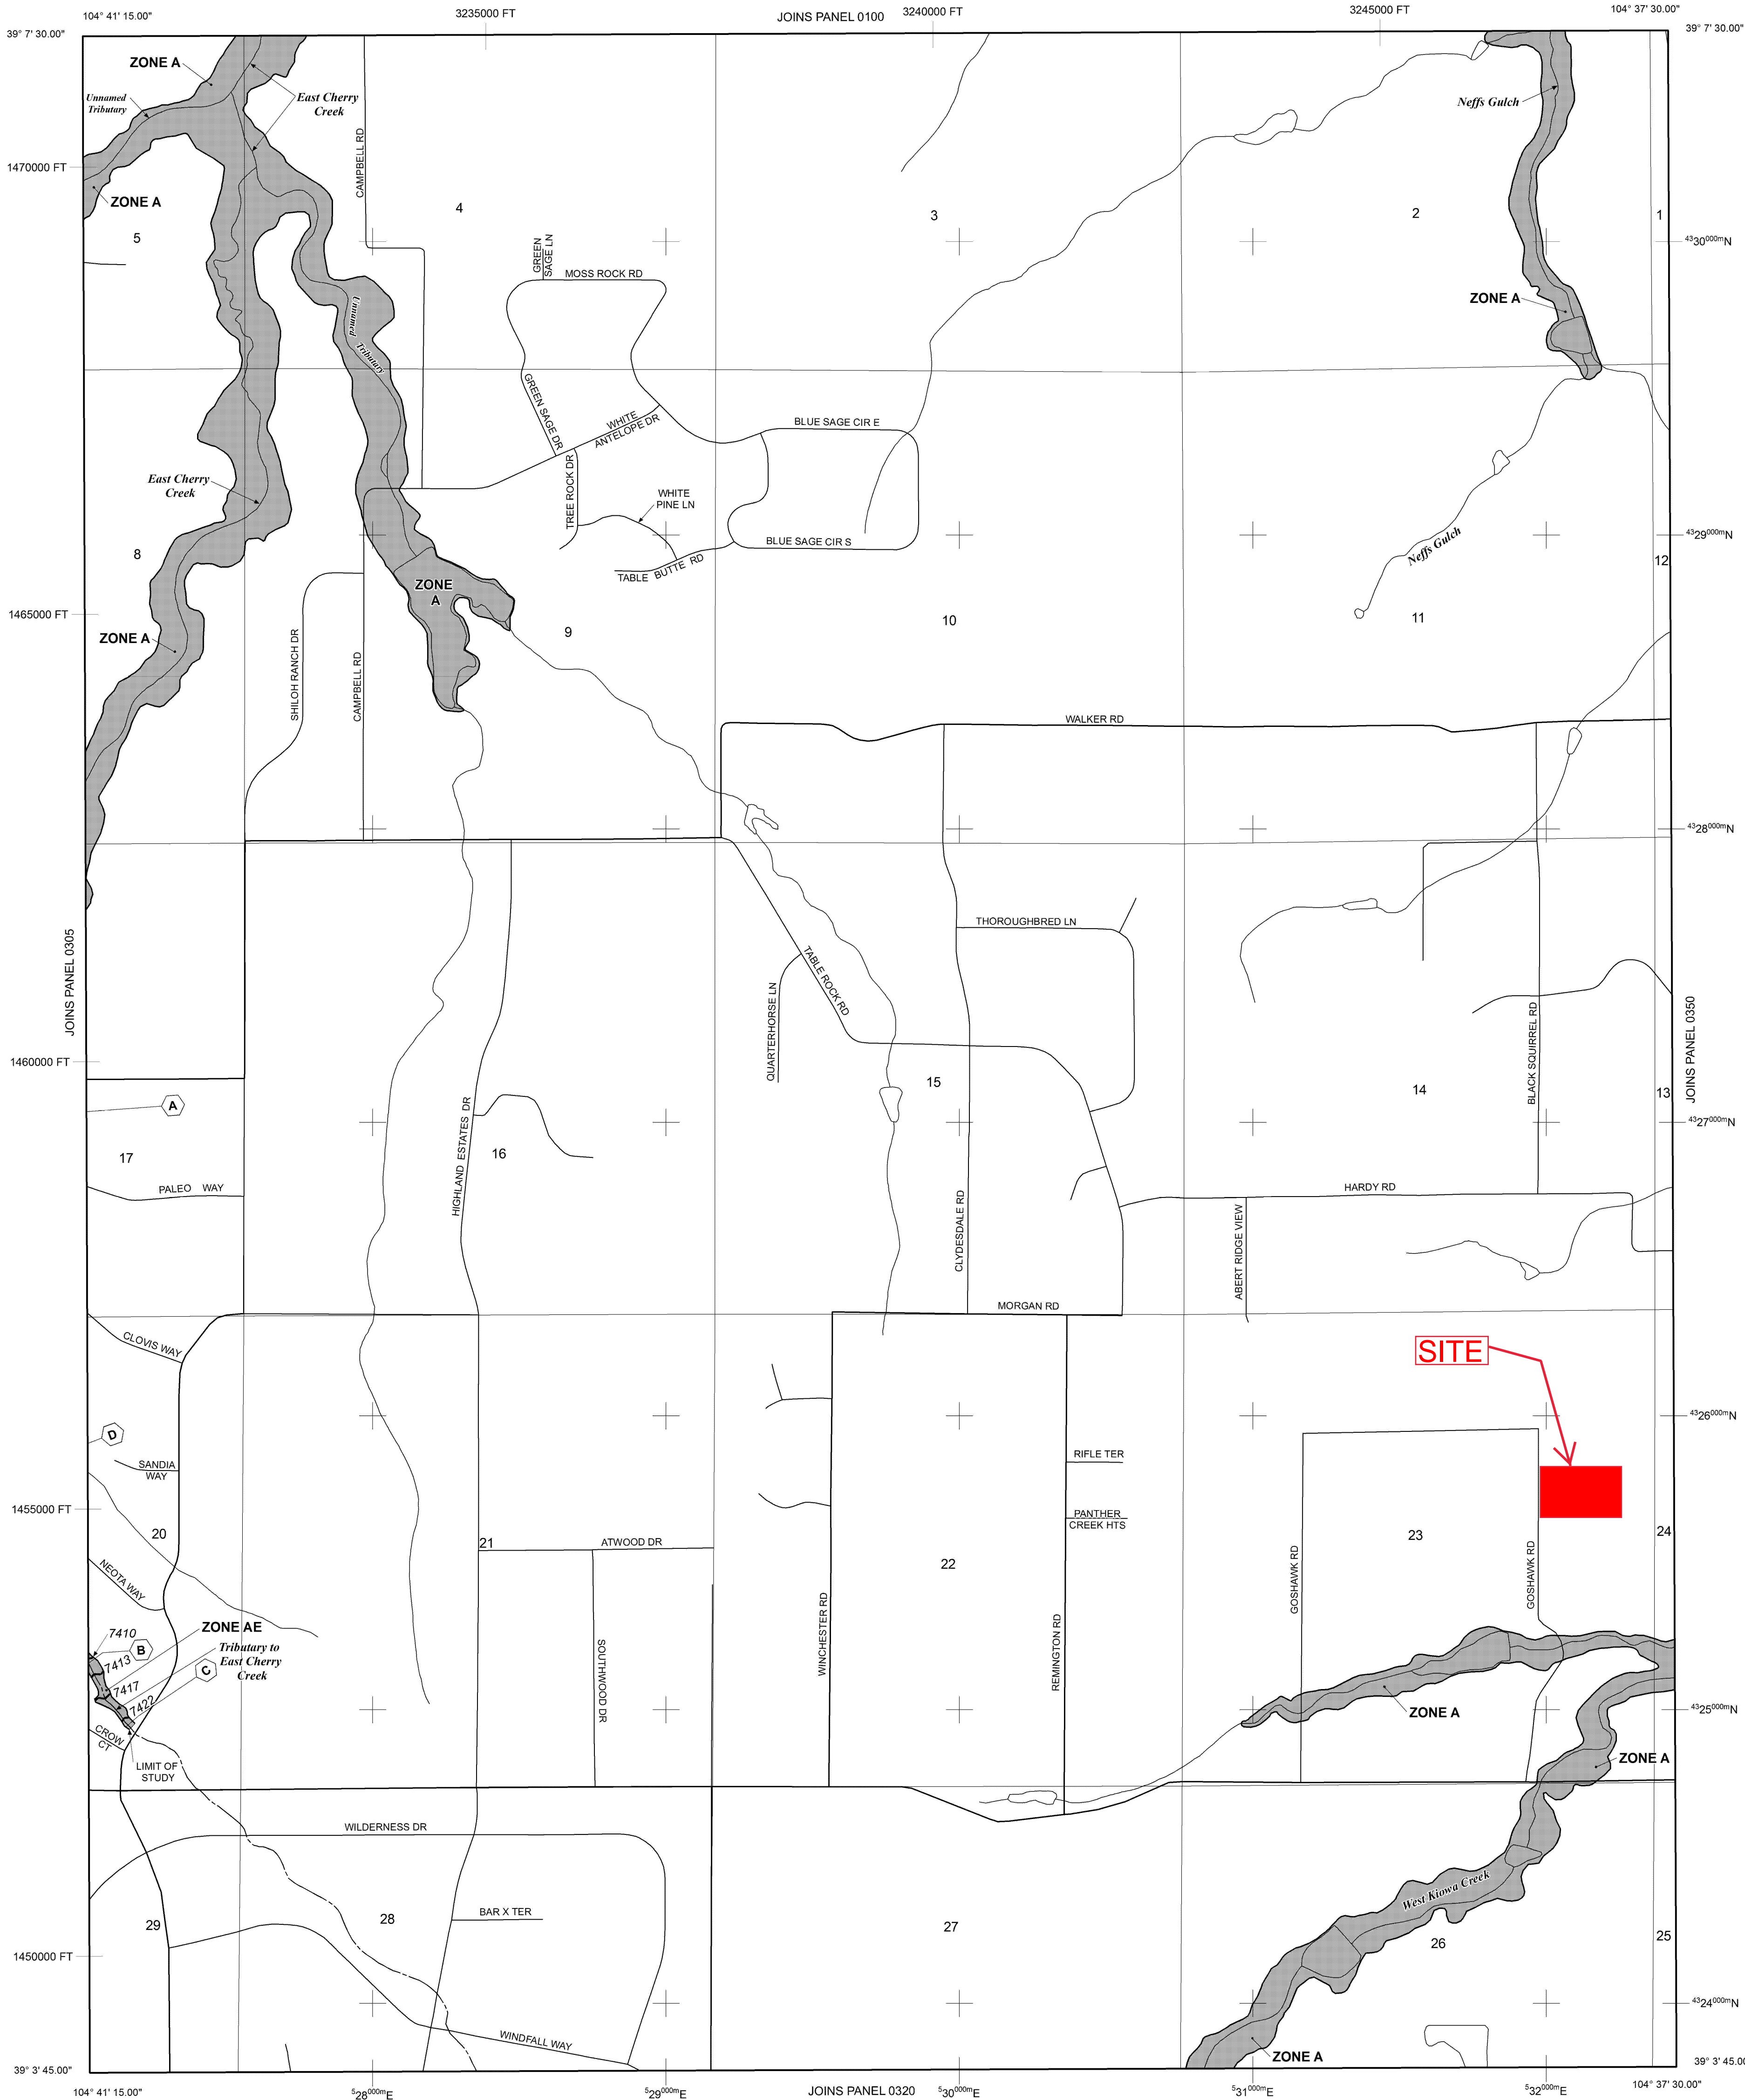

NOTE: MAP AREA SHOWN ON THIS PANEL IS LOCATED WITHIN TOWNSHIP 11 SOUTH, RANGE 65 WEST.

LEGEND

SPECIAL FLOOD HAZARD AREAS (SFHAS) SUBJECT TO INUNDATION BY THE 1% ANNUAL CHANCE FLOOD

- ZONE A** No Base Flood Elevations determined.
- ZONE AE** Base Flood Elevations determined.
- ZONE AH** Flood depths of 1 to 3 feet (usually areas of ponding); Base Flood Elevations determined.
- ZONE AD** Flood depths of 1 to 3 feet (usually sheet flow on sloping terrain); average depths determined. For areas of alluvial fan flooding, velocities also determined.
- ZONE AR** Special Flood Hazard Area Formerly protected from the 1% annual chance flood by a flood control system that was subsequently decommissioned. Zone AR indicates that the former flood control system is being restored to provide protection from the 1% annual chance or greater flood.
- ZONE A99** Area to be protected from 1% annual chance flood by a Federal flood protection system under construction; no Base Flood Elevations determined.
- ZONE V** Coastal flood zone with velocity hazard (wave action); no Base Flood Elevations determined.
- ZONE VE** Coastal flood zone with velocity hazard (wave action); Base Flood Elevations determined.

FLOODWAY AREAS IN ZONE AE
The floodway is the channel of a stream plus any adjacent floodplain areas that must be kept free of encroachment so that the 1% annual chance flood can be carried without substantial increases in flood heights.

OTHER FLOOD AREAS

ZONE X Areas of 0.2% annual chance flood; areas of 1% annual chance flood with average depths of less than 1 foot or with drainage areas less than 1 square mile; and areas protected by levees from 1% annual chance flood.

OTHER AREAS

ZONE X Areas determined to be outside the 0.2% annual chance floodplain.
ZONE D Areas in which flood hazards are undetermined, but possible.

COASTAL BARRIER RESOURCES SYSTEM (CBRS) AREAS

OTHERWISE PROTECTED AREAS (OPAs)

CBRS areas and OPAs are normally located within or adjacent to Special Flood Hazard Areas.

- Floodplain boundary
- Floodway boundary
- Zone D Boundary
- CBRS and OPA boundary

— Boundary dividing Special Flood Hazard Areas of different Base Flood Elevations, flood depths or flood velocities.

~ 513 ~ Base Flood Elevation line and value; elevation in feet* (EL 987)

~ 513 ~ Base Flood Elevation value where uniform within zone; elevation in feet*

* Referenced to the North American Vertical Datum of 1988 (NAVD 88)

— A — A — Cross section line

— 23 — 23 — Transect line

97° 07' 30.00" Geographic coordinates referenced to the North American Datum of 1983 (NAD 83)

4750000N 1000-meter Universal Transverse Mercator grid ticks, zone 13

6000000 FT 5000-foot grid ticks: Colorado State Plane coordinate system, central zone (FIPSZONE 0302), Lambert Conformal Conic Projection

DX5510 Bench mark (see explanation in Notes to Users section of this FIRM panel)

M1.5 River Mile

MAP REPOSITORIES Refer to Map Repositories list on Map Index

EFFECTIVE DATE OF COUNTYWIDE FLOOD INSURANCE RATE MAP MARCH 17, 1997

EFFECTIVE DATE(S) OF REVISION(S) TO THIS PANEL

DECEMBER 7, 2018 to update corporate limits, to change Base Flood Elevations and Special Flood Hazard Areas, to update map format, to add roads and road names, and to incorporate previously issued Letters of Map Revision.

For community map revision history prior to countywide mapping, refer to the Community Map History Table located in the Flood Insurance Study report for this jurisdiction.

To determine if flood insurance is available in this community, contact your insurance agent or call the National Flood Insurance Program at 1-800-638-6620.

MAP SCALE 1" = 1000'

500 0 1000 2000 FEET

300 0 300 600 METERS

NFIP

PANEL 0310G

FIRM

FLOOD INSURANCE RATE MAP

EL PASO COUNTY, COLORADO AND INCORPORATED AREAS

PANEL 310 OF 1300

(SEE MAP INDEX FOR FIRM PANEL LAYOUT)

CONTAINS:

COMMUNITY	NUMBER	PANEL	SUFFIX
EL PASO COUNTY	08009	0310	0

Notice to User: The Map Number shown below should be used when placing map orders. The Community Number shown above should be used on insurance applications for the subject community.

MAP NUMBER
08041C0310G

MAP REVISED
DECEMBER 7, 2018


Federal Emergency Management Agency

Appendix C – USDA Soils Maps

Soil Map—El Paso County Area, Colorado
(Loudermilk Minor Subdivision - USDA Soil Map)




Soil Map may not be valid at this scale.

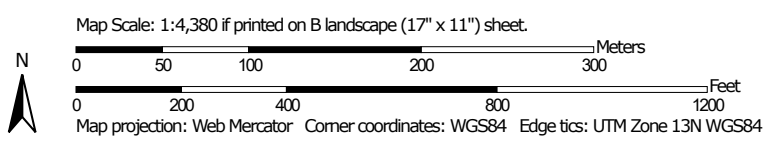


MAP LEGEND

Area of Interest (AOI)

 Area of Interest (AOI)

Soils

 Soil Map Unit Polygons

 Soil Map Unit Lines

 Soil Map Unit Points

Special Point Features



Blowout



Borrow Pit



Clay Spot



Closed Depression



Gravel Pit



Gravelly Spot



Landfill



Lava Flow



Marsh or swamp



Mine or Quarry



Miscellaneous Water



Perennial Water



Rock Outcrop



Saline Spot



Sandy Spot



Severely Eroded Spot



Sinkhole



Slide or Slip



Sodic Spot



Spoil Area



Stony Spot



Very Stony Spot



Wet Spot



Other



Special Line Features

Water Features



Streams and Canals

Transportation



Rails



Interstate Highways



US Routes



Major Roads



Local Roads

Background



Aerial Photography

MAP INFORMATION

The soil surveys that comprise your AOI were mapped at 1:24,000.

Warning: Soil Map may not be valid at this scale.

Enlargement of maps beyond the scale of mapping can cause misunderstanding of the detail of mapping and accuracy of soil line placement. The maps do not show the small areas of contrasting soils that could have been shown at a more detailed scale.

Please rely on the bar scale on each map sheet for map measurements.

Source of Map: Natural Resources Conservation Service

Web Soil Survey URL:

Coordinate System: Web Mercator (EPSG:3857)

Maps from the Web Soil Survey are based on the Web Mercator projection, which preserves direction and shape but distorts distance and area. A projection that preserves area, such as the Albers equal-area conic projection, should be used if more accurate calculations of distance or area are required.

This product is generated from the USDA-NRCS certified data as of the version date(s) listed below.

Soil Survey Area: El Paso County Area, Colorado

Survey Area Data: Version 16, Sep 10, 2018

Soil map units are labeled (as space allows) for map scales 1:50,000 or larger.


Date(s) aerial images were photographed: Jun 7, 2016—Aug 17, 2017

The orthophoto or other base map on which the soil lines were compiled and digitized probably differs from the background imagery displayed on these maps. As a result, some minor shifting of map unit boundaries may be evident.


Map Unit Legend

Map Unit Symbol	Map Unit Name	Acres in AOI	Percent of AOI
1	Alamosa loam, 1 to 3 percent slopes	3.3	2.0%
25	Elbeth sandy loam, 3 to 8 percent slopes	18.0	11.1%
26	Elbeth sandy loam, 8 to 15 percent slopes	0.1	0.1%
36	Holderness loam, 8 to 15 percent slopes	96.2	59.3%
92	Tomah-Crowfoot loamy sands, 3 to 8 percent slopes	44.6	27.5%
Totals for Area of Interest		162.2	100.0%

Drainage Class—El Paso County Area, Colorado
(Loudermilk Minor Subdivision - USDA Soil Map - Drainage Class)

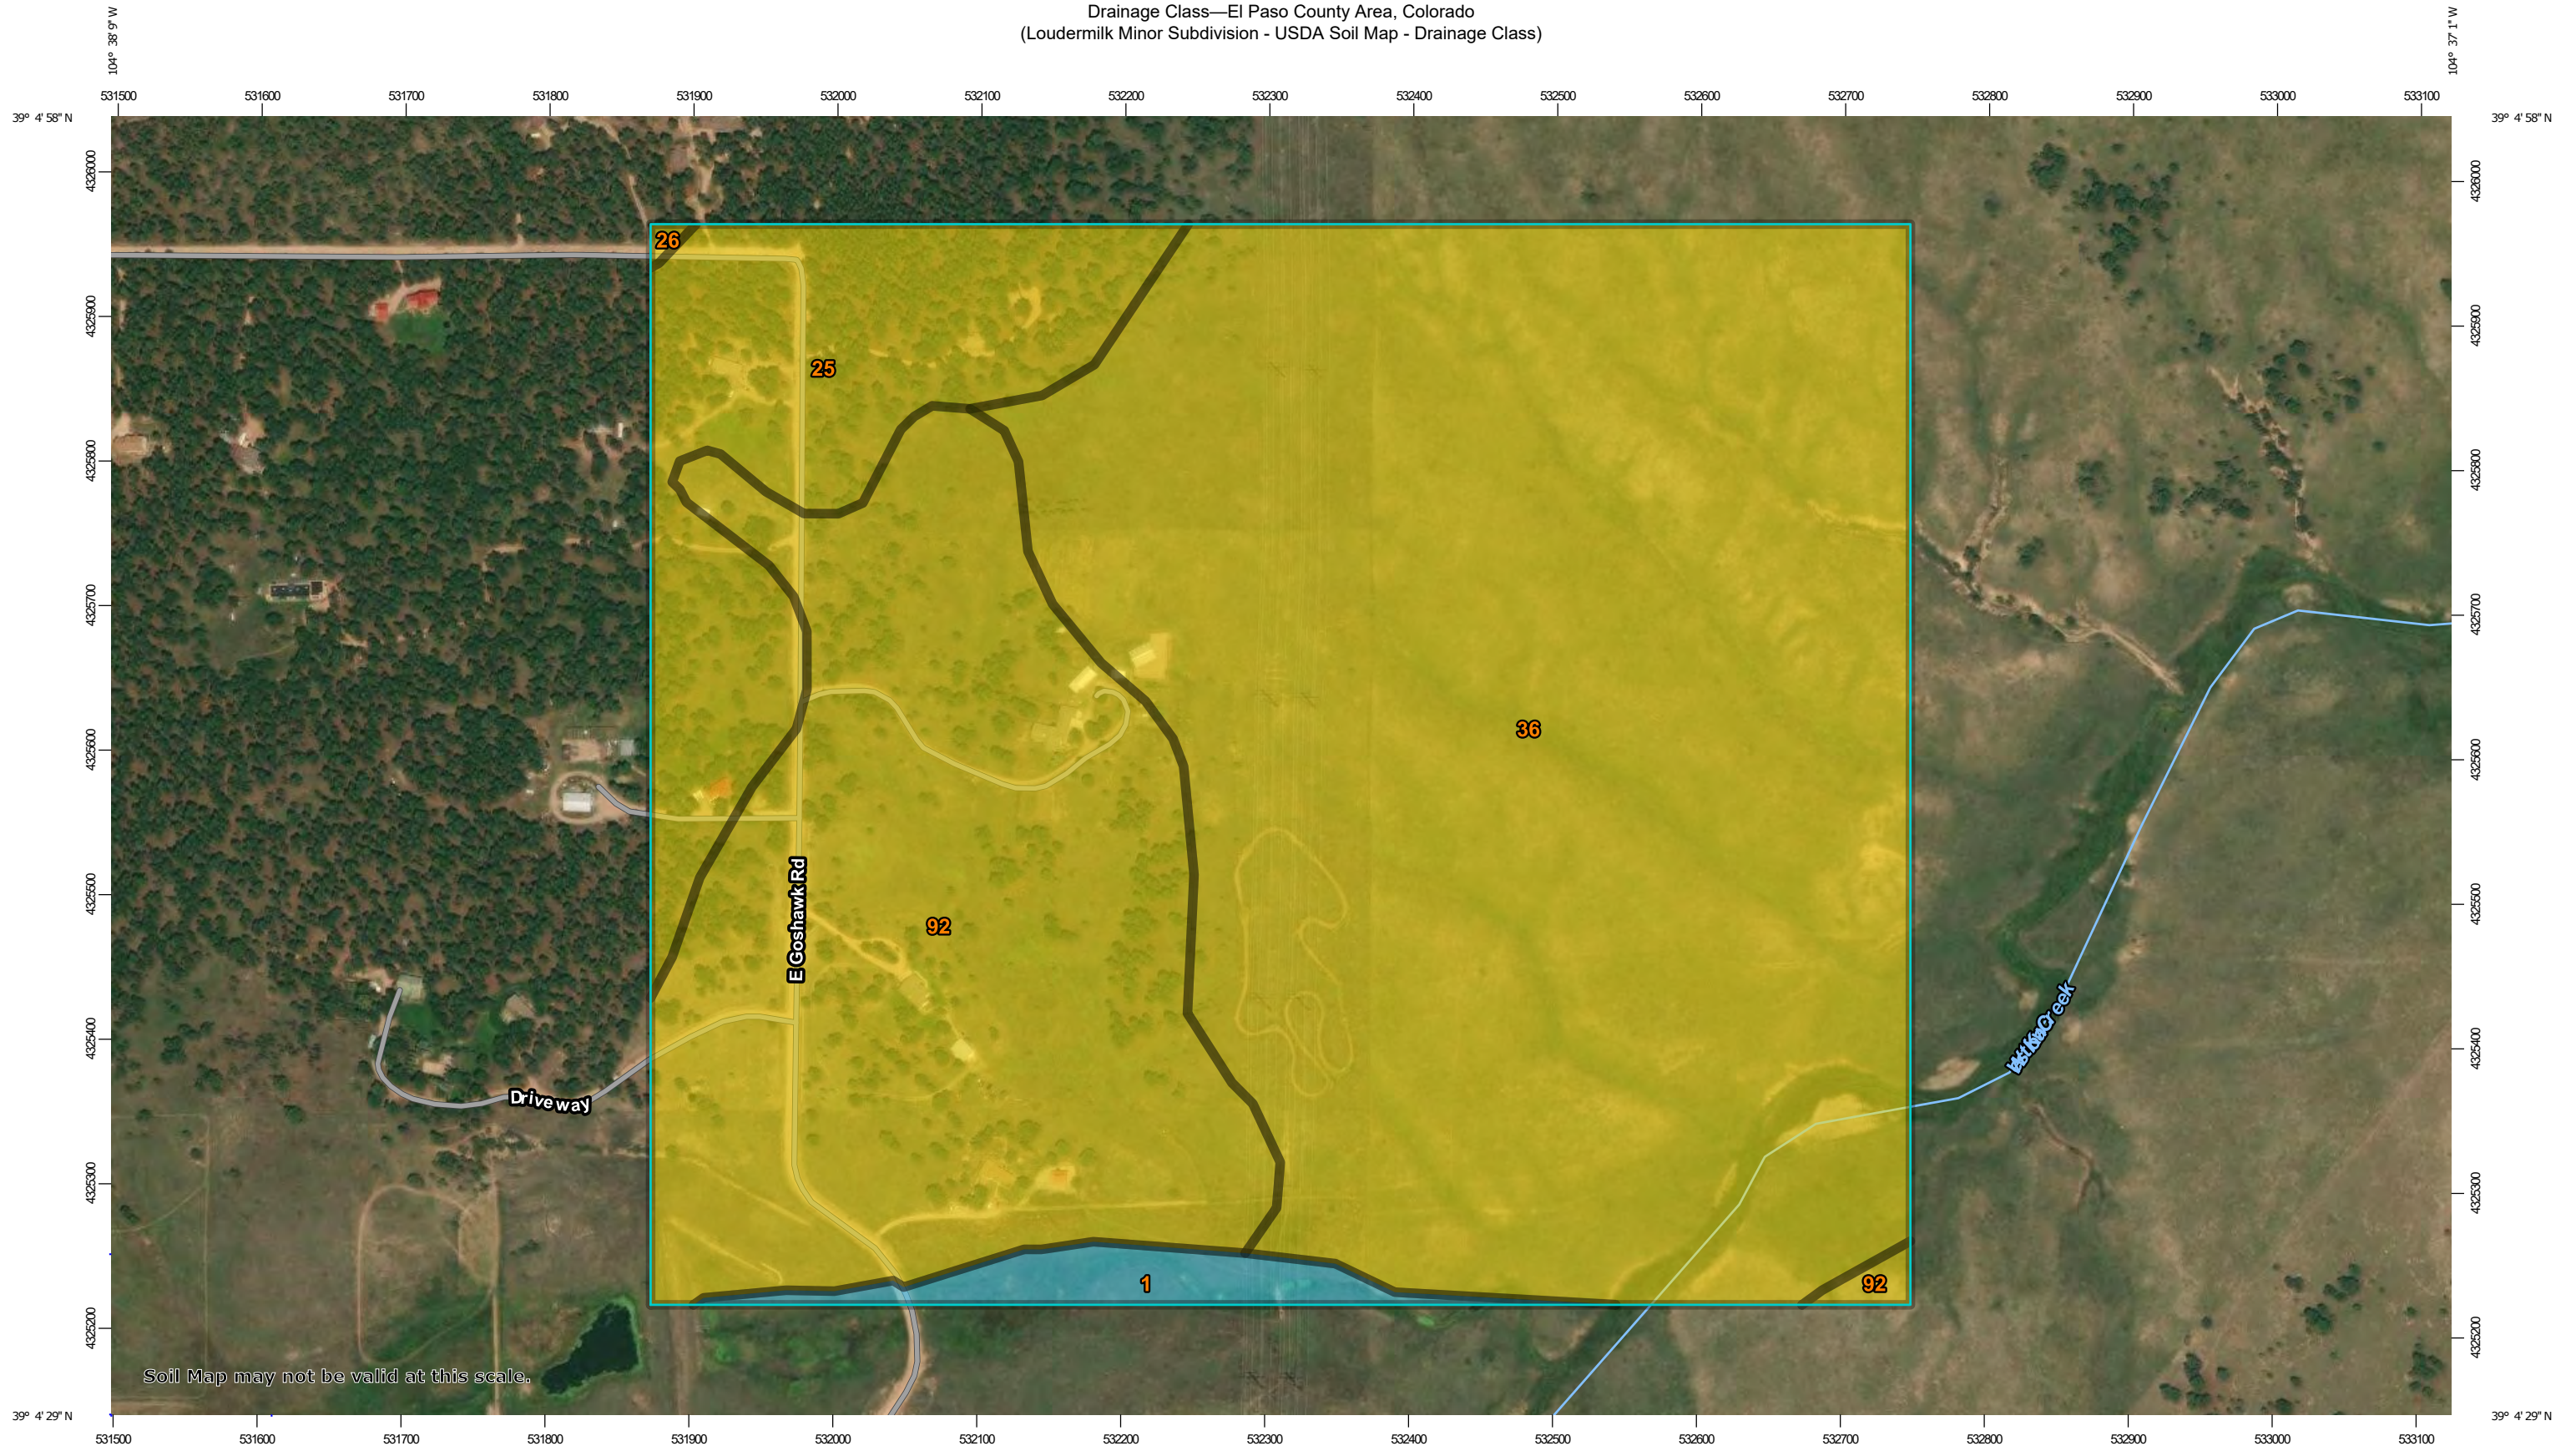


Soil Map may not be valid at this scale.

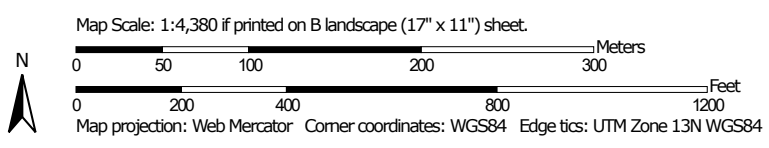


MAP LEGEND

Area of Interest (AOI)


 Area of Interest (AOI)

Soils

Soil Rating Polygons

-  Excessively drained
-  Somewhat excessively drained
-  Well drained
-  Moderately well drained
-  Somewhat poorly drained
-  Poorly drained
-  Very poorly drained
-  Subaqueous
-  Not rated or not available

Soil Rating Lines

-  Excessively drained
-  Somewhat excessively drained
-  Well drained
-  Moderately well drained
-  Somewhat poorly drained
-  Poorly drained
-  Very poorly drained
-  Subaqueous
-  Not rated or not available





Soil Rating Points

-  Excessively drained
-  Somewhat excessively drained
-  Well drained
-  Moderately well drained
-  Somewhat poorly drained
-  Poorly drained
-  Very poorly drained
-  Subaqueous
-  Not rated or not available


Water Features

 Streams and Canals

Transportation

-  Rails
-  Interstate Highways
-  US Routes
-  Major Roads
-  Local Roads

Background

 Aerial Photography

MAP INFORMATION

The soil surveys that comprise your AOI were mapped at 1:24,000.

Warning: Soil Map may not be valid at this scale.

Enlargement of maps beyond the scale of mapping can cause misunderstanding of the detail of mapping and accuracy of soil line placement. The maps do not show the small areas of contrasting soils that could have been shown at a more detailed scale.

Please rely on the bar scale on each map sheet for map measurements.

Source of Map: Natural Resources Conservation Service
 Web Soil Survey URL:
 Coordinate System: Web Mercator (EPSG:3857)

Maps from the Web Soil Survey are based on the Web Mercator projection, which preserves direction and shape but distorts distance and area. A projection that preserves area, such as the Albers equal-area conic projection, should be used if more accurate calculations of distance or area are required.

This product is generated from the USDA-NRCS certified data as of the version date(s) listed below.

Soil Survey Area: El Paso County Area, Colorado
 Survey Area Data: Version 16, Sep 10, 2018

Soil map units are labeled (as space allows) for map scales 1:50,000 or larger.

Date(s) aerial images were photographed: Jun 7, 2016—Aug 17, 2017

The orthophoto or other base map on which the soil lines were compiled and digitized probably differs from the background imagery displayed on these maps. As a result, some minor shifting of map unit boundaries may be evident.

Drainage Class

Map unit symbol	Map unit name	Rating	Acres in AOI	Percent of AOI
1	Alamosa loam, 1 to 3 percent slopes	Poorly drained	3.3	2.0%
25	Elbeth sandy loam, 3 to 8 percent slopes	Well drained	18.0	11.1%
26	Elbeth sandy loam, 8 to 15 percent slopes	Well drained	0.1	0.1%
36	Holderness loam, 8 to 15 percent slopes	Well drained	96.2	59.3%
92	Tomah-Crowfoot loamy sands, 3 to 8 percent slopes	Well drained	44.6	27.5%
Totals for Area of Interest			162.2	100.0%

Description

"Drainage class (natural)" refers to the frequency and duration of wet periods under conditions similar to those under which the soil formed. Alterations of the water regime by human activities, either through drainage or irrigation, are not a consideration unless they have significantly changed the morphology of the soil. Seven classes of natural soil drainage are recognized-excessively drained, somewhat excessively drained, well drained, moderately well drained, somewhat poorly drained, poorly drained, and very poorly drained. These classes are defined in the "Soil Survey Manual."

Rating Options

Aggregation Method: Dominant Condition

Component Percent Cutoff: None Specified

Tie-break Rule: Higher

Appendix D - Hydrologic and Hydraulic Calculations



NOAA Atlas 14, Volume 8, Version 2
Location name: Colorado Springs, Colorado, USA*
Latitude: 39.0794°, Longitude: -104.6285°
Elevation: 7417.11 ft**



* source: ESRI Maps
 ** source: USGS

POINT PRECIPITATION FREQUENCY ESTIMATES

Sanja Perica, Deborah Martin, Sandra Pavlovic, Ishani Roy, Michael St. Laurent, Carl Trypaluk, Dale Unruh, Michael Yekta, Geoffery Bonnin

NOAA, National Weather Service, Silver Spring, Maryland

[PF_tabular](#) | [PF_graphical](#) | [Maps_&_aerials](#)

PF tabular

PDS-based point precipitation frequency estimates with 90% confidence intervals (in inches)¹										
Duration	Average recurrence interval (years)									
	1	2	5	10	25	50	100	200	500	1000
5-min	0.241 (0.189-0.308)	0.292 (0.228-0.373)	0.379 (0.296-0.487)	0.457 (0.354-0.589)	0.570 (0.431-0.767)	0.663 (0.488-0.901)	0.760 (0.541-1.06)	0.863 (0.590-1.23)	1.01 (0.663-1.48)	1.12 (0.718-1.66)
10-min	0.353 (0.276-0.451)	0.427 (0.334-0.547)	0.556 (0.433-0.713)	0.669 (0.519-0.862)	0.835 (0.630-1.12)	0.970 (0.715-1.32)	1.11 (0.793-1.55)	1.26 (0.865-1.81)	1.48 (0.971-2.16)	1.64 (1.05-2.43)
15-min	0.430 (0.337-0.550)	0.521 (0.408-0.667)	0.678 (0.529-0.870)	0.816 (0.633-1.05)	1.02 (0.769-1.37)	1.18 (0.872-1.61)	1.36 (0.967-1.89)	1.54 (1.05-2.20)	1.80 (1.18-2.64)	2.00 (1.28-2.97)
30-min	0.610 (0.478-0.781)	0.739 (0.579-0.947)	0.961 (0.750-1.23)	1.16 (0.897-1.49)	1.44 (1.09-1.93)	1.67 (1.23-2.27)	1.91 (1.36-2.66)	2.17 (1.48-3.10)	2.52 (1.66-3.70)	2.81 (1.80-4.15)
60-min	0.773 (0.606-0.989)	0.928 (0.726-1.19)	1.20 (0.938-1.54)	1.45 (1.12-1.87)	1.82 (1.38-2.45)	2.12 (1.57-2.90)	2.45 (1.75-3.42)	2.80 (1.92-4.01)	3.30 (2.17-4.84)	3.70 (2.37-5.47)
2-hr	0.935 (0.739-1.19)	1.12 (0.881-1.42)	1.44 (1.13-1.83)	1.74 (1.36-2.22)	2.19 (1.68-2.95)	2.58 (1.92-3.49)	2.99 (2.15-4.15)	3.44 (2.38-4.89)	4.07 (2.71-5.95)	4.59 (2.96-6.75)
3-hr	1.02 (0.810-1.29)	1.21 (0.957-1.52)	1.55 (1.23-1.97)	1.88 (1.48-2.39)	2.38 (1.84-3.20)	2.82 (2.12-3.81)	3.29 (2.39-4.56)	3.81 (2.66-5.42)	4.56 (3.06-6.65)	5.17 (3.36-7.58)
6-hr	1.18 (0.946-1.48)	1.39 (1.11-1.73)	1.77 (1.41-2.22)	2.14 (1.70-2.70)	2.73 (2.13-3.65)	3.25 (2.47-4.38)	3.82 (2.80-5.27)	4.45 (3.14-6.30)	5.38 (3.64-7.80)	6.14 (4.03-8.94)
12-hr	1.38 (1.11-1.71)	1.61 (1.30-1.99)	2.05 (1.64-2.54)	2.47 (1.97-3.08)	3.14 (2.48-4.16)	3.73 (2.85-4.98)	4.38 (3.24-5.99)	5.10 (3.62-7.16)	6.15 (4.20-8.86)	7.01 (4.64-10.1)
24-hr	1.61 (1.31-1.98)	1.89 (1.53-2.32)	2.40 (1.94-2.95)	2.88 (2.32-3.56)	3.63 (2.87-4.74)	4.28 (3.29-5.64)	4.98 (3.71-6.74)	5.75 (4.12-8.00)	6.87 (4.74-9.81)	7.78 (5.20-11.2)
2-day	1.88 (1.54-2.28)	2.22 (1.82-2.69)	2.83 (2.31-3.44)	3.38 (2.74-4.14)	4.22 (3.35-5.43)	4.92 (3.81-6.40)	5.67 (4.25-7.57)	6.48 (4.67-8.91)	7.63 (5.30-10.8)	8.56 (5.78-12.2)
3-day	2.06 (1.70-2.48)	2.44 (2.01-2.94)	3.11 (2.55-3.77)	3.71 (3.03-4.51)	4.61 (3.67-5.89)	5.35 (4.16-6.92)	6.15 (4.63-8.16)	7.00 (5.07-9.56)	8.19 (5.72-11.5)	9.15 (6.22-13.0)
4-day	2.21 (1.83-2.66)	2.61 (2.16-3.14)	3.32 (2.73-4.00)	3.95 (3.23-4.78)	4.88 (3.90-6.20)	5.66 (4.41-7.28)	6.48 (4.89-8.57)	7.36 (5.35-10.0)	8.60 (6.03-12.1)	9.59 (6.54-13.6)
7-day	2.62 (2.18-3.12)	3.04 (2.52-3.62)	3.77 (3.12-4.51)	4.43 (3.65-5.33)	5.42 (4.36-6.83)	6.24 (4.90-7.97)	7.11 (5.41-9.34)	8.05 (5.90-10.9)	9.37 (6.62-13.1)	10.4 (7.17-14.7)
10-day	2.98 (2.49-3.54)	3.43 (2.86-4.07)	4.22 (3.51-5.02)	4.92 (4.07-5.88)	5.96 (4.81-7.46)	6.81 (5.38-8.66)	7.72 (5.91-10.1)	8.70 (6.40-11.7)	10.1 (7.15-14.0)	11.2 (7.71-15.7)
20-day	4.02 (3.38-4.72)	4.64 (3.90-5.45)	5.67 (4.76-6.68)	6.56 (5.47-7.76)	7.81 (6.33-9.61)	8.80 (6.98-11.0)	9.82 (7.56-12.6)	10.9 (8.06-14.5)	12.3 (8.81-16.9)	13.4 (9.37-18.8)
30-day	4.84 (4.10-5.65)	5.60 (4.74-6.54)	6.85 (5.77-8.02)	7.88 (6.60-9.27)	9.29 (7.55-11.3)	10.4 (8.27-12.9)	11.5 (8.86-14.7)	12.6 (9.36-16.6)	14.0 (10.1-19.1)	15.1 (10.6-21.1)
45-day	5.84 (4.96-6.77)	6.75 (5.73-7.83)	8.21 (6.95-9.56)	9.40 (7.92-11.0)	11.0 (8.94-13.2)	12.2 (9.72-15.0)	13.3 (10.3-16.9)	14.5 (10.8-18.9)	15.9 (11.5-21.5)	17.0 (12.0-23.5)
60-day	6.65 (5.68-7.68)	7.67 (6.54-8.86)	9.28 (7.88-10.8)	10.6 (8.93-12.3)	12.2 (10.00-14.7)	13.5 (10.8-16.5)	14.7 (11.4-18.5)	15.8 (11.9-20.6)	17.3 (12.5-23.3)	18.3 (13.0-25.3)





¹ Precipitation frequency (PF) estimates in this table are based on frequency analysis of partial duration series (PDS). Numbers in parenthesis are PF estimates at lower and upper bounds of the 90% confidence interval. The probability that precipitation frequency estimates (for a given duration and average recurrence interval) will be greater than the upper bound (or less than the lower bound) is 5%. Estimates at upper bounds are not checked against probable maximum precipitation (PMP) estimates and may be higher than currently valid PMP values. Please refer to NOAA Atlas 14 document for more information.

[Back to Top](#)

PF graphical

PDS-based depth-duration-frequency (DDF) curves


Latitude: 39.0794°, Longitude: -104.6285°

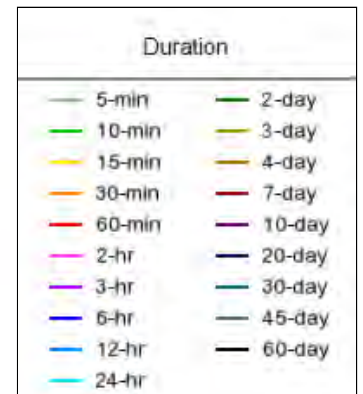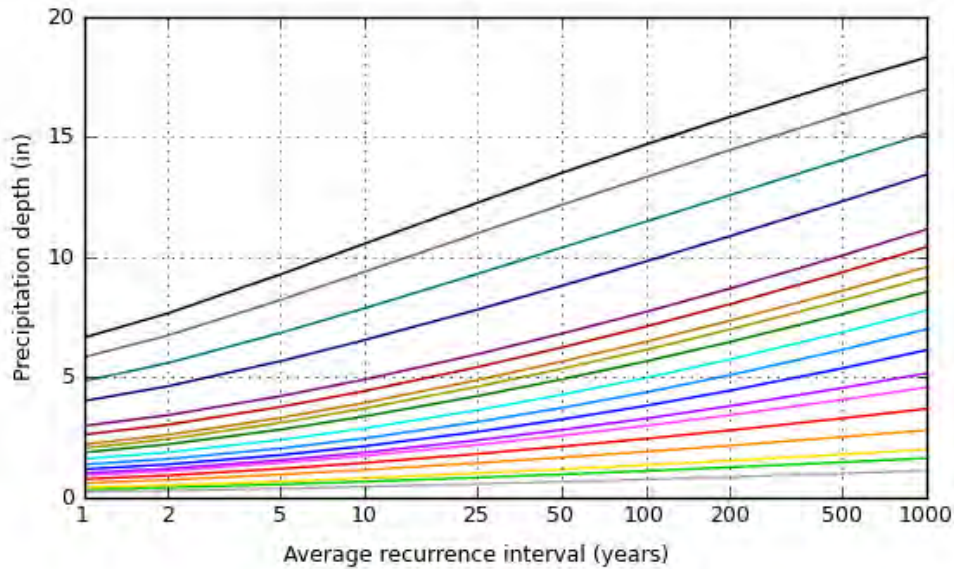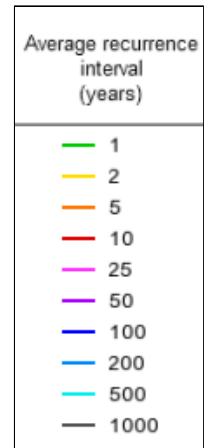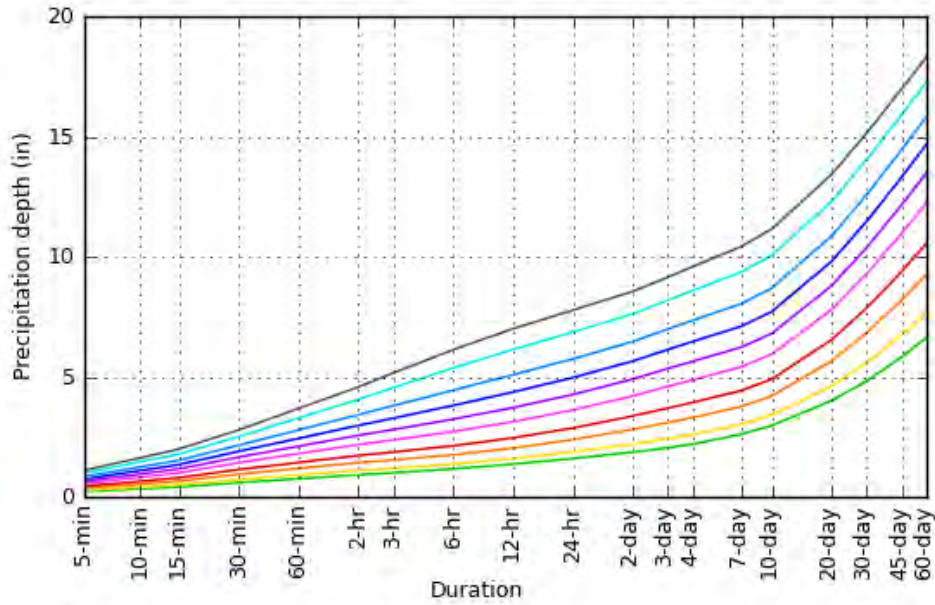

[Back to Top](#)

Maps & aerials

Small scale terrain

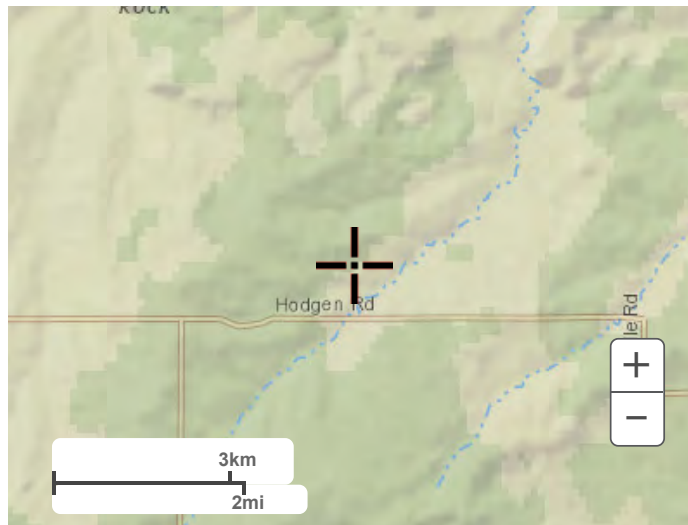

Large scale terrain



Large scale map



Large scale aerial



[Back to Top](#)

[US Department of Commerce](#)
[National Oceanic and Atmospheric Administration](#)
[National Weather Service](#)
[National Water Center](#)
1325 East West Highway
Silver Spring, MD 20910
Questions?: HDSC.Questions@noaa.gov

[Disclaimer](#)

Calculation of Peak Runoff using Rational Method

Designer: Richard Lyon
 Company: Rocky Mountain Group
 Date: 4/5/2019
 Project: Loudermilk Minor Subdivision
 Location: Goshawk Road

Version 2.00 released May 2017

Cells of this color are for required user-input
 Cells of this color are for optional override values
 Cells of this color are for calculated results based on overrides

$$t_1 = \frac{0.395(1.1 - C_s)\sqrt{L_1}}{S^{0.33}}$$

$$t_1 = \frac{L_1}{60K\sqrt{S_1}} = \frac{L_1}{60V_1}$$

Computed $t_c = t_1 + t_2$

Regional $t_c = (26 - 17i) + \frac{L_1}{60(14i + 9)\sqrt{S_1}}$

$t_{\text{minimum}} = 5$ (urban)
 $t_{\text{minimum}} = 10$ (non-urban)

Selected $t_c = \max\{t_{\text{minimum}}, \min(\text{Computed } t_c, \text{Regional } t_c)\}$

Select UDFCD location for NOAA Atlas 14 Rainfall Depths from the pulldown list OR enter your own depths obtained from the NOAA website (click this link)

2-yr	5-yr	10-yr	25-yr	50-yr	100-yr	500-yr
0.93	1.20	1.45	1.82	2.12	2.45	3.30

1-hour rainfall depth, P1 (in) = $\frac{a}{(b + t_c)^c}$

a	b	c
28.50	10.00	0.786

$Q(\text{cfs}) = \text{CIA}$

Subcatchment Name	Area (ac)	NRCS Hydrologic Soil Group	Percent Imperviousness	Runoff Coefficient, C							Overland (Initial) Flow Time					Channelized (Travel) Flow Time					Time of Concentration			Rainfall Intensity, I (in/hr)							Peak Flow, Q (cfs)								
				2-yr	5-yr	10-yr	25-yr	50-yr	100-yr	500-yr	Overland Flow Length L ₁ (ft)	U/S Elevation (ft) (Optional)	D/S Elevation (ft) (Optional)	Overland Flow Slope S ₁ (ft/ft)	Overland Flow Time t ₁ (min)	Channelized Flow Length L ₁ (ft)	U/S Elevation (ft) (Optional)	D/S Elevation (ft) (Optional)	Channelized Flow Slope S ₁ (ft/ft)	NRCS Conveyance Factor K	Channelized Flow Velocity V ₁ (ft/sec)	Channelized Flow Time t ₂ (min)	Computed t _c (min)	Regional t _c (min)	Selected t _c (min)	2-yr	5-yr	10-yr	25-yr	50-yr	100-yr	500-yr	2-yr	5-yr	10-yr	25-yr	50-yr	100-yr	500-yr
EX-1	5.87	A	7.1	0.03	0.03	0.03	0.05	0.09	0.17	0.30	500.00	7428.00	7404.00	0.048	25.75	200.00	7404.00	7395.00	0.045	5	1.06	3.14	28.90	26.36	26.36	1.57	2.03	2.45	3.08	3.59	4.14	5.58	0.25	0.35	0.48	0.82	1.80	4.02	9.82
EX-2	4.78	A	7.6	0.03	0.03	0.04	0.05	0.09	0.17	0.30	500.00	7430.00	7403.00	0.054	24.71	200.00	7403.00	7395.00	0.040	5	1.00	3.33	28.05	26.36	26.36	1.57	2.03	2.45	3.08	3.59	4.14	5.58	0.22	0.31	0.43	0.72	1.54	3.35	8.09
EX-3	3.85	A	8.6	0.03	0.04	0.04	0.06	0.10	0.18	0.31	500.00	7428.00	7413.00	0.030	29.85	100.00	7413.00	7404.00	0.090	5	1.50	1.11	30.96	25.08	25.08	1.61	2.09	2.52	3.17	3.69	4.26	5.74	0.21	0.30	0.41	0.68	1.40	2.90	6.84
EX-4	3.47	A	2.0	0.01	0.01	0.01	0.01	0.04	0.13	0.27	500.00	7430.00	7412.00	0.036	28.95	255.00	7412.00	7398.00	0.055	5	1.17	3.63	32.57	27.61	27.61	1.53	1.98	2.39	3.00	3.49	4.03	5.43	0.03	0.04	0.06	0.11	0.51	1.76	5.03
EX-5	1.83	A	2.0	0.01	0.01	0.01	0.01	0.04	0.13	0.27	500.00	7430.00	7398.00	0.064	23.94	100.00	7398.00	7394.00	0.040	5	1.00	1.67	25.61	26.56	26.56	1.60	2.06	2.49	3.13	3.64	4.21	5.67	0.02	0.02	0.03	0.06	0.28	0.97	2.77
OS-1	11.25	A	2.0	0.01	0.01	0.01	0.01	0.04	0.13	0.27	500.00	7450.00	7418.00	0.064	23.94	50.00	7418.00	7416.00	0.040	5	1.00	0.83	24.77	26.11	24.77	1.63	2.10	2.54	3.19	3.71	4.29	5.78	0.09	0.14	0.20	0.39	1.76	6.06	17.36
OS-2	2.02	A	14.2	0.07	0.07	0.08	0.10	0.15	0.22	0.35	250.00	7450.00	7434.00	0.064	15.91	450.00	7434.00	7424.00	0.022	15	2.24	3.35	19.27	28.16	19.27	1.86	2.41	2.91	3.65	4.25	4.91	6.62	0.25	0.35	0.46	0.73	1.26	2.19	4.62
OS-4	0.06	A	2.0	0.01	0.01	0.01	0.01	0.04	0.13	0.27	50.00	7434.00	7430.00	0.080	7.03	0.00	0.01	0.01	0.000	2.5	0.01	0.00	7.03	25.66	10.00	2.51	3.25	3.92	4.92	5.74	6.63	8.93	0.00	0.00	0.00	0.00	0.01	0.05	0.14
OS-5	6.42	A	2.0	0.01	0.01	0.01	0.01	0.04	0.13	0.27	500.00	7450.00	7414.00	0.072	23.03	0.00	0.01	0.01	0.000	2.5	0.01	0.00	23.03	25.66	23.03	1.69	2.19	2.64	3.32	3.87	4.47	6.02	0.06	0.08	0.12	0.23	1.04	3.60	10.31

Area-Weighted Runoff Coefficient Calculations

Version 2.00 released May 2017


Designer: Richard Lyon

Company: Rocky Mountain Group

Date: 4/5/2019

Project: Loudermilk Minor Subdivision

Location: Goshawk Road

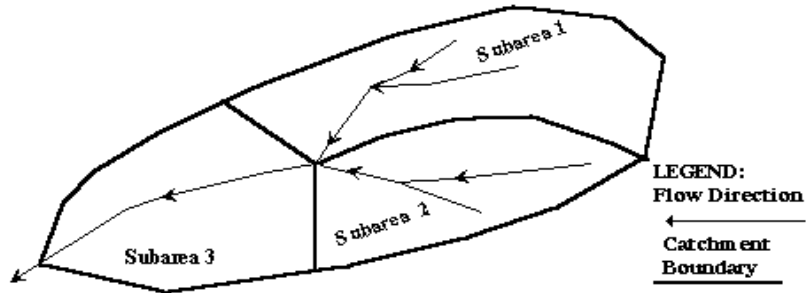

Subcatchment Name
Post-Dev

Cells of this color are for required user-input
Cells of this color are for optional override values
Cells of this color are for calculated results based on overrides

See sheet "Design Info" for imperviousness-based runoff coefficient values.

Sub-Area ID	Area (ac)	NRCS Hydrologic Soil Group	Percent Imperviousness	Runoff Coefficient, C						
				2-yr	5-yr	10-yr	25-yr	50-yr	100-yr	500-yr
ROOF	0.21	A	90.0	0.73	0.75	0.77	0.79	0.79	0.81	0.83
CONCRETE	0.06	A	90.0	0.73	0.75	0.77	0.79	0.79	0.81	0.83
WOOD	0.01	A	90.0	0.73	0.75	0.77	0.79	0.79	0.81	0.83
GRAVEL	0.07	A	80.0	0.63	0.65	0.66	0.69	0.71	0.73	0.77
FIELD/SOIL	5.51	A	2.0	0.01	0.01	0.01	0.01	0.04	0.13	0.27
Total Area (ac)	5.87	Area-Weighted C		0.05	0.05	0.05	0.06	0.09	0.17	0.30
		Area-Weighted Override C		0.05	0.05	0.05	0.06	0.09	0.17	0.30

Area-Weighted Runoff Coefficient Calculations

Version 2.00 released May 2017


Designer: Richard Lyon

Company: Rocky Mountain Group

Date: 4/5/2019

Project: Loudermilk Minor Subdivision

Location: Goshawk Road

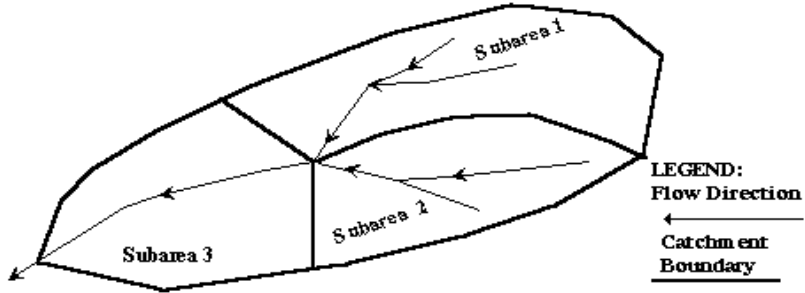

Subcatchment Name
Post-Dev

Cells of this color are for required user-input
Cells of this color are for optional override values
Cells of this color are for calculated results based on overrides

See sheet "Design Info" for imperviousness-based runoff coefficient values.

Sub-Area ID	Area (ac)	NRCS Hydrologic Soil Group	Percent Imperviousness	Runoff Coefficient, C						
				2-yr	5-yr	10-yr	25-yr	50-yr	100-yr	500-yr
GRAVEL	0.34	A	80.0	0.63	0.65	0.66	0.69	0.71	0.73	0.77
FIELD/SOIL	4.45	A	2.0	0.01	0.01	0.01	0.01	0.04	0.13	0.27
Total Area (ac)	4.78									
			Area-Weighted C	0.05	0.05	0.05	0.06	0.09	0.17	0.30
			Area-Weighted Override C	0.05	0.05	0.05	0.06	0.09	0.17	0.30

Area-Weighted Runoff Coefficient Calculations

Version 2.00 released May 2017


Designer: Richard Lyon

Company: Rocky Mountain Group

Date: 4/5/2019

Project: Loudermilk Minor Subdivision

Location: Goshawk Road

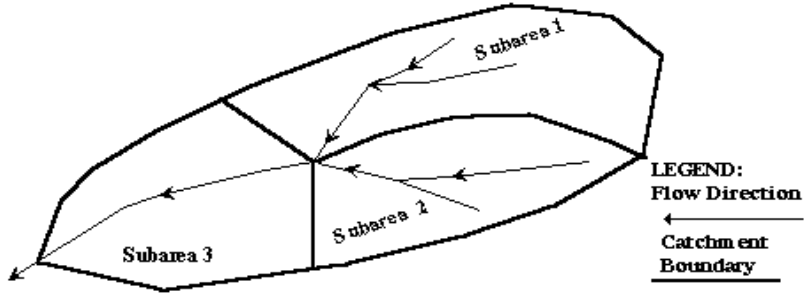

Subcatchment Name
Post-Dev

Cells of this color are for required user-input
Cells of this color are for optional override values
Cells of this color are for calculated results based on overrides

See sheet "Design Info" for imperviousness-based runoff coefficient values.

Sub-Area ID	Area (ac)	NRCS Hydrologic Soil Group	Percent Imperviousness	Runoff Coefficient, C						
				2-yr	5-yr	10-yr	25-yr	50-yr	100-yr	500-yr
ROOF	0.03	A	90.0	0.73	0.75	0.77	0.79	0.79	0.81	0.83
CONCRETE	0.02	A	90.0	0.73	0.75	0.77	0.79	0.79	0.81	0.83
WOOD	0.001	A	90.0	0.73	0.75	0.77	0.79	0.79	0.81	0.83
GRAVEL	0.27	A	80.0	0.63	0.65	0.66	0.69	0.71	0.73	0.77
FIELD/SOIL	3.54	A	2.0	0.01	0.01	0.01	0.01	0.04	0.13	0.27
Total Area (ac)	3.85									
			Area-Weighted C	0.06	0.06	0.06	0.07	0.10	0.18	0.31
			Area-Weighted Override C	0.06	0.06	0.06	0.07	0.10	0.18	0.31

Area-Weighted Runoff Coefficient Calculations

Version 2.00 released May 2017


Designer: Richard Lyon

Company: Rocky Mountain Group

Date: 4/5/2019

Project: Loudermilk Minor Subdivision

Location: Goshawk Road

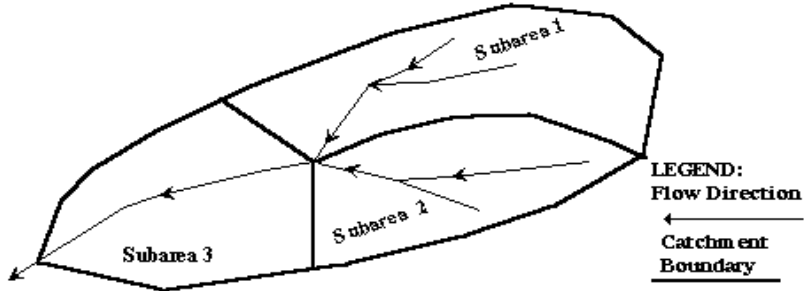

Subcatchment Name
Post-Dev

- Cells of this color are for required user-input
- Cells of this color are for optional override values
- Cells of this color are for calculated results based on overrides

See sheet "Design Info" for imperviousness-based runoff coefficient values.

Sub-Area ID	Area (ac)	NRCS Hydrologic Soil Group	Percent Imperviousness	Runoff Coefficient, C						
				2-yr	5-yr	10-yr	25-yr	50-yr	100-yr	500-yr
FIELD/SOIL	3.47	A	2.0	0.01	0.01	0.01	0.01	0.04	0.13	0.27
Total Area (ac)	3.47		Area-Weighted C	0.01	0.01	0.01	0.01	0.04	0.13	0.27
			Area-Weighted Override C	0.01	0.01	0.01	0.01	0.04	0.13	0.27

Area-Weighted Runoff Coefficient Calculations

Version 2.00 released May 2017


Designer: Richard Lyon

Company: Rocky Mountain Group

Date: 4/5/2019

Project: Loudermilk Minor Subdivision

Location: Goshawk Road

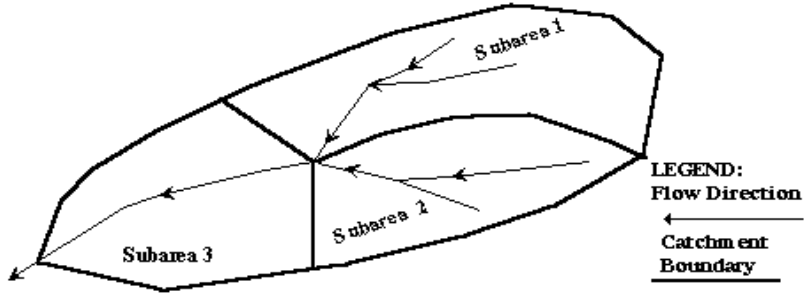

Subcatchment Name
Post-Dev

Cells of this color are for required user-input
Cells of this color are for optional override values
Cells of this color are for calculated results based on overrides

See sheet "Design Info" for imperviousness-based runoff coefficient values.

Sub-Area ID	Area (ac)	NRCS Hydrologic Soil Group	Percent Imperviousness	Runoff Coefficient, C						
				2-yr	5-yr	10-yr	25-yr	50-yr	100-yr	500-yr
FIELD/SOIL	1.83	A	2.0	0.01	0.01	0.01	0.01	0.04	0.13	0.27
Total Area (ac)	1.83			0.01	0.01	0.01	0.01	0.04	0.13	0.27
			Area-Weighted C							
			Area-Weighted Override C							
				0.01	0.01	0.01	0.01	0.04	0.13	0.27

Calculation of Peak Runoff using Rational Method

Designer: Richard Lyon
 Company: Rocky Mountain Group
 Date: 4/5/2019
 Project: Loudermilk Minor Subdivision
 Location: Goshawk Road

Version 2.00 released May 2017

Cells of this color are for required user-input
 Cells of this color are for optional override values
 Cells of this color are for calculated results based on overrides

$$t_1 = \frac{0.395(1.1 - C_s)\sqrt{L_1}}{S^{0.33}}$$

$$t_1 = \frac{L_1}{60K\sqrt{S}} = \frac{L_1}{60V_t}$$

Computed $t_c = t_1 + t_t$

Regional $t_c = (26 - 17i) + \frac{L_1}{60(14i + 9)\sqrt{S_1}}$

$t_{\text{minimum}} = 5$ (urban)
 $t_{\text{minimum}} = 10$ (non-urban)

Selected $t_c = \max\{t_{\text{minimum}}, \min(\text{Computed } t_c, \text{Regional } t_c)\}$

Select UDFCD location for NOAA Atlas 14 Rainfall Depths from the pulldown list OR enter your own depths obtained from the NOAA website (click this link)

2-yr	5-yr	10-yr	25-yr	50-yr	100-yr	500-yr
0.93	1.20	1.45	1.82	2.12	2.45	3.30

1-hour rainfall depth, P1 (in) =

a	b	c
28.50	10.00	0.786

Rainfall Intensity Equation Coefficients =

$$I(\text{in/hr}) = \frac{a + P_1}{(b + t_c)^c}$$

$Q(\text{cfs}) = CIA$

Subcatchment Name	Area (ac)	NRCS Hydrologic Soil Group	Percent Imperviousness	Runoff Coefficient, C								Overland (Initial) Flow Time					Channelized (Travel) Flow Time					Time of Concentration			Rainfall Intensity, I (in/hr)							Peak Flow, Q (cfs)							
				2-yr	5-yr	10-yr	25-yr	50-yr	100-yr	500-yr	Overland Flow Length L ₁ (ft)	U/S Elevation (ft) (Optional)	D/S Elevation (ft) (Optional)	Overland Flow Slope S ₁ (ft/ft)	Overland Flow Time t ₁ (min)	Channelized Flow Length L ₁ (ft)	U/S Elevation (ft) (Optional)	D/S Elevation (ft) (Optional)	Channelized Flow Slope S ₁ (ft/ft)	NRCS Conveyance Factor K	Channelized Flow Velocity V _t (ft/sec)	Channelized Flow Time t ₁ (min)	Computed t _c (min)	Regional t _c (min)	Selected t _c (min)	2-yr	5-yr	10-yr	25-yr	50-yr	100-yr	500-yr	2-yr	5-yr	10-yr	25-yr	50-yr	100-yr	500-yr
EX-1	2.17	A	15.9	0.08	0.08	0.09	0.11	0.16	0.23	0.36	220.00	7401.00	7395.00	0.027	19.58	0.00	0.00	0.00	1.000	5	5.00	0.00	19.58	23.30	19.58	1.85	2.39	2.88	3.62	4.22	4.87	6.56	0.31	0.43	0.57	0.88	1.47	2.47	5.07
EX-2	3.42	A	7.2	0.03	0.03	0.03	0.05	0.09	0.17	0.30	500.00	7412.00	7392.00	0.040	27.34	0.00	0.00	0.00	1.000	5	5.00	0.00	27.34	24.78	24.78	1.63	2.10	2.54	3.19	3.71	4.29	5.78	0.15	0.22	0.30	0.50	1.10	2.44	5.94
EX-3	3.81	A	8.7	0.03	0.04	0.04	0.06	0.10	0.18	0.31	500.00	7428.00	7413.00	0.030	29.83	100.00	7413.00	7404.00	0.090	5	1.50	1.11	30.94	25.06	25.06	1.61	2.09	2.52	3.17	3.69	4.26	5.74	0.21	0.30	0.41	0.69	1.39	2.89	6.78
EX-4	3.47	A	2.0	0.01	0.01	0.01	0.01	0.04	0.13	0.27	500.00	7430.00	7412.00	0.036	28.95	255.00	7412.00	7398.00	0.055	5	1.17	3.63	32.57	27.61	27.61	1.53	1.98	2.39	3.00	3.49	4.03	5.43	0.03	0.04	0.06	0.11	0.51	1.76	5.03
EX-5	1.83	A	2.0	0.01	0.01	0.01	0.01	0.04	0.13	0.27	500.00	7430.00	7398.00	0.064	23.94	100.00	7398.00	7394.00	0.040	5	1.00	1.67	25.61	26.56	25.61	1.60	2.06	2.49	3.13	3.64	4.21	5.67	0.02	0.02	0.03	0.06	0.28	0.97	2.77
DV-2	1.36	A	11.2	0.05	0.05	0.06	0.08	0.12	0.20	0.33	300.00	7428.00	7412.00	0.053	18.85	0.00	0.00	0.00	1.000	5	5.00	0.00	18.85	24.10	18.85	1.88	2.43	2.94	3.69	4.30	4.97	6.69	0.12	0.17	0.23	0.38	0.70	1.33	2.96
DV-1	3.75	A	7.5	0.03	0.03	0.04	0.05	0.09	0.17	0.30	500.00	7430.00	7401.00	0.058	24.15	0.00	0.00	0.00	1.000	5	5.00	0.00	24.15	24.73	24.15	1.65	2.13	2.58	3.23	3.77	4.35	5.86	0.18	0.25	0.35	0.58	1.26	2.75	6.64

Area-Weighted Runoff Coefficient Calculations

Version 2.00 released May 2017


Designer: Richard Lyon

Company: Rocky Mountain Group

Date: 4/5/2019

Project: Loudermilk Minor Subdivision

Location: Goshawk Road

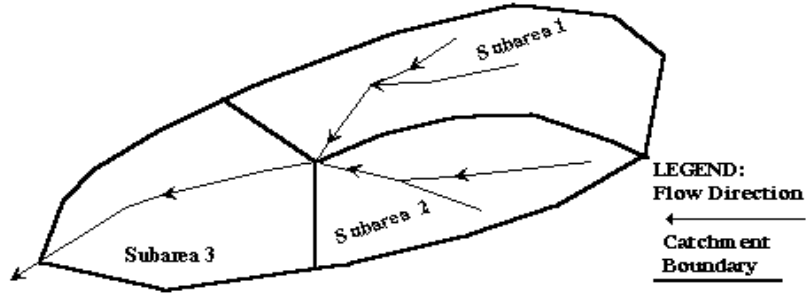

Subcatchment Name
Post-Dev

Cells of this color are for required user-input
Cells of this color are for optional override values
Cells of this color are for calculated results based on overrides

See sheet "Design Info" for imperviousness-based runoff coefficient values.

Sub-Area ID	Area (ac)	NRCS Hydrologic Soil Group	Percent Imperviousness	Runoff Coefficient, C						
				2-yr	5-yr	10-yr	25-yr	50-yr	100-yr	500-yr
ROOF	0.11	A	90.0	0.73	0.75	0.77	0.79	0.79	0.81	0.83
CONCRETE	0.04	A	90.0	0.73	0.75	0.77	0.79	0.79	0.81	0.83
WOOD	0.01	A	90.0	0.73	0.75	0.77	0.79	0.79	0.81	0.83
GRAVEL	0.14	A	80.0	0.63	0.65	0.66	0.69	0.71	0.73	0.77
FIELD/SOIL	3.45	A	2.0	0.01	0.01	0.01	0.01	0.04	0.13	0.27
Total Area (ac)	3.75			0.06	0.06	0.06	0.07	0.10	0.18	0.31
			Area-Weighted C	0.06	0.06	0.06	0.07	0.10	0.18	0.31
			Area-Weighted Override C	0.06	0.06	0.06	0.07	0.10	0.18	0.31

Area-Weighted Runoff Coefficient Calculations

Version 2.00 released May 2017


Designer: Richard Lyon

Company: Rocky Mountain Group

Date: 4/5/2019

Project: Loudermilk Minor Subdivision

Location: Goshawk Road

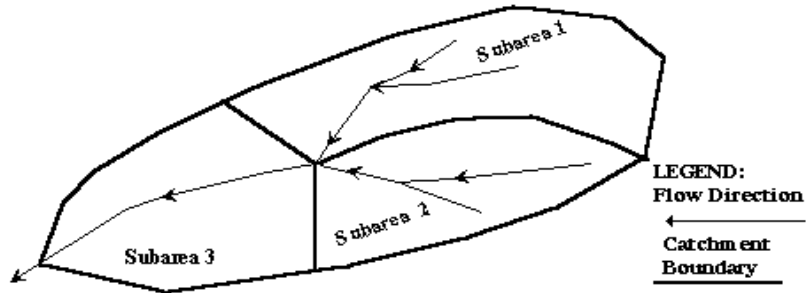

Subcatchment Name
Post-Dev

Cells of this color are for required user-input
Cells of this color are for optional override values
Cells of this color are for calculated results based on overrides

See sheet "Design Info" for imperviousness-based runoff coefficient values.

Sub-Area ID	Area (ac)	NRCS Hydrologic Soil Group	Percent Imperviousness	Runoff Coefficient, C						
				2-yr	5-yr	10-yr	25-yr	50-yr	100-yr	500-yr
GRAVEL	0.16	A	80.0	0.63	0.65	0.66	0.69	0.71	0.73	0.77
FIELD/SOIL	1.20	A	2.0	0.01	0.01	0.01	0.01	0.04	0.13	0.27
Total Area (ac)	1.36									
		Area-Weighted C		0.08	0.08	0.08	0.09	0.12	0.20	0.33
		Area-Weighted Override C		0.08	0.08	0.08	0.09	0.12	0.20	0.33

Area-Weighted Runoff Coefficient Calculations

Version 2.00 released May 2017


Designer: Richard Lyon

Company: Rocky Mountain Group

Date: 4/5/2019

Project: Loudermilk Minor Subdivision

Location: Goshawk Road

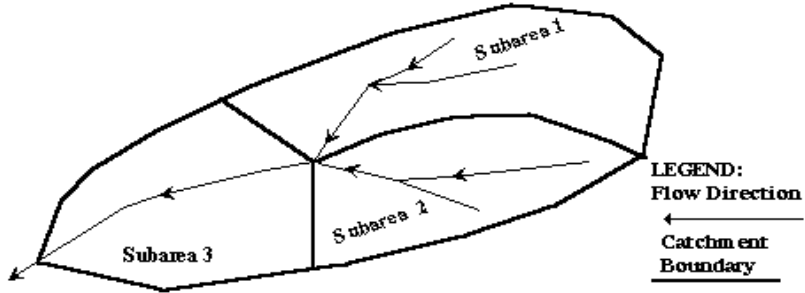

Subcatchment Name
Post-Dev

Cells of this color are for required user-input
Cells of this color are for optional override values
Cells of this color are for calculated results based on overrides


See sheet "Design Info" for imperviousness-based runoff coefficient values.

Sub-Area ID	Area (ac)	NRCS Hydrologic Soil Group	Percent Imperviousness	Runoff Coefficient, C						
				2-yr	5-yr	10-yr	25-yr	50-yr	100-yr	500-yr
ROOF	0.21	A	90.0	0.73	0.75	0.77	0.79	0.79	0.81	0.83
CONCRETE	0.06	A	90.0	0.73	0.75	0.77	0.79	0.79	0.81	0.83
WOOD	0.01	A	90.0	0.73	0.75	0.77	0.79	0.79	0.81	0.83
GRAVEL	0.07	A	80.0	0.63	0.65	0.66	0.69	0.71	0.73	0.77
FIELD/SOIL	1.81	A	2.0	0.01	0.01	0.01	0.01	0.04	0.13	0.27
Total Area (ac)	2.17									
			Area-Weighted C	0.12	0.12	0.13	0.13	0.16	0.23	0.36
			Area-Weighted Override C	0.12	0.12	0.13	0.13	0.16	0.23	0.36

Area-Weighted Runoff Coefficient Calculations

Version 2.00 released May 2017

Designer: Richard Lyon
 Company: Rocky Mountain Group
 Date: 4/5/2019
 Project: Loudermilk Minor Subdivision
 Location: Goshawk Road

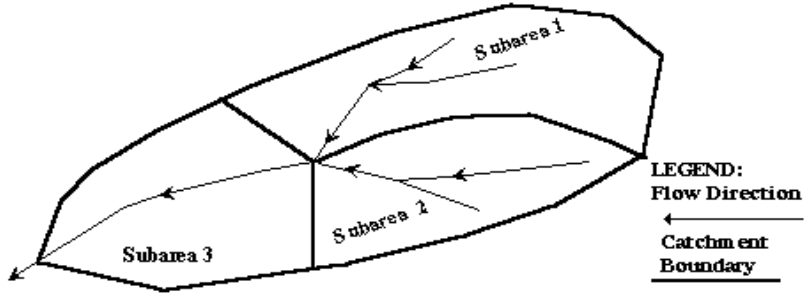

Subcatchment Name
Post-Dev

Cells of this color are for required user-input
Cells of this color are for optional override values
Cells of this color are for calculated results based on overrides

See sheet "Design Info" for imperviousness-based runoff coefficient values.

Sub-Area ID	Area (ac)	NRCS Hydrologic Soil Group	Percent Imperviousness	Runoff Coefficient, C						
				2-yr	5-yr	10-yr	25-yr	50-yr	100-yr	500-yr
GRAVEL	0.23	A	80.0	0.63	0.65	0.66	0.69	0.71	0.73	0.77
FIELD/SOIL	3.19	A	2.0	0.01	0.01	0.01	0.01	0.04	0.13	0.27
Total Area (ac)	3.42	Area-Weighted C		0.05	0.05	0.05	0.06	0.09	0.17	0.30
		Area-Weighted Override C		0.05	0.05	0.05	0.06	0.09	0.17	0.30

Area-Weighted Runoff Coefficient Calculations

Version 2.00 released May 2017


Designer: Richard Lyon

Company: Rocky Mountain Group

Date: 4/5/2019

Project: Loudermilk Minor Subdivision

Location: Goshawk Road

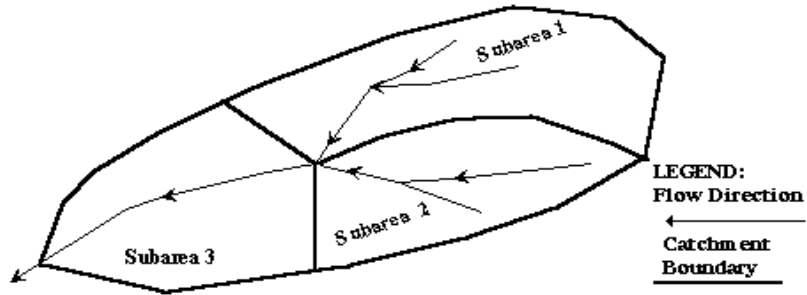

Subcatchment Name
Post-Dev

Cells of this color are for required user-input
Cells of this color are for optional override values
Cells of this color are for calculated results based on overrides

See sheet "Design Info" for imperviousness-based runoff coefficient values.

Sub-Area ID	Area (ac)	NRCS Hydrologic Soil Group	Percent Imperviousness	Runoff Coefficient, C						
				2-yr	5-yr	10-yr	25-yr	50-yr	100-yr	500-yr
ROOF	0.03	A	90.0	0.73	0.75	0.77	0.79	0.79	0.81	0.83
CONCRETE	0.02	A	90.0	0.73	0.75	0.77	0.79	0.79	0.81	0.83
WOOD	0.001	A	90.0	0.73	0.75	0.77	0.79	0.79	0.81	0.83
GRAVEL	0.27	A	80.0	0.63	0.65	0.66	0.69	0.71	0.73	0.77
FIELD/SOIL	3.49	A	2.0	0.01	0.01	0.01	0.01	0.04	0.13	0.27
Total Area (ac)	3.81									
			Area-Weighted C	0.06	0.06	0.06	0.07	0.10	0.18	0.31
			Area-Weighted Override C	0.06	0.06	0.06	0.07	0.10	0.18	0.31

Area-Weighted Runoff Coefficient Calculations

Version 2.00 released May 2017


Designer: Richard Lyon

Company: Rocky Mountain Group

Date: 4/5/2019

Project: Loudermilk Minor Subdivision

Location: Goshawk Road

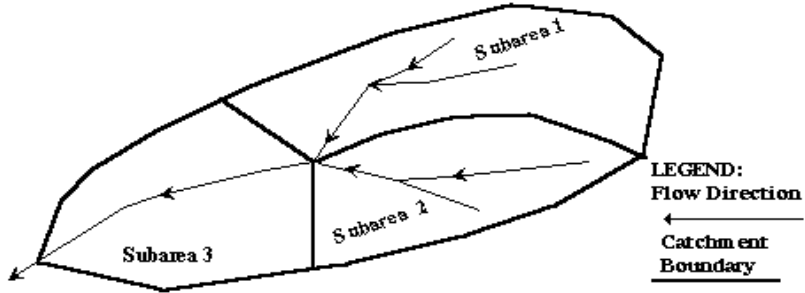

Subcatchment Name
Post-Dev

Cells of this color are for required user-input
 Cells of this color are for optional override values
 Cells of this color are for calculated results based on overrides

See sheet "Design Info" for imperviousness-based runoff coefficient values.

Sub-Area ID	Area (ac)	NRCS Hydrologic Soil Group	Percent Imperviousness	Runoff Coefficient, C						
				2-yr	5-yr	10-yr	25-yr	50-yr	100-yr	500-yr
FIELD/SOIL	3.47	A	2.0	0.01	0.01	0.01	0.01	0.04	0.13	0.27
Total Area (ac)	3.47		Area-Weighted C	0.01	0.01	0.01	0.01	0.04	0.13	0.27
			Area-Weighted Override C	0.01	0.01	0.01	0.01	0.04	0.13	0.27

Area-Weighted Runoff Coefficient Calculations

Version 2.00 released May 2017


Designer: Richard Lyon

Company: Rocky Mountain Group

Date: 1/15/2019

Project: Loudermilk Minor Subdivision

Location: Goshawk Road

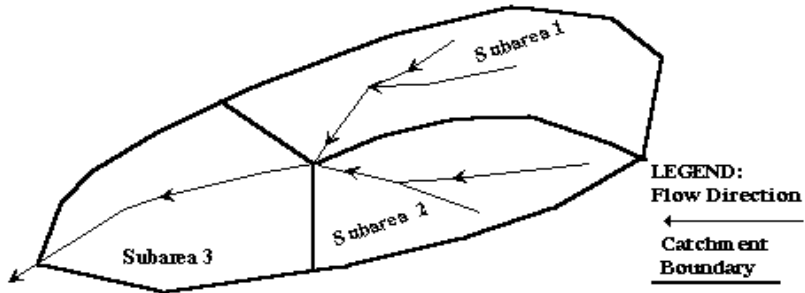

Subcatchment Name
Post-Dev

- Cells of this color are for required user-input
- Cells of this color are for optional override values
- Cells of this color are for calculated results based on overrides

See sheet "Design Info" for imperviousness-based runoff coefficient values.

Sub-Area ID	Area (ac)	NRCS Hydrologic Soil Group	Percent Imperviousness	Runoff Coefficient, C						
				2-yr	5-yr	10-yr	25-yr	50-yr	100-yr	500-yr
FIELD/SOIL	1.83	A	2.0	0.01	0.01	0.01	0.01	0.04	0.13	0.27
Total Area (ac)	1.83	Area-Weighted C		0.01	0.01	0.01	0.01	0.04	0.13	0.27
		Area-Weighted Override C		0.01	0.01	0.01	0.01	0.04	0.13	0.27

Calculation of Peak Runoff using Rational Method

Designer: Richard Lyon
 Company: Rocky Mountain Group
 Date: 4/5/2019
 Project: Loudermilk Minor Subdivision
 Location: Goshawk Road

Version 2.00 released May 2017

Cells of this color are for required user-input
 Cells of this color are for optional override values
 Cells of this color are for calculated results based on overrides

$$t_t = \frac{0.395(1.1 - C_s)\sqrt{L_t}}{S^{0.33}}$$

$$t_t = \frac{L_t}{60K\sqrt{S_t}} = \frac{L_t}{60V_t}$$

Computed $t_c = t_t + t_r$

Regional $t_c = (26 - 17i) + \frac{L_t}{60(14i + 9)\sqrt{S_t}}$

$t_{\text{minimum}} = 5$ (urban)
 $t_{\text{minimum}} = 10$ (non-urban)

Selected $t_c = \max\{t_{\text{minimum}}, \min(\text{Computed } t_c, \text{Regional } t_c)\}$

Select UDFCD location for NOAA Atlas 14 Rainfall Depths from the pulldown list OR enter your own depths obtained from the NOAA website (click this link)

1-hour rainfall depth, P1 (in)	2-yr	5-yr	10-yr	25-yr	50-yr	100-yr	500-yr
	0.93	1.20	1.45	1.82	2.12	2.45	3.30

Rainfall Intensity Equation Coefficients =

a	b	c
28.50	10.00	0.786

$$I(\text{in/hr}) = \frac{a + P_1}{(b + t_c)^c}$$


$Q(\text{cfs}) = CIA$

Subcatchment Name	Area (ac)	NRCS Hydrologic Soil Group	Percent Imperviousness	Runoff Coefficient, C								Overland (Initial) Flow Time					Channelized (Travel) Flow Time					Time of Concentration			Rainfall Intensity, I (in/hr)							Peak Flow, Q (cfs)							
				2-yr	5-yr	10-yr	25-yr	50-yr	100-yr	500-yr	Overland Flow Length L _i (ft)	U/S Elevation (ft) (Optional)	D/S Elevation (ft) (Optional)	Overland Flow Slope S _i (ft/ft)	Overland Flow Time t _i (min)	Channelized Flow Length L _i (ft)	U/S Elevation (ft) (Optional)	D/S Elevation (ft) (Optional)	Channelized Flow Slope S _i (ft/ft)	NRCS Conveyance Factor K	Channelized Flow Velocity V _i (ft/sec)	Channelized Flow Time t _i (min)	Computed t _c (min)	Regional t _c (min)	Selected t _c (min)	2-yr	5-yr	10-yr	25-yr	50-yr	100-yr	500-yr	2-yr	5-yr	10-yr	25-yr	50-yr	100-yr	500-yr
DP1	18.42	A	3.9	0.01	0.01	0.02	0.02	0.06	0.14	0.28	500.00	7450.00	7416.00	0.068	23.30	500.00	7416.00	7395.00	0.042	5	1.02	8.13	31.43	29.61	29.61	1.47	1.90	2.29	2.88	3.35	3.87	5.22	0.33	0.47	0.67	1.21	3.58	10.00	26.81
DP2	2.41	A	13.9	0.06	0.07	0.08	0.10	0.14	0.22	0.34	500.00	7450.00	7434.00	0.032	28.34	500.00	7434.00	7410.00	0.048	15	3.29	2.54	30.88	27.11	27.11	1.54	2.00	2.41	3.03	3.53	4.08	5.49	0.24	0.33	0.45	0.70	1.22	2.15	4.55
DP3	2.95	A	2.0	0.01	0.01	0.01	0.01	0.04	0.13	0.27	500.00	7450.00	7415.00	0.070	23.24	450.00	7415.00	7414.00	0.002	5	0.24	31.82	55.06	42.80	42.80	1.17	1.51	1.83	2.30	2.67	3.09	4.16	0.02	0.03	0.04	0.07	0.33	1.15	3.28

CIRCULAR CONDUIT FLOW (Normal & Critical Depth Computation)

Project: Loudermilk Minor Subdivision

Pipe ID: Proposed 18" CMP Culvert Pipe (DP1)

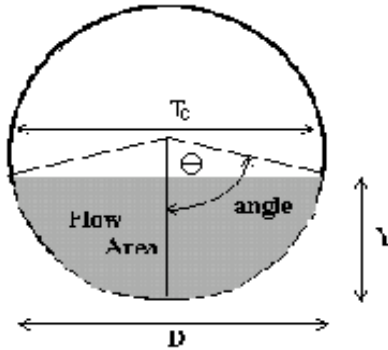


Design Information (Input)	
Pipe Invert Slope	So = 0.0267 ft/ft
Pipe Manning's n-value	n = 0.0150
Pipe Diameter	D = 18.00 inches
Design discharge	Q = 10.00 cfs
Full-flow Capacity (Calculated)	
Full-flow area	Af = 1.77 sq ft
Full-flow wetted perimeter	Pf = 4.71 ft
Half Central Angle	Theta = 3.14 radians
Full-flow capacity	Qf = 14.92 cfs
Calculation of Normal Flow Condition	
Half Central Angle ($0 < \theta < 3.14$)	Theta = 1.77 radians
Flow area	An = 1.11 sq ft
Top width	Tn = 1.47 ft
Wetted perimeter	Pn = 2.66 ft
Flow depth	Yn = 0.90 ft
Flow velocity	Vn = 9.05 fps
Discharge	Qn = 10.00 cfs
Percent Full Flow	Flow = 67.0% of full flow
Normal Depth Froude Number	Fr _n = 1.84 supercritical
Calculation of Critical Flow Condition	
Half Central Angle ($0 < \theta_c < 3.14$)	Theta-c = 2.25 radians
Critical flow area	Ac = 1.54 sq ft
Critical top width	Tc = 1.17 ft
Critical flow depth	Yc = 1.22 ft
Critical flow velocity	Vc = 6.50 fps
Critical Depth Froude Number	Fr _c = 1.00

Vertical Profile for the Culvert

Project = **Loudermilk Minor Subdivision**

Box ID = **Proposed 18" CMP Culvert Pipe (DP1)**

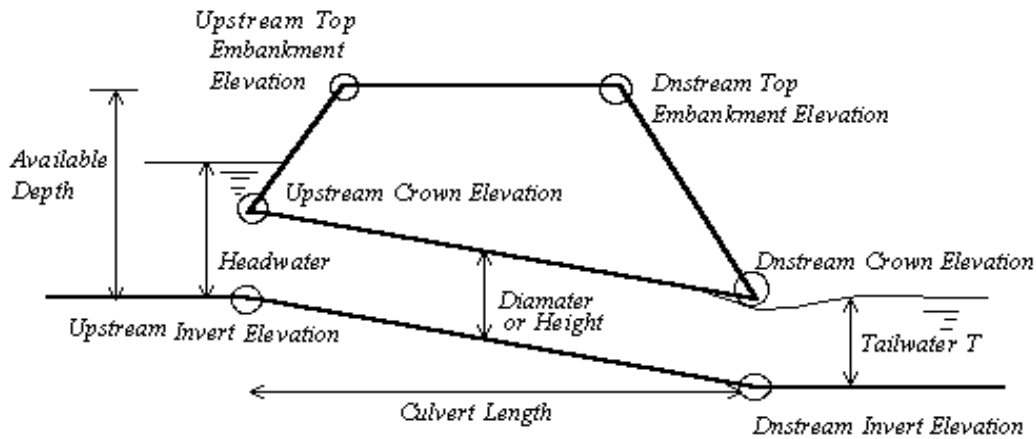

Culvert Information (Input)

Barrel Diameter or Height	D or H =	<input type="text" value="18.00"/>	inches
Barrel Length	L =	<input type="text" value="56.00"/>	ft
Barrel Invert Slope	So =	<input type="text" value="0.0267"/>	ft/ft
Downstream Invert Elevation	EDI =	<input type="text" value="7393.50"/>	ft
Downstream Top Embankment Elevation	EDT =	<input type="text" value="7402.00"/>	ft
Upstream Top Embankment Elevation	EUT =	<input type="text" value="7402.00"/>	ft
Design Headwater Depth (not elev.)	Hw =	<input type="text" value="6.00"/>	ft
Tailwater Depth (not elev.)	Yt =	<input type="text" value="7.50"/>	ft

Culvert Hydraulics (Calculated)

Available Headwater Depth	HW-a =	<input type="text" value="7.00"/>	ft
Design Hw/D ratio	Hw/D =	<input type="text" value="4.00"/>	


Culvert Vertical Profile

Upstream Invert Elevation	EUI =	<input type="text" value="7395.00"/>	ft
Upstream Crown Elevation	EUC =	<input type="text" value="7396.50"/>	ft
Upstream Soil Cover Depth	Upsoil =	<input type="text" value="5.50"/>	ft
Downstream Invert Elevation	EDI =	<input type="text" value="7393.50"/>	ft
Downstream Crown Elevation	EDC =	<input type="text" value="7395.00"/>	ft
Downstream Soil Cover Depth	Dnsoil =	<input type="text" value="7.00"/>	ft

Determination of Culvert Headwater and Outlet Protection

Project: **Loudermilk Minor Subdivision**

Basin ID: **DP1**

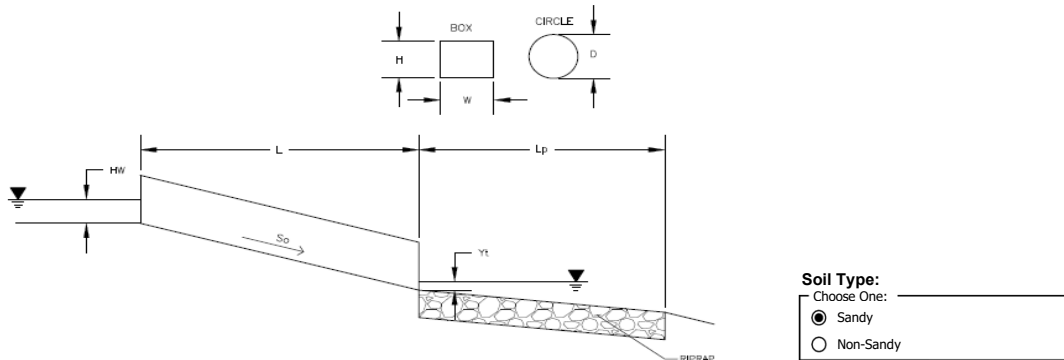

Soil Type:
 Choose One: _____
 Sandy
 Non-Sandy

Supercritical Flow! Using D_a to calculate protection type.


Design Information (Input):	
Design Discharge	Q = <input style="width: 50px;" type="text" value="10"/> cfs
Circular Culvert:	
Barrel Diameter in Inches	D = <input style="width: 50px;" type="text" value="18"/> inches
Inlet Edge Type (Choose from pull-down list)	Grooved End with Headwall
Box Culvert:	OR
Barrel Height (Rise) in Feet	Height (Rise) = <input style="width: 50px;" type="text"/>
Barrel Width (Span) in Feet	Width (Span) = <input style="width: 50px;" type="text"/>
Inlet Edge Type (Choose from pull-down list)	<input style="width: 50px;" type="text"/>
Number of Barrels	No = <input style="width: 50px;" type="text" value="1"/>
Inlet Elevation	Elev IN = <input style="width: 50px;" type="text" value="7395"/> ft
Outlet Elevation OR Slope	Elev OUT = <input style="width: 50px;" type="text" value="7393.5"/> ft
Culvert Length	L = <input style="width: 50px;" type="text" value="56"/> ft
Manning's Roughness	n = <input style="width: 50px;" type="text" value="0.015"/>
Bend Loss Coefficient	k_b = <input style="width: 50px;" type="text" value="0"/>
Exit Loss Coefficient	k_x = <input style="width: 50px;" type="text" value="1"/>
Tailwater Surface Elevation	Elev Y_t = <input style="width: 50px;" type="text"/>
Max Allowable Channel Velocity	V = <input style="width: 50px;" type="text" value="5"/> ft/s

Required Protection (Output):	
Tailwater Surface Height	Y_t = <input style="width: 50px;" type="text" value="0.60"/> ft
Flow Area at Max Channel Velocity	A_t = <input style="width: 50px;" type="text" value="2.00"/> ft ²
Culvert Cross Sectional Area Available	A = <input style="width: 50px;" type="text" value="1.77"/> ft ²
Entrance Loss Coefficient	k_e = <input style="width: 50px;" type="text" value="0.20"/>
Friction Loss Coefficient	k_f = <input style="width: 50px;" type="text" value="1.35"/>
Sum of All Losses Coefficients	k_s = <input style="width: 50px;" type="text" value="2.55"/> ft
Culvert Normal Depth	Y_n = <input style="width: 50px;" type="text" value="0.90"/> ft
Culvert Critical Depth	Y_c = <input style="width: 50px;" type="text" value="1.22"/> ft
Tailwater Depth for Design	d = <input style="width: 50px;" type="text" value="1.36"/> ft
Adjusted Diameter OR Adjusted Rise	D_a = <input style="width: 50px;" type="text" value="1.20"/> ft
Expansion Factor	$1/(2*\tan(\theta))$ = <input style="width: 50px;" type="text" value="5.25"/>
Flow/Diameter ^{2.5} OR Flow/(Span * Rise ^{1.5})	$Q/D^{2.5}$ = <input style="width: 50px;" type="text" value="3.63"/> ft ^{0.5} /s
Froude Number	Fr = <input style="width: 50px;" type="text" value="1.84"/> Supercritical!
Tailwater/Adjusted Diameter OR Tailwater/Adjusted Rise	Y_t/D = <input style="width: 50px;" type="text" value="0.50"/>
Inlet Control Headwater	H_{W1} = <input style="width: 50px;" type="text" value="2.00"/> ft
Outlet Control Headwater	H_{W0} = <input style="width: 50px;" type="text" value="1.13"/> ft
Design Headwater Elevation	HW = <input style="width: 50px;" type="text" value="7,397.00"/> ft
Headwater/Diameter OR Headwater/Rise Ratio	HW/D = <input style="width: 50px;" type="text" value="1.34"/>
Minimum Theoretical Riprap Size	d_{50} = <input style="width: 50px;" type="text" value="5"/> in
Nominal Riprap Size	d_{50} = <input style="width: 50px;" type="text" value="6"/> in
UDFCD Riprap Type	Type = <input style="width: 50px;" type="text" value="VL"/>
Length of Protection	L_p = <input style="width: 50px;" type="text" value="10"/> ft
Width of Protection	T = <input style="width: 50px;" type="text" value="4"/> ft

CIRCULAR CONDUIT FLOW (Normal & Critical Depth Computation)

Project: Loudermilk Minor Subdivision

Pipe ID: Existing Driveway Entrance Culvert Pipe (DP2)

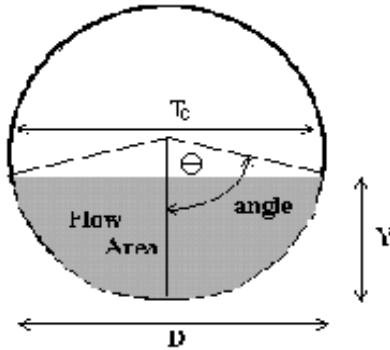

Design Information (Input)

Pipe Invert Slope	So =	0.0200	ft/ft
Pipe Manning's n-value	n =	0.0150	
Pipe Diameter	D =	18.00	inches
Design discharge	Q =	0.45	cfs

Full-flow Capacity (Calculated)

Full-flow area	Af =	1.77	sq ft
Full-flow wetted perimeter	Pf =	4.71	ft
Half Central Angle	Theta =	3.14	radians
Full-flow capacity	Qf =	12.91	cfs

Calculation of Normal Flow Condition

Half Central Angle ($0 < \theta < 3.14$)	Theta =	0.73	radians
Flow area	An =	0.13	sq ft
Top width	Tn =	1.00	ft
Wetted perimeter	Pn =	1.10	ft
Flow depth	Yn =	0.19	ft
Flow velocity	Vn =	3.42	fps
Discharge	Qn =	0.45	cfs
Percent Full Flow	Flow =	3.5%	of full flow
Normal Depth Froude Number	Fr _n =	1.66	supercritical


Calculation of Critical Flow Condition

Half Central Angle ($0 < \theta_c < 3.14$)	Theta-c =	0.84	radians
Critical flow area	Ac =	0.19	sq ft
Critical top width	Tc =	1.11	ft
Critical flow depth	Yc =	0.25	ft
Critical flow velocity	Vc =	2.35	fps
Critical Depth Froude Number	Fr _c =	1.00	

CIRCULAR CONDUIT FLOW (Normal & Critical Depth Computation)

Project: Loudermilk Minor Subdivision

Pipe ID: Proposed Culvert Pipe (DP3)

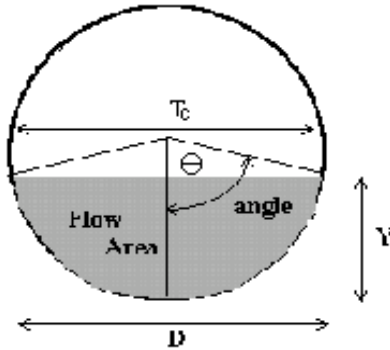


Design Information (Input)	
Pipe Invert Slope	So = 0.0200 ft/ft
Pipe Manning's n-value	n = 0.0150
Pipe Diameter	D = 18.00 inches
Design discharge	Q = 0.05 cfs
Full-flow Capacity (Calculated)	
Full-flow area	Af = 1.77 sq ft
Full-flow wetted perimeter	Pf = 4.71 ft
Half Central Angle	Theta = 3.14 radians
Full-flow capacity	Qf = 12.91 cfs
Calculation of Normal Flow Condition	
Half Central Angle ($0 < \theta < 3.14$)	Theta = 0.43 radians
Flow area	An = 0.03 sq ft
Top width	Tn = 0.62 ft
Wetted perimeter	Pn = 0.64 ft
Flow depth	Yn = 0.07 ft
Flow velocity	Vn = 1.76 fps
Discharge	Qn = 0.05 cfs
Percent Full Flow	Flow = 0.4% of full flow
Normal Depth Froude Number	Fr _n = 1.45 supercritical
Calculation of Critical Flow Condition	
Half Central Angle ($0 < \theta_c < 3.14$)	Theta-c = 0.47 radians
Critical flow area	Ac = 0.04 sq ft
Critical top width	Tc = 0.68 ft
Critical flow depth	Yc = 0.08 ft
Critical flow velocity	Vc = 1.33 fps
Critical Depth Froude Number	Fr _c = 1.00

Vertical Profile for the Culvert

Project = **Loudermilk Minor Subdivision**

Box ID = **Proposed 18" CMP Culvert Pipe (DP3)**

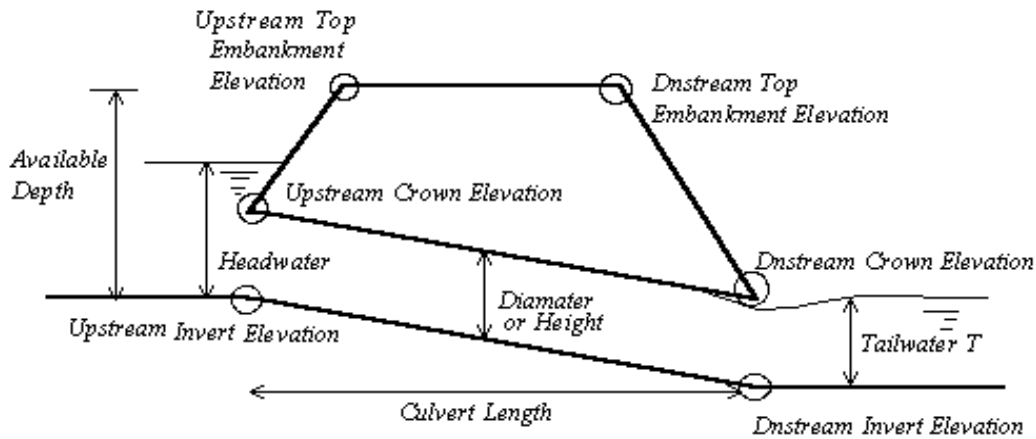

Culvert Information (Input)

Barrel Diameter or Height	D or H =	<input style="border: 2px solid blue;" type="text" value="18.00"/>	inches
Barrel Length	L =	<input style="border: 2px solid blue;" type="text" value="30.00"/>	ft
Barrel Invert Slope	So =	<input style="border: 2px solid blue;" type="text" value="0.0200"/>	ft/ft
Downstream Invert Elevation	EDI =	<input style="border: 2px solid blue;" type="text" value="7414.00"/>	ft
Downstream Top Embankment Elevation	EDT =	<input style="border: 2px solid blue;" type="text" value="7416.00"/>	ft
Upstream Top Embankment Elevation	EUT =	<input style="border: 2px solid blue;" type="text" value="7415.72"/>	ft
Design Headwater Depth (not elev.)	Hw =	<input style="border: 2px solid blue;" type="text" value="2.00"/>	ft
Tailwater Depth (not elev.)	Yt =	<input style="border: 2px solid blue;" type="text" value="2.80"/>	ft

Culvert Hydraulics (Calculated)

Available Headwater Depth	HW-a =	<input style="border: 2px solid green;" type="text" value="1.12"/>	ft
Design Hw/D ratio	Hw/D =	<input style="border: 2px solid green;" type="text" value="1.33"/>	


Culvert Vertical Profile

Upstream Invert Elevation	EUI =	<input style="border: 2px solid green;" type="text" value="7414.60"/>	ft
Upstream Crown Elevation	EUC =	<input style="border: 2px solid green;" type="text" value="7416.10"/>	ft
Upstream Soil Cover Depth	Upsoil =	<input style="border: 2px solid green;" type="text" value="-0.38"/>	ft
Downstream Invert Elevation	EDI =	<input style="border: 2px solid green;" type="text" value="7414.00"/>	ft
Downstream Crown Elevation	EDC =	<input style="border: 2px solid green;" type="text" value="7415.50"/>	ft
Downstream Soil Cover Depth	Dnsoil =	<input style="border: 2px solid green;" type="text" value="0.22"/>	ft

Determination of Culvert Headwater and Outlet Protection

Project: **Loudermilk Minor Subdivision**

Basin ID: **DP3**

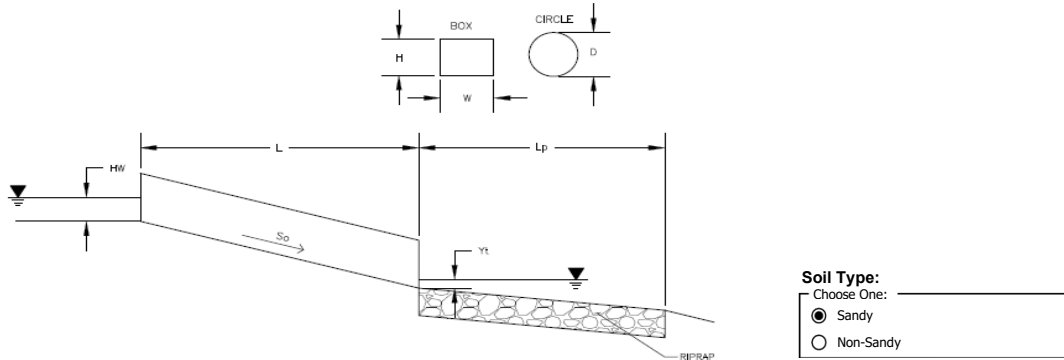

Soil Type:
 Choose One: _____
 Sandy
 Non-Sandy

Supercritical Flow! Using D_a to calculate protection type.

Design Information (Input):	
Design Discharge	Q = <input style="width: 100px;" type="text" value="1.15"/> cfs
Circular Culvert:	
Barrel Diameter in Inches	D = <input style="width: 100px;" type="text" value="18"/> inches
Inlet Edge Type (Choose from pull-down list)	Grooved End with Headwall
Box Culvert:	OR
Barrel Height (Rise) in Feet	Height (Rise) = <input style="width: 100px;" type="text"/>
Barrel Width (Span) in Feet	Width (Span) = <input style="width: 100px;" type="text"/>
Inlet Edge Type (Choose from pull-down list)	
Number of Barrels	No = <input style="width: 100px;" type="text" value="1"/>
Inlet Elevation	Elev IN = <input style="width: 100px;" type="text" value="7414"/> ft
Outlet Elevation OR Slope	Elev OUT = <input style="width: 100px;" type="text" value="7413.4"/> ft
Culvert Length	L = <input style="width: 100px;" type="text" value="30"/> ft
Manning's Roughness	n = <input style="width: 100px;" type="text" value="0.015"/>
Bend Loss Coefficient	k_b = <input style="width: 100px;" type="text" value="0"/>
Exit Loss Coefficient	k_x = <input style="width: 100px;" type="text" value="1"/>
Tailwater Surface Elevation	Elev Y_t = <input style="width: 100px;" type="text"/>
Max Allowable Channel Velocity	V = <input style="width: 100px;" type="text" value="5"/> ft/s
Required Protection (Output):	
Tailwater Surface Height	Y_t = <input style="width: 100px;" type="text" value="0.60"/> ft
Flow Area at Max Channel Velocity	A_t = <input style="width: 100px;" type="text" value="0.23"/> ft ²
Culvert Cross Sectional Area Available	A = <input style="width: 100px;" type="text" value="1.77"/> ft ²
Entrance Loss Coefficient	k_e = <input style="width: 100px;" type="text" value="0.20"/>
Friction Loss Coefficient	k_f = <input style="width: 100px;" type="text" value="0.72"/>
Sum of All Losses Coefficients	k_s = <input style="width: 100px;" type="text" value="1.92"/> ft
Culvert Normal Depth	Y_n = <input style="width: 100px;" type="text" value="0.30"/> ft
Culvert Critical Depth	Y_c = <input style="width: 100px;" type="text" value="0.40"/> ft
Tailwater Depth for Design	d = <input style="width: 100px;" type="text" value="0.95"/> ft
Adjusted Diameter OR Adjusted Rise	D_a = <input style="width: 100px;" type="text" value="0.90"/> ft
Expansion Factor	$1/(2*\tan(\theta))$ = <input style="width: 100px;" type="text" value="6.70"/>
Flow/Diameter ^{2.5} OR Flow/(Span * Rise ^{1.5})	$Q/D^{2.5}$ = <input style="width: 100px;" type="text" value="0.42"/> ft ^{0.5} /s
Froude Number	Fr = <input style="width: 100px;" type="text" value="1.73"/> Supercritical!
Tailwater/Adjusted Diameter OR Tailwater/Adjusted Rise	Y_t/D = <input style="width: 100px;" type="text" value="0.67"/>
Inlet Control Headwater	HW_i = <input style="width: 100px;" type="text" value="0.54"/> ft
Outlet Control Headwater	HW_o = <input style="width: 100px;" type="text" value="0.36"/> ft
Design Headwater Elevation	HW = <input style="width: 100px;" type="text" value="7,414.54"/> ft
Headwater/Diameter OR Headwater/Rise Ratio	HW/D = <input style="width: 100px;" type="text" value="0.36"/>
Minimum Theoretical Riprap Size	d_{50} = <input style="width: 100px;" type="text" value="1"/> in
Nominal Riprap Size	d_{50} = <input style="width: 100px;" type="text" value="6"/> in
UDFCD Riprap Type	Type = <input style="width: 100px;" type="text" value="VL"/>
Length of Protection	L_p = <input style="width: 100px;" type="text" value="5"/> ft
Width of Protection	T = <input style="width: 100px;" type="text" value="3"/> ft

Level Spreader Calculation

Design Procedure and Criteria

The following steps outline the grass buffer design procedure and criteria. [Figure GB-1](#) is a schematic of the facility and its components:

1. **Design Discharge:** Use the hydrologic procedures described in the *Runoff* chapter of Volume 1 to determine the 2-year peak flow rate (Q_2) of the area draining to the grass buffer.
2. **Minimum Width:** The width (W), normal to flow of the buffer, is typically the same as the contributing basin (see [Figure GB-1](#)). An exception to this is where flows become concentrated. Concentrated flows require a level spreader to distribute flows evenly across the width of the buffer. The minimum width should be:

$$W = \frac{Q_2}{0.05} \quad \text{Equation GB-1}$$

Where:

W = width of buffer (ft)

Q_2 = 2-year peak runoff (cfs)

To be conservative, the Q5 is used per calcs:

Culvert Pipe for DP1:

$$W = \frac{0.43 \text{ cfs}}{0.05} = 8.6 \text{ ft minimum width}$$

Design width of 10 ft. used. Safety factor of 1.16.

Culvert Pipe for DP2:

$$W = \frac{0.33 \text{ cfs}}{0.05} = 6.6 \text{ ft minimum width}$$

Design width of 7 ft. used. Safety factor of 1.06.

Culvert Pipe for DP3:

$$W = \frac{0.03 \text{ cfs}}{0.05} = 0.6 \text{ ft minimum width}$$



Design width of 2 ft. used. Safety factor of 3.33.

- 3. Length:** The recommended length (*L*), the distance along the sheet flow direction, should be a minimum of 14 feet. This value is based on the findings of Barrett et al. 2004 in *Stormwater Pollutant Removal in Roadside Vegetated Strips* and is appropriate for buffers with greater than 80% vegetative cover and slopes up to 10%. The study found that pollutant removal continues throughout a length of 14 feet. Beyond this length, a point of diminishing returns in pollutant reduction was found. It is important to note that shorter lengths or slightly steeper slopes will also provide some level of removal where site constraints dictate the geometry of the buffer.

Design length = 14 ft for each.

Appendix E – Elevation Exhibit, Subbasin Exhibits

Elevations Table				
Number	Minimum Elevation	Maximum Elevation	Area	Color
1	7385.00	7405.00	263738.01	Dark Red
2	7405.00	7411.00	253743.72	Red
3	7411.00	7415.00	222732.83	Light Red
4	7415.00	7420.00	308359.72	Orange
5	7420.00	7435.00	278081.02	Yellow

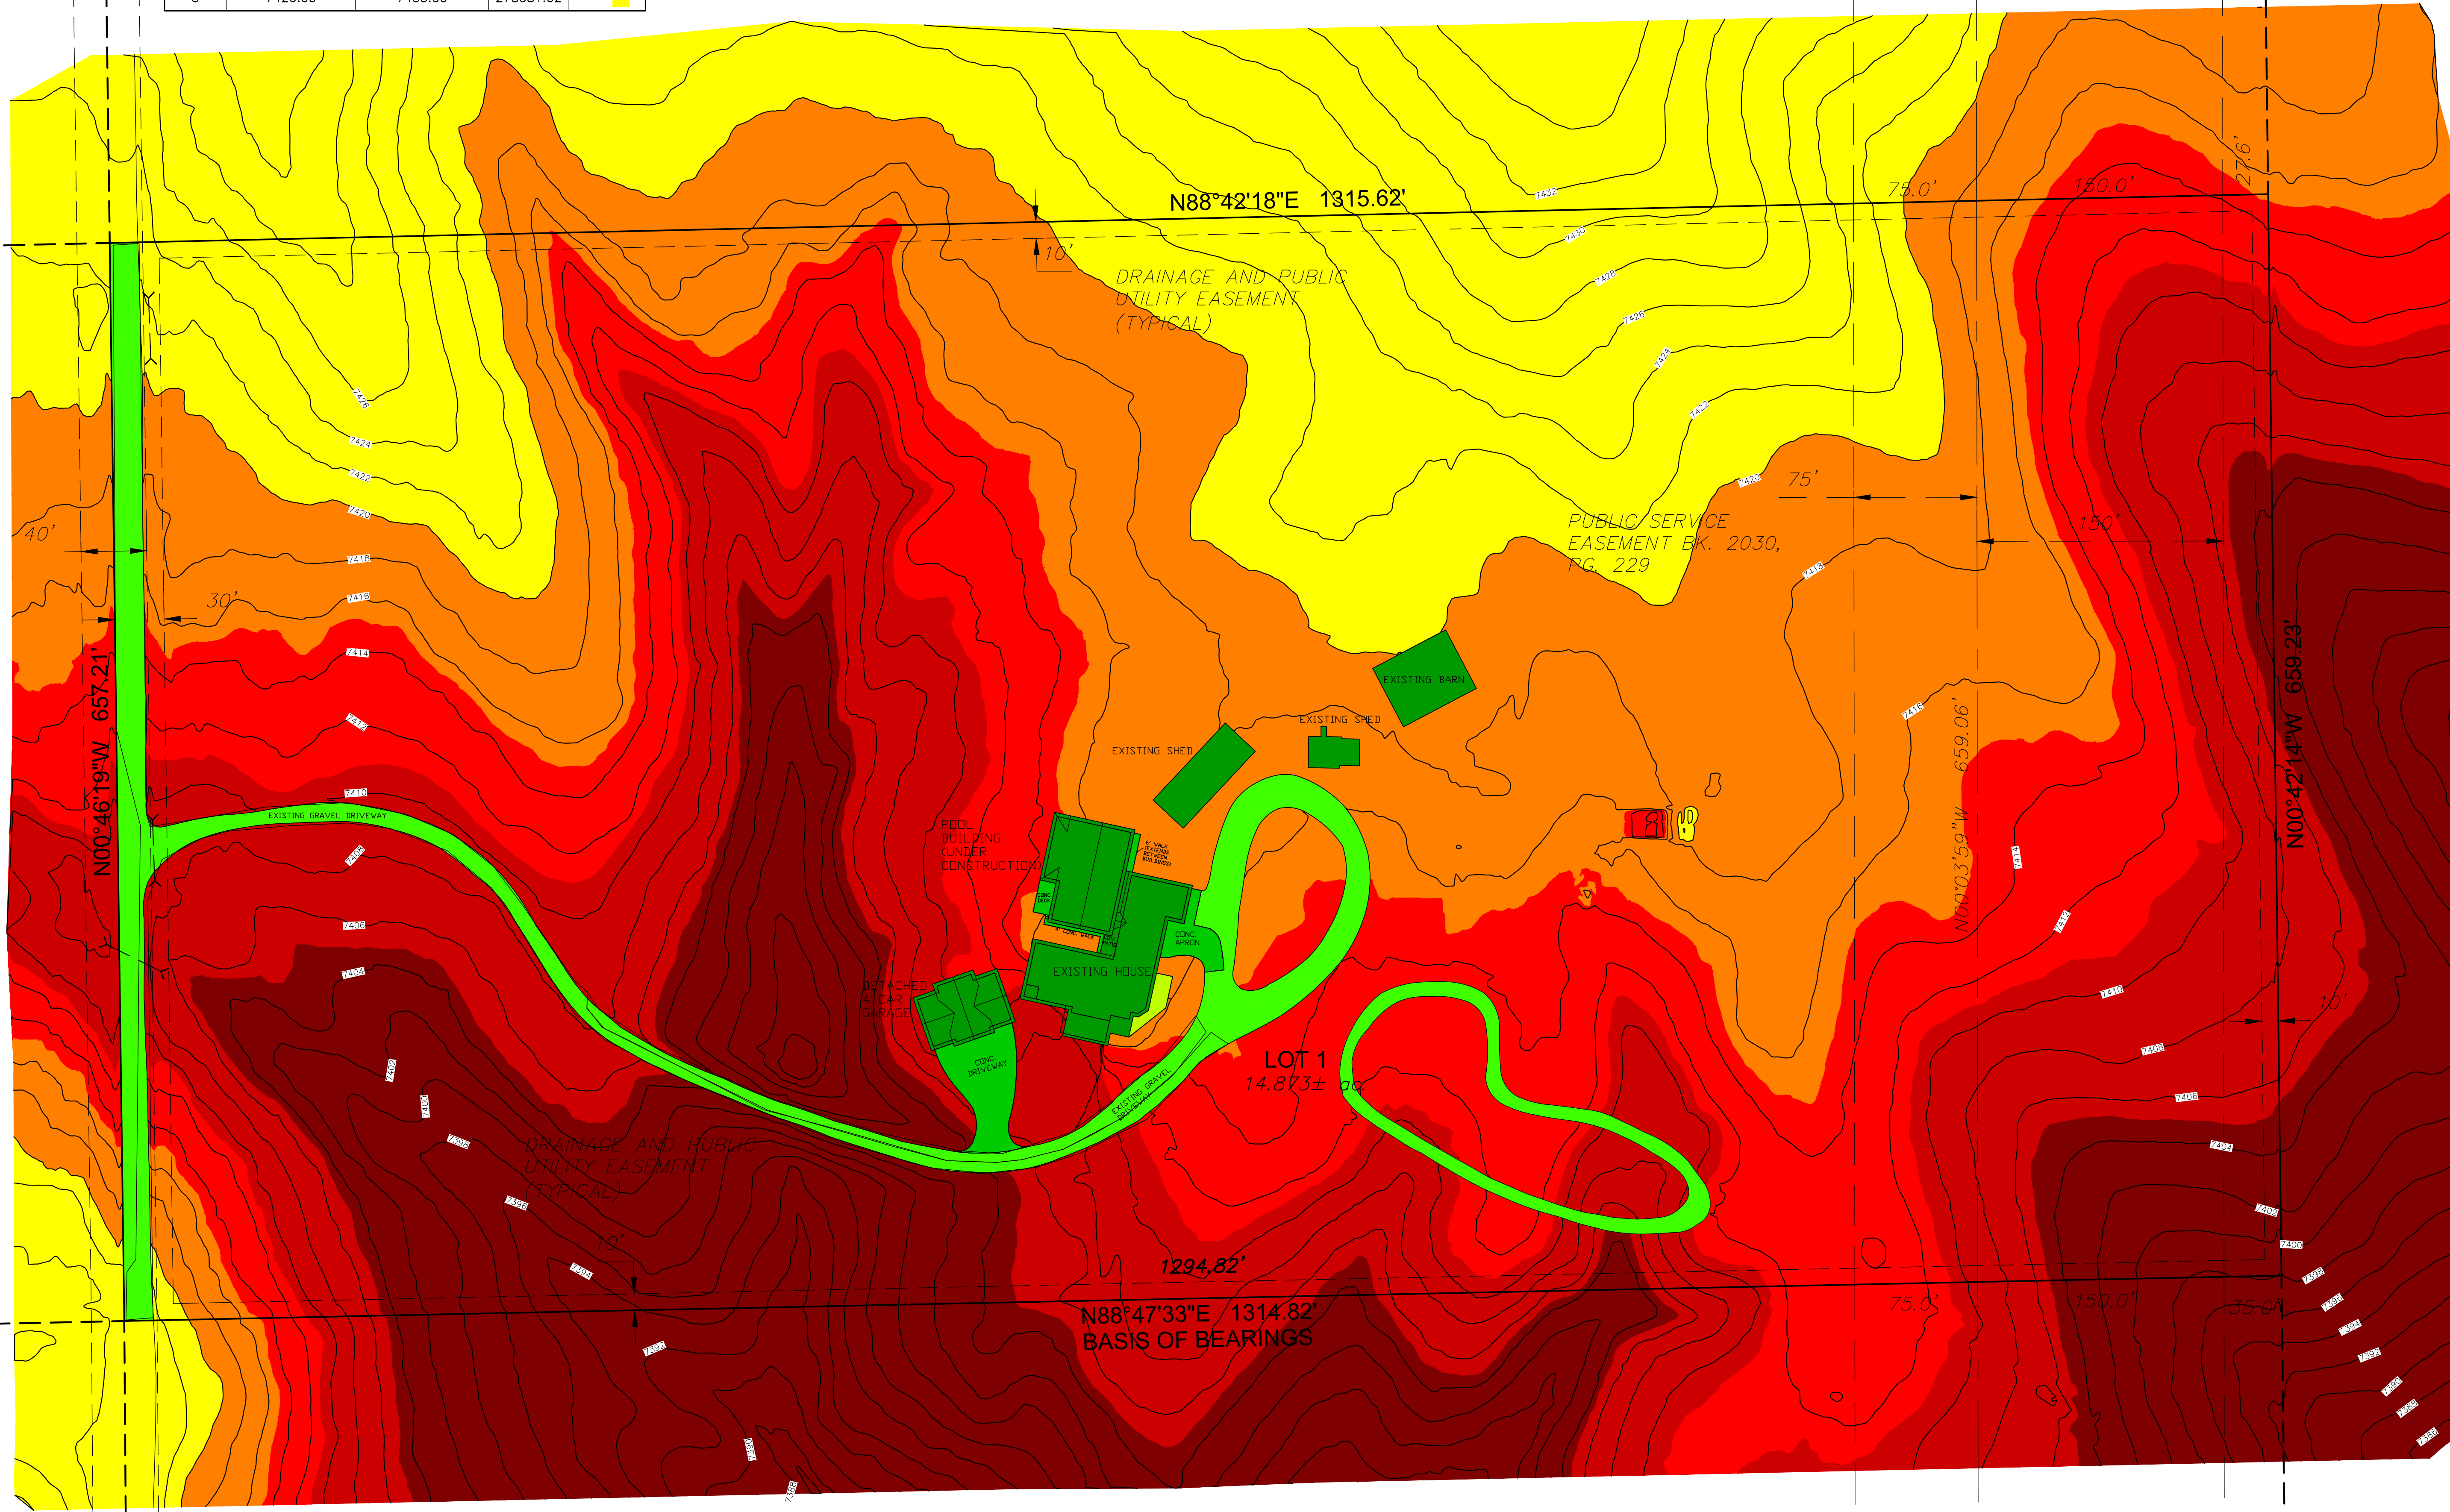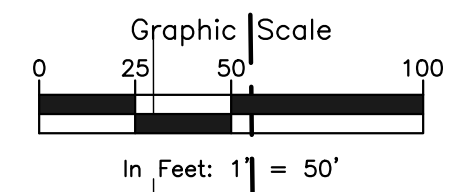

ROCKY MOUNTAIN GROUP
 ARCHITECTS
RMG
 ENGINEERS

SOUTHERN COLORADO
 19375 BEACON LITE RD., MONUMENT, CO 80132
 P.O. BOX 145 WWW.ROCKYMOUNTAINENGINEERS.COM
 Structural Forensics Geotechnical Materials Testing Civil Planning

NOT FOR CONSTRUCTION
 FOR CIVIL ONLY


LOUDERMILK MINOR SUBDIVISION
 17115 GOSHAWK ROAD
 COLORADO SPRINGS, CO

ARVIN AND CHERYL LOUDERMILK


These plans are copyrighted 2018 by Geotechnical Engineers Inc. dba RMG - Rocky Mountain Group all rights reserved. Any sale, reproduction, creation of derivative works based on these plans, or use of these plans for any purpose without proper compensation to and the express written consent of RMG, is strictly prohibited.

SHEET NAME		PROJECT STATUS	
ELEVATIONS EXHIBIT		APPLICATION SUBMITTAL	
ENG:	ROL	CHECKED:	ROL
DRAWN:	ROL	DATE	04/05/19
#	REVISION	DATE	
	SUBD APP	01/14/19	
	SUBD APP 2	01/17/19	
	CNTY REV. 1	04/05/19	
JOB NO.	167392		
SHEET NO.	EXHIBIT 01		
	of 05		

LAST SAVED: 4/5/2019 11:47:41 AM PATH: C:\Users\jld\OneDrive\Projects\2018\LOUDERMILK\Roadwork\167392\RMG\LOUDERMILK - ELEVATIONS.dwg

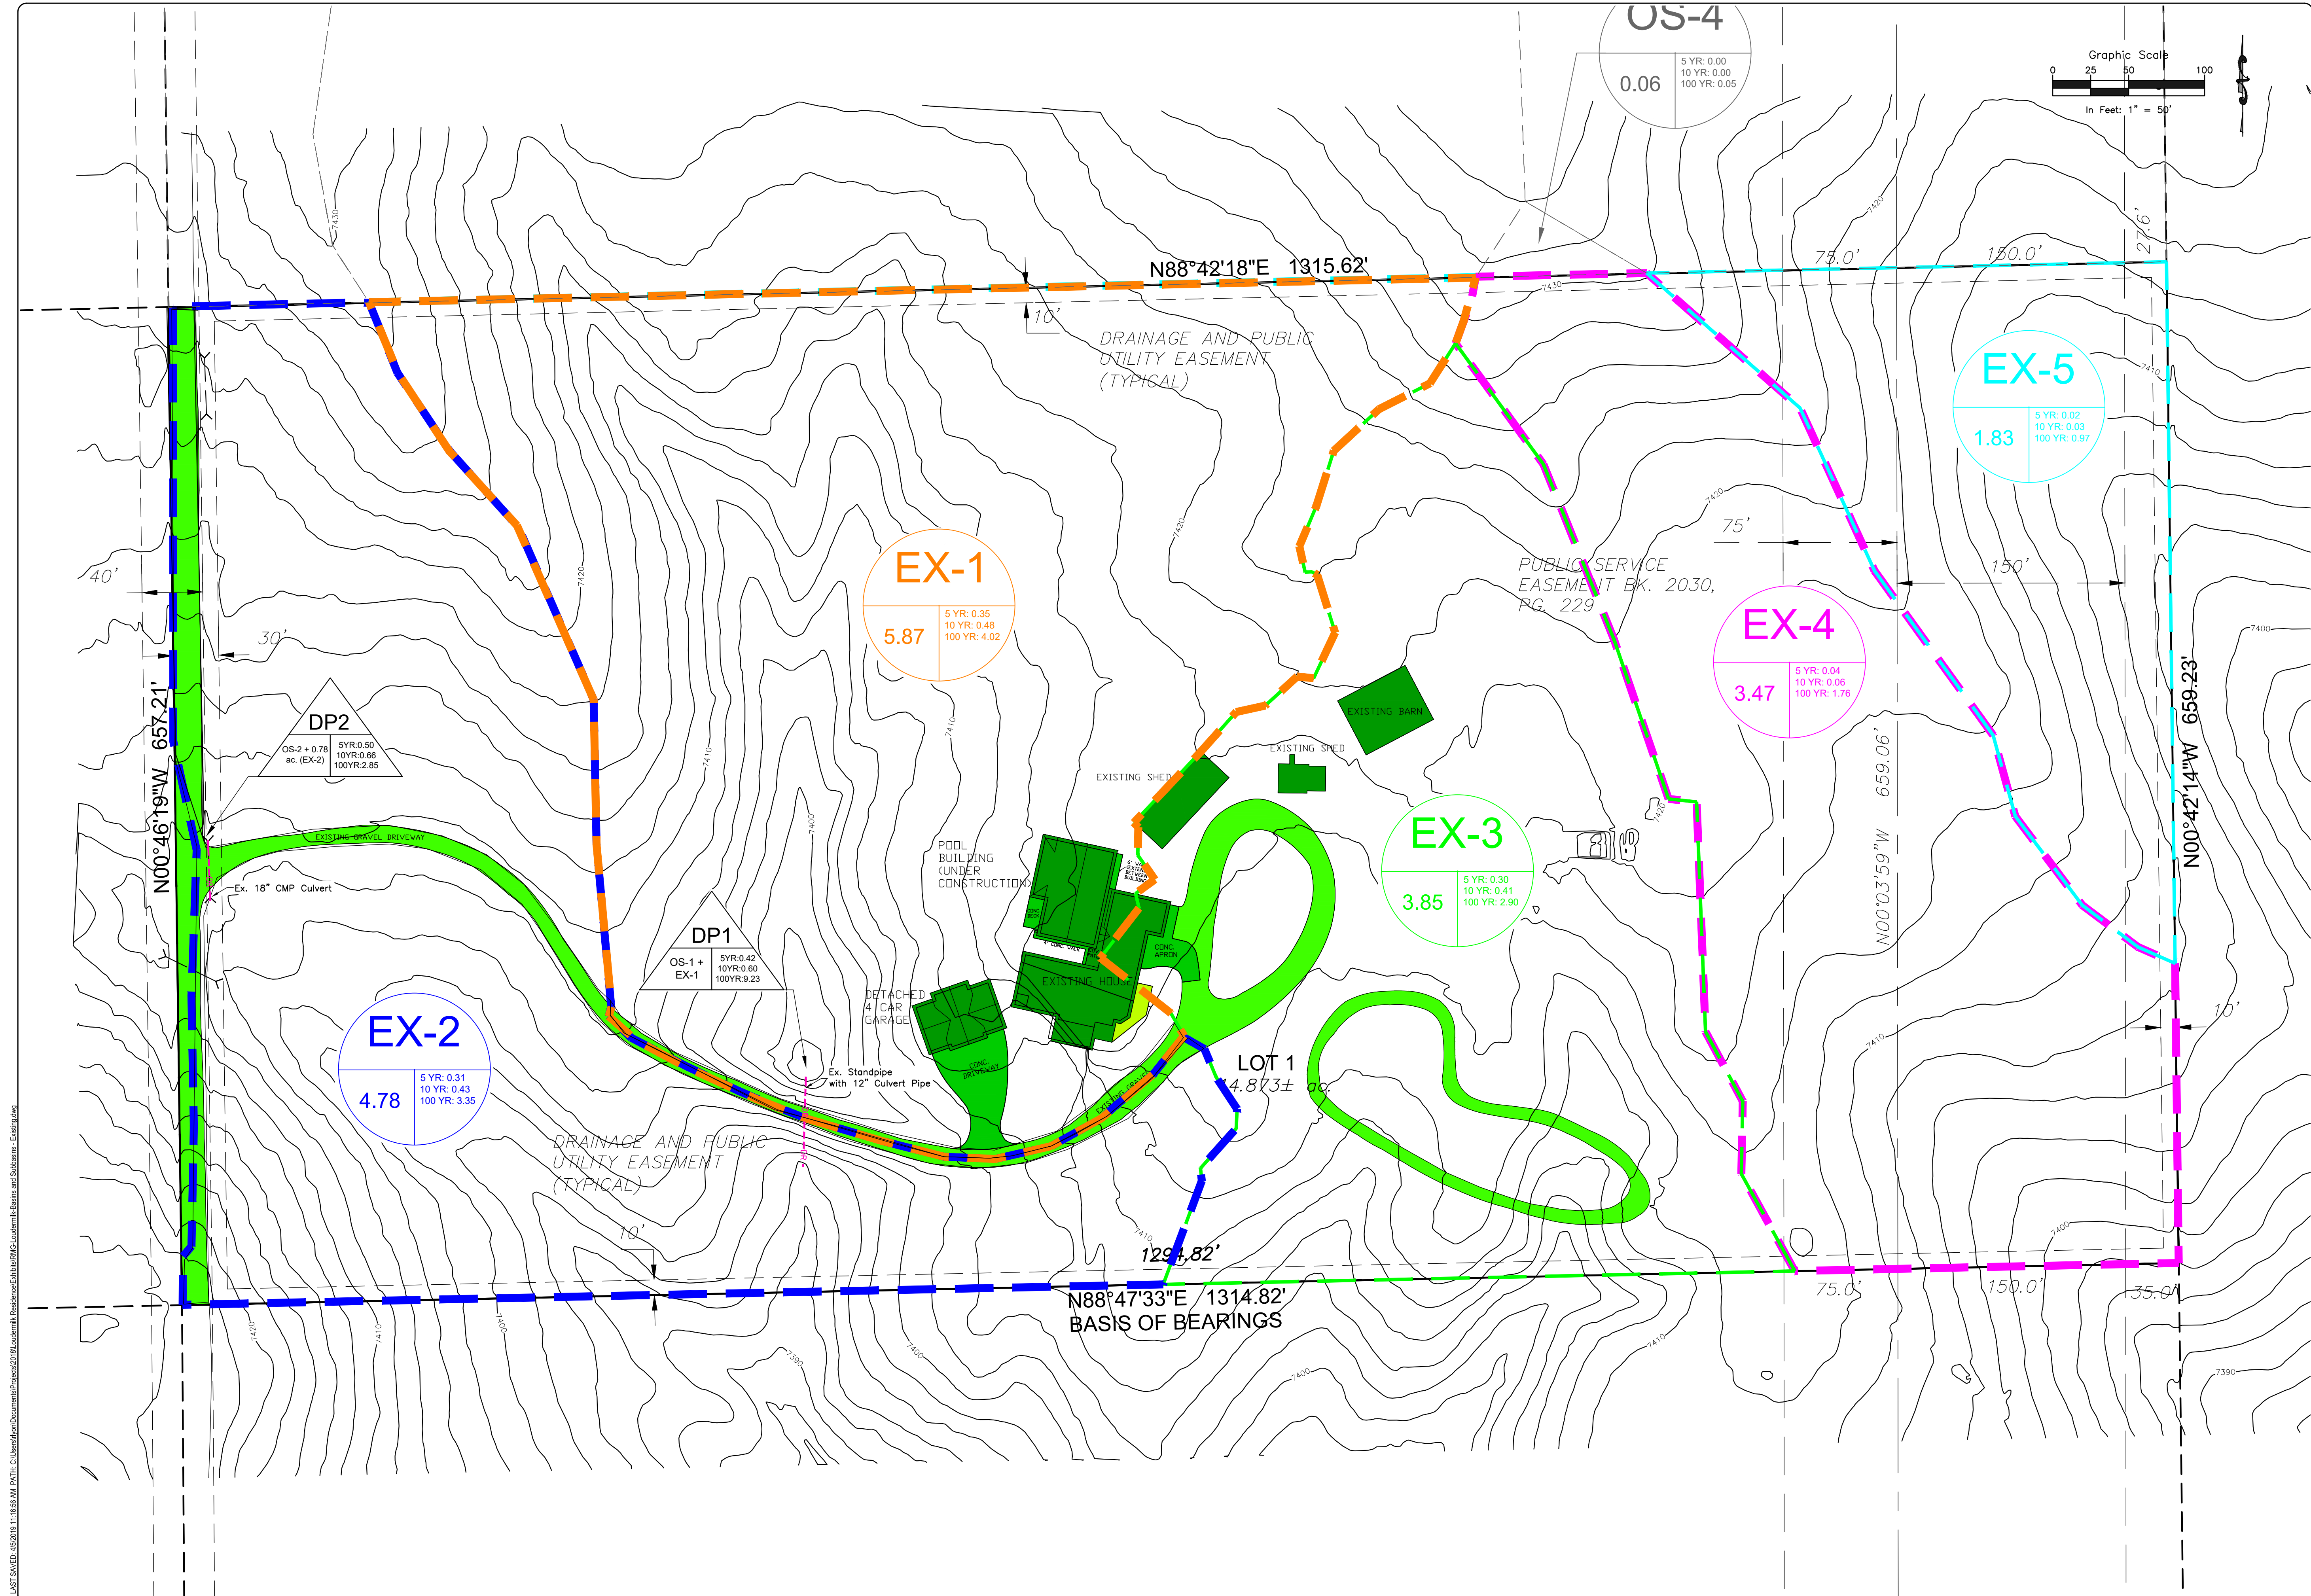

OS-4
0.06
5 YR: 0.00
10 YR: 0.00
100 YR: 0.05

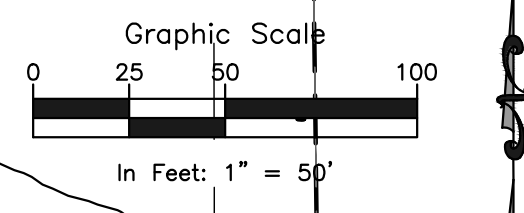

EX-1
5.87
5 YR: 0.35
10 YR: 0.48
100 YR: 4.02

EX-2
4.78
5 YR: 0.31
10 YR: 0.43
100 YR: 3.35

EX-3
3.85
5 YR: 0.30
10 YR: 0.41
100 YR: 2.90

EX-4
3.47
5 YR: 0.04
10 YR: 0.06
100 YR: 1.76

EX-5
1.83
5 YR: 0.02
10 YR: 0.03
100 YR: 0.97

DP2
OS-2 + 0.78 ac (EX-2)
5 YR: 0.50
10 YR: 0.65
100 YR: 2.85

DP1
OS-1 + EX-1
5 YR: 0.42
10 YR: 0.60
100 YR: 9.23

N88°47'33"E / 1314.82'
BASIS OF BEARINGS

LOT 1
4.873± ac

LAST SAVED: 4/20/19 11:16:56 AM PATH: C:\Users\jordan\Documents\Project\2018\LOUdermilk\Roadwork\Subbasins\LOUdermilk_Minor_Subdivision_and_Subbasins - Existing.dwg

Geotechnical
Materials Testing
Civil Planning

SOUTHERN COLORADO
19375 BEACON LITE RD., MONUMENT, CO 80132
719.585.5145 WWW.RMGENGINEERS.COM
Structural, Geotechnical, Drainage, Surveying, Hydrological, Geospatial

LOUdermilk MINOR SUBDIVISION
 17115 GOSHAWK ROAD
 COLORADO SPRINGS, CO

ARVIN AND CHERYL LOUdermilk


PROJECT STATUS: APPLICATION SUBMITTAL

SHEET NAME: EXISTING SUBBASINS

ENG:	ROL	
DRAWN:	ROL	
CHECKED:	ROL	
DATE:	04/05/19	
#	REVISION	DATE
1	SUBD APP	01/14/19
2	SUBD APP 2	01/17/19
3	CNTY REV. 1	04/05/19
4		
5		
6		
7		
8		
9		
10		
JOB NO.:	167392	
SHEET NO.:	EXHIBIT 02	

of 65

LAST SAVED: 4/5/2019 11:16:56 AM PATH: C:\Users\jfor\Documents\Project\2018\Loudermilk\Readme\Drawings\Subbasins and Subareas - Existing.dwg

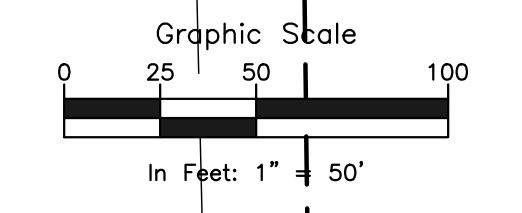

ROCKY MOUNTAIN GROUP
 ARCHITECTS
 ENGINEERS

Geotechnical
 Materials Testing
 Civil Planning

Architectural
 Structural
 Forensics

SOUTHERN COLORADO
 19375 BEACON LITE RD., MONUMENT, CO 80132
 719.585.5145 WWW.ROCKYMOUNTAINENGINEERS.COM
 Structural Engineering, Surveying, Planning, Architecture

NOT FOR CONSTRUCTION
 FOR CIVIL ONLY

LOUDERMILK MINOR SUBDIVISION
 17115 GOSHAWK ROAD
 COLORADO SPRINGS, CO

ARVIN AND CHERYL LOUDERMILK

SHEET NAME
EXISTING OFFSITE SUBBASINS

PROJECT STATUS
APPLICATION SUBMITTAL

ENG:	ROL	
DRAWN:	ROL	
CHECKED:	ROL	
DATE	04/05/19	
#	REVISION	DATE
	SUBD APP	01/14/19
	SUBD APP 2	01/17/19
	CNTY REV. 1	04/05/19
JOB NO.	167392	
SHEET NO.	EXHIBIT 03	
	of 05	

OS-2

2.02

5 YR:	0.35
10 YR:	0.46
100 YR:	2.19

OS-1

11.25

5 YR:	0.14
10 YR:	0.20
100 YR:	6.06

OS-5

6.42

5 YR:	0.08
10 YR:	0.12
100 YR:	3.60

OS-4

0.06

5 YR:	0.00
10 YR:	0.00
100 YR:	0.05

EX-1

5.87

5 YR:	0.35
10 YR:	0.48
100 YR:	4.02

EX-5


1.83


5 YR:	0.02
10 YR:	0.03
100 YR:	0.97

EX-4

3.47


5 YR:	0.04
10 YR:	0.06
100 YR:	1.76

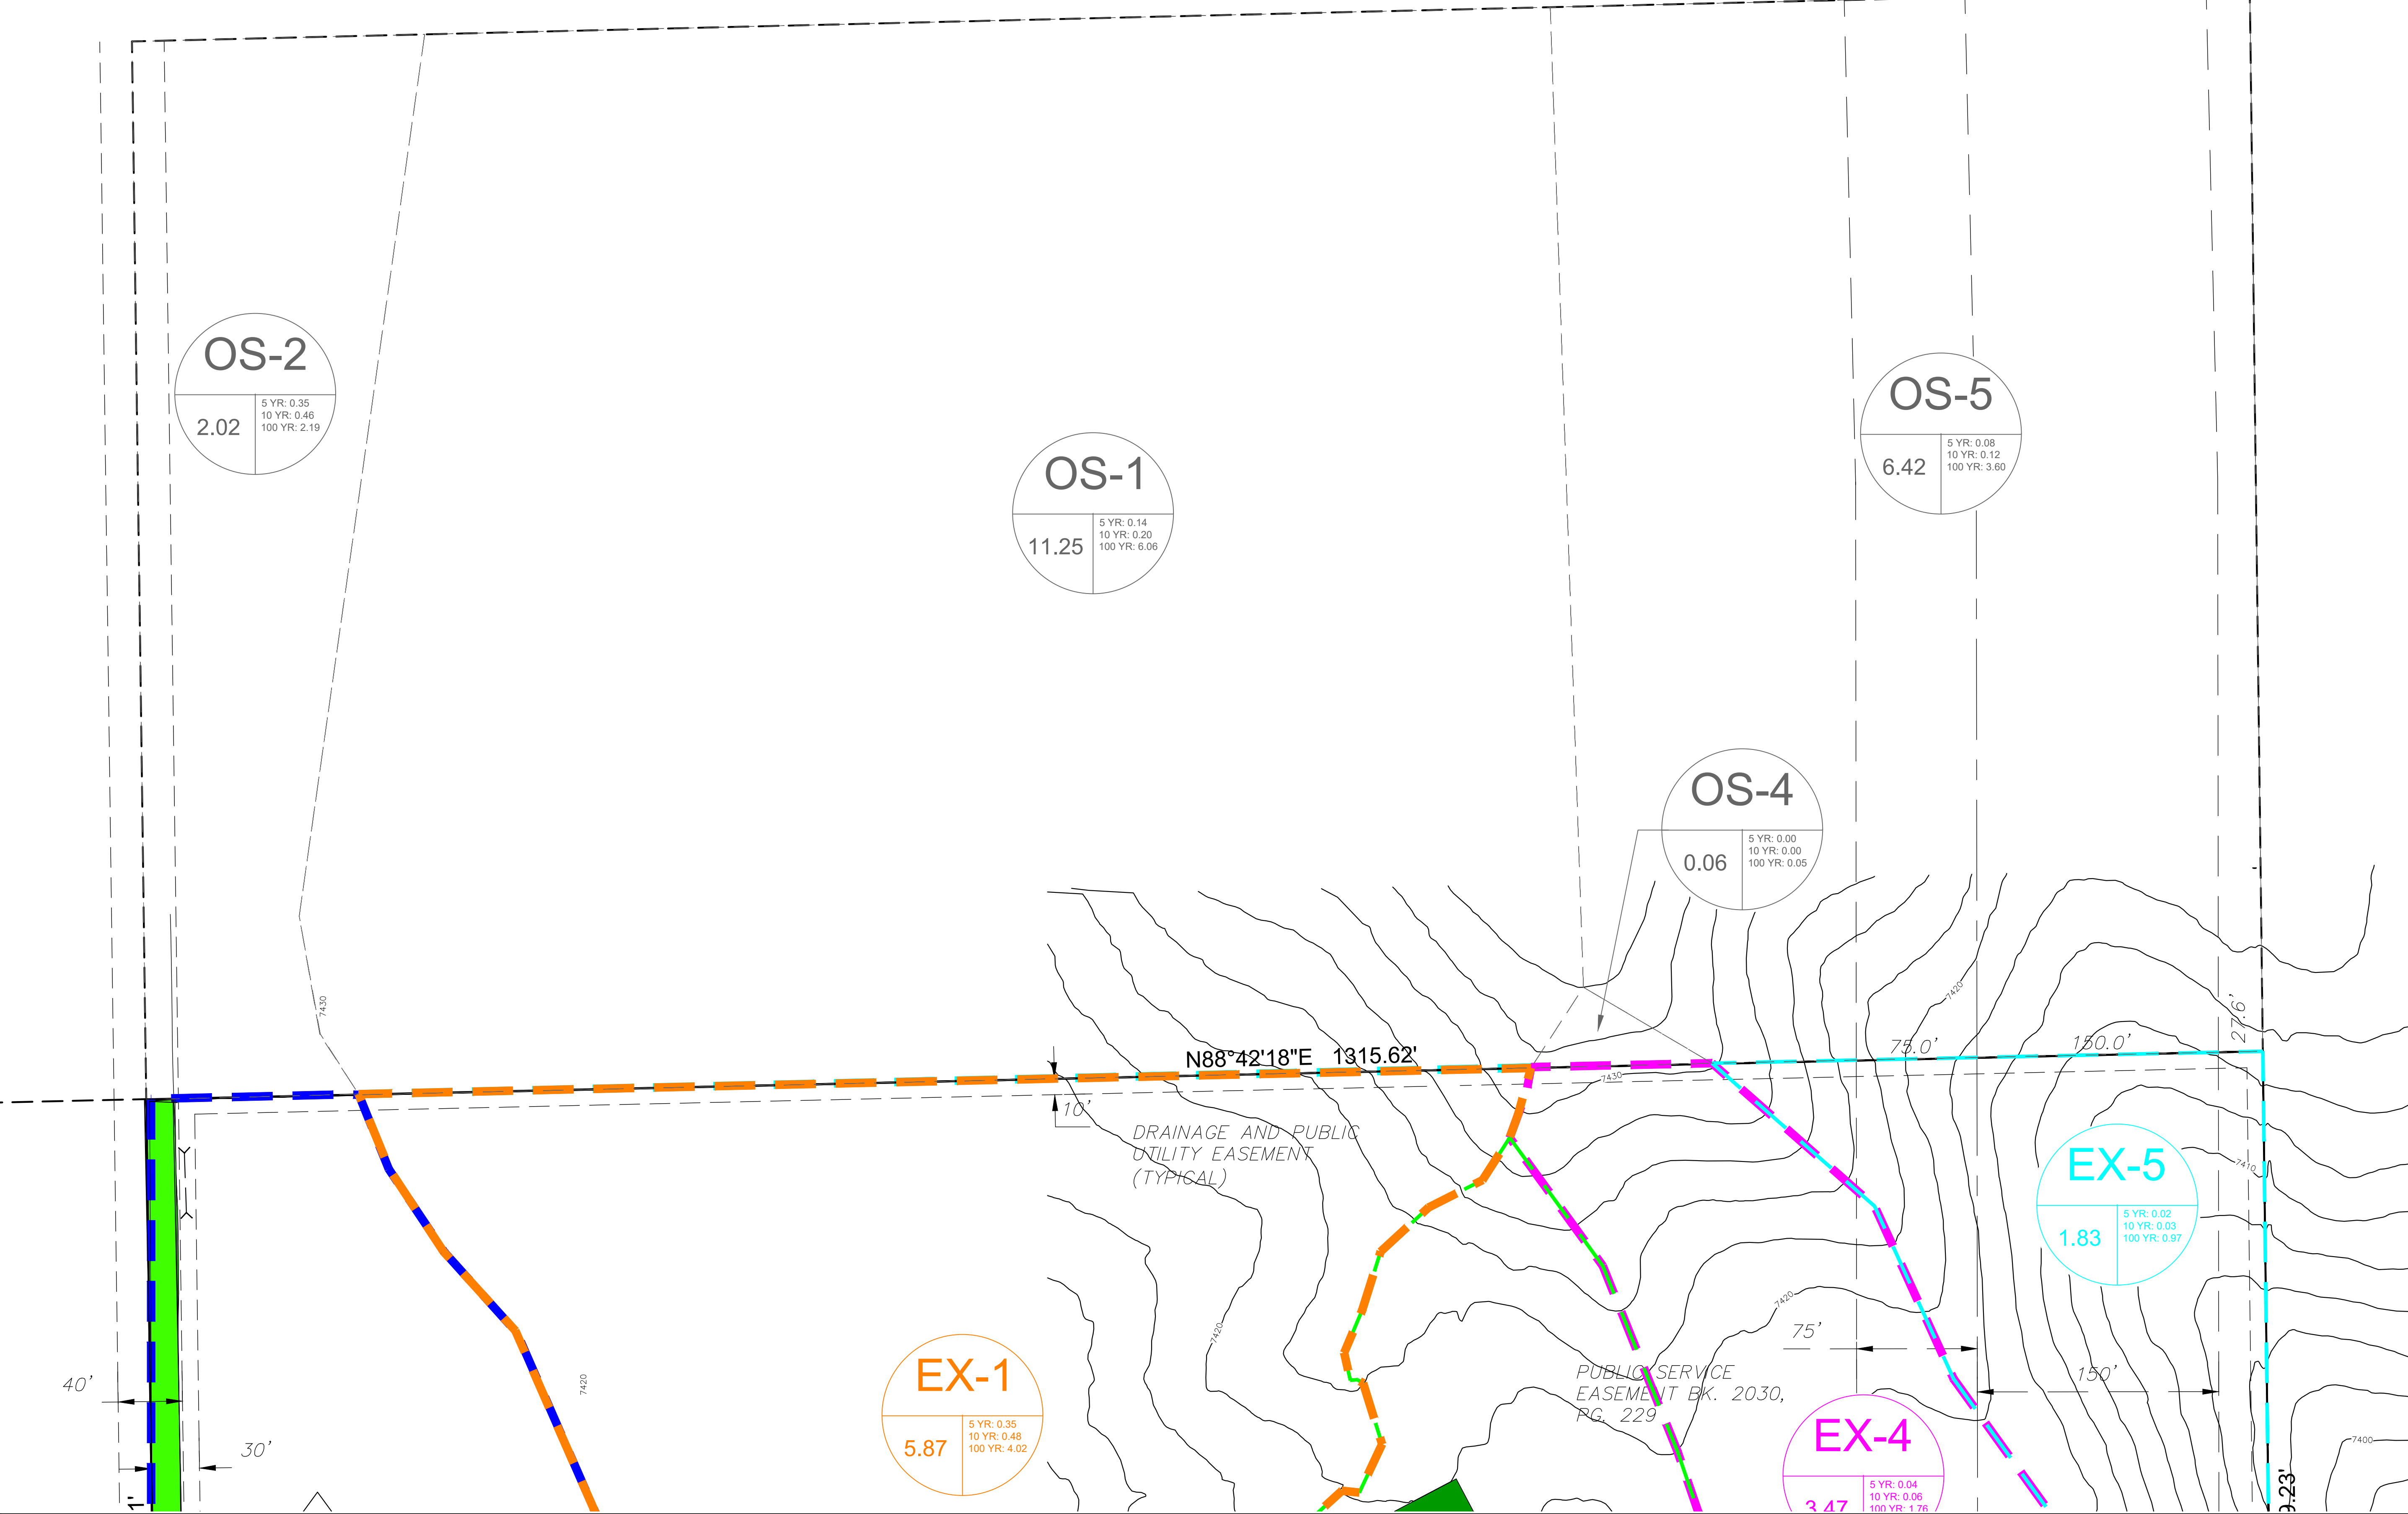

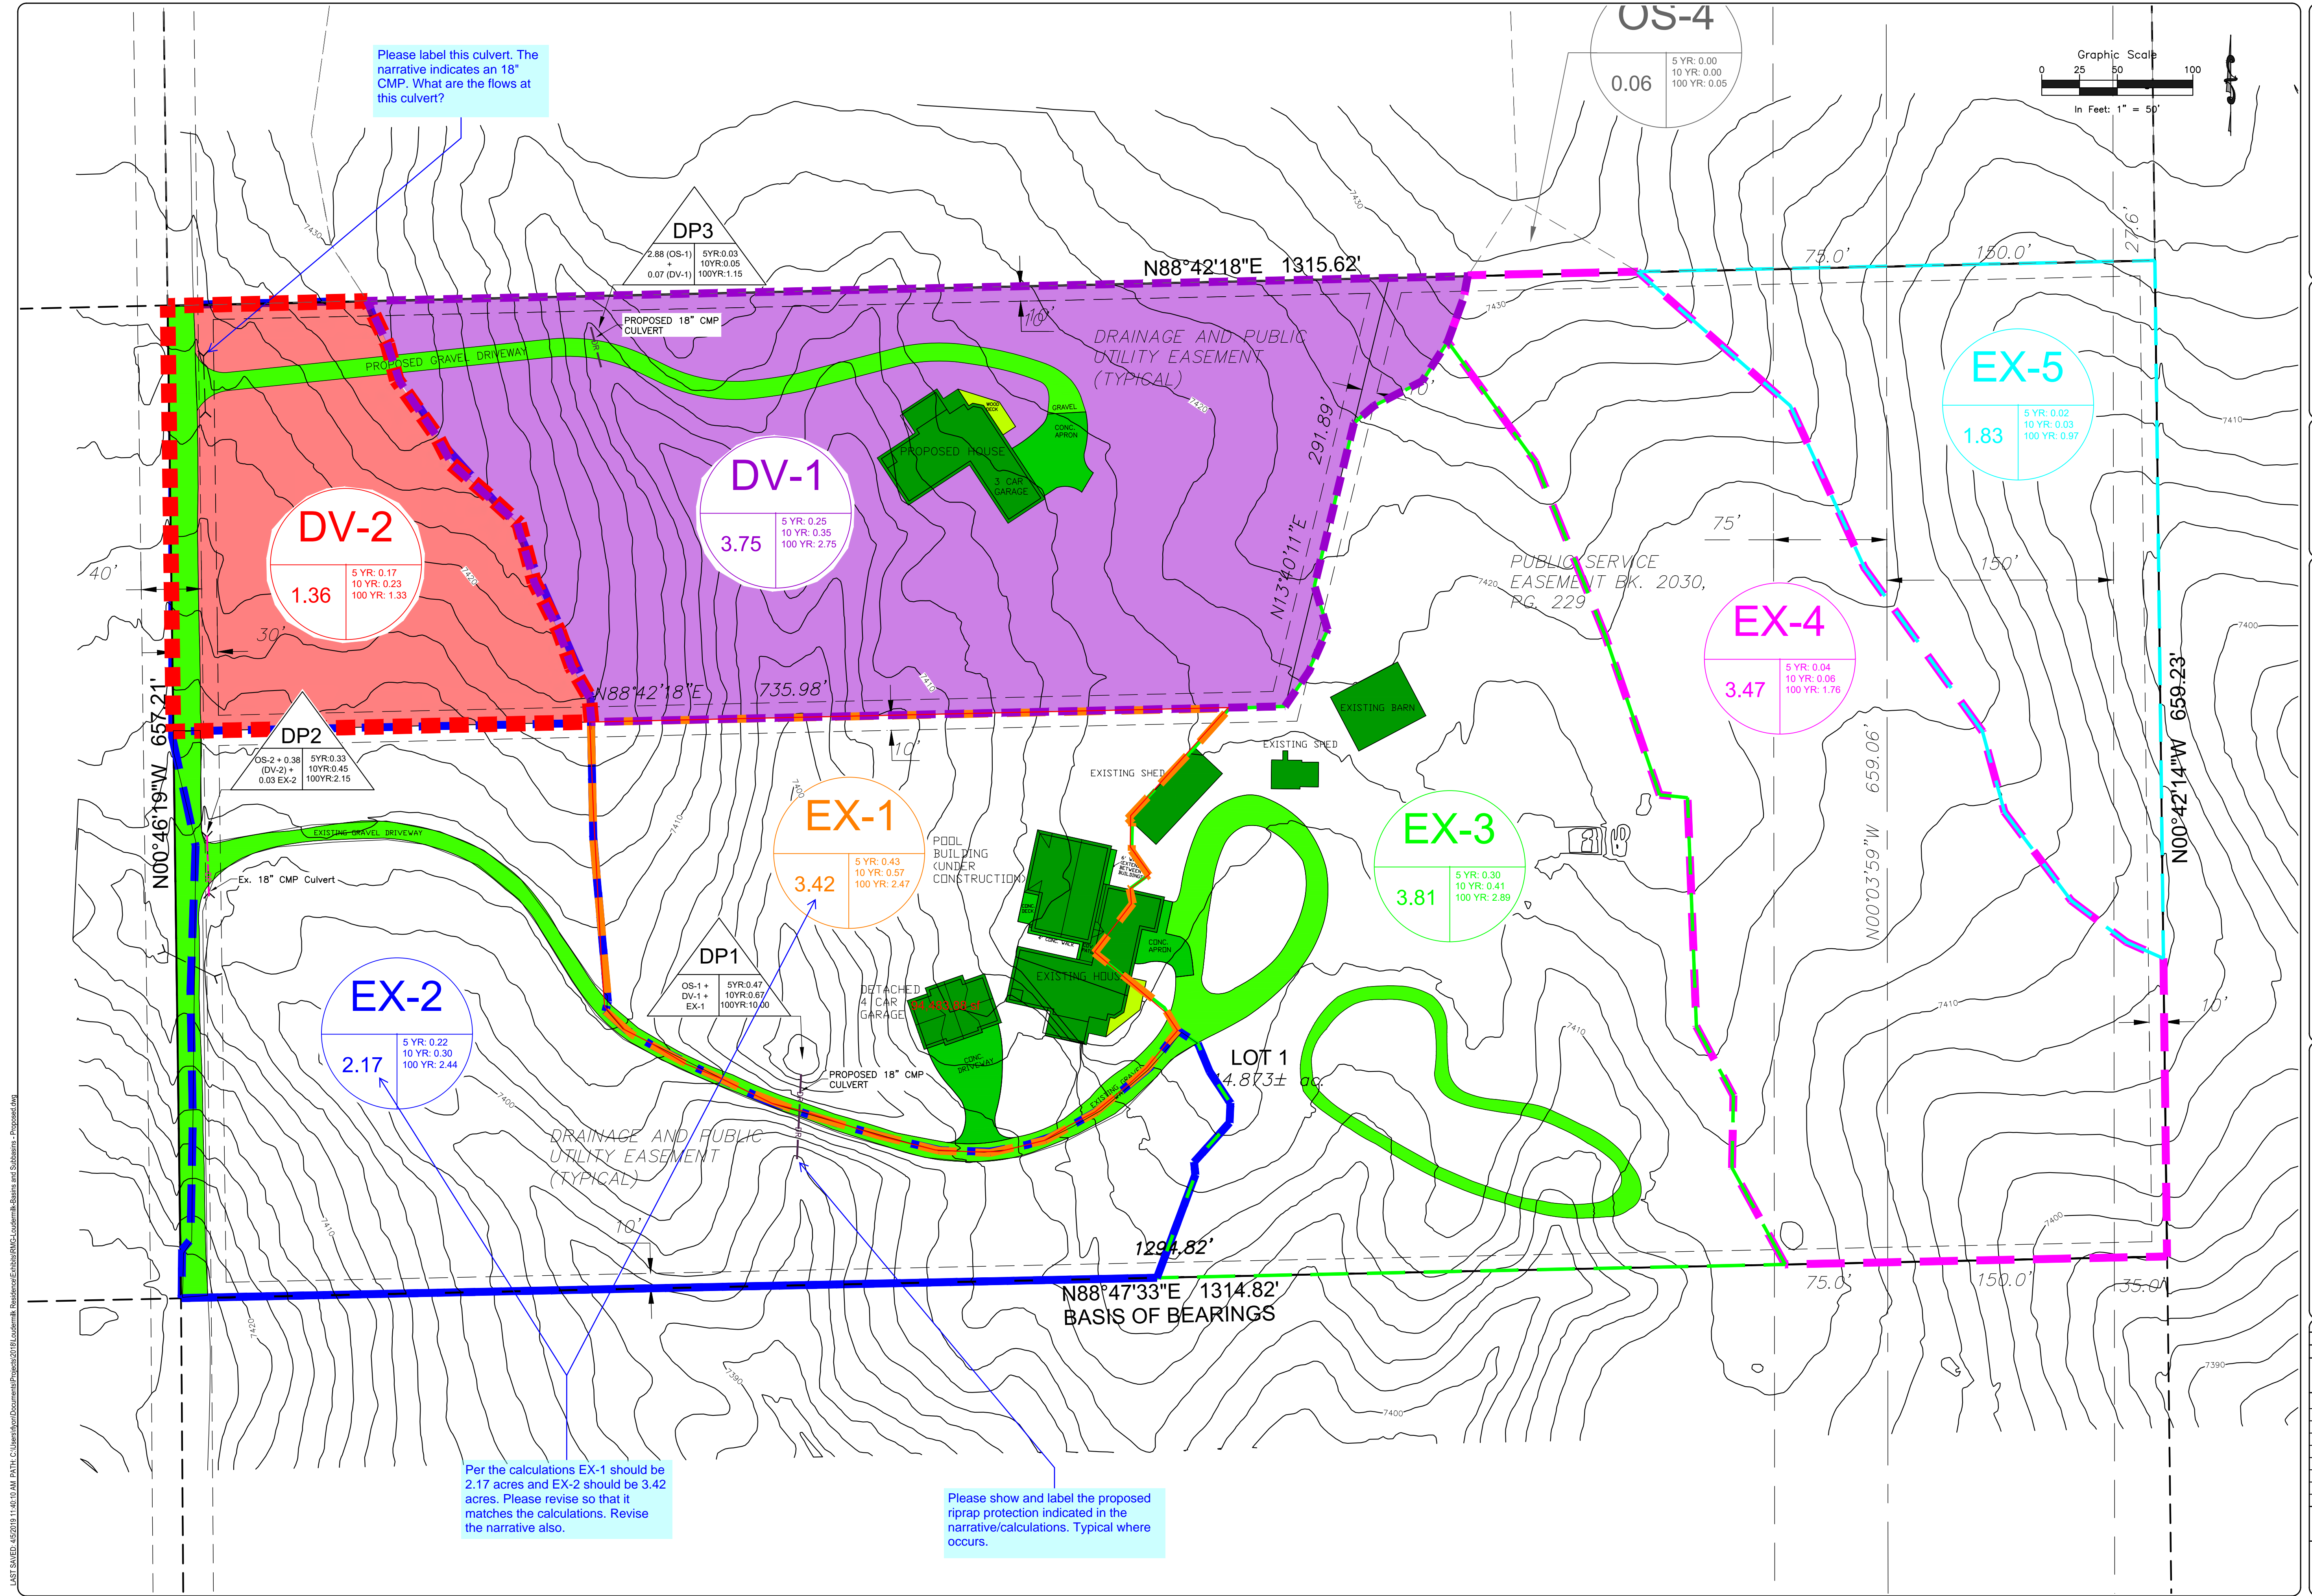


OS-4

0.06
5 YR: 0.00
10 YR: 0.00
100 YR: 0.05

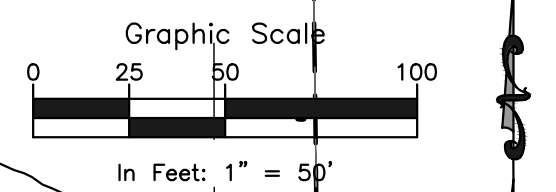

These plans are copyright 2018 by Geotechnical Engineers, Inc. dba RMG - Rocky Mountain Group all rights reserved. Any sale, reproduction, creation of derivative works based on these plans, or use of these plans for any purpose without proper compensation to and the express written consent of RMG, is strictly prohibited.

ENG:	RD	
DRAWN:	RD	
CHECKED:	RD	
DATE:	04/05/19	
#	REVISION	DATE
1	SUBD APP	01/14/19
2	SUBD APP 2	01/17/19
3	CNTY REV. 1	04/05/19
4		
5		
6		
JOB NO.:	167392	
SHEET NO.:	EXHIBIT 04	

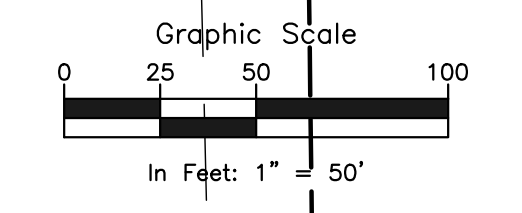

ROCKY MOUNTAIN GROUP
 ARCHITECTS
 ENGINEERS

Geotechnical
 Materials Testing
 Civil Planning

Architectural
 Structural
 Forensics

SOUTHERN COLORADO
 19375 BEACON LITE RD., MONUMENT, CO 80132
 719.585.5145 WWW.ROCKYMOUNTAINENGINEERS.COM
 Structural Engineering, Driveway Design, Right-of-Way

NOT FOR CONSTRUCTION
 FOR CIVIL ONLY

LOUDERMILK MINOR SUBDIVISION
 17115 GOSHAWK ROAD
 COLORADO SPRINGS, CO

ARVIN AND CHERYL LOUDERMILK


PROPOSED OFFSITE SUBBASINS

SHEET NAME

PROJECT STATUS
APPLICATION SUBMITTAL

ENG:	RDJ	
DRAWN:	RDJ	
CHECKED:	RDJ	
DATE	04/05/19	
#	REVISION	DATE
	SUBD APP	01/14/19
	SUBD APP 2	01/17/19
	CNTY REV. 1	04/05/19
JOB NO.	167392	
SHEET NO.	EXHIBIT 05	

of 05

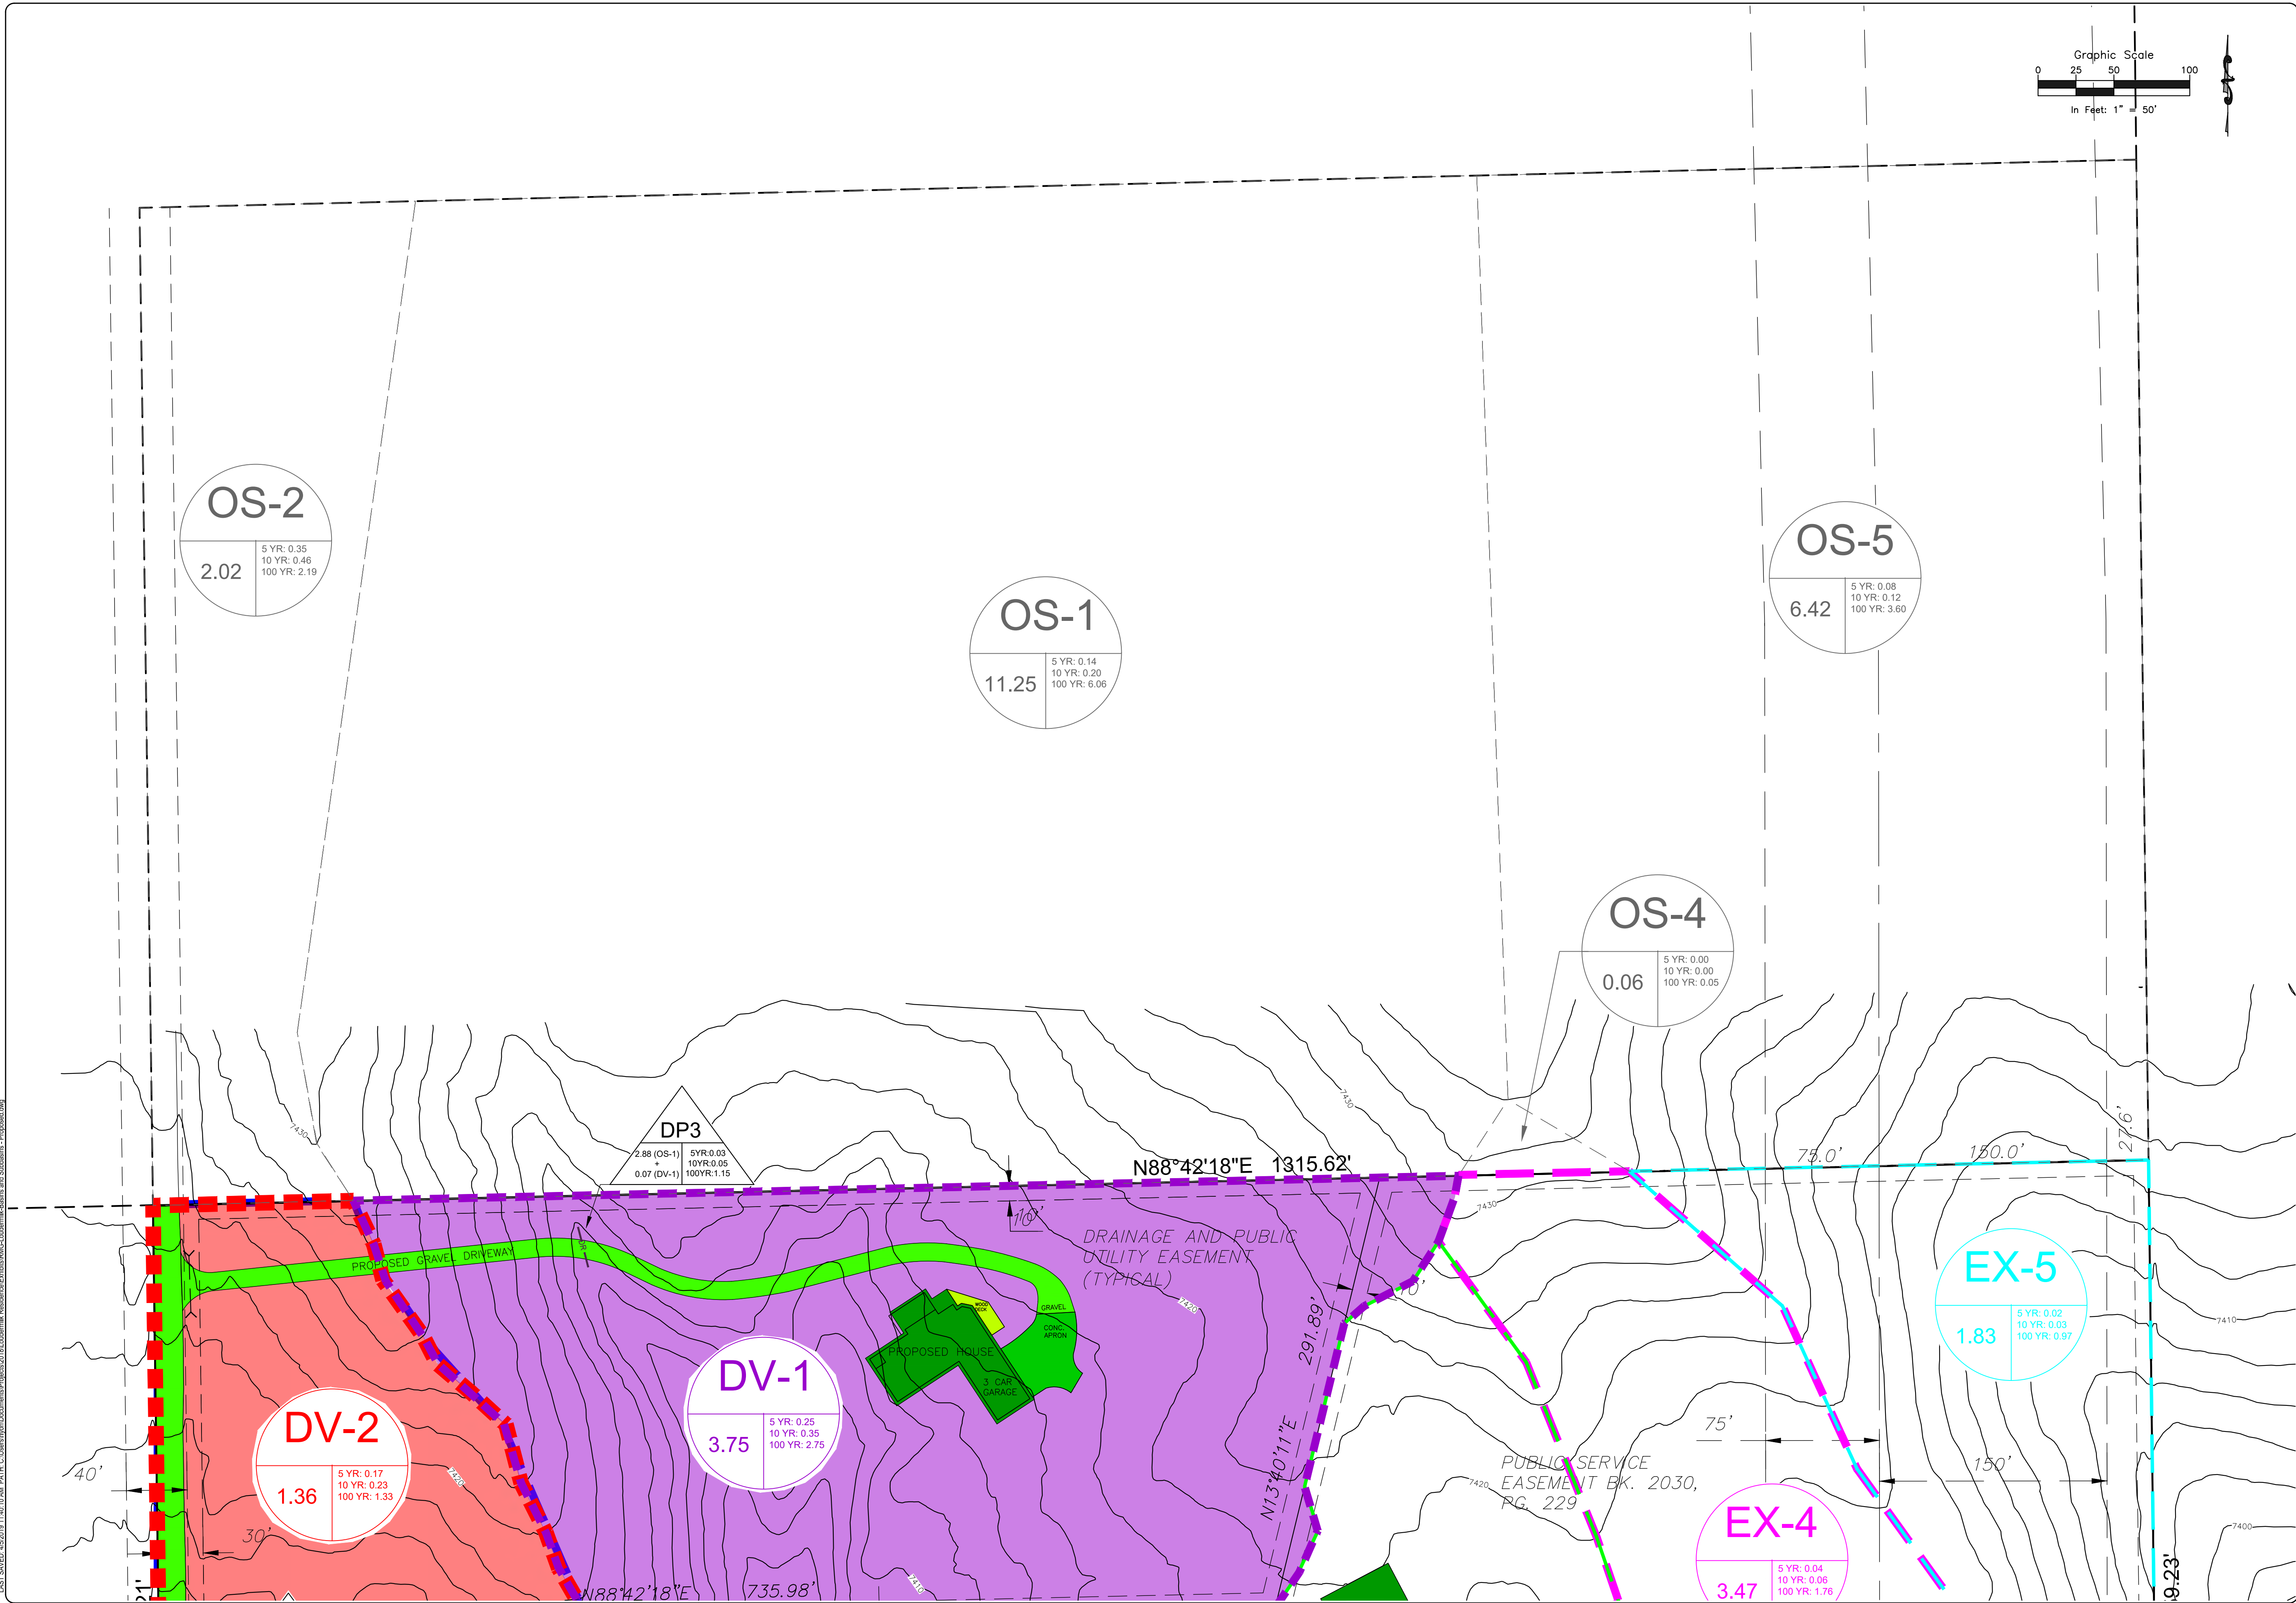

LAST SAVED: 4/5/2019 11:46:10 AM PATH: C:\Users\rdj\Documents\Projects\2018\Loudermilk\Roadwork\Drawings\Subbasins and Subbasins - Proposed.dwg

Markup Summary

Daniel Torres (19)


to a 3.42 acre
is remain the :

Subject: Highlight
Page Label: 8
Lock: Locked
Author: Daniel Torres
Date: 5/3/2019 9:10:49 AM
Color: ■

o a 2.17 aci
remains the

Subject: Highlight
Page Label: 8
Lock: Locked
Author: Daniel Torres
Date: 5/3/2019 9:10:50 AM
Color: ■

2.17

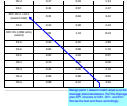


Subject: Callout
Page Label: 10
Lock: Locked
Author: Daniel Torres
Date: 5/3/2019 9:10:51 AM
Color: ■

Design point 1 doesn't match what is on the drainage plan/calculations. Per the drainage plan DP1 consists of OS1, DV1, and EX1. Revise the text and flows accordingly.



Subject: Callout
Page Label: 8
Lock: Locked
Author: Daniel Torres
Date: 5/3/2019 9:10:51 AM
Color: ■

Please see comments on drainage plan.

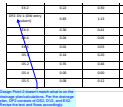

Subject: Callout
Page Label: 10
Lock: Locked
Author: Daniel Torres
Date: 5/3/2019 9:10:52 AM
Color: ■

Design Point 2 doesn't match what is on the drainage plan/calculations. Per the drainage plan, DP2 consists of OS2, DV2, and EX2. Revise the text and flows accordingly.

EX-1
DP1: DV-2 + EX-1 (culvert inlet)
EX-2

Subject: Highlight
Page Label: 10
Lock: Locked
Author: Daniel Torres
Date: 5/3/2019 9:10:54 AM
Color: ■

DP1: DV-2 + EX-1
(culvert inlet)

0.33

Subject: Highlight
Page Label: 10
Lock: Locked
Author: Daniel Torres
Date: 5/3/2019 9:10:59 AM
Color: ■

0.33

0.63

Subject: Highlight
Page Label: 10
Lock: Locked
Author: Daniel Torres
Date: 5/3/2019 9:11:00 AM
Color: ■

0.63

3.42

Subject: Highlight
Page Label: 10
Lock: Locked
Author: Daniel Torres
Date: 5/3/2019 9:11:00 AM
Color: ■

3.42

EX-2
DP2: DV-1 (DW entry culvert)
EX-3

Subject: Highlight
Page Label: 10
Lock: Locked
Author: Daniel Torres
Date: 5/3/2019 9:11:01 AM
Color: ■

DP2: DV-1 (DW entry culvert)

1.13

Subject: Highlight
Page Label: 10
Lock: Locked
Author: Daniel Torres
Date: 5/3/2019 9:11:02 AM
Color: ■

1.13

0.83

Subject: Highlight
Page Label: 10
Lock: Locked
Author: Daniel Torres
Date: 5/3/2019 9:11:02 AM
Color: ■

0.83

8.23

Subject: Highlight
Page Label: 10
Lock: Locked
Author: Daniel Torres
Date: 5/3/2019 9:11:04 AM
Color: ■

8.23

n sheet flow to the West Kiowa
r a 10-year storm event, and
ounts for 1.02 cfs for a 5-year
sr a 100-year storm event.

Please include DP3 in the post-developed flows table.

100-Year
2.75

Subject: Text Box
Page Label: 10
Lock: Locked
Author: Daniel Torres
Date: 5/3/2019 9:11:05 AM
Color: ■

Please include DP3 in the post-developed flows table.


if culvert pipe that crosses the existing
nd projects for the post-development.

Please show and label on the drainage plan

nd and within the drainage area as a whole
of roadbed to the West Kiowa creek. The
with historical drainage patterns to
ig channelized storm water flow via level
ignoring subsidence and/or expansion
ize and sediment control engineering
of these studies and the 10, 50, 100 and
of the proposed development. Culvert, level
of the drawings.


Subject: Callout
Page Label: 11
Lock: Locked
Author: Daniel Torres
Date: 5/3/2019 9:11:06 AM
Color: ■

Please show and label on the drainage plan

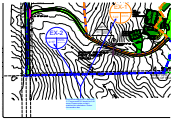


Subject: Callout
Page Label: 62
Lock: Locked
Author: Daniel Torres
Date: 5/3/2019 9:11:08 AM
Color: ■

Per the calculations EX-1 should be 2.17 acres and EX-2 should be 3.42 acres. Please revise so that it matches the calculations. Revise the narrative also.

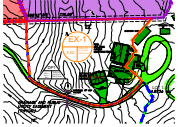


Subject: Area Measurement
Page Label: 62
Lock: Locked
Author: Daniel Torres
Date: 5/3/2019 9:11:10 AM
Color: ■

94,483.88 sf

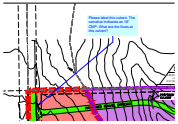

Subject: Callout
Page Label: 62
Lock: Locked
Author: Daniel Torres
Date: 5/3/2019 9:11:11 AM
Color: ■

Please label this culvert. The narrative indicates an 18" CMP. What are the flows at this culvert?

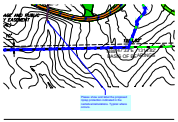

Subject: Callout
Page Label: 62
Lock: Locked
Author: Daniel Torres
Date: 5/3/2019 9:11:13 AM
Color: ■

Please show and label the proposed riprap protection indicated in the narrative/calculations. Typical where occurs.