MISFIT CREW ESTATES

A TRACT OF LAND LOCATED IN THE EAST HALF OF THE SOUTHEAST QUARTER QUARTER OF SECTION 24, TOWNSHIP 11 SOUTH, RANGE 66 WEST of the 6th PRINCIPAL MERIDIAN, EL PASO COUNTY, COLORADO

This report was not

COUNTY GOVERNMENT NOTES

- NOTE REGARDING REPORTS ON FILE: THE FOLLOWING REPORTS HAVE BEEN SUBMITTED IN ASSOCIATION WITH THE FINAL PLAT FOR THIS SUBDIVISION AND ARE ON FILE AT THE COUNTY PLANNING AND COMMUNITY DEVELOPMENT DEPARTMENT: FINAL DRAINAGE REPORT; WATER RESOURCES REPORT; OWTS WASTEWATER STUDY; GEOLOGY &
- SPECIFICALLY NOTED ON THE PLAT SHALL BE MAINTAINED BY THE INDIVIDUAL LOT OWNERS UNLESS OTHERWISE INDICATED. HOMEBUILDERS ARE RESPONSIBLE TO ENSURE PROPER DRAINAGE AROUND STRUCTURES, INCLUDING ELEVATIONS OF FOUNDATIONS AND WINDOW WELLS IN RELATION TO SIDE-LOT DRAINAGE EASEMENTS AND SWALES. HOMEOWNERS SHALL NOT CHANGE THE GRADE OF THE LOT OR DRAINAGE SWALES WITHIN SAID EASEMENTS, AS CONSTRUCTED BY THE BUILDER, IN A MANNER THAT WOULD CAUSE ADVERSE DRAINAGE IMPACTS TO PROPERTIES, STRUCTURES, FENCES, MATERIALS OR LANDSCAPING THAT COULD IMPEDE THE FLOW OF RUNOFF SHALL NOT BE PLACED IN DRAINAGE EASEMENTS.
- 3. DEVELOPER SHALL COMPLY WITH FEDERAL AND STATE LAWS, REGULATIONS, ORDINANCES, REVIEW AND PERMIT REQUIREMENTS, AND OTHER AGENCY REQUIREMENTS, IF ANY, OF APPLICABLE AGENCIES INCLUDING, BUT NOT LIMITED TO, THE COLORADO DIVISION OF WILDLIFE, COLORADO DEPARTMENT OF TRANSPORTATION, U.S. ARMY CORPS OF ENGINEERS AND THE U.S. FISH AND WILDLIFE SERVICE REGARDING THE ENDANGERED SPECIES ACT, PARTICULARLY AS IT RELATES TO THE LISTED SPECIES (E.G., PREBLE'S MEADOW JUMPING MOUSE).
- THE ADDRESSES EXHIBITED ON THIS PLAT ARE FOR INFORMATIONAL PURPOSES ONLY. THEY ARE NOT THE LEGAL DESCRIPTION AND ARE SUBJECT TO CHANGE.
- NO DRIVEWAY SHALL BE ESTABLISHED UNLESS AN ACCESS PERMIT HAS BEEN GRANTED BY EL PASO COUNTY.
- MAILBOXES SHALL BE INSTALLED IN ACCORDANCE WITH ALL EL PASO COUNTY AND UNITED STATES POSTAL SERVICE REGULATIONS
- ALL PROPERTY WITHIN THIS SUBDIVISION IS SUBJECT TO A DECLARATION OF COVENANTS AS RECORDED AT RECEPTION NO. . OF THE RECORDS OF THE EL PASO COUNTY CLERK AND RECORDER.
- INDIVIDUAL WELLS ARE THE RESPONSIBILITY OF EACH PROPERTY OWNER. PERMITS FOR INDIVIDUAL WELLS MUST BE OBTAINED FROM THE STATE ENGINEER WHO BY LAW HAS THE AUTHORITY TO SET CONDITIONS FOR THE ISSUANCE OF THESE PERMITS. WATER IN THE DENVER BASIN AQUIFERS IS ALLOCATED BASED ON A 100-YEAR AQUIFER LIFE HOWEVER, FOR EL PASO COUNTY PLANNING PURPOSES, WATER IN THE DENVER BASIN AQUIFERS IS EVALUATED BASED ON A 300-YEAR AQUIFER LIFE. APPLICANTS AND ALL FUTURE OWNERS OF THE SUBDIVISION SHOULD BE AWARE THAT THE ECONOMIC LIFE OF A WATER SUPPLY BASED ON WELLS IN A GIVEN DENVER BASIN AQUIFER MAY BE LESS THAN EITHER THE 100 YEARS OR 300 YEARS INDICATED DUE TO ANTICIPATED WATER LEVEL DECLINES. FURTHERMORE, THE WATER SUPPLY PLAN SHOULD NOT RELY SOLELY ON NON-RENEWABLE AQUIFERS. ALTERNATE RENEWABLE WATER RESOURCES SHOULD BE ACQUIRED AND INCORPORATED IN A PERMANENT WATER SUPPLY PLAN THAT PROVIDES FUTURE GENERATIONS WITH A WATER SUPPLY
- SEWAGE TREATMENT IS THE RESPONSIBILITY OF EACH INDIVIDUAL PROPERTY OWNER. THE EL PASO COUNTY DEPARTMENT OF HEALTH AND ENVIRONMENT MUST APPROVE EACH SYSTEM AND, IN SOME CASES THE DEPARTMENT MAY REQUIRE AN ENGINEER DESIGNED SYSTEM PRIOR TO PERMIT APPROVAL. THESE SYSTEMS MAY COST MORE TO DESIGN, INSTALL, AND MAINTAIN.
- 10. THE SUBDIVIDER(S) AGREES ON BEHALF OF HIM/HERSELF AND ANY DEVELOPER OR BUILDER SUCCESSORS AND ASSIGNEES THAT SUBDIVIDER AND/OR SAID SUCCESSORS AND ASSIGNS SHALL BE REQUIRED TO PAY TRAFFIC IMPACT FEES IN ACCORDANCE WITH EL PASO COUNTY ROAD IMPACT FEE PROGRAM RESOLUTION (RESOLUTION NO. 19-471), OR ANY AMENDMENTS THERETO, AT OR PRIOR TO THE TIME OF BUILDING PERMIT SUBMITTALS. THE FEE OBLIGATION, IF NOT PAID AT FINAL PLAT RECORDING, SHALL BE DOCUMENTED ON ALL SALES DOCUMENTS AND ON PLAT NOTES TO ENSURE THAT A TITLE SEARCH WOULD FIND THE FEE OBLIGATION BEFORE SALE OF THE PROPERTY.
- 11. ACCESS TO LOTS 2 AND 3 FROM MOUNTAIN SHADOW VIEW SHALL BE LOCATED WITHIN THE COMMON ACCESS EASEMENT SHOWN HEREON. THE RESPONSIBILITY FOR CONSTRUCTION AND MAINTENANCE OF SAID ACCESS IS DESCRIBED IN THE "DECLARATION OF WATER COVENANTS AND EASEMENTS FOR MIISFIT CREW ESTATES" AS , OF THE RECORDS OF EL PASO COUNTY, COLORADO
- 12. NOTICE: FUTURE PROPERTY OWNERS ARE ADVISED THAT EL PASO COUNTY'S APPROVAL OF THIS PLAT DOES NOT INCLUDE CERTIFICATION OF WATER RIGHTS OR THE STRUCTURAL STABILITY OF THE EXISTING STOCK POND LOCATED ON THE SUBJECT PROPERTY. THE STATE OF COLORADO HAS JURISDICTION REGARDING MODIFICATION OR ELIMINATION OF THE POND. EL PASO COUNTY SHALL NOT BE RESPONSIBLE OR LIABLE FOR SUCH MODIFICATIONS, REPAIRS, ENLARGEMENTS, OR REPLACEMENT AND THE COST THEREOF BY VIRTUE OF THIS SUBDIVISION APPROVAL.
- 13. THIS SUBDIVISION IS SURROUNDED BY AGRICULTURAL LAND. PROPERTY OWNERS MAY BE IMPACTED BY SOUNDS, SMELLS AND/OR ACTIVITIES ASSOCIATED WITH ACTIVE AGRICULTURAL PRACTICES. PURSUANT TO ARTICLE 3.5, TITLE 35, C.R.S., IT IS THE DECLARED POLICY OF THE STATE OF COLORADO TO CONSERVE, PROTECT, AND ENCOURAGE THE DEVELOPMENT AND IMPROVEMENT OF ITS AGRICULTURAL LAND FOR THE PRODUCTION OF FOOD AND OTHER AGRICULTURAL PRODUCTS. COLORADO IS A "RIGHT-TO-FARM" STATE PURSUANT TO C.R.S. 35-3.5-101, ET SEQ. LANDOWNERS, RESIDENTS AND VISITORS MUST BE PREPARED TO ACCEPT THE ACTIVITIES, SIGHTS, SOUNDS, AND SMELLS OF AGRICULTURAL OPERATIONS AS A NORMAL AND NECESSARY IMPACT OF LIVING IN A COUNTY WITH A STRONG RURAL CHARACTER AND A HEALTHY AGRICULTURAL SECTOR. STATE LAW PROVIDES THAT RANCHING, FARMING, OR OTHER AGRICULTURAL ACTIVITIES AND OPERATIONS SHALL NOT BE CONSIDERED TO BE NUISANCES SO LONG AS OPERATED IN CONFORMANCE WITH THE LAW AND IN A NON-NEGLIGENT MANNER. THEREFORE, ALL MUST BE PREPARED TO ENCOUNTER NOISES, ODORS, LIGHTS, MUD, DUST, SMOKE, CHEMICALS, MACHINERY ON PUBLIC ROADS, LIVESTOCK ON PUBLIC ROADS, STORAGE AND DISPOSAL OF MANURE, AND THE APPLICATION BY SPRAYING OR OTHERWISE OF CHEMICAL FERTILIZERS, SOIL AMENDMENTS, HERBICIDES, AND PESTICIDES, AND ONE OR MORE OF WHICH MAY NATURALLY OCCUR AS A PART OF LEGAL AND NON-NEGLIGENT AGRICULTURAL OPERATIONS. (USED WHEN SUBDIVISION IS ADJACENT TO AN EXISTING AGRICULTURAL OPERATION SUCH AS FEEDLOT, FARMED FIELD, OR WHEN DETERMINED NECESSARY BY THE PROJECT MANAGER).
- 14. SOIL AND GEOLOGIC CONDITIONS: AREAS WITHIN THIS SUBDIVISION HAVE BEEN FOUND TO BE IMPACTED BY POTENTIAL GEOLOGIC CONSTRAINTS AS DETAILED IN THE SOIL, GEOLOGY, AND GEOLOGIC HAZARD STUDY PREPARED BY ENTECH ENGINEERING, INC. AND DATED AUGUST 20, 2024. THE REPORT IS AVAILABLE IN THE EL PASO COUNTY PLANNING AND COMMUNITY DEVELOPMENT DEPARTMENT RECORDS (WWW.EPCDEVPLANREVIEW.COM) UNDER FILE NUMBER \$F2417. THE REPORT INCLUDES MAPPING OF THE POTENTIAL HAZARD AREAS WITHIN THE SUBDIVISION. A DESCRIPTION OF THE AFFECTED LOTS, POTENTIAL CONSTRAINTS AND MITIGATION MEASURES ARE LISTED BELOW. NO AREAS OF THE SITE EXCEED 30% IN GRADE. INDIVIDUAL SOILS INVESTIGATIONS AND FOUNDATION DESIGNS FOR ALL NEW BUILDING SITES AND SEPTIC SYSTEMS ARE REQUIRED ONCE BUILDING LOCATIONS HAVE BEEN DETERMINED. SHOULD GROUNDWATER OR BEDROCK BE ENCOUNTERED WITHIN 6 FEET OF THE SURFACE, DESIGNED ONSITE WASTEWATER SYSTEMS WILL BE REQUIRED. DESIGNED ONSITE WASTEWATER SYSTEMS ARE ANTICIPATED ON THE LOT DUE TO SEASONAL SHALLOW GROUNDWATER, HIGH ROCK PERCENTAGE, AND RESTRICTIVE CLAY SOILS. WASTEWATER ABSORPTION FIELDS MUST BE LOCATED AT LEAST 100 FEET FROM ANY WELL, 50 FEET FROM DRAINAGES, FLOODPLAINES OR PONDED AREAS AND 25 FEET FROM DRY GULCHES. NO ELEMENTS OF WASTEWATER TREATMENT SYSTEMS SHOULD BE PLACED IN AREAS OF POTENTIALLY SEASONAL SHALLOW GROUNDWATER OR SEASONAL SHALLOW WATER.


ARTIFICIAL FILL: LOT 1. MITIGATION MEASURES INCLUDE: OVEREXCAVATION, REPLACEMENT AND COMPACTION OF SOILS BENEATH FOUNDATIONS. EXPANSIVE SOILS: ALL LOTS MITIGATION MEASURES INCLUDE: SPECIAL FOUNDATION DESIGN, OVEREXCAVATION, REPLACEMENT AND COMPACTION OF SOILS

POTENTIALLY SEASONALLY HIGH GROUNDWATER: LOT 1 & 2. MITIGATION MEASURES INCLUDE: EXTENSION OF FOUNDATIONS A MINIMUM OF 30 INCHES BELOW GRADE, INSTALLATION OF FOUNDATION PERIMETER DRAINS AND GRADING TO DIRECT SURFACE FLOWS AWAY FROM STRUCTURES. ALL ORGANIC MATERIAL WOULD BE COMPLETELY REMOVED PRIOR TO ANY FILL PLACEMENT.

SEASONAL SHALLOW WATER: ALL LOTS (DRAINAGE EASEMENT PROVIDED). MITIGATION MEASURES INCLUDE: MITIGATION MEASURES INCLUDE: EXTENSION OF FOUNDATIONS A MINIMUM OF 30 INCHES BELOW GRADE, INSTALLATION OF FOUNDATION PERIMETER DRAINS AND GRADING TO DIRECT SURFACE FLOWS AWAY FROM STRUCTURES. ALL ORGANIC MATERIAL WOULD BE COMPLETELY REMOVED PRIOR TO ANY FILL PLACEMENT.

- 15. PER ECM SECTION I.7.1.B.5, RESIDENTIAL LOTS IMPERVIOUS AREA MAY NOT EXCEED 10 PERCENT UNLESS A STUDY IS PREPARED IN COMPLIANCE WITH THE REQUIREMENTS LAID OUT IN THE ABOVE REFERENCED ECM SECTION. IMPERVIOUS AREA MAY NOT EXCEED 20 PERCENT. THIS IMPERVIOUS AREA FOR EACH LOTMUST INCLUDE THE PROPOSED DRIVEWAY.
- 16. INDIVIDUAL LOT PURCHASERS ARE RESPONSIBLE FOR CONSTRUCTING DRIVEWAYS, INCLUDING NECESSARY DRAINAGE CULVERTS PER LAND DEVELOPMENT CODE 6.3.3.C2 AND 6.2.2.C.3. DUE TO THEIR LENGTH SOME OF THE DRIVEWAY MUST BE APPROVED BY THE FIRE DISTRICT.
- 17. OWNERS OF ALL LOTS SHALL SUBMIT AN ENGINEERED SITE PLAN AT TIME OF BUILDING PERMIT. ENGINEERED SITE PLAN SHALL DEPICT LOCATION OF PROPOSED HOUSE, INDIVIDUAL DRIVEWAY FROM PRIVATE DRIVEWAY TO HOUSE, AND ANY CULVERTS NECESSARY BASED ON HOUSE AND DRIVEWAY LOCATIONS.
- 18. LOT AND DENSITY DATA:

 - GROSS ACREAGE: 35.729 ACRES - TOTAL NUMBER OF LOTS IN THE SUBDIVISION: 3
 - GROSS DENSITY: 0.084 LOTS PER ACRE ACREAGE DEDICATED TO PUBLIC STREETS: 0.027 ACRES
 - NET ACREAGE: 35.702 ACRES
 - NET DENSITY: 0.084 LOTS PER ACRE

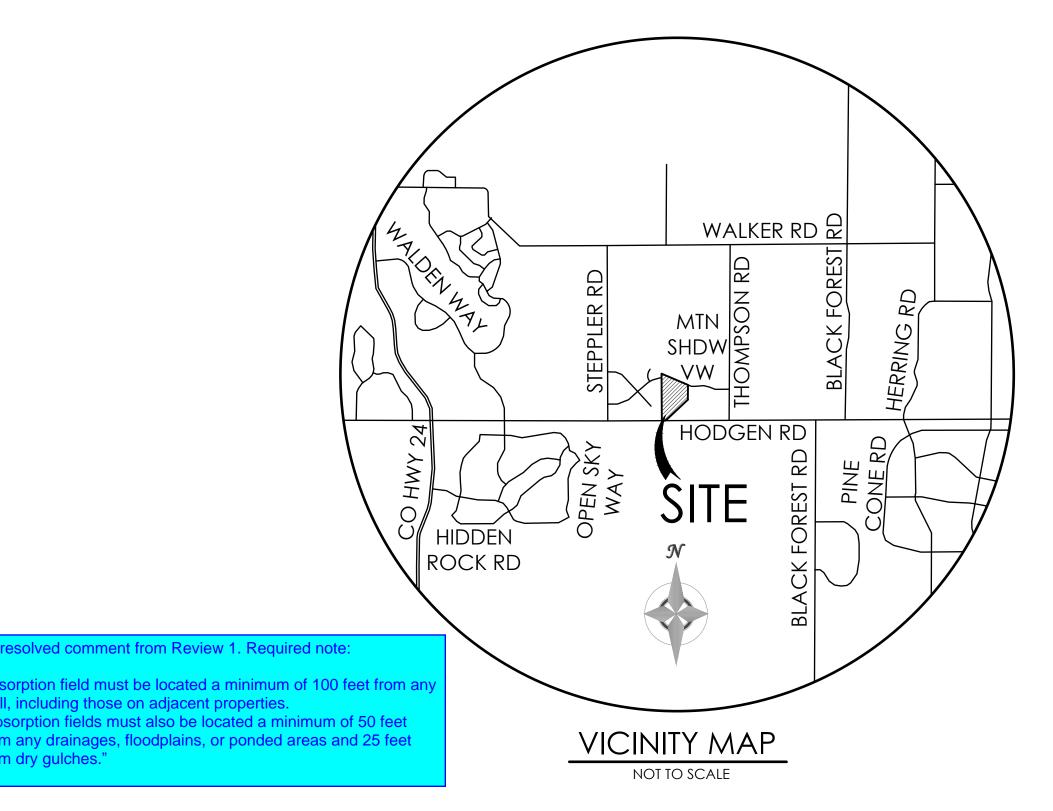

- BASIS OF BEARING: BEARINGS REFERRED TO HEREON ARE RELATIVE TO THE WEST LINE THE EAST HALF OF THE SOUTHEAST QUARTER OF SECTION 24, TOWNSHIP 11 SOUTH, RANGE 66 WEST BEARING N 00°20'57" W.
- 2. ALL CORNERS SET WITH NO. 5 REBAR WITH SURVEYOR'S ALUMINUM CAP PLS 27605 AND FLUSH WITH THE GROUND,
- 3. THIS SURVEY DOES NOT CONSTITUTE A TITLE SEARCH BY M.V.E., INC. TO DETERMINE OWNERSHIP OR EASEMENTS OF RECORD. FOR ALL INFORMATION REGARDING EASEMENTS, RIGHTS-OF-WAY AND TITLE OF RECORD, M.V.E., INC. RELIED , ORDER NO. _____ UPON TITLE INSURANCE POLICY PREPARED BY _ WITH EFFECTIVE DATE OF ______
- 4. FLOODPLAIN STATEMENT: ACCORDING TO FEMA FLOOD INSURANCE RATE MAP NO. 08041 C0305 G, DATED DECEMBER 7, 2018, THE PROPERTY IS LOCATED IN ZONE "X", (AREAS DETERMINED TO BE OUTSIDE THE 0.2% ANNUAL CHANCE FLOODPLAIN).
- 5. LINEAL UNITS SHOWN HEREON ARE US SURVEY FEET.
- 6. PROPERTY IS SUBJECT TO TERMS THEREFORE GRANTED IN DECREE IN THE DISTRICT COURT, WATER DIVISION 1, STATE OF COLORADO RECORDED_____, AT RECEPTION NO._____
- 7. NOTICE: ACCORDING TO COLORADO LAW YOU MUST COMMENCE ANY LEGAL ACTION BASED UPON ANY DEFECT IN THIS SURVEY WITHIN THREE YEARS AFTER YOU FIRST DISCOVER SUCH DEFECT. IN NO EVENT, MAY ANY ACTION BASED UPON ANY DEFECT IN THIS SURVEY BE COMMENCED MORE THAN TEN YEARS FROM THE DATE OF THE CERTIFICATION SHOWN HEREON. (SECTION 13-80-105 C.R.S.).
- 8. ANY PERSON WHO KNOWINGLY REMOVES, ALTERS OR DEFACES ANY PUBLIC LAND SURVEY MONUMENT OR LAND BOUNDARY MONUMENT OR ACCESSORY COMMITS A CLASS TWO (2) MISDEMEANOR PURSUANT TO C.R.S. § 18-4-508.
- 9. PORTIONS OF THIS PLAT CONTAIN VIEW EASMENTS. THE LIMITATIONS AND RESTRICTIONS IMPOSED ON SAID AREAS ARE DESCRIBED IN THE "DECLARATION OF WATER COVENANTS AND EASEMENTS FOR MIISFIT CREW ESTATES" AS RECORDED IN ____, OF THE RECORDS OF EL PASO COUNTY, COLORADO. VIEW EASEMENTS ARE PRIVATE EASEMENTS AND ARE NOT ENFORCED BY EL PASO COUNTY.
- 10. THERE SHALL BE NO DIRECT ACCESS TO HODGEN ROAD.

EASEMENTS

UNLESS OTHERWISE INDICATED, ALL SIDE, FRONT, AND REAR LOT LINES ARE HEREBY PLATTED ON EITHER SIDE WITH A 10 FOOT PUBLIC UTILITY AND DRAINAGE EASEMENT UNLESS OTHERWISE INDICATED. ALL EXTERIOR SUBDIVISION BOUNDARIES ARE HEREBY PLATTED WITH A 20 FOOT PUBLIC UTILITY AND DRAINAGE EASEMENT. THE SOLE RESPONSIBILITY FOR MAINTENANCE OF THESE EASEMENTS IS HEREBY VESTED WITH THE INDIVIDUAL PROPERTY OWNERS

BE IT KNOWN BY THESE PRESENTS:

THAT MARK E. MCDONALD AND AMANDA M. ENLOE ARE THE OWNERS OF THE FOLLOWING DESCRIBED TRACT OF LAND, TO WIT:

A TRACT OF LAND LOCATED IN THE EAST HALF OF THE SOUTHEAST QUARTER OF SECTION 24, TOWNSHIP 11 SOUTH, RANGE 66 WEST OF THE 6TH PRINCIPLE MERIDIAN MORE PARTICULARLY DESCRIBED AS FOLLOWS: COMMENCING AT THE SOUTHWEST CORNER OF SAID EAST HALF OF THE SOUTHEAST QUARTER OF SECTION 24; THENCE N 00°20'57" W ALONG THE WEST LINE OF SAID EAST HALF OF THE SOUTHEAST QUARTER (BASIS OF BEARING) A DISTANCE OF 50.00 FEET TO A POINT

ON THE NORTH RIGHT-OF-WAY LINE OF HODGEN ROAD AND THE TRUE POINT OF BEGINNING THENCE CONTINUING N 00°20'57" W ALONG THE WEST LINE OF SAID EAST HALF OF THE SOUTHEAST QUARTER A DISTANCE OF 2220.37

THENCE S 57°35'42" E A DISTANCE OF 1253.60 FEET;

THENCE S 00°20'57" E A DISTANCE OF 636.60 FEET;

THENCE \$ 45°48'39" W A DISTANCE OF 1305.41 FEET TO A POINT ON THE NORTH RIGHT-OF-WAY LINE OF HODGEN ROAD;

THENCE \$ 88°58'04" W A DISTANCE OF 112.72 FEET ALONG THE NORTH RIGHT-OF-WAY LINE OF HODGEN ROAD TO THE POINT OF <u>BEGINNING</u>.

SAID TRACT CONTAINS 1,556,343 SF (35.729 ACRES), MORE OR LESS.

SURVEYOR'S STATEMENT

I, randall D. Hency, a duly registered professional land surveyor in the state of colorado, do hereby certify that THIS PLAT OF "MIISFIT CREW ESTATES" TRULY AND CORRECTLY REPRESENTS THE RESULTS OF A SURVEY MADE ON 1/12/2024, BY ME OR UNDER MY DIRECT SUPERVISION AND THAT ALL MONUMENTS EXIST AS SHOWN HEREON; THAT MATHEMATICAL CLOSURE ERRORS ARE LESS THAN 1:10,000 ; AND THAT SAID PLAT HAS BEEN PREPARED IN FULL COMPLIANCE WITH ALL APPLICABLE LAWS OF THE STATE OF COLORADO DEALING WITH MONUMENTS, SUBDIVISION, OR SURVEYING OF LAND AND ALL APPLICABLE PROVISIONS OF THE EL PASO COUNTY LAND DEVELOPMENT CODE AND IS NOT A WARRANTY OR GUARANTEE EITHER EXPRESSED OR IMPLIED.

I ATTEST THE ABOVE ON THIS	DAY OF	, 20

RANDALL D. HENCY COLORADO REGISTERED PLS #27605 FOR AND ON BEHALF OF M.V.E., INC.

OWNER'S CERTIFICATE

THE UNDERSIGNED, BEING ALL THE OWNERS, MORTGAGEES, BENEFICIARIES OF DEEDS OF TRUST AND HOLDERS OF OTHER INTERESTS IN THE LAND DESCRIBEI herein, have laid out, subdivided, and platted said lands into lots, tracts, streets, and easements (use which are applicable) as shown hereon UNDER THE NAME AND SUBDIVISION OF MIISFIT CREW ESTATES. ALL PUBLIC IMPROVEMENTS SO PLATTED ARE HEREBY DEDICATED TO PUBLIC USE AND SAID OWNER DOES HEREBY COVENANT AND AGREE THAT THE PUBLIC IMPROVEMENTS WILL BE CONSTRUCTED TO EL PASO COUNTY STANDARDS AND THAT PROPER DRAINAGE AND EROSION CONTROL FOR SAME WILL BE PROVIDED AT SAID OWNER'S EXPENSE, ALL TO THE SATISFACTION OF THE BOARD OF COUNT COMMISSIONERS OF EL PASO COUNTY, COLORADO. UPON ACCEPTANCE BY RESOLUTION, ALL PUBLIC IMPROVEMENTS SO DEDICATED WILL BECOME MATTERS OF MAINTENANCE BY EL PASO COUNTY, COLORADO. THE UTILITY EASEMENTS SHOWN HEREON ARE HEREBY DEDICATED FOR PUBLIC UTILITIES AND COMMUNICATION SYSTEMS AND OTHER PURPOSES AS SHOWN HEREON. THE ENTITIES RESPONSIBLE FOR PROVIDING THE SERVICES FOR WHICH THE EASEMENTS ARE ESTABLISHED ARE HERBY GRANTED THE PERPETUAL RIGHT OF INGRESS AND EGRESS FROM AND TO ADJACENT PROPERTIES FOR INSTALLATION. MAINTENANCE, AND REPLACEMENT OF UTILITY LINES AND RELATED FACILITIES

MARK E. MCDONALD, OWNER		
STATE OF COLORADO)		
) SS COUNTY OF EL PASO)		
ACKNOWLEDGED BEFORE ME THIS	DAY OF	, 2024 BY MARK E. MCDONALD AS OWNER
MY COMMISSION EXPIRES		
WITNESS MY HAND AND OFFICIAL SEAL	NOTARY PUBLIC	
	THE IT WILL I TO BEING	
AMANDA M. ENLOE , OWNER		
STATE OF COLORADO)		
) SS COUNTY OF EL PASO)		
ACKNOWLEDGED BEFORE ME THIS	DAY OF	, 2024 BY AMANDA M. ENLOE AS OWNER.
MY COMMISSION EXPIRES		
WITNESS MY HAND AND OFFICIAL SEAL	NOTA DV DUDUC	
	NOTARY PUBLIC	

BOARD OF COUNTY COMMISSIONERS CERTIFICATE

THIS PLAT FOR "MIISFIT CREW ESTATES" WAS APPROVED FOR FILING BY THE EL PASO COUNTY, COLORADO BOARD OF COUNTY COMMISSIONERS ON THE _, 20____, SUBJECT TO ANY NOTES SPECIFIED HEREON AND ANY CONDITIONS INCLUDED IN THE RESOLUTION OF APPROVAL. THE DEDICATIONS OF LAND TO THE PUBLIC (EASEMENTS) ARE ACCEPTED, BUT PUBLIC IMPROVEMENTS THEREON WILL NOT BECOME THE MAINTENANCE RESPONSIBILITY OF EL PASO COUNTY UNTIL PRELIMINARY ACCEPTANCE OF THE PUBLIC IMPROVEMENTS IN ACCORDANCE WITH THE REQUIREMENTS OF THE LAND DEVELOPMENT CODE AND ENGINEERING CRITERIA MANUAL.

CHAIR, BOARD OF COUNTY COMMISSIONERS	DATE
PLANNING AND COMMUNITY DEVELOPMENT DIRECTOR	DATE

CLERK AND RECORDER

CLERK AND RECORDER:

STATE OF COLORADO	l SS
COUNTY OF EL PASO	7.55
	NSTRUMENT WAS FILED FOR RECORD IN MY OFFICE AT O'CL TION NO OF THE RECORDS OF EL PASO CO
STEVE SCHLEIKER, RECORDE	·R

CLOCK __.M. THIS ____ DAY OF _____, 20___, A.D. AND IS UNTY, COLORADO.

STEVE SCHLEIKER, RECORDER	
BY:	
DEPUTY	
SCHOOL FEE:	_
BRIDGE FEE:	_
PARK FEE:	_
DRAINAGE FEE:	



NOT TO SCALE

DAVID GORMAN, P.E. 1903 LELARAY STREET MARK E MCDONALD COLORADO SPRINGS CO 80909 AMANDA M ENLOE PH (719) 635-5736 5775 MOUNTAIN SHADOW VIEW FAX (719) 635-5450 COLORADO SPRINGS CO 80908 DAVEG@MVECIVIL.COM mmcd5280@gmail.com RANDALL D. HENCY CO PLS NO. 27605 POLARIS SURVEYING, INC 1903 LELARAY ST. STE 100

COLORADO SPRINGS, CO 80909

DATE OF PREPARATION: 5/21/2024

DATE OF SURVEY: 1/12/2024

(719) 448-0844

JOB#: 230406

MINOR SUBDIVISION PLAT MIISFIT CREW ESTATES

> ENGINEERS SURVEYORS 1903 Lelaray Street, Suite 200 Colorado Springs CO 80909

719.635.5736 www.mvecivil.com

MVE DRAWING: 61160-PLAT-CS OCTOBER 16, 2024 1 OF 2

MVE PROJECT:

PCD FILE # SF2417

10/16/2024

REVISIONS:

MISFIT CREW ESTATES A TRACT OF LAND LOCATED IN THE EAST HALF OF THE SOUTHEAST QUARTER QUARTER OF SECTION 24, TOWNSHIP 11 SOUTH, RANGE 66 WEST of the 6th PRINCIPAL MERIDIAN, EL PASO COUNTY, COLORADO LEGEND PROPOSED SUBDIVISION BOUNDARY LINE FOUND CORNER AS SHOWN SET #5 REBAR W/ ALUMINUM CAP MARKED "POLARIS, PLS 27605" FLUSH WITH THE GROUND PUBLIC UTILITY AND DRAINAGE EASEMENT DRAINAGE EASEMENT WITH NO BUILD AND NO STORAGE OF MATERIALS **VIEW EASEMENT** S 00°20'57" E, 636.60' (NO AREAS OUTSIDE OF THE SHOWN BOUNDARY ARE A PART OF THIS LOT 1 1,119,163 SF (25.692 AC) LOT 3 218,000 SF (5.005 AC) _S 88°58'04" W 10' ADDITIONAL RIGHT-OF-WAY 1,180 SF. (0.027 AC.) TO BE DEDICATED TO EL PASO COUNTY 218,000 SF (5.005 AC) POINT OF COMMENCEMENT (POC) E 1/16TH CORNER ON N 00°20'57" W, 2220.37' - POINT OF BEGINNING 1" = 100' 1:1,200 MINOR SUBDIVISION PLAT MIISFIT CREW ESTATES MYE, INC. MVE PROJECT: 61160 MVE DRAWING: 61160-PLAT-P\$1 DATE: OCTOBER 16, 2024 1903 Lelaray Street, Suite 200 Colorado Springs CO 80909 719.635.5736 www.mvecivil.com SHEET: 2 OF 2