


# PEERLESS FARMS CONSTRUCTION DOCUMENTS

## 16975 FALCON HIGHWAY, PEYTON, CO

SITUATED IN THE NORTHWEST QUARTER OF SECTION 13, TOWNSHIP 13 SOUTH, RANGE 64 WEST OF THE  
6TH P.M., CITY OF PEYTON, COUNTY OF EL PASO, STATE OF COLORADO

### VICINITY MAP

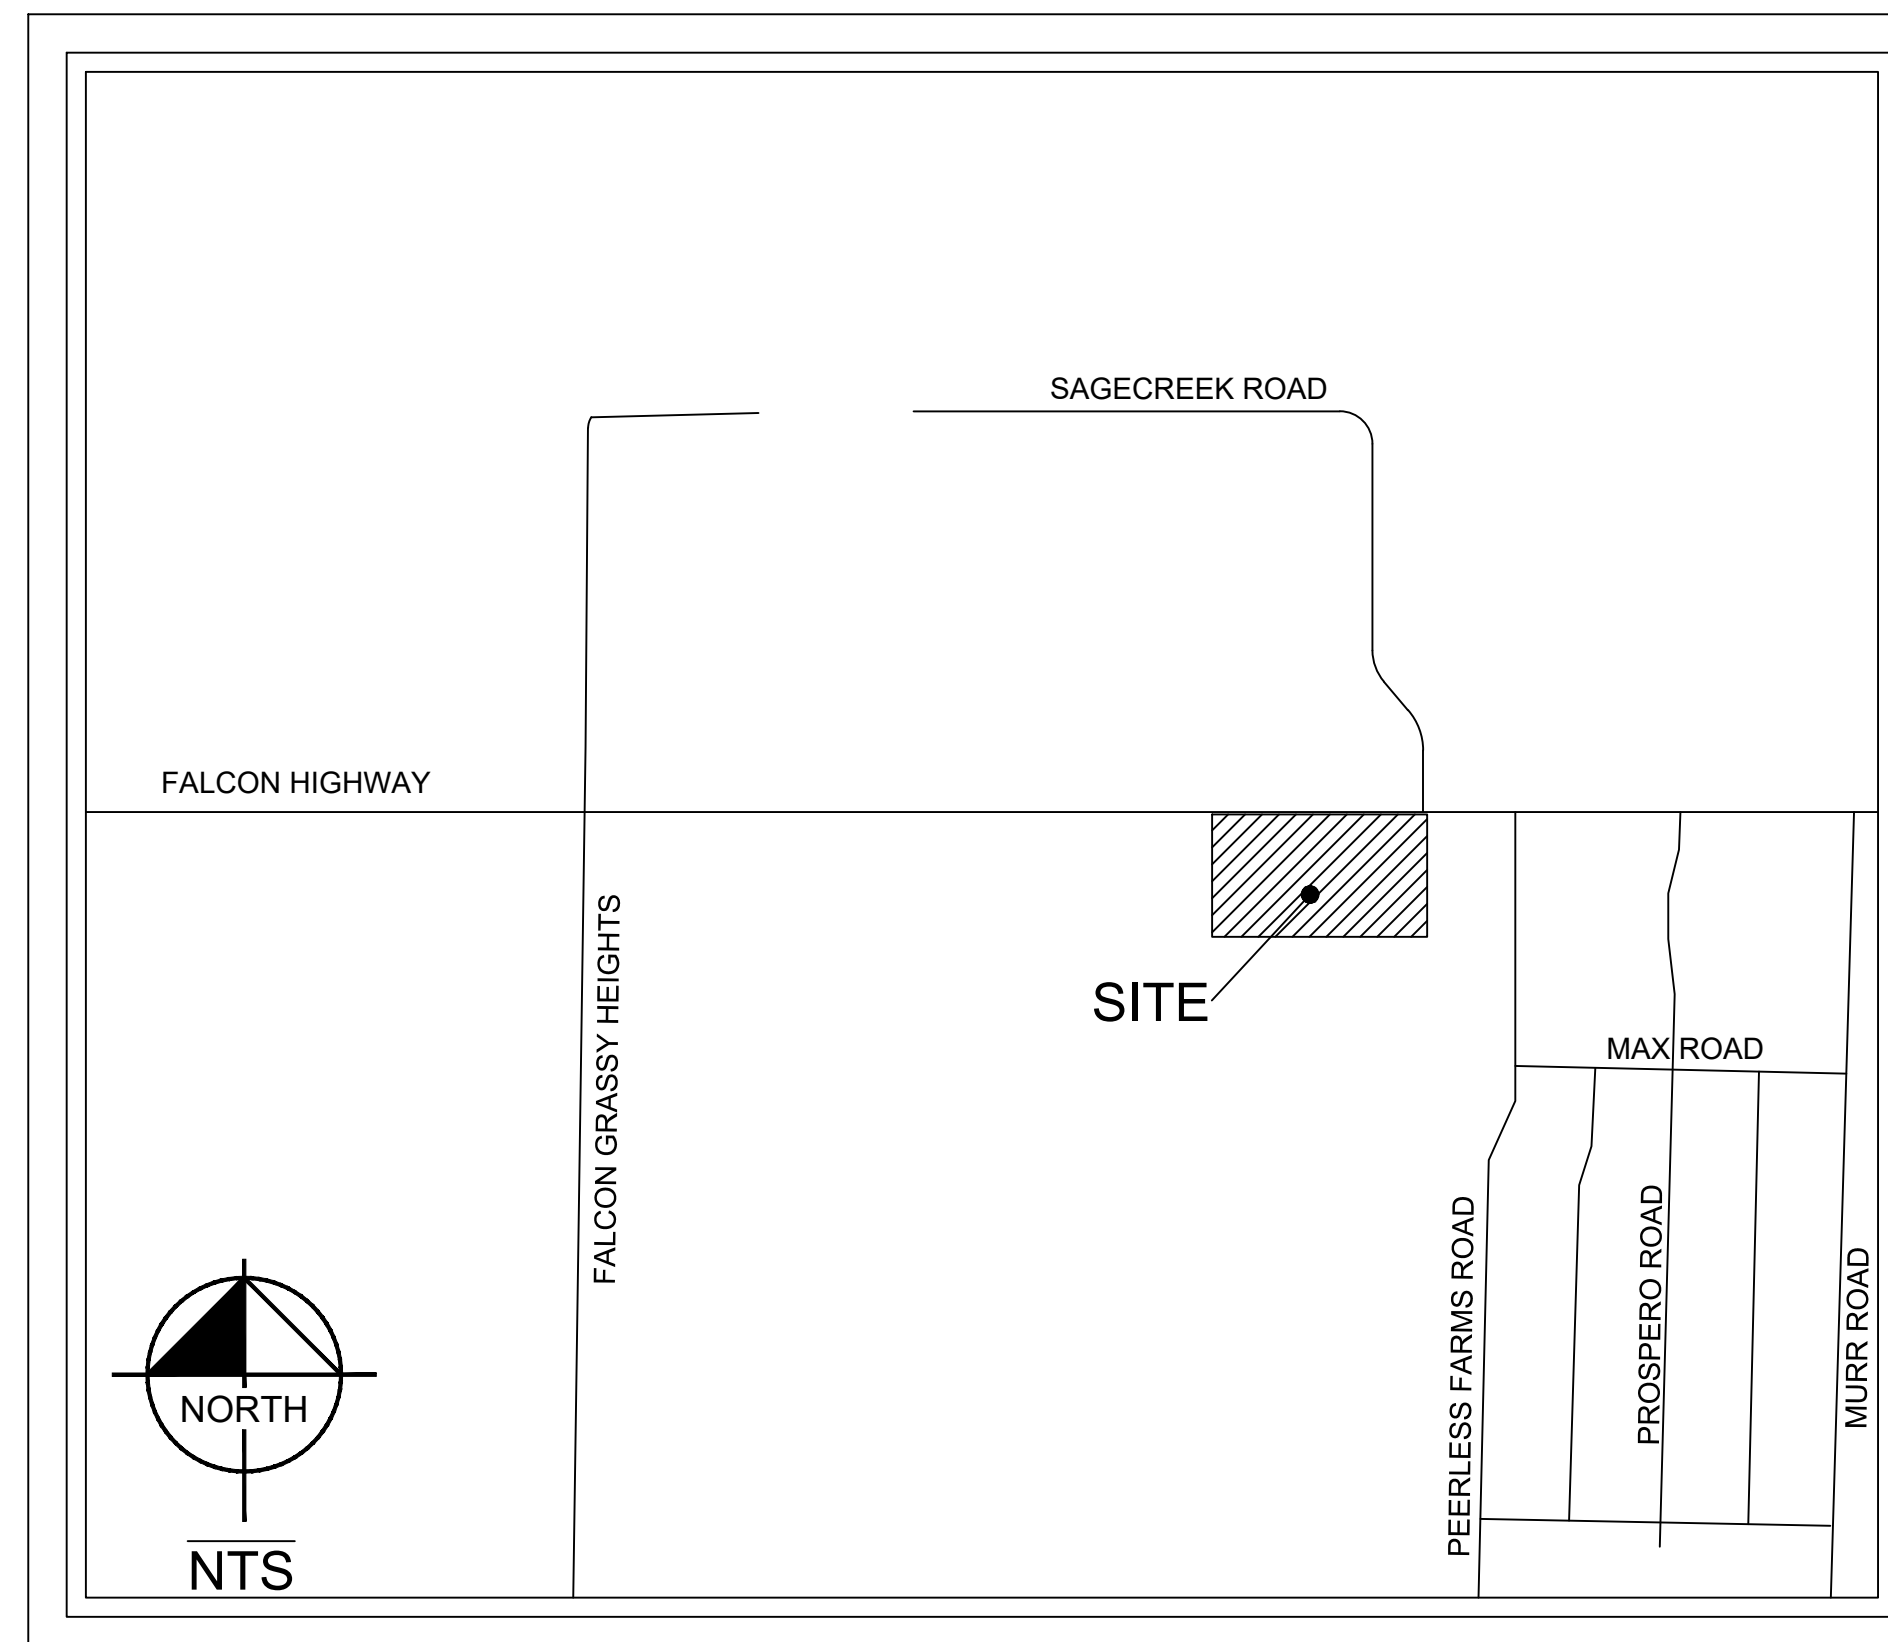

#### DEVELOPER'S SIGNATURE BLOCK

I, THE OWNER/DEVELOPER HAVE READ AND WILL COMPLY WITH ALL OF THE REQUIREMENTS SPECIFIED IN THESE DETAILED PLANS AND SPECIFICATIONS.

NAME \_\_\_\_\_ DATE \_\_\_\_\_

#### ENGINEER'S SIGNATURE BLOCK

THESE DETAILED PLANS AND SPECIFICATIONS WERE PREPARED UNDER MY DIRECTION AND SUPERVISION. SAID PLANS AND SPECIFICATIONS HAVE BEEN PREPARED ACCORDING TO THE CRITERIA ESTABLISHED BY THE COUNTY FOR DETAILED ROADWAY, DRAINAGE, GRADING AND EROSION CONTROL PLANS AND SPECIFICATIONS AND SAID PLANS AND SPECIFICATIONS ARE IN CONFORMITY WITH THE APPLICABLE MASTER DRAINAGE PLANS AND MASTER TRANSPORTATION PLANS. SAID PLANS AND SPECIFICATIONS MEET THE PURPOSES FOR WHICH THE PARTICULAR ROADWAY AND DRAINAGE FACILITIES ARE DESIGNED AND ARE CORRECT TO THE BEST OF MY KNOWLEDGE AND BELIEF. I ACCEPT RESPONSIBILITY FOR ANY LIABILITY CAUSED BY ANY NEGLIGENT ACTS, ERRORS OR OMISSIONS ON MY PART IN PREPARATION OF THE DETAILED PLANS AND SPECIFICATIONS

MITCHELL HESS, PE -- KIMLEY-HORN AND ASSOCIATES, INC. DATE \_\_\_\_\_

#### EL PASO COUNTY REVIEW STATEMENT

COUNTY PLAN REVIEW IS PROVIDED ONLY FOR GENERAL CONFORMANCE WITH COUNTY DESIGN CRITERIA. THE COUNTY IS NOT RESPONSIBLE FOR THE ACCURACY AND ADEQUACY OF THE DESIGN DIMENSIONS AND/OR ELEVATIONS WHICH SHALL BE CONFIRMED AT THE JOB SITE. THE COUNTY THROUGH THE APPROVAL OF THIS DOCUMENT ASSUMES NO RESPONSIBILITY FOR COMPLETENESS AND/OR ACCURACY OF THIS DOCUMENT.

FILED IN ACCORDANCE WITH THE REQUIREMENTS OF EL PASO COUNTY LAND DEVELOPMENT CODE, DRAINAGE CRITERIA MANUAL, VOLUMES 1 AND 2, AND ENGINEERING CRITERIA MANUAL AS AMENDED.

IN ACCORDANCE WITH ECM SECTION 1.12, THESE CONSTRUCTION DOCUMENTS WILL BE VALID FOR CONSTRUCTION FOR A PERIOD OF 2 YEARS FROM THE DATE SIGNED BY THE EL PASO COUNTY ENGINEER. IF CONSTRUCTION HAS NOT STARTED WITHIN THOSE 2 YEARS, THE PLANS WILL NEED TO BE RESUBMITTED FOR APPROVAL, INCLUDING PAYMENT OF REVIEW FEES AT THE PLANNING AND COMMUNITY DEVELOPMENT DIRECTORS DISCRETION.

JOSHUA PALMER, P.E. DATE \_\_\_\_\_  
COUNTY ENGINEER / ECM ADMINISTRATOR

#### BASIS OF BEARING

ALL BEARINGS DEPICTED ON THIS SUBDIVISION PLAT ARE BASED UPON THE NORTH LINE OF THE SUBJECT PROPERTY, BEING MONUMENTED AT EACH END BY FOUND REBAR AND PLASTIC SURVEYORS CAP, PLS 7338; BEARING N89°21'32"E.

#### BENCHMARK

SURVEY ELEVATIONS WERE BASED ON THE NE PROPERTY CORNER (FOUND REBAR WITH CAP, PLS 7338) WITH AN ELEVATION OF 6576.13 NAVD88.

DESIGN DATA	SAGECREEK RD
ROAD CLASSIFICATION	LOCAL
DESIGN SPEED	30 MPH
POSTED SPEED	30 MPH
CLEAR ZONE	7'
MINIMUM CL RADIUS OF CURVE	300'
NUMBER OF THROUGH LANES	2
LANE WIDTH	12'
RIGHT-OF-WAY	60'
PAVED WIDTH	28'
OUTSIDE SHOULDER WIDTH (PAVED/GRAVEL)	4' (2'-2')
DESIGN VEHICLE	WB-50
MINIMUM K-VALUE (CREST/SAG)	19'/37'
MINIMUM VERTICAL GRADE	0.5%

SHEET SET INDEX	
SHEET NO.	SHEET TITLE
C2.0	COVER SHEET
C2.1	NOTES & DETAILS
C2.2	PUBLIC ROADWAY PLAN & PROFILE
C2.3	CURB RETURN PLAN & PROFILES
C2.4	CUL-DU-SAC PLAN & PROFILE
C2.5	CULVERT PLAN & PROFILES

#### CONTACTS:

**OWNER:**  
ROBERT S. AND WENDY K. WILLIAMS  
16975 FALCON HIGHWAY  
PEYTON, CO 80831-7906  
TEL: (404) 438-1874  
CONTACT: ROBERT S. WILLIAMS

**EL PASO COUNTY:**  
EL PASO COUNTY  
PCD DEPARTMENT  
2880 INTERNATIONAL CIRCLE, SUITE 110  
COLORADO SPRINGS, CO 80910  
PHONE: (719) 520-6300

**ENGINEER:**  
KIMLEY-HORN AND ASSOCIATES, INC.  
2 NORTH NEVADA AVENUE, SUITE 900  
COLORADO SPRINGS, CO 80903  
TEL: (719) 453-0180  
CONTACT: MITCHELL HESS, P.E.

**SURVEYOR:**  
CENTENNIAL LAND SURVEYING  
6465 LEHMAN DRIVE  
COLORADO SPRINGS, CO 80918  
TEL: (719) 492-6540  
CONTACT: MICHAEL J. MUIRHEID, PLS



NO.	BY	DATE	APPR

**Kimley-Horn**  
© 2024, KIMLEY-HORN AND ASSOCIATES, INC.  
2 N. Nevada Avenue, Suite 900  
Colorado Springs, CO 80903 (719) 453-0180

DESIGNED BY: MOH  
DRAWN BY: JWM  
CHECKED BY: MOH  
DATE: 06/21/2024

PEERLESS FARMS  
EL PASO COUNTY, COLORADO  
COVER SHEET  
CONSTRUCTION DOCUMENTS

PRELIMINARY  
FOR REVIEW ONLY  
NOT FOR  
CONSTRUCTION  
**Kimley-Horn**  
Kimley-Horn and Associates, Inc.

PROJECT NO.  
196114000

DRAWING NAME  
196114000\_CV.dwg

C2.0

K:\COS\_LA\196114000 - Peerless Farms\CADD\PlanSheets\Roadway\196114000\_CV.dwg - Petik, Grant 6/28/2024 10:39 AM  
THIS DOCUMENT, TOGETHER WITH THE CONCEPTS AND DESIGNS PRESENTED HEREIN, AS AN INSTRUMENT OF SERVICE, IS INTENDED ONLY FOR THE SPECIFIC PURPOSE AND CLIENT FOR WHICH IT WAS PREPARED. REUSE OF ANY PART OF THIS DOCUMENT WITHOUT WRITTEN AUTHORIZATION AND ADAPTATION BY KIMLEY-HORN AND ASSOCIATES, INC. SHALL BE WITHOUT LIABILITY TO KIMLEY-HORN AND ASSOCIATES, INC.

K:\COS\_LA\196114000 - Peerless Farms\CADD\PlanSheets\Roadway\196114000\_CV.dwg - Petik, Grant 6/28/2024 10:39 AM  
THIS DOCUMENT IS THE PROPERTY OF KIMLEY-HORN AND ASSOCIATES, INC. IT IS TO BE USED ONLY FOR THE PROJECT AND SITE FOR WHICH IT WAS PREPARED. NO PART OF THIS DOCUMENT SHALL BE REPRODUCED OR TRANSMITTED IN ANY FORM OR BY ANY MEANS, ELECTRONIC OR MECHANICAL, INCLUDING PHOTOCOPYING, RECORDING, OR BY ANY INFORMATION STORAGE AND RETRIEVAL SYSTEM, WITHOUT THE WRITTEN PERMISSION OF KIMLEY-HORN AND ASSOCIATES, INC.

### STANDARD NOTES FOR EL PASO COUNTY CONSTRUCTION PLANS

- ALL DRAINAGE AND ROADWAY CONSTRUCTION SHALL MEET THE STANDARDS AND SPECIFICATIONS OF THE CITY OF COLORADO SPRINGS/EL PASO COUNTY DRAINAGE CRITERIA MANUAL, VOLUMES 1 AND 2, AND THE EL PASO COUNTY ENGINEERING CRITERIA MANUAL.
- CONTRACTOR SHALL BE RESPONSIBLE FOR THE NOTIFICATION AND FIELD NOTIFICATION OF ALL EXISTING UTILITIES, WHETHER SHOWN ON THE PLANS OR NOT, BEFORE BEGINNING CONSTRUCTION. LOCATION OF EXISTING UTILITIES SHALL BE VERIFIED BY THE CONTRACTOR PRIOR TO CONSTRUCTION. CALL 811 TO CONTACT THE UTILITY NOTIFICATION CENTER OF COLORADO (UNCC).
- CONTRACTOR SHALL KEEP A COPY OF THESE APPROVED PLANS, THE GRADING AND EROSION CONTROL PLAN, THE STORMWATER MANAGEMENT PLAN (SWMP), THE SOILS AND GEOTECHNICAL REPORT, AND THE APPROPRIATE DESIGN AND CONSTRUCTION STANDARDS AND SPECIFICATIONS AT THE JOB SITE AT ALL TIMES, INCLUDING THE FOLLOWING:
  - EL PASO COUNTY ENGINEERING CRITERIA MANUAL (ECM)
  - CITY OF COLORADO SPRINGS/EL PASO COUNTY DRAINAGE CRITERIA MANUAL, VOLUMES 1 AND 2
  - COLORADO DEPARTMENT OF TRANSPORTATION (CDOT) STANDARD SPECIFICATIONS FOR ROAD AND BRIDGE CONSTRUCTION CDOT M & S STANDARDS
- NOTWITHSTANDING ANYTHING DEPICTED IN THESE PLANS IN WORDS OR GRAPHIC REPRESENTATION, ALL DESIGN AND CONSTRUCTION RELATED TO ROADS, STORM DRAINAGE AND EROSION CONTROL SHALL CONFORM TO THE STANDARDS AND REQUIREMENTS OF THE MOST RECENT VERSION OF THE RELEVANT ADOPTED EL PASO COUNTY STANDARDS, INCLUDING THE LAND DEVELOPMENT CODE, THE ENGINEERING CRITERIA MANUAL, THE DRAINAGE CRITERIA MANUAL, AND THE DRAINAGE CRITERIA MANUAL VOLUME 2. ANY DEVIATIONS FROM REGULATIONS AND STANDARDS MUST BE REQUESTED, AND APPROVED, IN WRITING. ANY MODIFICATIONS NECESSARY TO MEET CRITERIA AFTER-THE-FACT WILL BE ENTIRELY THE DEVELOPER'S RESPONSIBILITY TO RECTIFY.
- IT IS THE DESIGN ENGINEER'S RESPONSIBILITY TO ACCURATELY SHOW EXISTING CONDITIONS, BOTH ON-SITE AND OFF-SITE, ON THE CONSTRUCTION PLANS. ANY MODIFICATIONS NECESSARY DUE TO CONFLICTS, OMISSIONS, OR CHANGED CONDITIONS WILL BE ENTIRELY THE DEVELOPER'S RESPONSIBILITY TO RECTIFY.
- CONTRACTOR SHALL SCHEDULE A PRE-CONSTRUCTION MEETING WITH EL PASO COUNTY PLANNING AND COMMUNITY DEVELOPMENT (PCD) - INSPECTIONS, PRIOR TO STARTING CONSTRUCTION.
- IT IS THE CONTRACTOR'S RESPONSIBILITY TO UNDERSTAND THE REQUIREMENTS OF ALL JURISDICTIONAL AGENCIES AND TO OBTAIN ALL REQUIRED PERMITS, INCLUDING BUT NOT LIMITED TO EL PASO COUNTY EROSION AND STORMWATER QUALITY CONTROL PERMIT (ESQCP), REGIONAL BUILDING FLOODPLAIN DEVELOPMENT PERMIT, U.S. ARMY CORPS OF ENGINEERS-ISSUED 401 AND/OR 404 PERMITS, AND COUNTY AND STATE FUGITIVE DUST PERMITS.
- CONTRACTOR SHALL NOT DEVIATE FROM THE PLANS WITHOUT FIRST OBTAINING WRITTEN APPROVAL FROM THE DESIGN ENGINEER AND PCD. CONTRACTOR SHALL NOTIFY THE DESIGN ENGINEER IMMEDIATELY UPON DISCOVERY OF ANY ERRORS OR INCONSISTENCIES.
- ALL STORM DRAIN PIPE SHALL BE CLASS III RCP UNLESS OTHERWISE NOTED AND APPROVED BY PCD.
- CONTRACTOR SHALL COORDINATE GEOTECHNICAL TESTING PER ECM STANDARDS. PAVEMENT DESIGN SHALL BE APPROVED BY EL PASO COUNTY PCD PRIOR TO PLACEMENT OF CURB AND GUTTER AND PAVEMENT.
- ALL CONSTRUCTION TRAFFIC MUST ENTER/EXIT THE SITE AT APPROVED CONSTRUCTION ACCESS POINTS.
- SIGHT VISIBILITY TRIANGLES AS IDENTIFIED IN THE PLANS SHALL BE PROVIDED AT ALL INTERSECTIONS. OBSTRUCTIONS GREATER THAN 18 INCHES ABOVE FLOWLINE ARE NOT ALLOWED WITHIN SIGHT TRIANGLES.
- SIGNING AND STRIPING SHALL COMPLY WITH EL PASO COUNTY DPW AND MUTCD CRITERIA.
- CONTRACTOR SHALL OBTAIN ANY PERMITS REQUIRED BY EL PASO COUNTY DPW, INCLUDING WORK WITHIN THE RIGHT-OF-WAY AND SPECIAL TRANSPORT PERMITS.
- THE LIMITS OF CONSTRUCTION SHALL REMAIN WITHIN THE PROPERTY LINE UNLESS OTHERWISE NOTED. THE OWNER/DEVELOPER SHALL OBTAIN WRITTEN PERMISSION AND EASEMENTS, WHERE REQUIRED, FROM ADJOINING PROPERTY OWNER(S) PRIOR TO ANY OFF-SITE DISTURBANCE, GRADING, OR CONSTRUCTION.

### STANDARD NOTES FOR EL PASO COUNTY SIGNING & STRIPING PLANS

- ALL SIGNS AND PAVEMENT MARKINGS SHALL BE IN COMPLIANCE WITH THE CURRENT MANUAL ON UNIFORM TRAFFIC CONTROL DEVICES (MUTCD).
- REMOVAL OF EXISTING PAVEMENT MARKINGS SHALL BE ACCOMPLISHED BY A METHOD THAT DOES NOT MATERIALLY DAMAGE THE PAVEMENT. THE PAVEMENT MARKINGS SHALL BE REMOVED TO THE EXTENT THAT THEY WILL NOT BE VISIBLE UNDER DAY OR NIGHT CONDITIONS. AT NO TIME WILL IT BE ACCEPTABLE TO PAINT OVER EXISTING PAVEMENT MARKINGS.
- ANY DEVIATION FROM THE STRIPING AND SIGNING PLAN SHALL BE APPROVED BY EL PASO COUNTY PLANNING AND COMMUNITY DEVELOPMENT.
- ALL SIGNS SHOWN ON THE SIGNING AND STRIPING PLAN SHALL BE NEW SIGNS. EXISTING SIGNS MAY REMAIN OR BE REUSED IF THEY MEET CURRENT EL PASO COUNTY AND MUTCD STANDARDS.
- STREET NAME AND REGULATORY STOP SIGNS SHALL BE ON THE SAME POST AT INTERSECTIONS.
- ALL REMOVED SIGNS SHALL BE DISPOSED OF IN A PROPER MANNER BY THE CONTRACTOR.
- ALL STREET NAME SIGNS SHALL HAVE "D" SERIES LETTERS, WITH LOCAL ROADWAY SIGNS BEING 4" UPPER-LOWER CASE LETTERING ON 8" BLANK AND NON-LOCAL ROADWAY SIGNS BEING 6" LETTERING, UPPER-LOWER CASE ON 12" BLANK, WITH A WHITE BORDER THAT IS NOT RECESSED. MULTI-LANE ROADWAYS WITH SPEED LIMITS OF 40 MPH OR HIGHER SHALL HAVE 8" UPPER-LOWER CASE LETTERING ON 18" BLANK WITH A WHITE BORDER THAT IS NOT RECESSED. THE WIDTH OF THE NON-RECESSED WHITE BORDERS SHALL MEET MUTCD (UPDATED DEC. 2023) "STANDARD HIGHWAY SIGNS" STANDARDS.
- ALL TRAFFIC SIGNS SHALL HAVE A MINIMUM HIGH INTENSITY PRISMATIC GRADE SHEETING.
- ALL LOCAL RESIDENTIAL STREET SIGNS SHALL BE MOUNTED ON A 1.75" X 1.75" SQUARE TUBE SIGN POST AND STUB POST BASE. FOR OTHER APPLICATIONS, REFER TO THE CDOT STANDARD S-614-B REGARDING USE OF THE P2 TUBULAR STEEL POST SLIPBASE DESIGN. ALL SIGNS SHALL BE SINGLE SHEET ALUMINUM WITH 0.100" MINIMUM THICKNESS.
- ALL LIMIT LINES/STOP LINES, CROSSWALK LINES, PAVEMENT LEGENDS, AND ARROWS SHALL BE A MINIMUM 125 MIL THICKNESS PREFORMED THERMOPLASTIC PAVEMENT MARKINGS WITH TAPERED LEADING EDGES PER CDOT STANDARD S-627-1. WORD AND SYMBOL MARKINGS SHALL BE THE NARROW TYPE. STOP BARS SHALL BE 24" IN WIDTH. CROSSWALKS LINES SHALL BE 12" WIDE AND 8" LONG PER CDOT S-627-1.
- ALL LONGITUDINAL LINES SHALL BE A MINIMUM 15MIL THICKNESS EPOXY PAINT. ALL NON-LOCAL RESIDENTIAL ROADWAYS SHALL INCLUDE BOTH RIGHT AND LEFT EDGE LINE STRIPING AND ANY ADDITIONAL STRIPING AS REQUIRED BY CDOT S-627-1.
- THE CONTRACTOR SHALL NOTIFY EL PASO COUNTY PLANNING AND COMMUNITY DEVELOPMENT (719) 520-6819 PRIOR TO AND UPON COMPLETION OF SIGNING AND STRIPING.
- THE CONTRACTOR SHALL OBTAIN A WORK IN THE RIGHT OF WAY PERMIT FROM THE EL PASO COUNTY DEPARTMENT OF PUBLIC WORKS (DPW) PRIOR TO ANY SIGNAGE OR STRIPING WORK WITHIN AN EXISTING EL PASO COUNTY ROADWAY.

### ENGINEERING CONSTRUCTION NOTES

- ALL EXISTING UTILITIES SHOWN ARE LOCATED ACCORDING TO THE INFORMATION AVAILABLE TO THE ENGINEER AT THE TIME THE DRAWINGS WERE PREPARED AND HAVE NOT BEEN INDEPENDENTLY VERIFIED BY THE OWNER OR THE ENGINEER. GUARANTEE IS NOT MADE THAT ALL EXISTING UNDERGROUND UTILITIES ARE SHOWN OR THAT THE LOCATION OF THOSE SHOWN ARE ENTIRELY ACCURATE. THE ACTUAL LOCATION OF ANY EXISTING UTILITIES IS THE CONTRACTOR'S RESPONSIBILITY AND SHALL BE DONE BEFORE HE COMMENCES ANY WORK IN THE VICINITY. FURTHERMORE, THE CONTRACTOR SHALL BE FULLY RESPONSIBLE FOR ANY AND ALL DAMAGES DUE TO THE CONTRACTOR'S FAILURE TO EXACTLY LOCATE AND PRESERVE ANY AND ALL UNDERGROUND UTILITIES. THE OWNER OR ENGINEER WILL ASSUME NO LIABILITY FOR ANY DAMAGES SUSTAINED OR COST INCURRED BECAUSE OF THE OPERATIONS IN THE VICINITY OF EXISTING UTILITIES OR STRUCTURES, NOR FOR TEMPORARY BRACING AND SHORING OF SAME. IF IT IS NECESSARY TO SHORE, BRACE, SWING OR RELOCATE A UTILITY, THE UTILITY COMPANY OR DEPARTMENT AFFECTED SHALL BE CONTACTED AND THEIR PERMISSION OBTAINED REGARDING THE METHOD TO USE FOR SUCH WORK.
- IT IS THE CONTRACTOR'S RESPONSIBILITY TO CONTACT THE VARIOUS UTILITY COMPANIES WHICH MAY HAVE BURIED OR AERIAL UTILITIES WITHIN OR NEAR THE CONSTRUCTION AREA BEFORE COMMENCING WORK. THE CONTRACTOR SHALL PROVIDE 48 HOURS MINIMUM NOTICE TO ALL UTILITY COMPANIES PRIOR TO BEGINNING CONSTRUCTION.
- CONTRACTOR SHALL CONTACT UTILITY NOTIFICATION CENTER FOR THE LOCATION OF UNDERGROUND UTILITIES AT LEAST 48 HOURS PRIOR TO COMMENCEMENT OF CONSTRUCTION (1-800-922-1987).
- CONSTRUCTION SHALL COMPLY WITH ALL GOVERNING CODES AND BE CONSTRUCTED TO SAME.
- THE CONTRACTOR SHALL BE RESPONSIBLE TO OBTAIN ALL REQUIRED CONSTRUCTION PERMITS AND BONDS PRIOR TO CONSTRUCTION.
- THE CONTRACTOR SHALL RESTORE ALL DISTURBED VEGETATION IN KIND, UNLESS SHOWN OTHERWISE.
- ALL PAVING, CONSTRUCTION, MATERIALS, AND WORKMANSHIP WITHIN THE PUBLIC RIGHT-OF-WAY OR EASEMENT SHALL CONFORM TO EL PASO COUNTY SPECIFICATIONS AND STANDARDS. (LATEST EDITION)
- CONTRACTOR SHALL PROVIDE ALL LIGHTS, SIGNS, BARRICADES, FLAGGERS, AND ALL OTHER DEVICES NECESSARY TO PROVIDE FOR PUBLIC SAFETY IN ACCORDANCE WITH MUTCD CONSTRUCTION AREA TRAFFIC CONTROL.
- AFTER COMPLETION OF CONSTRUCTION, CONTRACTOR SHALL PROVIDE AS-BUILT DRAWINGS OF ALL IMPROVEMENTS INCLUDED IN THE CIVIL CONSTRUCTION DRAWINGS TO THE OWNER AND ENGINEER OF RECORD.

### GENERAL NOTES

- THE PARTIES RESPONSIBLE FOR THIS PLAN HAVE FAMILIARIZED THEMSELVES WITH ALL CURRENT ACCESSIBILITY CRITERIA AND SPECIFICATIONS AND THE PROPOSED PLAN REFLECTS ALL SITE ELEMENTS REQUIRED BY THE APPLICABLE ADA DESIGN STANDARDS AND GUIDELINES AS PUBLISHED BY THE UNITED STATES DEPARTMENT OF JUSTICE. APPROVAL OF THIS PLAN BY EL PASO COUNTY DOES NOT ASSURE COMPLIANCE WITH THE ADA OR ANY REGULATIONS OR GUIDELINES ENACTED OR PROMULGATED UNDER OR WITH RESPECT TO SUCH LAWS.

### ENGINEERING DEMOLITION NOTES

- ALL DEMOLITION SHALL BE CARRIED OUT IN A SAFE MANNER AND IN STRICT ACCORDANCE WITH OSHA REGULATIONS. CONTRACTOR SHALL BE AWARE OF AND TAKE PRECAUTION OF OVERHEAD POWER LINES WITHIN THE PROJECT AREA.
- ALL CONDITIONS SHOWN TO BE "EXISTING" SHALL BE VERIFIED IN THE FIELD BY THE GENERAL CONTRACTOR PRIOR TO START OF CONSTRUCTION. ANY DISCREPANCIES SHALL BE NOTED AND SUBMITTED TO THE OWNER AND THE ENGINEER FOR REVIEW. CHANGES TO THE ORIGINAL DESIGN OF THIS PROJECT DUE TO EXISTING SITE CONDITIONS MUST BE APPROVED BY BOTH THE OWNER AND THE ENGINEER PRIOR TO MAKING ANY CHANGES.
- THE CONTRACTOR SHALL FIELD VERIFY THE EXTENT OF DEMOLITION.
- WHEN UTILITIES ARE REMOVED, CAP AND SEAL AT A MINIMUM DEPTH OF 8" BELOW FINISH GRADE.

### ENGINEERING SITE NOTES

- CONTRACTOR IS RESPONSIBLE FOR PROTECTION OF ALL PROPERTY CORNERS.
- CONTRACTOR SHALL MATCH PROPOSED CURB AND GUTTER, CONCRETE, AND PAVEMENT TO EXISTING GRADE AT ALL TIE IN LOCATIONS.
- CONTRACTOR SHALL REMOVE PAVEMENT AND CONCRETE IN ACCORDANCE WITH SPECIFICATIONS OF EL PASO COUNTY AND/OR THE COLORADO STATE DEPARTMENT OF TRANSPORTATION.
- CONTRACTOR IS RESPONSIBLE FOR REPAIRING THE DAMAGE DONE TO ANY EXISTING ITEM DURING CONSTRUCTION, SUCH AS, BUT NOT LIMITED TO, DRAINAGE, UTILITIES, PAVEMENT, STRIPING, CURB, ETC. REPAIRS SHALL BE EQUAL TO, OR BETTER THAN, EXISTING CONDITIONS. CONTRACTOR IS RESPONSIBLE TO DOCUMENT ALL EXISTING DAMAGE AND NOTIFY CONSTRUCTION MANAGER PRIOR TO CONSTRUCTION START.
- CONTRACTOR TO REMOVE OR RELOCATE, WHEN APPLICABLE, ALL EXISTING BUILDINGS, FOUNDATIONS, BASEMENTS, CONNECTING IMPROVEMENTS, DRAIN PIPES, SANITARY SEWER PIPES, POWER POLES, AND GUY WIRES, WATER METERS AND WATER LINES, WELLS, SIDEWALKS, SIGN POLES, UNDERGROUND GAS, SEPTIC TANKS, AND ASPHALT, SHOWN AND NOT SHOWN, WITHIN CONSTRUCTION LIMITS AND WHERE NEEDED, TO ALLOW FOR NEW CONSTRUCTION AS SHOWN.

### ENGINEERING PAVING NOTES


- CONTRACTOR SHALL ADJUST AND/OR CUT EXISTING PAVEMENT AS NECESSARY TO ASSURE A SMOOTH FIT AND CONTINUOUS GRADE.
- WHERE NEW PAVEMENT MEETS THE EXISTING PAVEMENT, THE CONTRACTOR SHALL SAW CUT THE EXISTING PAVEMENT A MINIMUM 2" DEEP FOR A SMOOTH AND STRAIGHT JOINT AND MATCH THE EXISTING PAVEMENT ELEVATION WITH THE PROPOSED JOINT UNLESS OTHERWISE INDICATED.

### ENGINEERING GRADING NOTES


- CONTOURS ON SIDEWALKS AND PRIVATE/PUBLIC ROADWAYS ARE TO FINISH GRADE.
- FOR GROUND TREATMENT OF ALL OPEN AREAS WITHIN THE PROJECT SITE, REFER TO LANDSCAPE PLANS.
- THE CONTRACTOR SHALL BE RESPONSIBLE FOR THE CONTROL OF DUST AND DIRT RISING AND SCATTERING IN THE AIR DURING CONSTRUCTION AND SHALL PROVIDE WATER SPRINKLING OR OTHER SUITABLE METHODS OF CONTROL. THE CONTRACTOR SHALL COMPLY WITH ALL GOVERNING REGULATIONS PERTAINING TO ENVIRONMENTAL PROTECTION.
- THE CONTRACTOR SHALL GRADE THE SITE TO THE ELEVATIONS INDICATED AND SHALL REGRADE WASHOUTS WHERE THEY OCCUR AFTER EVERY RAINFALL UNTIL A GRASS STAND OR OTHER FINAL LANDSCAPE PLANTING IS WELL ESTABLISHED.

### ENGINEERING DRAINAGE AND STORM WATER NOTES


- ON-SITE STORM SEWER SYSTEM HAS BEEN PROVIDED TO MAINTAIN THE EXISTING DRAINAGE PATTERNS.
- ALL ON-SITE STORM SEWER IS PRIVATE, UNLESS OTHERWISE NOTED.
- EXISTING DRAINAGE STRUCTURES TO BE INSPECTED AND REPAIRED AS NEEDED, AND ANY EXISTING PIPES TO BE CLEANED OUT TO REMOVE ALL SILT AND DEBRIS.
- THE CONTRACTOR SHALL DE-SILT ALL DRAINAGE STRUCTURES AS REQUIRED DURING AND AT THE END OF CONSTRUCTION TO PROVIDE POSITIVE DRAINAGE FLOWS.
- IF TEMPORARY OR PERMANENT DEWATERING IS REQUIRED, THE CONTRACTOR SHALL OBTAIN ANY APPLICABLE REQUIRED PERMITS. THE CONTRACTOR IS TO COORDINATE WITH THE OWNER PRIOR TO EXCAVATION.
- OWNER AND CONTRACTOR ARE RESPONSIBLE FOR OBTAINING THE STATE STORMWATER DISCHARGE PERMIT FOR CONSTRUCTION ACTIVITIES AT LEAST TEN BUSINESS DAYS PRIOR TO COMMENCEMENT OF CONSTRUCTION ACTIVITIES.

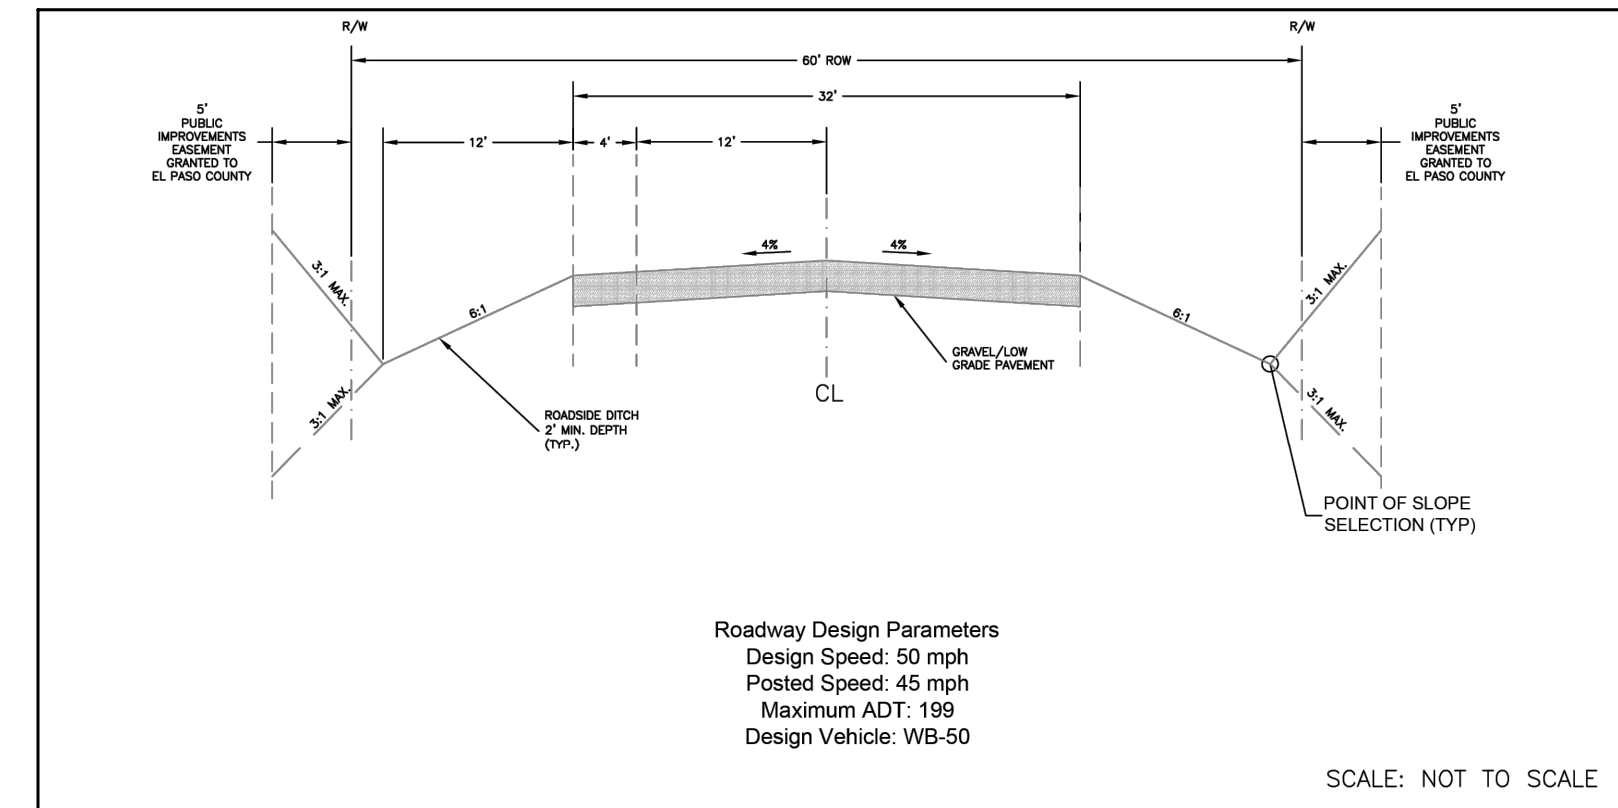

DATE APPROVED: 9/16/10	PROJECT: Rural Gravel Local Roadway	FILE NAME: SD_2-10
APPROVED BY: André P. Brackin	REVISION DATE: 12/8/15	DEPARTMENT OF TRANSPORTATION

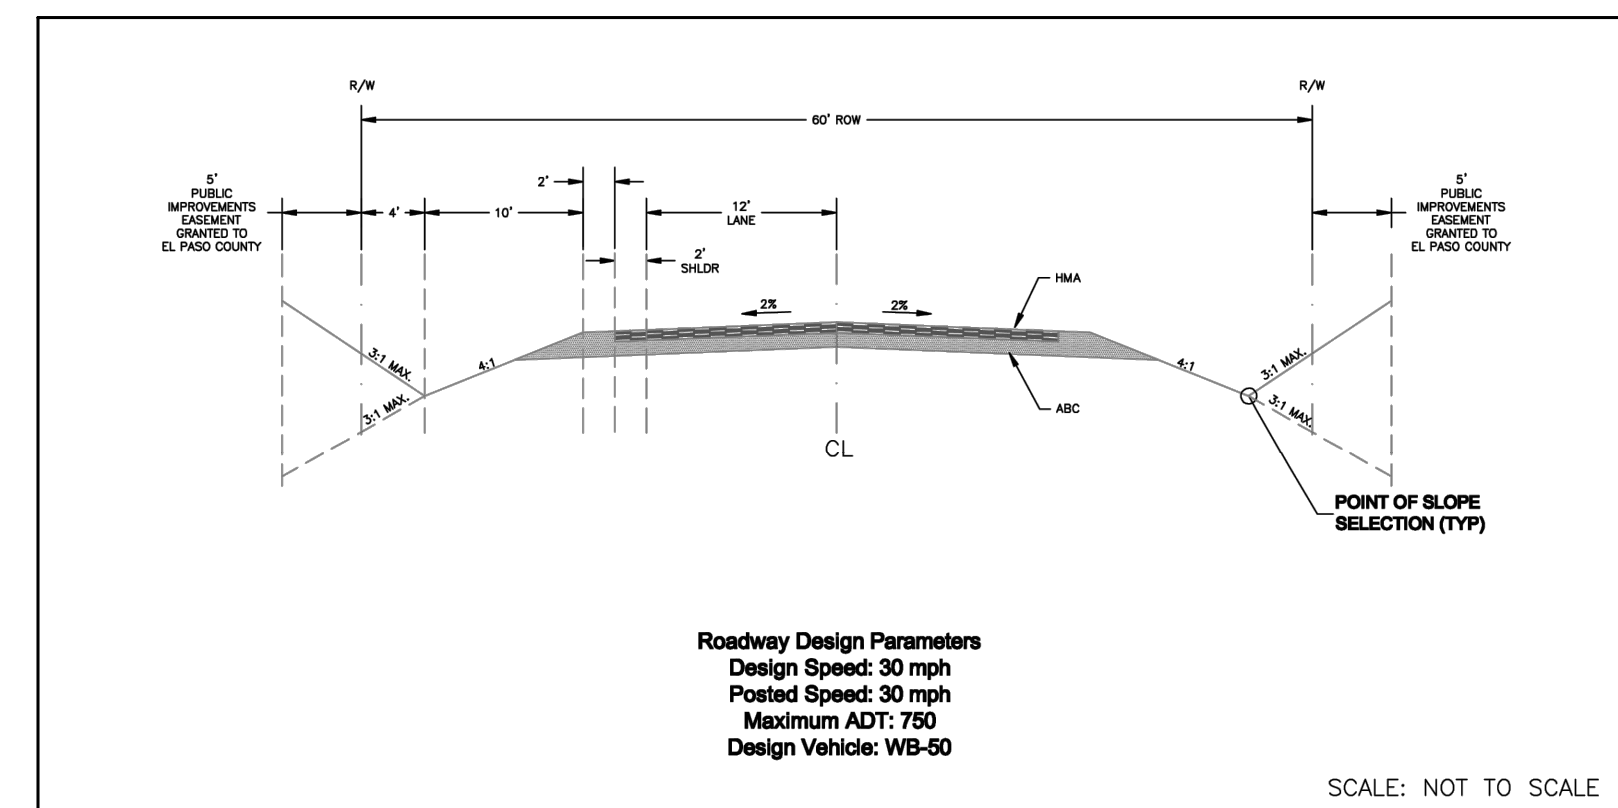

DATE APPROVED: 12/31/05	PROJECT: Rural Local Roadway	FILE NAME: SD_2-11
APPROVED BY: John A. McCarty	REVISION DATE: 12/22/05	DEPARTMENT OF TRANSPORTATION

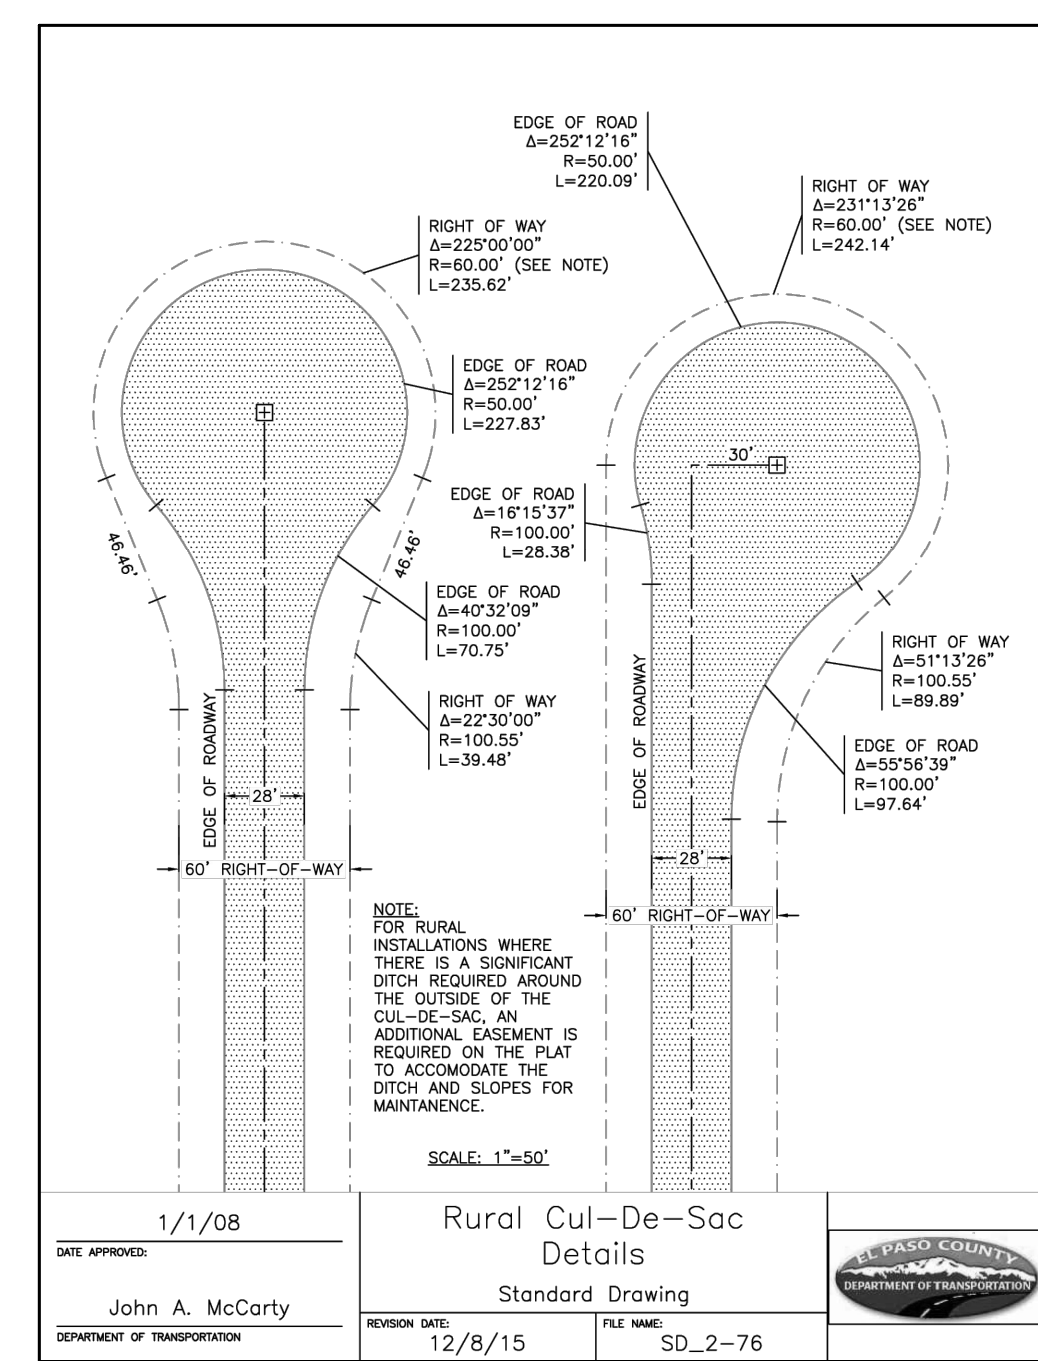

NO.	DATE	APPR.

**Kimley-Horn**  
© 2024, KIMLEY-HORN AND ASSOCIATES, INC.  
274 Nevada Avenue, Suite 900  
Colorado Springs, CO 80903 (719) 453-0180

DESIGNED BY: MOH  
DRAWN BY: JWM  
CHECKED BY: MOH  
DATE: 06/21/2024

PEERLESS FARMS  
EL PASO COUNTY, COLORADO  
NOTES & DETAILS  
CONSTRUCTION DOCUMENTS


PRELIMINARY  
FOR REVIEW ONLY  
NOT FOR CONSTRUCTION  
Kimley-Horn and Associates, Inc.

PROJECT NO.  
196114000  
DRAWING NAME  
196114000\_CV.dwg  
C2.1



Unresolved from Submittal 1: Provide a detail of drainage ditch cross section with side slopes, min depth, etc.

Submittal 2 addition: The detail on sheet two shows two different cross sections, one that is not applicable if appears since the slopes are 4:1 and only one has a min depth listed. It needs to be clear the proposed side slopes (both front and back) and min depth for the construction of these ditches since they are providing drainage and water quality.

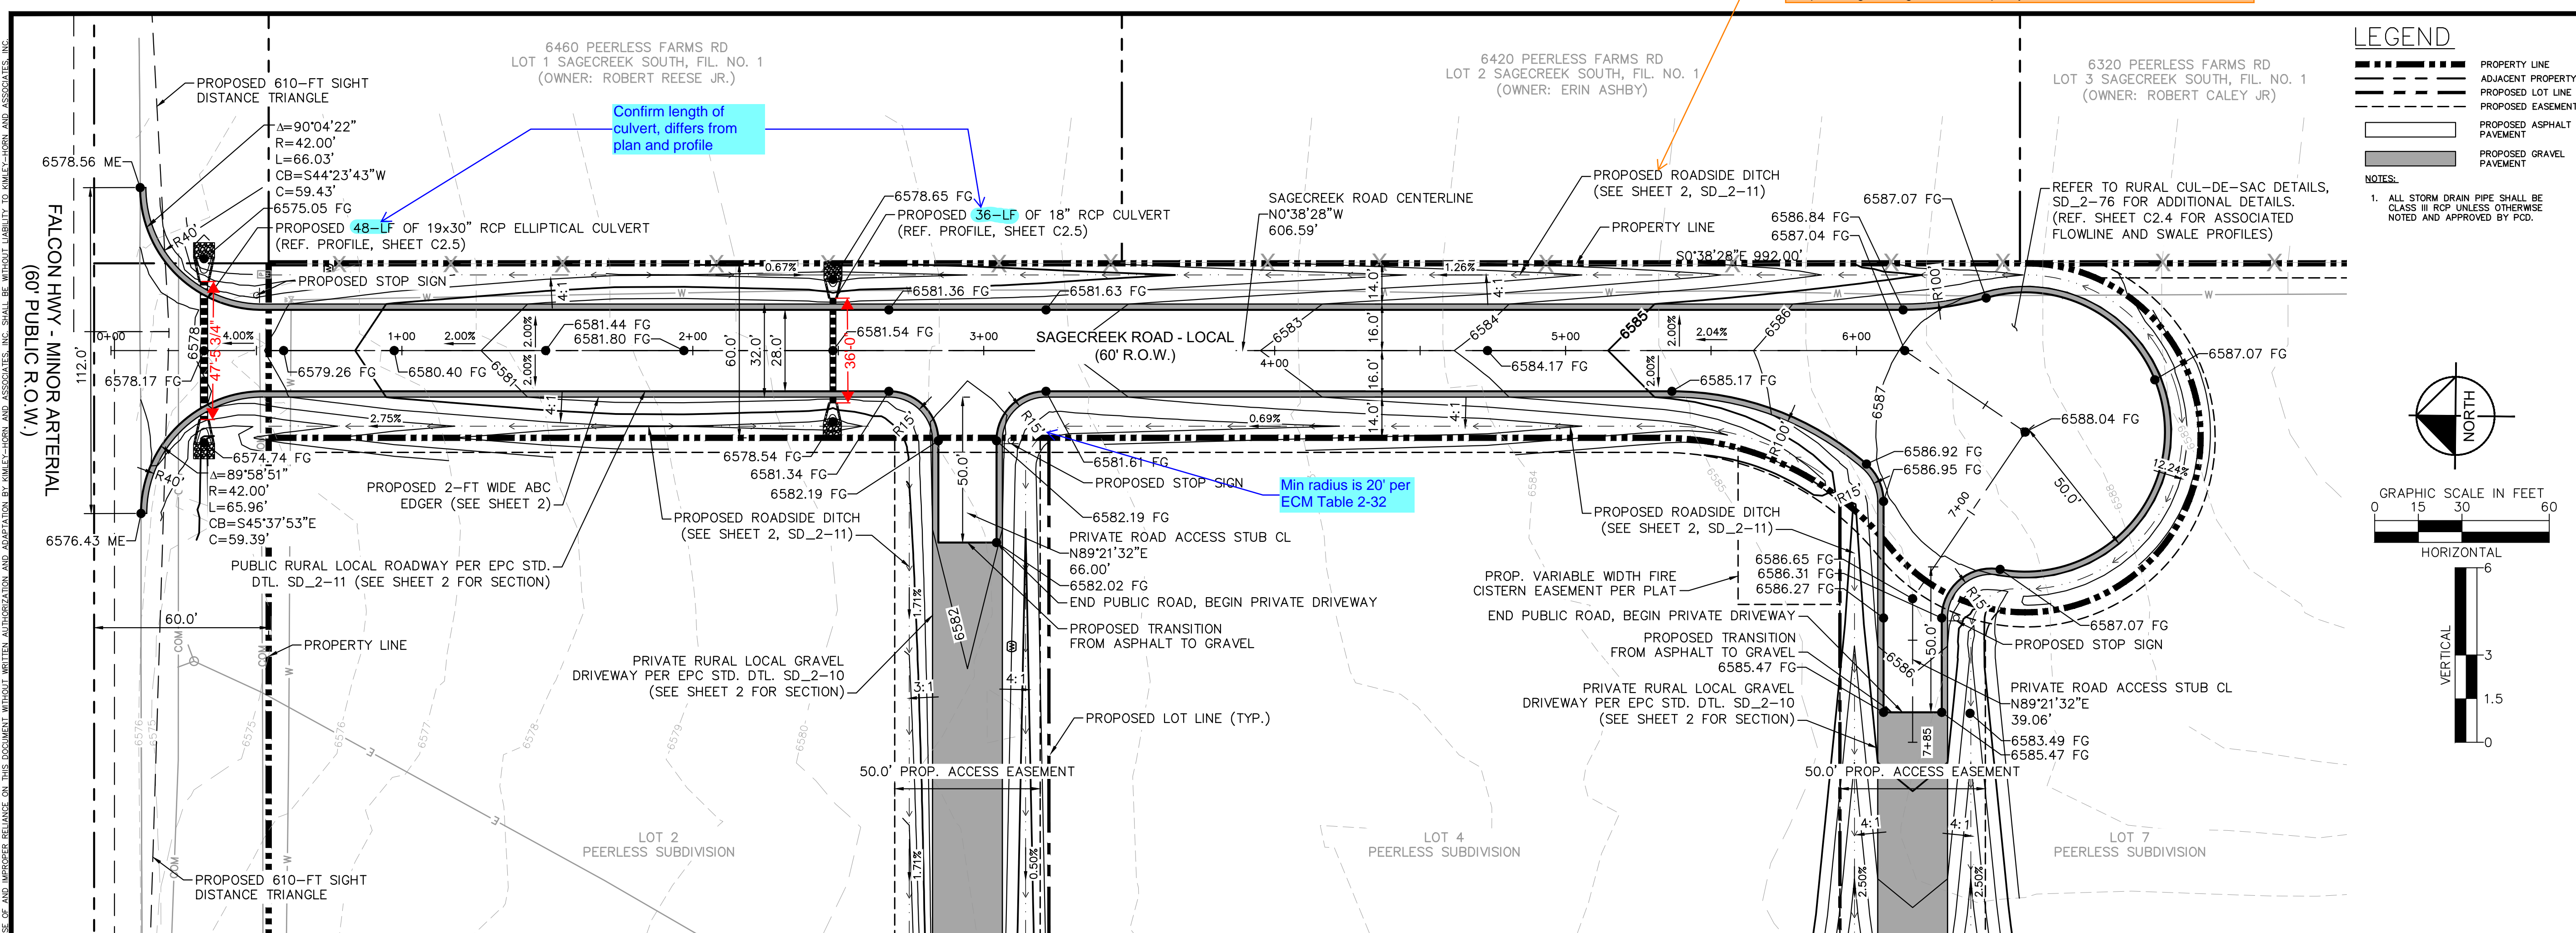


**LEGEND**

- PROPERTY LINE
- ADJACENT PROPERTY LINE
- PROPOSED LOT LINE
- PROPOSED EASEMENT
- PROPOSED ASPHALT PAVEMENT
- PROPOSED GRAVEL PAVEMENT

**NOTES:**

- ALL STORM DRAIN PIPE SHALL BE CLASS II RCP UNLESS OTHERWISE NOTED AND APPROVED BY PCD.

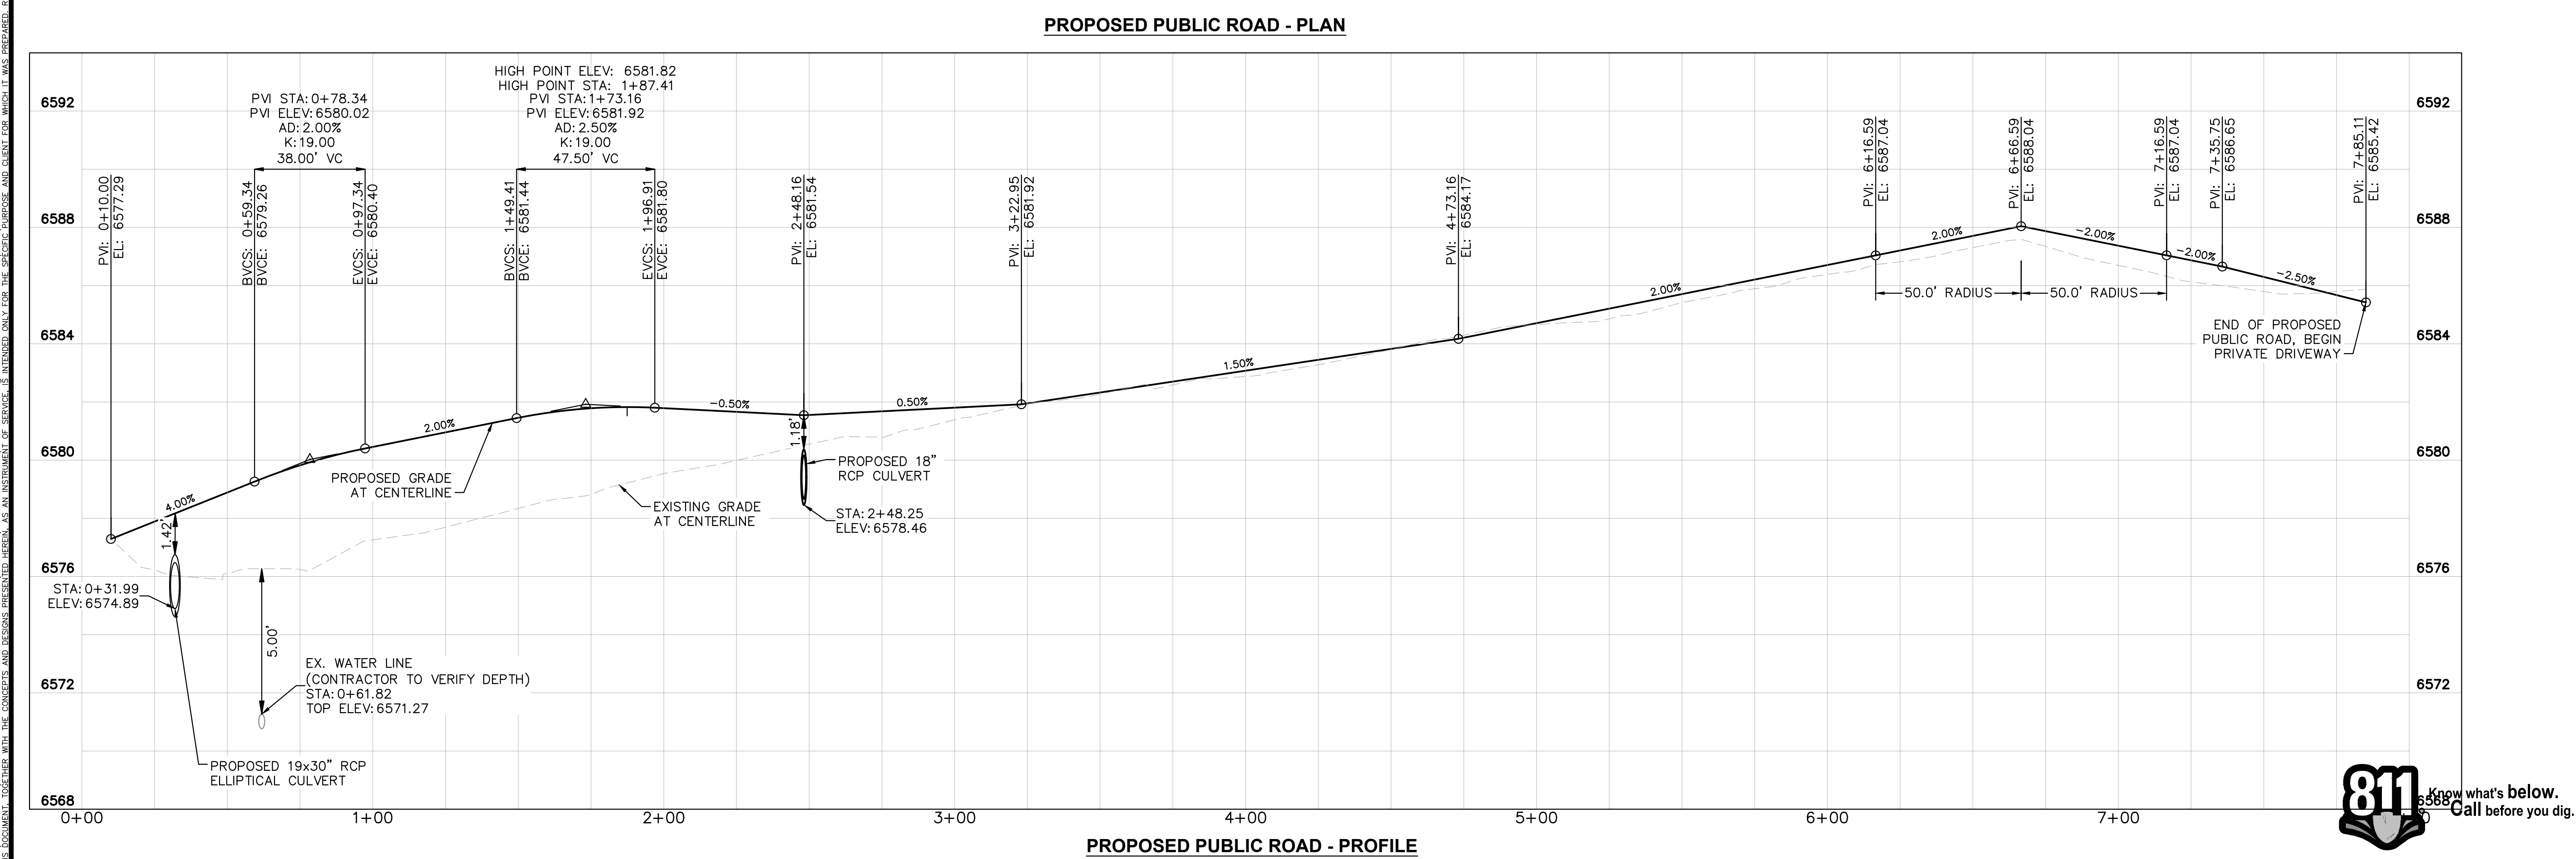

K:\COS\_LA\196114000 - Peerless Farms\CADD\PlanSheets\CD\_RD.dwg - Pelik - Grant - 6/28/2024 10:40 AM

NO.	BY	DATE	APPR

**Kimley»Horn**  
 © 2024, KIMLEY-HORN AND ASSOCIATES, INC.  
 2 N Nevada Avenue, Suite 900  
 Colorado Springs, CO 80903 (719) 453-0180

DESIGNED BY: MOH  
 DRAWN BY: JWM  
 CHECKED BY: MOH  
 DATE: 06/21/2024

**PEERLESS FARMS**  
 EL PASO COUNTY, COLORADO  
 PUBLIC ROADWAY PLAN & PROFILE  
 CONSTRUCTION DOCUMENTS

**PRELIMINARY**  
 FOR REVIEW ONLY  
 NOT FOR CONSTRUCTION


PROJECT NO.  
196114000

DRAWING NAME  
CD\_RD

C2.2



K:\COS-LA\196114000 - Peerless Farms\CA\CD\PlanSheets\CD\_RD.dwg - Petik - Grant - 6/28/2024 10:40 AM  
 THIS DOCUMENT, TOGETHER WITH THE CONCEPTS AND DESIGN PRESENTED HEREIN, IS AN INSTRUMENT OF SERVICE, INTENDED ONLY FOR THE SPECIFIC PURPOSE AND CLIENT FOR WHICH IT WAS PREPARED. REUSE OF AND MISREPRESENTATION OF THIS DOCUMENT WITHOUT WRITTEN AUTHORIZATION AND ASSOCIATES, INC. SHALL BE WITHOUT LIABILITY TO KIMLEY-HORN AND ASSOCIATES, INC.

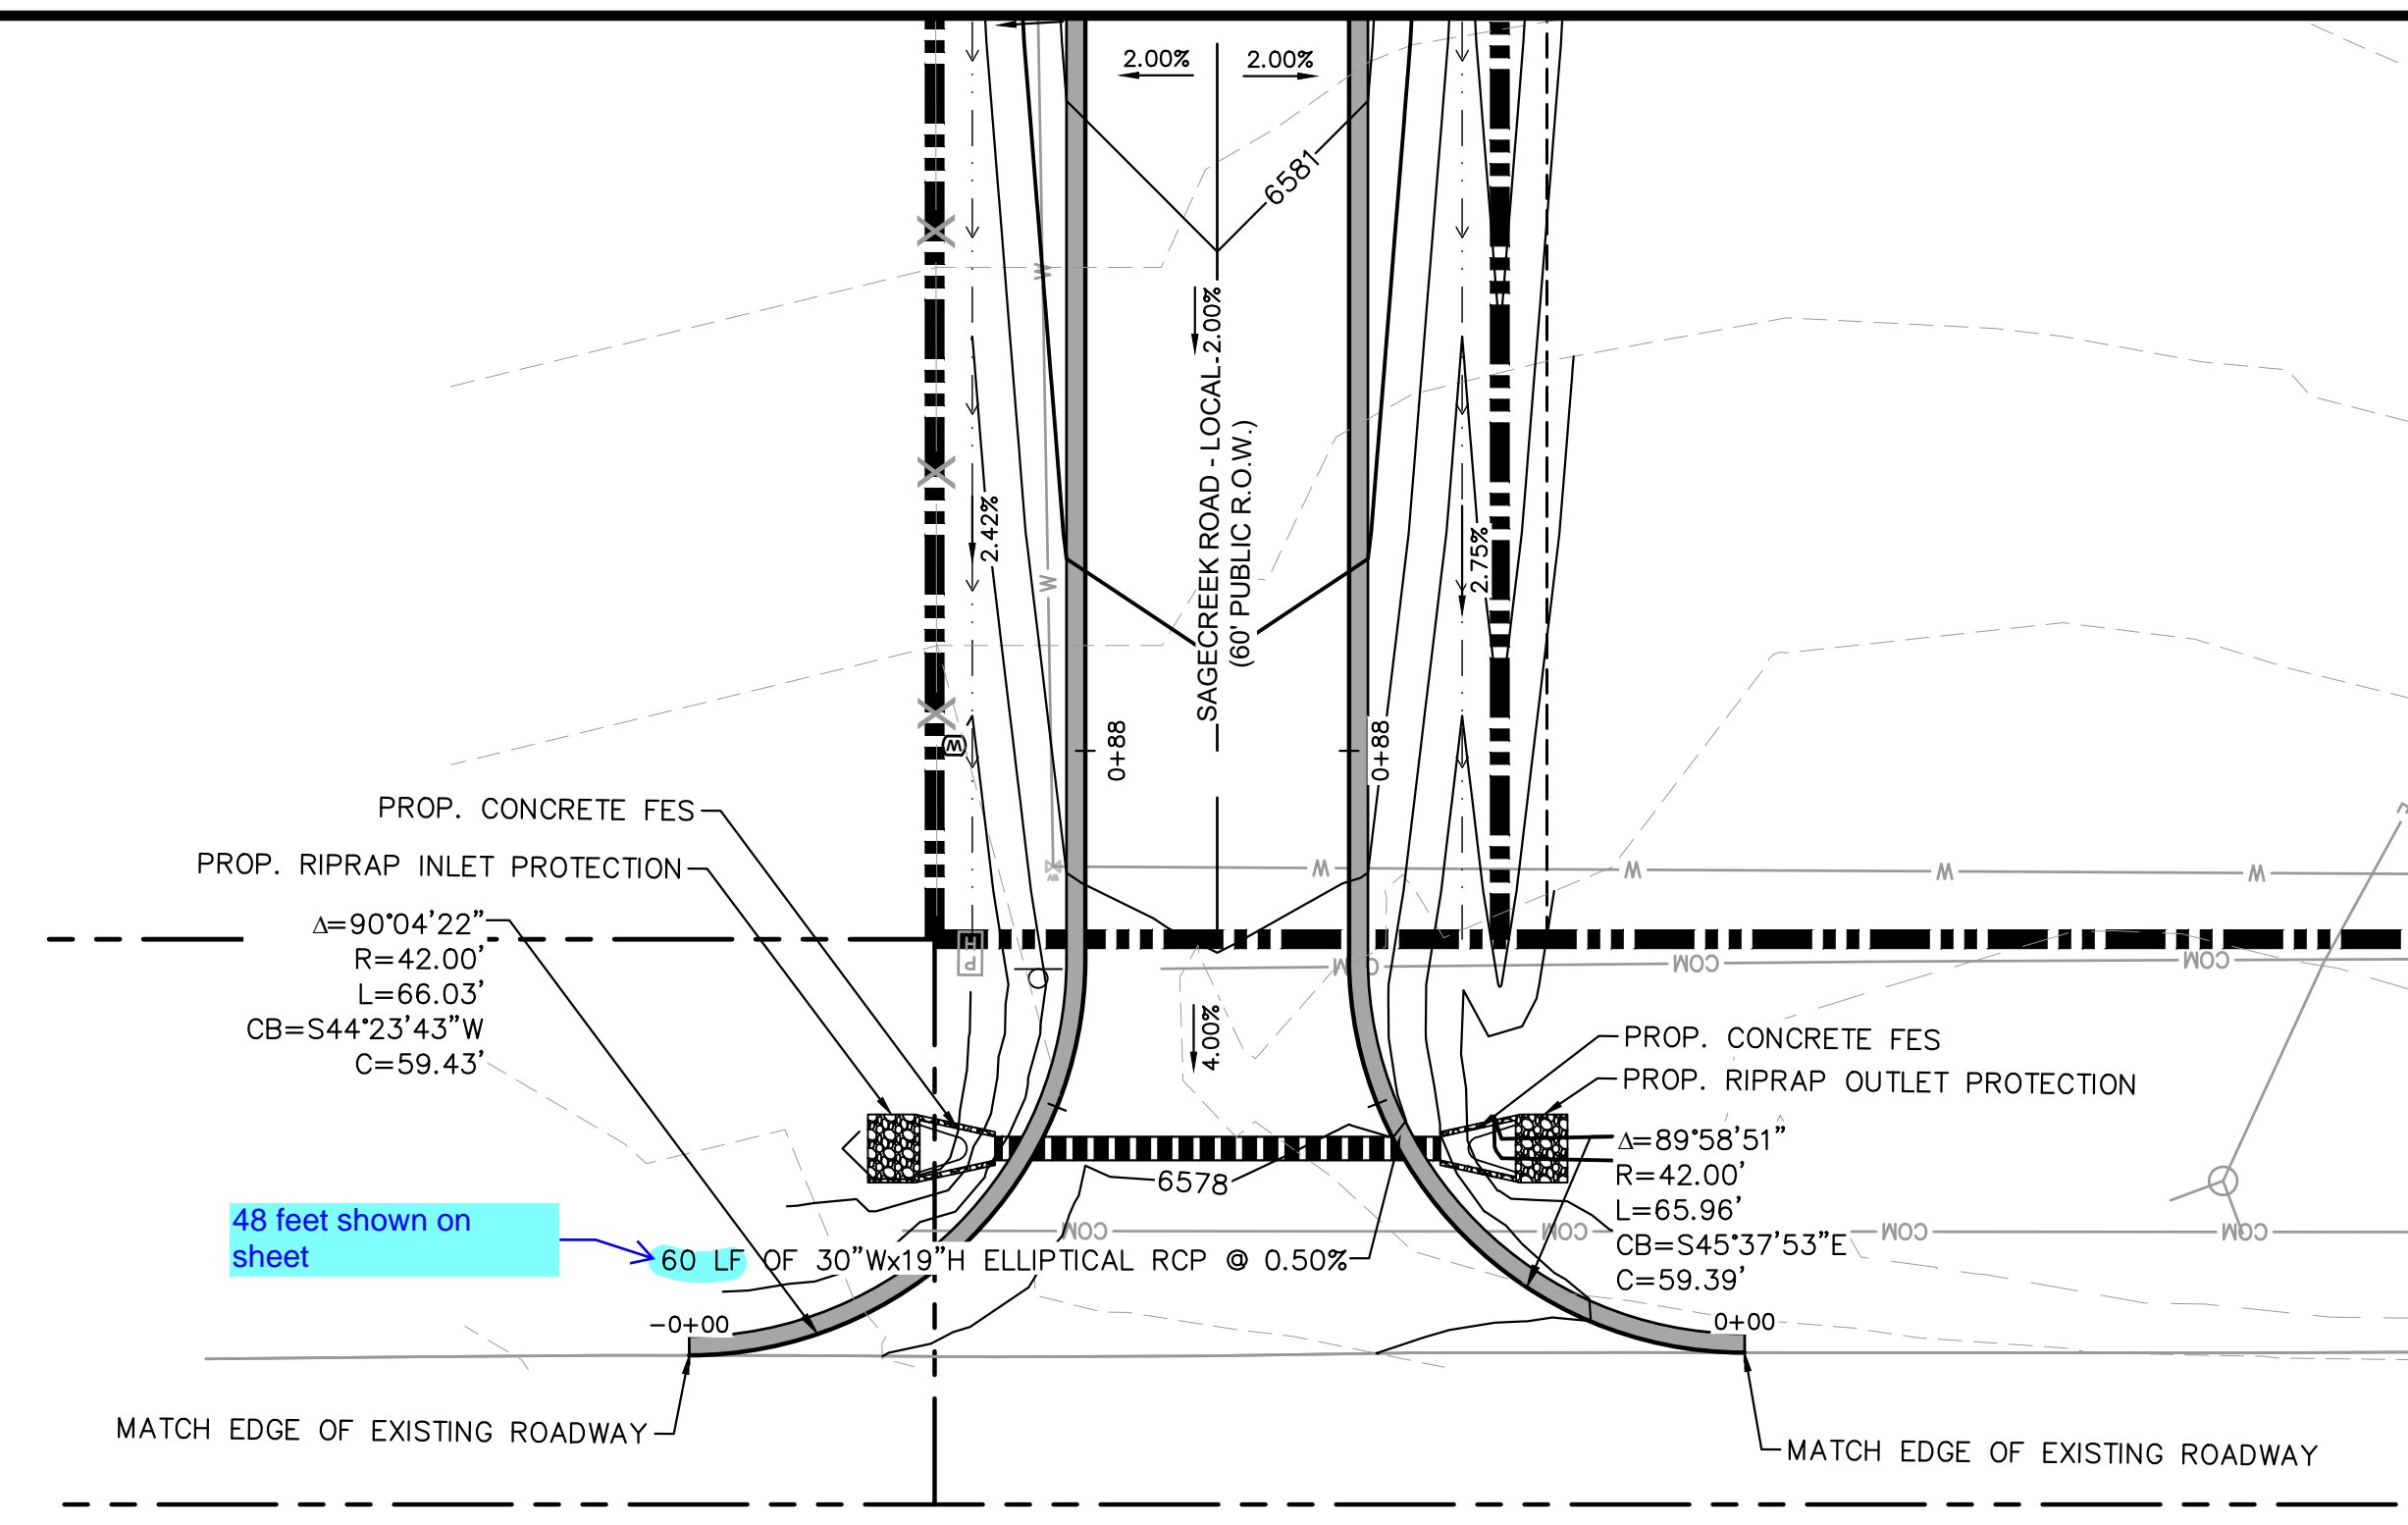

**LEGEND**

- PROPERTY LINE
- ADJACENT PROPERTY LINE
- PROPOSED LOT LINE
- PROPOSED EASEMENT
- PROPOSED ASPHALT PAVEMENT
- PROPOSED GRAVEL PAVEMENT


**NOTES:**

- ALL STORM DRAIN PIPE SHALL BE CLASS III RCP UNLESS OTHERWISE NOTED AND APPROVED BY PCD.


**GRAPHIC SCALE IN FEET**  
 0 10 20 40

**NORTH**

FALCON HWY - MINOR ARTERIAL  
 (60' PUBLIC R.O.W.)  
**PROPOSED PUBLIC CURB RETURNS - PLAN**

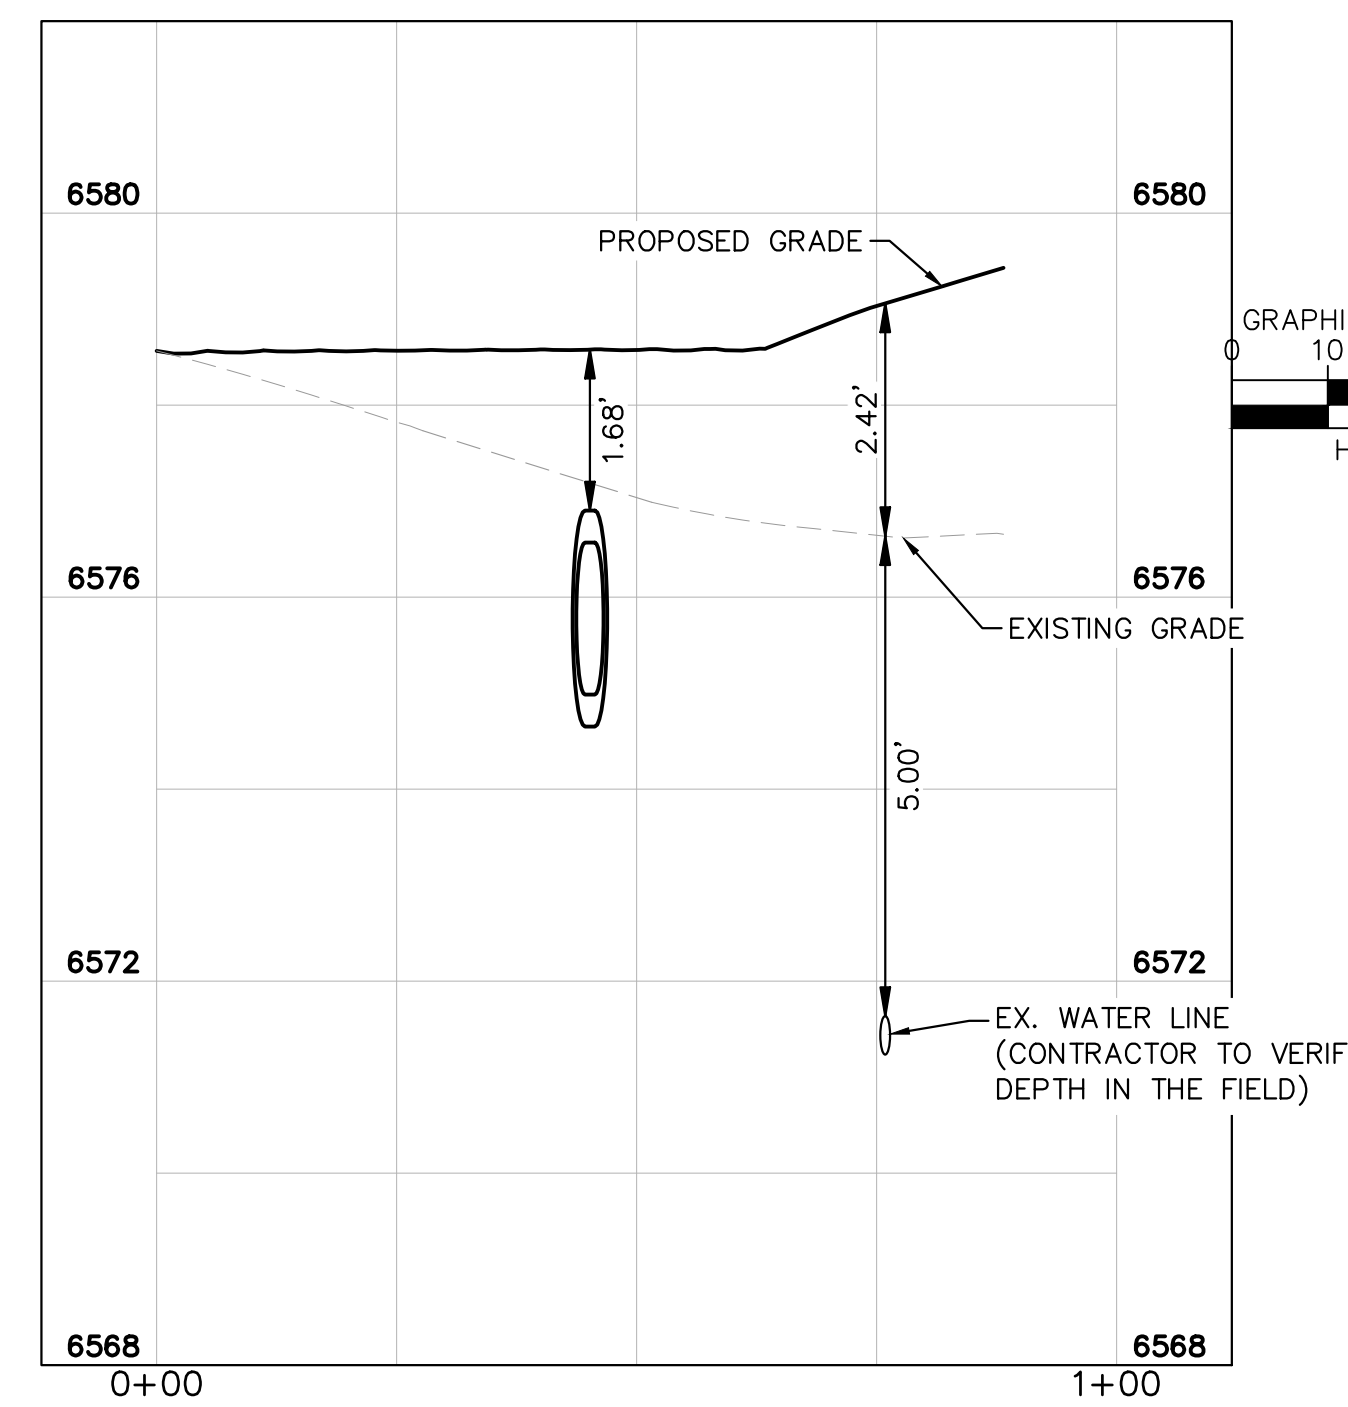

**N CURB RETURN - PROFILE**

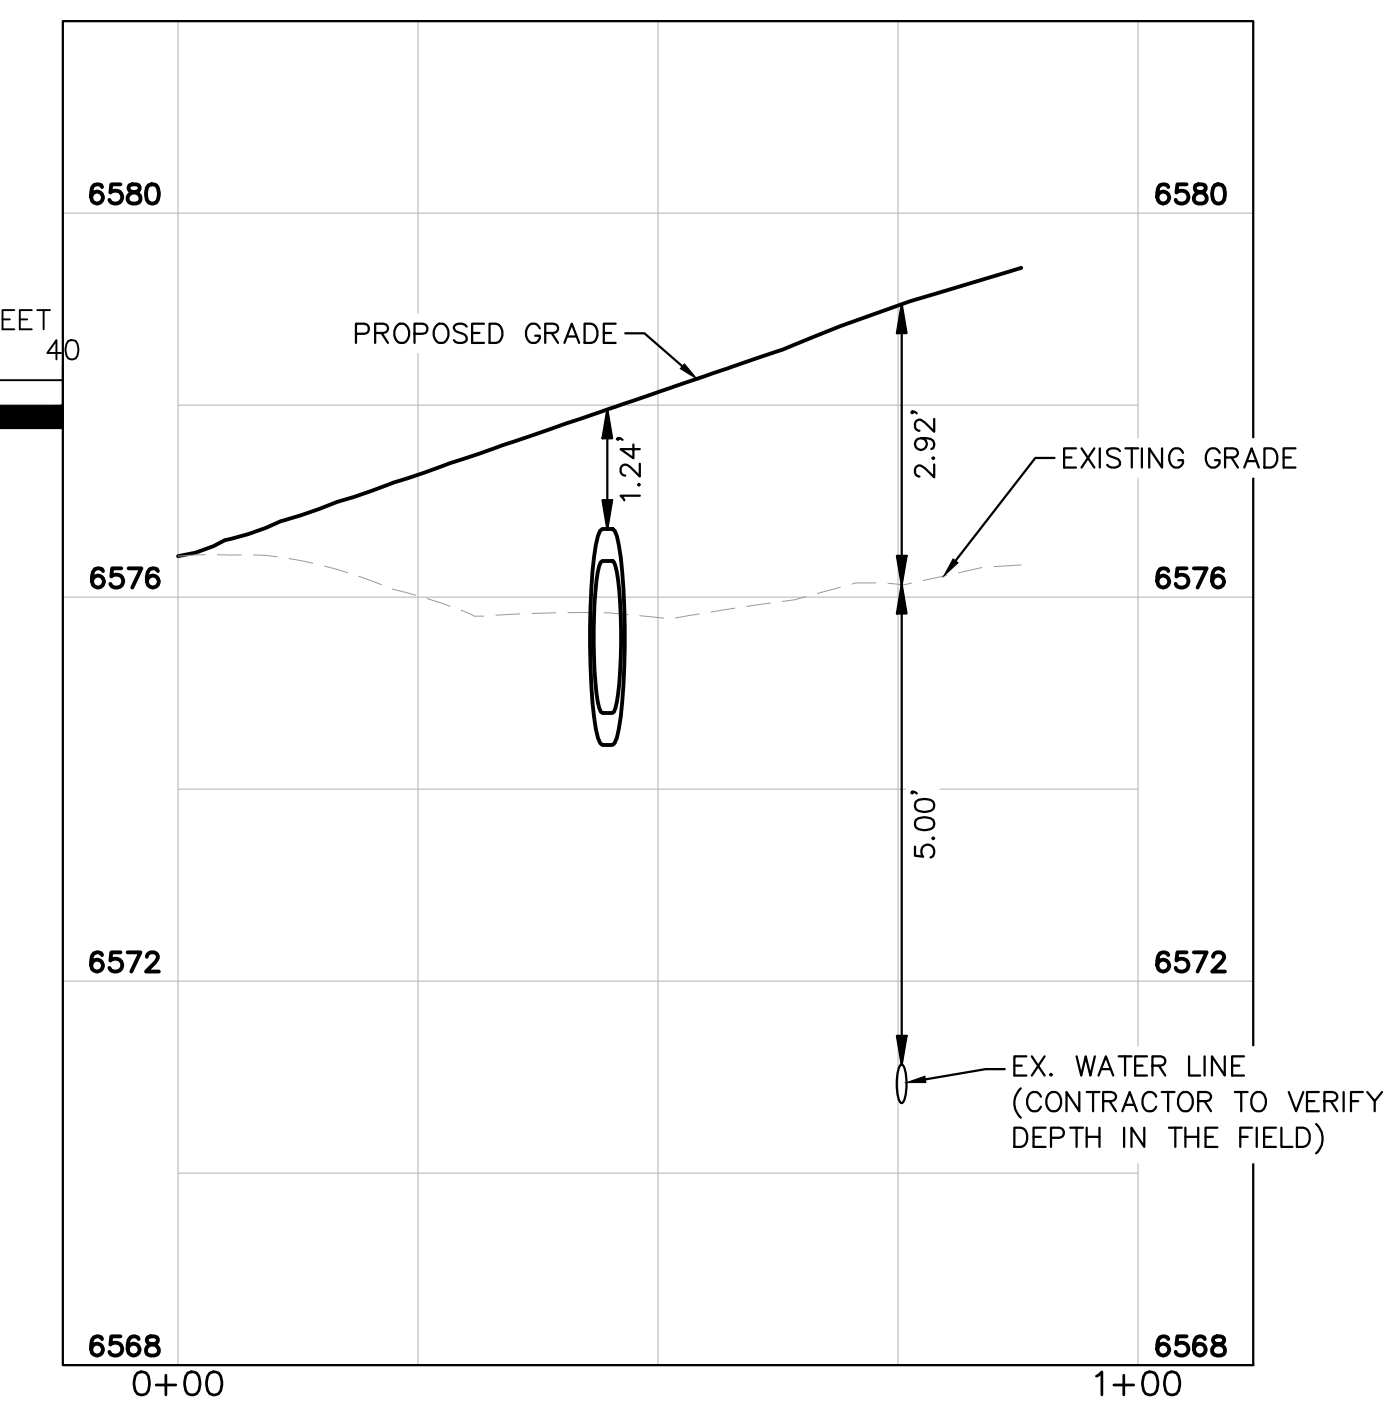

**S CURB RETURN - PROFILE**

NO.	BY	DATE	APPR.

**Kimley»Horn**  
 © 2024, KIMLEY-HORN AND ASSOCIATES, INC.  
 2 N Nevada Avenue, Suite 900  
 Colorado Springs, CO 80903 (719) 453-0180

DESIGNED BY: MOH  
 DRAWN BY: JWM  
 CHECKED BY: MOH  
 DATE: 06/21/2024


PEERLESS FARMS  
 EL PASO COUNTY, COLORADO  
 CURB RETURN PLAN & PROFILES  
 CONSTRUCTION DOCUMENTS

PRELIMINARY  
 FOR REVIEW ONLY  
 NOT FOR  
 CONSTRUCTION  
**Kimley»Horn**  
 Kimley-Horn and Associates, Inc.

PROJECT NO.  
 196114000  
 DRAWING NAME  
 CD\_RD  
 C2.3



K:\COS\LA\196114000 - Peerless Farms\CA\CD\PlanSheets\CD\_RD.dwg - Petik, Grant 6/28/2024 10:40 AM  
 THIS DOCUMENT, TOGETHER WITH THE CONCEPTS AND DESIGN PRESENTED HEREIN, IS AN INSTRUMENT OF SERVICE INTENDED ONLY FOR THE SPECIFIC PROJECT AND CLIENT FOR WHICH IT WAS PREPARED. REUSE OF AND MISREPRESENTATION OF THIS DOCUMENT WITHOUT WRITTEN AUTHORIZATION AND ADAPTATION BY KIMLEY-HORN AND ASSOCIATES, INC. SHALL BE WITHOUT LIABILITY TO KIMLEY-HORN AND ASSOCIATES, INC.




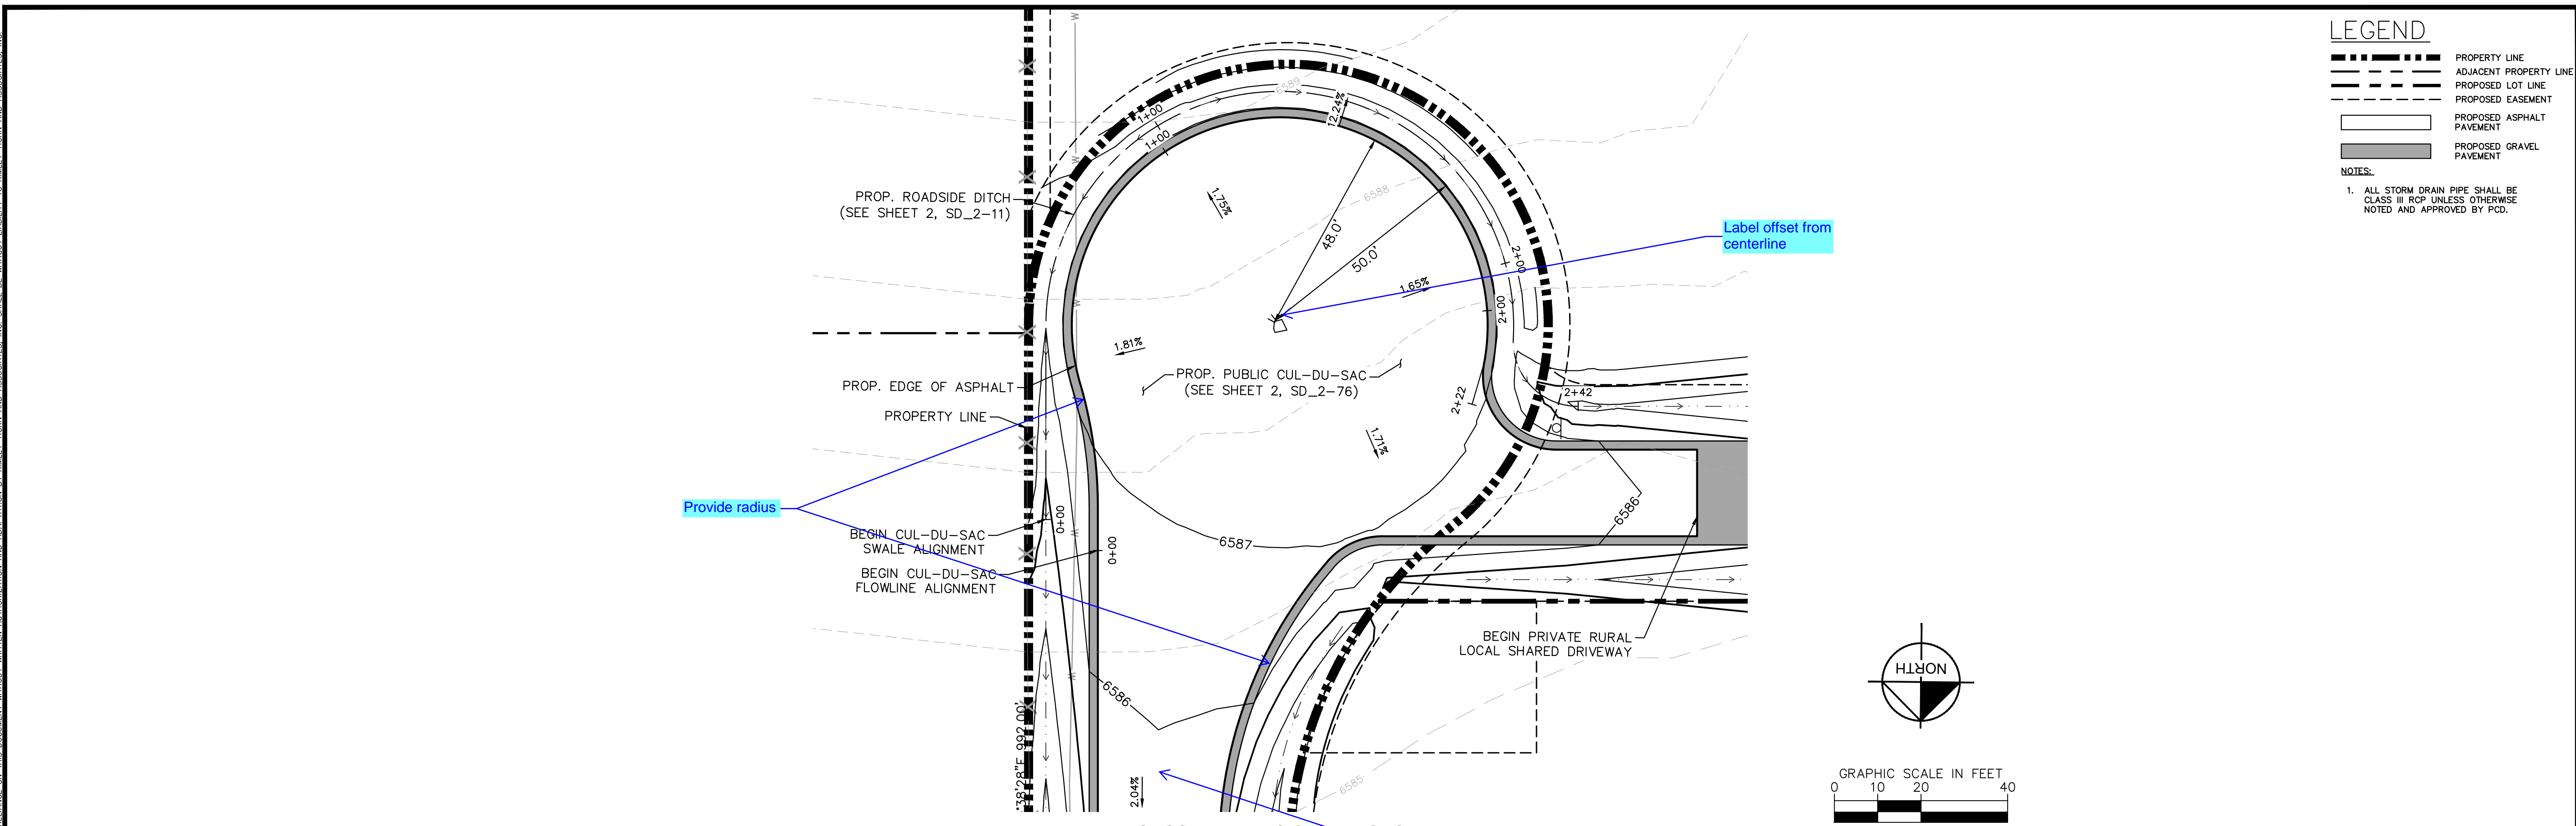


**LEGEND**

	PROPERTY LINE
	ADJACENT PROPERTY LINE
	PROPOSED LOT LINE
	PROPOSED EASEMENT
	PROPOSED ASPHALT PAVEMENT
	PROPOSED GRAVEL PAVEMENT

**NOTES:**

- ALL STORM DRAIN PIPE SHALL BE CLASS III RCP UNLESS OTHERWISE NOTED AND APPROVED BY PCD.

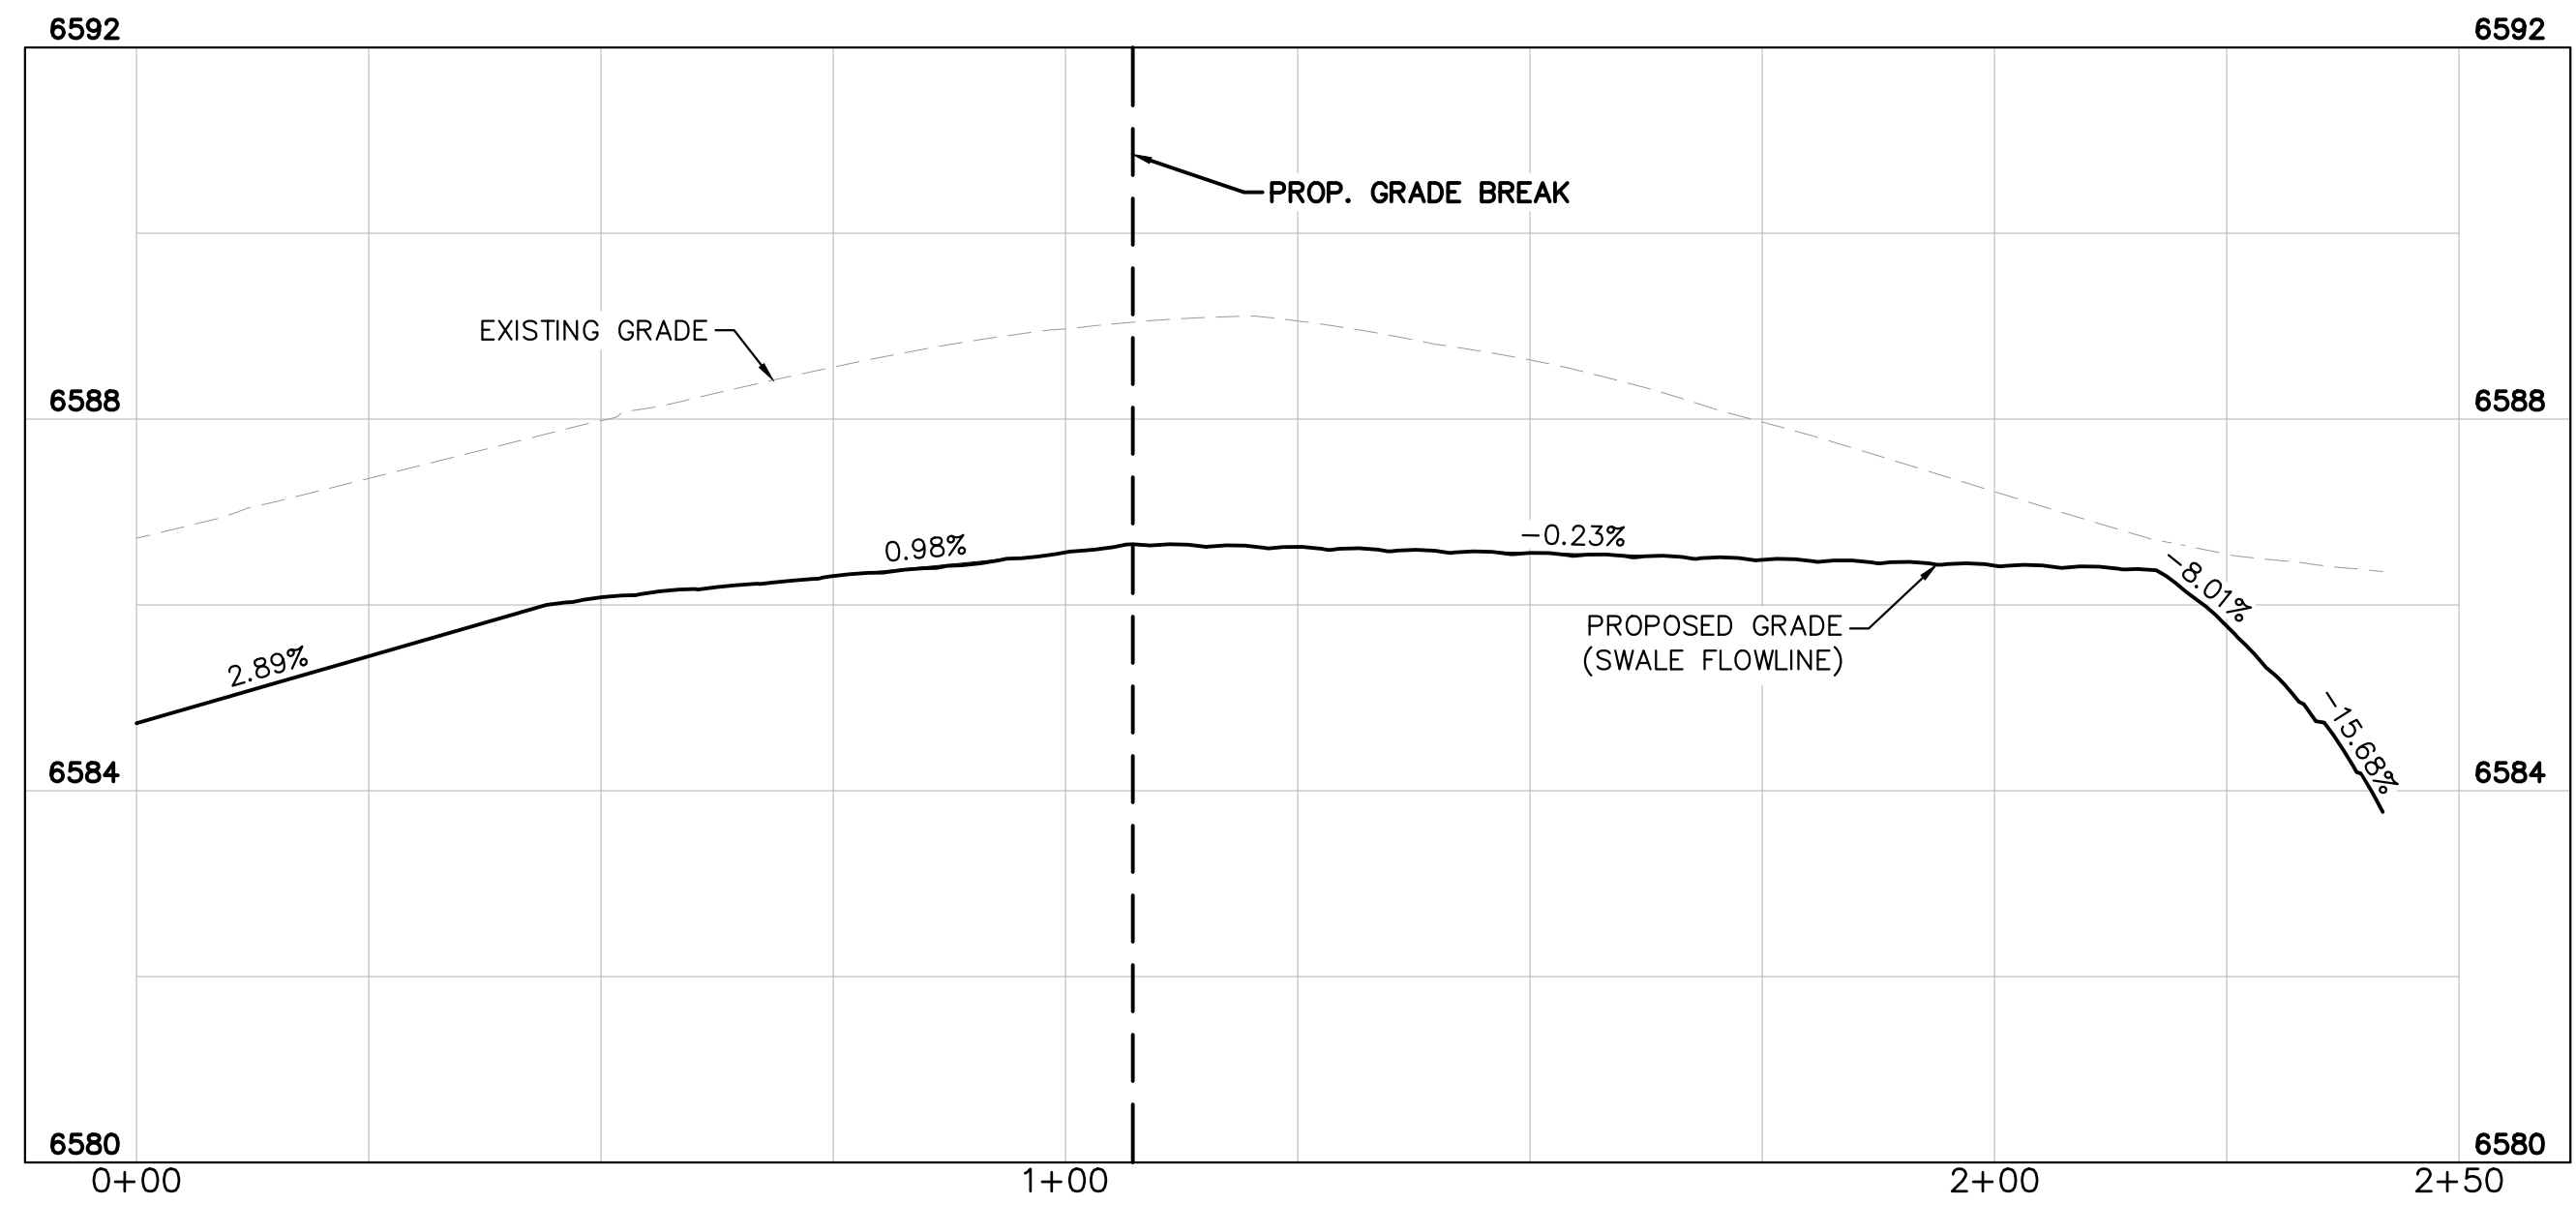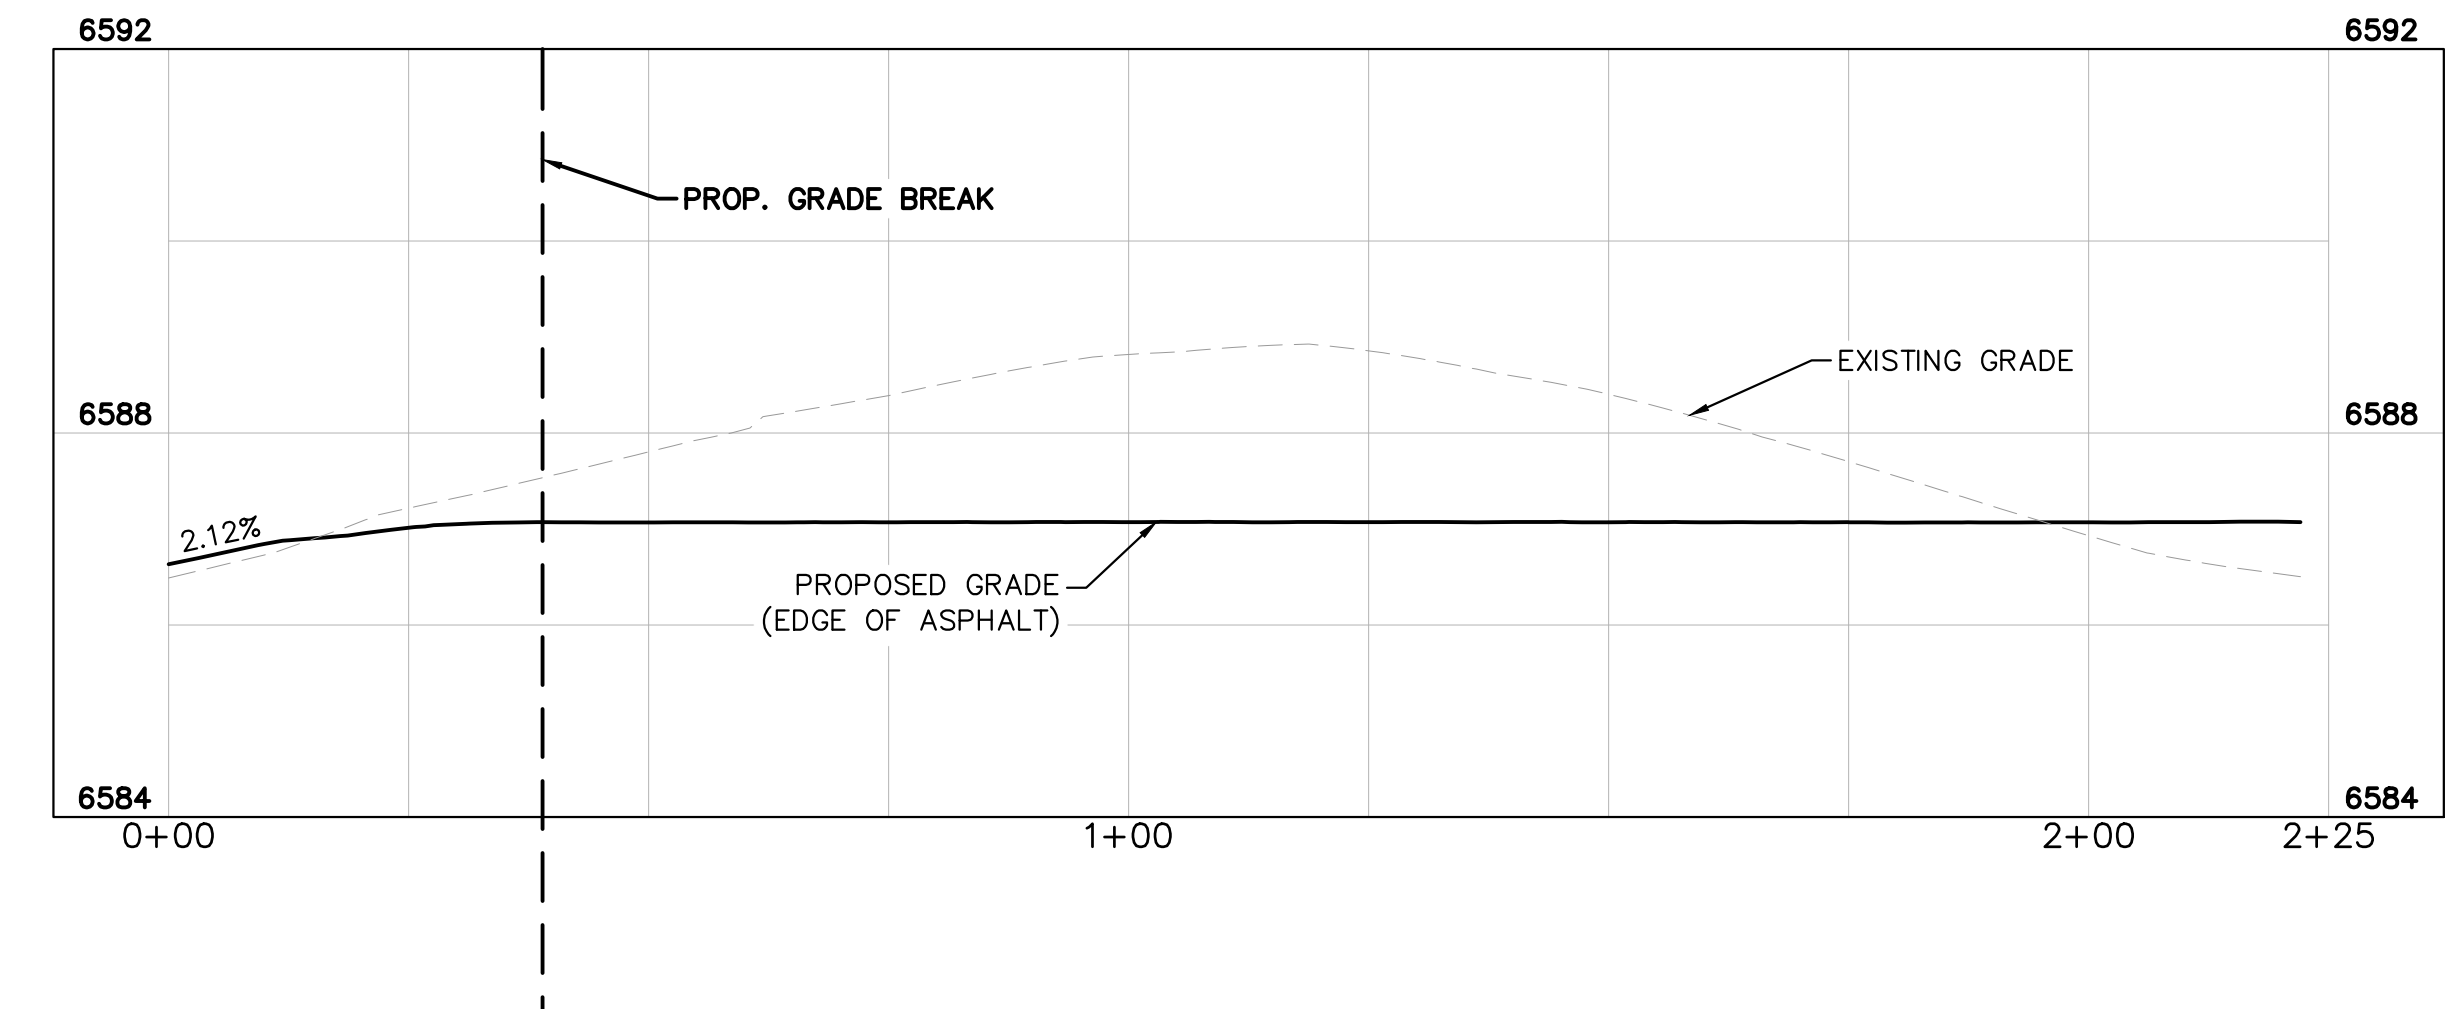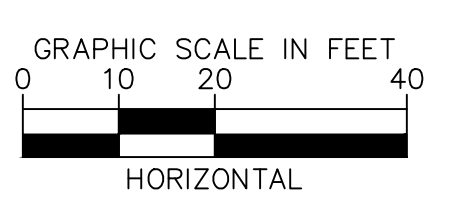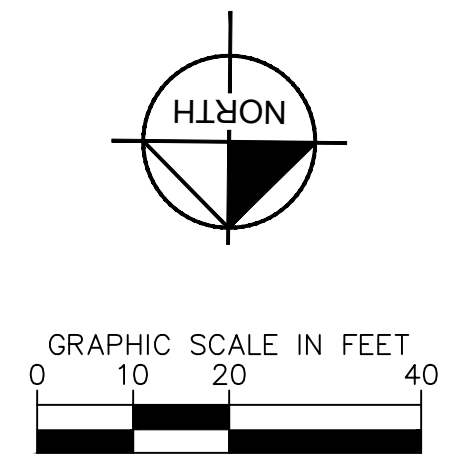

NO.	BY	DATE	APPR

**Kimley»Horn**  
 © 2024, KIMLEY-HORN AND ASSOCIATES, INC.  
 2 N Nevada Avenue, Suite 900  
 Colorado Springs, CO 80903 (719) 453-0180

DESIGNED BY: MOH  
 DRAWN BY: JWM  
 CHECKED BY: MOH  
 DATE: 06/21/2024


PEERLESS FARMS  
 EL PASO COUNTY, COLORADO  
 CUL-DU-SAC PLAN & PROFILE  
 CONSTRUCTION DOCUMENTS

PRELIMINARY  
 FOR REVIEW ONLY  
 NOT FOR  
 CONSTRUCTION  
**Kimley»Horn**  
 Kimley-Horn and Associates, Inc.


PROJECT NO.  
196114000  
 DRAWING NAME  
CD\_RD  
 C2.4



K:\COS-LA\196114000 - Peerless Farms\CADD\PlanSheets\CD\_RD.dwg - Plot: Cont 6/28/2024 10:40 AM  
 THIS DOCUMENT, TOGETHER WITH THE CONCEPTS AND DESIGNS PRESENTED HEREIN, IS AN INSTRUMENT OF SERVICE AND SHALL BE WITHOUT LIABILITY TO KIMLEY-HORN AND ASSOCIATES, INC.

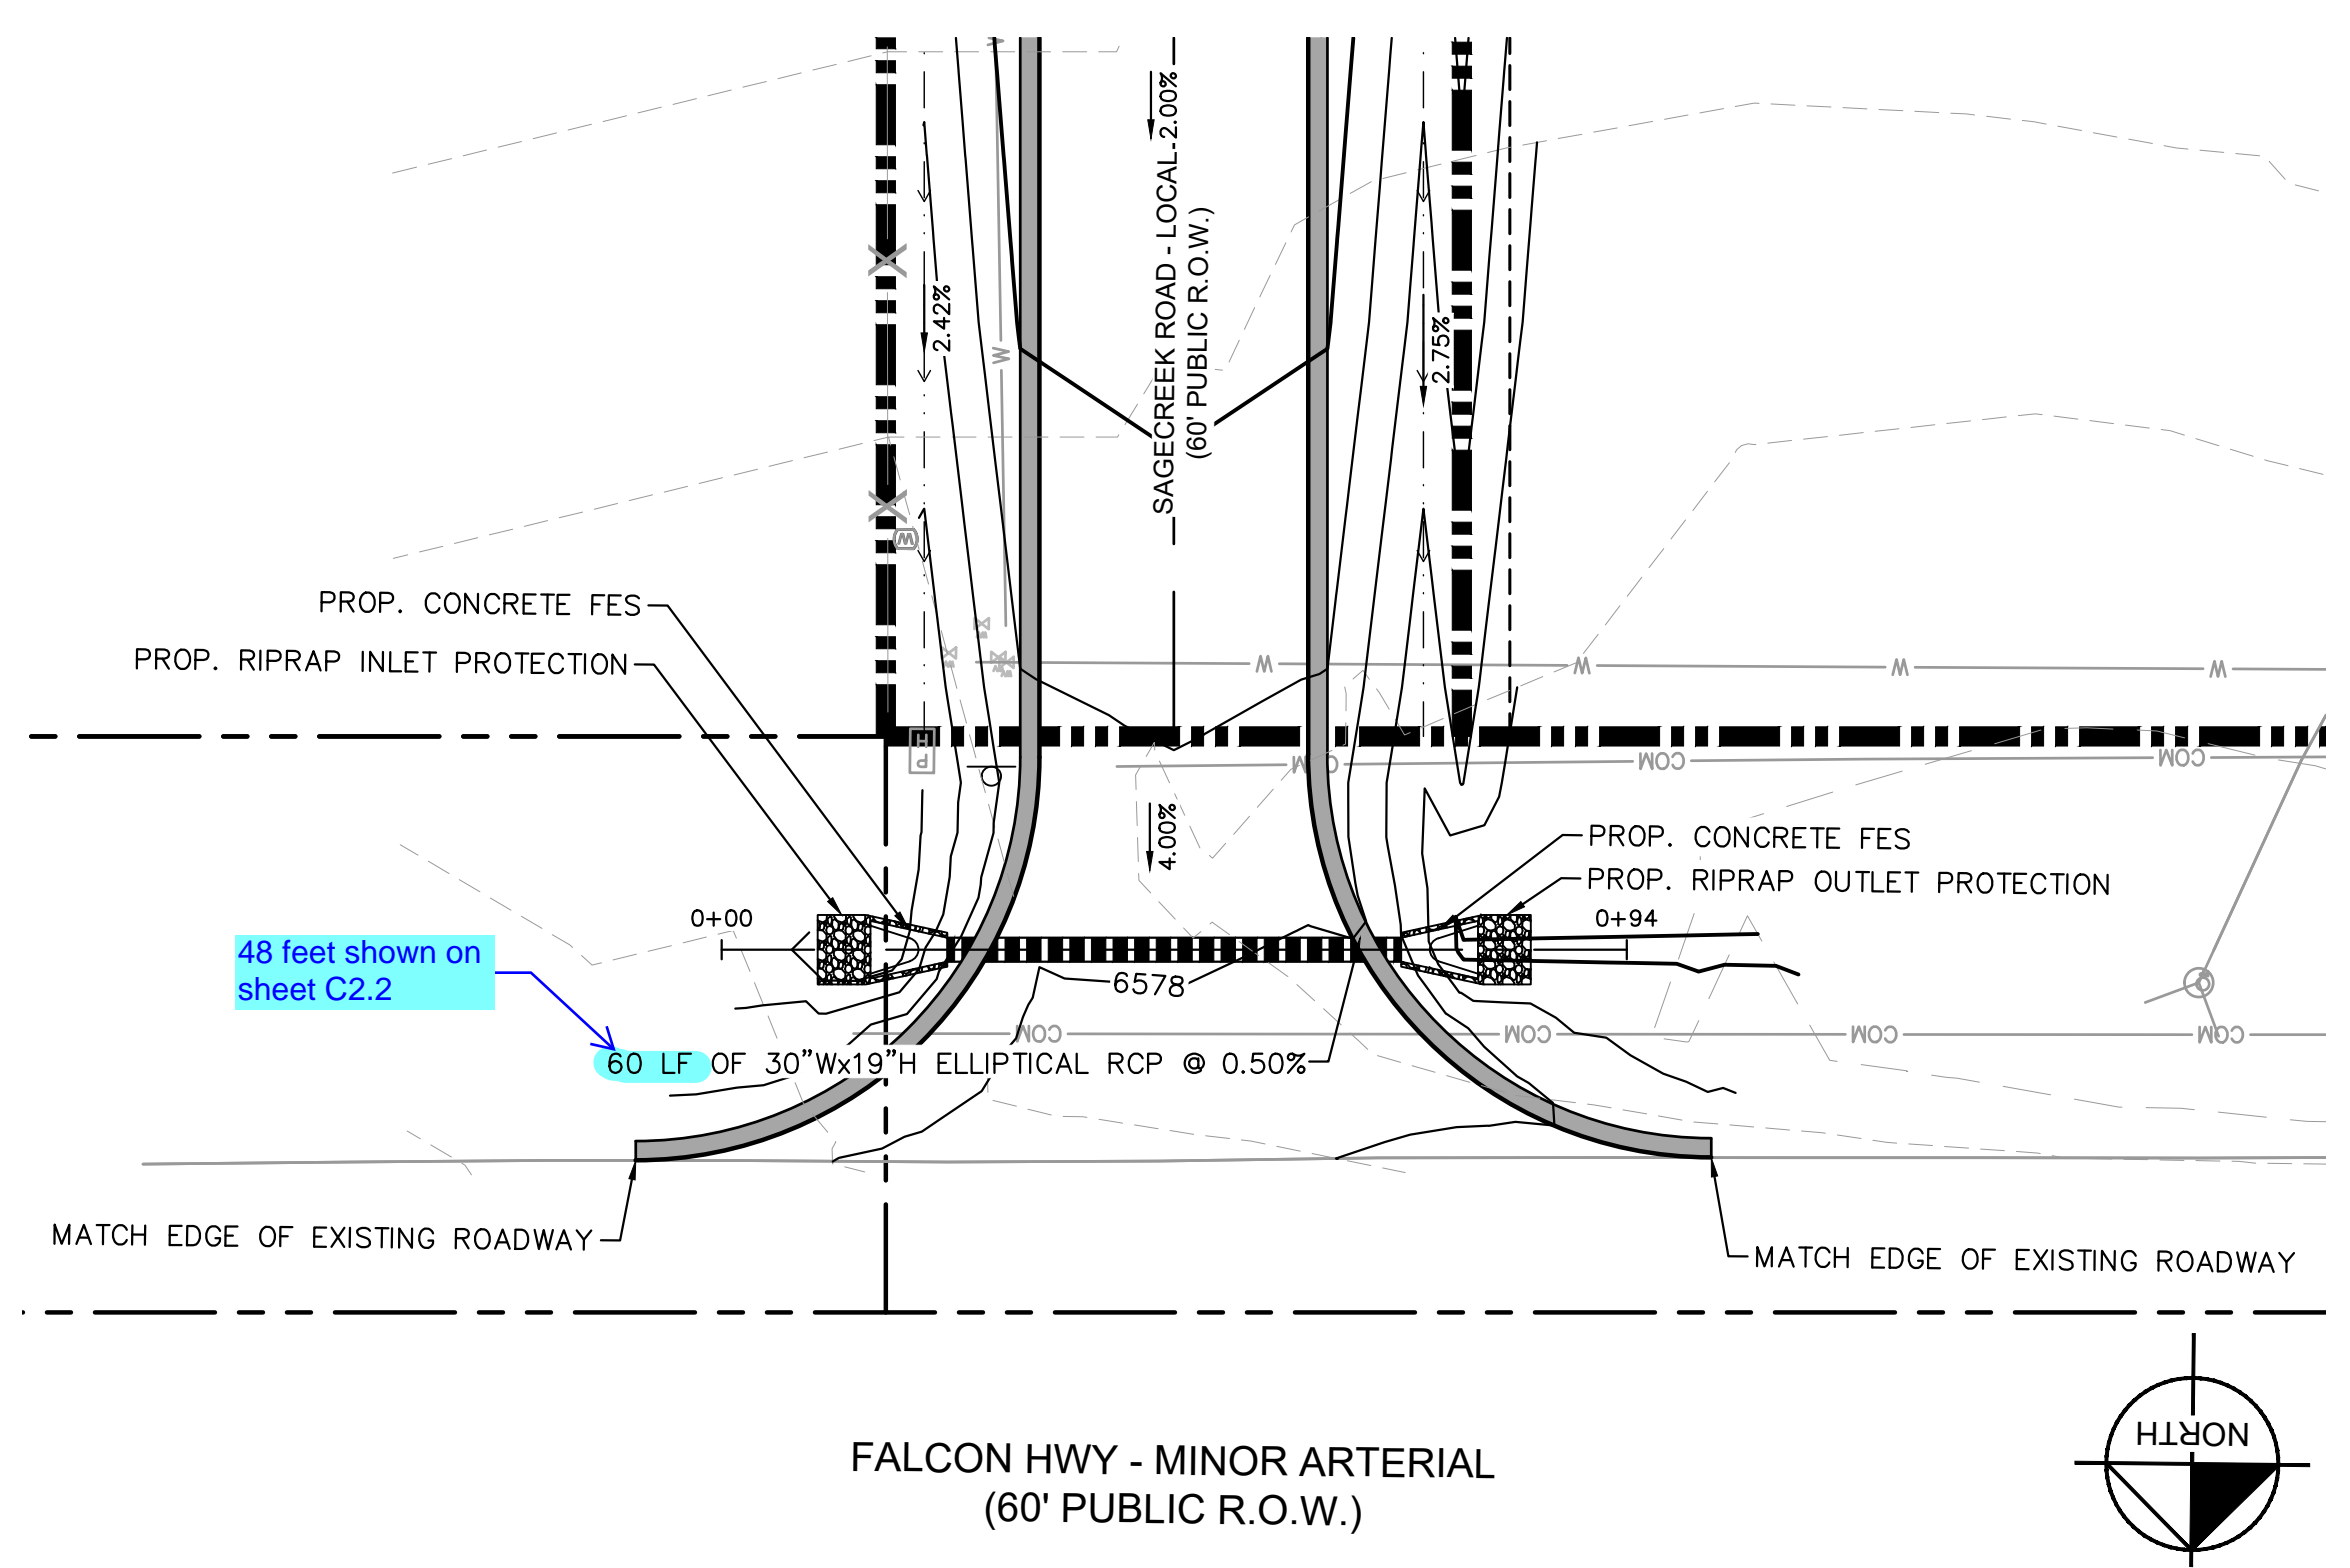

**PROPOSED N CULVERT - PLAN**

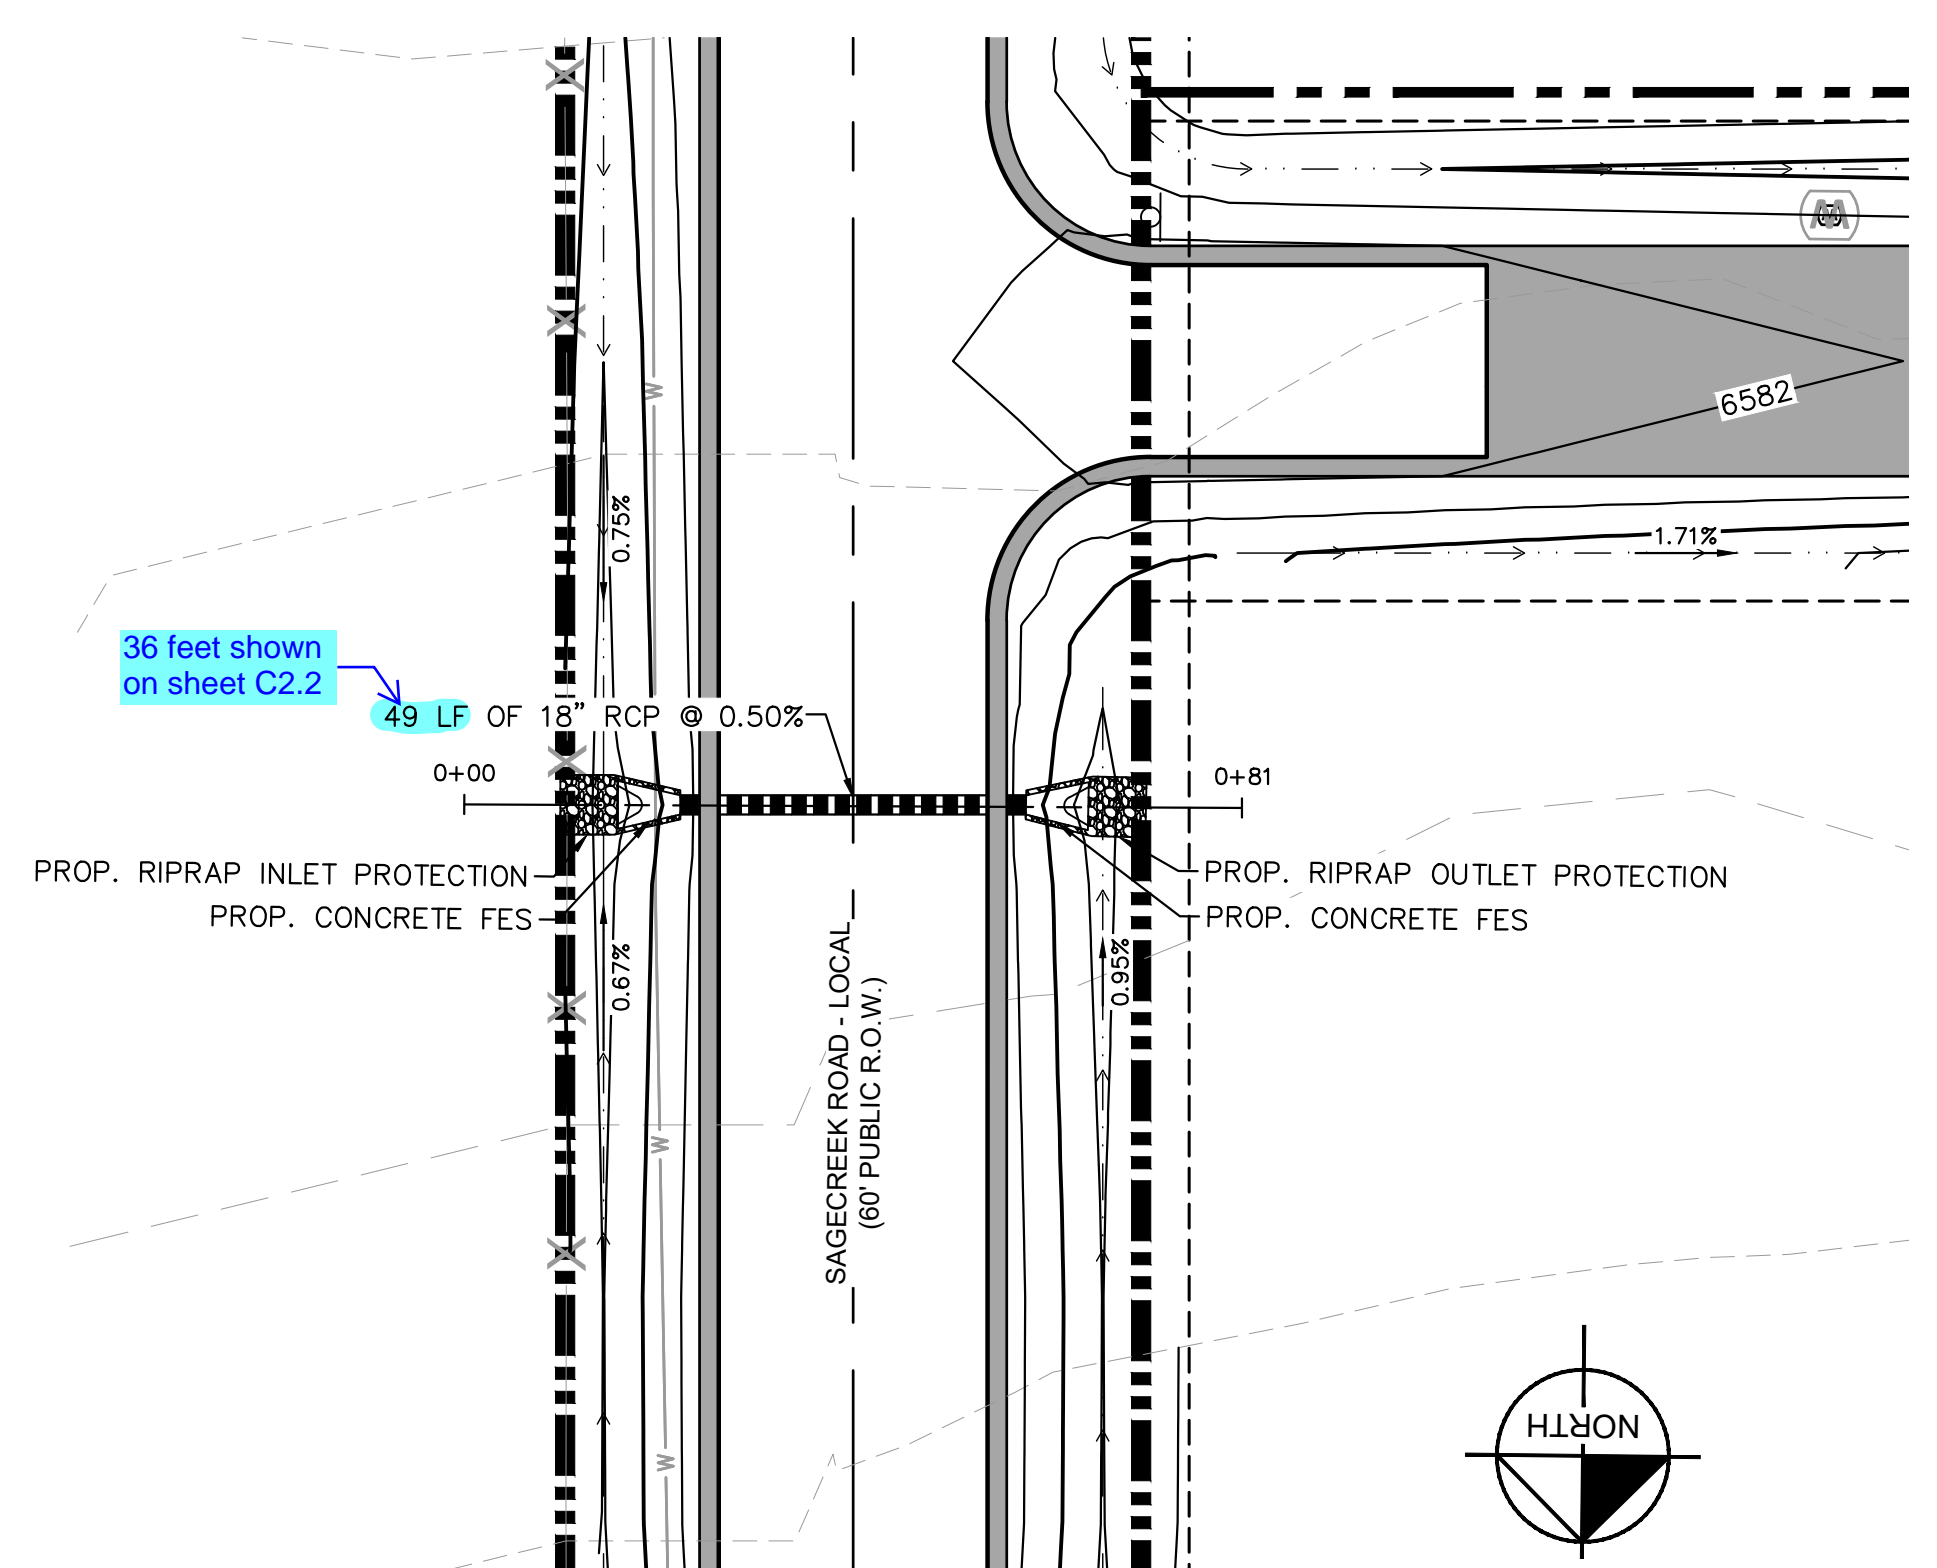




**PROPOSED S CULVERT - PLAN**

**LEGEND**


- PROPERTY LINE
- ADJACENT PROPERTY LINE
- PROPOSED LOT LINE
- PROPOSED EASEMENT
- PROPOSED ASPHALT PAVEMENT
- PROPOSED GRAVEL PAVEMENT

**NOTES:**


- ALL STORM DRAIN PIPE SHALL BE CLASS III RCP UNLESS OTHERWISE NOTED AND APPROVED BY PCD.

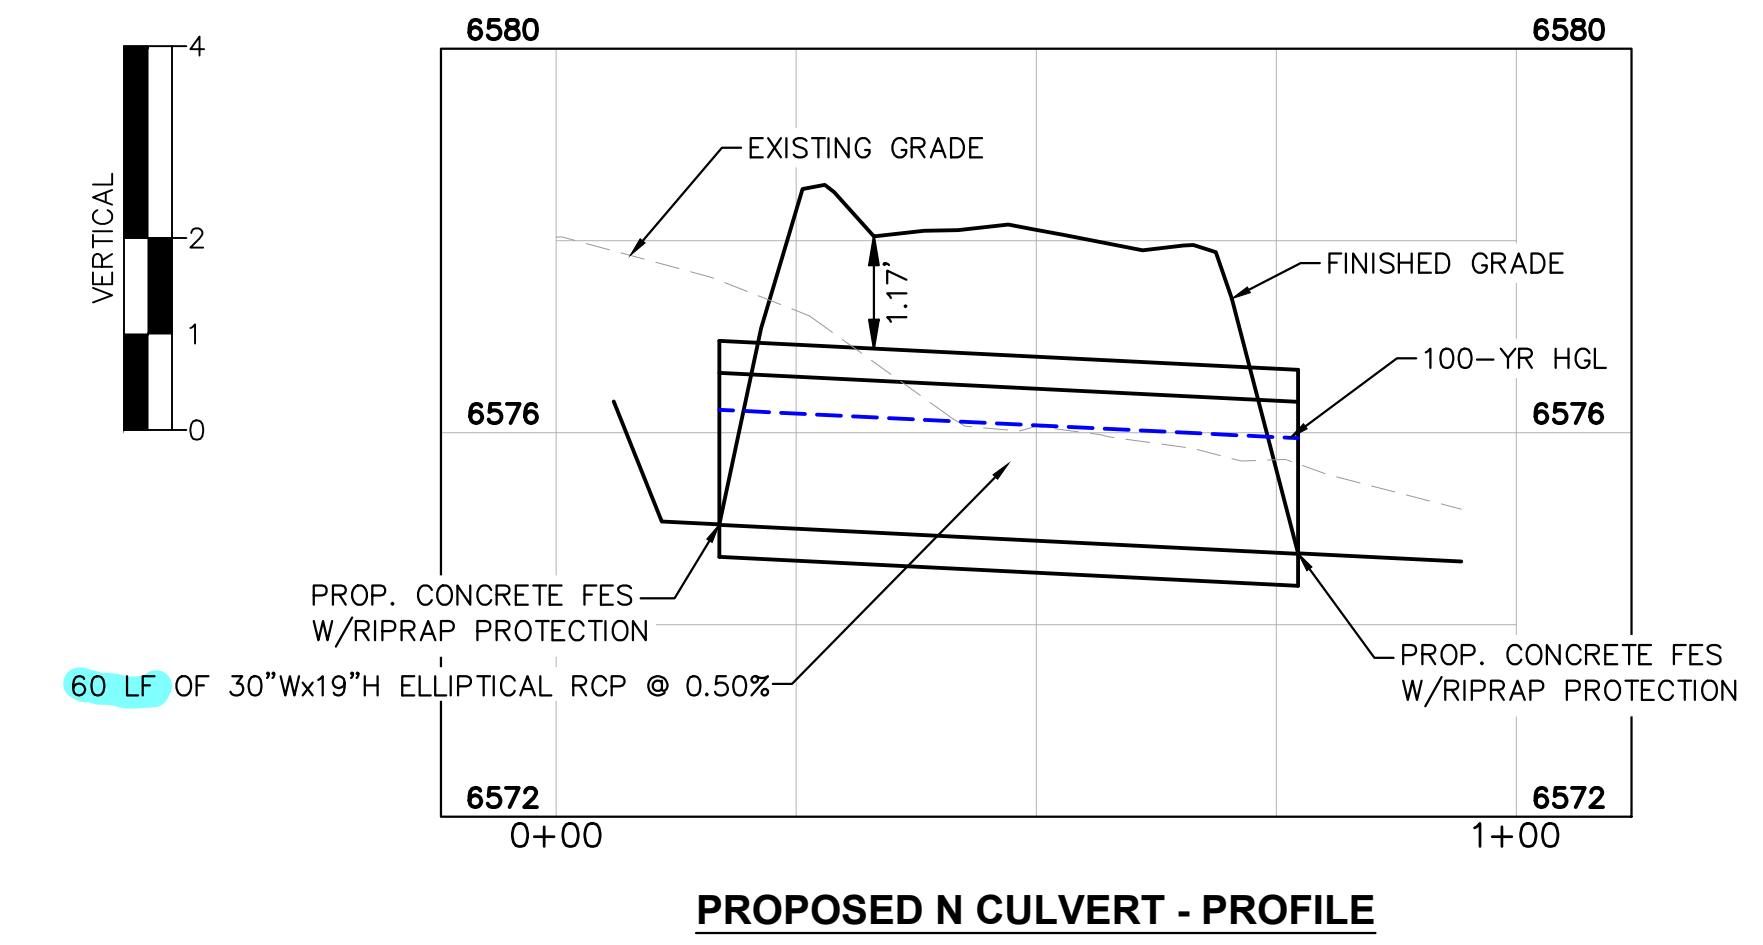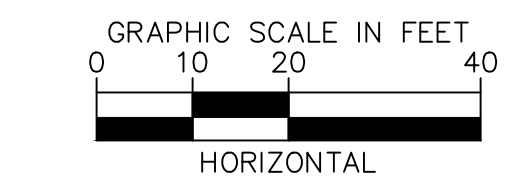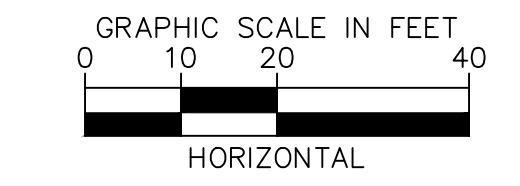

**PROPOSED N CULVERT - PROFILE**

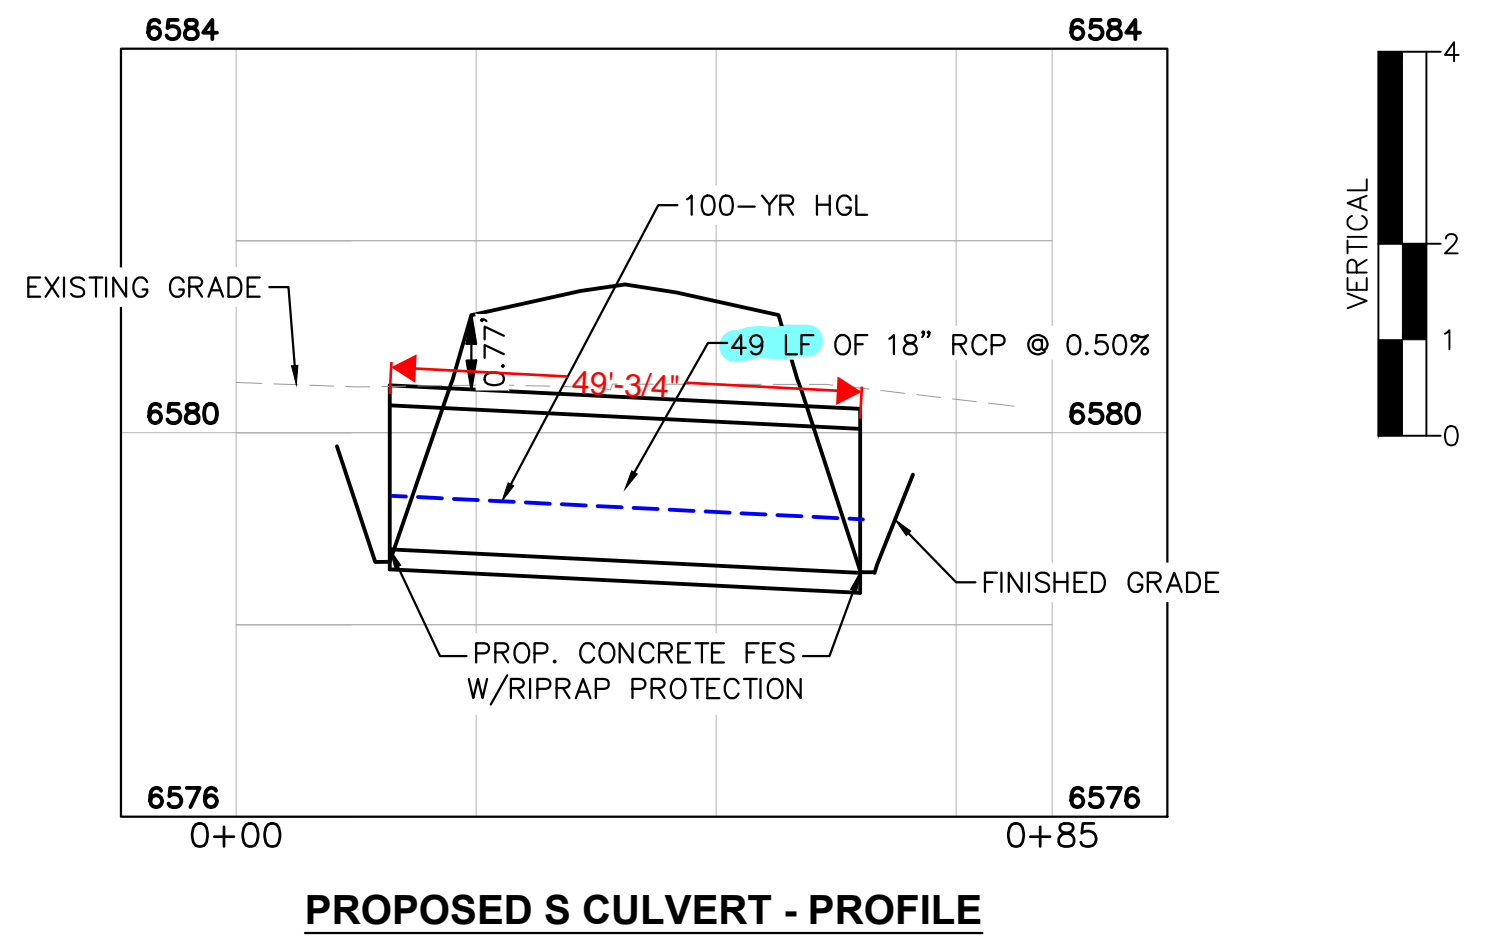

**PROPOSED S CULVERT - PROFILE**

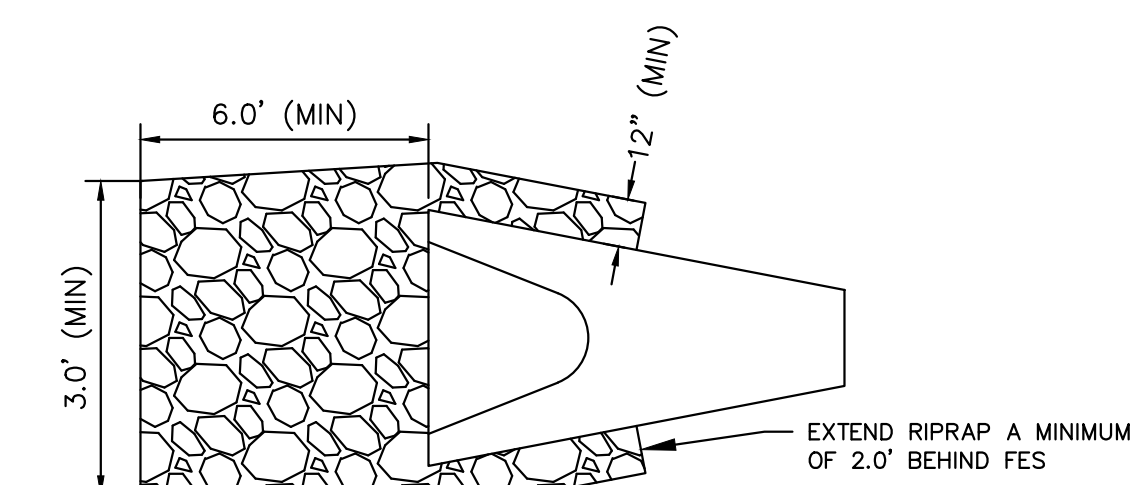

**PERMANENT CULVERT INLET/OUTLET PROTECTION DETAIL**

\*RIPRAP PROTECTION TO BE 18" THICK TYPE L RIPRAP (D50 = 9")

NO.	BY	DATE	APPR

**Kimley-Horn**  
 © 2024, KIMLEY-HORN AND ASSOCIATES, INC.  
 2 N Nevada Avenue, Suite 900  
 Colorado Springs, CO 80903 (719) 453-0180

DESIGNED BY: MOH  
 DRAWN BY: JWM  
 CHECKED BY: MOH  
 DATE: 06/21/2024

**PEERLESS FARMS**  
 EL PASO COUNTY, COLORADO  
 CULVERT PLAN & PROFILES  
 CONSTRUCTION DOCUMENTS

**PRELIMINARY**  
 FOR REVIEW ONLY  
 NOT FOR  
 CONSTRUCTION  
**Kimley-Horn**  
 Kimley-Horn and Associates, Inc.

PROJECT NO.  
196114000

DRAWING NAME  
CD\_RD

C2.5

