


Front Range - Midway Solar Project

Physical Constraints / Other Design Constraints Subject to Title Clearing / Preliminary Design

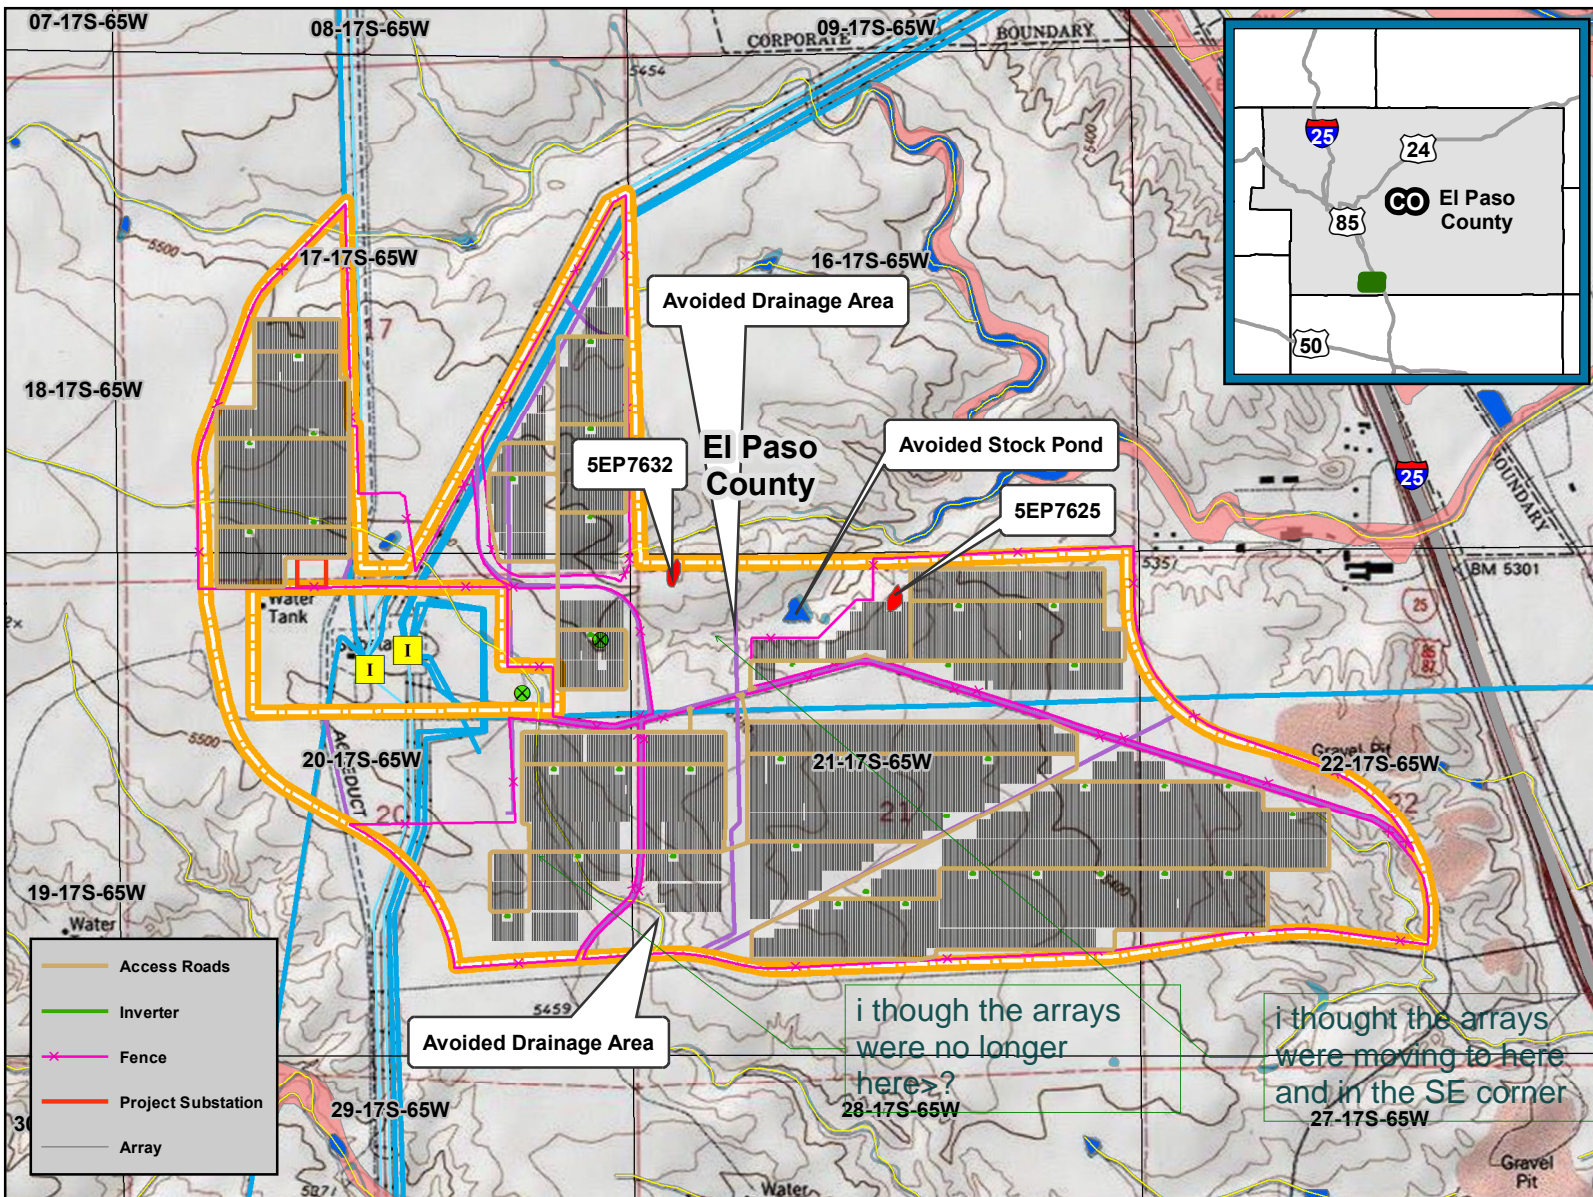

- Project Boundary
- Avoided Archeological Sites
- POI Location
- NHD Lines
- NHD Polygon
- NWI Wetlands
- FEMA

- Other Design Constraints Subject to Title Clearing
- Transmission Lines**
- Voltage kV**
- 115
- 230
- Communications Tower



The following companies and organizations provided data that contributed to the production of this map.

U.S. Geological Survey (USGS)
 Environmental Systems Research Institute (ESRI)
 U. S. Department of Agriculture (USDA)
 WhiteStar Corporation



0 0.125 0.25 0.5
 Miles

Scale: 1:24,000

Date: 1/16/2018

Coordinate System:
 NAD 1983 StatePlane Colorado Central FIPS 0502 Feet

constraint MapV_1 attmnt 42 redlines.pdf Markup Summary 7-28-2020

dsdparsons (2)



Subject: Callout
Page Label: 1
Author: dsdparsons
Date: 7/28/2020 4:19:42 PM
Status:
Color: ■
Layer:
Space:

i thought the arrays were no longer here>?



Subject: Callout
Page Label: 1
Author: dsdparsons
Date: 7/28/2020 4:20:10 PM
Status:
Color: ■
Layer:
Space:

i thought the arrays were moving to here and in the SE corner