

20040 CHISHOLM TRL
71024-04-002
PLAT 3327
RR-0.5
LOT 37 WOODCREST
ADD22385

APPROVED
Plan Review
RECORD # 22385-04-002
ADVISORY

EPC Planning & Community
Development Department

FOR INFORMATION ONLY
THIS REVIEW IS FOR INFORMATION ONLY
IT DOES NOT GUARANTEE THE ACCURACY
OR COMPLETENESS OF THE INFORMATION
PROVIDED BY THE APPLICANT.

THE APPLICANT'S LIABILITY FOR THE
CORRECTNESS OF THE INFORMATION
PROVIDED IS UNWAIVERED BY THE
REVIEWING AGENCY.


An Access Permit must be obtained by the
applicant from the Engineering Department
before any construction begins on this site.
Obstruction of the right-of-way by the
applicant is prohibited without approval of the
Engineering & Community Development Department.

Not Required
RECORD

1-10-07-2385-04-002
ADVISORY

EPC Planning & Community
Development Department

THE USER'S RESPONSIBILITY TO
VERIFY THE ACCURACY OF THE
INFORMATION PROVIDED BY THE
APPLICANT IS UNWAIVERED BY
THE REVIEWING AGENCY.

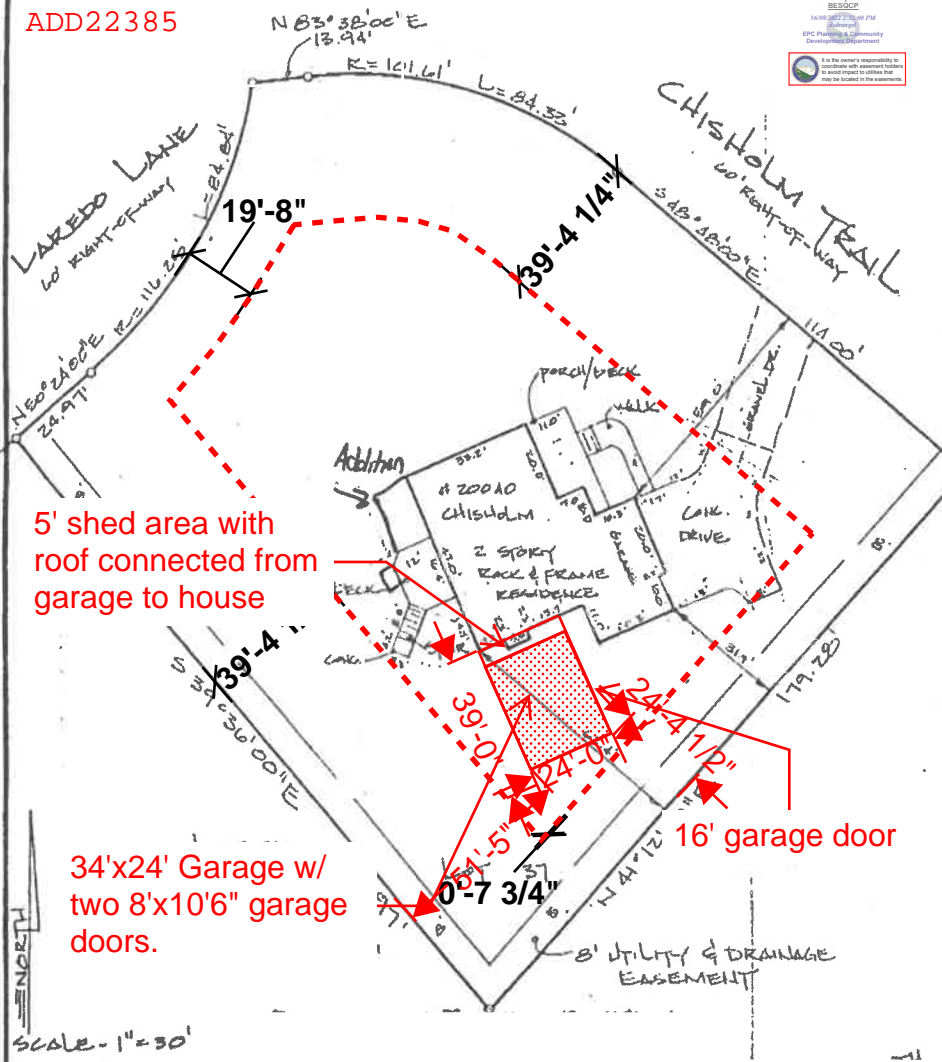

5' shed area with
roof connected from
garage to house

34'x24' Garage w/
two 8'x10'6"
doors.

16' garage door

SCALE - 1" = 30'

RESIDENTIAL



2017 PPRBC

Address: 20040 CHISHOLM TRL, MONUMENT

Parcel: 7102404002

Plan Track #: 163032 

Received: 01-Jun-2022 (KALLISTAJ)

Description:

GARAGE ADDITION

Contractor: HENSEL PHELPS CONSTRUCTION CO

Type of Unit:

Required PPRBD Departments (2)

<p>Floodplain</p> <p>(N/A) RBD GIS</p>	<p>Construction</p>
---	----------------------------

Required Outside Departments (2)

<p>County Zoning</p> <p>APPROVED</p> <p>Plan Review</p> <p><i>06/08/2022 2:32:19 PM</i></p> <p><i>dsdrangel</i></p> <p>EPC Planning & Community Development Department</p>	<p>Woodmoor Water</p>
--	------------------------------

Release of this plan does not preclude compliance with all applicable codes, ordinances and other pertinent regulations. This plan set must be present on the job site for every inspection.