

2026 Financial Assurance Estimate Form (with pre-plat construction)

Updated: 2/2026

PROJECT INFORMATION			
Project Name: Honor Charter Academy	Date: 07-22-2026	PCD File No. PPR2615	

Description	Quantity	Units	Unit Cost		Total	(with Pre-Plat Construction) % Complete	Remaining
SECTION 1 - GRADING AND EROSION CONTROL (Construction and Permanent BMPs)							
Earthwork							
less than 5,000; \$8,000 min		CY	\$ 7.50	=	\$ -		\$ -
5,001-20,000; \$30,000 min	19808.	CY	\$ 6.50	=	\$ 128,752.00		\$ 128,752.00
20,001-50,000; \$100,000 min		CY	\$ 4.50	=	\$ -		\$ -
50,001-200,000; \$175,000 min		CY	\$ 3.00	=	\$ -		\$ -
greater than 200,000; \$500,000 min		CY	\$ 2.50	=	\$ -		\$ -
Erosion Control Blanket		SY	\$ 6.00	=	\$ -		\$ -
Seeding (inc. noxious weed mgmnt.) & Mulching	6.	AC	\$ 2,037.00	=	\$ 12,222.00		\$ 12,222.00
Permanent Pond/PCM (provide engineer's estimate)	1.	EA	\$ 68,415.00	=	\$ 68,415.00		\$ 68,415.00
					\$ -		\$ -
					\$ -		\$ -
[insert items not listed but part of construction plans]					\$ -		\$ -
Safety Fence		LF	\$ 5.00	=	\$ -		\$ -
Inlet Protection		EA	\$ 322.00	=	\$ -		\$ -
Rock Check Dam		EA	\$ 908.00	=	\$ -		\$ -
Concrete Washout Basin	1.	EA	\$ 1,790.00	=	\$ 1,790.00		\$ 1,790.00
Sediment Basin	1.	EA	\$ 3,483.00	=	\$ 3,483.00		\$ 3,483.00
Sediment Trap		EA	\$ 877.00	=	\$ -		\$ -
Silt Fence	4132.	LF	\$ 3.00	=	\$ 12,396.00		\$ 12,396.00
Slope Drain		LF	\$ 30.00	=	\$ -		\$ -
Straw Bale		EA	\$ 56.00	=	\$ -		\$ -
Straw Wattle/Rock Sock	1500.	LF	\$ 11.00	=	\$ 16,500.00		\$ 16,500.00
Surface Roughening	1.	AC	\$ 507.00	=	\$ 507.00		\$ 507.00
Vehicle Tracking Control	1.	EA	\$ 3,840.00	=	\$ 3,840.00		\$ 3,840.00
				=	\$ -		\$ -
				=	\$ -		\$ -
				=	\$ -		\$ -
[insert items not listed but part of construction plans]				=	\$ -		\$ -
MAINTENANCE (35% of Construction BMPs)				=	\$ 13,480.60		\$ 13,480.60
Section 1 Subtotal				=	\$ 261,385.60		\$ 261,385.60
SECTION 2 - PUBLIC IMPROVEMENTS *							
ROADWAY IMPROVEMENTS							
Construction Traffic Control	1.	LS	\$ 50,000.00	=	\$ 50,000.00		\$ 50,000.00
Aggregate Base Course (135 lbs/cf)		Tons	\$ 42.00	=	\$ -		\$ -
Aggregate Base Course (135 lbs/cf)	140.	CY	\$ 81.00	=	\$ 11,340.00		\$ 11,340.00
Asphalt Pavement (3" thick)		SY	\$ 22.00	=	\$ -		\$ -
Asphalt Pavement (4" thick)	842.	SY	\$ 31.00	=	\$ 26,102.00		\$ 26,102.00
Asphalt Pavement (6" thick)		SY	\$ 47.00	=	\$ -		\$ -
Asphalt Pavement (147 lbs/cf) _" thick		Tons	\$ 140.00	=	\$ -		\$ -
Raised Median, Paved		SF	\$ 15.00	=	\$ -		\$ -
Signs (regulatory/advisory/guide/street)	10.	EA	\$ 293.00	=	\$ 2,930.00		\$ 2,930.00
Epoxy Pavement Marking	264.	SF	\$ 19.00	=	\$ 5,016.00		\$ 5,016.00
Thermoplastic Pavement Marking		SF	\$ 29.00	=	\$ -		\$ -
Barricade - Type 3		EA	\$ 380.00	=	\$ -		\$ -
Delineator - Type I		EA	\$ 38.00	=	\$ -		\$ -
Curb and Gutter, Type A (6" Vertical)	440.	LF	\$ 49.00	=	\$ 21,560.00		\$ 21,560.00
Curb and Gutter, Type B (Median)		LF	\$ 50.00	=	\$ -		\$ -
Curb and Gutter, Type C (Ramp)		LF	\$ 51.00	=	\$ -		\$ -
4" Sidewalk (common areas only)	310.	SY	\$ 69.00	=	\$ 21,390.00		\$ 21,390.00
5" Sidewalk		SY	\$ 85.00	=	\$ -		\$ -
6" Sidewalk		SY	\$ 113.00	=	\$ -		\$ -
8" Sidewalk		SY	\$ 141.00	=	\$ -		\$ -
Pedestrian Ramp	4.	EA	\$ 1,961.00	=	\$ 7,844.00		\$ 7,844.00
Cross Pan, local (8" thick, 6' wide to include return)		LF	\$ 87.00	=	\$ -		\$ -
Cross Pan, collector (9" thick, 8' wide to include return)	205.	LF	\$ 131.00	=	\$ 26,855.00		\$ 26,855.00
Curb Opening with Drainage Chase		EA	\$ 2,341.00	=	\$ -		\$ -
Guardrail Type 3 (W-Beam)		LF	\$ 87.00	=	\$ -		\$ -
Guardrail Type 7 (Concrete)		LF	\$ 104.00	=	\$ -		\$ -
Guardrail End Anchorage		EA	\$ 2,485.00	=	\$ -		\$ -
Guardrail Impact Attenuator		EA	\$ 22,568.00	=	\$ -		\$ -
Sound Barrier Fence (CMU block, 6' high)		LF	\$ 113.00	=	\$ -		\$ -
Sound Barrier Fence (panels, 6' high)		LF	\$ 115.00	=	\$ -		\$ -
Electrical Conduit, Size =		LF	\$ 33.00	=	\$ -		\$ -
Traffic Signal, (provide engineer's estimate)		EA		=	\$ -		\$ -
Survey Monumentation		EA	\$ 638.00	=	\$ -		\$ -
				=	\$ -		\$ -

PROJECT INFORMATION			
Project Name: Honor Charter Academy	Date: 07-22-2026	PCD File No. PPR2615	

Description	Quantity	Units	Unit Cost		Total	(with Pre-Plat Construction)	
						% Complete	Remaining
				=	\$ -		\$ -
				=	\$ -		\$ -
[insert items not listed but part of construction plans]				=	\$ -		\$ -
STORM DRAIN IMPROVEMENTS							
Concrete Box Culvert (M Standard), Size (W x H)		LF		=	\$ -		\$ -
18" Reinforced Concrete Pipe		LF	\$ 111.00	=	\$ -		\$ -
24" Reinforced Concrete Pipe		LF	\$ 161.00	=	\$ -		\$ -
30" Reinforced Concrete Pipe	1494.	LF	\$ 167.00	=	\$ 249,498.00		\$ 249,498.00
36" Reinforced Concrete Pipe	438.	LF	\$ 191.00	=	\$ 83,658.00		\$ 83,658.00
42" Reinforced Concrete Pipe		LF	\$ 275.00	=	\$ -		\$ -
48" Reinforced Concrete Pipe		LF	\$ 349.00	=	\$ -		\$ -
54" Reinforced Concrete Pipe		LF	\$ 465.00	=	\$ -		\$ -
60" Reinforced Concrete Pipe		LF	\$ 476.00	=	\$ -		\$ -
66" Reinforced Concrete Pipe		LF	\$ 550.00	=	\$ -		\$ -
72" Reinforced Concrete Pipe		LF	\$ 616.00	=	\$ -		\$ -
18" Corrugated Steel Pipe		LF	\$ 136.00	=	\$ -		\$ -
24" Corrugated Steel Pipe		LF	\$ 229.00	=	\$ -		\$ -
30" Corrugated Steel Pipe		LF	\$ 244.00	=	\$ -		\$ -
36" Corrugated Steel Pipe		LF	\$ 244.00	=	\$ -		\$ -
42" Corrugated Steel Pipe		LF	\$ 226.00	=	\$ -		\$ -
48" Corrugated Steel Pipe		LF	\$ 465.00	=	\$ -		\$ -
54" Corrugated Steel Pipe		LF	\$ 459.00	=	\$ -		\$ -
60" Corrugated Steel Pipe		LF	\$ 501.00	=	\$ -		\$ -
66" Corrugated Steel Pipe		LF	\$ 580.00	=	\$ -		\$ -
72" Corrugated Steel Pipe		LF	\$ 654.00	=	\$ -		\$ -
78" Corrugated Steel Pipe		LF	\$ 728.00	=	\$ -		\$ -
84" Corrugated Steel Pipe		LF	\$ 901.00	=	\$ -		\$ -
Flared End Section (FES) RCP Size = 36" Elliptical (unit cost = 6x pipe unit cost)	1.	EA	\$ 6,000.00	=	\$ 6,000.00		\$ 6,000.00
Flared End Section (FES) CSP Size = (unit cost = 6x pipe unit cost)		EA		=	\$ -		\$ -
				=	\$ -		\$ -
[insert items not listed but part of construction plans]				=	\$ -		\$ -
End Treatment- Headwall	1.	EA	\$ 6,000.00	=	\$ 6,000.00		\$ 6,000.00
End Treatment- Wingwall		EA		=	\$ -		\$ -
End Treatment - Cutoff Wall		EA		=	\$ -		\$ -
Curb Inlet (Type R) L=5', Depth < 5'		EA	\$ 8,814.00	=	\$ -		\$ -
Curb Inlet (Type R) L=5', 5' ≤ Depth < 10'		EA	\$ 10,835.00	=	\$ -		\$ -
Curb Inlet (Type R) L=5', 10' ≤ Depth < 15'		EA	\$ 12,206.00	=	\$ -		\$ -
Curb Inlet (Type R) L=10', Depth < 5'		EA	\$ 11,438.00	=	\$ -		\$ -
Curb Inlet (Type R) L=10', 5' ≤ Depth < 10'		EA	\$ 12,689.00	=	\$ -		\$ -
Curb Inlet (Type R) L=10', 10' ≤ Depth < 15'		EA	\$ 16,174.00	=	\$ -		\$ -
Curb Inlet (Type R) L=15', Depth < 5'		EA	\$ 14,452.00	=	\$ -		\$ -
Curb Inlet (Type R) L=15', 5' ≤ Depth < 10'		EA	\$ 17,237.00	=	\$ -		\$ -
Curb Inlet (Type R) L=15', 10' ≤ Depth < 15'		EA	\$ 21,610.00	=	\$ -		\$ -
Curb Inlet (Type R) L=20', Depth < 5'		EA	\$ 16,499.00	=	\$ -		\$ -
Curb Inlet (Type R) L=20', 5' ≤ Depth < 10'		EA	\$ 20,012.00	=	\$ -		\$ -
Grated Inlet (Type C), Depth < 5'		EA	\$ 8,156.00	=	\$ -		\$ -
Grated Inlet (Type D), Depth < 5'		EA	\$ 11,435.00	=	\$ -		\$ -
Storm Sewer Manhole, Box Base		EA	\$ 18,950.00	=	\$ -		\$ -
Storm Sewer Manhole, Slab Base	5.	EA	\$ 9,314.00	=	\$ 46,570.00		\$ 46,570.00
Geotextile (Erosion Control)		SY	\$ 6.00	=	\$ -		\$ -
Rip Rap, d50 size from 6" to 24"	66.	Tons	\$ 102.00	=	\$ 6,732.00		\$ 6,732.00
Rip Rap, Grouted		Tons	\$ 136.00	=	\$ -		\$ -
Drainage Channel Construction, Size (W x H)		LF		=	\$ -		\$ -
Drainage Channel Lining, Concrete		CY	\$ 815.00	=	\$ -		\$ -
Drainage Channel Lining, Rip Rap		CY	\$ 234.00	=	\$ -		\$ -
Drainage Channel Lining, Grass	1.	AC	\$ 2,100.00	=	\$ 2,100.00		\$ 2,100.00
Permanent Drainage Channel Lining or Roadside Ditch TRM		SY	\$ 13.00	=	\$ -		\$ -
				=	\$ -		\$ -
				=	\$ -		\$ -
				=	\$ -		\$ -
[insert items not listed but part of construction plans]				=	\$ -		\$ -
Section 2 Subtotal					= \$ 573,595.00		\$ 573,595.00

* - Subject to defect warranty financial assurance. A minimum of 20% shall be retained until final acceptance (MAXIMUM OF 80% COMPLETE ALLOWED)

PROJECT INFORMATION							
Project Name: Honor Charter Academy			Date: 07-22-2026		PCD File No. PPR2615		
Description	Quantity	Units	Unit Cost		Total	(with Pre-Plat Construction)	
						% Complete	Remaining
SECTION 3 - COMMON DEVELOPMENT IMPROVEMENTS (Private or District and NOT Maintained by EPC)**							
ROADWAY IMPROVEMENTS							
				=	\$ -		\$ -
				=	\$ -		\$ -
STORM DRAIN IMPROVEMENTS (Exception: Permanent Pond/BMP shall be itemized under Section 1)							
				=	\$ -		\$ -
				=	\$ -		\$ -
WATER SYSTEM IMPROVEMENTS							
Water Main Pipe (PVC), Size 8"		LF	\$ 90.00	=	\$ -		\$ -
Water Main Pipe (Ductile Iron), Size 8"		LF	\$ 105.00	=	\$ -		\$ -
Gate Valves, 8"		EA	\$ 2,599.00	=	\$ -		\$ -
Fire Hydrant Assembly, w/ all valves		EA	\$ 9,228.00	=	\$ -		\$ -
Water Service Line Installation, inc. tap and valves		EA	\$ 1,852.00	=	\$ -		\$ -
Fire Cistern Installation, complete		EA		=	\$ -		\$ -
[insert items not listed but part of construction plans]				=	\$ -		\$ -
SANITARY SEWER IMPROVEMENTS							
Sewer Main Pipe (PVC), Size 8"		LF	\$ 90.00	=	\$ -		\$ -
Sanitary Sewer Manhole, Depth < 15 feet		EA	\$ 6,136.00	=	\$ -		\$ -
Sanitary Service Line Installation, complete		EA	\$ 1,962.00	=	\$ -		\$ -
Sanitary Sewer Lift Station, complete		EA		=	\$ -		\$ -
[insert items not listed but part of construction plans]				=	\$ -		\$ -
LANDSCAPING IMPROVEMENTS (For subdivision specific condition of approval, or PUD)							
Fences	1336.	EA	\$ 12.00	=	\$ 16,032.00		\$ 16,032.00
Trees	27.	EA	\$ 700.00	=	\$ 18,900.00		\$ 18,900.00
		EA		=	\$ -		\$ -
		EA		=	\$ -		\$ -
		EA		=	\$ -		\$ -
Section 3 Subtotal				=	\$ 34,932.00		\$ 34,932.00
AS-BUILT PLANS (Public Improvements inc. Permanent WQCV BMPs)		LS	\$ 1,500.00	=	\$ 1,500.00		\$ 1,500.00
POND/BMP CERTIFICATION (inc. elevations and volume calculations)		LS	\$ 1,500.00	=	\$ 1,500.00		\$ 1,500.00
Total Construction Financial Assurance						\$	872,912.60
(Sum of all section subtotals plus as-builts and pond/BMP certification)							
Total Remaining Construction Financial Assurance (with Pre-Plat Construction)						\$	872,912.60
(Sum of all section totals less credit for items complete plus as-builts and pond/BMP certification)							
Total Defect Warranty Financial Assurance						\$	156,596.80
(20% of all items identified as (*). To be collateralized at time of preliminary acceptance)							

Approvals	
I hereby certify that this is an accurate and complete estimate of costs for the work as shown on the Grading and Erosion Control Plan and Construction Drawings associated with the Project.	
Engineer (P.E. Seal Required) Approved by Owner / Applicant Approved by El Paso County Engineer / ECM Administrator Date Date	

Jul 24, 2026 - 12:59pm by nrmaster X:\ENGINEERING\CD\2015170 - Honor Charter School - Pylon, CD\ENV\Construction Drawings\201517_PPR-ST.dwg



Know what's below
Call before you dig.

STORMWATER PLAN

UNAUTHORIZED CHANGES & USES

THE ENGINEER PREPARING THESE PLANS WILL NOT BE RESPONSIBLE FOR, OR LIABLE FOR, UNAUTHORIZED CHANGES TO OR USES OF THESE PLANS. ALL CHANGES OF THESE PLANS MUST BE IN WRITING AND MUST BE APPROVED BY THE PREPARER OF THESE PLANS PRIOR TO CONSTRUCTION. CONSTRUCTION CONTRACTOR AGREES THAT IN ACCORDANCE WITH GENERALLY ACCEPTED CONSTRUCTION PRACTICES, CONSTRUCTION CONTRACTOR WILL BE REQUIRED TO ASSUME SOLE AND COMPLETE RESPONSIBILITY FOR JOB SITE CONDITIONS DURING THE COURSE OF CONSTRUCTION OF THE PROJECT, INCLUDING SAFETY OF ALL PERSONS AND PROPERTY, THAT THIS REQUIREMENT SHALL BE MADE TO APPLY CONTINUOUSLY AND NOT BE LIMITED TO NORMAL WORKING HOURS, AND CONSTRUCTION CONTRACTOR FURTHER AGREES TO DEFEND, INDEMNIFY AND HOLD DESIGN PROFESSIONAL HARMLESS FROM ANY AND ALL LIABILITY, REAL OR ALLEGED, IN CONNECTION WITH THE PERFORMANCE OF WORK ON THIS PROJECT, EXCEPTING LIABILITY ARISING FROM THE SOLE NEGLIGENCE OF DESIGN PROFESSIONAL.

NOTE TO CONTRACTOR




THE EXISTENCE AND LOCATION OF ANY UNDERGROUND UTILITIES, PIPES, AND/OR STRUCTURES SHOWN ON THESE PLANS WERE OBTAINED BY A SEARCH OF AVAILABLE RECORDS. THERE MAY BE EXISTING UTILITIES NOT SHOWN ON THESE PLANS. THE CONTRACTOR SHALL ASCERTAIN THE TRUE VERTICAL AND HORIZONTAL LOCATION OF THOSE UNDERGROUND UTILITIES TO BE USED PRIOR TO CONSTRUCTION AND SHALL BE RESPONSIBLE FOR ANY DAMAGE TO ANY PUBLIC OR PRIVATE UTILITIES, SHOWN OR NOT SHOWN HEREON.

BASIS OF BEARINGS:

BEARINGS ARE BASED ON THE WESTERLY BOUNDARY OF THE SUBJECT PARCEL COINCIDENT WITH THE EASTERLY BOUNDARY OF THE BENT GRASS RESIDENTIAL FILING NO.2, MONUMENTED ON THE NORTH END WITH A NO.5 REBAR & 1-3/8" RED PLASTIC CAP MARKED "ALC PLS 38087", FOUND FLUSH WITH GRADE, AND ON THE SOUTH END WITH A NO. 4 REBAR & 1" ORANGE PLASTIC CAP MARKED "PLS 38141", RECOVERED 0.6 BELOW GRADE, AND IS ASSUMED TO BEAR N 00°08'14" E A MEASURED DISTANCE OF 619.52 FEET.

BENCHMARK:

ELEVATIONS ARE BASED ON THE PROJECT BENCHMARK IDENTIFIED AS JK0239 ELEVATION=6902.3'(NAVD88), PER DATA PUBLISHED BY THE NATIONAL GEODETIC SURVEY.

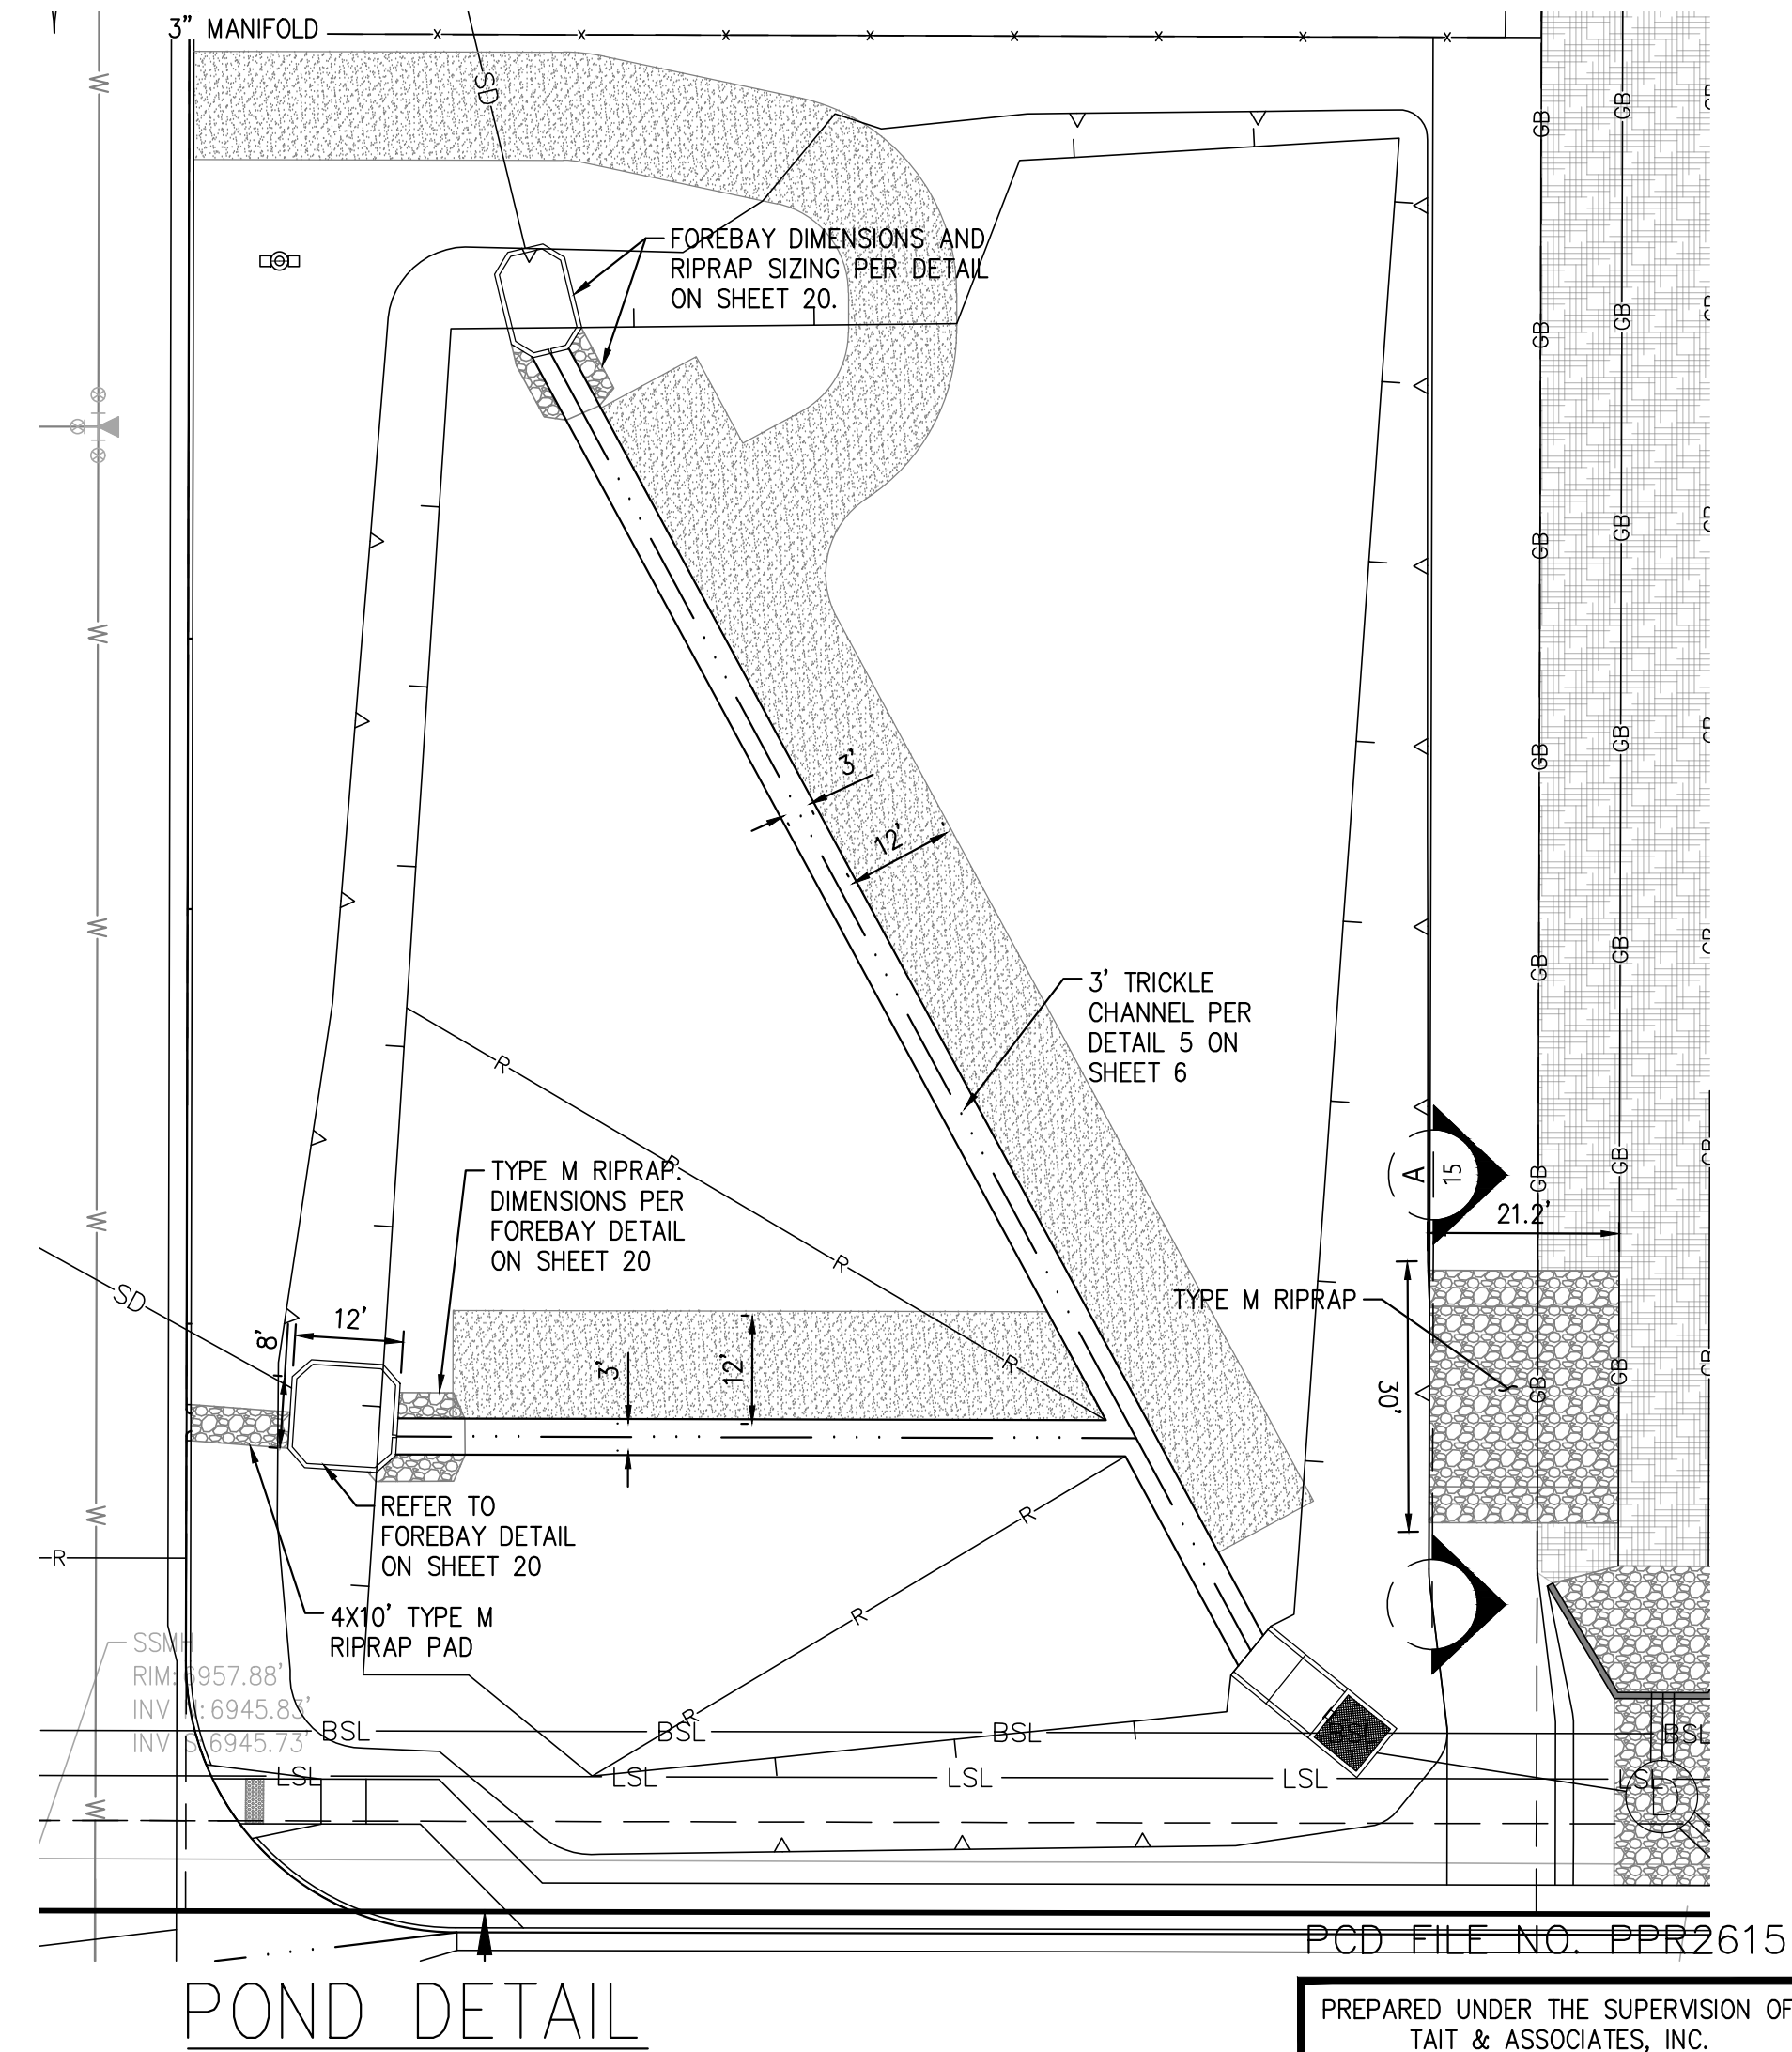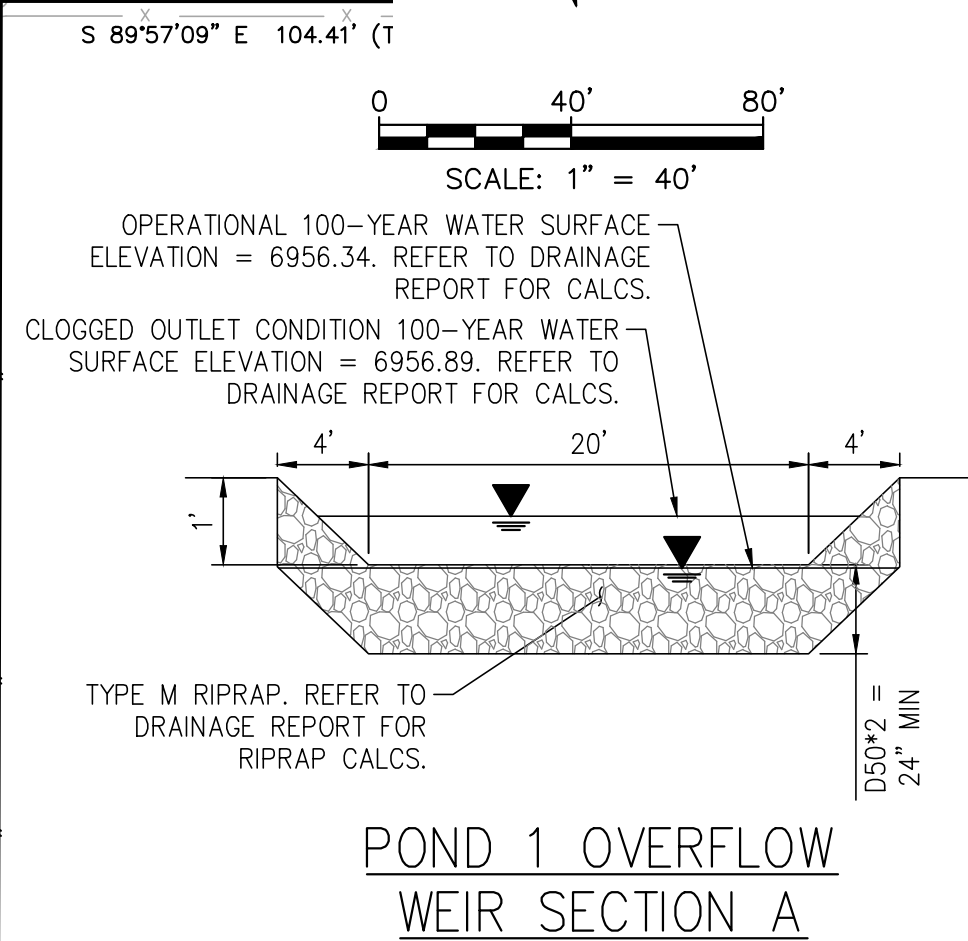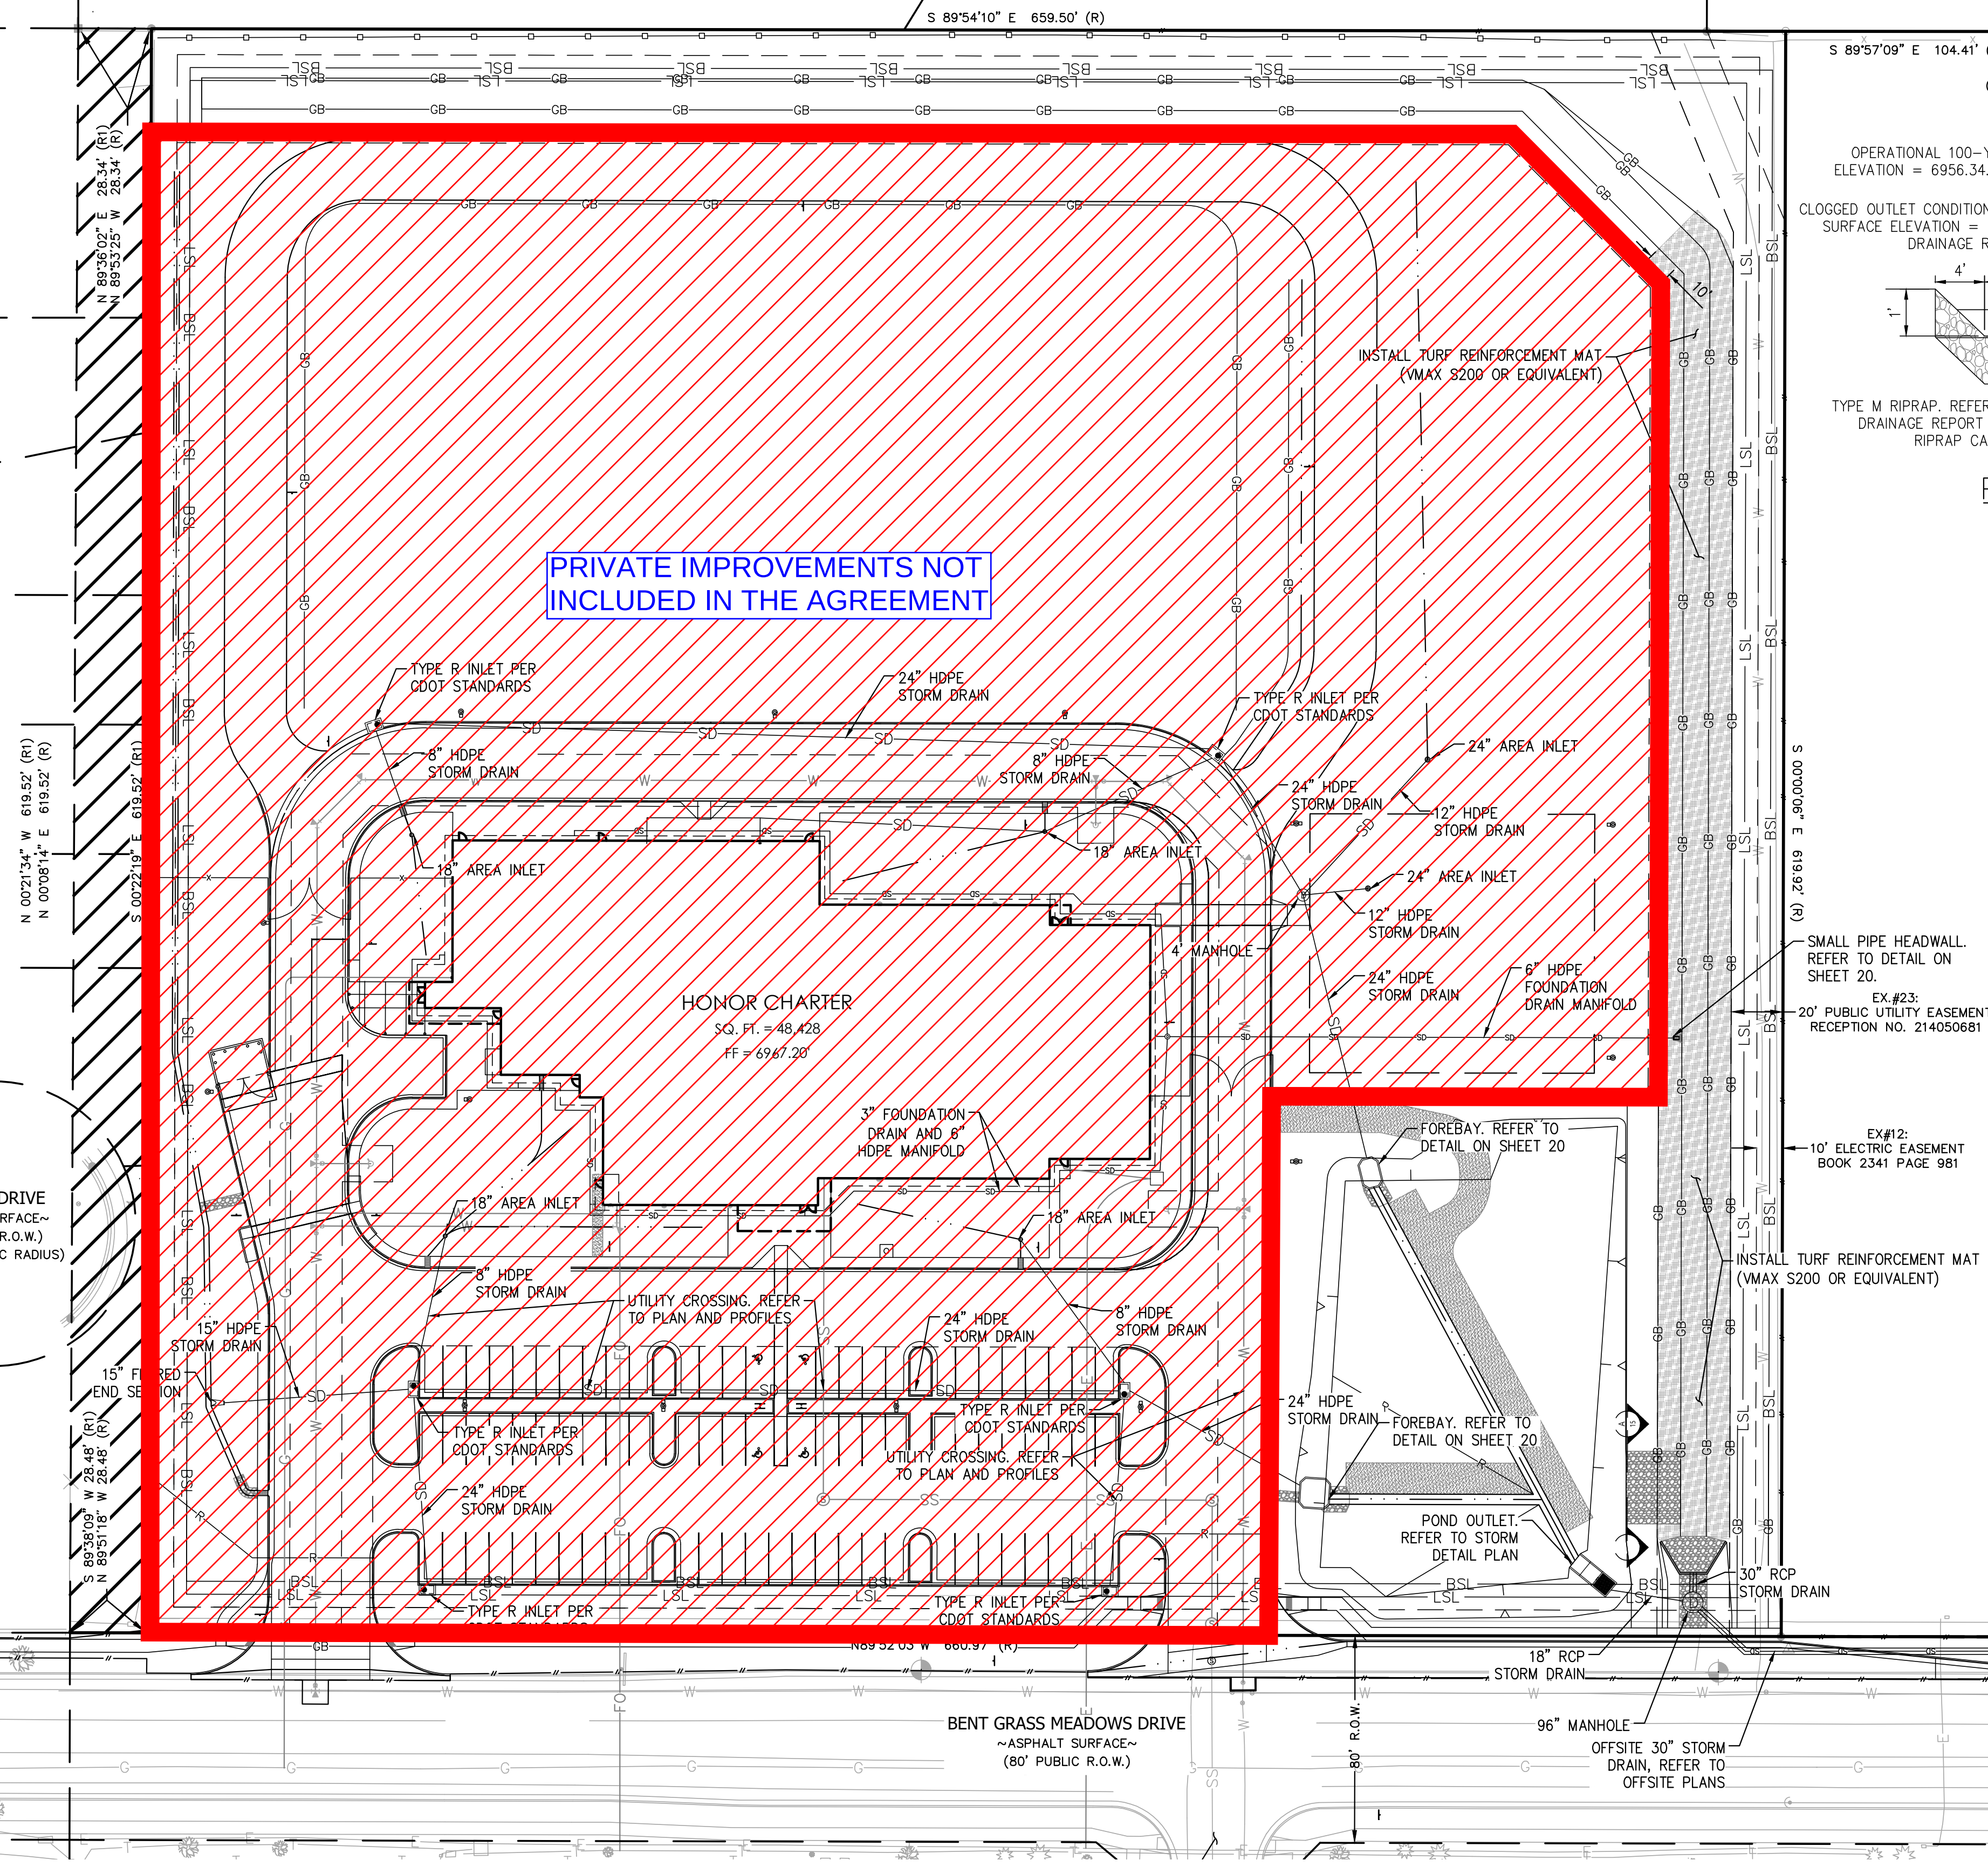

SYMBOLS LEGEND

---	PROPERTY LINE
---	ADJACENT PROPERTY LINE
---	ROW LINE
---	BUILDING SETBACK LINE
---	PROPOSED EASEMENT
---	LIMIT OF DISTURBANCE
---	EXISTING WATER LINE
---	EXISTING SEWER LINE
---	PROPOSED TELEPHONE SERVICE LINE
---	PROPOSED ELECTRIC SERVICE LINE
---	PROPOSED WATER SERVICE LINE
---	PROPOSED SS SERVICE LINE
---	PROPOSED STORM DRAIN
---	PROPOSED RIDGELINE
---	PROPOSED GRADE BREAK
---	PROPOSED TOP OF POND
---	PROPOSED BOTTOM OF POND
---	PROPOSED SIGN
---	PROPOSED SS CLEANOUT
---	PROPOSED BACKFLOW PREVENTOR
---	EXISTING FIRE HYDRANT
---	PROPOSED FIRE HYDRANT
---	PROPOSED STREET LIGHT
---	EXISTING INLET
---	PROPOSED INLET
---	PROPOSED STORM INFRASTRUCTURE
---	PROPOSED STORM MANHOLE
---	PROPOSED TEE / THRUST BLOCK
---	PROPOSED FLARED-END SECTION
---	EXISTING SANITARY SEWER MANHOLE
---	PROPOSED TURF REINFORCEMENT MAT

STORMWATER PLAN

HONOR CHARTER SCHOOL
HIGHMARK SCHOOL DEVELOPMENT
8250 BENT GRASS MEADOWS DR.

DRAWING C/W
DATE: 11/11/2024
CHECKED:
DATE:
REVISION #:
DATE:
JOB NO. C01517

15
OF
38

BRIAN CAMPBELL
COLORADO P.E. #40196

320 North Lincoln Avenue
Loveland, CO 80537

p: 970.613.1447

www.tait.com

ENGINEERING ENVIRONMENTAL BUILDING LAND
Denver
Sacramento
San Jose
San Francisco
Seattle

Since 1944



2/6/2024 Internal Review #1

Jul 24, 2026 - 1:03pm by rromstetter A:\ENGINEERING\CO\CO16170 - Honor Charter School - Pylon, CO\ENR\Construction Drawings\CO1617_26.dwg



Know what's below
Call before you dig.

UNAUTHORIZED CHANGES & USES

THE ENGINEER PREPARING THESE PLANS WILL NOT BE RESPONSIBLE FOR, OR LIABLE FOR, UNAUTHORIZED CHANGES TO OR USES OF THESE PLANS. ALL CHANGES OF THESE PLANS MUST BE IN WRITING AND MUST BE APPROVED BY THE PREPARER OF THESE PLANS PRIOR TO CONSTRUCTION. CONSTRUCTION CONTRACTOR AGREES THAT IN ACCORDANCE WITH GENERALLY ACCEPTED CONSTRUCTION PRACTICES, CONSTRUCTION CONTRACTOR WILL BE REQUIRED TO ASSUME SOLE AND COMPLETE RESPONSIBILITY FOR JOB SITE CONDITIONS DURING THE COURSE OF CONSTRUCTION OF THE PROJECT, INCLUDING SAFETY OF ALL PERSONS AND PROPERTY, THAT THIS REQUIREMENT SHALL BE MADE TO APPLY CONTINUOUSLY AND NOT BE LIMITED TO NORMAL WORKING HOURS, AND CONSTRUCTION CONTRACTOR FURTHER AGREES TO DEFEND, INDEMNIFY AND HOLD DESIGN PROFESSIONAL HARMLESS FROM ANY AND ALL LIABILITY, REAL OR ALLEGED, IN CONNECTION WITH THE PERFORMANCE OF WORK ON THIS PROJECT, EXCEPTING LIABILITY ARISING FROM THE SOLE NEGLIGENCE OF DESIGN PROFESSIONAL.

NOTE TO CONTRACTOR


THE EXISTENCE AND LOCATION OF ANY UNDERGROUND UTILITIES, PIPES, AND/OR STRUCTURES SHOWN ON THESE PLANS WERE OBTAINED BY A SEARCH OF AVAILABLE RECORDS. THERE MAY BE EXISTING UTILITIES NOT SHOWN ON THESE PLANS. THE CONTRACTOR SHALL ASCERTAIN THE TRUE VERTICAL AND HORIZONTAL LOCATION OF THOSE UNDERGROUND UTILITIES TO BE USED PRIOR TO CONSTRUCTION AND SHALL BE RESPONSIBLE FOR ANY DAMAGE TO ANY PUBLIC OR PRIVATE UTILITIES, SHOWN OR NOT SHOWN HEREON.

BASIS OF BEARINGS:

BEARINGS ARE BASED ON THE WESTERLY BOUNDARY OF THE SUBJECT PARCEL COINCIDENT WITH THE EASTERLY BOUNDARY OF THE BENT GRASS RESIDENTIAL FILING NO.2, MONUMENTED ON THE NORTH END WITH A NO.5 REBAR & 1-3/8" RED PLASTIC CAP MARKED "ALC PLS 38087", FOUND FLUSH WITH GRADE, AND ON THE SOUTH END WITH A NO. 4 REBAR & 1" ORANGE PLASTIC CAP MARKED "PLS 38141", RECOVERED 0.6 BELOW GRADE, AND IS ASSUMED TO BEAR N 00°08'14" E A MEASURED DISTANCE OF 619.52 FEET.

BENCHMARK:

ELEVATIONS ARE BASED ON THE PROJECT BENCHMARK IDENTIFIED AS JK0239 ELEVATION=6902.3'(NAVD88), PER DATA PUBLISHED BY THE NATIONAL GEODETIC SURVEY.

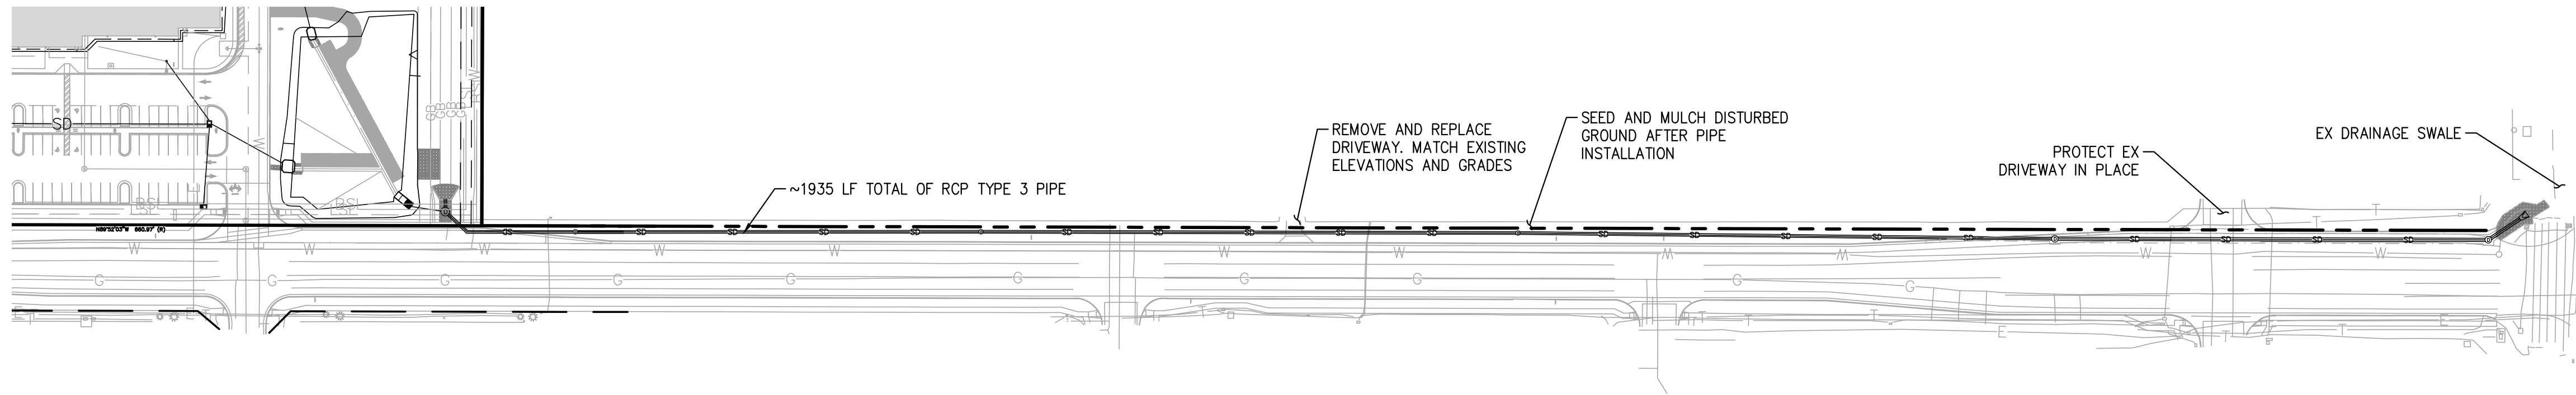

OFFSITE OVERALL STORM PLAN

SYMBOLS LEGEND

—	PROPERTY LINE
— — —	ADJACENT PROPERTY LINE
— — — —	ROW LINE
— — — —	BUILDING SETBACK LINE
- - - - -	PROPOSED EASEMENT
— — — — —	LIMIT OF DISTURBANCE
— W —	EXISTING WATER LINE
— SS —	EXISTING SEWER LINE
— T —	PROPOSED TELEPHONE SERVICE LINE
— E —	PROPOSED ELECTRIC SERVICE LINE
— W —	PROPOSED WATER SERVICE LINE
— SS —	PROPOSED SS SERVICE LINE
— SD —	PROPOSED STORM DRAIN
— R —	PROPOSED RIDGE LINE
— GB —	PROPOSED GRADE BREAK
— V —	PROPOSED TOP OF POND
— V —	PROPOSED BOTTOM OF POND
—	PROPOSED SIGN
—	PROPOSED SS CLEANOUT
—	PROPOSED BACKFLOW PREVENTOR
—	EXISTING FIRE HYDRANT
—	PROPOSED FIRE HYDRANT
—	PROPOSED STREET LIGHT
—	EXISTING INLET
—	PROPOSED INLET
—	PROPOSED STORM INFRASTRUCTURE
—	PROPOSED STORM MANHOLE
—	PROPOSED TEE / THRUST BLOCK
—	PROPOSED FLARED-END SECTION
—	EXISTING SANITARY SEWER MANHOLE

0 100' 200'
SCALE: 1" = 100'



PCD FILE NO. PPR2615

PREPARED UNDER THE SUPERVISION OF
TAIT & ASSOCIATES, INC.

BRIAN CAMPBELL
COLORADO P.E. #40196

OFFSITE OVERALL STORM PLAN

HONOR CHARTER SCHOOL
HIGHMARK SCHOOL DEVELOPMENT
8250 BENT GRASS MEADOWS DR.

DRAWING CW
DATE: 11/11/2024
CHECKED:
DATE:
DATE:
REVISION #:
DATE:
JOB NO. CO1617

31
OF
38

2/6/2024 Internal Review #1

320 North Lincoln Avenue
Loveland, CO 80537

p: 970.613.1447
www.tait.com

ENGINEERING ENVIRONMENTAL BUILDING LAND
Socio-Architectural Denver
3201 1st, Suite 2000, North

Since 1964



NO.	DESCRIPTION	REVISIONS	BY	DATE
1	NOI			

Jul 24, 2026 - 1:03pm by rromstetter A:\ENGINEERING\CO\CO15170 - Honor Charter School - Payson, CO\ENR\Construction Drawings\CO1517_250.dwg



UNAUTHORIZED CHANGES & USES

THE ENGINEER PREPARING THESE PLANS WILL NOT BE RESPONSIBLE FOR, OR LIABLE FOR, UNAUTHORIZED CHANGES TO OR USES OF THESE PLANS. ALL CHANGES OF THESE PLANS MUST BE IN WRITING AND MUST BE APPROVED BY THE PREPARER OF THESE PLANS PRIOR TO CONSTRUCTION. CONSTRUCTION CONTRACTOR AGREES THAT IN ACCORDANCE WITH GENERALLY ACCEPTED CONSTRUCTION PRACTICES, CONSTRUCTION CONTRACTOR WILL BE REQUIRED TO ASSUME SOLE AND COMPLETE RESPONSIBILITY FOR JOB SITE CONDITIONS DURING THE COURSE OF CONSTRUCTION OF THE PROJECT, INCLUDING SAFETY OF ALL PERSONS AND PROPERTY, THAT THIS REQUIREMENT SHALL BE MADE TO APPLY CONTINUOUSLY AND NOT BE LIMITED TO NORMAL WORKING HOURS, AND CONSTRUCTION CONTRACTOR FURTHER AGREES TO DEFEND, INDEMNIFY AND HOLD DESIGN PROFESSIONAL HARMLESS FROM ANY AND ALL LIABILITY, REAL OR ALLEGED, IN CONNECTION WITH THE PERFORMANCE OF WORK ON THIS PROJECT, EXCEPTING LIABILITY ARISING FROM THE SOLE NEGLIGENCE OF DESIGN PROFESSIONAL.

NOTE TO CONTRACTOR

THE EXISTENCE AND LOCATION OF ANY UNDERGROUND UTILITIES, PIPES, AND/OR STRUCTURES SHOWN ON THESE PLANS WERE OBTAINED BY A SEARCH OF AVAILABLE RECORDS. THERE MAY BE EXISTING UTILITIES NOT SHOWN ON THESE PLANS. THE CONTRACTOR SHALL ASCERTAIN THE TRUE VERTICAL AND HORIZONTAL LOCATION OF THOSE UNDERGROUND UTILITIES TO BE USED PRIOR TO CONSTRUCTION AND SHALL BE RESPONSIBLE FOR ANY DAMAGE TO ANY PUBLIC OR PRIVATE UTILITIES, SHOWN OR NOT SHOWN HEREON.

BASIS OF BEARINGS:


BEARINGS ARE BASED ON THE WESTERLY BOUNDARY OF THE SUBJECT PARCEL COINCIDENT WITH THE EASTERLY BOUNDARY OF THE BENT GRASS RESIDENTIAL FILING NO.2, MONUMENTED ON THE NORTH END WITH A NO.5 REBAR & 1-3/8" RED PLASTIC CAP MARKED "ALC PLS 38087", FOUND FLUSH WITH GRADE, AND ON THE SOUTH END WITH A NO. 4 REBAR & 1" ORANGE PLASTIC CAP MARKED "PLS 38141", RECOVERED 0.6 BELOW GRADE, AND IS ASSUMED TO BEAR N 00°08'14" E A MEASURED DISTANCE OF 619.52 FEET.

BENCHMARK:


ELEVATIONS ARE BASED ON THE PROJECT BENCHMARK IDENTIFIED AS JK0239 ELEVATION=6902.3'(NAVD88), PER DATA PUBLISHED BY THE NATIONAL GEODETIC SURVEY.

SYMBOLS LEGEND

—	PROPERTY LINE
—	ADJACENT PROPERTY LINE
—	ROW LINE
—	BUILDING SETBACK LINE
- - -	PROPOSED EASEMENT
—	LIMIT OF DISTURBANCE
— W —	EXISTING WATER LINE
— SS —	EXISTING SEWER LINE
— T —	PROPOSED TELEPHONE SERVICE LINE
— E —	PROPOSED ELECTRIC SERVICE LINE
— W —	PROPOSED WATER SERVICE LINE
— SS —	PROPOSED SS SERVICE LINE
— SD —	PROPOSED STORM DRAIN
— R —	PROPOSED RIDGELINE
— GB —	PROPOSED GRADE BREAK
—	PROPOSED TOP OF POND
—	PROPOSED BOTTOM OF POND
—	PROPOSED SIGN
—	PROPOSED SS CLEANOUT
—	PROPOSED BACKFLOW PREVENTOR
—	EXISTING FIRE HYDRANT
—	PROPOSED FIRE HYDRANT
—	PROPOSED STREET LIGHT
—	EXISTING INLET
—	PROPOSED INLET
—	PROPOSED STORM INFRASTRUCTURE
—	PROPOSED STORM MANHOLE
—	PROPOSED TEE / THRUST BLOCK
—	PROPOSED FLARED-END SECTION
—	EXISTING SANITARY SEWER MANHOLE

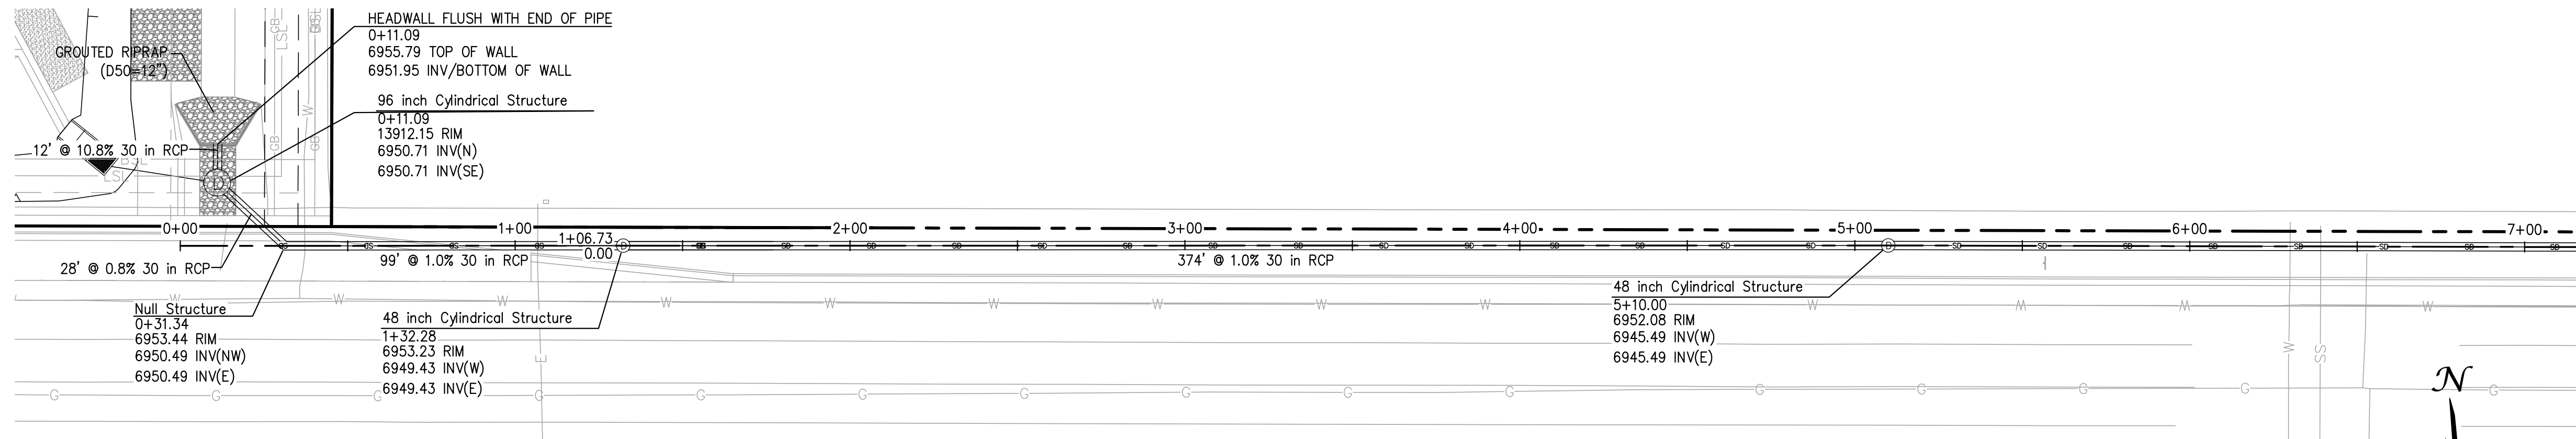

OFFSITE STORM PLAN 1

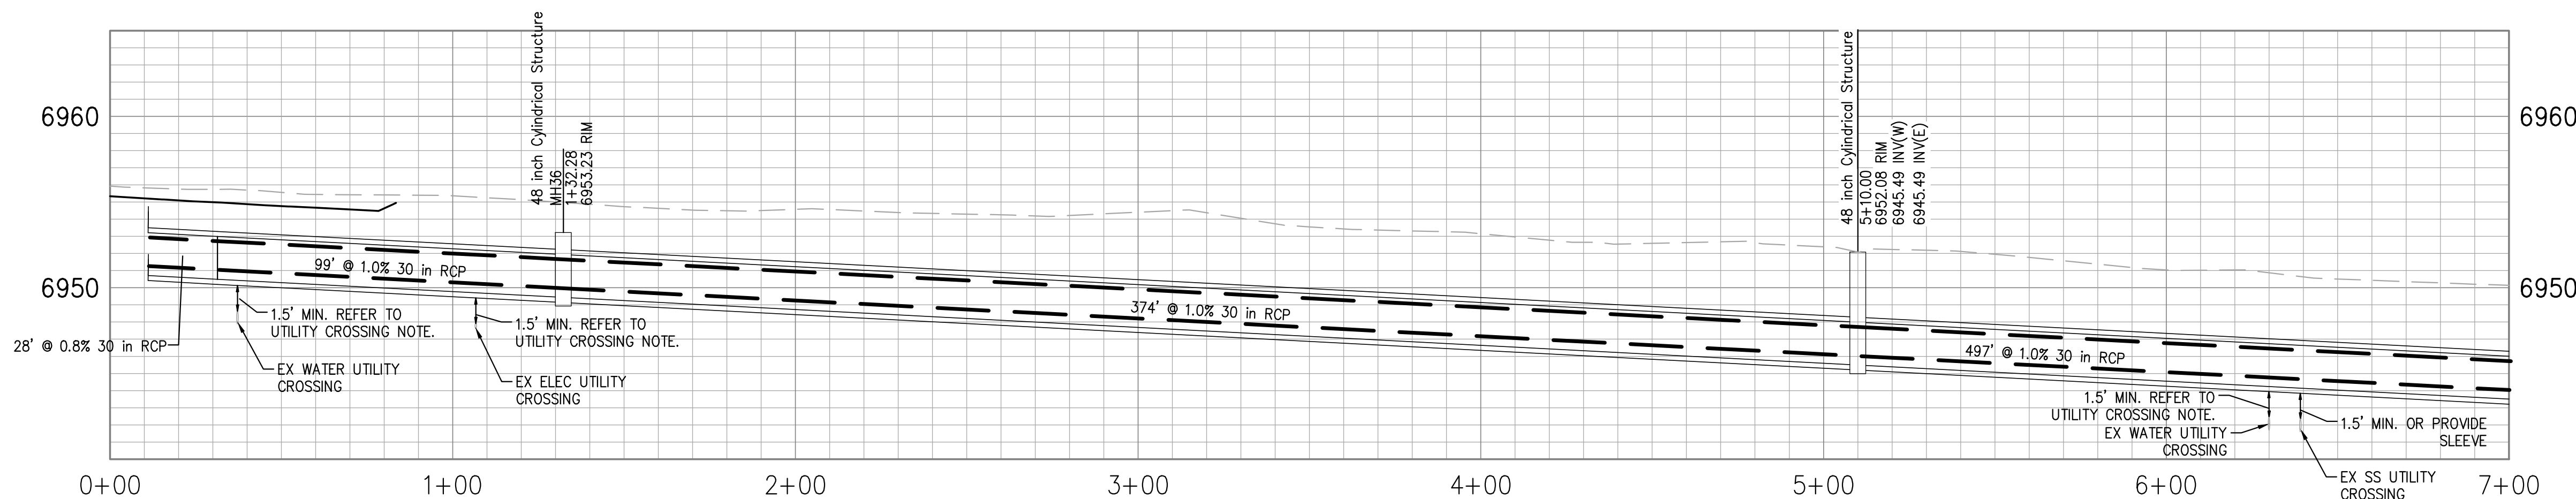

OFFSITE STORM PROFILE 1

UTILITY CROSSING NOTE:

UTILITY CROSSING DEPTHS ARE UNKNOWN. 1.5' OF SEPARATION MUST BE KEPT BETWEEN THE OFFSITE STORM SYSTEM AND ANY UTILITY CROSSING. CONTRACTOR TO VERIFY THE UTILITY LOCATION AND DEPTHS OF ALL UTILITIES. UTILITIES THAT HAVE LESS THAN 1.5' SEPARATION MUST BE LOWERED PER DETAIL W-19/W-20 ON SHEET 35.

PCD FILE NO. PPR2615

PREPARED UNDER THE SUPERVISION OF
TAIT & ASSOCIATES, INC.

DRAWING CW
DATE: 11/11/2024
CHECKED:
DATE:
REVISION #:
DATE:
JOB NO. CO1517

BRIAN CAMPBELL
COLORADO P.E. #40196

32
OF
38

OFFSITE STORM P&P
HONOR CHARTER SCHOOL
HIGHMARK SCHOOL DEVELOPMENT
8250 BENT GRASS MEADOWS DR.



320 North Lincoln Avenue
Loveland, CO 80537
p: 970.613.1447
www.tait.com
ENGINEERING ENVIRONMENTAL BUILDING LAND
SCAPE ARCHITECTURE
SINCE 1964

NO.	DESCRIPTION	BY	DATE
1	NOI	Dollis	2/6/2024

Jul 24, 2026 - 1:03pm by rromstetter A:\ENGINEERING\CO\CO15170 - Honor Charter School - Payson, CO\ENGINEERING\Drawings\CO1517_20.dwg



Know what's below
Call before you dig.

UNAUTHORIZED CHANGES & USES

THE ENGINEER PREPARING THESE PLANS WILL NOT BE RESPONSIBLE FOR, OR LIABLE FOR, UNAUTHORIZED CHANGES TO OR USES OF THESE PLANS. ALL CHANGES OF THESE PLANS MUST BE IN WRITING AND MUST BE APPROVED BY THE PREPARER OF THESE PLANS PRIOR TO CONSTRUCTION. CONSTRUCTION CONTRACTOR AGREES THAT IN ACCORDANCE WITH GENERALLY ACCEPTED CONSTRUCTION PRACTICES, CONSTRUCTION CONTRACTOR WILL BE REQUIRED TO ASSUME SOLE AND COMPLETE RESPONSIBILITY FOR JOB SITE CONDITIONS DURING THE COURSE OF CONSTRUCTION OF THE PROJECT, INCLUDING SAFETY OF ALL PERSONS AND PROPERTY, THAT THIS REQUIREMENT SHALL BE MADE TO APPLY CONTINUOUSLY AND NOT BE LIMITED TO NORMAL WORKING HOURS, AND CONSTRUCTION CONTRACTOR FURTHER AGREES TO DEFEND, INDEMNIFY AND HOLD DESIGN PROFESSIONAL HARMLESS FROM ANY AND ALL LIABILITY, REAL OR ALLEGED, IN CONNECTION WITH THE PERFORMANCE OF WORK ON THIS PROJECT, EXCEPTING LIABILITY ARISING FROM THE SOLE NEGLIGENCE OF DESIGN PROFESSIONAL.

NOTE TO CONTRACTOR

THE EXISTENCE AND LOCATION OF ANY UNDERGROUND UTILITIES, PIPES, AND/OR STRUCTURES SHOWN ON THESE PLANS WERE OBTAINED BY A SEARCH OF AVAILABLE RECORDS. THERE MAY BE EXISTING UTILITIES NOT SHOWN ON THESE PLANS. THE CONTRACTOR SHALL ASCERTAIN THE TRUE VERTICAL AND HORIZONTAL LOCATION OF THOSE UNDERGROUND UTILITIES TO BE USED PRIOR TO CONSTRUCTION AND SHALL BE RESPONSIBLE FOR ANY DAMAGE TO ANY PUBLIC OR PRIVATE UTILITIES, SHOWN OR NOT SHOWN HEREON.

BASIS OF BEARINGS:

BEARINGS ARE BASED ON THE WESTERLY BOUNDARY OF THE SUBJECT PARCEL COINCIDENT WITH THE EASTERLY BOUNDARY OF THE BENT GRASS RESIDENTIAL FILING NO.2, MONUMENTED ON THE NORTH END WITH A NO.5 REBAR & 1-3/8" RED PLASTIC CAP MARKED "ALC PLS 38087", FOUND FLUSH WITH GRADE, AND ON THE SOUTH END WITH A NO. 4 REBAR & 1" ORANGE PLASTIC CAP MARKED "PLS 38141", RECOVERED 0.6 BELOW GRADE, AND IS ASSUMED TO BEAR N 00°08'14" E A MEASURED DISTANCE OF 619.52 FEET.

BENCHMARK:

ELEVATIONS ARE BASED ON THE PROJECT BENCHMARK IDENTIFIED AS JK0239 ELEVATION=6902.3'(NAVD88), PER DATA PUBLISHED BY THE NATIONAL GEODETIC SURVEY.



PCD FILE NO. PPR2615

PREPARED UNDER THE SUPERVISION OF
TAIT & ASSOCIATES, INC.

BRIAN CAMPBELL
COLORADO P.E. #40196

SYMBOLS LEGEND

	PROPERTY LINE
	ADJACENT PROPERTY LINE
	ROW LINE
	BUILDING SETBACK LINE
	PROPOSED EASEMENT
	LIMIT OF DISTURBANCE
	EXISTING WATER LINE
	EXISTING SEWER LINE
	PROPOSED TELEPHONE SERVICE LINE
	PROPOSED ELECTRIC SERVICE LINE
	PROPOSED WATER SERVICE LINE
	PROPOSED SS SERVICE LINE
	PROPOSED STORM DRAIN
	PROPOSED RIDGELINE
	PROPOSED GRADE BREAK
	PROPOSED TOP OF POND
	PROPOSED BOTTOM OF POND
	PROPOSED SIGN
	PROPOSED SS CLEANOUT
	PROPOSED BACKFLOW PREVENTOR
	EXISTING FIRE HYDRANT
	PROPOSED FIRE HYDRANT
	PROPOSED STREET LIGHT
	EXISTING INLET
	PROPOSED INLET
	PROPOSED STORM INFRASTRUCTURE
	PROPOSED STORM MANHOLE
	PROPOSED TEE / THRUST BLOCK
	PROPOSED FLARED-END SECTION
	EXISTING SANITARY SEWER MANHOLE

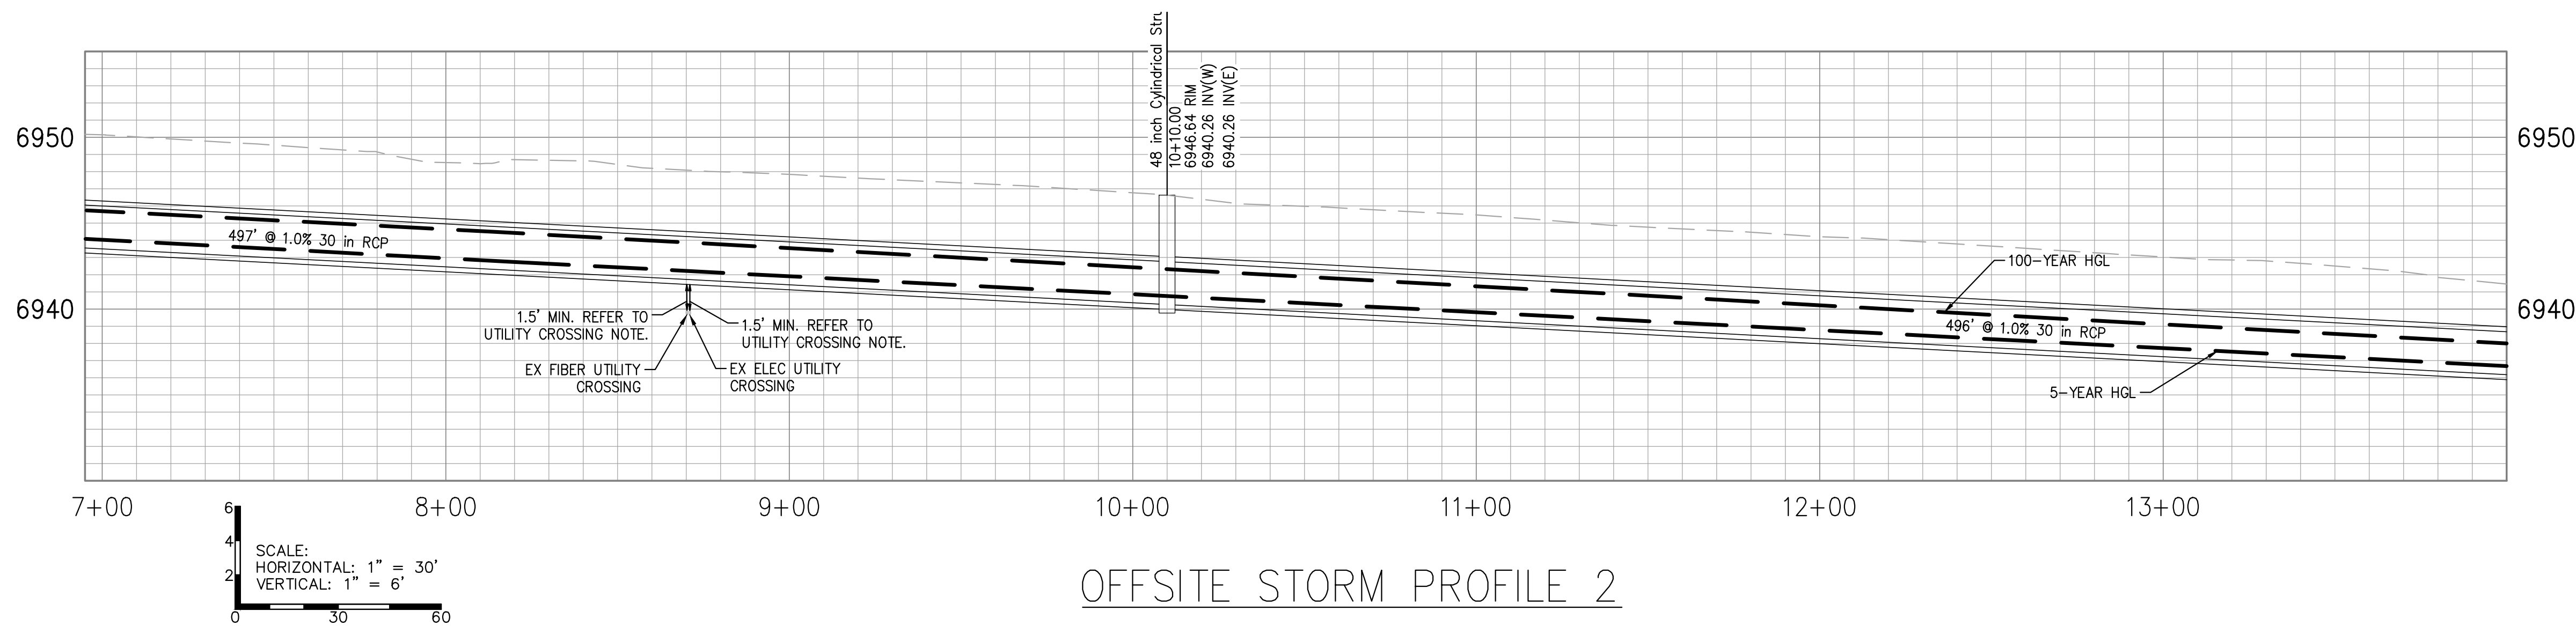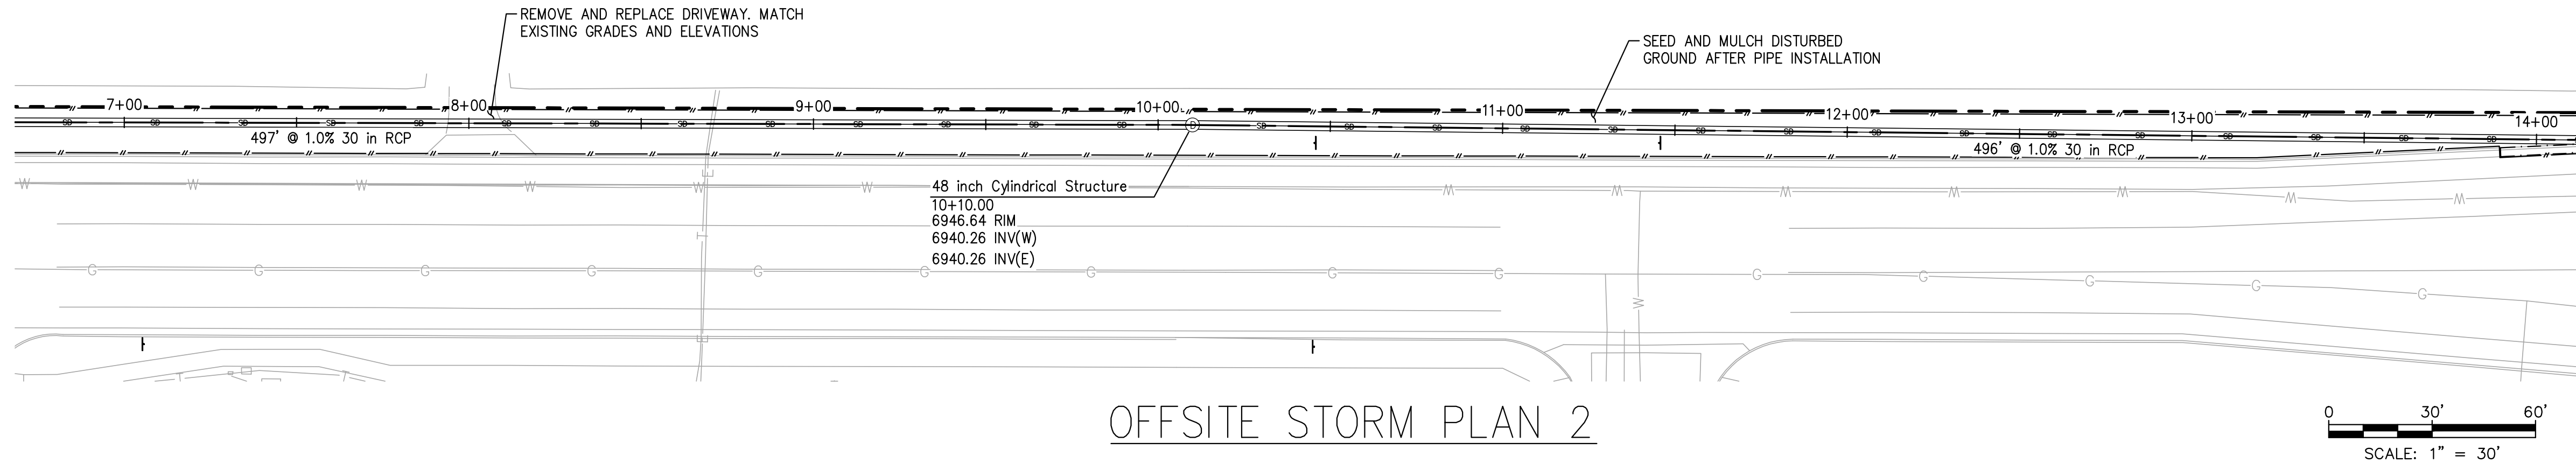

UTILITY CROSSING NOTE:
UTILITY CROSSING DEPTHS ARE UNKNOWN. 1.5' OF SEPARATION MUST BE KEPT BETWEEN THE OFFSITE STORM SYSTEM AND ANY UTILITY CROSSING. CONTRACTOR TO VERIFY THE UTILITY LOCATION AND DEPTHS OF ALL UTILITIES. UTILITIES THAT HAVE LESS THAN 1.5' SEPARATION MUST BE LOWERED PER DETAIL W-19/W-20 ON SHEET 35.

OFFSITE STORM P&P 2

HONOR CHARTER SCHOOL
HIGHMARK SCHOOL DEVELOPMENT
8250 BENT GRASS MEADOWS DR.

DRAWING CW
DATE: 11/11/2024
CHECKED:
DATE:
REVISION #:
DATE:
JOB NO. CO1517

33
OF
38

2/6/2024 Internal Review #1

320 North Lincoln Avenue
Loveland, CO 80537
p: 970.613.1447
www.tait.com
ENGINEERING ENVIRONMENTAL BUILDING LAND
Surveying Planning Denver
Since 1944
Dolans

TAIT
& ASSOCIATES

NO.	DESCRIPTION	BY	DATE

Jul 24, 2026 - 1:04pm by rromstetter A:\ENGINEERING\CO\CO15170 - Honor Charter School - Payson, CO\ENR\Construction Drawings\CO1517_20.dwg



Know what's below
Call before you dig.

UNAUTHORIZED CHANGES & USES

THE ENGINEER PREPARING THESE PLANS WILL NOT BE RESPONSIBLE FOR, OR LIABLE FOR, UNAUTHORIZED CHANGES TO OR USES OF THESE PLANS. ALL CHANGES OF THESE PLANS MUST BE IN WRITING AND MUST BE APPROVED BY THE PREPARER OF THESE PLANS PRIOR TO CONSTRUCTION. CONSTRUCTION CONTRACTOR AGREES THAT IN ACCORDANCE WITH GENERALLY ACCEPTED CONSTRUCTION PRACTICES, CONSTRUCTION CONTRACTOR WILL BE REQUIRED TO ASSUME SOLE AND COMPLETE RESPONSIBILITY FOR JOB SITE CONDITIONS DURING THE COURSE OF CONSTRUCTION OF THE PROJECT, INCLUDING SAFETY OF ALL PERSONS AND PROPERTY, THAT THIS REQUIREMENT SHALL BE MADE TO APPLY CONTINUOUSLY AND NOT BE LIMITED TO NORMAL WORKING HOURS, AND CONSTRUCTION CONTRACTOR FURTHER AGREES TO DEFEND, INDEMNIFY AND HOLD DESIGN PROFESSIONAL HARMLESS FROM ANY AND ALL LIABILITY, REAL OR ALLEGED, IN CONNECTION WITH THE PERFORMANCE OF WORK ON THIS PROJECT, EXCEPTING LIABILITY ARISING FROM THE SOLE NEGLIGENCE OF DESIGN PROFESSIONAL.

NOTE TO CONTRACTOR



THE EXISTENCE AND LOCATION OF ANY UNDERGROUND UTILITIES, PIPES, AND/OR STRUCTURES SHOWN ON THESE PLANS WERE OBTAINED BY A SEARCH OF AVAILABLE RECORDS. THERE MAY BE EXISTING UTILITIES NOT SHOWN ON THESE PLANS. THE CONTRACTOR SHALL ASCERTAIN THE TRUE VERTICAL AND HORIZONTAL LOCATION OF THOSE UNDERGROUND UTILITIES TO BE USED PRIOR TO CONSTRUCTION AND SHALL BE RESPONSIBLE FOR ANY DAMAGE TO ANY PUBLIC OR PRIVATE UTILITIES, SHOWN OR NOT SHOWN HEREON.

BASIS OF BEARINGS:



BEARINGS ARE BASED ON THE WESTERLY BOUNDARY OF THE SUBJECT PARCEL COINCIDENT WITH THE EASTERLY BOUNDARY OF THE BENT GRASS RESIDENTIAL FILING NO.2, MONUMENTED ON THE NORTH END WITH A NO.5 REBAR & 1-3/8" RED PLASTIC CAP MARKED "ALC PLS 38087", FOUND FLUSH WITH GRADE, AND ON THE SOUTH END WITH A NO. 4 REBAR & 1" ORANGE PLASTIC CAP MARKED "PLS 38141", RECOVERED 0.6' BELOW GRADE, AND IS ASSUMED TO BEAR N 00°08'14" E A MEASURED DISTANCE OF 619.52 FEET.

BENCHMARK:

ELEVATIONS ARE BASED ON THE PROJECT BENCHMARK IDENTIFIED AS JK0239 ELEVATION=6902.3'(NAVD88), PER DATA PUBLISHED BY THE NATIONAL GEODETIC SURVEY.

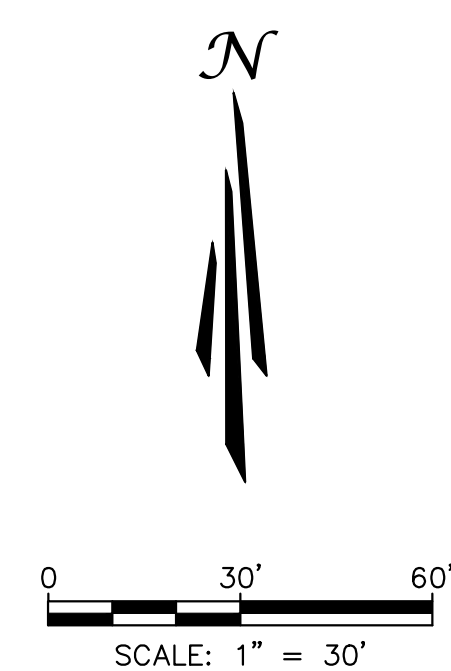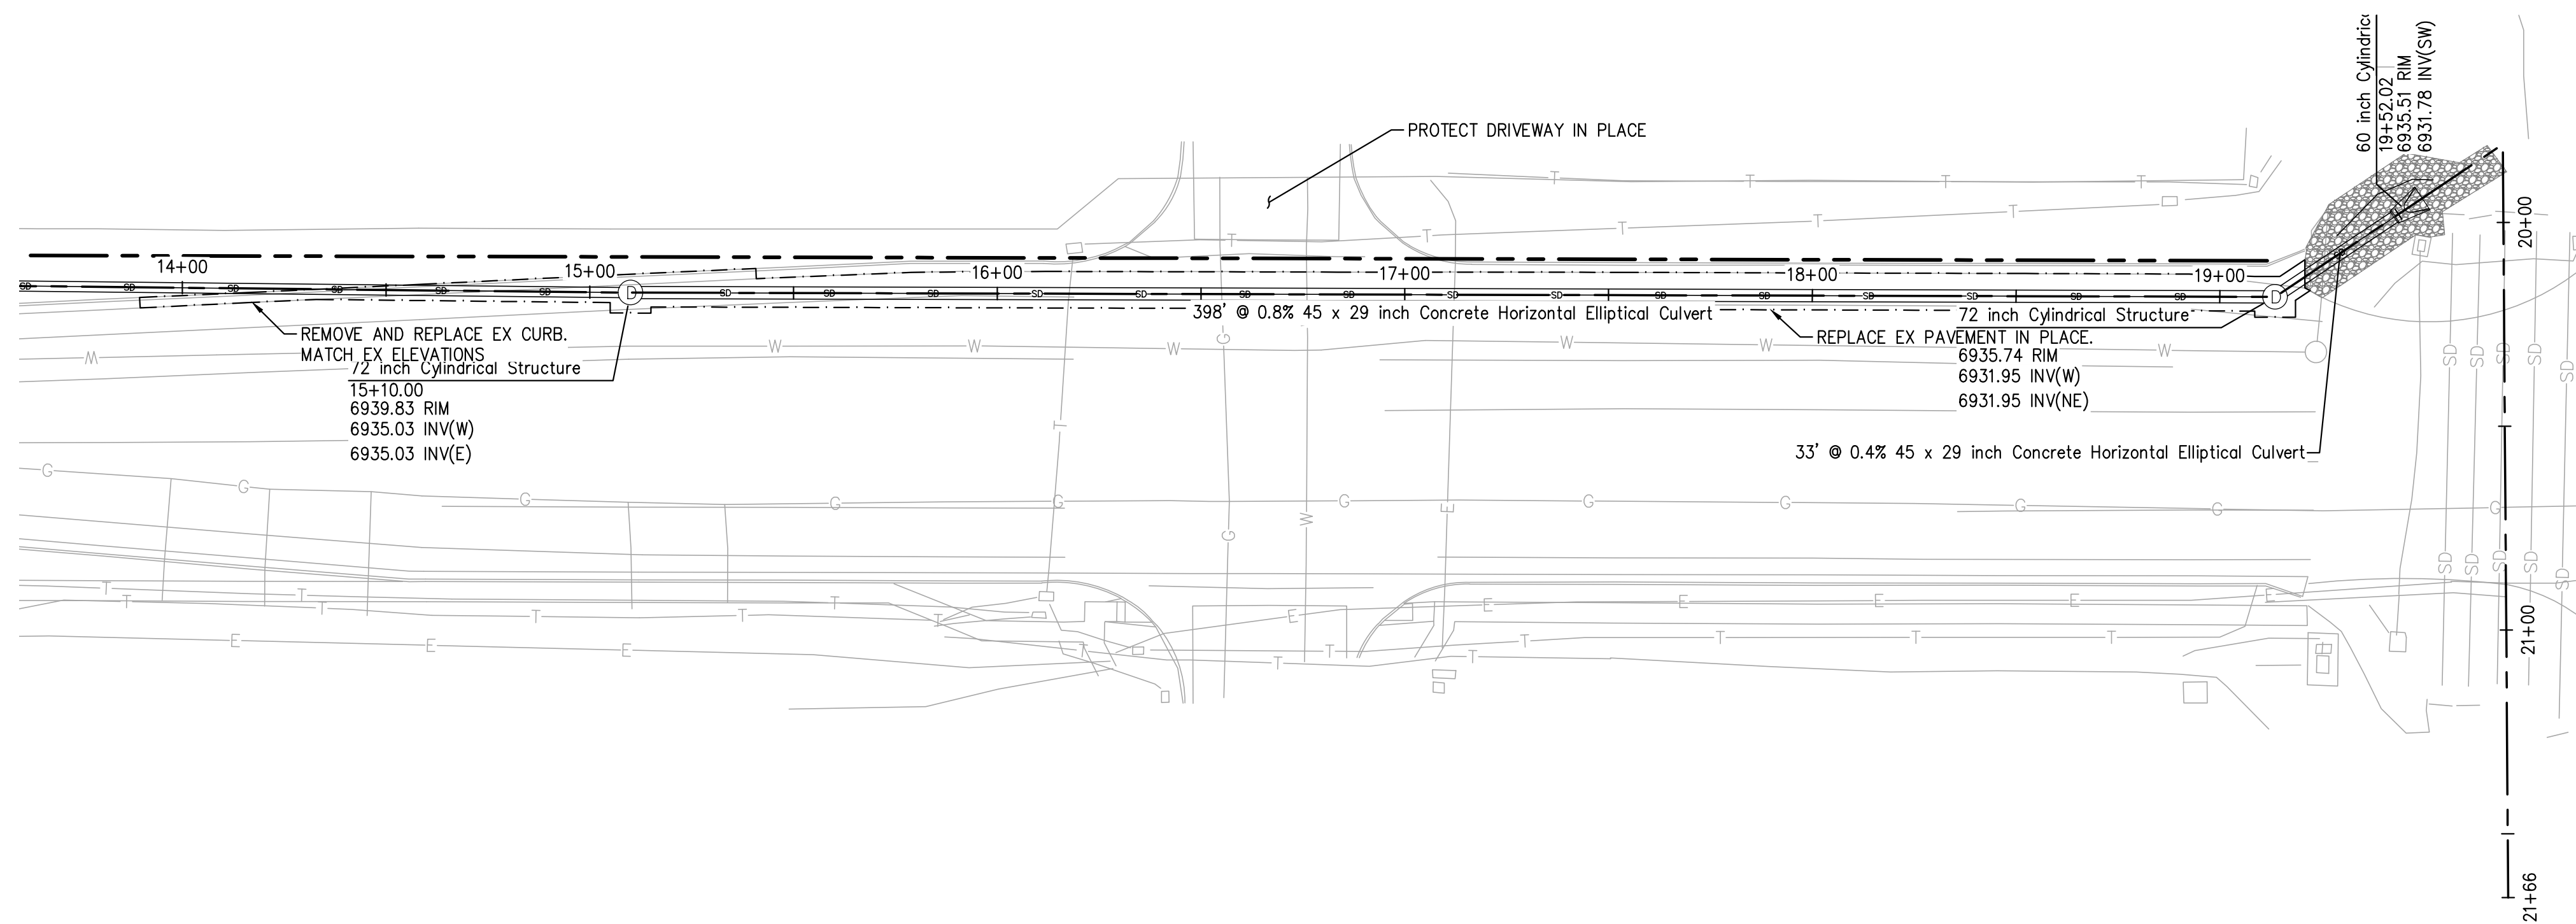



SYMBOLS LEGEND	
	PROPERTY LINE
	ADJACENT PROPERTY LINE
	ROW LINE
	BUILDING SETBACK LINE
	PROPOSED EASEMENT
	LIMIT OF DISTURBANCE
	EXISTING WATER LINE
	EXISTING SEWER LINE
	PROPOSED TELEPHONE SERVICE LINE
	PROPOSED ELECTRIC SERVICE LINE
	PROPOSED WATER SERVICE LINE
	PROPOSED SS SERVICE LINE
	PROPOSED STORM DRAIN
	PROPOSED RIDGELINE
	PROPOSED GRADE BREAK
	PROPOSED TOP OF POND
	PROPOSED BOTTOM OF POND
	PROPOSED SIGN
	PROPOSED SS CLEANOUT
	PROPOSED BACKFLOW PREVENTOR
	EXISTING FIRE HYDRANT
	PROPOSED FIRE HYDRANT
	PROPOSED STREET LIGHT
	EXISTING INLET
	PROPOSED INLET
	PROPOSED STORM INFRASTRUCTURE
	PROPOSED STORM MANHOLE
	PROPOSED TEE / THRUST BLOCK
	PROPOSED FLARED-END SECTION
	EXISTING SANITARY SEWER MANHOLE

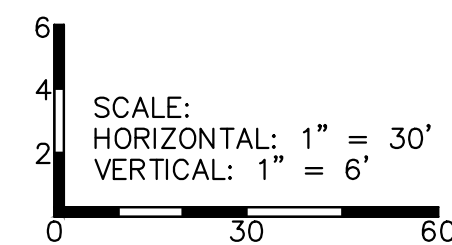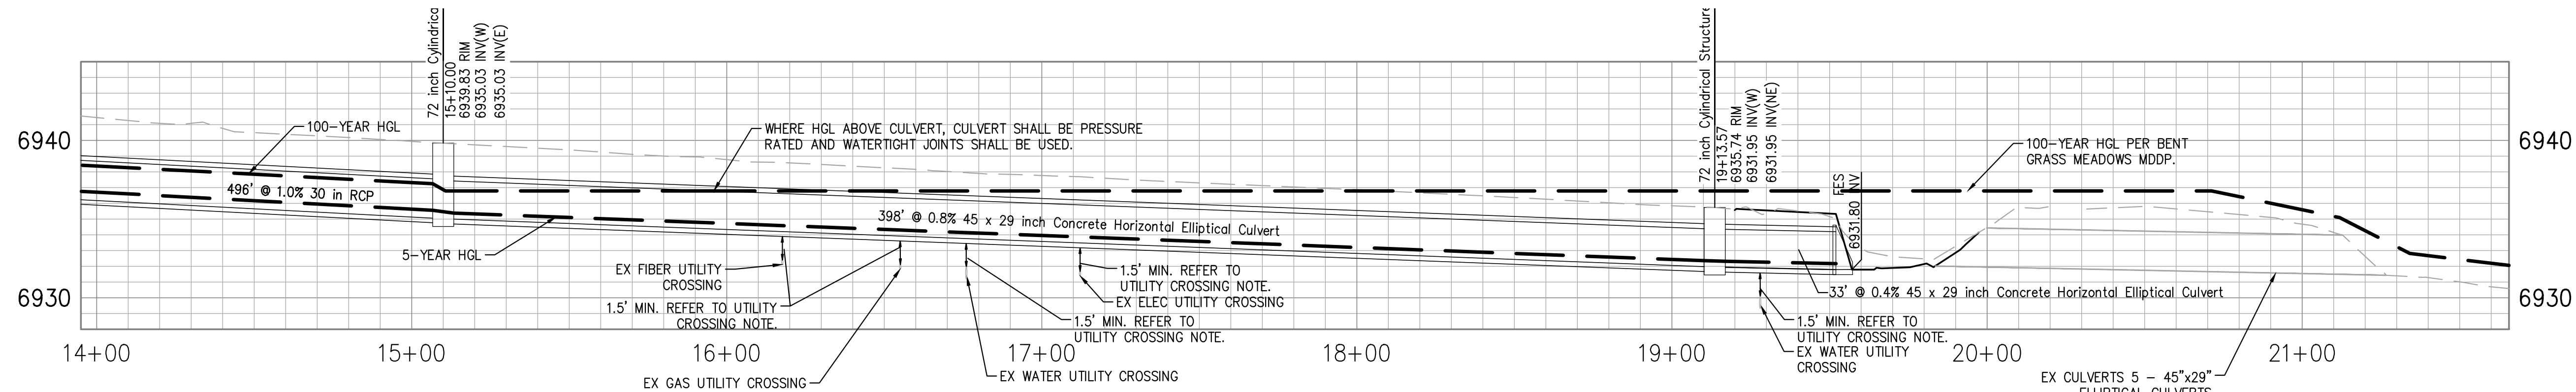

OFFSITE STORM PROFILE 3

UTILITY CROSSING NOTE:

UTILITY CROSSING DEPTHS ARE UNKNOWN. 1.5' OF SEPARATION MUST BE KEPT BETWEEN THE OFFSITE STORM SYSTEM AND ANY UTILITY CROSSING. CONTRACTOR TO VERIFY THE UTILITY LOCATION AND DEPTHS OF ALL UTILITIES. UTILITIES THAT HAVE LESS THAN 1.5' SEPARATION MUST BE LOWERED PER DETAIL W-19/W-20 ON SHEET 35.

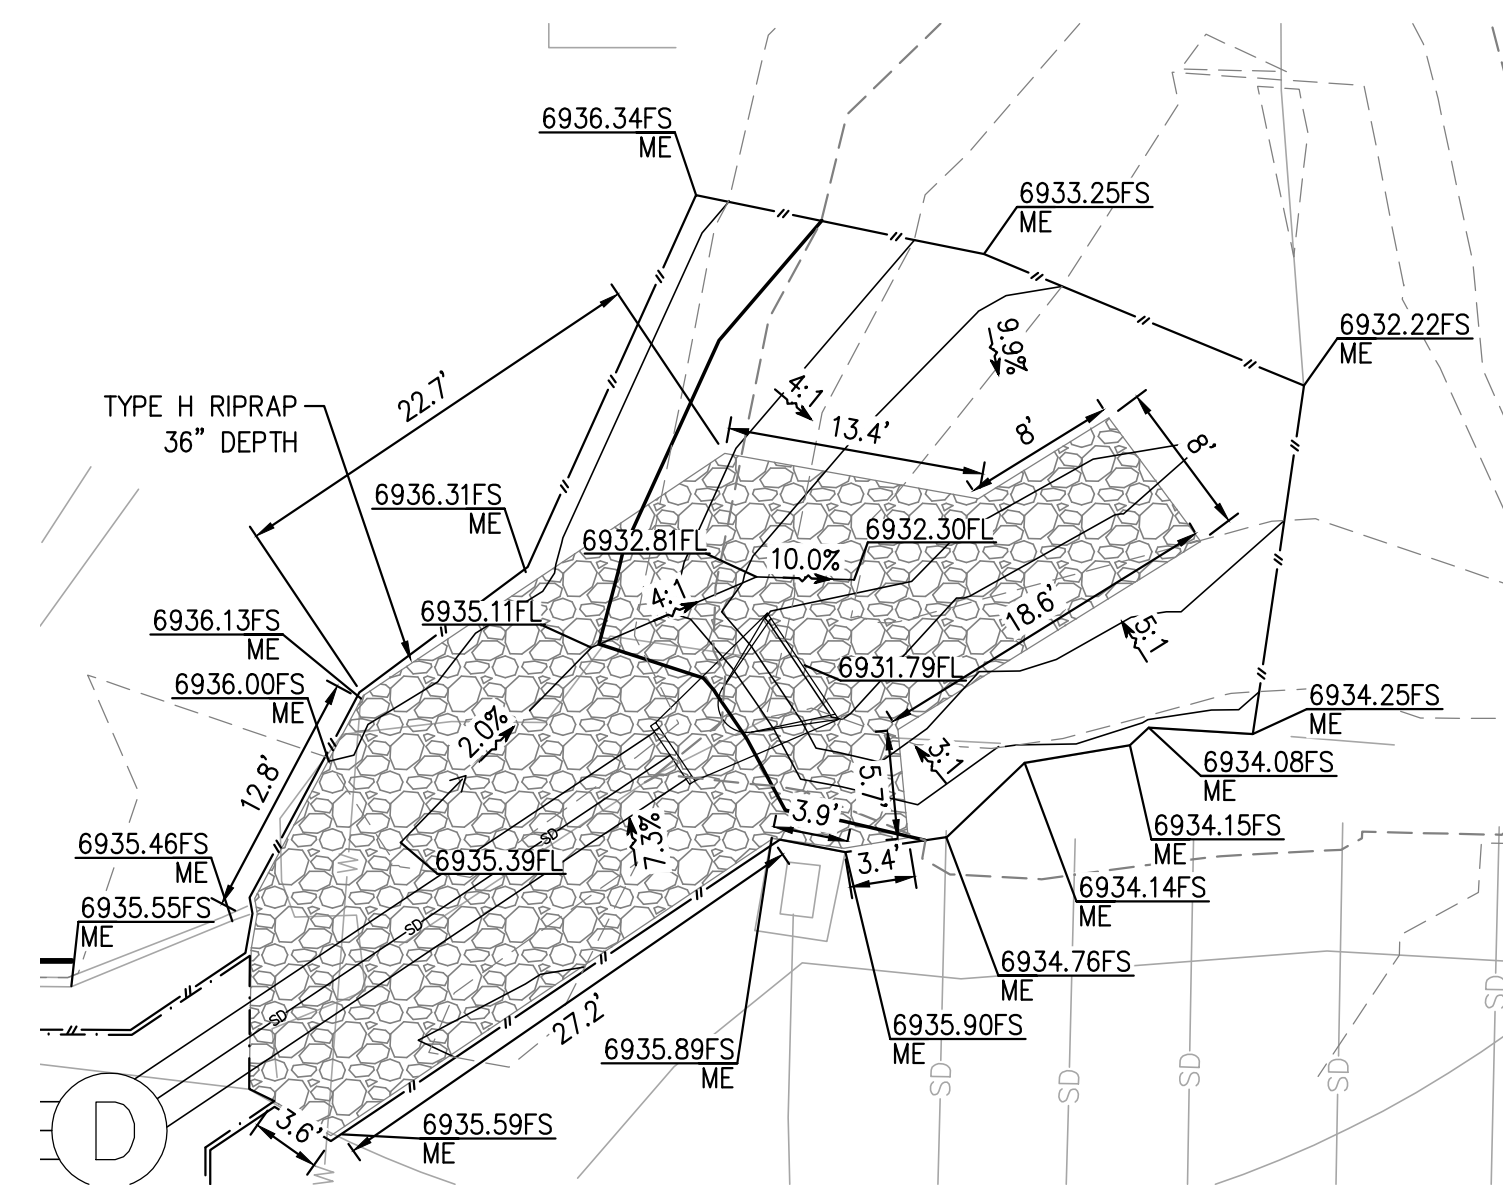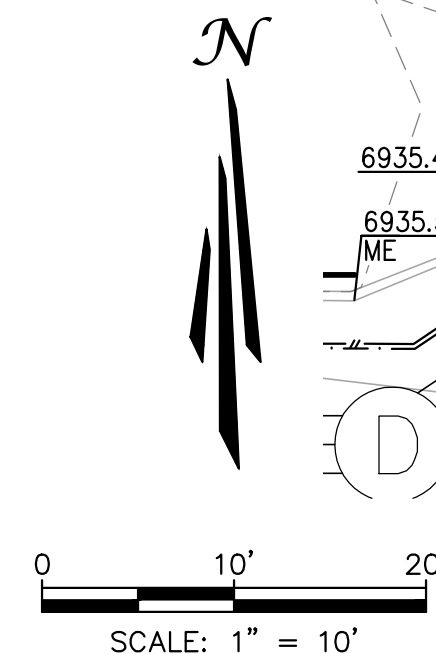

FES GRADING DETAIL

PCD FILE NO. PPR2615

PREPARED UNDER THE SUPERVISION OF
TAIT & ASSOCIATES, INC.

DRAWING CW	CHECKED	DATE
DATE	DATE	DATE
DATE	DATE	DATE
DATE	DATE	DATE

34
OF
38

BRIAN CAMPBELL
COLORADO P.E. #40196

OFFSITE STORM P&P 3
HONOR CHARTER SCHOOL
HIGHMARK SCHOOL DEVELOPMENT
8250 BENT GRASS MEADOWS DR.



320 North Lincoln Avenue
Loveland, CO 80537

p: 970.613.1447
www.tait.com

ENGINEERING ENVIRONMENTAL BUILDING LAND
Surveying Surveying Surveying Surveying
Surveying Surveying Surveying Surveying

JOB NO. CO1517

2/6/2024 Internal Review #1