



NO.	DESCRIPTION

BY: _____
 SHEET TITLE: **SITE PLAN**


ADDRESS: **1365 Murphy Rd.
 Elbert, CO 80106**

DESIGNER: **Arise Building and
 Restoration**

DATE: _____

SCALE: _____

SHEET: **S-1**

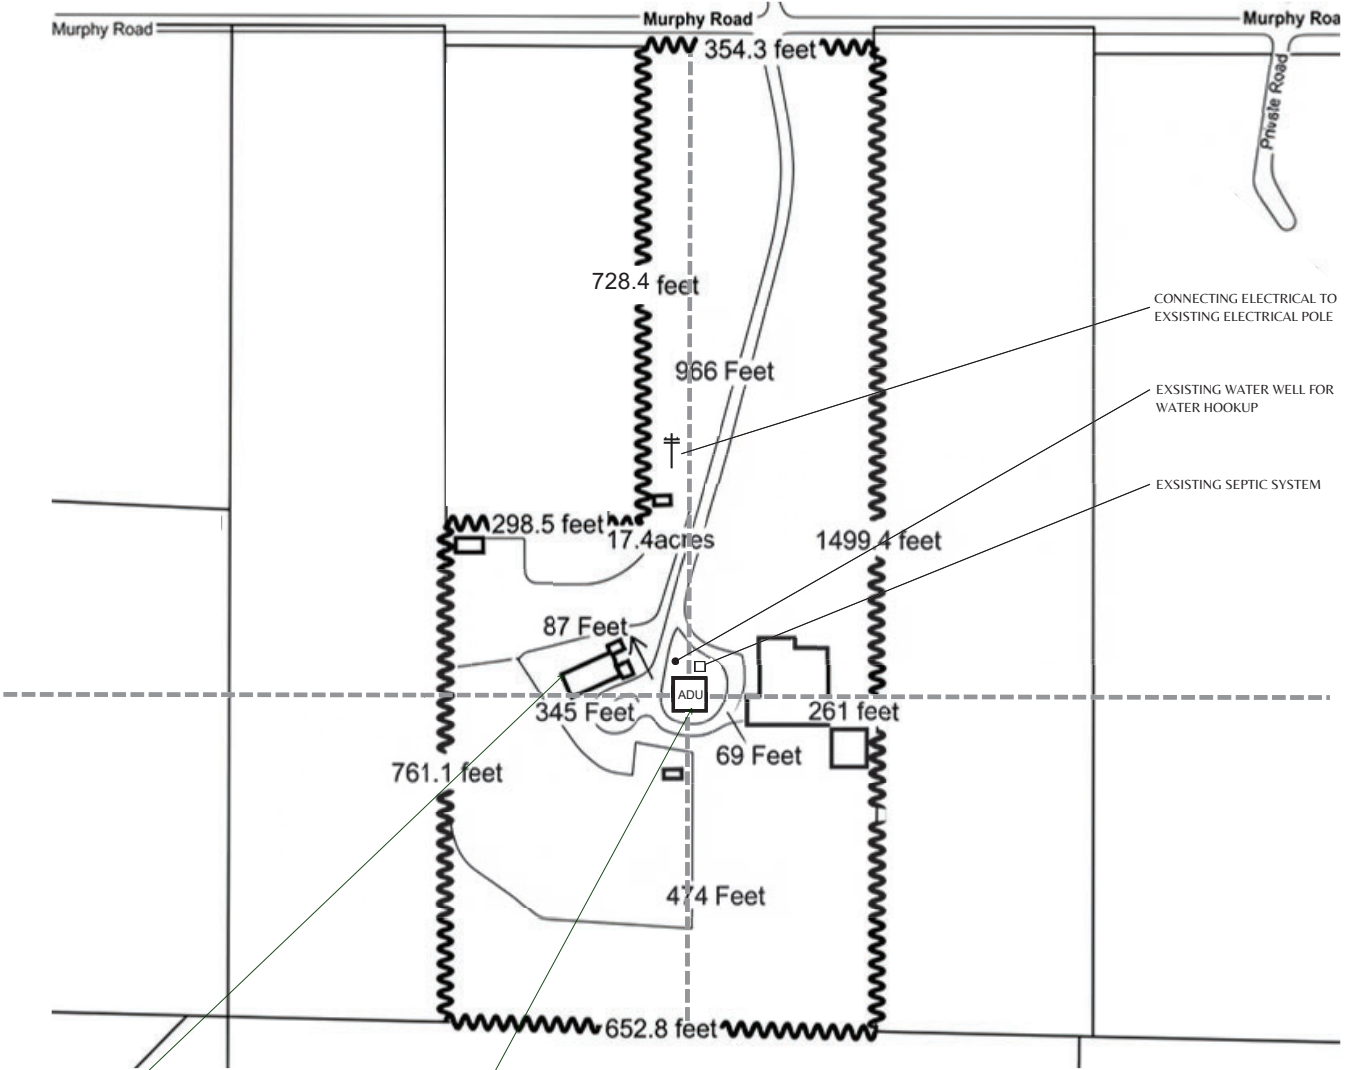

Please label and add the square footage of all structures including the primary home, accessory structures etc.

Please label as "Proposed ALQ"

Please review Falcon Fire comments regarding depicting truck turn around.

Please add the following: north arrow, parcel #4205003008, RR-5 zoning, ownership info, and legal description.

Please add: PCD File No. AL2615