


# THE SOD GUY - SALES LOT

SITE DEVELOPMENT PLANS  
LOT 1, APPALOOSA HIGHWAY 24 SUBDIVISION

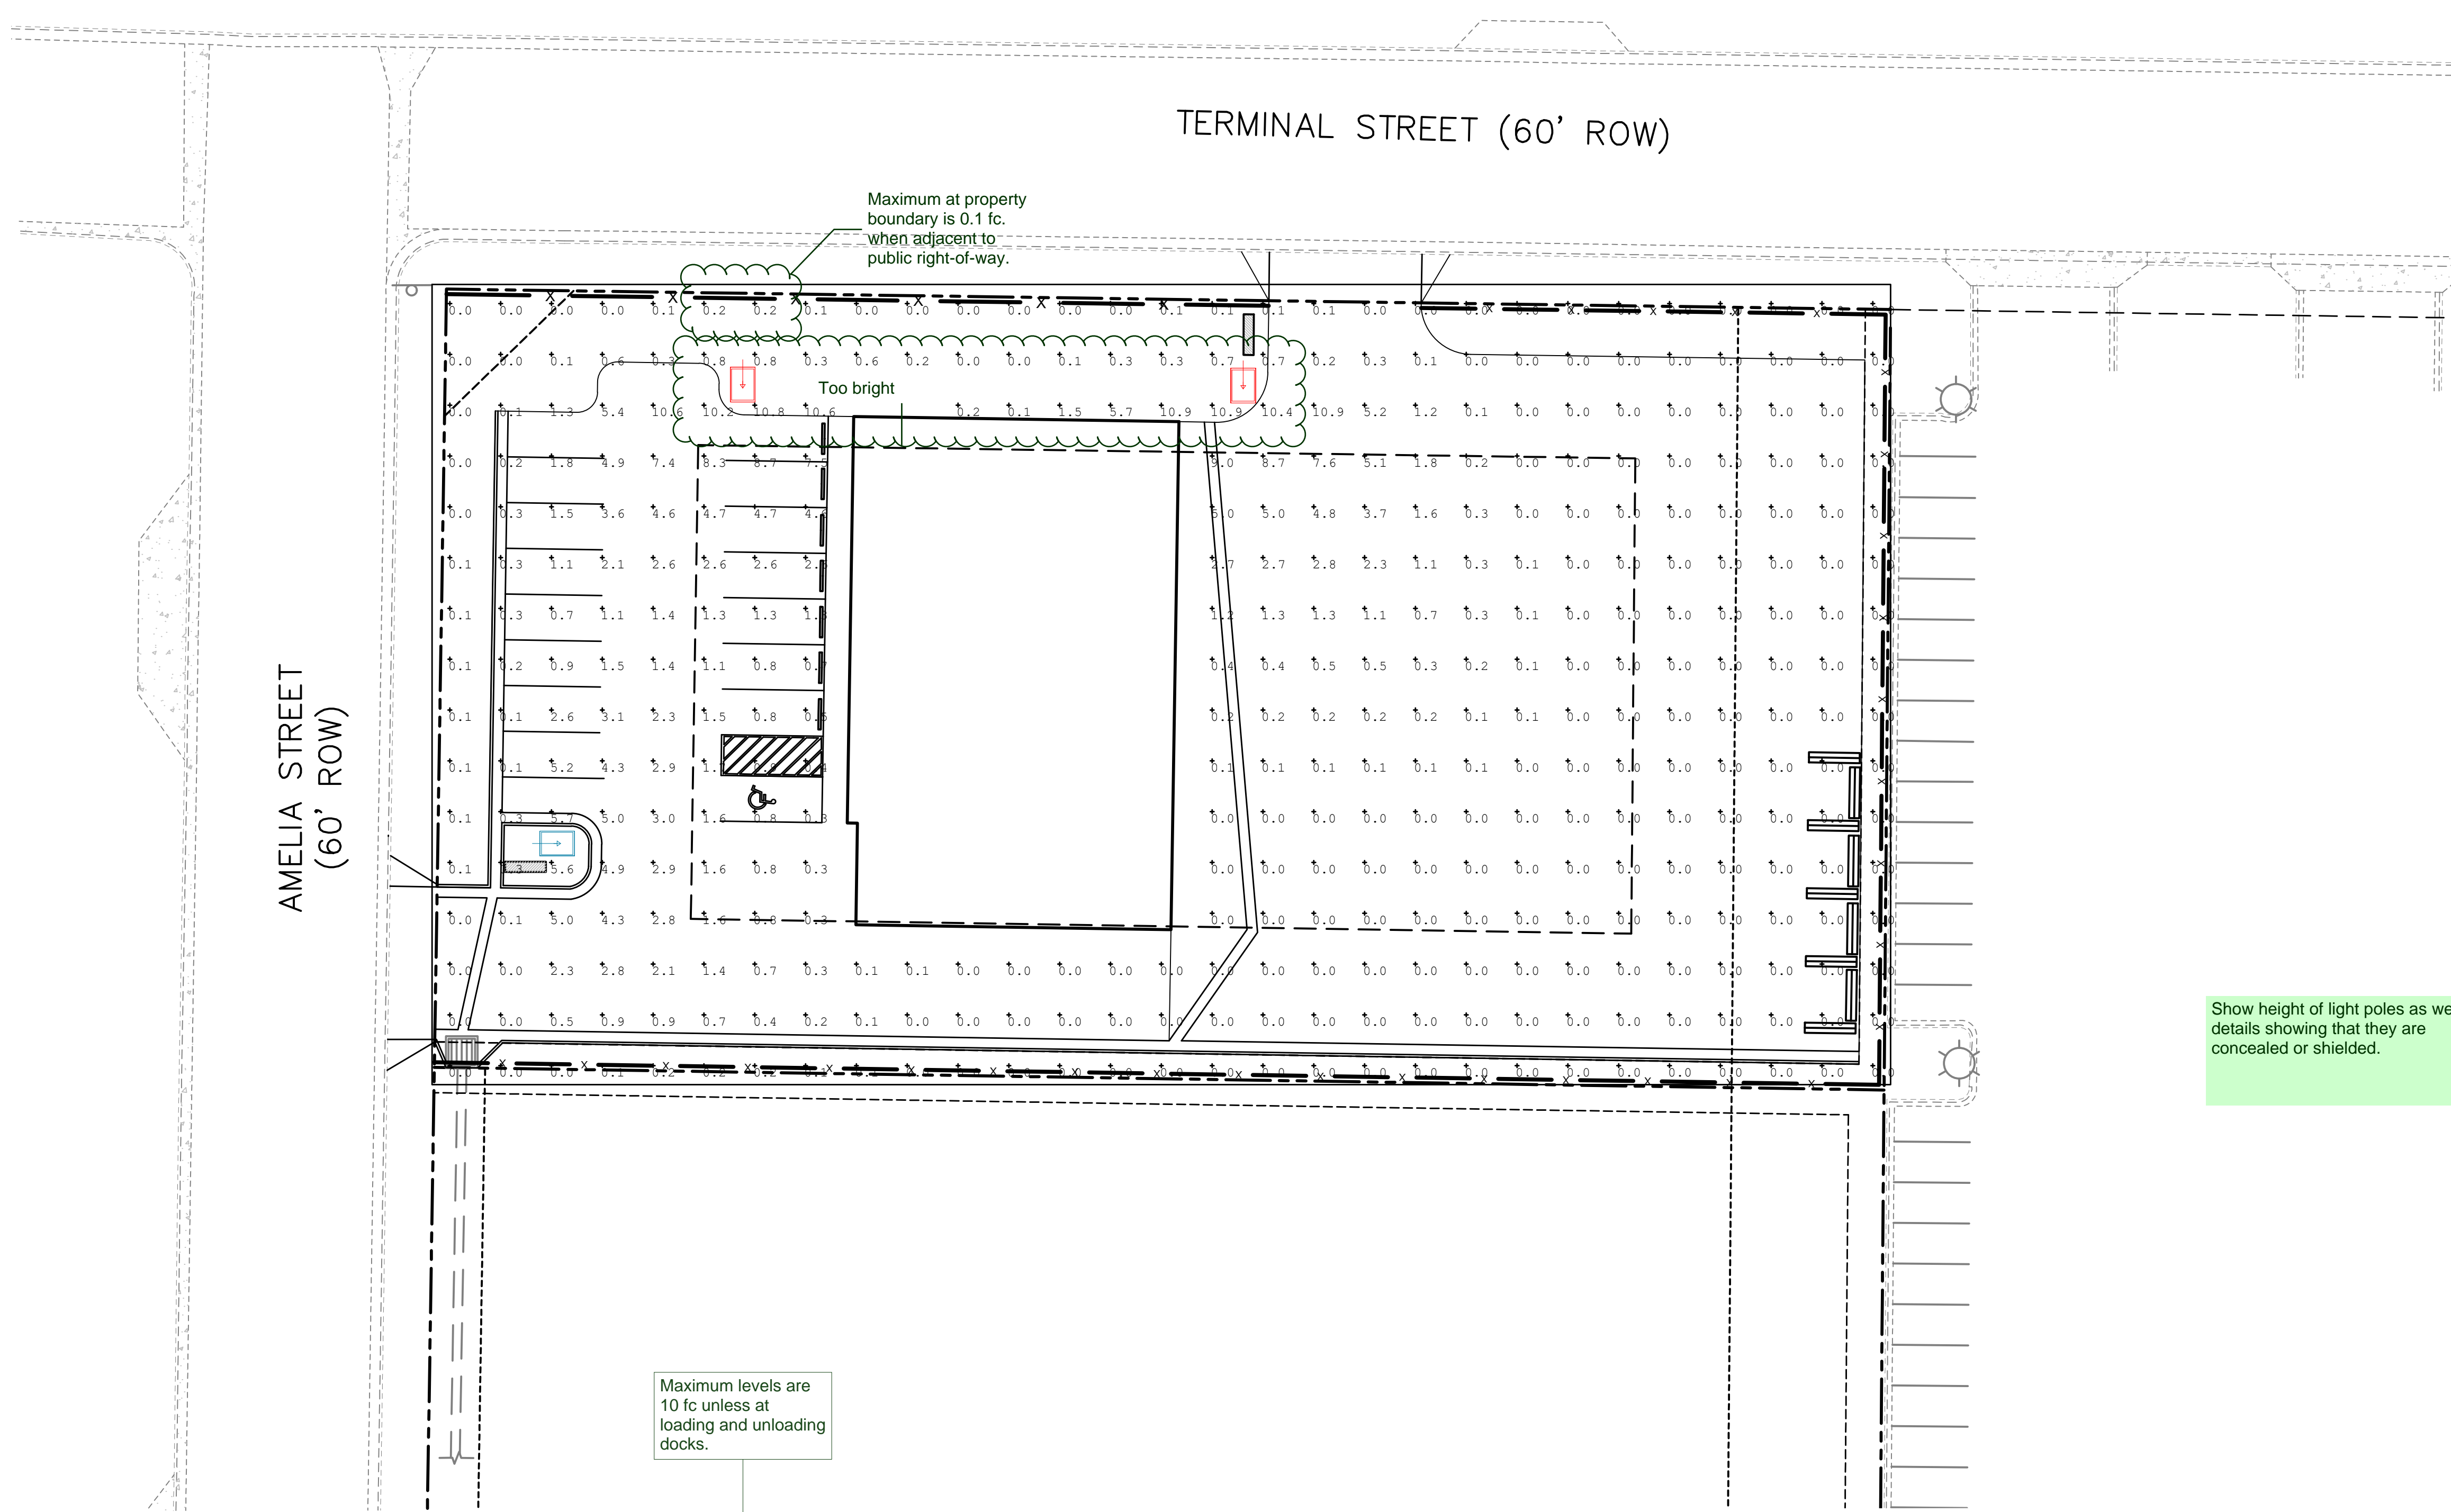


Show height of light poles as well as details showing that they are concealed or shielded.

Maximum levels are 10 fc unless at loading and unloading docks.

Calculation Summary						
Label	Units	Avg	Max	Min	Avg/Min	Max/Min
Overall Area	Fc	0.94	10.9	0.0	N.A.	N.A.
Property Line	Fc	0.01	0.1	0.0	N.A.	N.A.
Overall Lot	Fc	0.95	10.9	0.0	N.A.	N.A.

Luminaire Schedule						
Symbol	Qty	Label	Lum. Watts	sm. Lumens	LF	Description
	1	AA	225	19935	0.900	GLEON-AF-04-LED-E1-SLR HSS
	1	BB	113	10111	0.900	GLEON-AF-02-LED-E1-SLR HSS

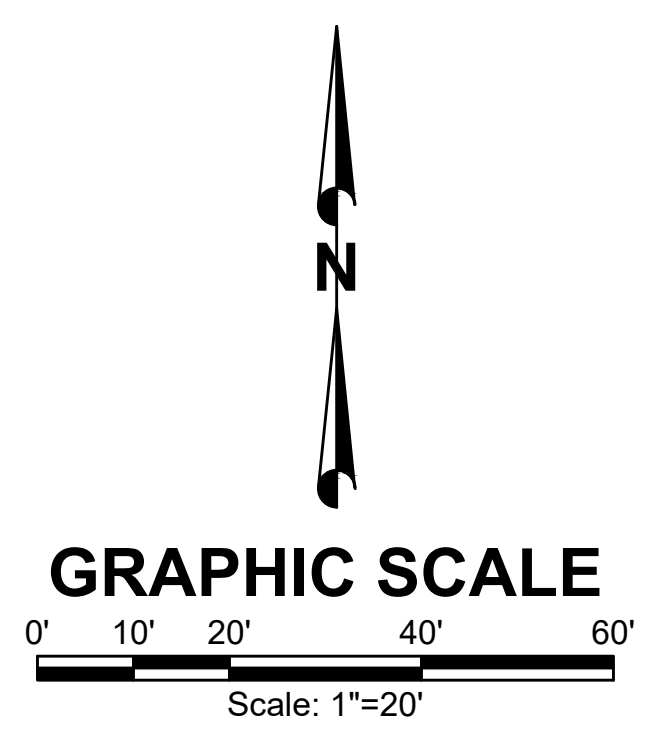

P:\Clients\The Sod Guy\CAD\Development Plan\Lighting Plan.dwg ----- 3/5/2019 4:08 PM

NO.	REVISIONS	BY	DATE

**FORSGREN**  
*Associates, Inc.*  
56 Inverness Drive East, Suite 112, Englewood, CO 80112  
PH: 720.214.5884 FAX: 720.000.0000

PROJECT NO.	
DRAWN	
DESIGNED	
APPROVED	
DATE	


**OWNER**  
THE SOD GUY  
COLORADO SPRINGS, CO

**SALES LOT - SPECIAL USE**  
**LIGHTING PLAN**

SHEET NO:  
**LP-01**  
DATE:  
12/30/18  
PAGE NO:  
1 OF 1

# Lighting\_v1-redline.pdf Markup Summary


Maximum at property boundary is 0.1 fc. when adjacent to public right-of-way. (1)

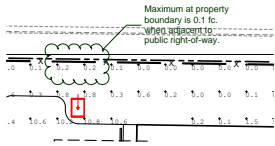

**Subject:** Cloud+  
**Page Label:** [1] C-01  
**Lock:** Unlocked  
**Author:** dsdkendall  
**Date:** 6/14/2019 11:05:14 AM  
**Status:**  
**Color:** ■  
**Layer:**  
**Space:**

Maximum at property boundary is 0.1 fc. when adjacent to public right-of-way.


Maximum levels are 10 fc unless at loading and unloading docks. (1)

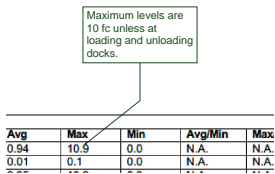

**Subject:** Callout  
**Page Label:** [1] C-01  
**Lock:** Unlocked  
**Author:** dsdkendall  
**Date:** 6/14/2019 11:06:25 AM  
**Status:**  
**Color:** ■  
**Layer:**  
**Space:**

Maximum levels are 10 fc unless at loading and unloading docks.


Show height of light poles as well as details showing that they are concealed or shielded. (1)

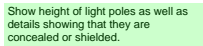

**Subject:** Text Box  
**Page Label:** [1] C-01  
**Lock:** Unlocked  
**Author:** dsdkendall  
**Date:** 6/14/2019 11:07:51 AM  
**Status:**  
**Color:** ■  
**Layer:**  
**Space:**

Show height of light poles as well as details showing that they are concealed or shielded.

Too bright (1)

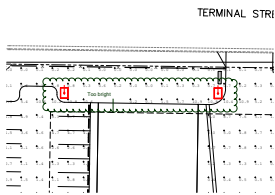

**Subject:** Cloud+  
**Page Label:** [1] C-01  
**Lock:** Unlocked  
**Author:** dsdkendall  
**Date:** 6/14/2019 11:06:43 AM  
**Status:**  
**Color:** ■  
**Layer:**  
**Space:**

Too bright