
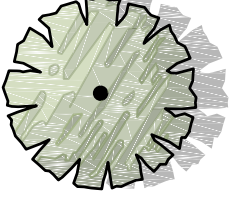


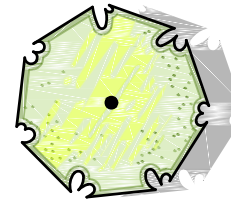


# PLANT SCHEDULE

TREES    COMMON NAME    CONT    CAL    SIZE    QTY


	Concolor Fir	B & B		7"	3
	Sunburst Common Honeylocust	B & B	2"Cal		3

# PLANT SCHEDULE


SHRUBS    COMMON NAME    SIZE    QTY

	Calgary Carpet Juniper	5 gal	5
	Dwarf Korean Lilac	5 gal	6
	Jackman's Potentilla	5 gal	8

# SITE KEY

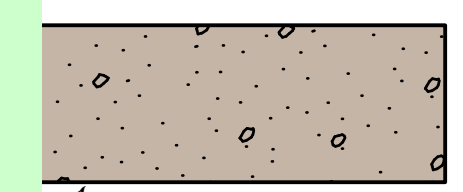


1 1/2" RIVER ROCK

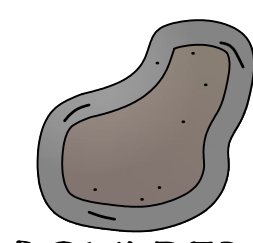

BOULDER


Show how many trees are required as well as provided. Show which type of landscaping they are for, for example:  
 Roadway Landscaping: Required/Provided  
 Internal Landscaping: Required/provided - percentage and trees  
 Etc.

Show distance of frontage.

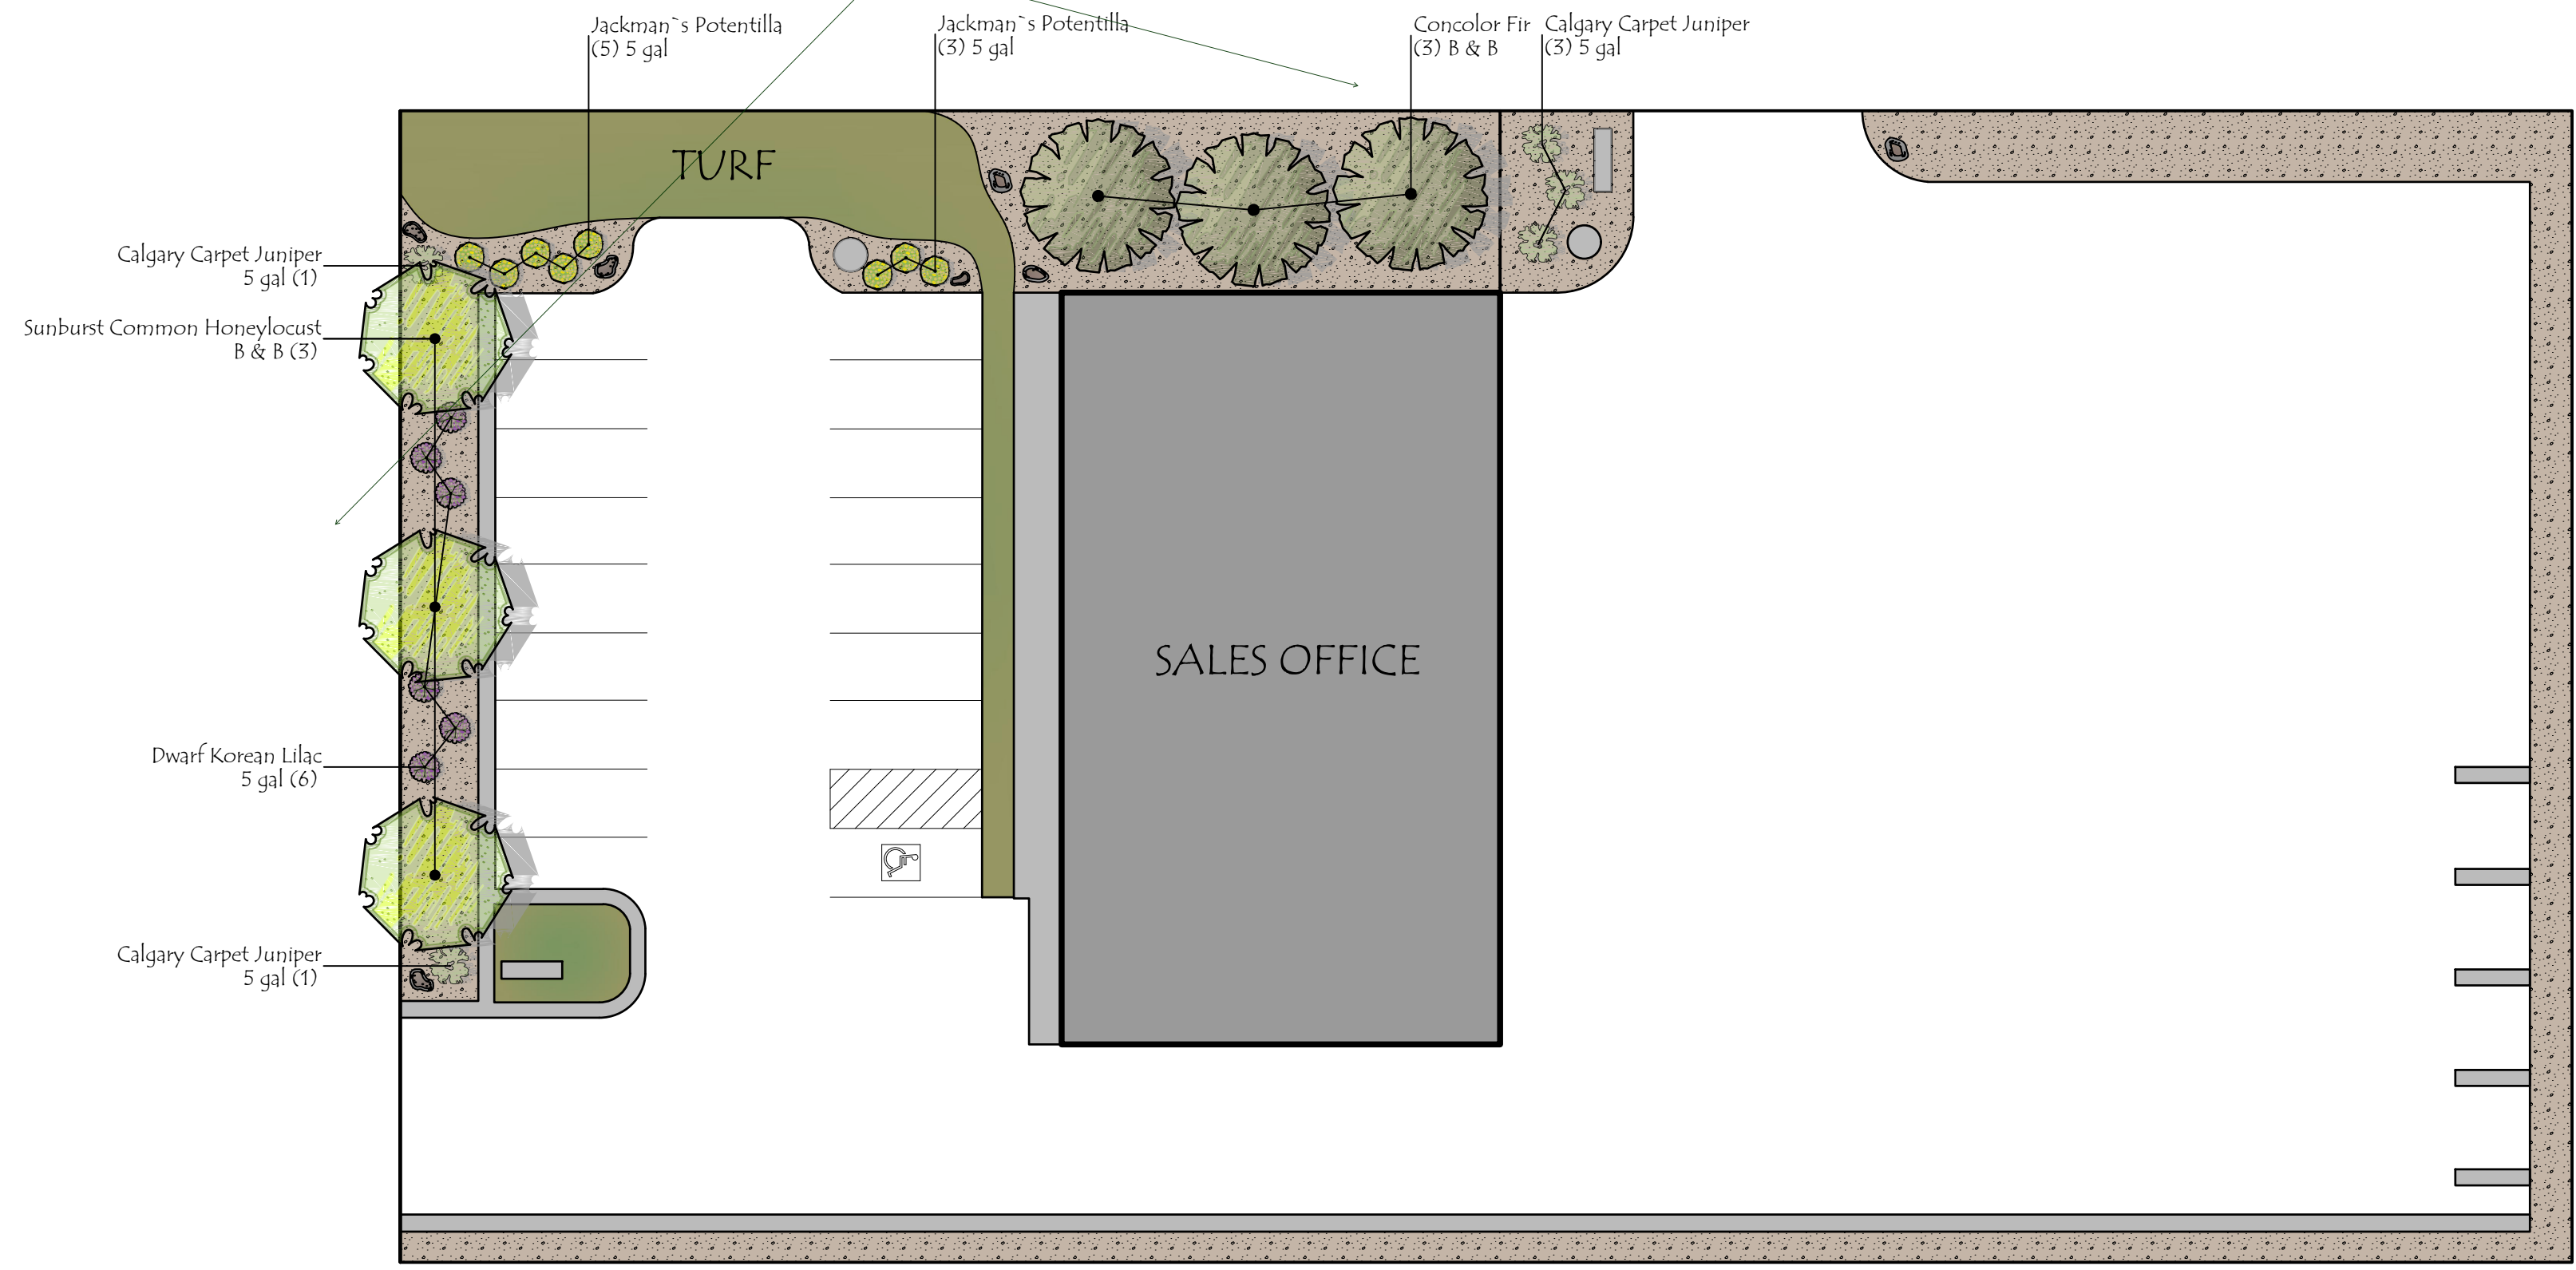

5 percent of lot area should be internal landscaping, 75% of that should be live ground cover, an alternative landscape plan may be requested, approval of that would be at the Director's discretion.

See chapter 6 of Land Development Code for landscaping requirements.

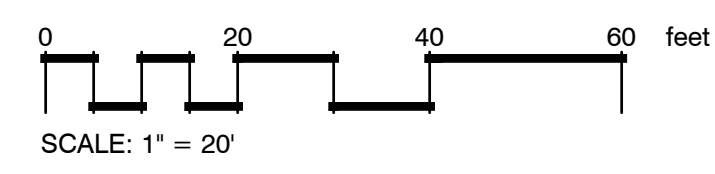

42600 SUMMIT VIEW CT.  
PARKER, COLORADO

## PROJECT INFO

OFFICE // 303.841.7338  
 FAX // 303.841.9796  
 INFO@HUGHESLANDSCAPINGINC.COM

DESIGNED BY: ALEX QUARNBERG  
 ONSITE FOREMAN:

PLAN DRAWN BY: ALEX QUARNBERG

HOMEOWNERS:

CONTACT: . . .  
 @YAHOO.COM

## DRAFT DATES

1ST DRAFT	2-20-19
2ND DRAFT	2-21-19
3RD DRAFT	
4TH DRAFT	

THE  
 SOD GUY  
 COLORADO SPRINGS, CO




NORTH

LANDSCAPE PLAN  
 SHEET 1 OF 1

# Landscape\_v1-redline.pdf Markup Summary

5 percent of lot area should be internal landscaping, 75% of that should be live ground cover, an alternative landscape plan may be

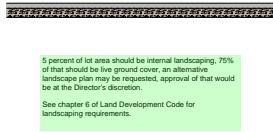


**Subject:** Text Box  
**Page Label:** [1] Sod Guy Springs Plan-18x24  
**Lock:** Unlocked  
**Author:** dsdkendall  
**Date:** 6/14/2019 11:03:36 AM  
**Status:**  
**Color:** ■  
**Layer:**  
**Space:**

5 percent of lot area should be internal landscaping, 75% of that should be live ground cover, an alternative landscape plan may be requested, approval of that would be at the Director's discretion.

See chapter 6 of Land Development Code for landscaping requirements.

Show distance of frontage. (1)

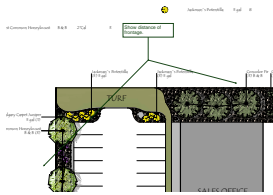

**Subject:** Callout  
**Page Label:** [1] Sod Guy Springs Plan-18x24  
**Lock:** Unlocked  
**Author:** dsdkendall  
**Date:** 6/14/2019 11:00:27 AM  
**Status:**  
**Color:** ■  
**Layer:**  
**Space:**

Show distance of frontage.

Show how many trees are required as well as provided. Show which type of landscaping they are for, for example: Roadway Land



**Subject:** Text Box  
**Page Label:** [1] Sod Guy Springs Plan-18x24  
**Lock:** Unlocked  
**Author:** dsdkendall  
**Date:** 6/14/2019 11:00:46 AM  
**Status:**  
**Color:** ■  
**Layer:**  
**Space:**

Show how many trees are required as well as provided. Show which type of landscaping they are for, for example:

Roadway Landscaping:  
Required/Provided  
Internal Landscaping: Required/provided  
- percentage and trees

Etc.