

**T-Mobile**

880 DELAWARE STREET  
DENVER, CO 80202

PROJECT INFORMATION:

CUCHARES RANCH  
DNO3486D  
9260 DRENNAN ROAD  
COLORADO SPRINGS, CO 80925  
EL PASO COUNTY


CURRENT ISSUE DATE: 1/4/05

ISSUED FOR CONSTRUCTION

| REV. DATE | DESCRIPTION       | TC |
|-----------|-------------------|----|
| 01/30/04  | PRELIM. ZONING    | TC |
| 02/24/04  | ZONING            | TC |
| 03/11/04  | REV. ZONING       | TC |
| 07/15/04  | PRELIM. CONST. DB | DB |
| 12/28/04  | FINAL CONST. DB   | DB |
| 1/4/05    | REV. CONST. DB    | DB |
|           |                   |    |
|           |                   |    |

PLANS PREPARED BY:  
**SI** Communication Services, Inc.  
7720 E. Bellevue, Ste. B-230  
Englewood, Co. 80111  
Telephone: (303) 740-9885  
Fax: (303) 740-9608


DRAWN BY: CHK. DMB. APP. M/S

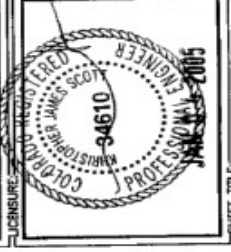

SHEET TITLE: SITE PLAN


SHEET NUMBER: A1

DATE: 1/05

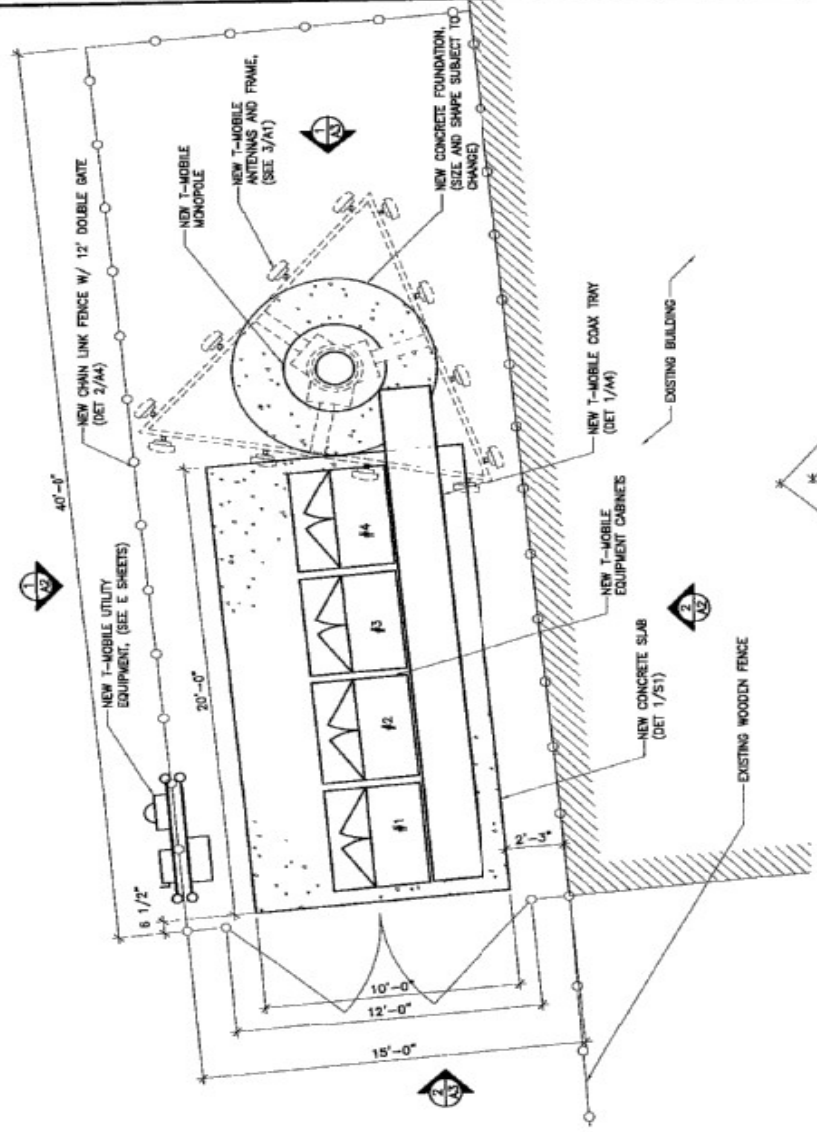


2 ENLARGED SITE PLAN  
3/8" = 1'-0"

Please provide a current elevation plan view that shows the new antenna array being added with profile etc. This is the original site plan

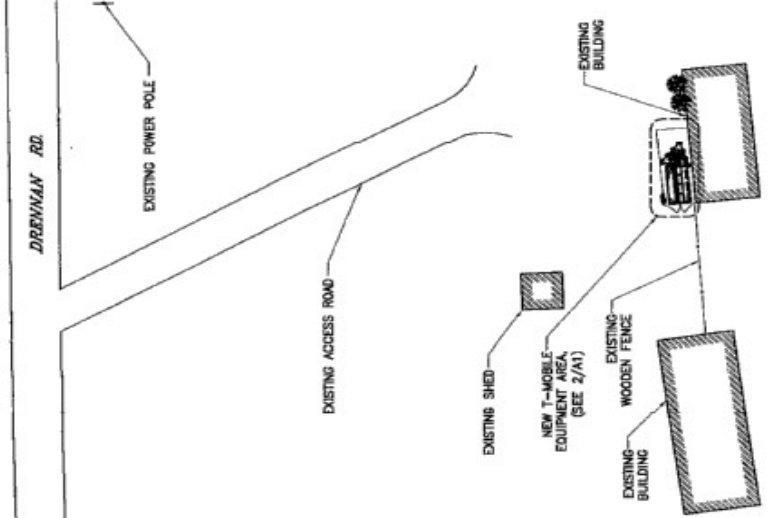

1 SITE PLAN  
1/8" = 1'-0"

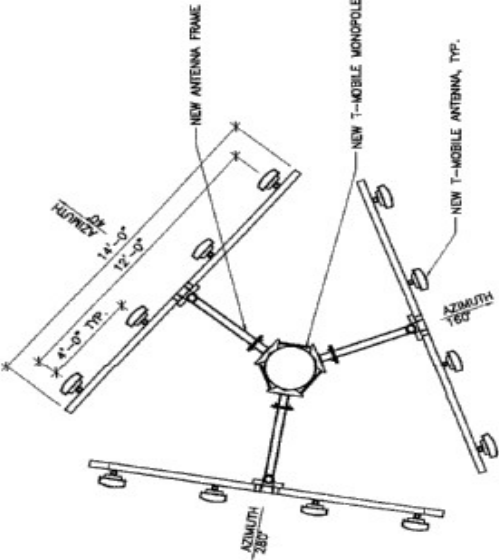

3 ANTENNA DETAIL  
3/8" = 1'-0"