



2383 DELAWARE STREET
DENVER, CO 80206

PROJECT INFORMATION:

CUCHARES RANCH
DNO34860
9265 DRENNAN ROAD
COLORADO SPRINGS, CO 80925
EL PASO COUNTY

CURRENT ISSUE DATE: 1/4/05

ISSUED FOR:

CONSTRUCTION

REV. DATE: DESCRIPTION:


REV.	DATE	DESCRIPTION
1	01/20/04	PRELIM. ZONING TC
2	02/24/04	ZONING TC
3	03/11/04	REV. ZONING TC
4	07/15/04	PRELIM. CONST. DB
5	12/8/04	FINAL CONST. DB
6	1/4/05	REV. CONST. DB

PLANS PREPARED BY:

SI Communication Services, Inc.
7720 E. Bellevue, Ste. 9-230
Englewood, Co. 80111
Telephone: (303) 740-9965
Fax: (303) 740-9808

CHK. BY: DWB

APP. BY: MJS

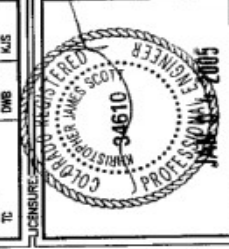



SHEET TITLE:

SITE PLAN

SHEET NUMBER:

A1

BASE: T. REC. SHEET

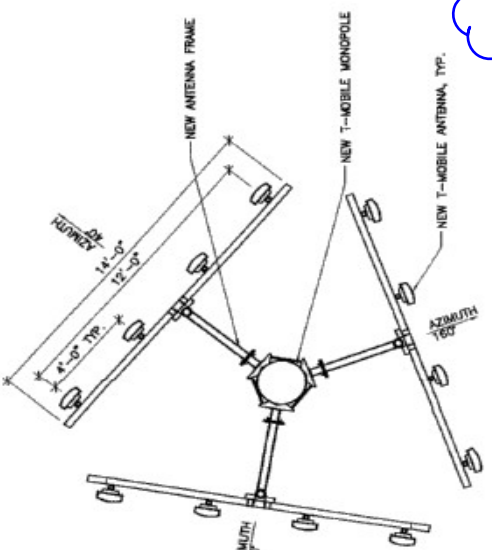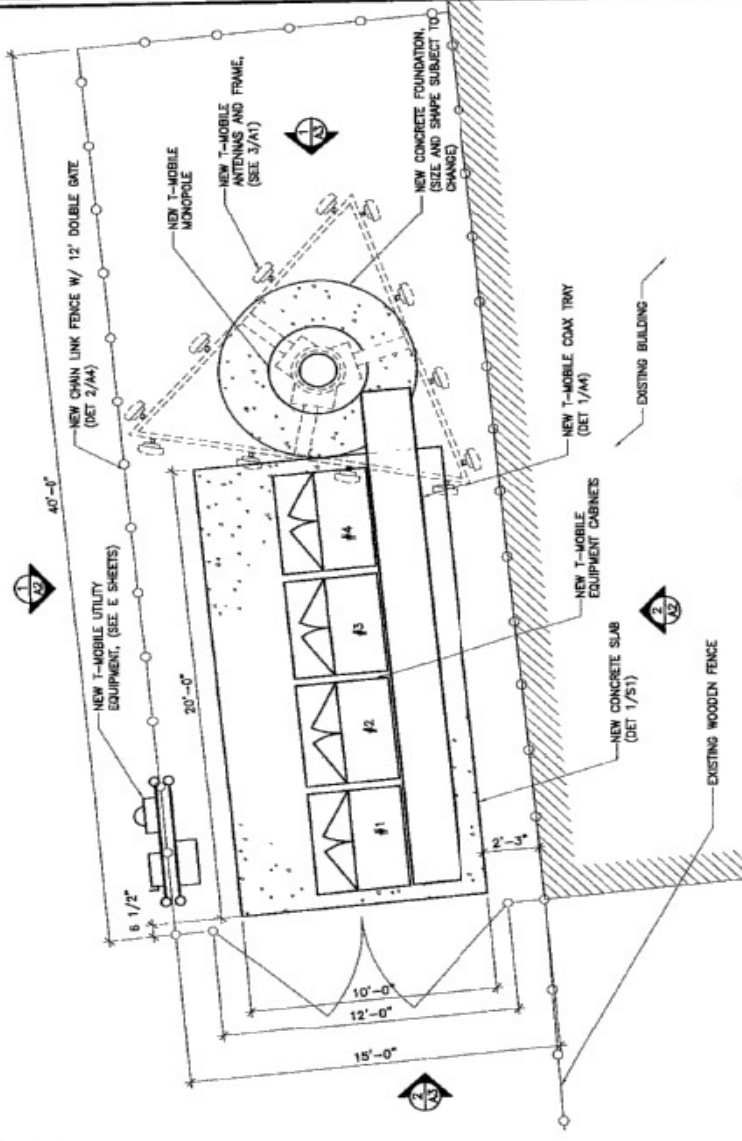

2 ENLARGED SITE PLAN 3/8" = 1'-0"

3 ANTENNA DETAIL 3/8" = 1'-0"

Vicinity map needs to be updated with current roads

Please provide a current complete site plan that shows the new tower additions, any added structures, cabinets etc.

Site plan to show property lines and any easements, Location of all existing and proposed utility lines and associated infrastructure

Add PCD File # TWR-21-011