


# Plot Plan

This is hard to see, the northern property line is not shown.

show easements

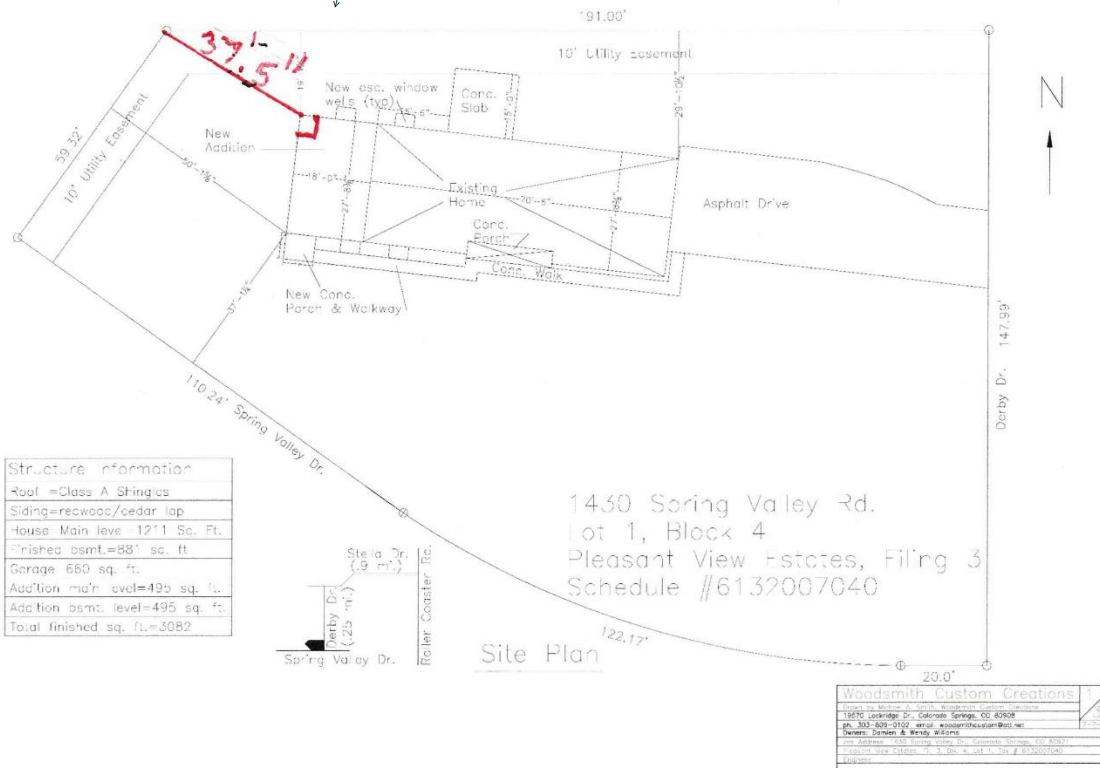


# Markup Summary

---

dskendall (2)

---

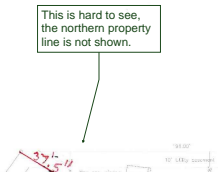

**Subject:** Callout  
**Page Label:** 1  
**Lock:** Unlocked  
**Author:** dskendall  
**Date:** 3/29/2019 2:18:16 PM  
**Color:** ■

This is hard to see, the northern property line is not shown.

show easements

---

**Subject:** Text Box  
**Page Label:** 1  
**Lock:** Unlocked  
**Author:** dskendall  
**Date:** 3/29/2019 2:18:29 PM  
**Color:** ■

show easements