

HIGHWAY 24 EASTGATE BUSINESS PARK

A CONDOMINIUM PLAT OF LOT 3, HILLCREST ACRES
EL PASO COUNTY, COLORADO

BUILDING NO. 3

CORRECTED TO ADD OMITTED UNIT DESIGNATION

Know all men by these presents:

That Laca-Laja, LLC, a Colorado Limited Liability Company, being the owner of the following tract of land to wit: A portion of Lot 1, Highway 24 Eastgate Business Park, recorded October 21, 2009 under Reception No. 209600917, formerly Lot 3, Hillcrest Acres, recorded May 12, 1960 in Plat Book B-2 at Page 64, County of El Paso, State of Colorado, except those portions conveyed to the Department of Transportation by instruments recorded July 1, 1993 in Book 6206 at Page 523 and Order and Decree Recorded January 3, 2003 at reception No. 203001280, describing the building footprint for Condominium Building 3, being more particularly described as follows: Commencing at the Northeast corner of said Lot 1, Highway 24 Eastgate Business Park; thence S24°20'36"W, 90.05' to the Point of Beginning; thence S32°47'14"E, 65.50'; thence S37°12'46"W, 250.50'; thence N32°47'14"W, 65.50'; thence N57°12'46"E, 250.50 to the Point of Beginning and containing 16408 SF / 0.377 AC.

Owners Certificate:

The aforesaid owner has executed this instrument this _____ day of _____, 20____ A.D.




By: _____
James E. Whidden, Managing Member

Notary:

STATE OF COLORADO }
 } ss
COUNTY OF EL PASO }

Acknowledged before me this _____ day of _____
by James E. Whidden as managing member.
My commission expires April 4, 2022
Witness my hand and official seal

Oliver E. Watts, Notary Public

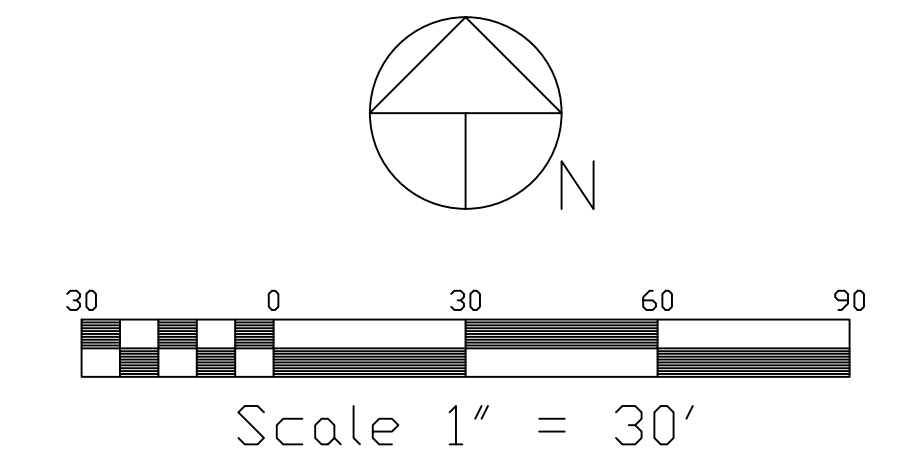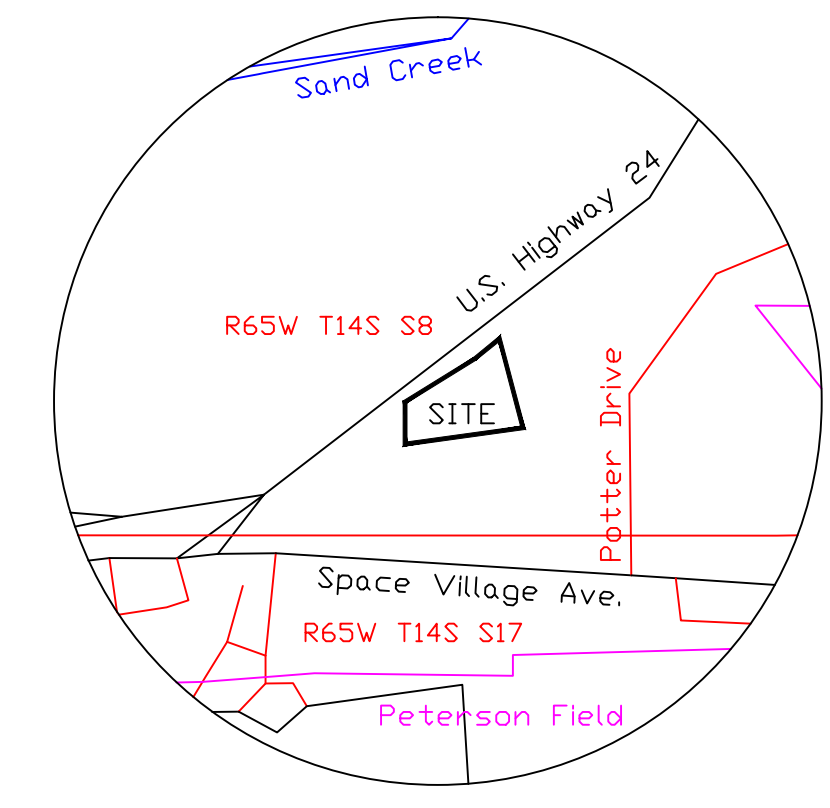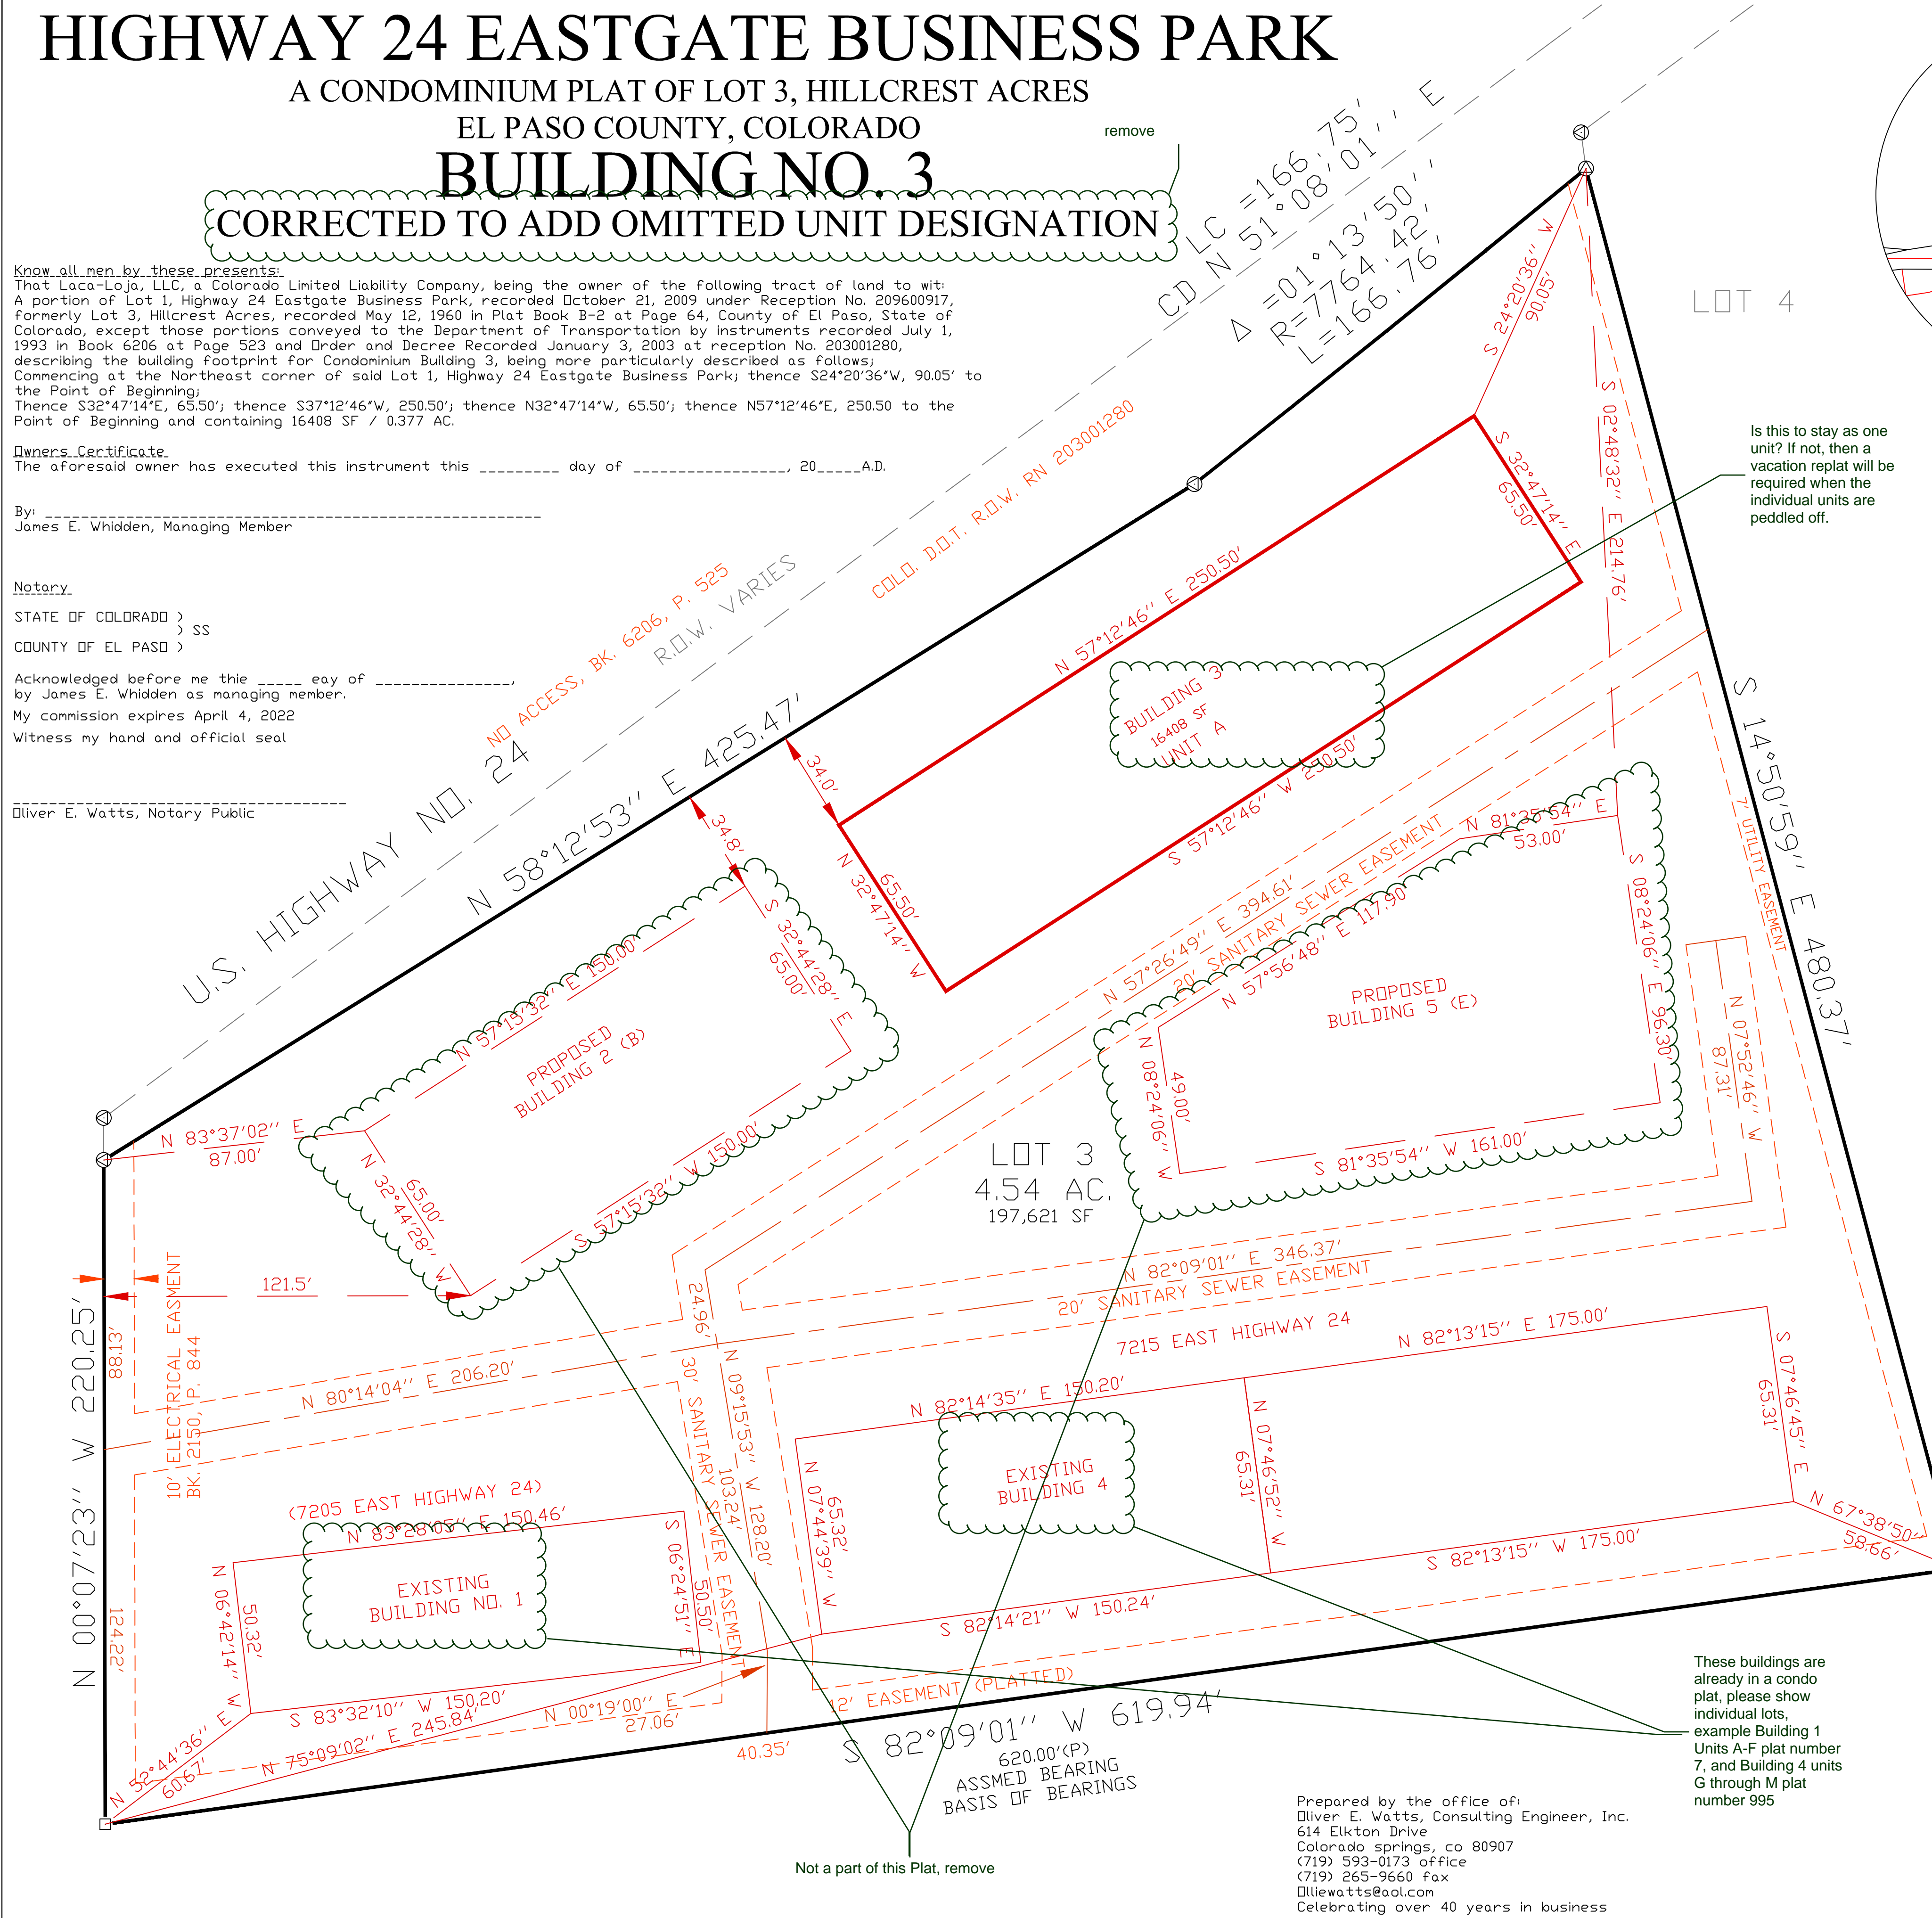

- LEGEND:**
- FOUND 1-1/4" AL. CAP, #19620 DN #5 REBAR
 - ⊗ FOUND 1/2" IRON PIPE
 - ⊙ FOUND 3-1/4" AL. CAP, #25381 DN #5 REBAR

VICINITY MAP

1"=1000'

This Condominium Plat for Highway 24 Eastgate Business Park, Building No. 3 was approved for filing by the El Paso County, Colorado Planning and Community Development Department Director on the _____ day of _____, 20____, subject to any notes or conditions specified hereon, Highway 24 Eastgate Business Park in entirety is intended for the areas described by this Condominium Plat subject to all covenants, conditions, and restrictions recorded against and appurtenant to the original plat recorded in the Office of the El Paso County Clerk and Recorder, Reception # _____

Planning and Community Development Director

Surveyors Certificate

I, Oliver E. Watts, a duly registered Professional Land Surveyor in the State of Colorado, do hereby certify that this plat truly and correctly represents the results of a survey made on date of survey, by me or under my direct supervision and that all monuments exist as shown hereon; that mathematical closure errors are less than 1:10,000; and that said plat has been prepared in full compliance with all applicable laws of the State of Colorado dealing with monuments, subdivision, or surveying of land and all applicable provisions of the El Paso County Land Development Code. These drawings and maps accurately depict the condominiums as required by the Condominium Declaration for Highway 24 Eastgate Business Park as recorded October 21, 2009, at Reception No. 209122752 of the records of El Paso County, Colorado. This plat contains all that information required by Section 38-33.3-209 C.R.S.

I attest the above on this _____ day of _____, 20____.

Oliver E. Watts, Colorado PE-LS No. 9853
For and On Behalf of: Oliver E. Watts, Consulting Engineer, Inc.

Please fix the numbering of the notes. Also the easements listed do not match what is depicted on the plat. Revise accordingly.

NOTES:

1. Bearings are based on the record bearing of S82°09'01"W for the south line of Highway 24 Eastgate Business Park monumented as shown on the plat.
2. Units of measurement: US Survey Feet
3. Bench Mark: US NGS Bench Mark No. R76 Elevation = 6286.32, NGVD 1929 Adjustment
4. All building locations measurements are to the edge of the outside walls
5. C.C.E. indicates general common elements as described by declaration
6. L.C.E. indicates limited common elements as described by declaration
7. The approval of the replat vacates all prior plats for the area described by this replat
8. All property within this subdivision is subject to an Avigation Easement as recorded in Book 3900 at Page 276
9. There are no plat notes that affect this site on the recorded subdivision plat of Hillcrest Acres
10. Water and wastewater service for this subdivision is provided by the Cherokee Metropolitan District subject to the District's rules, regulations and specifications, per instruments recorded in Book 3779 at Page 789 and at Reception No. 201084507.
11. Unless otherwise indicated, all side, front, and rear lot lines are hereby platted on either side with a 10 foot public utility and drainage easement unless otherwise indicated. All exterior subdivision boundaries are hereby platted with a 20 foot public utility and drainage easement. The sole responsibility for maintenance of these easements is hereby vested with the individual property owners
12. Developer shall comply with federal and state laws, regulations, ordinances, review and permit requirements, and other agency requirements, if any, of applicable agencies including, but not limited to, the Colorado Division of Wildlife, Colorado Department of Transportation, U.S. Army Corps of Engineers and the U.S. Fish and Wildlife Service regarding the Endangered Species Act, particularly as it relates to the listed species (e.g., Preble's Meadow Jumping Mouse).
13. The addresses exhibited on this plat are for informational purposes only. They are not the legal description and are subject to change.
14. No driveways shall be established unless an access permit has been granted by El Paso County.
15. Mailboxes shall be installed in accordance with all El Paso County and United States Postal Service regulations.
16. Note Regarding Reports on File: The following reports have been submitted in association with the Preliminary Plan or Final Plat for this subdivision and are on file at the County Planning and Community Development Department: Transportation Impact Study; Drainage Report; Water Resources Report; Wastewater Disposal Report; Geology and Soils Report; Fire Protection Report; Wildfire Hazard Report; Natural Features Report; (other; modify based upon specific reports)
17. There shall be no direct access to Highway 24 per deed recorded in Book 6206 at Page 525
18. The property within this subdivision is subject to the Declarations as recorded at Reception no. 209122752 of the records of the El Paso County Clerk and Recorder.
19. The information was provided by the client as follows:
 - Title Company: _____ Information missing
 - Commitment No: _____
 - Effective Date: _____
20. This survey does not constitute a Title search or opinion.
21. This map is being re-recorded to add the omitted unit designation

Notice: according to Colorado law, you must commence any legal action based upon any defect in the survey within three years after you first discover such defect. In no event may any action based upon any defect in this survey be commenced more than ten years from the date of the certification shown hereon.

Flood plain:
According to the current effective Federal Emergency Management Agency Flood Insurance Rate Map, the subject property is located outside the boundary of the 100 Year Floodplain, as identified on FEMA Mapping Panel No. 08041C0754 G, dated December 7, 2018.

STATE OF COLORADO
COUNTY OF EL PASO
I hereby certify that this instrument was filed in my office on this _____ day of _____, 200____ and was recorded at Reception Number _____ of the records of El Paso County

El Paso County Clerk and Recorder
Fee: _____
Surcharge: _____
School fees: _____ Park fees: _____ Drainage fees: _____ Bridge fees: _____

These buildings are already in a condo plat, please show individual lots, example Building 1 Units A-F plat number 7, and Building 4 units G through M plat number 995

Prepared by the office of:
Oliver E. Watts, Consulting Engineer, Inc.
614 Elkton Drive
Colorado Springs, CO 80907
(719) 593-0173 office
(719) 265-9660 fax
Olliewatts@aol.com
Celebrating over 40 years in business

DRAWN BY: O.E. WATTS DATE: 12-20-19 DWG. NO.: 04-3486-14 SURVEYED BY: DEV, ESV, THRU 7-28-16	APPROVED BY: PROJ. NO. DWG.	REVISIONS	OLIVER E. WATTS CONSULTING ENGINEER COLORADO SPRINGS	PROJECT HIGHWAY 24 EASTGATE BUSINESS PARK EL PASO COUNTY	SHEET NAME CONDOMINIUM PLAT	SHEET NO. 1 OF 1
---	-----------------------------------	-----------	--	--	--------------------------------	---------------------

Plat_V1.pdf Markup Summary

Callout (1)



Subject: Callout
Page Label: 1
Lock: Locked
Author: Daniel Torres
Date: 1/29/2020 4:09:24 PM
Status:
Color: ■
Layer:
Space:


Please fix the numbering of the notes. Also the easements listed do not match what is depicted on the plat. Revise accordingly.

Cloud+ (7)




Subject: Cloud+
Page Label: 1
Lock: Locked
Author: dsdsevigny
Date: 1/29/2020 4:09:21 PM
Status:
Color: ■
Layer:
Space:

Information missing

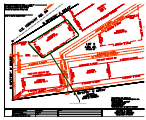


Subject: Cloud+
Page Label: 1
Lock: Locked
Author: dsdsevigny
Date: 1/29/2020 4:09:22 PM
Status:
Color: ■
Layer:
Space:

Not a part of this Plat, remove

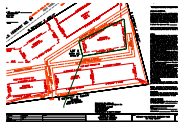

Subject: Cloud+
Page Label: 1
Lock: Locked
Author: dsdsevigny
Date: 1/29/2020 4:09:23 PM
Status:
Color: ■
Layer:
Space:

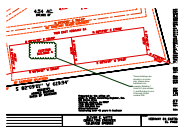

Subject: Cloud+
Page Label: 1
Lock: Locked
Author: dsdsevigny
Date: 1/29/2020 4:09:30 PM
Status:
Color: ■
Layer:
Space:

These buildings are already in a condo plat, please show individual lots, example Building 1 Units A-F plat number 7, and Building 4 units G through M plat number 995



Subject: Cloud+
Page Label: 1
Lock: Locked
Author: dsdseigny
Date: 1/29/2020 4:09:31 PM
Status:
Color: ■
Layer:
Space:



Subject: Cloud+
Page Label: 1
Lock: Locked
Author: dsdseigny
Date: 1/29/2020 4:09:32 PM
Status:
Color: ■
Layer:
Space:

Is this to stay as one unit? If not, then a vacation replat will be required when the individual units are peddled off.



Subject: Cloud+
Page Label: 1
Lock: Locked
Author: dsdseigny
Date: 1/29/2020 4:09:33 PM
Status:
Color: ■
Layer:
Space:

remove

Highlight (2)


Recep
 11. Un
 public

Subject: Highlight
Page Label: 1
Lock: Locked
Author: Daniel Torres
Date: 1/29/2020 4:09:25 PM
Status:
Color: ■
Layer:
Space:

ease
 11. De
 othe

Subject: Highlight
Page Label: 1
Lock: Locked
Author: Daniel Torres
Date: 1/29/2020 4:09:29 PM
Status:
Color: ■
Layer:
Space:

Text Box (1)

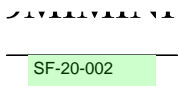

Subject: Text Box
Page Label: 1
Lock: Locked
Author: dsdseigny
Date: 1/29/2020 4:09:21 PM
Status:
Color: ■
Layer:
Space:

SF-20-002

SF-20-002