


©2019 Microsoft Corporation. ©2019 NAVTEQ. ©2019 Image courtesy of NASA

PLOT PLAN / SPECIAL USE DRAWING


www.invarion.com

Identify all vehicle storage areas.
Show setbacks from buildings to nearest property line.

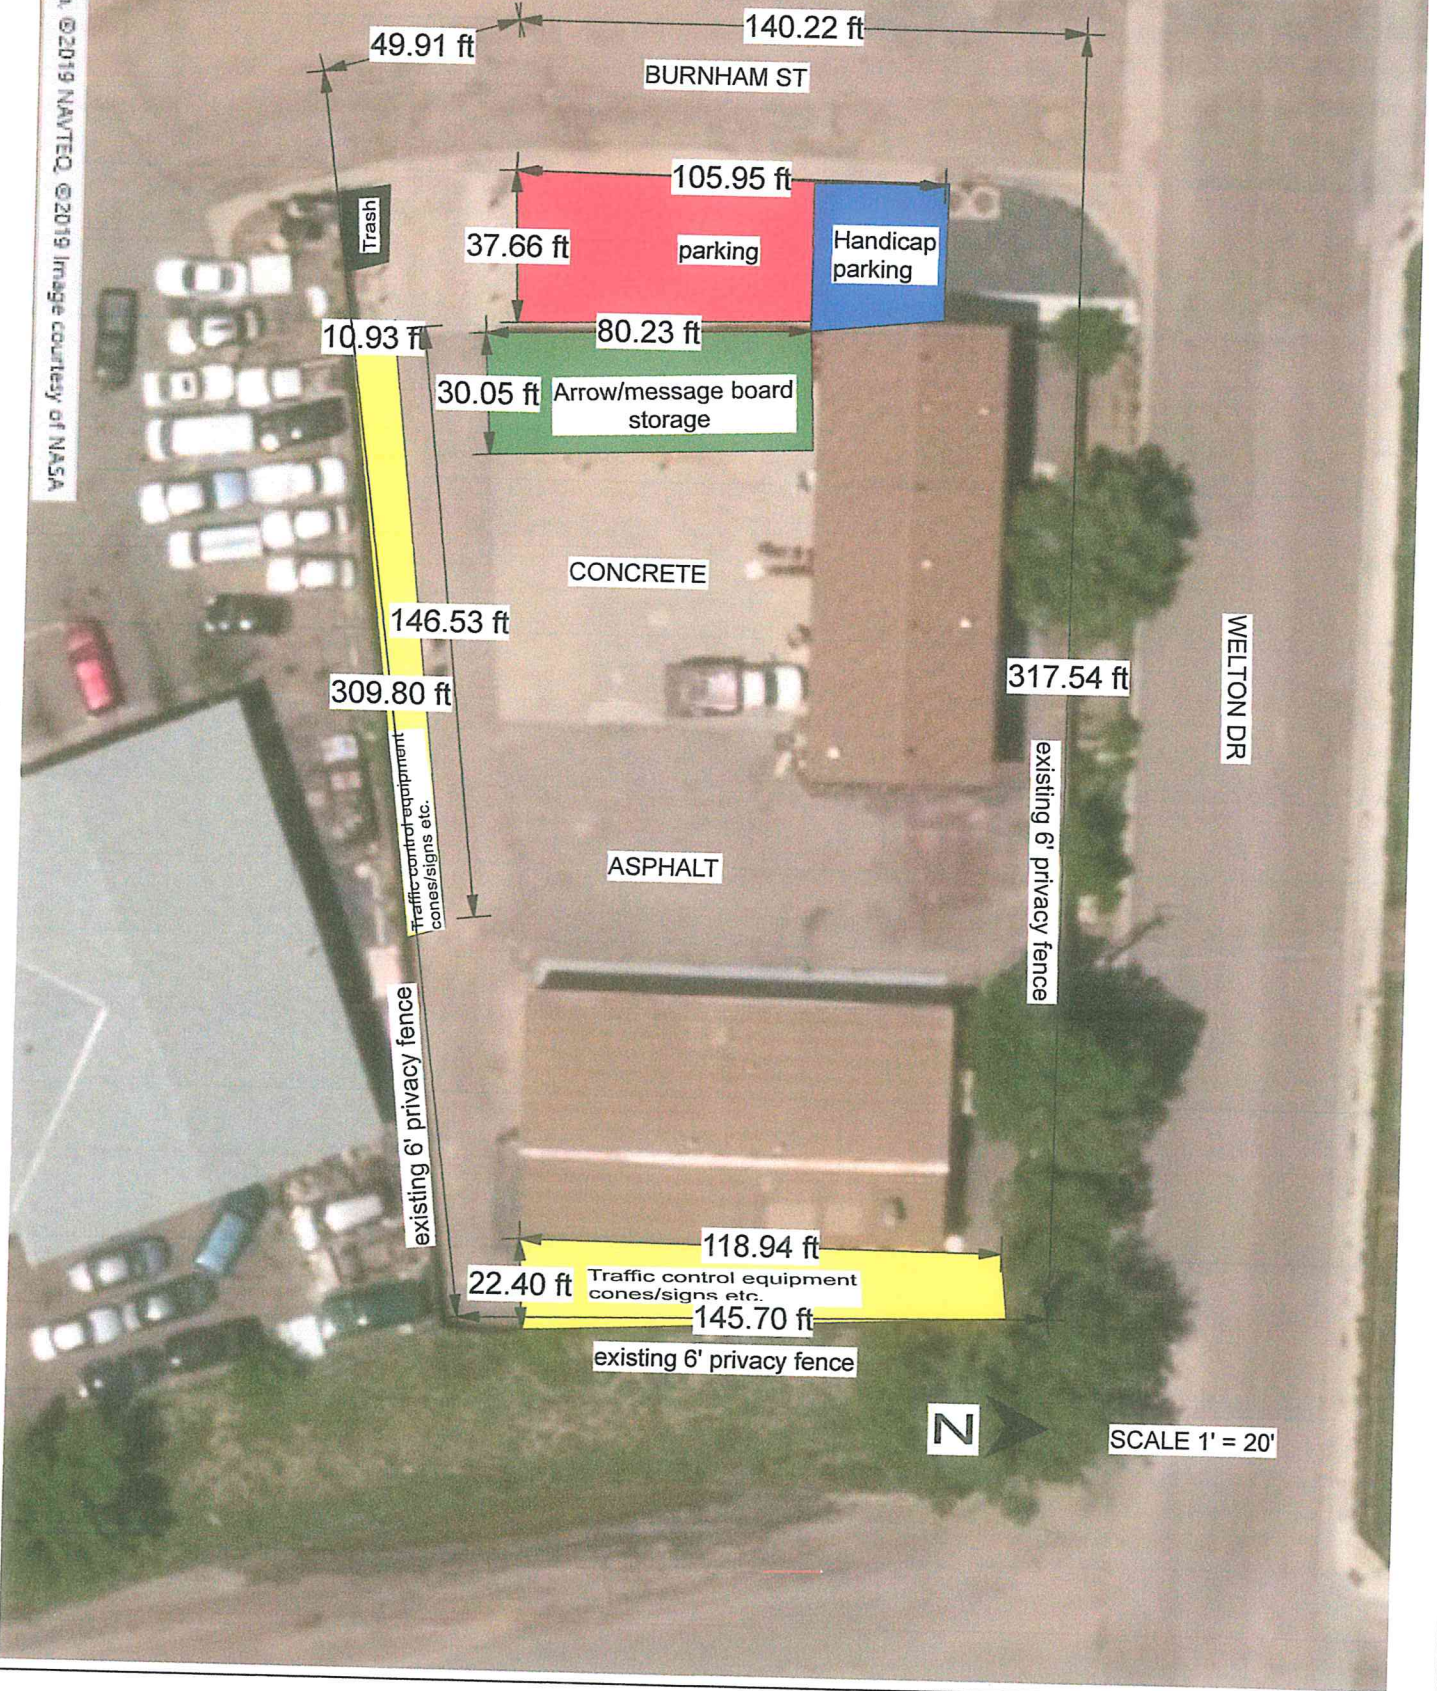

Show property boundaries on this plan. Designate vehicle storage area. Add North arrow.

Add PCD File No. AL196

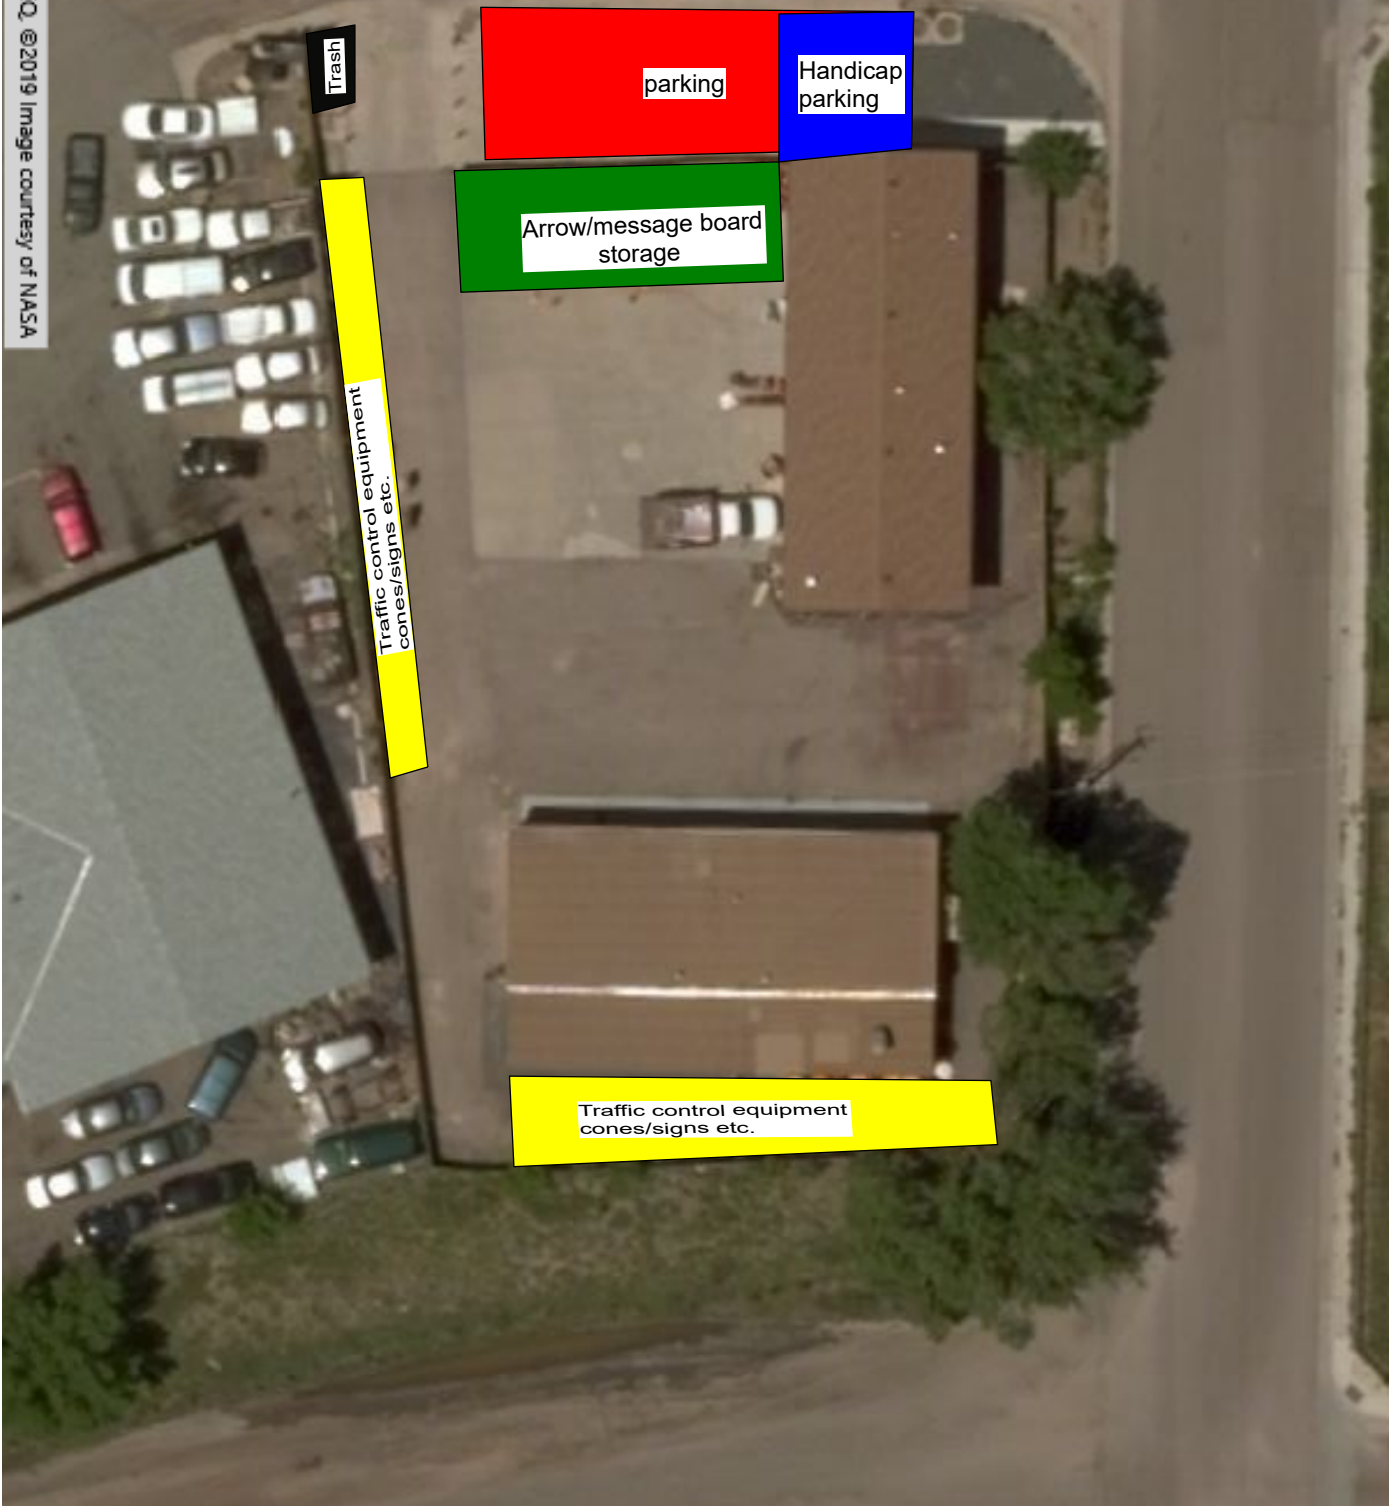

Trash

parking

Handicap parking


Arrow/message board storage

Traffic control equipment cones/signs etc.

Traffic control equipment cones/signs etc.

Markup Summary

Identify all vehicle storage areas. Show setbacks from buildings to nearest property line. (1)

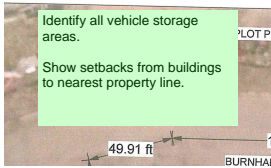


Subject: Text Box
Page Label: 1
Lock: Locked
Author: dsdkendall
Date: 4/22/2019 11:54:40 AM
Color: ■

Identify all vehicle storage areas.

Show setbacks from buildings to nearest property line.

Show property boundaries on this plan. Designate vehicle storage area. Add North arrow. Add PCD File No. AL196 (1)

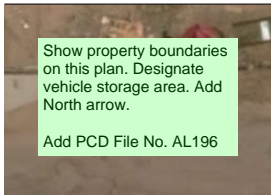

Subject: Text Box
Page Label: 2
Lock: Locked
Author: dsdkendall
Date: 4/22/2019 11:54:41 AM
Color: ■

Show property boundaries on this plan.
Designate vehicle storage area. Add
North arrow.

Add PCD File No. AL196