

SITE PLAN

SCALE: 1" = 30'-0"

AERIAL VIEW

SCALE: NTS

TOTAL # OF PANELS
31



Platted Parcel



Assessor's Map 57350

120.00' Per Final Recorded Plat & Assessor's Map

100.00' Per Final Recorded Plat & Assessor's Map

418.99' Per Final Recorded Plat & Assessor's Map

162.29' Per Final Recorded Plat & Assessor's Map

150.00' Per Final Recorded Plat & Assessor's Map

270.21' Per Final Recorded Plat & Assessor's Map

152.97' Per Final Recorded Plat & Assessor's Map

307.93' Per Final Recorded Plat & Assessor's Map

307.93' Per Final Recorded Plat & Assessor's Map

460.44' Per Final Recorded Plat & Assessor's Map

242.67' Per Final Recorded Plat & Assessor's Map



120.00' Per Final Recorded Plat & Assessor's Map

APPROVED
Plan Review
08/28/2020 4:01:32 PM
dsdespinosa
EPC Planning & Community Development Department

Not Required
BESQCP
08/28/2020 4:01:55 PM
dsdespinosa
EPC Planning & Community Development Department


ANY APPROVAL GIVEN BY EL PASO COUNTY DOES NOT OBTAIN THE NEED TO COMPLY WITH APPLICABLE FEDERAL, STATE, OR LOCAL LAWS AND/OR REGULATION. Planning & Community Development Department approval is contingent upon compliance with all applicable rules on the recorded plat. An access permit must be granted by the Planning & Community Development Department prior to the establishment of any driveway onto a County road. Diversion of blockage of any drainage way is not permitted without approval of the Planning & Community Development Department.

It is the owner's responsibility to coordinate with easement holders to avoid impact to utilities that may be located in the easements.

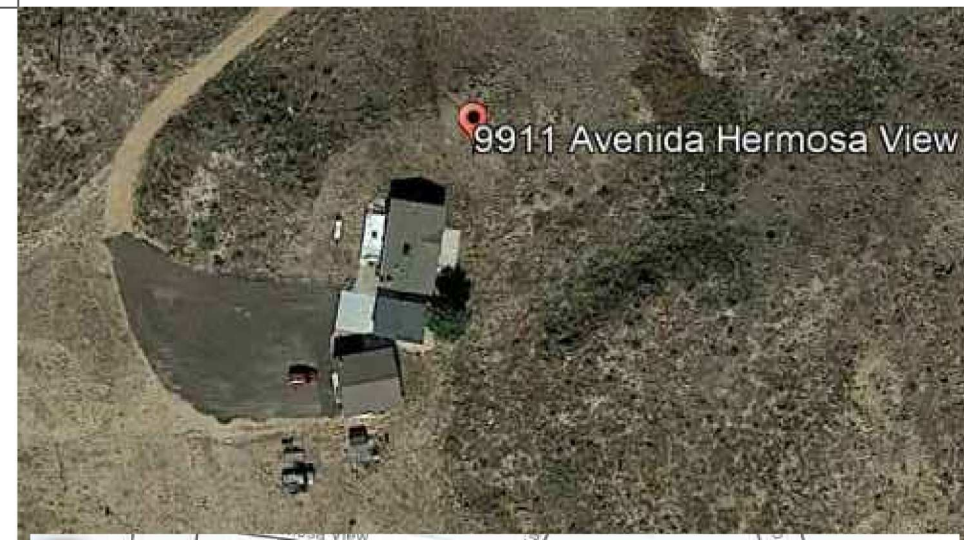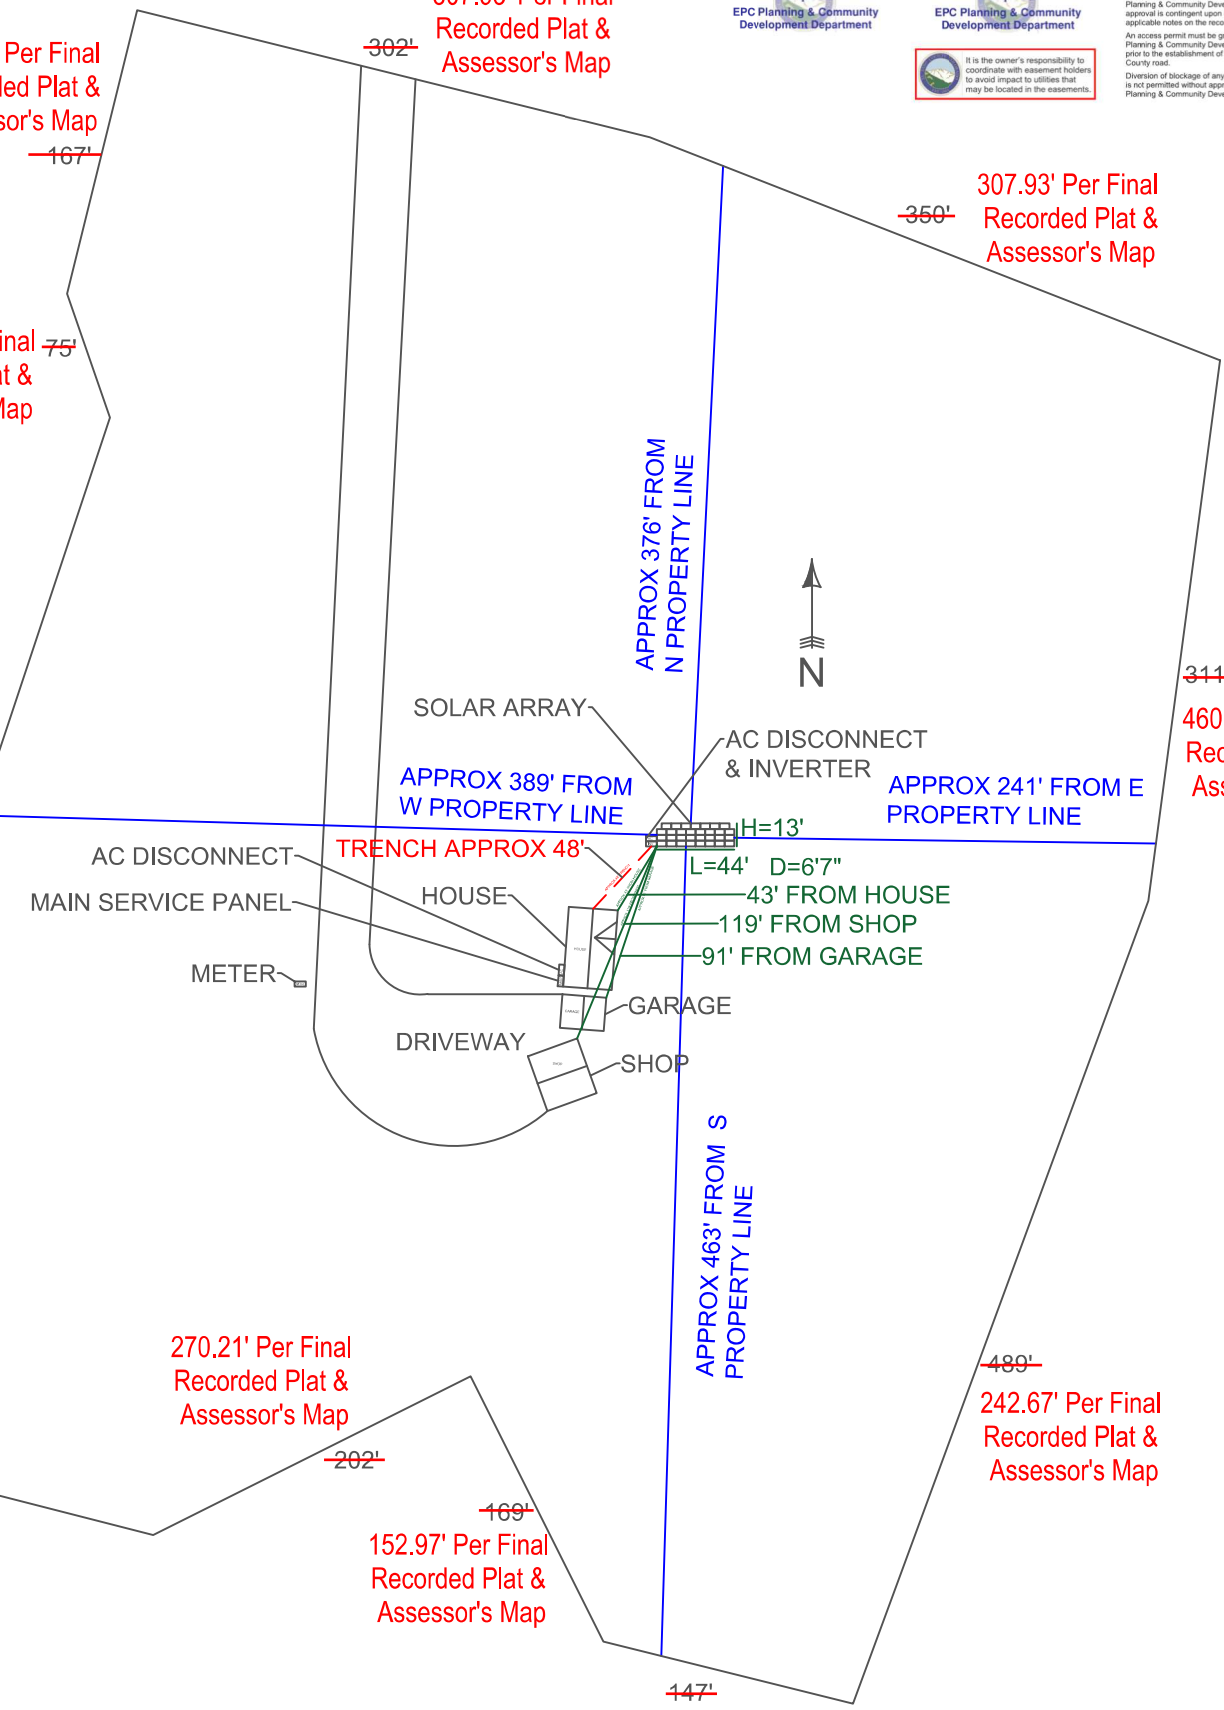

ABBREVIATIONS


INV	INVERTER	MSP	MAIN SERVICE PANEL
AC	AC DISCONNECT	MTR	METER

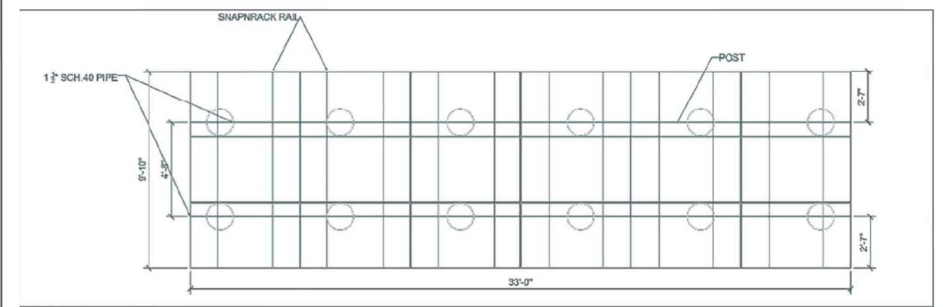

ATTACHMENT DETAIL

SCALE: 1/4" = 1'

R129873
ADD20394
PLAT 3427
ZONE RR-5
DIST 4

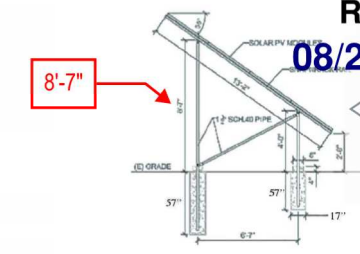

Released for Permit
08/24/2020 9:55:59 AM



CONTRACTOR INFORMATION

Big Dog Renewable Electric Energy
Contractor Lic # EC.0100531
620 Pheasant Ridge Dr
Chubbuck, ID 83202
208-242-3352 T
208-232-5935 F X



www.bigdogenergy.com

DESIGNED BY

ALAN JOHNSON
9911 AVENIDA HERMOSA VIEW
FOUNTAIN, CO 80817
512-567-3644

SOLAR PHOTOVOLTAIC SYSTEM

DATE	7/16/2020
ISSUED FOR: PERMIT	SITE PLAN, AERIAL VIEW


RESIDENTIAL



2017 PPRBC

Address: 9911 AVENIDA HERMOSA VW, FOUNTAIN

Parcel: 5735002002

Plan Track #: 129873 

Received: 15-Jun-2020 (BECKYA)

Map #: 170G

Description:

PV SOLAR

Contractor: BIG DOG RENEWABLE ENERGY LLC

Type of Unit:

Required PPRBD Departments (3)

Floodplain

(N/A) RBD GIS

Construction

Electrical
Released for Permit
08/11/2020 3:11:46 PM




shelby
ELECTRICAL

Required Outside Departments (1)

County Zoning

APPROVED
Plan Review

08/28/2020 4:13:52 PM
dsdespinoza



EPC Planning & Community
Development Department

Release of this plan does not preclude compliance with all applicable codes, ordinances and other pertinent regulations. This plan set must be present on the job site for every inspection.